



工程指示 / 要求簡箋(E.I.)

工程指示編號：EI / 1566 / 20 修改版次：G
 工程編號：J851 工程名稱：青衣 明翹匯
 工程項目：確認模圖(單元件幕牆)
 收件人：羅小姐 發件人：Leung Hin Wai 日期：23/03/2020

要求提供 / 確認 事項：

- | | | |
|------------------------------------|-------------------------------------|-------------------------------|
| <input type="checkbox"/> 初步鋁料 B.M. | <input type="checkbox"/> 加工拆圖，然後生產 | <input type="checkbox"/> 尺寸表 |
| <input type="checkbox"/> 正式鋁料 B.M. | <input type="checkbox"/> 技術上資料 / 指示 | <input type="checkbox"/> 報價 |
| <input type="checkbox"/> 配件 B.M. | <input type="checkbox"/> 樣辦或貨品說明書 | <input type="checkbox"/> 分判合約 |
| <input type="checkbox"/> 其他：_____ | | |

內容：

確認模圖。共1頁。

請在_____前完成上列要求。

附： -

以上項目為：

- 原合約工程包 原合約工程加 / 減賬 新工程報價

原因： -

分發東莞各部門：

- () 生產技術總監 連附件 () 技術部 連附件 () 生產部 連附件 () 機械設計部 連附件
 () 採購部 連附件 () 生產統籌部 連附件
 () 質檢部 連附件 () 會計部 連附件 () 報關組 連附件 () 其他 _____ 連附件

分發香港各部門：

- () 行政部 連附件 () 會計部 連附件 () 統籌部 連附件 () 工程部地盤科文(柄) 連附件
 () 採購部 連附件 () QS 部 連附件 () 維修部 連附件 () 其他 _____ 連附件

傳遞編號：



HK 0395

發件人簽署：

項目經理簽署：

(Handwritten signatures)

CUSTOMER	HONGKONG CO.	CUSTOMER APPROVAL	CUST PART NO.	X85782
			SECTION NO.	LH0091262

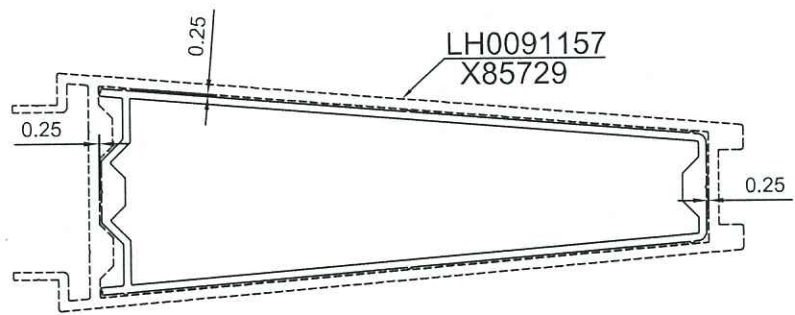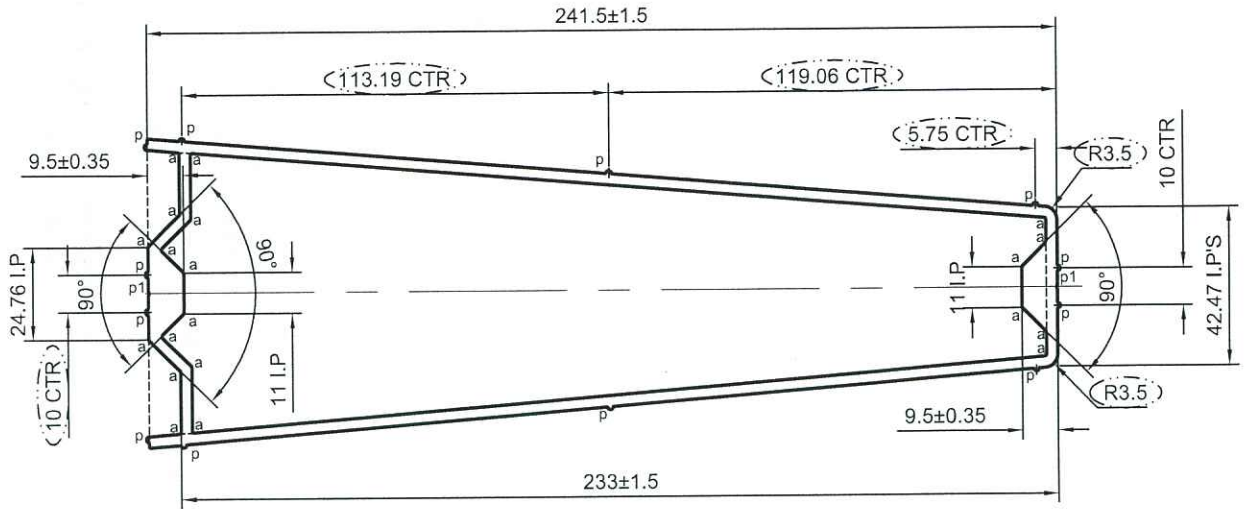

美特鋁質有限公司
承認圖面
日期 23/3-2020

p1=R0.3X0.3
p=R0.75X0.75
a=R0.5 b=R1

*配合尺寸以实物配合效果为准!

NO.V.F

SCALE 1:3

SIGNATURE GRADEING	HIGH SIGNATURE GRADEING	C.C.DIA(MM)	Ø249.91		喷涂收费周长(mm):		-		
AREA (SQ MM)	(2044.02)	UNSPECIFIED THICKNESS	3±0.25	PERIMETER (MM)	(638.07)	STANDARD	BS EN755	SCALE	1:2
MASS (KG/M)	(5.539)	UNSPECIFIED CORNERS	R 0.3	SURFACE AREA	-	ALLOY	6063-T6	VERSION	D
			DRAWN	陈晓舒	DATE	2020-03-20	APELLATION	-	PAGE OF
			STANDARDIZATION		DATE				
			TO SIGN	陈国提	DATE				
			AUDITING		DATE				
MARKER	MODIFY	FILE NO	SIGNATURE	DATE	APPROV				

 PANASIA ALUMINUM (CHINA) LIMITED