



工程指示 / 要求簡箋(E.I.)

工程指示編號：EI / 1575 / 20 修改版次：A
 工程編號：J851 工程名稱：青衣 明翹匯
 工程項目：修改模圖
 收件人：羅小姐 發件人：Leung Hin Wai 日期：10/3-2020

要求提供 / 確認 事項：

- | | | |
|------------------------------------|-------------------------------------|-------------------------------|
| <input type="checkbox"/> 初步鋁料 B.M. | <input type="checkbox"/> 加工拆圖，然後生產 | <input type="checkbox"/> 尺寸表 |
| <input type="checkbox"/> 正式鋁料 B.M. | <input type="checkbox"/> 技術上資料 / 指示 | <input type="checkbox"/> 報價 |
| <input type="checkbox"/> 配件 B.M. | <input type="checkbox"/> 樣辦或貨品說明書 | <input type="checkbox"/> 分判合約 |
| <input type="checkbox"/> 其他：_____ | | |

內容：在 9/3 確認的模圖 X85755 (LH0091188)，需按附頁修改

請在 _____ 前完成上列要求。

附： -

以上項目為：

- 原合約工程包 原合約工程加 / 減賬 新工程報價

原因： - _____

分發東莞各部門：


- () 生產技術總監 連附件 () 技術部 連附件 () 生產部 連附件 () 機械設計部 連附件
 () 採購部 連附件 () 生產統籌部 連附件
 () 質檢部 連附件 () 會計部 連附件 () 報關組 連附件 () 其他 _____ 連附件

分發香港各部門：

- () 行政部 連附件 () 會計部 連附件 () 統籌部 連附件 () 工程部地盤科文(柄) 連附件
 () 採購部 連附件 () QS 部 連附件 () 維修部 連附件 () 其他 _____ 連附件

傳遞編號：HK 0311

發件人簽署：
 項目經理簽署：

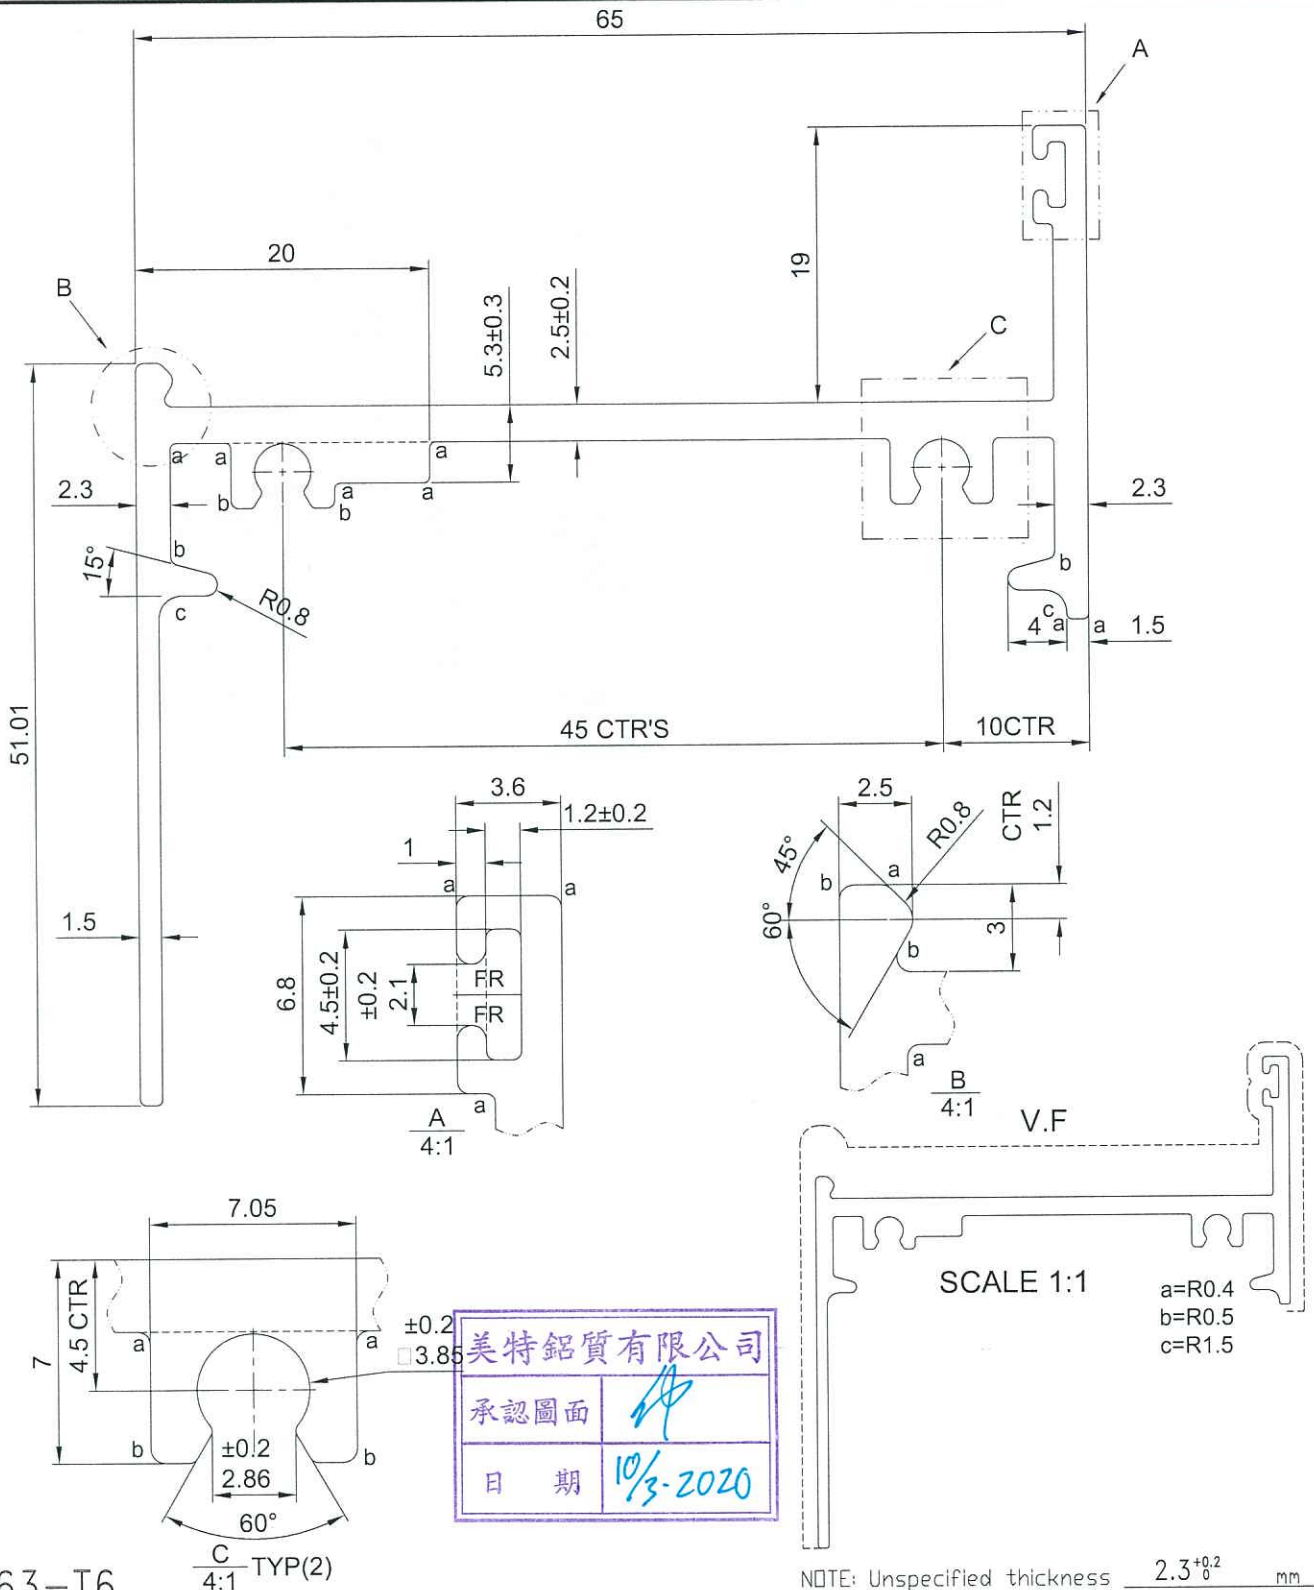






6063-T6

C
4:1 TYP(2)

NOTE: Unspecified thickness $2.3^{+0.2}$ mm
Radii on unspecified corner (max. 0.3 mm)

SECTIONAL AREA	mm ²	ADDITIONAL TOLERANCE	DATE	REVISION			
				NO.	DATE	NAME	DESCRIPTION
382.558		Thickness ± 0.1 mm	17/02/2020	A	07/03	WAI	
WEIGHT	KG/M	Flatness 0.1 /25mm width	SCALE				
1.037		Straightness 0.3 /300mm	1 : 1				
PERIMETER	mm	Twist 0.5° /300 mm max	DRAWN				
343.100		Angularity ± 1.0 degree	CHECK				
V.F.	mm						
181.764							

CUSTOMER	HONGKONG CO.	CUSTOMER APPROVAL	CUST PART NO.	X85755
			SECTION NO.	LH0091188

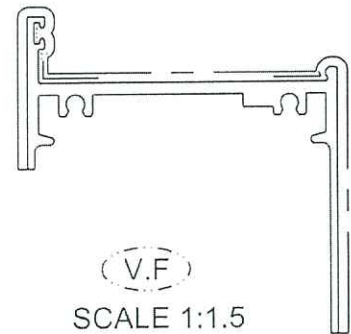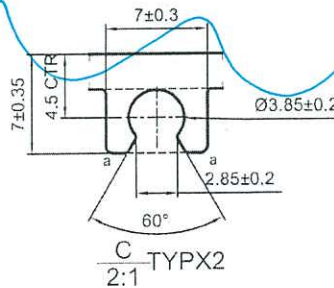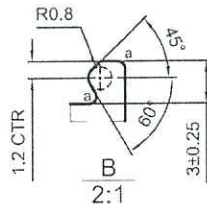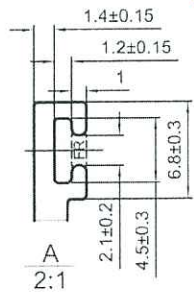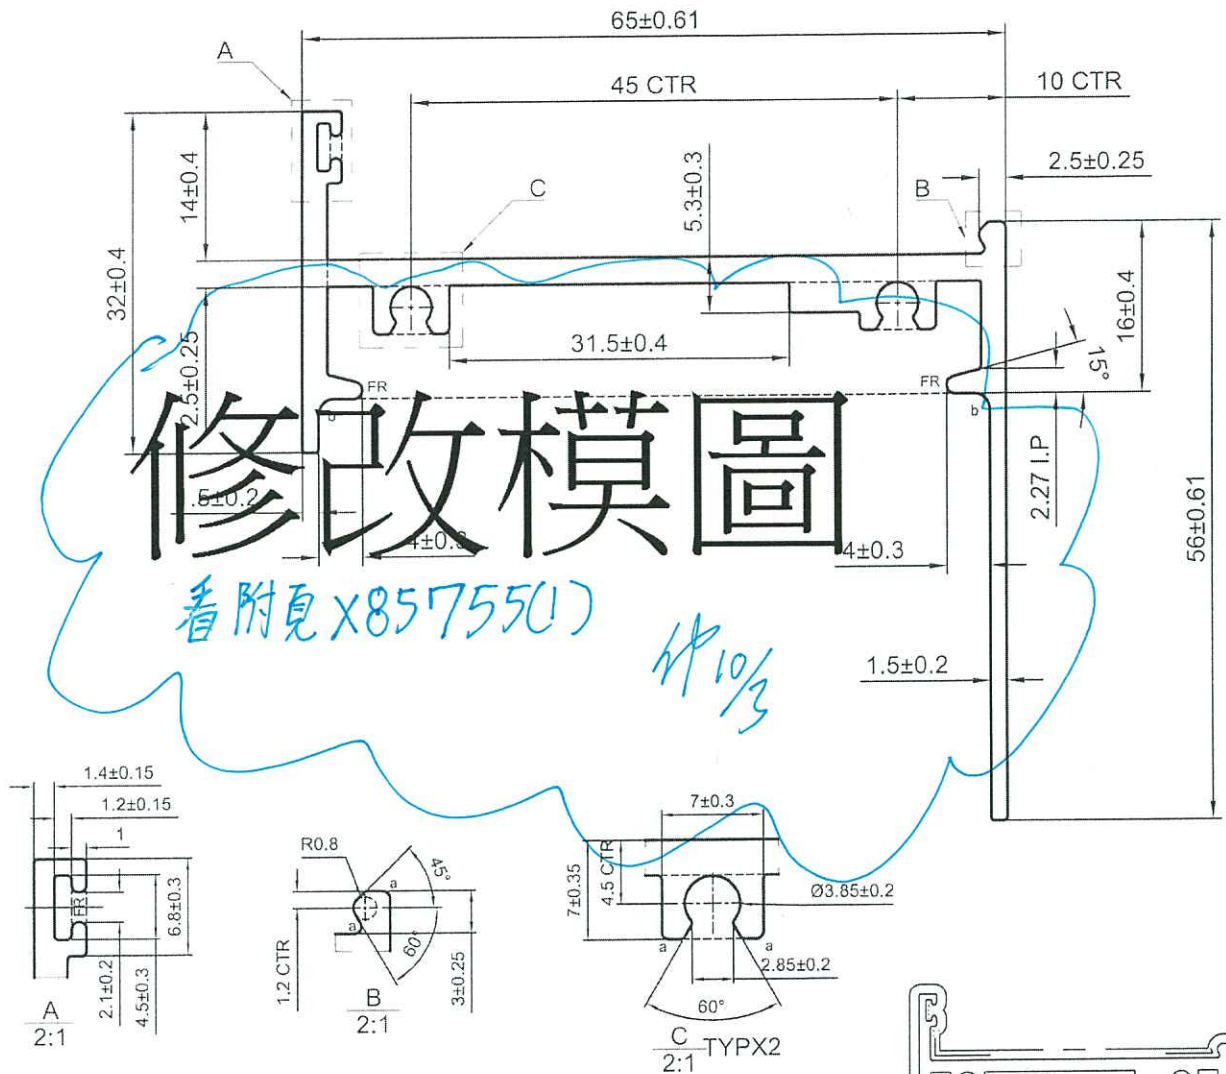

a=R0.5 b=R1.5

- 次要装饰面, 喷涂膜厚不足, 但不露底
- 装饰面
- 凹槽位置可能会有露底现象, 即膜厚不足

备注: 没有配合型号!

美特铝质有限公司	
承認圖面	10/3
日期	9/3-2020

(V.F)
SCALE 1:1.5

SIGNATURE GRADEING	HIGH SIGNATURE GRADEING	C.C.DIA(MM)	Ø 92.94	喷涂收费周长(mm):		179.83
AREA (SQ MM)	383.02	UNSPECIFIED THICKNESS	2.3±0.2	PERIMETER (MM)	349.88	STANDARD BS EN755
MASS (KG/M)	1.038	UNSPECIFIED CORNERS	R 0.3	SURFACE AREA	179.83	ALLOY 6063-T6
		DRAWN	陈晓舒	DATE	2020-02-20	APELLATION -
		STANDARDIZATION		DATE		PAGE OF
		TO SIGN	陈国提	DATE		
		AUDITING		DATE		
MARKER	MODIFY	FILE NO	SIGNATURE	DATE	APPROV	DATE

 PANASIA ALUMINUM (CHINA) LIMITED