



工程指示 / 要求簡箋(E.I.)

工程指示編號：EI/1941

修改版次：A

工程編號：J851

工程名稱：青衣 明翹匯

工程項目：地盤用鋁料加工圖(VMU 幕牆樣板)

收件人：生統

發件人：Leung Hin Wai

日期：17/6-2020

要求提供 / 確認 事項：

- | | | |
|------------------------------------|-------------------------------------|-------------------------------|
| <input type="checkbox"/> 初步鋁料 B.M. | <input type="checkbox"/> 加工拆圖，然後生產 | <input type="checkbox"/> 尺寸表 |
| <input type="checkbox"/> 正式鋁料 B.M. | <input type="checkbox"/> 技術上資料 / 指示 | <input type="checkbox"/> 報價 |
| <input type="checkbox"/> 配件 B.M. | <input type="checkbox"/> 樣辦或貨品說明書 | <input type="checkbox"/> 分判合約 |
| <input type="checkbox"/> 其他：_____ | | |

內容：

請按附頁加工，送香港司機陳米埔露天車場。

UN01,UN02,UN03,UN04,UN05,UN06,UN01W,UN02W,UN03W,UN04W,UN05W,UN06W 用 EI1801的玻璃

UN01E,UN02E,UN03E,UN04E,UN05E,UN06E 用EI1847的玻璃

請在 6月尾 前完成上列要求。

附：

1 + 1 頁

以上項目為：

- 原合約工程包 原合約工程加 / 減賬 新工程報價

原因：-

分發東莞各部門：

- () 生產技術總監 連附件 () 技術部 連附件 () 生產部 連附件 () 機械設計部 連附件
 () 採購部 連附件 () 生產統籌部 連附件
 () 質檢部 連附件 () 會計部 連附件 () 報關組 連附件 () 其他 _____ 連附件

分發香港各部門：

- () 行政部 連附件 () 會計部 連附件 () 統籌部 連附件 () 工程部地盤科文 連附件
 () 採購部 連附件 () QS 部 連附件 () 維修部 連附件 () 其他 _____ 連附件

傳遞編號：

HK 1176

發件人簽署：

項目經理簽署：

B.D. REF :
 F.S.D. REF :
 Note:
 1. All dimensions are in mm.
 2. All elevations are viewed from outside.
 3. All dimensions to be verified on site before fabrication.


GENERAL NOTES
 Legend:
 1. F.F.L. --- Finished Floor Level
 2. S.F.L. --- Structural Floor Level
 3. (R) --- Recessed Detail
 X1
 X001
 DETAIL MARK NO
 REFER SHEET NO

CLIENT :
 佳明集團控股有限公司
 GRAND MTR GROUP HOLDINGS LIMITED
 MAIN CONTRACTOR :
 GRAND TECH CONSTRUCTION CO. LTD.

ARCHITECT :
 WONG SUNG & PARTNERS LIMITED
 ARCHITECTS IN HONG KONG
 STRUCTURAL ENGINEER :
 C H WONG & ASSOCIATES LTD

PROJECT :
 RESIDENTIAL DEVELOPMENT AT
 TUNG YI TOWN LOT 108 SH SHAN ROAD
 TITLE :
 PARTIAL ELEVATION SECTION AND
 PLAN OF CURTAIN WALL MOCK UP

JOB NO. : J-851
 DRAWN BY : LUC
 DATE : 13-05-2020
 SCALE : A1 : LUP
 PKG. NO. : JBS1-WA-PE101
 REV. : B

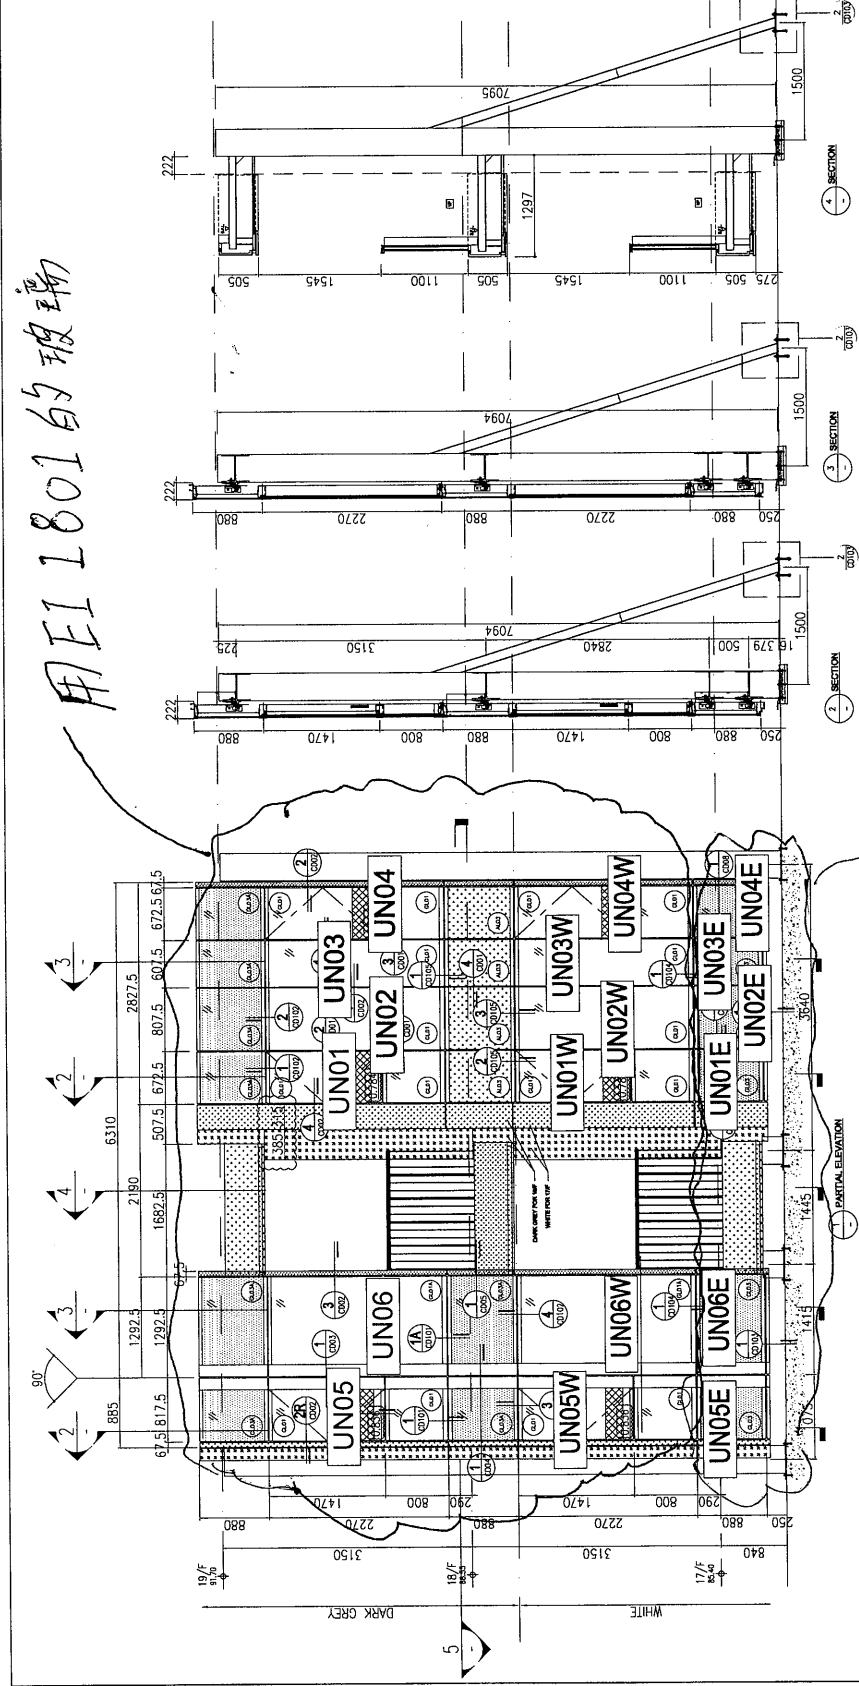

ALD1	3mm THK. ALUM. CLADDING
A03	3mm THK. ALUM. CLADDING(SANDY BROWN)
A01	ALUM. FEATURE
GLD1	28mm THK. GREY BLUE GLASS(6mm HST+2mm AIR+6mm TEMPERED)
GLD2	12mm THK. LOW-IRON SPANDREL U.S. GLASS & 2mm THK. ALUM. BACKPAN (WHITE COLOR)
GLD3	12mm THK. GREY BLUE LOW-IRON SPANDREL U.S. GLASS & 2mm THK. ALUM. BACKPAN (DARK GREY COLOR)
GLD4	12mm THK. GREY BLUE LOW-IRON SPANDREL U.S. GLASS & 2mm THK. ALUM. BACKPAN (DARK GREY COLOR)

17/F	18/F
CLIMATE WALL (W/LOW/ TRANSPARENT): WHITE	DARK GREY
CURTAIN WALL (W/LOW/ TRANSPARENT): WHITE	DARK GREY
CLIMATE WALL (W/LOW/ TRANSPARENT): WHITE	BLACK
CLIMATE WALL (W/LOW/ TRANSPARENT): WHITE	DARK GREY
CLIMATE WALL (W/LOW/ TRANSPARENT): WHITE	DARK GREY
CLIMATE WALL (W/LOW/ TRANSPARENT): WHITE	DARK GREY
CLIMATE WALL (W/LOW/ TRANSPARENT): WHITE	DARK GREY
CLIMATE WALL (W/LOW/ TRANSPARENT): WHITE	SMOKE BROWN
CLIMATE WALL (W/LOW/ TRANSPARENT): WHITE	DARK GREY

