



工程指示 / 要求簡箋(E.I.)

工程指示編號：EI/2462

修改版次：13

工程編號：J851

工程名稱：青衣 明翹匯

工程項目：後裝門窗事宜

收件人：生統

發件人：Leung Hin Wai

日期：28/9-2020

要求提供 /  確認 事項：

- |                                    |                                     |                               |
|------------------------------------|-------------------------------------|-------------------------------|
| <input type="checkbox"/> 初步鋁料 B.M. | <input type="checkbox"/> 加工拆圖，然後生產  | <input type="checkbox"/> 尺寸表  |
| <input type="checkbox"/> 正式鋁料 B.M. | <input type="checkbox"/> 技術上資料 / 指示 | <input type="checkbox"/> 報價   |
| <input type="checkbox"/> 配件 B.M.   | <input type="checkbox"/> 樣辦或貨品說明書   | <input type="checkbox"/> 分判合約 |
| <input type="checkbox"/> 其他：_____  |                                     |                               |

內容：提供開土機和垃圾槽的平面位置圖

請在\_\_\_\_\_前完成上列要求。

附： -

以上項目為：

原合約工程包

原合約工程加 / 減賬

新工程報價

原因： -

分發東莞各部門：

- ( ) 生產技術總監  連附件 ( ) 技術部  連附件 ( ) 生產部  連附件 ( ) 機械設計部  連附件  
 ( ) 採購部  連附件 ( ) 生產統籌部  連附件  
 ( ) 質檢部  連附件 ( ) 會計部  連附件 ( ) 報關組  連附件 ( ) 其他 \_\_\_\_\_  連附件

分發香港各部門：

- ( ) 行政部  連附件 ( ) 會計部  連附件 ( ) 統籌部  連附件 ( ) 工程部地盤科文  連附件  
 ( ) 採購部  連附件 ( ) QS 部  連附件 ( ) 維修部  連附件 ( ) 其他 \_\_\_\_\_  連附件

傳遞編號：

H7K 2225

發件人簽署：

項目經理簽署：



B.D. REF :

F.S.D. REF :

Note :

- 1. All dimensions are in mm.
- 2. All elevations are viewed from outside.
- 3. All dimensions to be verified on site before fabrication.

GENERAL NOTES

Legend :

- 1. F.F.L. --- Finished Floor Level
- 2. S.F.L. --- Structural Floor Level
- 3. (R) --- Reversed Detail

X1 --- DETAIL MARK NO.  
 X001 --- REFER SHEET NO.

--- FACADE MARK

NO.	DATE	BY	REVISION
F	01.08.2020		GENERAL REVISION
E	13.07.2020		GENERAL REVISION
D	04.05.2020		GENERAL REVISION
C	20.03.2020		GENERAL REVISION
B	05.03.2020		GENERAL REVISION
A	13.02.2020		GENERAL REVISION

CLIENT :  
**佳明集團控股有限公司**  
 GRAND MING GROUP HOLDINGS LIMITED

MAIN CONTRACTOR :  
**GRAND TECH CONSTRUCTION CO. LTD.**

ARCHITECT :  
**WONG TUNG & PARTNERS LIMITED**  
 ARCHITECTS & PLANNERS

STRUCTURAL ENGINEER :

**C M WONG & ASSOCIATES LTD**

**美特鋁質有限公司**  
 MIDI ALUMINIUM FABRICATOR LTD.  
 Units 6-8, Sunny Industrial Centre, 1/F  
 610 Che Kwo Ling Road, Kowloon  
 Tel: 23489211-4 Fax: (852) 27275666

PROJECT :  
 RESIDENTIAL DEVELOPMENT AT  
 TSING YI TOWN LOT 190 SAI SHAN ROAD


TITLE :  
 WINDOW LOCATION PLAN  
 OF TOWER 2 / TOWER 2A (2/F-31/F)

JOB NO. : J-851

DRAWN BY : DATE : 2-12-2019

CHKD BY : SCALE : A3:1:200

DWG. NO. : JB51-NW-202 REV. : F

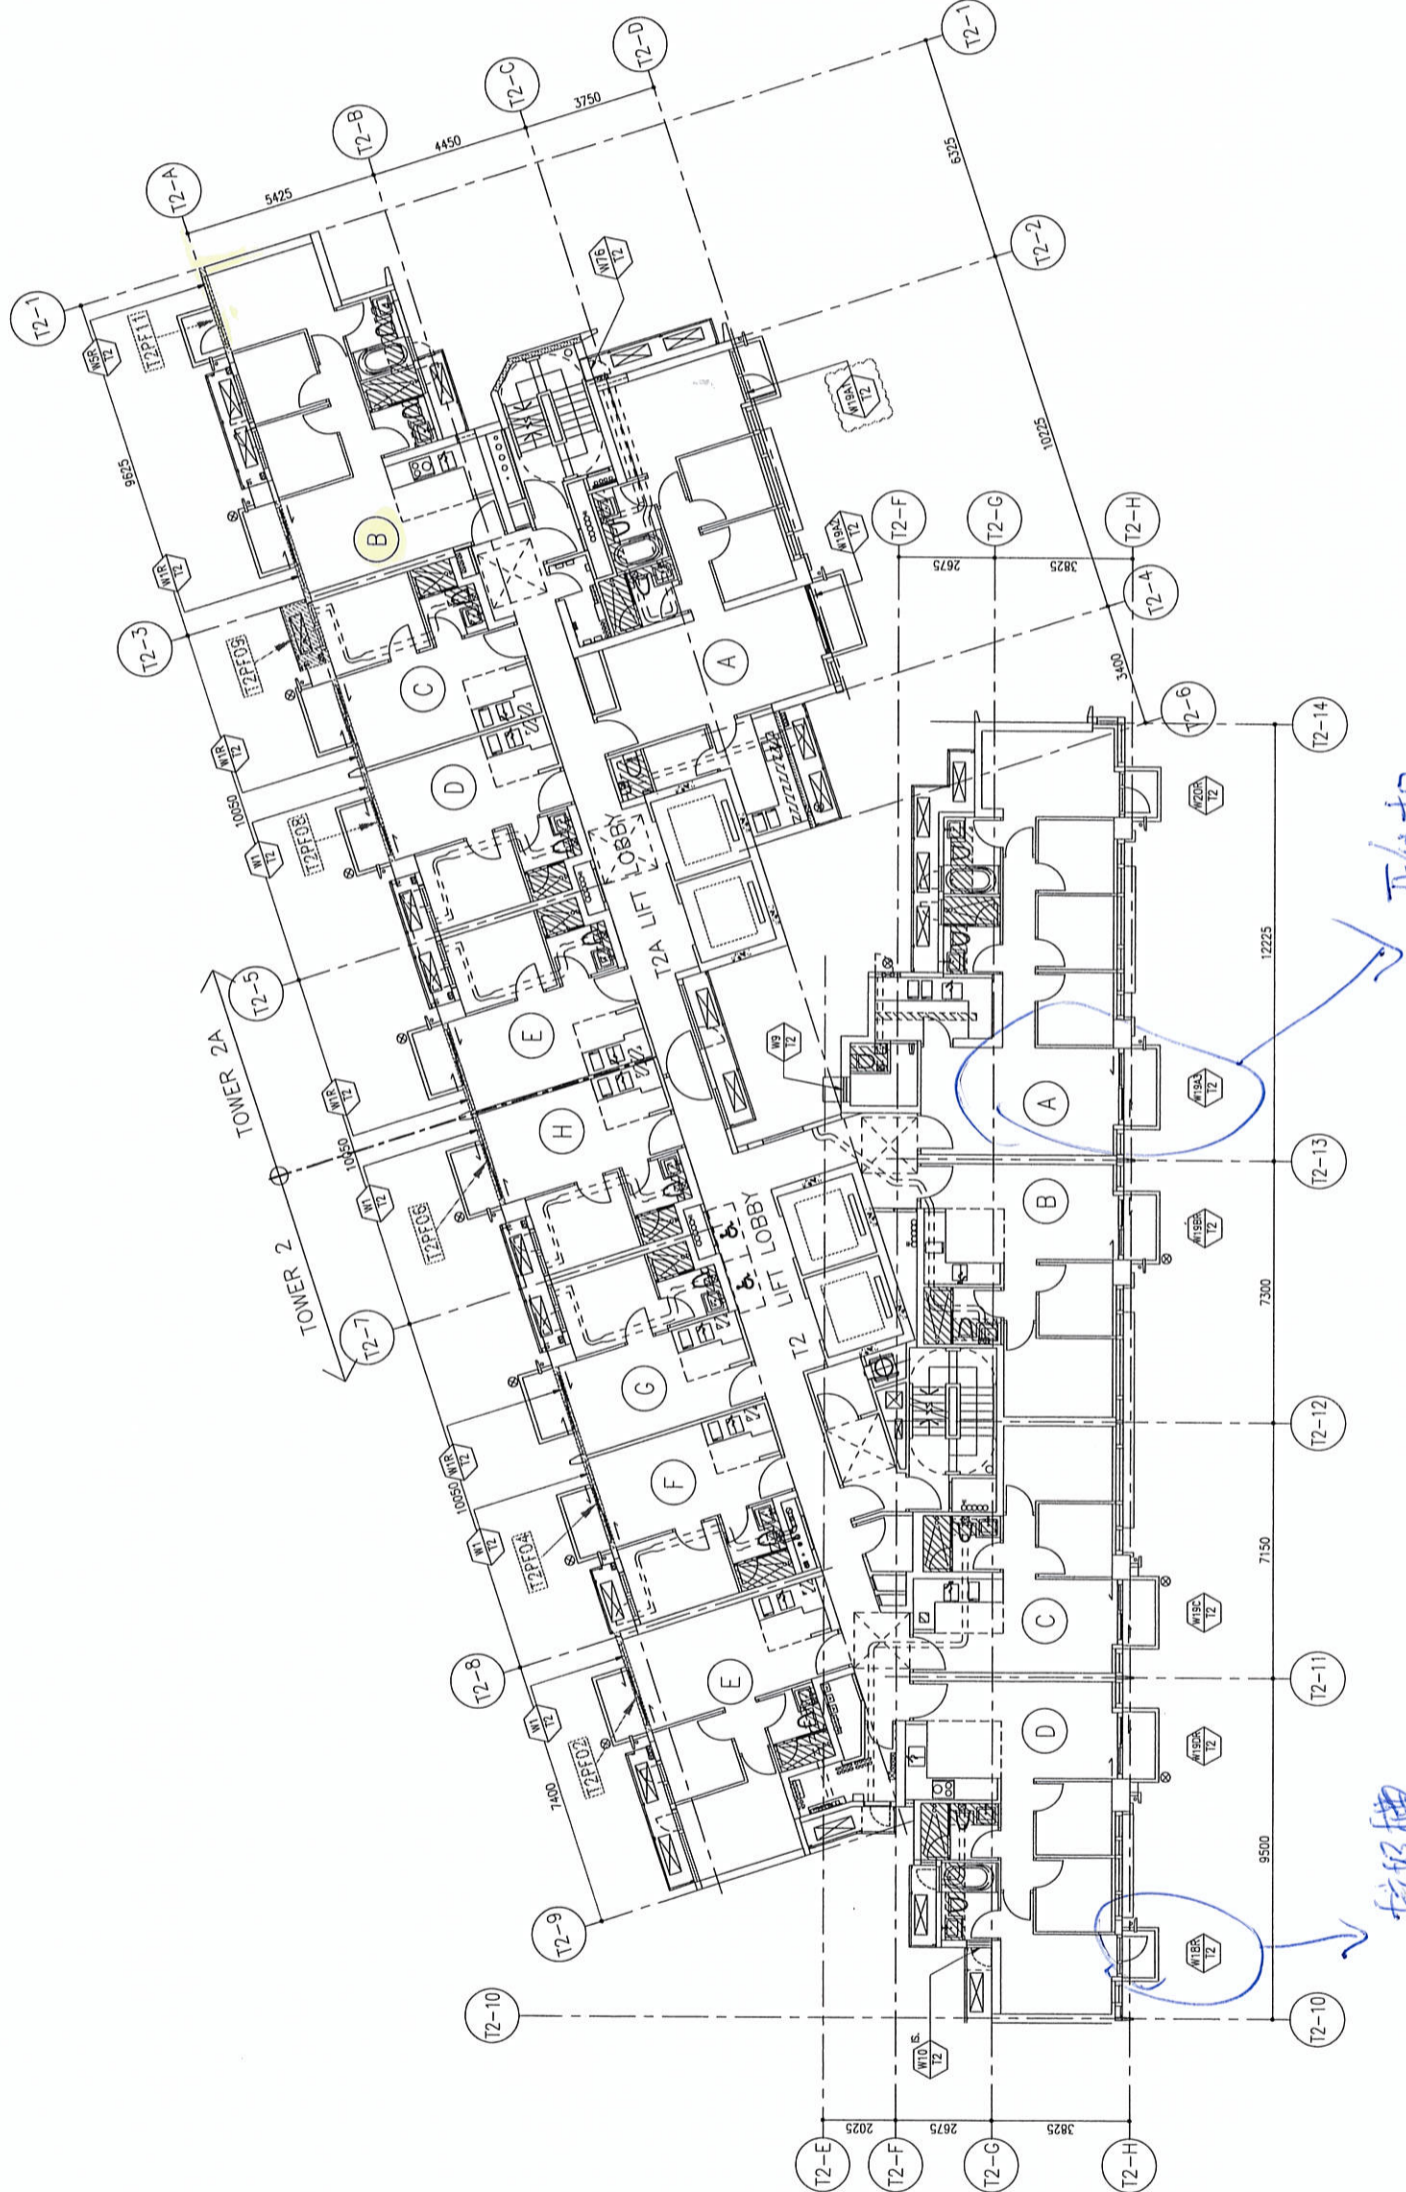

T2/T2A 2/F-31/F PLAN