



工程指示 / 要求簡箋(E.I.)

工程指示編號：EI/2585

修改版次：-

工程編號：J851

工程名稱：青衣 明翹匯

工程項目：地盤用玻璃 BM (預制窗大貨)

收件人：羅小姐

發件人：Leung Hin Wai

日期：16/10/2020

要求提供 / 確認 事項：

- | | | |
|------------------------------------|-------------------------------------|-------------------------------|
| <input type="checkbox"/> 初步鋁料 B.M. | <input type="checkbox"/> 加工拆圖，然後生產 | <input type="checkbox"/> 尺寸表 |
| <input type="checkbox"/> 正式鋁料 B.M. | <input type="checkbox"/> 技術上資料 / 指示 | <input type="checkbox"/> 報價 |
| <input type="checkbox"/> 配件 B.M. | <input type="checkbox"/> 樣辦或貨品說明書 | <input type="checkbox"/> 分判合約 |
| <input type="checkbox"/> 其他：_____ | | |

內容：

此玻璃 BM 和加工圖不要加工，只作備料用。

請在_____前完成上列要求。

附：1+9頁

以上項目為：

- 原合約工程包 原合約工程加 / 減賬 新工程報價

原因：-

分發東莞各部門：

- ()生產技術總監 連附件 ()技術部 連附件 ()生產部 連附件 ()機械設計部 連附件
 ()採購部 連附件 ()生產統籌部 連附件
 ()質檢部 連附件 ()會計部 連附件 ()報關組 連附件 ()其他 _____ 連附件

分發香港各部門：

- ()行政部 連附件 ()會計部 連附件 ()統籌部 連附件 ()工程部地盤科文(積) 連附件
 ()採購部 連附件 ()QS 部 連附件 ()維修部 連附件 ()其他 _____ 連附件

傳遞編號：

發件人簽署：

項目經理簽署：

廠用玻璃B.M.表

項目類別: 幕牆玻璃

批准:

A/C Code:

BM編號:	玻璃編號	玻璃类型	窗号	幅数	總計玻璃面積 (平方			單面积 (m2)	總数量	總面积 (m2)	备注
					玻璃尺寸						
					W (mm)	H (mm)	x				
1	GL02-01	GL02	T1-W3	27	327	1721	x	0.56	27	15.195	送地盘
2	GL02-01	GL02	T1-W33	2	327	1721	x	0.56	2	1.126	送地盘
3	GL02-01	GL02	T2-W3R	27	327	1721	x	0.56	27	15.195	送地盘
4	GL02-01	GL02	T2-W33R	2	327	1721	x	0.56	2	1.126	送地盘
5	GL02-02	GL02	T1-W7	27	427	1721	x	0.73	27	19.841	送地盘
6	GL02-02	GL02	T1-W37	2	427	1721	x	0.73	2	1.470	送地盘
7	GL02-02	GL02	T2-W7R	27	427	1721	x	0.73	27	19.841	送地盘
8	GL02-02	GL02	T2-W37R	2	427	1721	x	0.73	2	1.470	送地盘
9	GL02-03	GL02	T1-W2	84	517	1631	x	0.84	84	70.831	送地盘
10	GL02-03	GL02	T1-W2R	84	517	1631	x	0.84	84	70.831	送地盘
11	GL02-03	GL02	T2-W2	56	517	1631	x	0.84	56	47.221	送地盘
12	GL02-03	GL02	T2-W2R	84	517	1631	x	0.84	84	70.831	送地盘
13	GL02-04	GL02	T1-W32	3	517	1646	x	0.85	3	2.553	送地盘
14	GL02-04	GL02	T1-W32R	3	517	1646	x	0.85	3	2.553	送地盘
15	GL02-04	GL02	T2-W32	2	517	1646	x	0.85	2	1.702	送地盘
16	GL02-04	GL02	T2-W32R	3	517	1646	x	0.85	3	2.553	送地盘
17	GL02-05	GL02	T2-W23	28	546	1631	x	0.89	28	24.935	送地盘
18	GL02-06	GL02	T2-W53	1	546	1646	x	0.90	1	0.899	送地盘
19	GL02-07	GL02	T2-W23	28	547	1631	x	0.89	28	24.980	送地盘
20	GL02-08	GL02	T2-W53	1	547	1646	x	0.90	1	0.900	送地盘

廠用玻璃B.M.表

項目類別: 幕牆玻璃

批准:

日期:

A/C Code:

BM編號:	玻璃編號	玻璃类型	窗号	幅数	總計玻璃面積 (平方			單面积 (m ²)	總数量	總面积 (m ²)	備注
					W (mm)	玻璃尺寸					
						x	H (mm)				
21	GL02-09	GL02	T1-W13	27	551	x	1136	0.63	27	16.900	送地盘
22	GL02-09	GL02	T1-W43	1	551	x	1136	0.63	1	0.626	送地盘
23	GL02-10	GL02	T1-W4	27	552	x	1721	0.95	27	25.650	送地盘
24	GL02-10	GL02	T1-W34	2	552	x	1721	0.95	2	1.900	送地盘
25	GL02-10	GL02	T2-W4R	27	552	x	1721	0.95	27	25.650	送地盘
26	GL02-10	GL02	T2-W34R	2	552	x	1721	0.95	2	1.900	送地盘
27	GL02-11	GL02	T1-W2	84	556	x	1631	0.91	84	76.174	送地盘
28	GL02-11	GL02	T1-W2R	84	556	x	1631	0.91	84	76.174	送地盘
29	GL02-11	GL02	T2-W2	56	556	x	1631	0.91	56	50.783	送地盘
30	GL02-11	GL02	T2-W2R	84	556	x	1631	0.91	84	76.174	送地盘
31	GL02-12	GL02	T1-W14	26	556	x	1531	0.85	26	22.132	送地盘
32	GL02-13	GL02	T1-W3	27	556	x	1721	0.96	27	25.836	送地盘
33	GL02-13	GL02	T1-W4	27	556	x	1721	0.96	27	25.836	送地盘
34	GL02-13	GL02	T1-W6	27	556	x	1721	0.96	27	25.836	送地盘
35	GL02-13	GL02	T1-W7	27	556	x	1721	0.96	27	25.836	送地盘
36	GL02-13	GL02	T1-W33	2	556	x	1721	0.96	2	1.914	送地盘
37	GL02-13	GL02	T1-W34	2	556	x	1721	0.96	2	1.914	送地盘
38	GL02-13	GL02	T1-W36	2	556	x	1721	0.96	2	1.914	送地盘
39	GL02-13	GL02	T1-W37	2	556	x	1721	0.96	2	1.914	送地盘
40	GL02-13	GL02	T2-W3R	27	556	x	1721	0.96	27	25.836	送地盘

廠用玻璃B.M.表

項目類別:
幕牆玻璃

批准:

A/C Code:

BM編號:

修改版次:

總計玻璃面積 (平方

備注

序号	玻璃编号	玻璃类型	窗号	幅数	玻璃尺寸		单面积 (m ²)	总数量	总面积 (m ²)	备注
					W (mm)	H (mm)				
41	GL02-13	GL02	T2-W4R	27	556	1721	0.96	27	25.836	送地盘
42	GL02-13	GL02	T2-W6R	27	556	1721	0.96	27	25.836	送地盘
43	GL02-13	GL02	T2-W7R	27	556	1721	0.96	27	25.836	送地盘
44	GL02-13	GL02	T2-W33R	2	556	1721	0.96	2	1.914	送地盘
45	GL02-13	GL02	T2-W34R	2	556	1721	0.96	2	1.914	送地盘
46	GL02-13	GL02	T2-W36R	2	556	1721	0.96	2	1.914	送地盘
47	GL02-13	GL02	T2-W37R	2	556	1721	0.96	2	1.914	送地盘
48	GL02-14	GL02	T1-W32	3	556	1646	0.92	3	2.746	送地盘
49	GL02-14	GL02	T1-W32R	3	556	1646	0.92	3	2.746	送地盘
50	GL02-14	GL02	T2-W32	2	556	1646	0.92	2	1.830	送地盘
51	GL02-14	GL02	T2-W32R	3	556	1646	0.92	3	2.746	送地盘
52	GL02-15	GL02	T1-W44	1	556	1546	0.86	1	0.860	送地盘
53	GL02-16	GL02	T1-W14	26	562	1531	0.86	26	22.371	送地盘
54	GL02-17	GL02	T1-W44	1	562	1546	0.87	1	0.869	送地盘
55	GL02-18	GL02	T2-W13	53	576	1136	0.65	53	34.680	送地盘
56	GL02-18	GL02	T2-W43	2	576	1136	0.65	2	1.309	送地盘
57	GL02-19	GL02	T1-W6	27	1287	1721	2.21	27	59.803	送地盘
58	GL02-19	GL02	T1-W36	2	1287	1721	2.21	2	4.430	送地盘
59	GL02-19	GL02	T2-W6R	27	1287	1721	2.21	27	59.803	送地盘
60	GL02-19	GL02	T2-W36R	2	1287	1721	2.21	2	4.430	送地盘

廠用玻璃B.M.表

項目類別: 幕牆玻璃

批准:


總計玻璃面積 (平方

備注

BM編號:	玻璃編號	玻璃类型	窗号	幅数	玻璃尺寸			單面积 (m ²)	總数量	總面积 (m ²)	备注
					W (mm)	x	H (mm)				
61	GL02-20	GL02	T1-W72	1	1859	x	1876	3.49	1	3.487	送地盘
62	GL02-21	GL02	T1-W72	1	556	x	1876	1.04	2	2.086	送地盘
63	GL06-01	GL06	T1-W11	27	303	x	1086	0.33	27	8.885	送地盘
64	GL06-01	GL06	T1-W41	1	303	x	1086	0.33	1	0.329	送地盘
65	GL06-01	GL06	T2-W11	27	303	x	1086	0.33	27	8.885	送地盘
66	GL06-01	GL06	T2-W41	1	303	x	1086	0.33	1	0.329	送地盘
67	GL06-02	GL06	T1-W66	1	376	x	1086	0.41	1	0.408	送地盘
68	GL06-02	GL06	T1-W64	1	376	x	1086	0.41	1	0.408	送地盘
69	GL06-02	GL06	T2-W38	1	376	x	1086	0.41	1	0.408	送地盘
70	GL06-02	GL06	T2-W64	1	376	x	1086	0.41	1	0.408	送地盘
71	GL06-03	GL06	T1-W60	2	376	x	1036	0.39	2	0.779	送地盘
72	GL06-03	GL06	T1-W60AR	1	376	x	1036	0.39	1	0.390	送地盘
73	GL06-04	GL06	T1-W8	54	426	x	1086	0.46	54	24.982	送地盘
74	GL06-04	GL06	T1-W38	4	426	x	1086	0.46	4	1.851	送地盘
75	GL06-05	GL06	T1-W38A	1	426	x	1036	0.44	1	0.441	送地盘
76	GL06-06	GL06	T1-W47	1	526	x	1676	0.88	1	0.882	送地盘
77	GL06-07	GL06	T1-W10A	26	576	x	1086	0.63	26	16.264	送地盘
78	GL06-07	GL06	T1-W40A	1	576	x	1086	0.63	1	0.626	送地盘
79	GL06-07	GL06	T2-W10	27	576	x	1086	0.63	27	16.889	送地盘

廠用玻璃B.M.表

BM編號:		工程號:	J851	計算:	SAM	日期:	30/6/2020	送呈:	施哥
		地盤名稱:	TYTL190	核對:	XYB	日期:	30/6/2020	副本:	
		項目類別:	幕牆玻璃	批准:		日期:		A/C Code:	
		修改版次:		總計玻璃面積 (平方		備注			
序號	玻璃編號	玻璃類型	窗號	玻璃尺寸		單面積 (m ²)	總數量	總面積 (m ²)	備注
				W (mm)	H (mm)				
80	GL06-07	GL06	T2-W22	27		0.63	27	16.889	送地盤
81	GL06-07	GL06	T2-W40	1		0.63	1	0.626	送地盤
82	GL06-07	GL06	T2-W52	2		0.63	2	1.251	送地盤
83	GL06-07	GL06	T2-W63	1		0.63	1	0.626	送地盤
84	GL06-07	GL06	T2-W10R	53		0.63	53	33.153	送地盤
85	GL06-07	GL06	T2-W22R	27		0.63	27	16.889	送地盤
86	GL06-07	GL06	T2-W40R	2		0.63	2	1.251	送地盤
87	GL06-07	GL06	T2-W52R	2		0.63	2	1.251	送地盤
88	GL06-08	GL06	T1-W10	27		0.60	27	16.112	送地盤
89	GL06-08	GL06	T1-W40	1		0.60	1	0.597	送地盤
90	GL06-09	GL06	T2-W73	1		0.85	2	1.700	送地盤
91	GL07-01	GL07	T2-W23	28		0.25	28	6.880	送地盤
92	GL07-01	GL07	T2-W53	1		0.25	1	0.246	送地盤
93	GL07-02	GL07	T1-W2	84		0.25	84	20.966	送地盤
94	GL07-02	GL07	T1-W3	27		0.25	27	6.739	送地盤
95	GL07-02	GL07	T1-W4	27		0.25	27	6.739	送地盤
96	GL07-02	GL07	T1-W6	27		0.25	27	6.739	送地盤
97	GL07-02	GL07	T1-W7	27		0.25	27	6.739	送地盤
98	GL07-02	GL07	T1-W14	26		0.25	26	6.490	送地盤

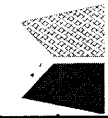

美特鋁質有限公司
MIDI Aluminium Fabricator Ltd.

工程號:

J851

計算:

SAM

日期:

30/6/2020

送呈:

施哥

地盤名稱:

TYTL190

核對:

XYB

日期:

30/6/2020

副本:

廠用玻璃B.M.表

項目類別:

批准:

幕牆玻璃

日期:

A/C Code:


BM編號:

修改版次:

總計玻璃面積 (平方

備注

序号	玻璃编号	玻璃类型	窗号	幅数	玻璃尺寸		单面积 (m ²)	总数量	总面积 (m ²)	备注
					W (mm)	H (mm)				
					x	x				
99	GL07-02	GL07	T1-W32	3	640	390	0.25	3	0.749	送地盘
100	GL07-02	GL07	T1-W33	2	640	390	0.25	2	0.499	送地盘
101	GL07-02	GL07	T1-W34	2	640	390	0.25	2	0.499	送地盘
102	GL07-02	GL07	T1-W36	2	640	390	0.25	2	0.499	送地盘
103	GL07-02	GL07	T1-W37	2	640	390	0.25	2	0.499	送地盘
104	GL07-02	GL07	T1-W44	1	640	390	0.25	1	0.250	送地盘
105	GL07-02	GL07	T1-W2R	84	640	390	0.25	84	20.966	送地盘
106	GL07-02	GL07	T1-W32R	3	640	390	0.25	3	0.749	送地盘
107	GL07-02	GL07	T2-W2	56	640	390	0.25	56	13.978	送地盘
108	GL07-02	GL07	T2-W3R	27	640	390	0.25	27	6.739	送地盘
109	GL07-02	GL07	T2-W4R	27	640	390	0.25	27	6.739	送地盘
110	GL07-02	GL07	T2-W6R	27	640	390	0.25	27	6.739	送地盘
111	GL07-02	GL07	T2-W7R	27	640	390	0.25	27	6.739	送地盘
112	GL07-02	GL07	T2-W32	2	640	390	0.25	2	0.499	送地盘
113	GL07-02	GL07	T2-W33R	2	640	390	0.25	2	0.499	送地盘
114	GL07-02	GL07	T2-W34R	2	640	390	0.25	2	0.499	送地盘
115	GL07-02	GL07	T2-W36R	2	640	390	0.25	2	0.499	送地盘
116	GL07-02	GL07	T2-W37R	2	640	390	0.25	2	0.499	送地盘
117	GL07-02	GL07	T2-W2R	84	640	390	0.25	84	20.966	送地盘
118	GL07-02	GL07	T2-W32R	3	640	390	0.25	3	0.749	送地盘

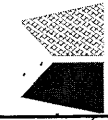

美特鋁質有限公司
MIDI Aluminium Fabricator Ltd.

工程號:

J851

計算:

SAM

日期:

30/6/2020

送呈:

施哥

地盤名稱: TYTL190

核對:

XYB

日期:

30/6/2020

副本:

廠用玻璃B.M.表

項目類別: 幕牆玻璃

批准:

日期:

A/C Code:

BM編號:

修改版次:

總計玻璃面積 (平方

米)

備注

序号	玻璃编号	玻璃类型	窗号	幅数	玻璃尺寸		单面积 (m ²)	总数量	總面积 (m ²)	备注
					W (mm)	H (mm)				
119	GL07-03	GL07	T1-W72	1	640	480	0.31	2	0.614	送地盘
120	GL07-04	GL07	T2-W73	1	536	480	0.26	1	0.257	送地盘
121	GL08-01	GL08	T1-W16	54	461	952	0.44	108	47.373	送地盘
122	GL08-01	GL08	T2-W16	54	461	952	0.44	108	47.373	送地盘
123	GL08-02	GL08	T1-W16	54	461	753	0.35	108	37.465	送地盘
124	GL08-02	GL08	T1-W46	4	461	753	0.35	8	2.775	送地盘
125	GL08-02	GL08	T2-W16	54	461	753	0.35	108	37.465	送地盘
126	GL08-02	GL08	T2-W46	4	461	753	0.35	8	2.775	送地盘
127	GL08-03	GL08	T1-W46	4	461	1302	0.60	8	4.800	送地盘
128	GL08-03	GL08	T2-W46	4	461	1302	0.60	8	4.800	送地盘
129	GL08-04	GL08	T1-W15	26	493	952	0.47	78	36.589	送地盘
130	GL08-04	GL08	T2-W15	26	493	952	0.47	78	36.589	送地盘
131	GL08-05	GL08	T1-W15	26	493	753	0.37	78	28.937	送地盘
132	GL08-05	GL08	T1-W45	2	493	753	0.37	6	2.226	送地盘
133	GL08-05	GL08	T2-W15	26	493	753	0.37	78	28.937	送地盘
134	GL08-05	GL08	T2-W45	2	493	753	0.37	6	2.226	送地盘
135	GL08-06	GL08	T1-W45	2	493	1302	0.64	6	3.850	送地盘
136	GL08-06	GL08	T2-W45	2	493	1302	0.64	6	3.850	送地盘
137	GL08-07	GL08	T1-W17	27	526	1676	0.88	27	23.803	送地盘



美特鋁質 有限公司
MIDI Aluminium Fabricator Ltd.

工程號:

J851

計算:

SAM

日期:

30/6/2020

送呈:

施哥

地盤名稱: TYTL190

核對:

XYB

日期:

30/6/2020

副本:

廠用玻璃B.M.表

項目類別: 幕牆玻璃

批准:

日期:

A/C Code:

BM編號:

修改版次:

總計玻璃面積 (平方

備注

序号	玻璃编号	玻璃类型	窗号	幅数	玻璃尺寸		单面积 (m ²)	总数量	总面积 (m ²)	备注
					W (mm)	H (mm)				
138	GL08-08	GL08	T2-W72	27	x	1676	1.05	27	28.328	送地盘
139	GL08-08	GL08	T2-W74	2	x	1676	1.05	2	2.098	送地盘
							总数量	3088	1904.338	

1).本表中所有玻璃對角線尺寸偏差要求不超過正負2mm.

2).本表中所有玻璃要求4邊粗磨邊處理並倒棱角。(除了GL07玻璃要W方向上下精磨,請看附圖GL07)

3).本表中所有強化玻璃均需做HEAT SOAK TEST,但不需強化標誌.

5).所有成品玻璃均需注明其加工圖號,尺寸及其使用位置

6).所有成品玻璃均需做好室內外保護(透明靜電膠紙加四周PK白膠紙,離邊40mm)

7).所有玻璃之入爐方向以寬度方向進入。

8).所有玻璃成品到地盤時需齊款,齊層,齊數量,具體來貨詳情由地盤通知

9).所有玻璃成品到貨前需提前3天通知地盤并告知來貨詳情,以便申請入閘紙


注:

1	GL02	GL02:12mm THK. SSC1-60T TEMPERED GLASS							樣板編號	D20010211
2	GL06	GL06:12mm Grey Blue Tempered Glass w/ Frosted Texture At Inner Surface							樣板編號	D19120228
3	GL07	GL07:12mm THK. CLEAR TEMPERED GLASS							樣板編號	D19110488
4	GL08	GL08:12mm Clear Tempered Glass w/ Frosted Texture At Inner Surface							樣板編號	D20040330



美特鋁質有限公司
MIDI Aluminium Fabricator Ltd.


類別		物料號	
制圖	譚林輝	2020.04.30	圖號 GL07
修改日期		復核	謝永林 2020.05.04
		批准	Sze
		數量	見BOM表
		位置	

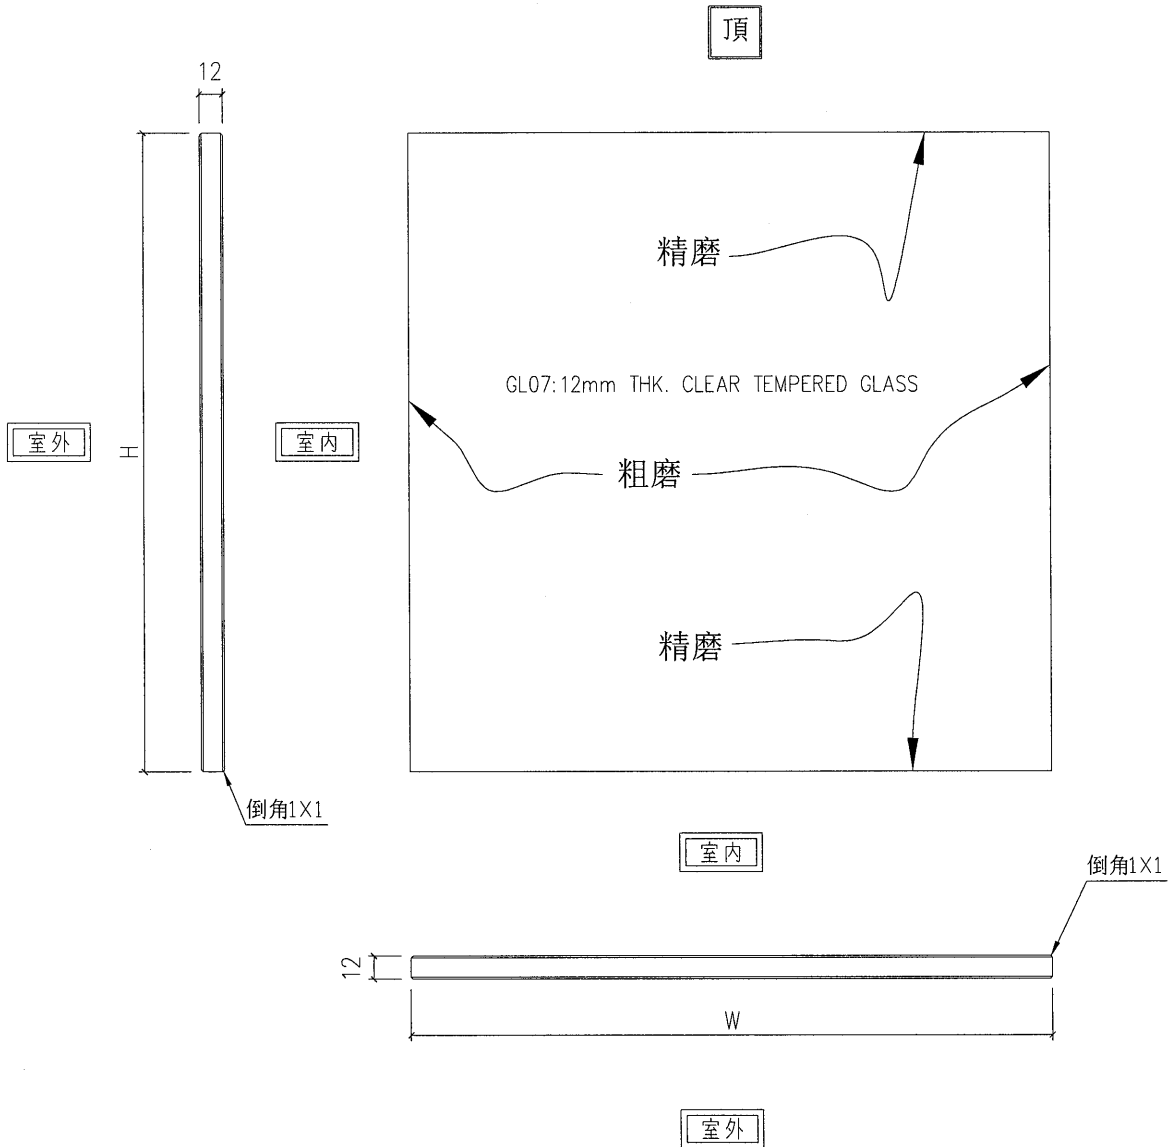


工程號	J-851	地盤	青衣翹匯
名稱	玻璃加工圖		採用
材料		地盤	
顏色		工廠	✓

附件	
----	--


FREE AREA(%)	OPENABLE AREA	GLAZING AREA
57%	0.72	1.31

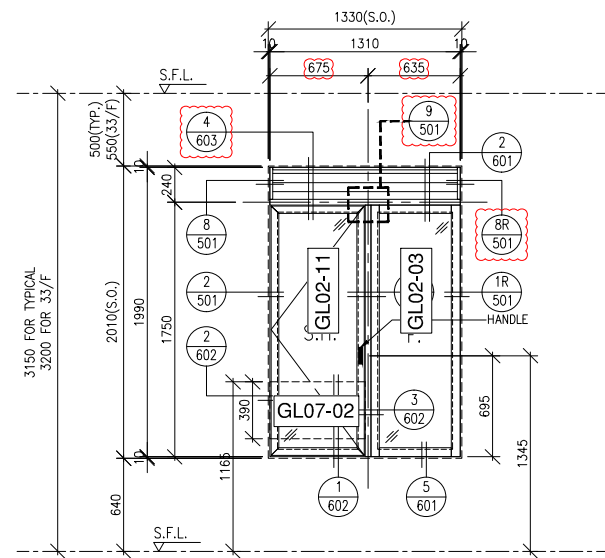

OPENABLE AREA	GLAZING AREA
0.77	1.15

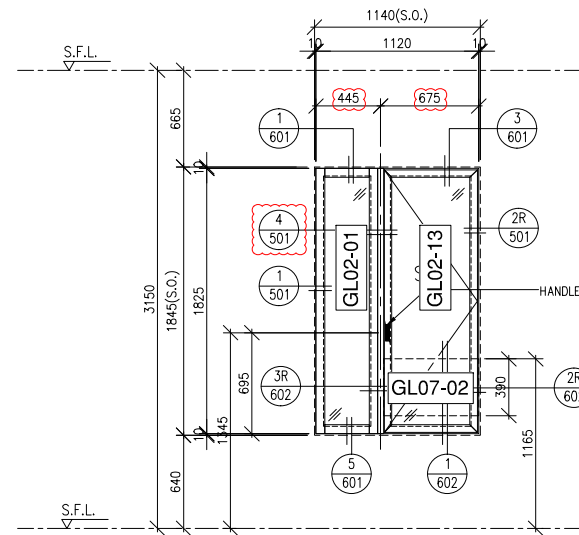

OPENABLE AREA	GLAZING AREA
0.77	1.45

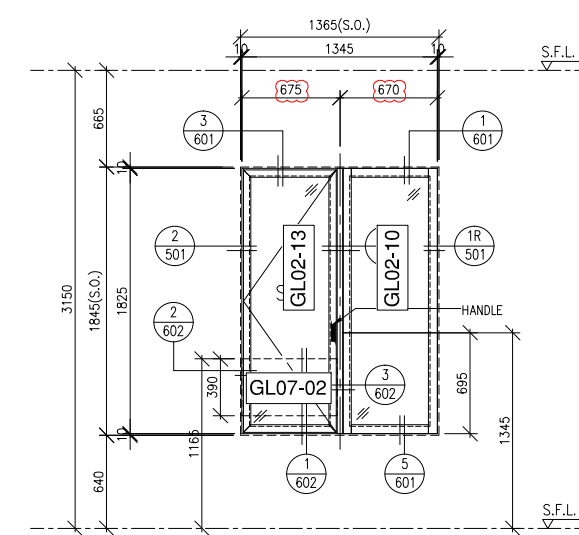


WINDOW MARK	W2 T1 84 nos.		
LOCATION	T1A FLAT E.G MBR. (1-31/F & 33/F ; 4,13,14,24/F OMITTED) T1 FLAT F MBR. (1-31/F & 33/F ; 4,13,14,24/F OMITTED)		
GLAZING	GL02	FRAME	AL11
REMARK	65mm ALUM. WINDOW SECTION		


WINDOW MARK	W3 T1 27 nos.		
LOCATION	T1A FLAT C BR3. (1-31/F; 4,13,14,24/F OMITTED)		
GLAZING	GL02	FRAME	AL11
REMARK	65mm ALUM. WINDOW SECTION		

WINDOW MARK	W4 T1 27 nos.		
LOCATION	T1A FLAT C BR2. (1-31/F; 4,13,14,24/F OMITTED)		
GLAZING	GL02	FRAME	AL11
REMARK	65mm ALUM. WINDOW SECTION		


OPENABLE AREA	GLAZING AREA
0.77	2.45

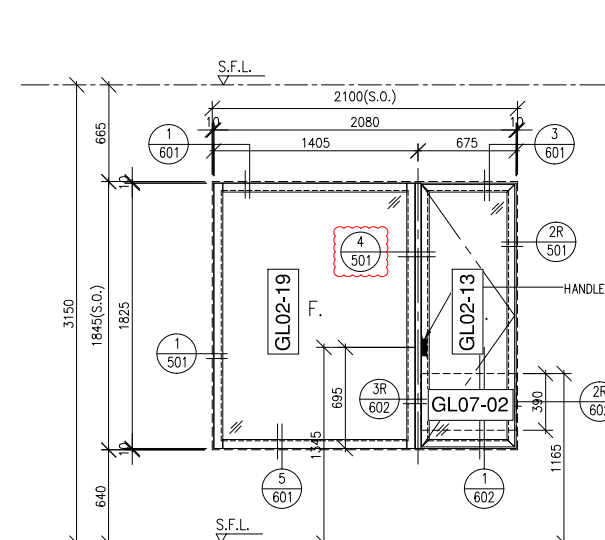

OPENABLE AREA	GLAZING AREA
0.77	1.28

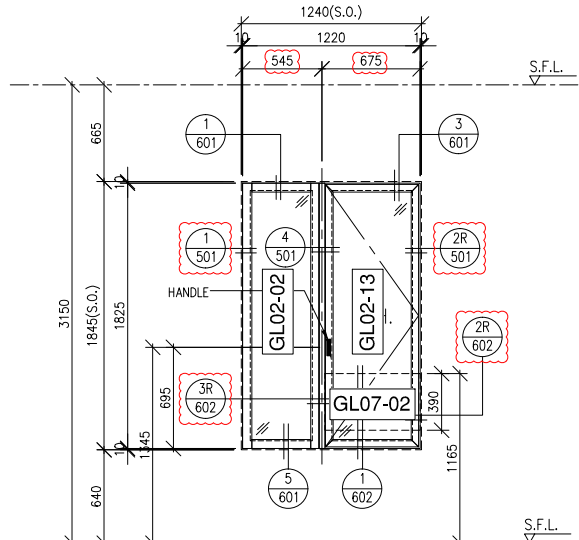

OPENABLE AREA	GLAZING AREA
0.52	0.43

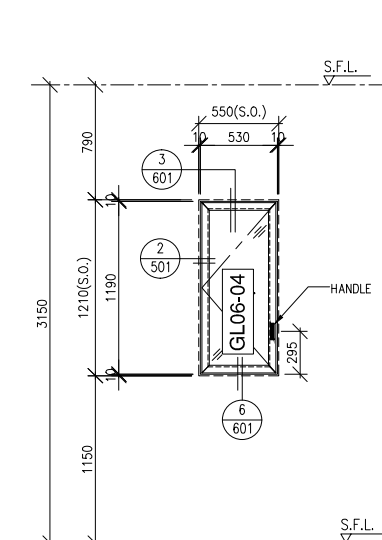

WINDOW MARK	W6 T1 27 nos.		
LOCATION	T1 FLAT E MBR. (1-31/F; 4,13,14,24/F OMITTED)		
GLAZING	GL02	FRAME	AL11
REMARK	65mm ALUM. WINDOW SECTION		

WINDOW MARK	W7 T1 27 nos.		
LOCATION	T1 FLAT E BR2. (1-31/F; 4,13,14,24/F OMITTED)		
GLAZING	GL02	FRAME	AL11
REMARK	65mm ALUM. WINDOW SECTION		

WINDOW MARK	W8 T1 54 nos.		
LOCATION	T1A FLAT C M.BATH. (1-31/F; 4,13,14,24/F OMITTED) T1A FLAT C BATH1. (1-31/F; 4,13,14,24/F OMITTED)		
GLAZING	GL06	FRAME	AL11
REMARK	65mm ALUM. WINDOW SECTION		

B.D. REF :
F.S.D. REF :

Note :
1.All dimensions are in mm.
2.All elevations are viewed from outside.
3.All dimensions to be verified on site before fabrication.

GENERAL NOTES

Legend :
1. F.F.L.-- Finished Floor Level
2. S.F.L.-- Structural Floor Level
3. (R) -- Reversed Detail

X1 -- DETAIL MARK NO.
X001 -- REFER SHEET NO.

B	28.02.2020	GENERAL REVISION	
A	06.02.2020	GENERAL REVISION	
NO.	DATE	REVISED	BY

CLIENT :
佳明集團控股有限公司
GRAND MING GROUP HOLDINGS LIMITED

MAIN CONTRACTOR :
GRAND TECH CONSTRUCTION CO.LTD.

ARCHITECT :
WONG TUNG & PARTNERS LIMITED
ARCHITECTS & PLANNERS

STRUCTURAL ENGINEER :
C M WONG & ASSOCIATES LTD

美特鋁質有限公司
MIDI ALUMINIUM FABRICATOR LTD.
Units 6-8, Sunray Industrial Centre, 1/F
610 Cha Kwo Ling Road, Kowloon
Tel:23489211-4 Fax:(852)27727666

PROJECT :
RESIDENTIAL DEVELOPMENT AT
TSING YI TOWN LOT 190 SAI SHAN ROAD

TITLE :
WINDOW SCHEDULE
FOR PRECAST FACADE
OF T1/T1A (1 OF 6)


JOB NO. : J-851

DRAWN BY : C.H.P. DATE : 30-11-2019


CHKD BY : SCALE A1: A3: 1:30

DWG. NO. : J851-SCH-101 REV. : B


FREE AREA(%)	OPENABLE AREA	GLAZING AREA
57%	0.66	0.56

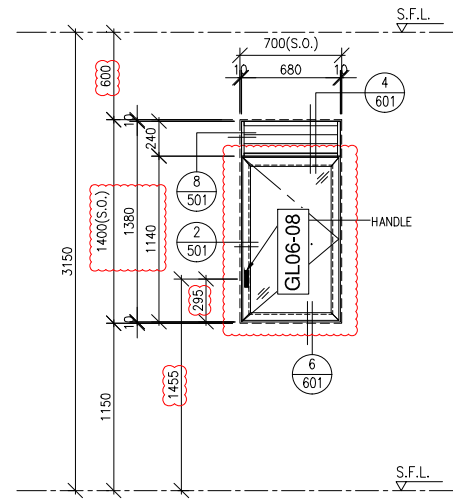

GLAZING AREA
0.30

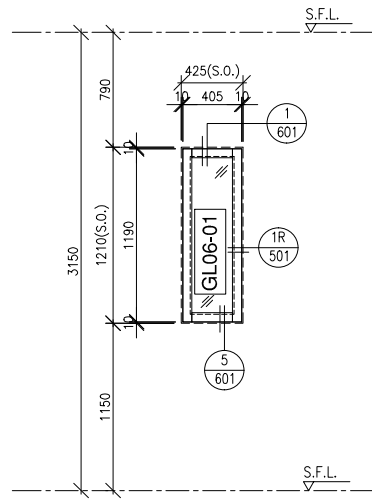

FREE AREA(%)	OPENABLE AREA	GLAZING AREA
57%	0.70	0.59

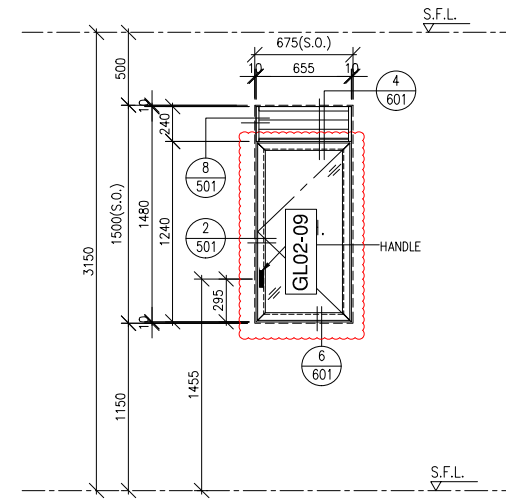

B.D. REF :
F.S.D. REF :
Note :
1.All dimensions are in mm.
2.All elevations are viewed from outside.
3.All dimensions to be verified on site before fabrication.

GENERAL NOTES
Legend :
1. F.F.L.-- Finished Floor Level
2. S.F.L.-- Structural Floor Level
3. (R) -- Reversed Detail
X1 -- DETAIL MARK NO.
X001 -- REFER SHEET NO.


WINDOW MARK	W10 T1 27 nos.		
LOCATION	T1 FLAT A M.BATH. (1-31/F; 4,13,14,24/F OMITTED)		
GLAZING	GL06	FRAME	AL11
REMARK	65mm ALUM. WINDOW SECTION		

WINDOW MARK	W11 T1 27 nos.		
LOCATION	T1 FLAT D BATH1. (1-31/F; 4,13,14,24/F OMITTED)		
GLAZING	GL06	FRAME	AL11
REMARK	65mm ALUM. WINDOW SECTION		


WINDOW MARK	W13 T1 27 nos.		
LOCATION	T1 FLAT A KIT. (1-31/F; 4,13,14,24/F OMITTED)		
GLAZING	GL02	FRAME	AL11
REMARK	65mm ALUM. WINDOW SECTION		

B	28.02.2020	GENERAL REVISION	
A	06.02.2020	GENERAL REVISION	
NO.	DATE	REVISED	BY


FREE AREA(%)	OPENABLE AREA	GLAZING AREA
57%	0.66	1.26

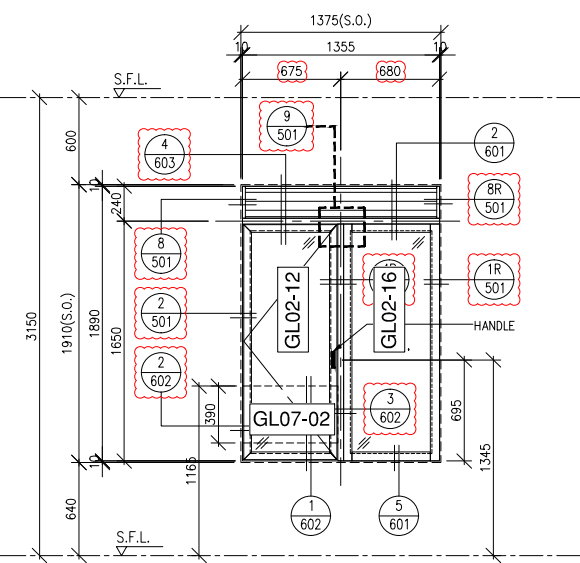

OPENABLE AREA	GLAZING AREA
1.57	1.37

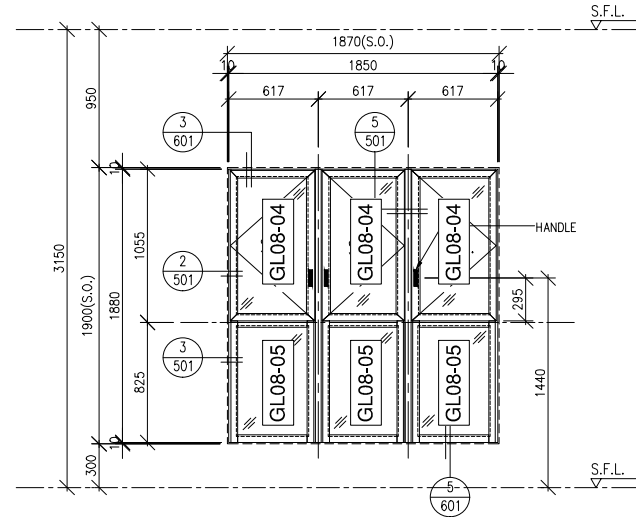

OPENABLE AREA	GLAZING AREA
1.00	0.86

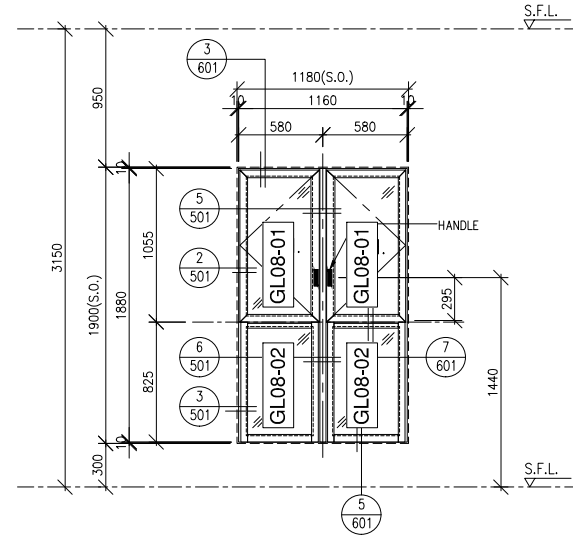

CLIENT :
佳明集團控股有限公司
GRAND MING GROUP HOLDINGS LIMITED
MAIN CONTRACTOR :
GRAND TECH CONSTRUCTION CO. LTD.
ARCHITECT :
WONG TUNG & PARTNERS LIMITED
ARCHITECTS & PLANNERS
STRUCTURAL ENGINEER :
C M WONG & ASSOCIATES LTD
美特鋁質有限公司
MIDI ALUMINIUM FABRICATOR LTD.
Units 6-8, Sunray Industrial Centre, 1/F
610 Cha Kwo Ling Road, Kowloon
Tel:23489211-4 Fax:(852)27727666
PROJECT :
RESIDENTIAL DEVELOPMENT AT
TSING YI TOWN LOT 190 SAI SHAN ROAD


WINDOW MARK	W14 T1 26 nos.		
LOCATION	T1 FLAT A STORE (2-31/F; 4,13,14,24/F OMITTED)		
GLAZING	GL02	FRAME	AL11
REMARK	65mm ALUM. WINDOW SECTION		

WINDOW MARK	W15 T1 26 nos.		
LOCATION	T1A LOBBY CORRIDOR (2-31/F; 4,13,14,24/F OMITTED)		
GLAZING	GL08	FRAME	AL11
REMARK	65mm ALUM. WINDOW SECTION		

WINDOW MARK	W16 T1 54 nos.		
LOCATION	T1 LOBBY CORRIDOR (1-31/F; 4,13,14,24/F OMITTED)		
GLAZING	GL08	FRAME	AL11
REMARK	65mm ALUM. WINDOW SECTION		

TITLE :	WINDOW SCHEDULE FOR PRECAST FACADE OF T1/T1A (2 OF 6)		
JOB NO. :	J-851		
DRAWN BY :	C.H.P.	DATE :	30-11-2019
CHKD BY :		SCALE :	A1: A3: 1:30
DWG. NO. :	J851-SCH-102	REV. :	B

OPENABLE AREA	GLAZING AREA
0.60	0.59

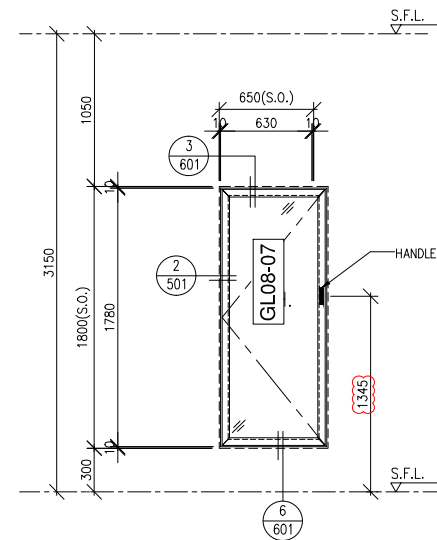

WINDOW MARK	W17 T1 27 nos.		
LOCATION	T1 LOBBY CORRIDOR (1-31/F; 4,13,14,24/F OMITTED)		
GLAZING	GL08	FRAME	AL11
REMARK	65mm ALUM. WINDOW SECTION		


FREE AREA(%)	OPENABLE AREA	GLAZING AREA
57%	0.73	1.33

WINDOW MARK	W17 T1 27 nos.		
LOCATION	T1 LOBBY CORRIDOR (1-31/F; 4,13,14,24/F OMITTED)		
GLAZING	GL08	FRAME	AL11
REMARK	65mm ALUM. WINDOW SECTION		


OPENABLE AREA	GLAZING AREA
0.77	1.15

WINDOW MARK	W17 T1 27 nos.		
LOCATION	T1 LOBBY CORRIDOR (1-31/F; 4,13,14,24/F OMITTED)		
GLAZING	GL08	FRAME	AL11
REMARK	65mm ALUM. WINDOW SECTION		


OPENABLE AREA	GLAZING AREA
0.77	1.45

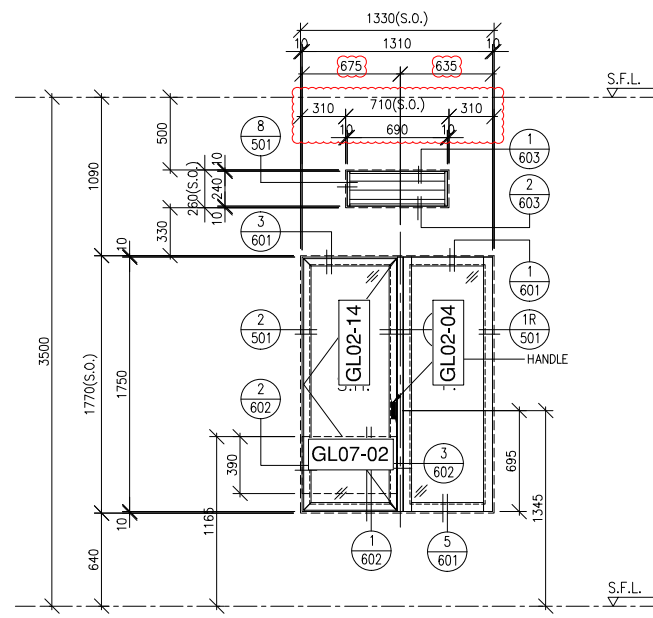

WINDOW MARK	W32 T1 3 nos.		
LOCATION	T1A FLAT E,G MBR.(32/F) T1 FLAT F MBR.(32/F)		
GLAZING	GL02	FRAME	AL11
REMARK	65mm ALUM. WINDOW SECTION		

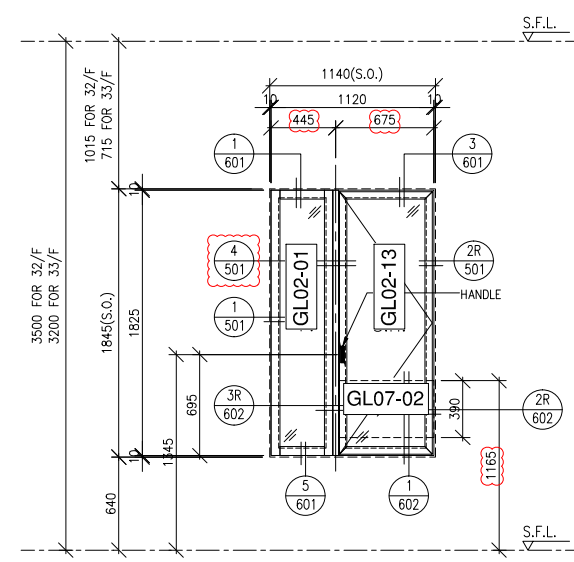

WINDOW MARK	W33 T1 2 nos.		
LOCATION	T1A FLAT C BR3. (32-33/F)		
GLAZING	GL02	FRAME	AL11
REMARK	65mm ALUM. WINDOW SECTION		

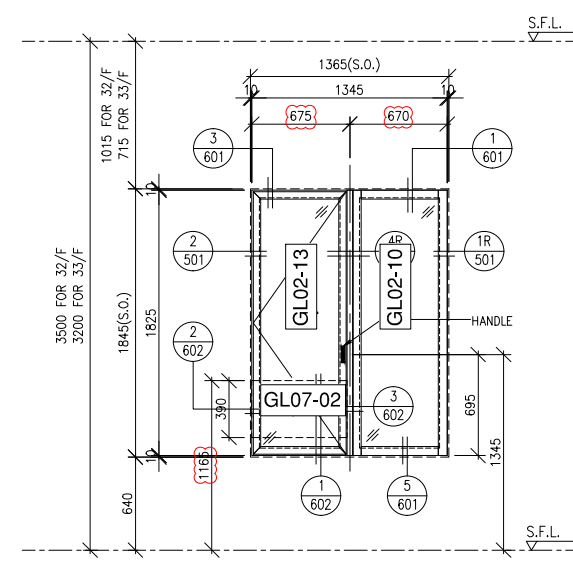

WINDOW MARK	W34 T1 2 nos.		
LOCATION	T1A FLAT C BR2. (32-33/F)		
GLAZING	GL02	FRAME	AL11
REMARK	65mm ALUM. WINDOW SECTION		

B.D. REF :
F.S.D. REF :
Note :
1.All dimensions are in mm.
2.All elevations are viewed from outside.
3.All dimensions to be verified on site before fabrication.

GENERAL NOTES
Legend :
1. F.F.L.-- Finished Floor Level
2. S.F.L.-- Structural Floor Level
3. (R) -- Reversed Detail
X1 -- DETAIL MARK NO.
X001 -- REFER SHEET NO.

B	28.02.2020	GENERAL REVISION	
A	06.02.2020	GENERAL REVISION	
NO.	DATE	REVISED	BY

CLIENT :
佳明集團控股有限公司
GRAND MING GROUP HOLDINGS LIMITED

MAIN CONTRACTOR :
GRAND TECH CONSTRUCTION CO.LTD.

ARCHITECT :
WONG TUNG & PARTNERS LIMITED
ARCHITECTS & PLANNERS

STRUCTURAL ENGINEER :
C M WONG & ASSOCIATES LTD

美特鋁質有限公司
MIDI ALUMINIUM FABRICATOR LTD.
Units 6-8, Sunray Industrial Centre, 1/F
610 Cha Kwo Ling Road, Kowloon
Tel:23489211-4 Fax:(852)2727666

PROJECT :
RESIDENTIAL DEVELOPMENT AT
TSING YI TOWN LOT 190 SAI SHAN ROAD




TITLE :
WINDOW SCHEDULE
FOR PRECAST FACADE
OF T1/T1A (3 OF 6)

JOB NO. :	J-851
DRAWN BY : C.H.P.	DATE : 30-11-2019
CHKD BY :	SCALE A1: A3: 1:30
DWG. NO. : J851-SCH-103	REV. : B

OPENABLE AREA	GLAZING AREA
0.77	2.45

OPENABLE AREA	GLAZING AREA
0.77	1.28

OPENABLE AREA	GLAZING AREA
0.52	0.43

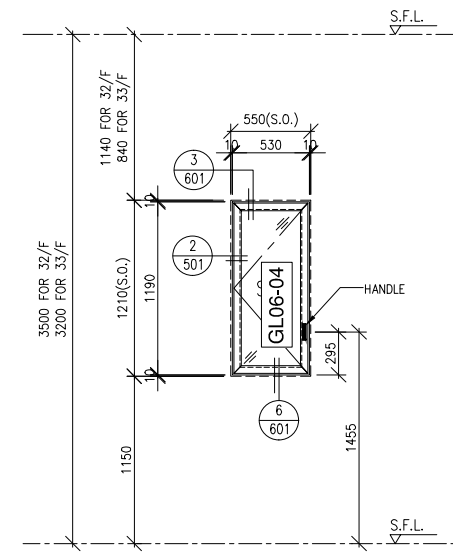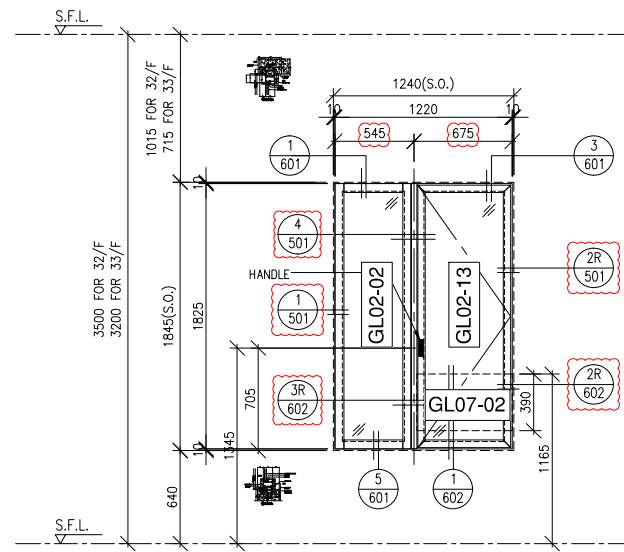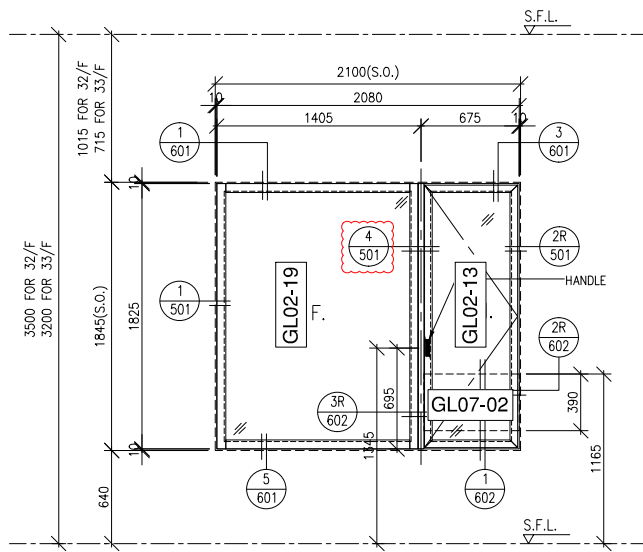

WINDOW MARK	W36 T1 2 nos.
-------------	------------------

LOCATION	T1 FLAT E MBR. (32-33/F)
----------	--------------------------

GLAZING	GL02	FRAME	AL11
---------	------	-------	------

REMARK	65mm ALUM. WINDOW SECTION
--------	---------------------------

FREE AREA(%)	OPENABLE AREA	GLAZING AREA
57%	0.66	0.56

WINDOW MARK	W37 T1 2 nos.
-------------	------------------

LOCATION	T1 FLAT E BR2. (32-33/F)
----------	--------------------------

GLAZING	GL02	FRAME	AL11
---------	------	-------	------

REMARK	65mm ALUM. WINDOW SECTION
--------	---------------------------

GLAZING AREA
0.30




WINDOW MARK	W38 T1 4 nos.
-------------	------------------

LOCATION	T1A FLAT C M.BATH. (32-33/F) T1A FLAT C BATH1. (32-33/F)
----------	-------------------------------------------------------------

GLAZING	GL06	FRAME	AL11
---------	------	-------	------

REMARK	65mm ALUM. WINDOW SECTION
--------	---------------------------

FREE AREA(%)	OPENABLE AREA	GLAZING AREA
57%	0.70	0.60

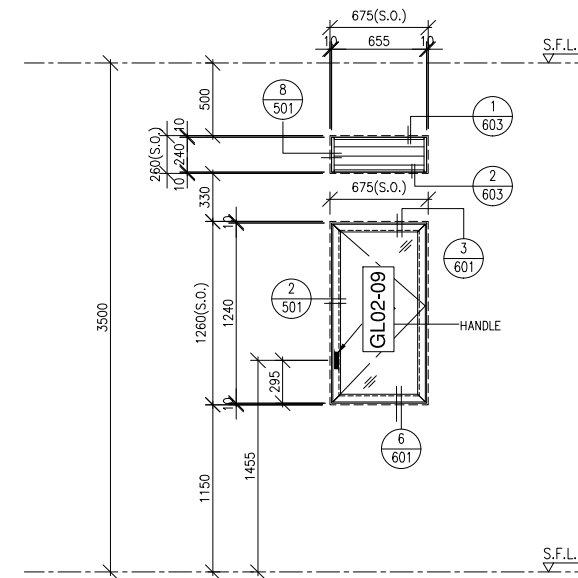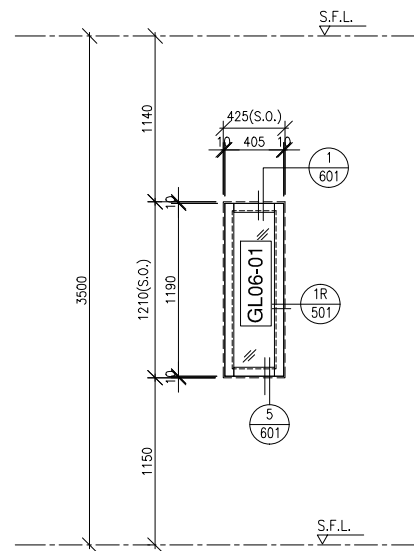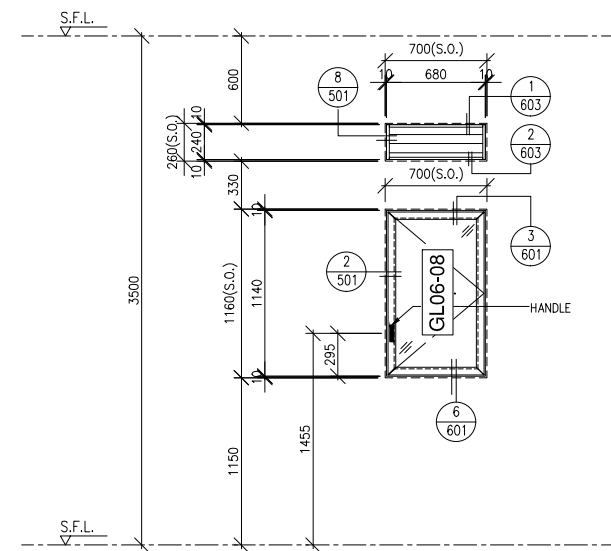

WINDOW MARK	W40 T1 1 no.
-------------	-----------------

LOCATION	T1 FLAT A M.BATH. (32/F)
----------	--------------------------

GLAZING	GL06	FRAME	AL11
---------	------	-------	------

REMARK	65mm ALUM. WINDOW SECTION
--------	---------------------------

WINDOW MARK	W41 T1 1 no.
-------------	-----------------

LOCATION	T1 FLAT D BATH1. (32/F)
----------	-------------------------

GLAZING	GL06	FRAME	AL11
---------	------	-------	------

REMARK	65mm ALUM. WINDOW SECTION
--------	---------------------------

WINDOW MARK	W43 T1 1 no.
-------------	-----------------

LOCATION	T1 FLAT A KIT. (32/F)
----------	-----------------------

GLAZING	GL02	FRAME	AL11
---------	------	-------	------

REMARK	65mm ALUM. WINDOW SECTION
--------	---------------------------

B.D. REF :
F.S.D. REF :
Note :
1. All dimensions are in mm.
2. All elevations are viewed from outside.
3. All dimensions to be verified on site before fabrication.

GENERAL NOTES

Legend :
1. F.F.L.-- Finished Floor Level
2. S.F.L.-- Structural Floor Level
3. (R) -- Reversed Detail

X1 -- DETAIL MARK NO.
X001 -- REFER SHEET NO.

NO.	DATE	REVISED	BY
B	28.02.2020	GENERAL REVISION	
A	06.02.2020	GENERAL REVISION	

CLIENT :
佳明集團控股有限公司
GRAND MING GROUP HOLDINGS LIMITED

MAIN CONTRACTOR :
GRAND TECH CONSTRUCTION CO. LTD.

ARCHITECT :
WONG TUNG & PARTNERS LIMITED
ARCHITECTS & PLANNERS



STRUCTURAL ENGINEER :
C M WONG & ASSOCIATES LTD



美特鋁質有限公司
MIDI ALUMINIUM FABRICATOR LTD.

Units 6-8, Sunray Industrial Centre, 1/F
610 Cha Kwo Ling Road, Kowloon
Tel:23489211-4 Fax:(852)2772666

PROJECT :
RESIDENTIAL DEVELOPMENT AT
TSING YI TOWN LOT 190 SAI SHAN ROAD

TITLE :
WINDOW SCHEDULE
FOR PRECAST FACADE
OF T1/T1A (4 OF 6)

JOB NO. : J-851

DRAWN BY : C.H.P. DATE : 30-11-2019




CHKD BY : SCALE A1: A3: 1:30

DWG. NO. : J851-SCH-104 REV. : B

FREE AREA(%)	OPENABLE AREA	GLAZING AREA
57%	0.67	1.28

OPENABLE AREA	GLAZING AREA
2.11	1.84

OPENABLE AREA	GLAZING AREA
1.34	1.16

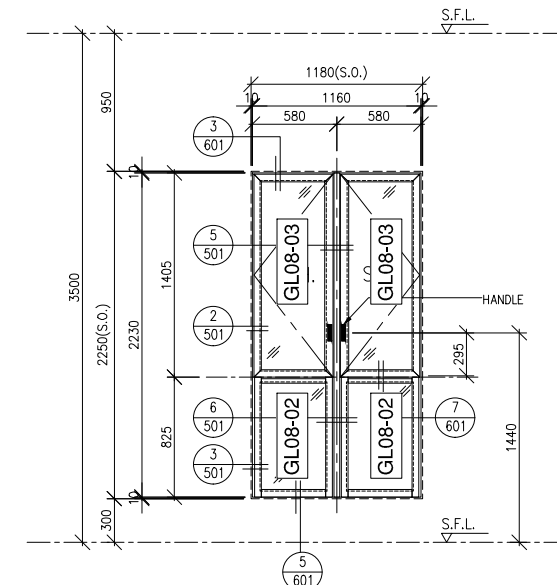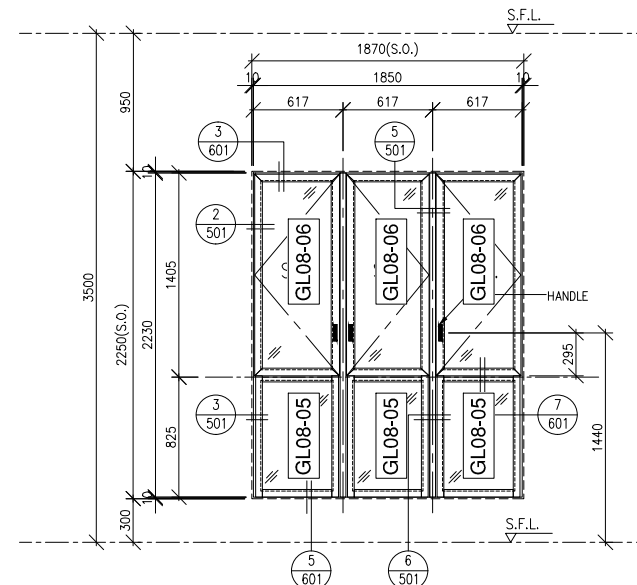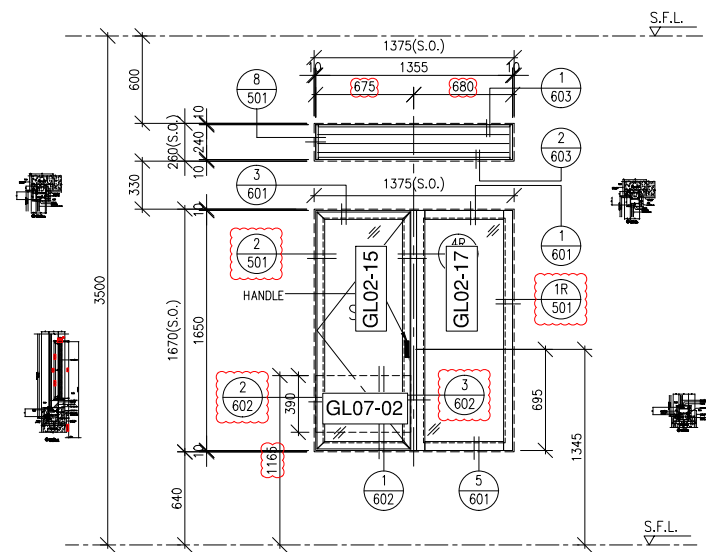

WINDOW MARK	W44 T1 1 nos.		
LOCATION	T1 FLAT A STORE (32/F)		
GLAZING	GL02	FRAME	AL11
REMARK	65mm ALUM. WINDOW SECTION		




WINDOW MARK	W45 T1 2 nos.		
LOCATION	T1A LOBBY CORRIDOR (32-33/F)		
GLAZING	GL08	FRAME	AL11
REMARK	65mm ALUM. WINDOW SECTION		

WINDOW MARK	W46 T1 4 nos.		
LOCATION	T1 LOBBY CORRIDOR (32-33/F)		
GLAZING	GL08	FRAME	AL11
REMARK	65mm ALUM. WINDOW SECTION		

OPENABLE AREA	GLAZING AREA
0.51	0.49

FREE AREA(%)	OPENABLE AREA	GLAZING AREA
57%	0.69	0.59

FREE AREA(%)	OPENABLE AREA	GLAZING AREA
57%	0.69	0.59

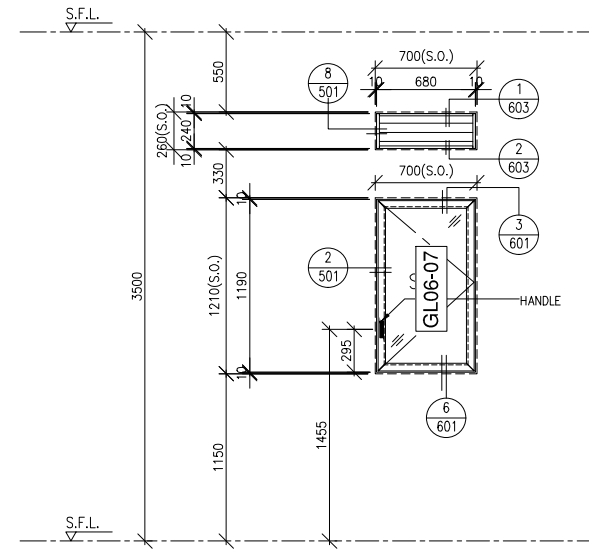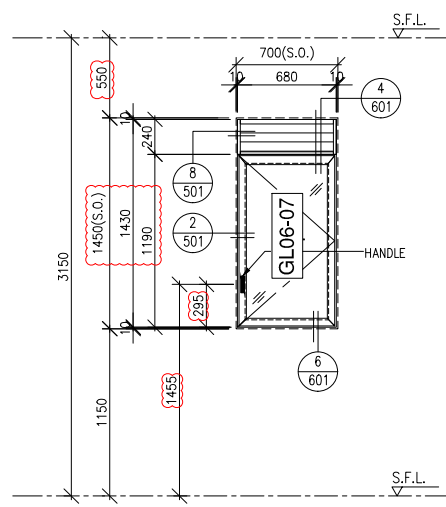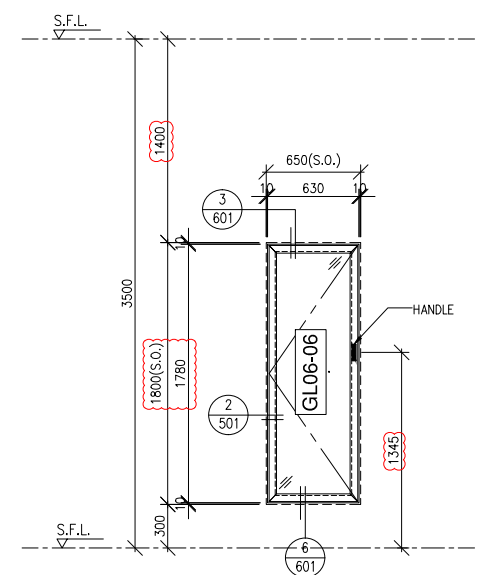

WINDOW MARK	W47 T1 2 nos.		
LOCATION	T1 LOBBY CORRIDOR (32-33/F)		
GLAZING	GL06	FRAME	AL11
REMARK	65mm ALUM. WINDOW SECTION		

WINDOW MARK	W10A T1 26 nos.		
LOCATION	T1 FLAT D M.BATH. (2-31/F; 4,13,14,24/F OMITTED)		
GLAZING	GL06	FRAME	AL11
REMARK	65mm ALUM. WINDOW SECTION		

WINDOW MARK	W40A T1 1 no.		
LOCATION	T1 FLAT D M.BATH. (32/F)		
GLAZING	GL06	FRAME	AL11
REMARK	65mm ALUM. WINDOW SECTION		

B.D. REF :
F.S.D. REF :
Note :
1.All dimensions are in mm.
2.All elevations are viewed from outside.
3.All dimensions to be verified on site before fabrication.

GENERAL NOTES
Legend :
1. F.F.L.-- Finished Floor Level
2. S.F.L.-- Structural Floor Level
3. (R) -- Reversed Detail
X1 -- DETAIL MARK NO.
X001 -- REFER SHEET NO.

NO.	DATE	REVISED	BY
B	28.02.2020	GENERAL REVISION	
A	06.02.2020	GENERAL REVISION	

CLIENT :
佳明集團控股有限公司
GRAND MING GROUP HOLDINGS LIMITED

MAIN CONTRACTOR :
GRAND TECH CONSTRUCTION CO. LTD.

ARCHITECT :
WONG TUNG & PARTNERS LIMITED
ARCHITECTS & PLANNERS
WT

STRUCTURAL ENGINEER :
C M WONG & ASSOCIATES LTD

美特鋁質有限公司
MIDI ALUMINIUM FABRICATOR LTD.
Units 6-8, Sunray Industrial Centre, 1/F
610 Cha Kwo Ling Road, Kowloon
Tel:23489211-4 Fax:(852)27727666

PROJECT :
RESIDENTIAL DEVELOPMENT AT
TSING YI TOWN LOT 190 SAI SHAN ROAD

TITLE :
WINDOW SCHEDULE
FOR PRECAST FACADE
OF T1/T1A (5 OF 6)

JOB NO. :	J-851
DRAWN BY : C.H.P.	DATE : 30-11-2019
CHKD BY :	SCALE A1: A3: 1:30
DWG. NO. : J851-SCH-105	REV. : B

FREE AREA(%)	OPENABLE AREA	GLAZING AREA	WINDOW MARK	LOCATION	GLAZING	FRAME	AL	REMARK
57%	0.45	0.36	W60 T1	T1 FLAT A UTILITY RM (35/F)	GL06	AL11		65mm ALUM. WINDOW SECTION
57%	0.45	0.36	W60A T1	T1 FLAT A POWDER ROOM (35/F)	GL06	AL11		65mm ALUM. WINDOW SECTION
57%	0.47	0.38	W61 T1	T1 FLAT B UTILITY RM (35/F)	GL06	AL11		65mm ALUM. WINDOW SECTION
57%	0.47	0.38	W66 T1	T1 FLAT B UTILITY RM (35/F)	GL06	AL11		65mm ALUM. WINDOW SECTION
57%	0.50	0.41	W72 T1	T1 FLAT B LIV. & DIN. (35/F)	GL02	AL11		65mm ALUM. WINDOW SECTION
57%	0.50	0.41	W38A T1	T1 FLAT A M.BATH1. (33/F)	GL06	AL11		65mm ALUM. WINDOW SECTION
57%	0.47	0.38	W64 T1	T1A FLAT B M.BATH1. (33/F)	GL06	AL11		65mm ALUM. WINDOW SECTION

B.D. REF :
F.S.D. REF :

Note :
1. All dimensions are in mm.
2. All elevations are viewed from outside.
3. All dimensions to be verified on site before fabrication.

GENERAL NOTES

Legend :
1. F.F.L. --- Finished Floor Level
2. S.F.L. --- Structural Floor Level
3. (R) --- Reversed Detail

X1 --- DETAIL MARK NO.
X001 --- REFER SHEET NO.

CLIENT :
佳明集團控股有限公司
GRAND MING GROUP HOLDINGS LIMITED

MAIN CONTRACTOR :
GRAND TECH CONSTRUCTION CO. LTD.

ARCHITECT :
WONG TUNG & PARTNERS LIMITED
ARCHITECTS & PLANNERS

STRUCTURAL ENGINEER :
C M WONG & ASSOCIATES LTD

美特鋁質有限公司
MIDI ALUMINIUM FABRICATOR LTD.
Units 6-8, Sunray Industrial Centre, 1/F
610 Cha Kwo Ling Road, Kowloon
Tel: 23489211-4 Fax: (852) 27727666

PROJECT :
RESIDENTIAL DEVELOPMENT AT
TSING YI TOWN LOT 190 SAI SHAN ROAD

TITLE :
WINDOW SCHEDULE
FOR PRECAST FACADE
OF T1/T1A (6 OF 6)

JOB NO. : J-851

DRAWN BY : C.H.P. DATE : 30-11-2019

CHKD BY : SCALE A1: A3: 1:30

DWG. NO. : J851-SCH-106 REV. : C

<p>FREE AREA(%) 57%</p>	<p>FREE AREA(%) 57%</p>	<p>FREE AREA(%) 57%</p>	<p>B.D. REF : F.S.D. REF : Note : 1.All dimensions are in mm. 2.All elevations are viewed from outside. 3.All dimensions to be verified on site before fabrication.</p> <p>GENERAL NOTES</p> <p>Legend : 1. F.F.L.-- Finished Floor Level 2. S.F.L.-- Structural Floor Level 3. (R) -- Reversed Detail</p> <p>X1 -- DETAIL MARK NO. X001 -- REFER SHEET NO.</p> <table border="1"> <tr><td>C</td><td>18.03.2020</td><td>GENERAL REVISION</td><td></td></tr> <tr><td>B</td><td>28.02.2020</td><td>GENERAL REVISION</td><td></td></tr> <tr><td>A</td><td>06.02.2020</td><td>GENERAL REVISION</td><td></td></tr> <tr><td>NO.</td><td>DATE</td><td>REVISED</td><td>BY</td></tr> </table>	C	18.03.2020	GENERAL REVISION		B	28.02.2020	GENERAL REVISION		A	06.02.2020	GENERAL REVISION		NO.	DATE	REVISED	BY
C	18.03.2020	GENERAL REVISION																	
B	28.02.2020	GENERAL REVISION																	
A	06.02.2020	GENERAL REVISION																	
NO.	DATE	REVISED	BY																
<p>WINDOW MARK 29 nos.</p> <p>LOCATION T1A FLAT C M.BATH. (1-33/F; 4,13,14,24/F OMITTED)</p> <p>GLAZING FRAME AL11</p> <p>REMARK 65mm ALUM. WINDOW SECTION</p>	<p>WINDOW MARK 28 nos.</p> <p>LOCATION T1 FLAT A KIT. (1-32/F; 4,13,14,24/F OMITTED)</p> <p>GLAZING FRAME AL11</p> <p>REMARK 65mm ALUM. WINDOW SECTION</p>	<p>WINDOW MARK 29 nos.</p> <p>LOCATION T1 LOBBY CORRIDOR (1-33/F; 4,13,14,24/F OMITTED)</p> <p>GLAZING FRAME AL11</p> <p>REMARK 65mm ALUM. WINDOW SECTION</p>	<p>CLIENT : 佳明集團控股有限公司 GRAND MING GROUP HOLDINGS LIMITED</p> <p>MAIN CONTRACTOR : GRAND TECH CONSTRUCTION CO. LTD.</p> <p>ARCHITECT : WONG TUNG & PARTNERS LIMITED ARCHITECTS & PLANNERS</p> <p>STRUCTURAL ENGINEER : C M WONG & ASSOCIATES LTD</p> <p>美特鋁質有限公司 MIDI ALUMINIUM FABRICATOR LTD. Units 6-8, Sunray Industrial Centre, 1/F 610 Cha Kwo Ling Road, Kowloon Tel:23489211-4 Fax:(852)27727666</p> <p>PROJECT : RESIDENTIAL DEVELOPMENT AT TSING YI TOWN LOT 190 SAI SHAN ROAD</p> <p>TITLE : LOUVRE SCHEDULE FOR PRECAST FACADE OF T1/T1A</p> <p>JOB NO. : J-851</p> <p>DRAWN BY : C.H.P. DATE : 30-11-2019</p> <p>CHKD BY : SCALE A1: A3: 1:30</p> <p>DWG. NO. : J851-SCH-107 REV. : C</p>																
<p>FREE AREA(%) 52.6%</p>	<p>WINDOW MARK</p> <p>LOCATION</p> <p>GLAZING FRAME</p> <p>REMARK</p>	<p>WINDOW MARK</p> <p>LOCATION</p> <p>GLAZING FRAME</p> <p>REMARK</p>																	
<p>WINDOW MARK 29 nos.</p> <p>LOCATION T1 FLAT E BATH. (1-33/F; 4,13,14,24/F OMITTED)</p> <p>GLAZING FRAME AL11</p> <p>REMARK 65mm ALUM. WINDOW SECTION</p>	<p>WINDOW MARK</p> <p>LOCATION</p> <p>GLAZING FRAME</p> <p>REMARK</p>	<p>WINDOW MARK</p> <p>LOCATION</p> <p>GLAZING FRAME</p> <p>REMARK</p>																	

FREE AREA(%)	OPENABLE AREA	GLAZING AREA
57%	0.72	1.31




OPENABLE AREA	GLAZING AREA
0.77	1.15

OPENABLE AREA	GLAZING AREA
0.77	1.45

B.D. REF :
F.S.D. REF :
Note :
1.All dimensions are in mm.
2.All elevations are viewed from outside.
3.All dimensions to be verified on site before fabrication.

GENERAL NOTES

Legend :
1. F.F.L.--- Finished Floor Level
2. S.F.L.--- Structural Floor Level
3. (R) --- Reversed Detail
X1 --- DETAIL MARK NO.
X001 --- REFER SHEET NO.

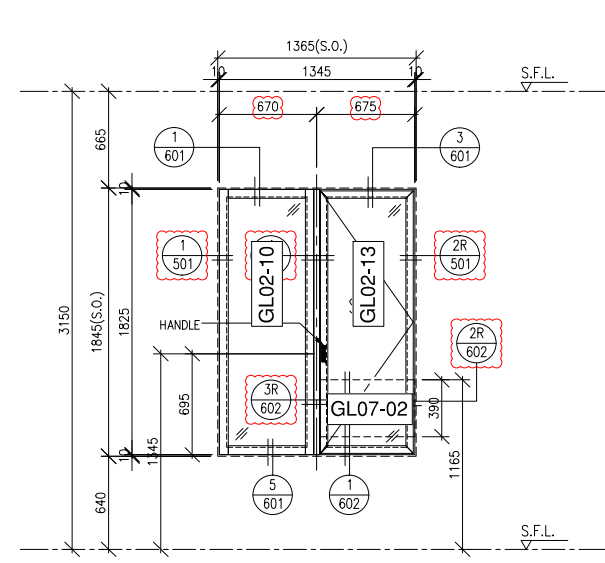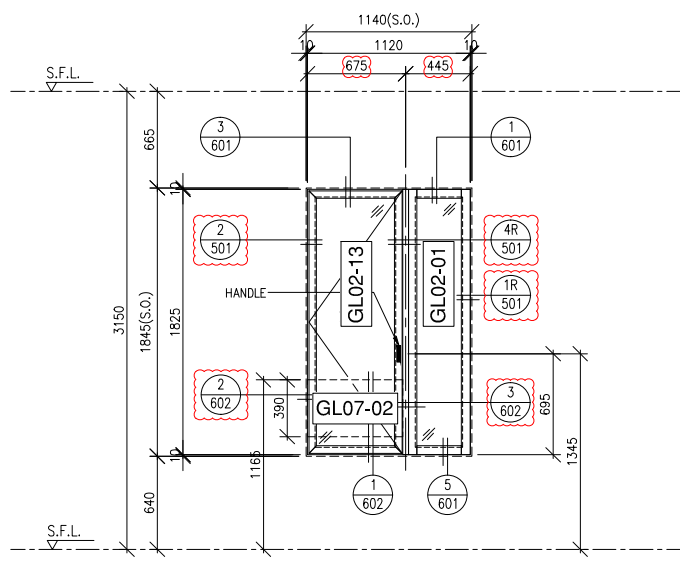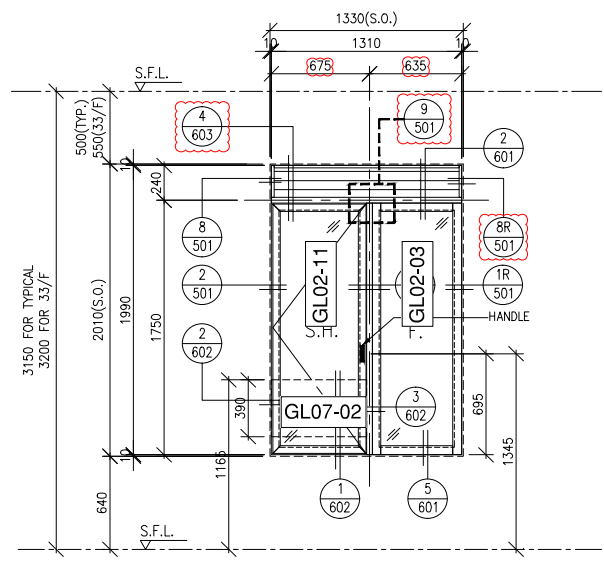

WINDOW MARK W2
T2 56 nos.

WINDOW MARK W3
T2 27 nos.

WINDOW MARK W4
T2 27 nos.

LOCATION T2A FLAT D MBR. (1-31/F & 33/F ; 4,13,14,24/F OMITTED)
T2 FLAT H MBR. (1-31/F & 33/F ; 4,13,14,24/F OMITTED)

LOCATION T2A FLAT B BR3.(1-31/F; 4,13,14,24/F OMITTED)

LOCATION T2A FLAT B BR2.(1-31/F; 4,13,14,24/F OMITTED)

GLAZING GL02 FRAME AL11

GLAZING GL02 FRAME AL11

GLAZING GL02 FRAME AL11

REMARK 65mm ALUM. WINDOW SECTION

REMARK 65mm ALUM. WINDOW SECTION

REMARK 65mm ALUM. WINDOW SECTION

OPENABLE AREA	GLAZING AREA
0.77	2.45

OPENABLE AREA	GLAZING AREA
0.77	1.28

NO.	DATE	REVISED	BY
B	28.02.2020	GENERAL REVISION	
A	06.02.2020	GENERAL REVISION	

CLIENT :
佳明集團控股有限公司
GRAND MING GROUP HOLDINGS LIMITED

MAIN CONTRACTOR :
GRAND TECH CONSTRUCTION CO.LTD.

ARCHITECT :
WONG TUNG & PARTNERS LIMITED
ARCHITECTS & PLANNERS

STRUCTURAL ENGINEER :
C M WONG & ASSOCIATES LTD

美特鋁質有限公司
MIDI ALUMINIUM FABRICATOR LTD.
Units 6-8, Sunray Industrial Centre, 1/F
610 Cha Kwo Ling Road, Kowloon
Tel:23489211-4 Fax:(852)27727666

PROJECT :
RESIDENTIAL DEVELOPMENT AT
TSING YI TOWN LOT 190 SAI SHAN ROAD

WINDOW MARK W6
T2 27 nos.

WINDOW MARK W7
T2 27 nos.

WINDOW MARK

LOCATION T2 FLAT E MBR.(1-31/F; 4,13,14,24/F OMITTED)

LOCATION T2 FLAT E BR2.(1-31/F; 4,13,14,24/F OMITTED)

LOCATION

GLAZING GL02 FRAME AL11

GLAZING GL02 FRAME AL11

GLAZING FRAME

REMARK 65mm ALUM. WINDOW SECTION

REMARK 65mm ALUM. WINDOW SECTION

REMARK

TITLE :
WINDOW SCHEDULE
FOR PRECAST FACADE
OF T2/T2A (1 OF 6)


JOB NO. : J-851

DRAWN BY : C.H.P. DATE : 30-11-2019


CHKD BY : SCALE A1: A3: 1:30

DWG. NO. : J851-SCH-201 REV. : B


FREE AREA(%)	OPENABLE AREA	GLAZING AREA
57%	0.69	0.59

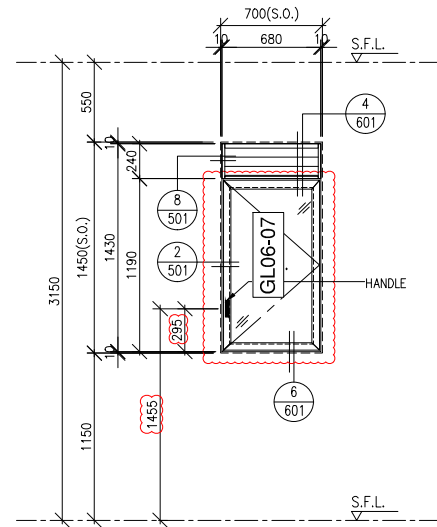

GLAZING AREA
0.30

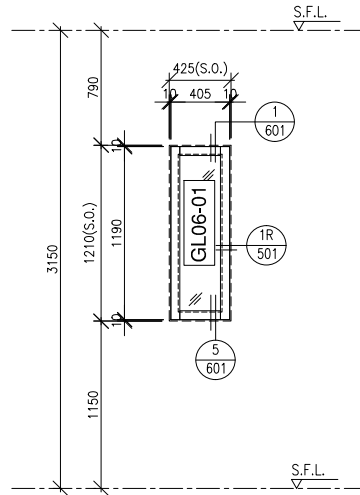

FREE AREA(%)	OPENABLE AREA	GLAZING AREA
57%	0.70	0.59

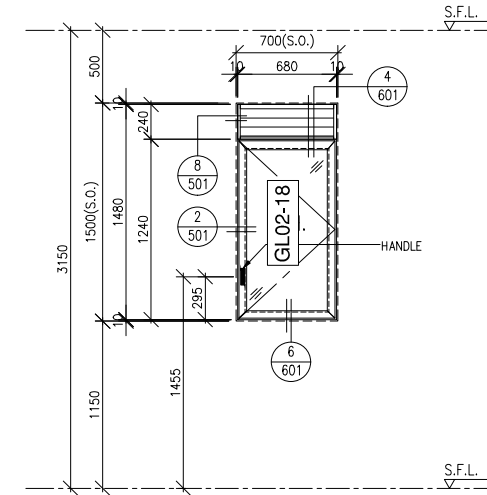

B.D. REF :
F.S.D. REF :
Note :
1. All dimensions are in mm.
2. All elevations are viewed from outside.
3. All dimensions to be verified on site before fabrication.

GENERAL NOTES
Legend :
1. F.F.L.-- Finished Floor Level
2. S.F.L.-- Structural Floor Level
3. (R) -- Reversed Detail
X1 -- DETAIL MARK NO.
X001 -- REFER SHEET NO.

WINDOW MARK W10 T2 27 nos.

LOCATION T2 FLAT A M.BATH.(1-31/F; 4,13,14,24/F OMITTED)

GLAZING GL06 FRAME AL11

REMARK 65mm ALUM. WINDOW SECTION

WINDOW MARK W11 T2 27 nos.

LOCATION T2 FLAT D BATH1.(1-31/F; 4,13,14,24/F OMITTED)

GLAZING GL06 FRAME AL11

REMARK 65mm ALUM. WINDOW SECTION

OPENABLE AREA	GLAZING AREA
1.57	1.37

WINDOW MARK W13 T2 54 nos.

LOCATION T2 FLAT A KIT.(1-31/F; 4,13,14,24/F OMITTED)
T2A FLAT A KIT.(1-31/F; 4,13,14,24/F OMITTED)

GLAZING GL02 FRAME AL11

REMARK 65mm ALUM. WINDOW SECTION

OPENABLE AREA	GLAZING AREA
1.00	0.86

NO.	DATE	REVISED	BY
B	28.02.2020	GENERAL REVISION	
A	06.02.2020	GENERAL REVISION	

CLIENT :
佳明集團控股有限公司
GRAND MING GROUP HOLDINGS LIMITED

MAIN CONTRACTOR :
GRAND TECH CONSTRUCTION CO. LTD.

ARCHITECT :
WONG TUNG & PARTNERS LIMITED
ARCHITECTS & PLANNERS
WT

STRUCTURAL ENGINEER :
C M WONG & ASSOCIATES LTD

美特鋁質有限公司
MIDI ALUMINIUM FABRICATOR LTD.
Units 6-8, Sunray Industrial Centre, 1/F
610 Cha Kwo Ling Road, Kowloon
Tel:23489211-4 Fax:(852)27727666

PROJECT :
RESIDENTIAL DEVELOPMENT AT
TSING YI TOWN LOT 190 SAI SHAN ROAD

WINDOW MARK W15 T2 27 nos.

LOCATION T2 LOBBY CORRIDOR(1-31/F; 4,13,14,24/F OMITTED)

GLAZING GL08 FRAME AL11



REMARK 65mm ALUM. WINDOW SECTION

WINDOW MARK W16 T2 54 nos.

LOCATION T2 LOBBY CORRIDOR(1-31/F; 4,13,14,24/F OMITTED)

GLAZING GL08 FRAME AL11


REMARK 65mm ALUM. WINDOW SECTION

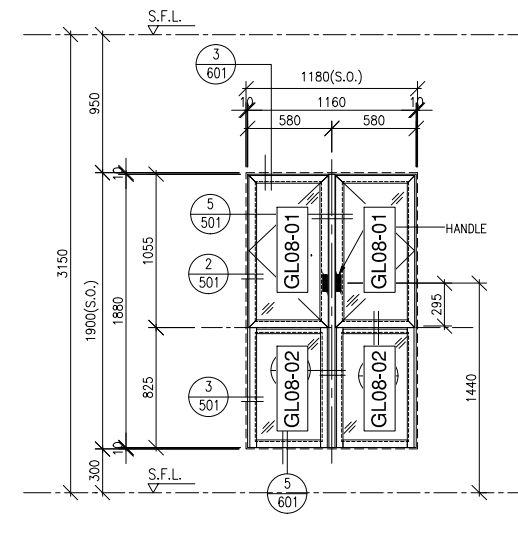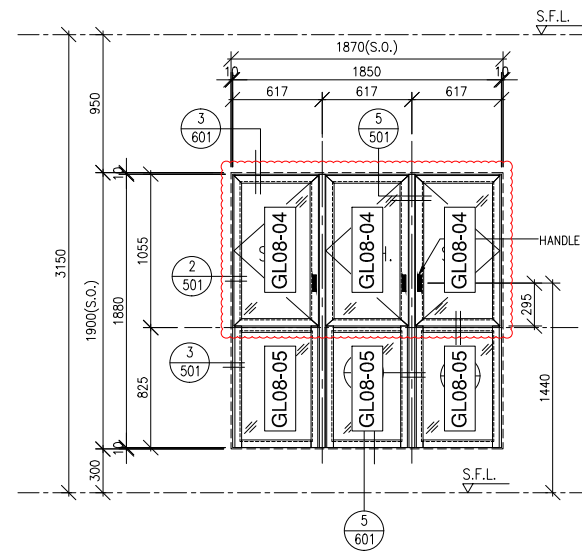


TITLE :
WINDOW SCHEDULE
FOR PRECAST FACADE
OF T2/T2A (2 OF 6)

JOB NO. : J-851
DRAWN BY : C.H.P. DATE : 30-11-2019
CHKD BY : SCALE A1: A3: 1:30
DWG. NO. : J851-SCH-202 REV. : B

OPENABLE AREA	GLAZING AREA
0.69	0.59

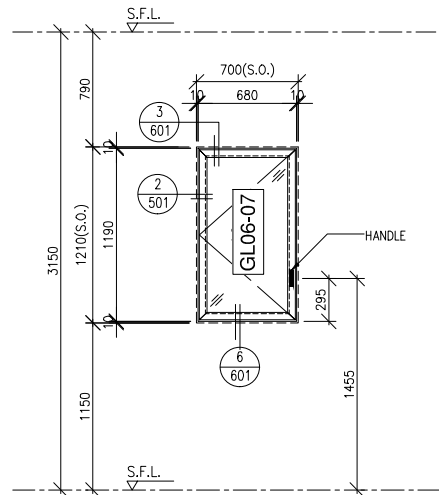

FREE AREA(%)	OPENABLE AREA	GLAZING AREA
57%	0.70	1.34

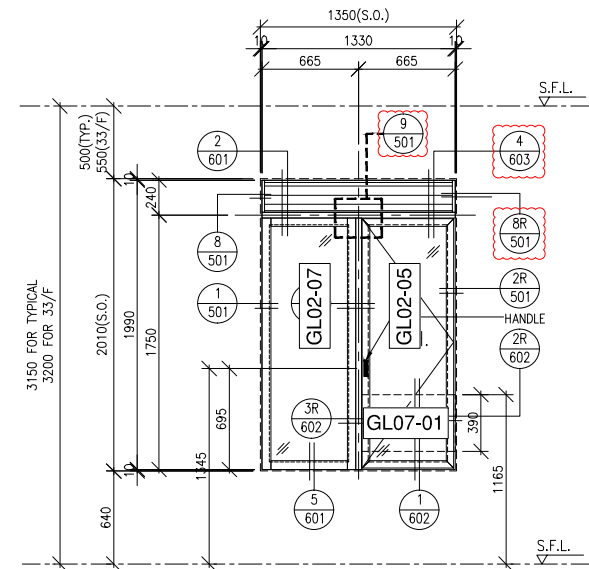

B.D. REF :
F.S.D. REF :
Note :
1.All dimensions are in mm.
2.All elevations are viewed from outside.
3.All dimensions to be verified on site before fabrication.

GENERAL NOTES


Legend :
1. F.F.L.-- Finished Floor Level
2. S.F.L.-- Structural Floor Level
3. (R) -- Reversed Detail

X1 -- DETAIL MARK NO.
X001 -- REFER SHEET NO.


WINDOW MARK	W22 T2	27 nos.
LOCATION	T2A FLAT B M.BATH.(1-31/F; 4,13,14,24/F OMITTED)	
GLAZING	GL06	FRAME AL11
REMARK	65mm ALUM. WINDOW SECTION	

WINDOW MARK	W23 T2	28 nos.
LOCATION	T2 FLAT F MBR.(1-31/F & 33/F ; 4,13,14,24/F OMITTED)	
GLAZING	GL02	FRAME AL11
REMARK	65mm ALUM. WINDOW SECTION	


FREE AREA(%)	OPENABLE AREA	GLAZING AREA
57%	0.73	1.33

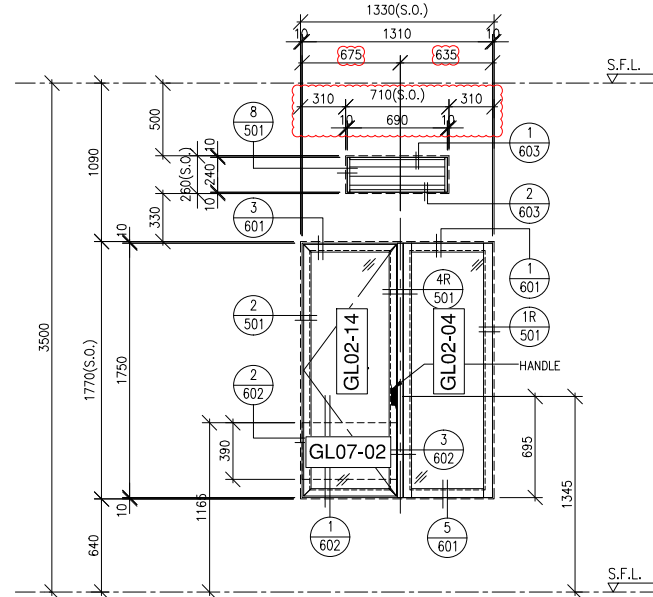

OPENABLE AREA	GLAZING AREA
0.77	1.15

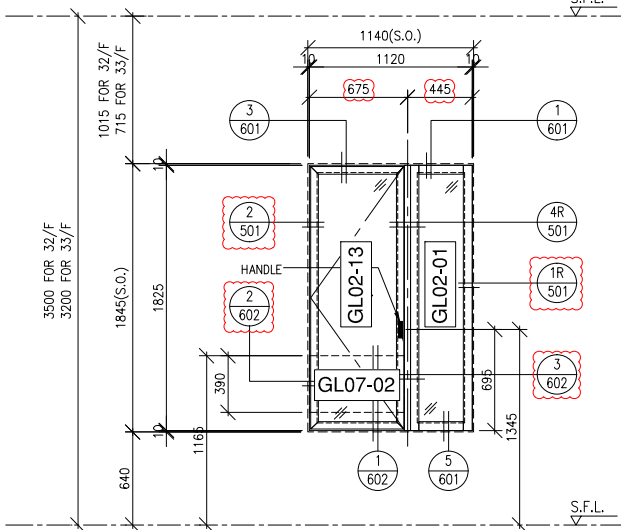

OPENABLE AREA	GLAZING AREA
0.77	1.45

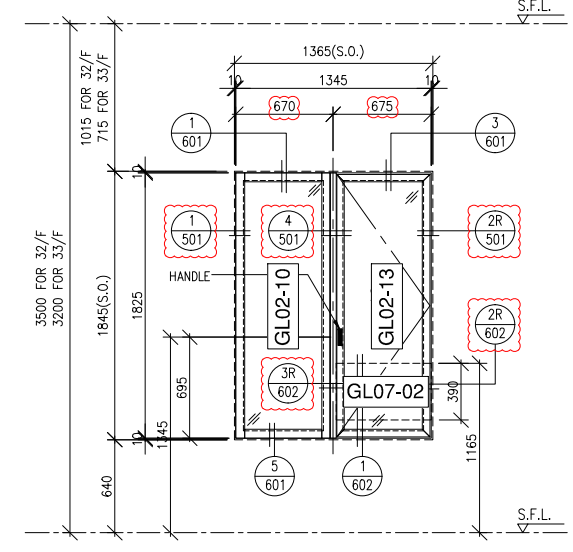

NO.	DATE	REVISED	BY
B	28.02.2020	GENERAL REVISION	
A	06.02.2020	GENERAL REVISION	

CLIENT :
佳明集團控股有限公司
GRAND MING GROUP HOLDINGS LIMITED

MAIN CONTRACTOR :
GRAND TECH CONSTRUCTION CO. LTD.

ARCHITECT :
WONG TUNG & PARTNERS LIMITED
ARCHITECTS & PLANNERS

STRUCTURAL ENGINEER :
C M WONG & ASSOCIATES LTD

美特鋁質有限公司
MIDI ALUMINIUM FABRICATOR LTD.
Units 6-8, Sunray Industrial Centre, 1/F
610 Cha Kwo Ling Road, Kowloon
Tel:23489211-4 Fax:(852)27727666

PROJECT :
RESIDENTIAL DEVELOPMENT AT
TSING YI TOWN LOT 190 SAI SHAN ROAD

WINDOW MARK	W32 T2	2 nos.
LOCATION	T2A FLAT D MBR.(32/F) T2 FLAT H MBR.(32/F)	
GLAZING	GL02	FRAME AL11
REMARK	65mm ALUM. WINDOW SECTION	

WINDOW MARK	W33 T2	2 nos.
LOCATION	T2A FLAT B BR3. (32-33/F)	
GLAZING	GL02	FRAME AL11
REMARK	65mm ALUM. WINDOW SECTION	

WINDOW MARK	W34 T2	2 nos.
LOCATION	T2A FLAT B BR2. (32-33/F)	
GLAZING	GL02	FRAME AL11
REMARK	65mm ALUM. WINDOW SECTION	

TITLE :	WINDOW SCHEDULE FOR PRECAST FACADE OF T2/T2A (3 OF 6)		
JOB NO. :	J-851		
DRAWN BY :	C.H.P.	DATE :	30-11-2019
CHKD BY :		SCALE :	A1: A3: 1:30
DWG. NO. :	J851-SCH-203	REV. :	B




OPENABLE AREA	GLAZING AREA
0.77	2.45

OPENABLE AREA	GLAZING AREA
0.77	1.28

FREE AREA(%)	OPENABLE AREA	GLAZING AREA
57%	0.47	0.38

B.D. REF :
F.S.D. REF :
Note :
1.All dimensions are in mm.
2.All elevations are viewed from outside.
3.All dimensions to be verified on site before fabrication.

GENERAL NOTES
Legend :
1. F.F.L.-- Finished Floor Level
2. S.F.L.-- Structural Floor Level
3. (R) -- Reversed Detail
X1 -- DETAIL MARK NO.
X001 -- REFER SHEET NO.

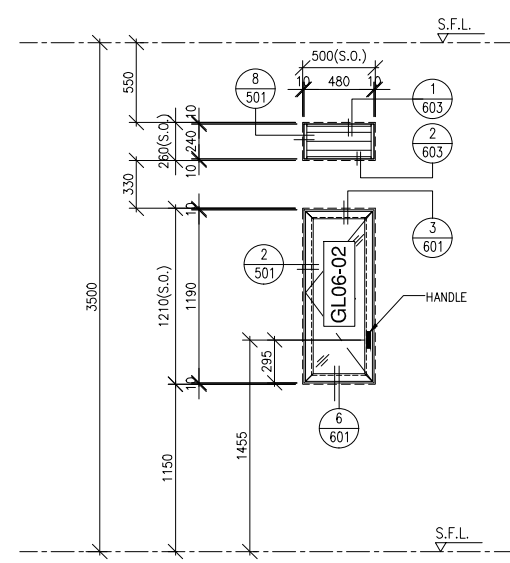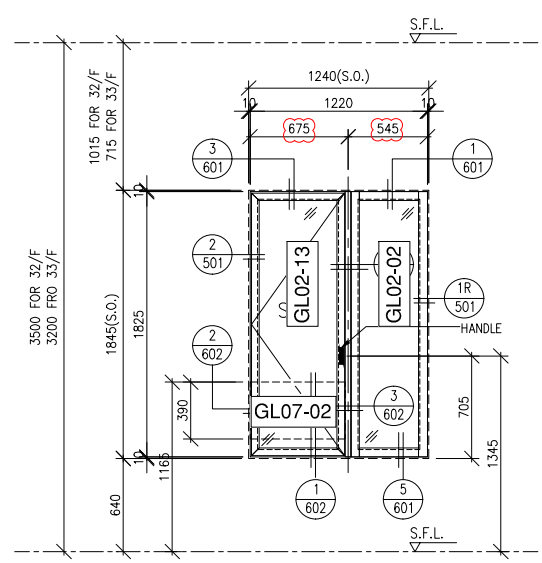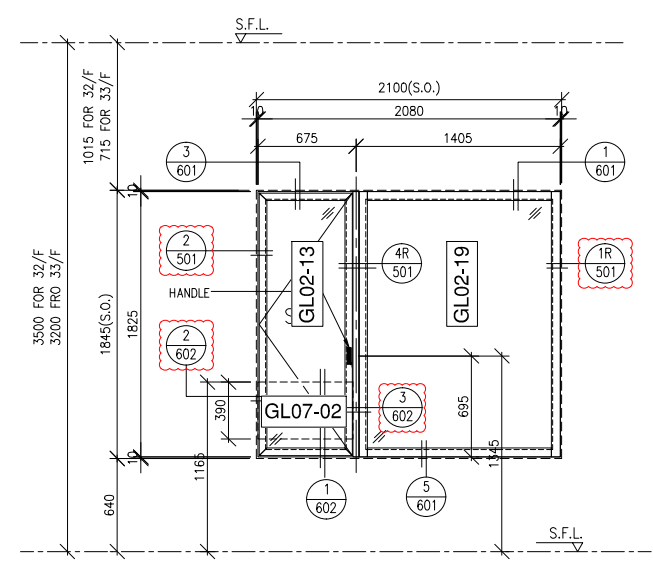

WINDOW MARK	W36 MIR. T2 2 nos.		
-------------	--------------------	--	--

LOCATION	T2 FLAT E MBR. (32-33/F)		
----------	--------------------------	--	--

GLAZING	GL02	FRAME	AL11
---------	------	-------	------

REMARK	65mm ALUM. WINDOW SECTION		
--------	---------------------------	--	--

FREE AREA(%)	OPENABLE AREA	GLAZING AREA
57%	0.69	0.59

WINDOW MARK	W37 MIR. T2 2 nos.		
-------------	--------------------	--	--

LOCATION	T2 FLAT E BR2. (32-33/F)		
----------	--------------------------	--	--

GLAZING	GL02	FRAME	AL11
---------	------	-------	------

REMARK	65mm ALUM. WINDOW SECTION		
--------	---------------------------	--	--

GLAZING AREA
0.30




WINDOW MARK	W38 T2 1 nos.		
-------------	---------------	--	--

LOCATION	T2 FLAT B M.BATH. (33/F)		
----------	--------------------------	--	--

GLAZING	GL06	FRAME	AL11
---------	------	-------	------

REMARK	65mm ALUM. WINDOW SECTION		
--------	---------------------------	--	--

FREE AREA(%)	OPENABLE AREA	GLAZING AREA
57%	0.72	0.62

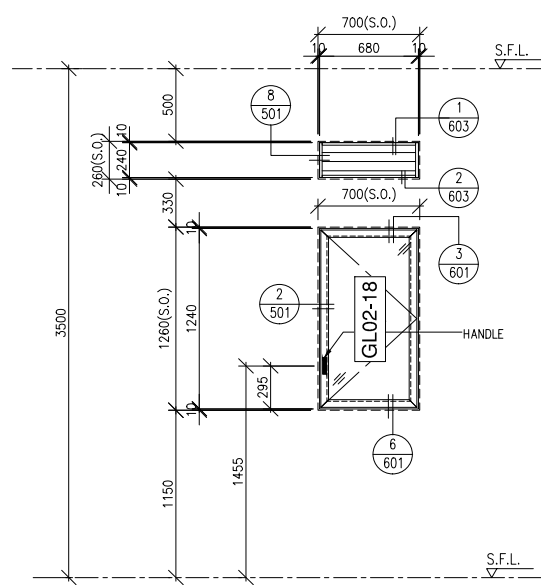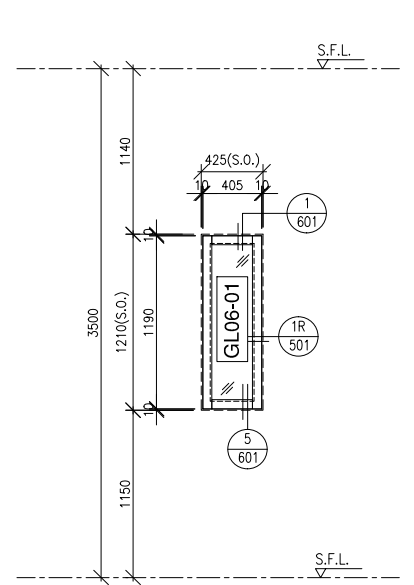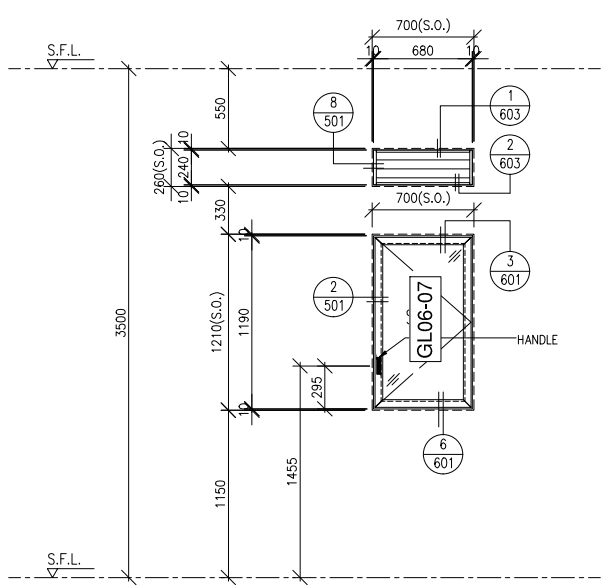

WINDOW MARK	W40 T2 1 no.		
-------------	--------------	--	--

LOCATION	T2 FLAT A M.BATH. (32/F)		
----------	--------------------------	--	--

GLAZING	GL06	FRAME	AL11
---------	------	-------	------

REMARK	65mm ALUM. WINDOW SECTION		
--------	---------------------------	--	--

WINDOW MARK	W41 T2 1 no.		
-------------	--------------	--	--

LOCATION	T2 FLAT D BATH1. (32/F)		
----------	-------------------------	--	--

GLAZING	GL06	FRAME	AL11
---------	------	-------	------

REMARK	65mm ALUM. WINDOW SECTION		
--------	---------------------------	--	--

WINDOW MARK	W43 T2 2 nos.		
-------------	---------------	--	--

LOCATION	T2A FLAT A KIT. (32/F) T2 FLAT A KIT. (32/F)		
----------	-------------------------------------------------	--	--

GLAZING	GL02	FRAME	AL11
---------	------	-------	------

REMARK	65mm ALUM. WINDOW SECTION		
--------	---------------------------	--	--

NO.	DATE	REVISED	BY
B	28.02.2020	GENERAL REVISION	
A	06.02.2020	GENERAL REVISION	

CLIENT :
佳明集團控股有限公司
GRAND MING GROUP HOLDINGS LIMITED

MAIN CONTRACTOR :
GRAND TECH CONSTRUCTION CO. LTD.

ARCHITECT :
WONG TUNG & PARTNERS LIMITED
ARCHITECTS & PLANNERS

STRUCTURAL ENGINEER :
C M WONG & ASSOCIATES LTD

美特鋁質有限公司
MIDI ALUMINIUM FABRICATOR LTD.
Units 6-8, Sunray Industrial Centre, 1/F
610 Cha Kwo Ling Road, Kowloon
Tel:23489211-4 Fax:(852)27727666



PROJECT :
RESIDENTIAL DEVELOPMENT AT
TSING YI TOWN LOT 190 SAI SHAN ROAD

TITLE :
WINDOW SCHEDULE
FOR PRECAST FACADE
OF T2/T2A (4 OF 6)

JOB NO. :	J-851
DRAWN BY : C.H.P.	DATE : 30-11-2019
CHKD BY :	SCALE A1: 1:30 A3: 1:30
DWG. NO. : J851-SCH-204	REV. : B

OPENABLE AREA	GLAZING AREA
2.11	1.84

OPENABLE AREA	GLAZING AREA
1.34	1.16

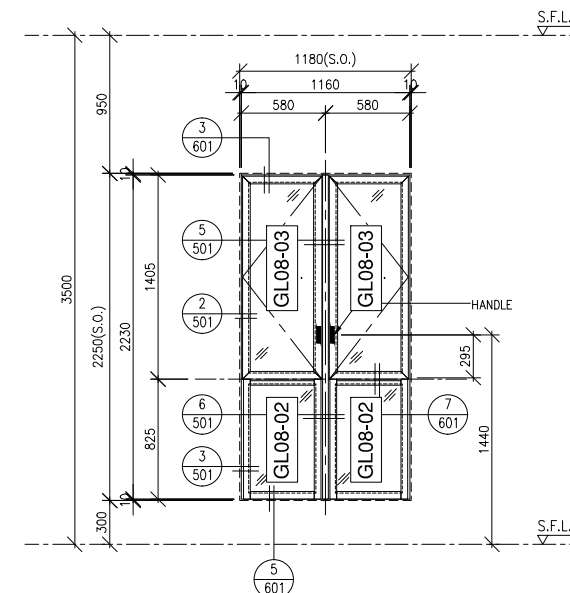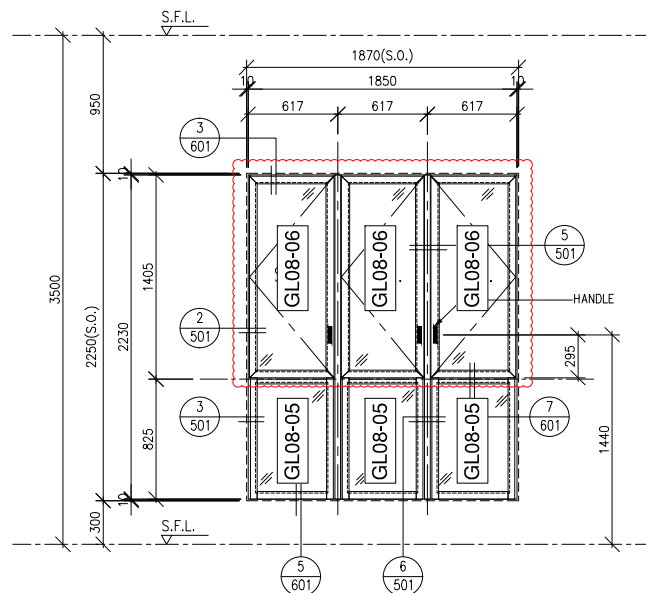

B.D. REF :
F.S.D. REF :
Note :
1. All dimensions are in mm.
2. All elevations are viewed from outside.
3. All dimensions to be verified on site before fabrication.

GENERAL NOTES

- Legend :**
- 1. F.F.L.-- Finished Floor Level
 - 2. S.F.L.-- Structural Floor Level
 - 3. (R) -- Reversed Detail
- (X1) --- DETAIL MARK NO.
(X001) --- REFER SHEET NO.


WINDOW MARK	
LOCATION	
GLAZING	FRAME
REMARK	

WINDOW MARK	W45 T2 2 nos.
LOCATION	T2A LOBBY CORRIDOR (32-33/F)
GLAZING	GL08 FRAME AL11
REMARK	65mm ALUM. WINDOW SECTION

WINDOW MARK	W46 T2 4 nos.
LOCATION	T2 LOBBY CORRIDOR (32-33/F)
GLAZING	GL08 FRAME AL11
REMARK	65mm ALUM. WINDOW SECTION

B	28.02.2020	GENERAL REVISION	
A	06.02.2020	GENERAL REVISION	
NO.	DATE	REVISED	BY

FREE AREA(%)
52%

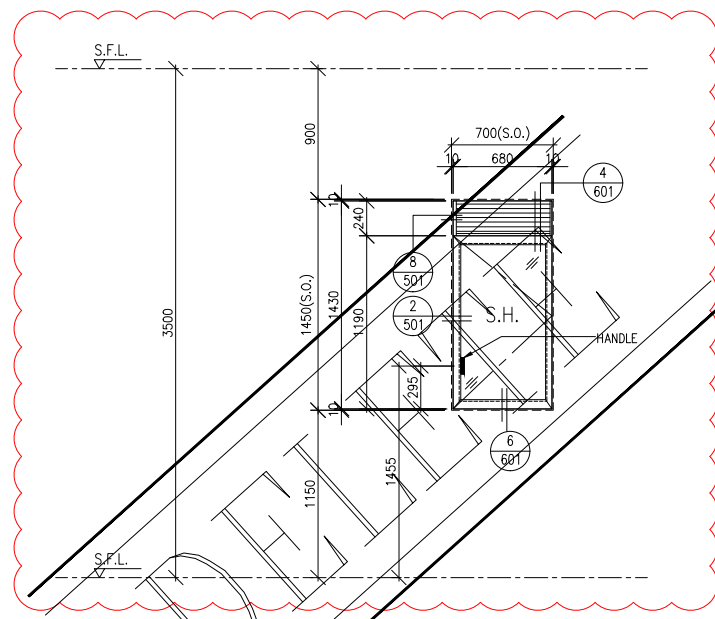

WINDOW MARK	W40A T2 2 nos.
LOCATION	T2 FLAT A BATH. (32/F) T2 FLAT A BATH1. (32/F)
GLAZING	GL06 FRAME AL11
REMARK	65mm ALUM. WINDOW SECTION

WINDOW MARK	
LOCATION	
GLAZING	FRAME
REMARK	

WINDOW MARK	
LOCATION	
GLAZING	FRAME
REMARK	

CLIENT :
佳明集團控股有限公司
GRAND MING GROUP HOLDINGS LIMITED

MAIN CONTRACTOR :
GRAND TECH CONSTRUCTION CO. LTD.

ARCHITECT :
WONG TUNG & PARTNERS LIMITED
ARCHITECTS & PLANNERS

STRUCTURAL ENGINEER :
C M WONG & ASSOCIATES LTD

美特鋁質有限公司
MIDI ALUMINIUM FABRICATOR LTD.
Units 6-8, Sunray Industrial Centre, 1/F
610 Cha Kwo Ling Road, Kowloon
Tel:23489211-4 Fax:(852)27727666

PROJECT :
RESIDENTIAL DEVELOPMENT AT
TSING YI TOWN LOT 190 SAI SHAN ROAD

TITLE :
WINDOW SCHEDULE
FOR PRECAST FACADE
OF T2/T2A (5 OF 6)

JOB NO. : J-851

DRAWN BY : C.H.P. DATE : 30-11-2019

CHKD BY : SCALE A1: A3: 1:30

DWG. NO. : J851-SCH-205 REV. : B

OPENABLE AREA	GLAZING AREA	FREE AREA(%)	OPENABLE AREA	GLAZING AREA	FREE AREA(%)	OPENABLE AREA	GLAZING AREA	
0.69	0.59	57%	0.71	1.36	57%	0.69	0.59	
WINDOW MARK	W52 T2 2 nos.		WINDOW MARK	W53 T2 1 no.		WINDOW MARK	W63 T2 2 nos.	
LOCATION	T2A FLAT B M.BATH. (32-33/F)		LOCATION	T2 FLAT F MBR.(32/F)		LOCATION	T2 FLAT A UTILITY RM (35/F) T2 FLAT A POWDER RM (35/F)	
GLAZING	GL06	FRAME AL11	GLAZING	GL02	FRAME AL11	GLAZING	GL06	FRAME AL11
REMARK	65mm ALUM. WINDOW SECTION		REMARK	65mm ALUM. WINDOW SECTION		REMARK	65mm ALUM. WINDOW SECTION	
FREE AREA(%)	OPENABLE AREA	FREE AREA(%)	OPENABLE AREA	GLAZING AREA	FREE AREA(%)	OPENABLE AREA	GLAZING AREA	
57%	0.47	52%	0.67	1.23	57%	0.69	0.59	
GLAZING AREA	0.38							
WINDOW MARK	W64 T2 2 nos.		WINDOW MARK	W64A T2 1 no.		WINDOW MARK	W73 T2 1 no.	
LOCATION	T2 FLAT B UTILITY RM (35/F) T2 FLAT B UTILITY (35/F)		LOCATION	T2 FLAT A POWDER RM (35/F)		LOCATION	T2 FLAT B LIV. & DIN. (35/F)	
GLAZING	GL06	FRAME AL11	GLAZING	GL06	FRAME AL11	GLAZING		FRAME
REMARK	65mm ALUM. WINDOW SECTION		REMARK	65mm ALUM. WINDOW SECTION		REMARK		

B.D. REF :
F.S.D. REF :

Note :
1.All dimensions are in mm.
2.All elevations are viewed from outside.
3.All dimensions to be verified on site before fabrication.

GENERAL NOTES

Legend :
1. F.F.L.-- Finished Floor Level
2. S.F.L.-- Structural Floor Level
3. (R) -- Reversed Detail

X1 -- DETAIL MARK NO.
X001 -- REFER SHEET NO.

C	18.03.2020	GENERAL REVISION	
B	28.02.2020	GENERAL REVISION	
A	06.02.2020	GENERAL REVISION	
NO.	DATE	REVISED	BY

CLIENT :
佳明集團控股有限公司
GRAND MING GROUP HOLDINGS LIMITED

MAIN CONTRACTOR :
GRAND TECH CONSTRUCTION CO.LTD.

ARCHITECT :
WONG TUNG & PARTNERS LIMITED
ARCHITECTS & PLANNERS

STRUCTURAL ENGINEER :
C M WONG & ASSOCIATES LTD

美特鋁質有限公司
MIDI ALUMINIUM FABRICATOR LTD.
Units 6-8, Sunray Industrial Centre, 1/F
610 Cha Kwo Ling Road, Kowloon
Tel:23489211-4 Fax:(852)27727666

PROJECT :
RESIDENTIAL DEVELOPMENT AT
TSING YI TOWN LOT 190 SAI SHAN ROAD

TITLE :
WINDOW SCHEDULE
FOR PRECAST FACADE
OF T2/T2A (6 OF 6)

JOB NO. : J-851

DRAWN BY : C.H.P. DATE : 30-11-2019

CHKD BY : SCALE A1: A3: 1:30

DWG. NO. : J851-SCH-206 REV. : C

<p>FREE AREA(%) 52%</p>	<p>FREE AREA(%) 52%</p>	<p>FREE AREA(%) 57%</p>	<p>B.D. REF : F.S.D. REF : Note : 1. All dimensions are in mm. 2. All elevations are viewed from outside. 3. All dimensions to be verified on site before fabrication.</p> <p>GENERAL NOTES</p> <p>Legend : 1. F.F.L.-- Finished Floor Level 2. S.F.L.-- Structural Floor Level 3. (R) -- Reversed Detail</p> <p>X1 -- DETAIL MARK NO. X001 -- REFER SHEET NO.</p> <table border="1"> <tr><td>B</td><td>28.02.2020</td><td>GENERAL REVISION</td><td></td></tr> <tr><td>A</td><td>06.02.2020</td><td>GENERAL REVISION</td><td></td></tr> <tr><td>NO.</td><td>DATE</td><td>REVISED</td><td>BY</td></tr> </table>	B	28.02.2020	GENERAL REVISION		A	06.02.2020	GENERAL REVISION		NO.	DATE	REVISED	BY
B	28.02.2020	GENERAL REVISION													
A	06.02.2020	GENERAL REVISION													
NO.	DATE	REVISED	BY												
<p>WINDOW MARK L24 T2 56 nos.</p>	<p>WINDOW MARK L37 T2 29 nos.</p>	<p>WINDOW MARK L37A T2 27 nos.</p>													
<p>LOCATION T2 FLAT A KIT. (1-32/F; 4,13,14,24/F OMITTED)</p>	<p>LOCATION T2 FLAT E BATH. (1-33/F; 4,13,14,24/F OMITTED)</p>	<p>LOCATION T2A FLAT B BATH. (1-31/F; 4,13,14,24/F OMITTED)</p>													
<p>GLAZING FRAME AL11</p>	<p>GLAZING FRAME AL11</p>	<p>GLAZING FRAME AL11</p>													
<p>REMARK 65mm ALUM. WINDOW SECTION</p>	<p>REMARK 65mm ALUM. WINDOW SECTION</p>	<p>REMARK 65mm ALUM. WINDOW SECTION</p>													
<p>FREE AREA(%) 57%</p>			<p>CLIENT : 佳明集團控股有限公司 GRAND MING GROUP HOLDINGS LIMITED</p> <p>MAIN CONTRACTOR : GRAND TECH CONSTRUCTION CO. LTD.</p> <p>ARCHITECT : WONG TUNG & PARTNERS LIMITED ARCHITECTS & PLANNERS WT</p> <p>STRUCTURAL ENGINEER : C M WONG & ASSOCIATES LTD</p> <p>美特鋁質有限公司 MIDI ALUMINIUM FABRICATOR LTD. Units 6-8, Sunray Industrial Centre, 1/F 610 Cha Kwo Ling Road, Kowloon Tel:23489211-4 Fax:(852)27727666</p> <p>PROJECT : RESIDENTIAL DEVELOPMENT AT TSING YI TOWN LOT 190 SAI SHAN ROAD</p>												
<p>WINDOW MARK L37B T2 2 nos.</p>		<p>WINDOW MARK</p>	<p>TITLE : LOUVRE SCHEDULE FOR PRECAST FACADE OF T2/T2A</p>												
<p>LOCATION T2A FLAT B BATH. (32/F & 33/F)</p>		<p>LOCATION</p>	<p>JOB NO. : J-851</p>												
<p>GLAZING FRAME AL11</p>		<p>GLAZING FRAME</p>	<p>DRAWN BY : C.H.P. DATE : 30-11-2019</p>												
<p>REMARK 65mm ALUM. WINDOW SECTION</p>		<p>REMARK</p>	<p>CHKD BY : SCALE A1: A3: 1:30 DWG. NO. : J851-SCH-207 REV. : B</p>												

FREE AREA(%)	OPENABLE AREA	GLAZING AREA	FREE AREA(%)	OPENABLE AREA	GLAZING AREA	OPENABLE AREA	GLAZING AREA	
57%	0.72	1.31	57%	0.69	0.59	0.69	0.59	
WINDOW MARK	W2 MIR. T2 81 nos.		WINDOW MARK	W10 MIR. T2 54 nos.		WINDOW MARK	W22 MIR. T2 27 nos.	
LOCATION	T2A FLAT C&E MBR. (1-31/F & 33/F; 4,13,14,24/F OMITTED) T2 FLAT G MBR. (1-31/F & 33/F; 4,13,14,24/F OMITTED)		LOCATION	T2 FLAT A BATH1.(1-31/F; 4,13,14,24/F OMITTED) T2 FLAT D M.BATH.(2-31/F; 4,13,14,24/F OMITTED) T2A FLAT C MBR.(32/F)		LOCATION	T2A FLAT B BATH1.(1-31/F; 4,13,14,24/F OMITTED)	
GLAZING	GL02	FRAME AL11	GLAZING	GL06	FRAME AL11	GLAZING	GL06	FRAME AL11
REMARK	65mm ALUM. WINDOW SECTION		REMARK	65mm ALUM. WINDOW SECTION		REMARK	65mm ALUM. WINDOW SECTION	
FREE AREA(%)	OPENABLE AREA	GLAZING AREA	FREE AREA(%)	OPENABLE AREA	GLAZING AREA	OPENABLE AREA	GLAZING AREA	
57%	0.73	1.33	57%	0.69	0.59	0.69	0.59	
WINDOW MARK	W32 MIR. T2 3 nos.		WINDOW MARK	W40 MIR. T2 2 nos.		WINDOW MARK	W52 MIR. T2 2 nos.	
LOCATION	T2A FLAT C,E MBR.(32/F) T2 FLAT G MBR.(32/F)		LOCATION	T2 FLAT D M.BATH. (32/F) T2 FLAT A BATH.1 (32/F)		LOCATION	T2A FLAT B BATH1. (32-33/F)	
GLAZING	GL02	FRAME AL11	GLAZING	GL06	FRAME AL11	GLAZING	GL06	FRAME AL11
REMARK	65mm ALUM. WINDOW SECTION		REMARK	65mm ALUM. WINDOW SECTION		REMARK	65mm ALUM. WINDOW SECTION	

B.D. REF :
F.S.D. REF :
Note :
1.All dimensions are in mm.
2.All elevations are viewed from outside.
3.All dimensions to be verified on site before fabrication.

GENERAL NOTES
Legend :
1. F.F.L.-- Finished Floor Level
2. S.F.L.-- Structural Floor Level
3. (R) -- Reversed Detail
X1 -- DETAIL MARK NO.
X001 -- REFER SHEET NO.

NO.	DATE	REVISED	BY

CLIENT :
佳明集團控股有限公司
GRAND MING GROUP HOLDINGS LIMITED

MAIN CONTRACTOR :
GRAND TECH CONSTRUCTION CO.LTD.

ARCHITECT :
WONG TUNG & PARTNERS LIMITED
ARCHITECTS & PLANNERS
WT

STRUCTURAL ENGINEER :
C M WONG & ASSOCIATES LTD

美特鋁質有限公司
MIDI ALUMINIUM FABRICATOR LTD.
Units 6-8, Sunray Industrial Centre, 1/F
610 Cha Kwo Ling Road, Kowloon
Tel:23489211-4 Fax:(852)2727666

PROJECT :
RESIDENTIAL DEVELOPMENT AT
TSING YI TOWN LOT 190 SAI SHAN ROAD

TITLE :
WINDOW SCHEDULE
FOR PRECAST FACADE
OF T2/T2A

JOB NO. : J-851
DRAWN BY : C.H.P. DATE : 30-11-2019
CHKD BY : SCALE A1: A3: 1:30
DWG. NO. : J851-SCH-208 REV. : -

