

工程指示 / 要求簡箋(E.I.)

工程指示編號：EI / 2605 / 21 修改版次：C

工程編號：J851 工程名稱：青衣明翹匯

工程項目：露台欄河 - 訂購地盤用鐵件 (35/F)

收件人：Maggie Lor (羅小姐) 發件人：Yancy Chen 日期：19/01/2021

要求提供 / 確認 事項：

- | | | |
|------------------------------------|-------------------------------------|-------------------------------|
| <input type="checkbox"/> 初步鋁料 B.M. | <input type="checkbox"/> 加工拆圖，然後生產 | <input type="checkbox"/> 尺寸表 |
| <input type="checkbox"/> 正式鋁料 B.M. | <input type="checkbox"/> 技術上資料 / 指示 | <input type="checkbox"/> 報價 |
| <input type="checkbox"/> 配件 B.M. | <input type="checkbox"/> 樣辦或貨品說明書 | <input type="checkbox"/> 分判合約 |
| <input type="checkbox"/> 其他：_____ | | |

內容：

根據 CVI-241 指示，按附件加工圖修改 15mm 厚鐵巴，數量 710 件。

請在 10/2/2021 前完成上列要求。

附：

1+ 4頁

以上項目為：

- 原合約工程包 原合約工程加 / 減賬 新工程報價

原因：-

分發東莞各部門：

- () 生產技術總監 連附件 () 技術部 連附件 () 生產部 連附件 () 機械設計部 連附件
 () 採購部 連附件 () 生產統籌部 連附件
 () 質檢部 連附件 () 會計部 連附件 () 報關組 連附件 () 其他 _____ 連附件

分發香港各部門：

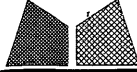
- () 行政部 連附件 () 會計部 連附件 () 統籌部 連附件 () 工程部地盤科文 連附件 羅哥
 () 採購部 連附件 () QS 部 連附件 () 維修部 連附件 () 其他 _____ 連附件

傳遞編號：

發件人簽署：

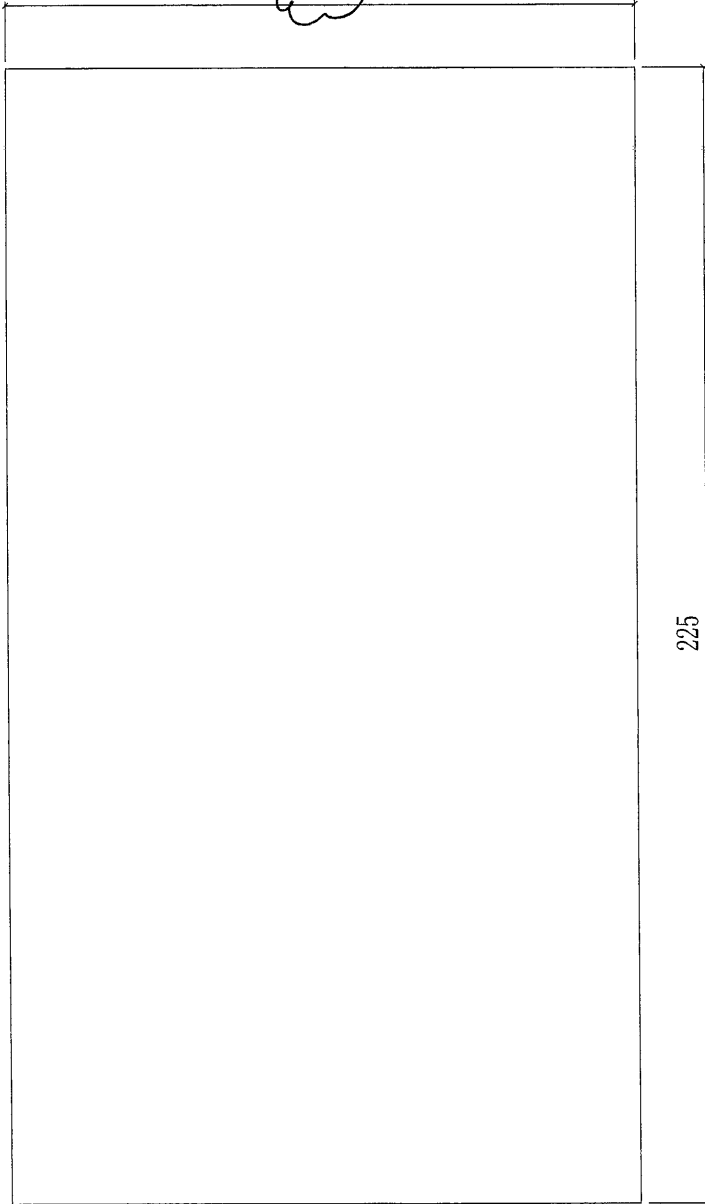
項目經理簽署：

Yancy Chen
[Signature]

 美特鋁質有限公司 MIDI Aluminium Fabricator Ltd.				工程號	J851	類別		物料號	-					
				地盘	青衣190	制圖	W. E. X	2020-10-08	圖號	FR-S01				
修改	+	-	-	採用工廠		地盤	✓	圖紙名稱	铁件加工图	復核	-	-	數量	680+30
日期	19/01	-	-	材料颜色	热浸锌	材料	15mm厚铁巴	批准	-	-	單件重量	2.94	(KG)	

舊圖是150, 現在要改成109

109



109

CONFIRMATION OF INSTRUCTION

To : Wong Tung & Partners Limited
Attn. : Mr. Bryan Lau/Mr. Eric Chan

Ref. : GTC/TYTL190/3.2/CVI-241
Date : 6/1/2021

C.C. :

<input checked="" type="checkbox"/> DMDL(w/o)	<input type="checkbox"/> WTP (by email)	<input type="checkbox"/> OPL (by email)	<input type="checkbox"/> Alpha (by email)
<input type="checkbox"/> CMW(by email)	<input type="checkbox"/> WSP (by email)	<input checked="" type="checkbox"/> MIDI (by email)	<input type="checkbox"/> Ever Rich (by email)
<input type="checkbox"/> ALN(by email)	<input type="checkbox"/> KIRA(by email)	<input type="checkbox"/> Dynamic (by email)	<input type="checkbox"/> HITACHI (by email)
<input checked="" type="checkbox"/> Site(by email)	<input type="checkbox"/> RE (by email)	<input type="checkbox"/> Mang Yip (by email)	

We acknowledge receipt of the following instruction:

Date instructed : 29/12/2020
By : Mr. Bryan Lau
of Company : WTP
Ref. : Site meeting on 2020/12/29
Subject : 1. Clarification of level and sectional detail of parapet wall at roof floor
2. Clarification of finishing material for glass balustrade at 35/F
3. Revised layout plan of flat roof and window at 35/F of T2A-A

Description & details

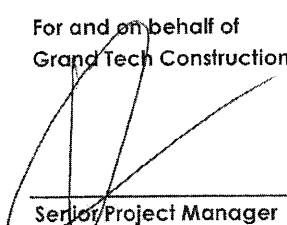
1. The parapet wall at roof floor shall be constructed according to the mark-up drawing : SK-CVI-241-1 to 3.
2. The glass balustrade at 35/F shall be constructed according to the mark-up drawing : SK-CVI-241-4 to 6.
3. The layout plan of flat roof and window at 35/F of T2A-A shall be revised according to the mark-up drawing : SK-CVI-241-7 for construction.

Please note that

<input type="checkbox"/>	Abortive work will result
<input type="checkbox"/>	Cost effect is expected. The assessment of which will be submitted in due course.
<input type="checkbox"/>	Time effect is expected. The assessment of which will be submitted in due course.
<input checked="" type="checkbox"/>	No time or cost effect expected

Please issue formal A.I.(s) to cover the above instruction within 7 days, otherwise it is our understanding that the content above will be treated as an Architect's Instruction.

For and on behalf of
Grand Tech Construction Co., Ltd.


Senior Project Manager
Elvis Koo

Proposed Residential Development at Tsing Yi Town
Lot 190 Sai Shan Road

 佳盛建築有限公司
GRAND TECH CONSTRUCTION CO., LTD.

