

工程指示 / 要求簡箋(E.I.)

工程指示編號：EI / 2702 / 21

修改版次：C

工程編號：J851

工程名稱：青衣明翹匯

工程項目：35/F 趟折門 - 加工圖

收件人：生統

發件人：Yancy Chen

日期：05/03/2021

要求提供 / 確認 事項：

- | | | |
|------------------------------------|-------------------------------------|-------------------------------|
| <input type="checkbox"/> 初步鋁料 B.M. | <input type="checkbox"/> 加工拆圖，然後生產 | <input type="checkbox"/> 尺寸表 |
| <input type="checkbox"/> 正式鋁料 B.M. | <input type="checkbox"/> 技術上資料 / 指示 | <input type="checkbox"/> 報價 |
| <input type="checkbox"/> 配件 B.M. | <input type="checkbox"/> 樣辦或貨品說明書 | <input type="checkbox"/> 分判合約 |
| <input type="checkbox"/> 其他：_____ | | |

內容：

根據地盤復尺，請按附頁修改尺寸加工。

請在 10/03/2021 前完成上列要求。

附：-

1+5 頁

以上項目為：

- 原合約工程包 原合約工程加 / 減賬 新工程報價

原因：-

分發東莞各部門：

- 生產技術總監 連附件 技術部 連附件 生產部 連附件 機械設計部 連附件
 採購部 連附件 生產統籌部 連附件
 質檢部 連附件 會計部 連附件 報關組 連附件 其他 _____ 連附件

分發香港各部門：


- 行政部 連附件 會計部 連附件 統籌部 連附件 工程部地盤科文 連附件 **積子**
 採購部 連附件 QS 部 連附件 維修部 連附件 其他 _____ 連附件

傳遞編號：

HK 0431 / 21

發件人簽署：Yc

項目經理簽署：仲

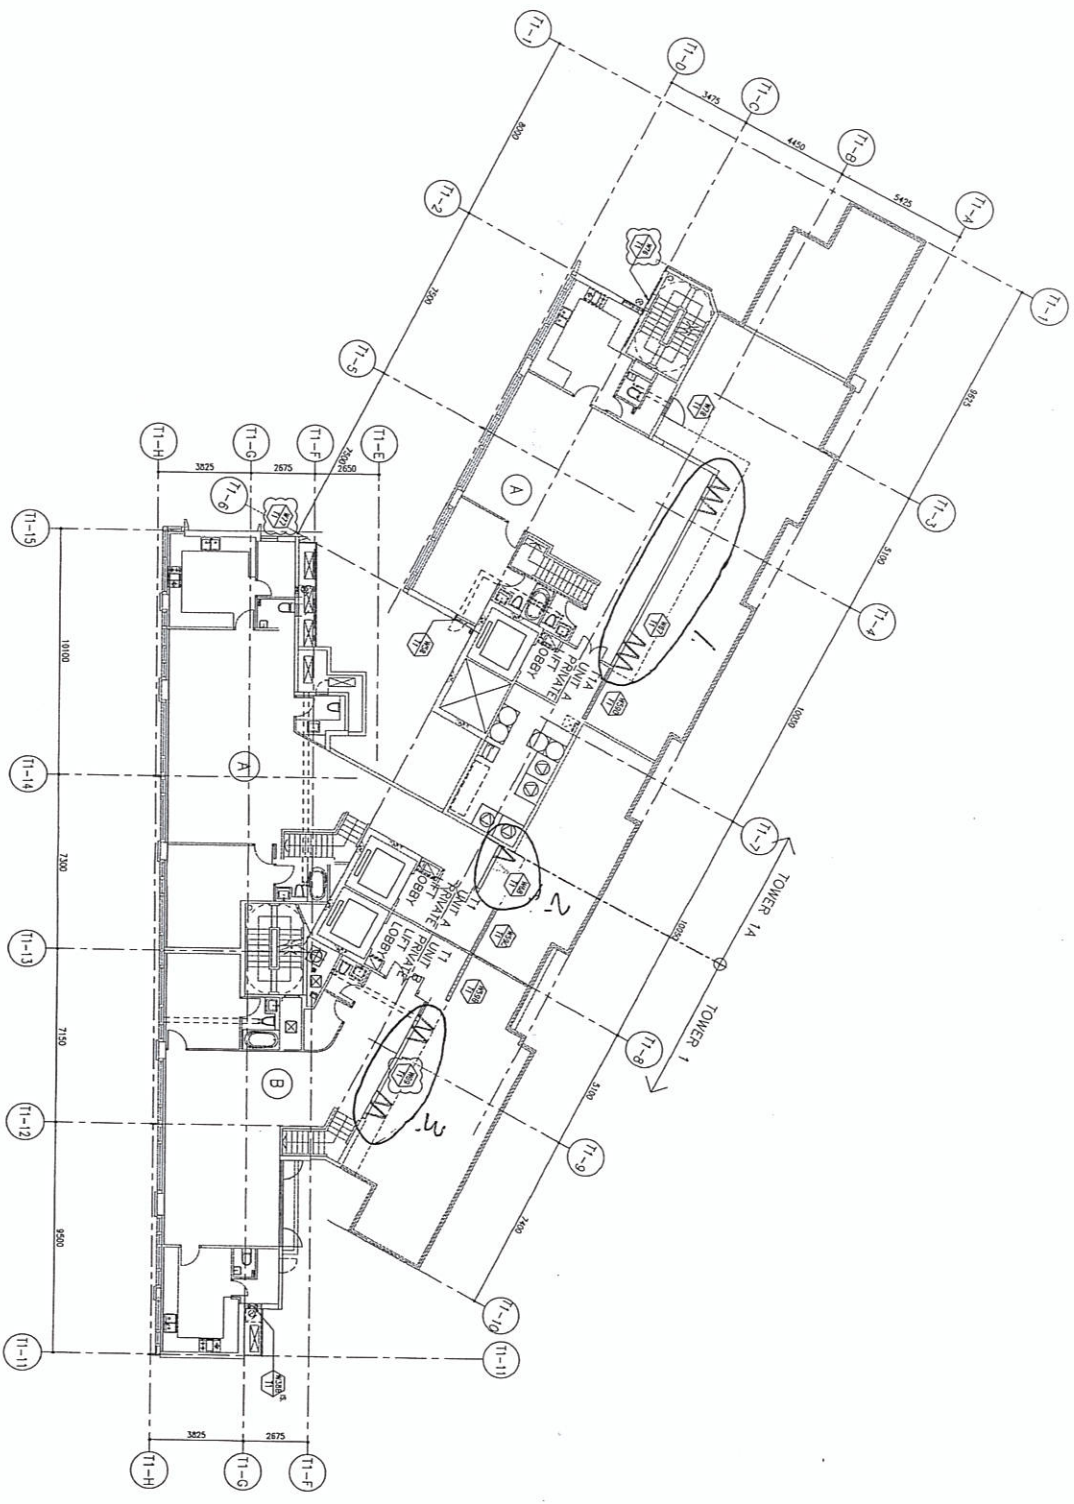

T1/T1A 35/F PLAN

3.D. REF :
 F.S.O. REF :
 Scale :
 1. All dimensions are in mm.
 2. All finishes are viewed from outside.
 3. All dimensions to be verified on site before construction.
 GENERAL NOTES


- Legend :
- 1. FFL -- Finished Floor Level
 - 2. SFL -- Structural Floor Level
 - 3. Ⓞ -- Room Detail
 - X1 -- DETAIL WORK NO.
 - X001 -- RETURN SHEET NO.
 - AREA -- FINISH WORK

NO.	REVISION	DATE	BY
1	ISSUE FOR PERMIT		
2	GENERAL DESIGN		
3	GENERAL DESIGN		
CLIENT :
 佳明集團控股有限公司
 GRAND MING GROUP HOLDINGS LIMITED
 MAIN CONTRACTOR :
 GRAND TECH CONSTRUCTION CO. LTD.
 ARCHITECT :
 WONG TUNG & PARTNERS LIMITED
 STRUCTURAL ENGINEER :
 C H WONG & ASSOCIATES LTD
 黃特經 經理 有限公司
 MIDJ Attention: YANIKOR TAN
 Unit 8, 8/F, Sanyang Industrial Building, 1/F
 810 On Yee Street, Tsim Sha Tsui, Kowloon, H.K.
 Tel: 23489211-4 Fax: 23489212-66

PROJECT :
 RESIDENTIAL DEVELOPMENT AT
 TENING TOWN LOT 183 SHAN SHAN ROAD
 TITLE :
 WINDOW LOCATION PLAN
 OF TOWER 1 / TOWER 1A (35/F)
 JOB NO. : J-451
 DRAWING BY : DATE : 2-12-2019
 CHECK BY : SCALE : A1:1/500
 A1:1/500
 DMC NO. : 8594-W-07
 REV. : E

OPENABLE AREA GLAZING AREA
13.87 9.89

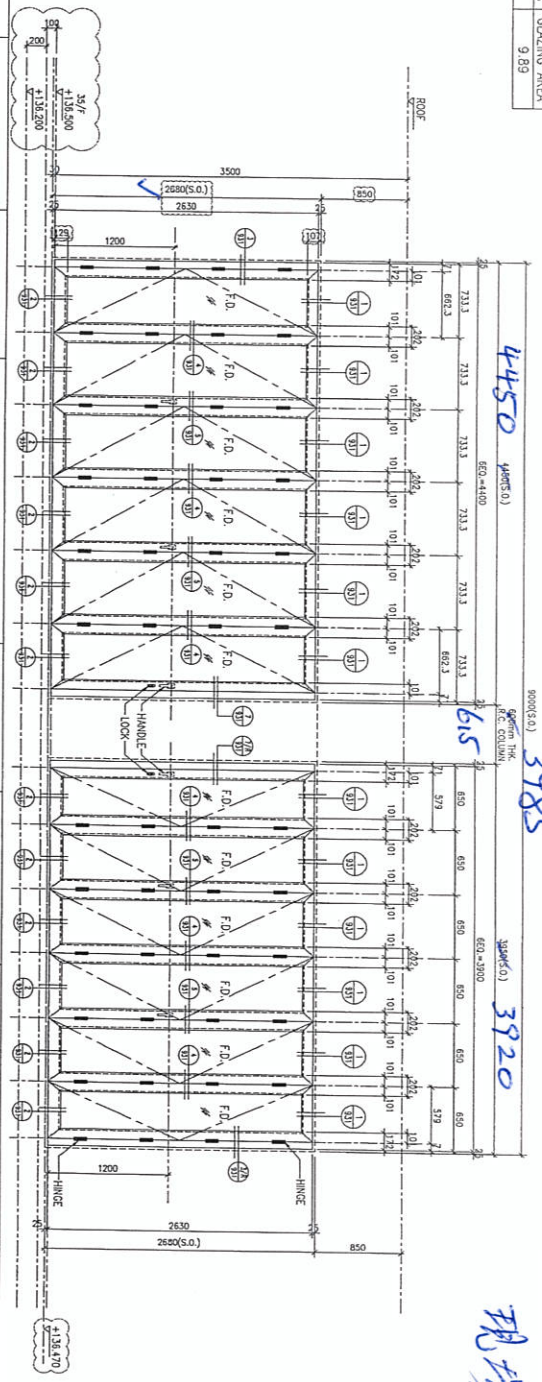


WINDOW MARK W667
GLAZING G102
REMARK SITE IN-SITU WINDOW

LOCATION TOWER 1A FLAT A LV. & DIN(35/F)
FRAME AL11

WINDOW MARK W667
GLAZING G102
REMARK SITE IN-SITU WINDOW

OPENABLE AREA GLAZING AREA
3.13 2.13

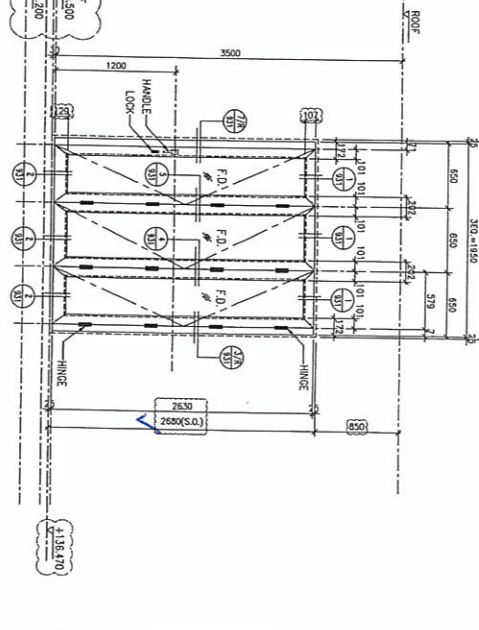


WINDOW MARK W668
GLAZING G102
REMARK SITE IN-SITU WINDOW

LOCATION TOWER 1 FLAT A LV. & DIN(35/F)
FRAME AL11

WINDOW MARK W668
GLAZING G102
REMARK SITE IN-SITU WINDOW

OPENABLE AREA GLAZING AREA
6.73 3.92

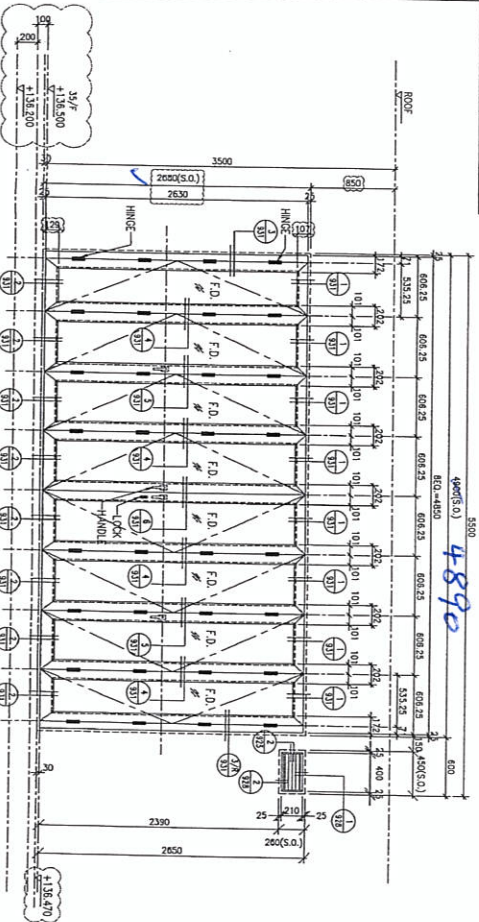

WINDOW MARK W669
GLAZING G102
REMARK SITE IN-SITU WINDOW

LOCATION TOWER 1 FLAT B LV. & DIN(35/F)
FRAME AL11

REMARK SITE IN-SITU WINDOW

3.D. REF :
F.S.D. REF :
1. All dimensions are in mm.
2. All dimensions are viewed from outside.
3. All dimensions to be verified on site before fabrication.

GENERAL NOTES

Legend :
1. FTL - Fixed floor level
2. FTL - Structural floor level
3. RL - Revised level

X1 - DETAIL MARK NO.
X001 - REFER SHEET NO.

SEE --- SEE FIRST DRAWING CLASS (Special) /
DOAS DETAIL WINDOW FRAME IN W/F27 FIRST

DATE : 4/3/21

CLIENT : 佳明集團控股有限公司
GRAND MING GROUP HOLDINGS LIMITED

MAIN CONTRACTOR : GRAND TECH CONSTRUCTION CO. LTD.

ARCHITECT : WONG TUNG & PARTNERS LIMITED
ARCHITECTS & PLANNERS

STRUCTURAL ENGINEER : C M WONG & ASSOCIATES LTD

UNITED MIDD 英特經貿有限公司
Units 8-9, Sunny Industrial Centre, 1/F
810 Chee Kwoong Road, Kowloon, HONG KONG
Tel: (852) 2391-1114 Fax: (852) 27172188

PROJECT : RESIDENTIAL DEVELOPMENT AT
TUNG YI TOWN, LOT 190 SAN SHAN ROAD

TITLE : WINDOW SCHEDULE
OF TOWER 1 / TOWER 1A
AND TOWER 2 / TOWER 2A

JOB NO. : J-851
DRAWN BY :
DATE : 2-12-2019
SCALE : As Shown
CHKD BY :
DATE :
DWG. NO. : J851-W-121 REV. : E

