

工程指示 / 要求簡箋(E.I.)

工程指示編號：EI / 2793 / 21      修改版次：A  
 工程編號      : J851                      工程名稱    : 青衣明翹匯  
 工程項目      : 平台 Window Wall+更亭 - 廠用玻璃 BM  
 收件人         : Maggie Lor (羅小姐)      發件人      : Yancy Chen      日期        : 04/03/2021

要求提供 /  確認 事項：

- |                                    |                                     |                               |
|------------------------------------|-------------------------------------|-------------------------------|
| <input type="checkbox"/> 初步鋁料 B.M. | <input type="checkbox"/> 加工拆圖，然後生產  | <input type="checkbox"/> 尺寸表  |
| <input type="checkbox"/> 正式鋁料 B.M. | <input type="checkbox"/> 技術上資料 / 指示 | <input type="checkbox"/> 報價   |
| <input type="checkbox"/> 配件 B.M.   | <input type="checkbox"/> 樣辦或貨品說明書   | <input type="checkbox"/> 分判合約 |
| <input type="checkbox"/> 其他：_____  |                                     |                               |

內容：

請按附件修改 BM 表及圖紙，可加工。

請在 15/3/2021 前完成上列要求。

附：

1+ 10 頁

以上項目為：

- 原合約工程包                       原合約工程加 / 減賬                       新工程報價

原因：-

分發東莞各部門：

- ( ) 生產技術總監  連附件    ( ) 技術部     連附件    ( ) 生產部     連附件    ( ) 機械設計部  連附件  
 ( ) 採購部     連附件    (✓) 生產統籌部  連附件    *梅軍*  
 ( ) 質檢部     連附件    ( ) 會計部     連附件    ( ) 報關組     連附件    ( ) 其他 \_\_\_\_\_  連附件

分發香港各部門：

- ( ) 行政部  連附件    ( ) 會計部  連附件    ( ) 統籌部  連附件    ( ) 工程部地盤科文     連附件  
 ( ) 採購部  連附件    ( ) QS 部  連附件    ( ) 維修部  連附件    ( ) 其他 \_\_\_\_\_  連附件

傳遞編號：

*HK 0413 / 21*


發件人簽署：

*Yancy Chen*


項目經理簽署：

*[Signature]*

第一頁 訂貨 BM

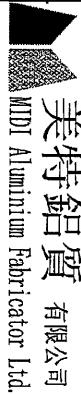 <b>美特鋁質有限公司</b> MIDI Aluminium Fabricator Ltd.		工程號:	J-851		計算:	HHQ		日期:	08/12/2020		送呈:	施哥		
<b>廠用玻璃B.M.表</b>		地盤名稱:	青衣明邨匯		核對:			日期:			副本:			
		項目類別:	WINDOW WALL+更亭		批准:			日期:			A/C Code:			
BM編號:		修改版次:	E12793 A版次		總計玻璃面積 (平方米):				200.981		此BM依據 20210204收到6th 修改			
序號	修改內容	玻璃圖號	顏色與類型	厚度 (mm)		玻璃尺寸		數量 (塊)	總面積 (平方米)	備注				
				寬度 (mm)	高度 (mm)	寬度 (mm)	高度 (mm)							
1	A(修改)	J851-WW-G01	15mm THK. CLEAR TEMPERED GLASS	15	654.0	3783.0	3783.0	1	2.474					
2	A(修改)	J851-WW-G02		15	1755.0	338.0	338.0	1	0.593					
3	A(修改)	J851-WW-G03		15	1755.0	978.0	978.0	1	1.716					
4	A(修改)	J851-WW-G04		15	645.0	3783.0	3783.0	1	2.440					
5	A(修改)	J851-WW-G05		15	664.5	3783.0	3783.0	1	2.514					
6	A(修改)	J851-WW-G06	15mm THK. GREY BLUE TEMPERED GLASS	15	1675.0	738.0	738.0	1	1.236					
7	A(修改)	J851-WW-G07		15	1675.0	578.0	578.0	1	0.968					
8	A(修改)	J851-WW-G08		15	664.5	3783.0	3783.0	1	2.514					
9	A(修改)	J851-WW-G09		15	830.0	2345.0	2345.0	1	1.946					
9	A(新增)	J851-WW-G09a		15	830.0	3423.0	3423.0	1	2.841					
10	A(修改)	J851-WW-G10	12mm THK. CLEAR TEMPERED GLASS	15	1675.0	2338.0	2338.0	1	3.916					
11	A(修改)	J851-WW-G11		15	1675.0	978.0	978.0	1	1.638					
12	A(修改)	J851-WW-G12		15	839.5	2345.0	2345.0	1	1.969					
12a	A(新增)	J851-WW-G12a		15	839.5	3423.0	3423.0	1	2.874					
13	A(修改)	J851-WW-G13		12	1339.0	3523.0	3523.0	4	18.869					
14	A(修改)	J851-WW-G14	12mm THK. CLEAR TEMPERED GLASS	12	1339.0	1078.0	1078.0	1	1.443					
15	A(修改)	J851-WW-G16		12	1427.5	3523.0	3523.0	4	20.116					
16	A(修改)	J851-WW-G17		12	1334.0	3523.0	3523.0	5	23.498					
17	A(修改)	J851-WW-G18		12	1154.0	1617.5	1617.5	2	3.733					
18		J851-WW-G19		12	980.0	1851.0	1851.0	2	3.628		門玻璃			
19	A(修改)	J851-WW-G20	12	1154.0	3502.0	3502.0	19	76.785						

110  
第二頁訂貨 BM

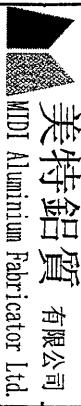 <b>美特鋁質有限公司</b> MIDI Aluminium Fabricator Ltd		<b>工程號:</b> J-851	<b>計算:</b> HHQ	<b>日期:</b> 08/12/2020	<b>送呈:</b> 施哥				
<b>廠用玻璃B.M.表</b>		<b>地盤名稱:</b> 青衣明耀匯	<b>核對:</b>	<b>日期:</b>	<b>副本:</b>				
<b>項目類別:</b> WINDOW WALL+更亭		<b>批准:</b>	<b>日期:</b>	<b>A/C Code:</b>					
<b>BM編號:</b>	<b>修改版次:</b> EI2793 A版次	<b>總計玻璃面積 (平方米):</b> 200.981		此BM依據 20210204收到6th 修改					
序號	修改內容	玻璃圖號	顏色與類型	厚度 (mm)	玻璃尺寸		數量 (塊)	總面積 (平方米)	備注
					寬度 (mm)	高度 (mm)			
20	A(修改)	J851-WW-G21	12mm THK. CLEAR TEMPERED GLASS	12	554.0	2202.5	1	1.220	
21	A(修改)	J851-WW-G22		12	1156.0	2202.5	6	15.277	
22	A(修改)	J851-WW-G23		12	1044.0	2202.5	1	2.299	
23	新增	J851-LGW2-G1	10mm THK. CLEAR TEMPERED GLASS	10	710.0	2302.0	1	1.634	更亭門窗玻璃
24	新增	J851-LGW3-G1		10	832.0	467.0	1	0.389	更亭門窗玻璃
25	新增	J851-LGW4-G1		10	466.0	934.0	2	0.870	更亭門窗玻璃
26	新增	J851-LGW4-G2	8mm THK. CLEAR TEMPERED GLASS	10	429.0	934.0	3	1.202	更亭門窗玻璃
27	新增	J851-LGW3-G2		12	574.0	328.0	2	0.377	更亭門窗玻璃
1).本表中所有玻璃對角線尺寸偏差要求不超過正負2mm。 2).本表中玻璃要求粗磨邊處理並倒棱角。 3).本表中所有強化玻璃均需HEAT SOAK TEST。 4).本表中所有強化玻璃之入爐方向均以寬度方向進入。 5).本表中所有玻璃成品送交東莞美而特廠，每次交貨時須齊層、齊款、齊數量，每次來貨之具體數量由美而特廠生產統籌部提供。 6).本表中所有玻璃成品均需注明室內外面及其玻璃編號，以便識別。									

BD. REF :  
 F.S.D. REF :  
 Note:  
 1. All dimensions are in mm.  
 2. All elevations are viewed from outside.  
 3. All dimensions to be verified on site before fabrication.  
 GENERAL NOTES

- Legend :
- 1. FFL --- Finished floor level
  - 2. SFL --- Structural floor level
  - 3. (7) --- Proposed level
- X1 --- METAL WORK NO.  
 X001 --- SHEET NO.
- DK-12 --- DARK TYPHOON (P)  
 DK-13 --- DARK TYPHOON (F)  
 DK-17 --- DARK TYPHOON (F)  
 DK-27 --- DARK TYPHOON (F)  
 DK-28(20) --- DARK TYPHOON (X20)

E 12-01-2021 AS PER ARCHITECT COMMENTS	BY : [Signature]	DATE :
O 08-01-2021 AS PER ARCHITECT COMMENTS	BY : [Signature]	DATE :
G 05-01-2021 AS PER ARCHITECT COMMENTS	BY : [Signature]	DATE :
A 21-01-2021 AS PER ARCHITECT COMMENTS	BY : [Signature]	DATE :
NO. _____	BY : _____	DATE : _____
DATE : _____	REVISION :	

CLIENT :  
 佳明集團控股有限公司  
 GRAND MINE GROUP HOLDINGS LIMITED

MAIN CONTRACTOR :  
 GRAND TECH CONSTRUCTION CO. LTD.

ARCHITECT :  
 WONG THINE & PARTNERS LIMITED  
 WPT



STRUCTURAL ENGINEER :  
 C M WONG & ASSOCIATES LTD

美特經貿有限公司  
 MTDI Architectural Fabrication Ltd.  
 Unit 6-8, Sunny Industrial Centre, 1/F  
 810 Cheung Kuo Ling Road, Kowloon  
 Tel: 23248921-4 Fax: (852) 27277666

PRODUCT :  
 RESIDENTIAL DEVELOPMENT AT  
 TIAN'S TOWN LOT 180 SHAN ROAD

TITLE :  
 PARTIAL ELEVATION, SECTION & PLAN  
 FOR WINDOW WALL



JOB NO. :	J-851
ISSUED BY :	LS
DATE :	22-06-2020
SCALE :	A1 : 1:50
DWG. NO. :	J851-WW-F02
REV. :	E

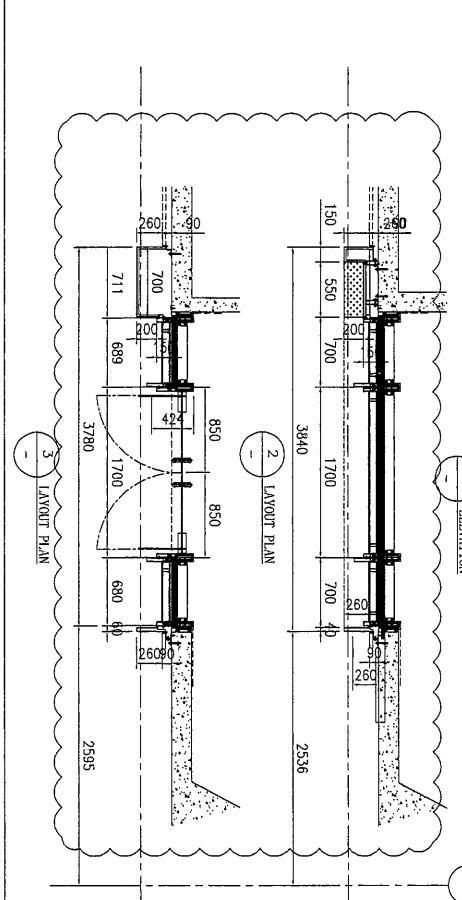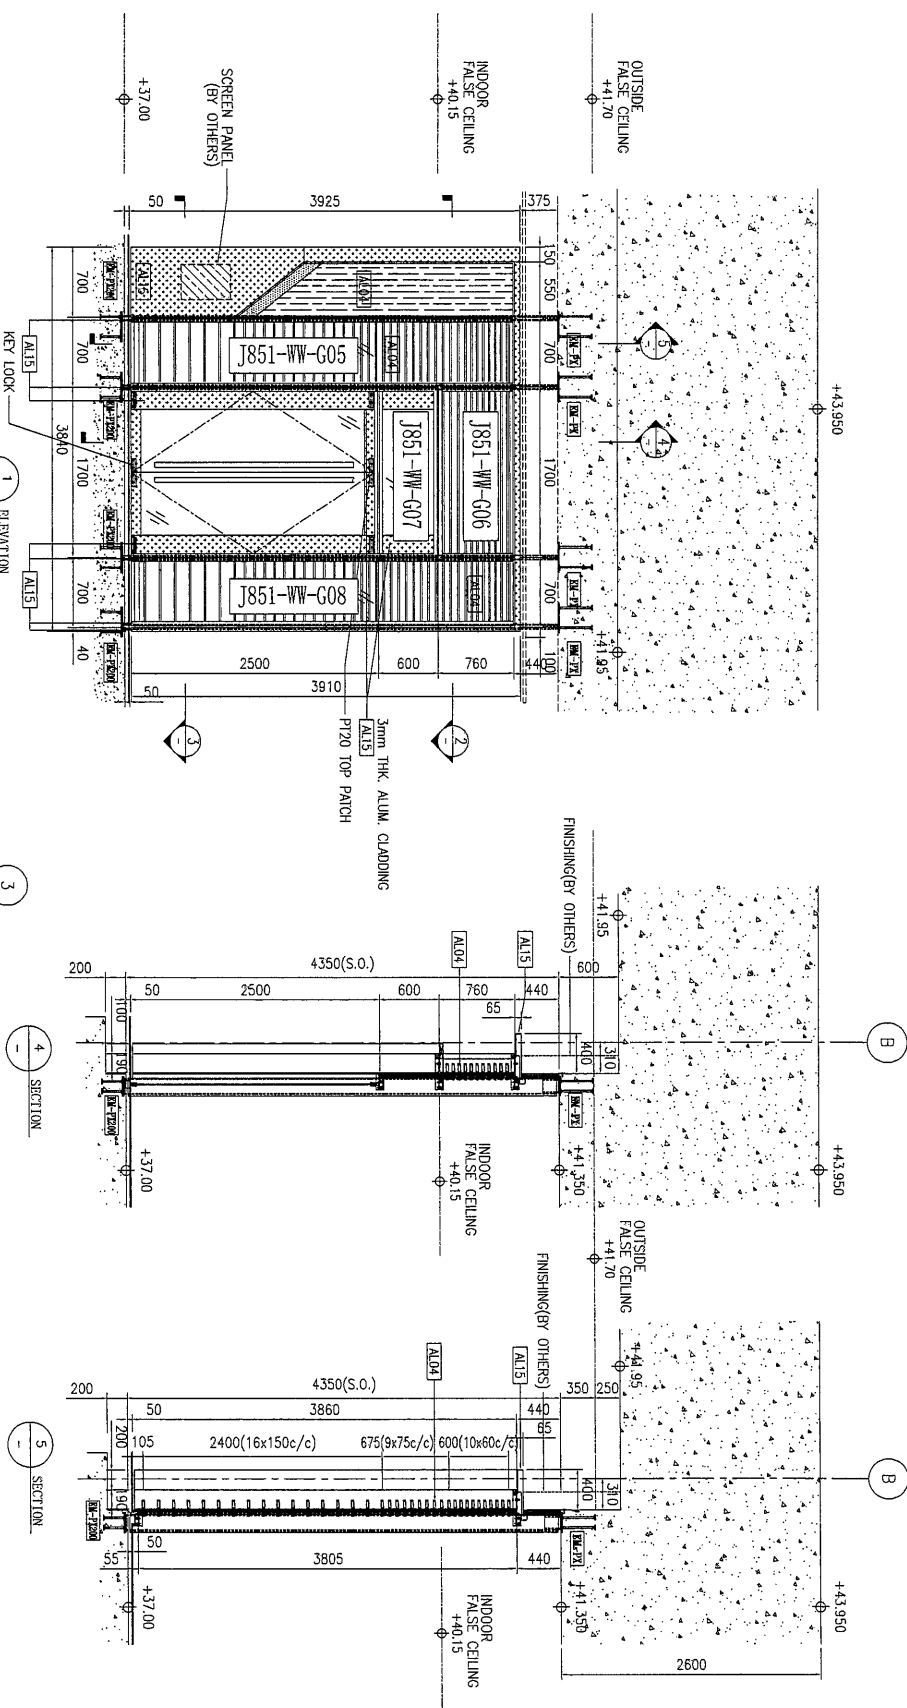

GLASS WALL MARK	AW1
LOCATION	T1 LIFT LOBBY @ UPPER GROUND FLOOR
AMOUNT	1 NOS.
GLASS	G102-12mm THK. GRFY BLUE TEmPERED GLASS
COLOR CODE	AL151-DARK BRONZE




LEGEND	12mm THK. TEMPERED GLASS
3mm THK. ALUM. CLADDING	3mm THK. ALUM. CLADDING
ALUM. GRATES	ALUM. GRATES
15mm THK. ALUM. FLASHING	15mm THK. ALUM. FLASHING



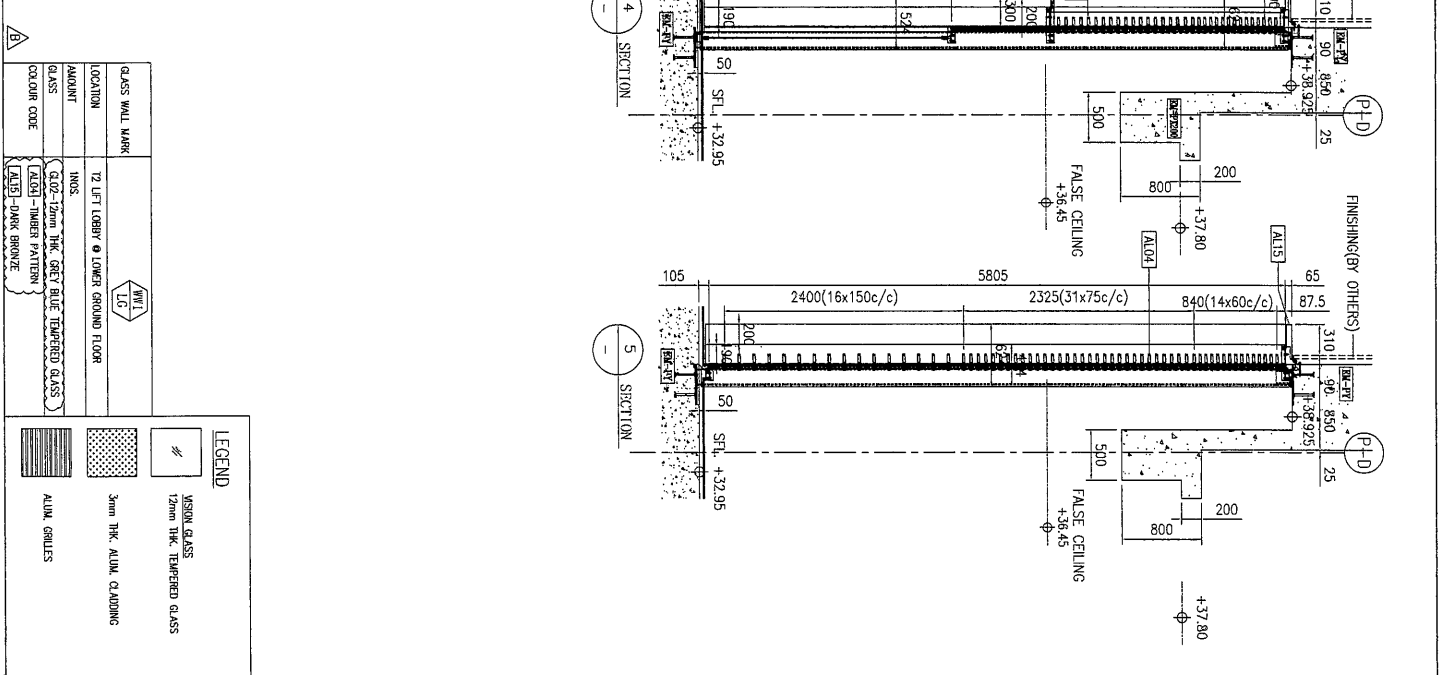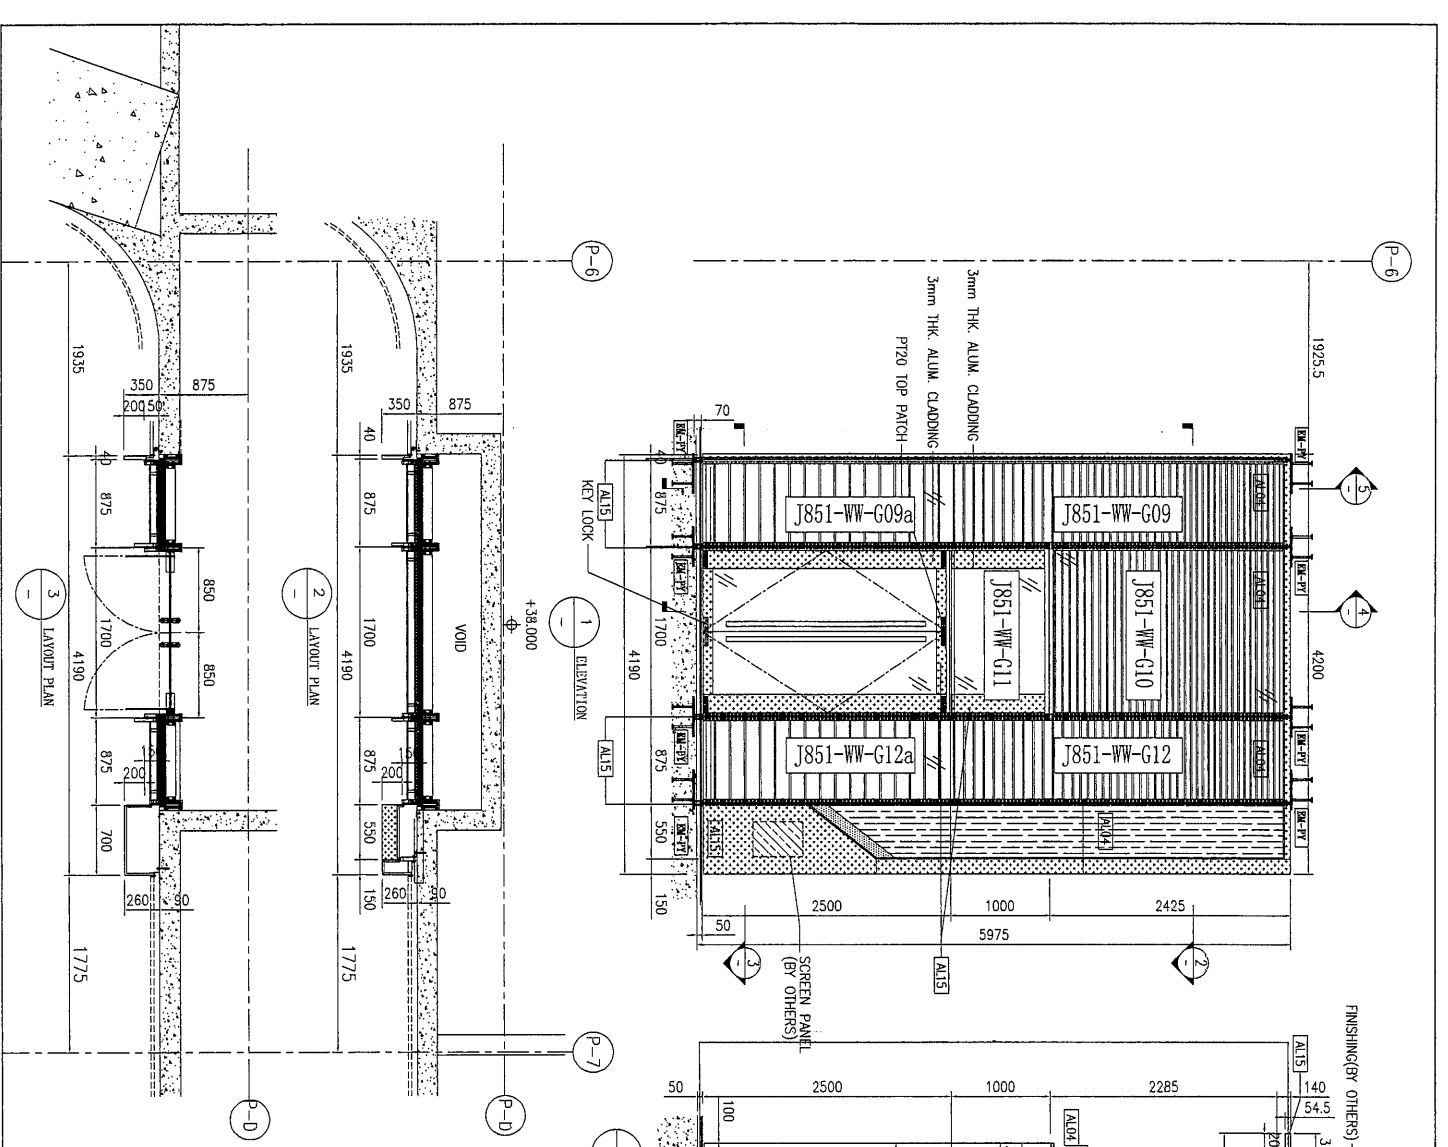

<b>GLASS WALL MARK</b> LOCATION: TO LEFT LOBBY @ LOWER GROUND FLOOR AMOUNT: 10MS GLASS: 6.02-12mm THK, ONE' BLUE TINTED GLASS COLOUR CODE: AL03-DARK BRONZE		<b>LEGEND</b> VISION GLASS 12mm THK TEMPERED GLASS 3mm THK ALUM. CLADDING ALUM. GRILLS	
<b>PROJECT:</b> RESIDENTIAL DEVELOPMENT AT TSING NI TOWN LOT 190 SHAN SHAN ROAD		<b>CLIENT:</b> 佳明集團控股有限公司 GRAND HING GROUP HOLDINGS LIMITED	
<b>ARCHITECT:</b> WING TUNG & PARTNERS LIMITED ARCHITECTS IN CHARGE		<b>MAIN CONTRACTOR:</b> GRAND TECH CONSTRUCTION CO. LTD.	
<b>STRUCTURAL ENGINEER:</b> CMA C M WONG & ASSOCIATES LTD		<b>DATE:</b> 11/11/2021	
<b>JOB NO.:</b> J-551		<b>SCALE:</b> A1: 1/50	
<b>DATE:</b> 22-06-2020		<b>REV.:</b> E	

1. All dimensions are in mm.  
 2. All elevations are viewed from outside.  
 3. All dimensions to be verified on site before fabrication.  
**GENERAL NOTES**  
 Legend:  
 1. F51 - Finished floor level  
 2. SFL - Standard floor level  
 3. F - Finished level  
 4. F - Finished level  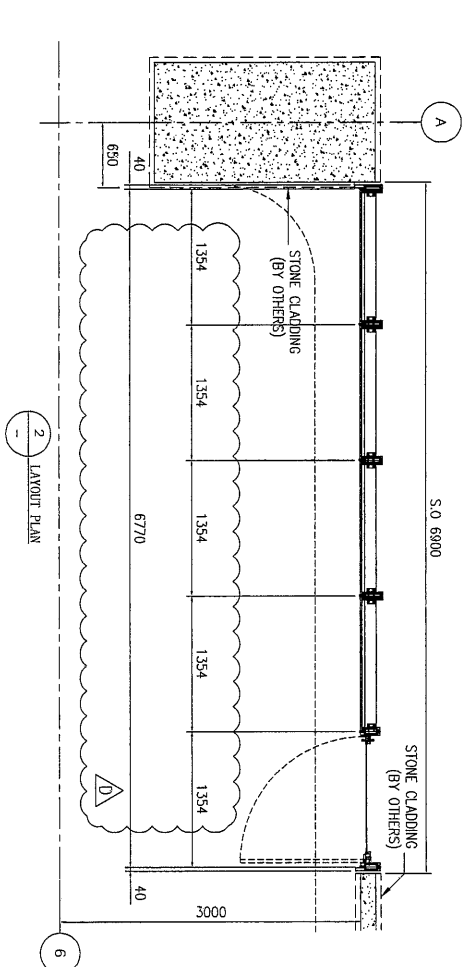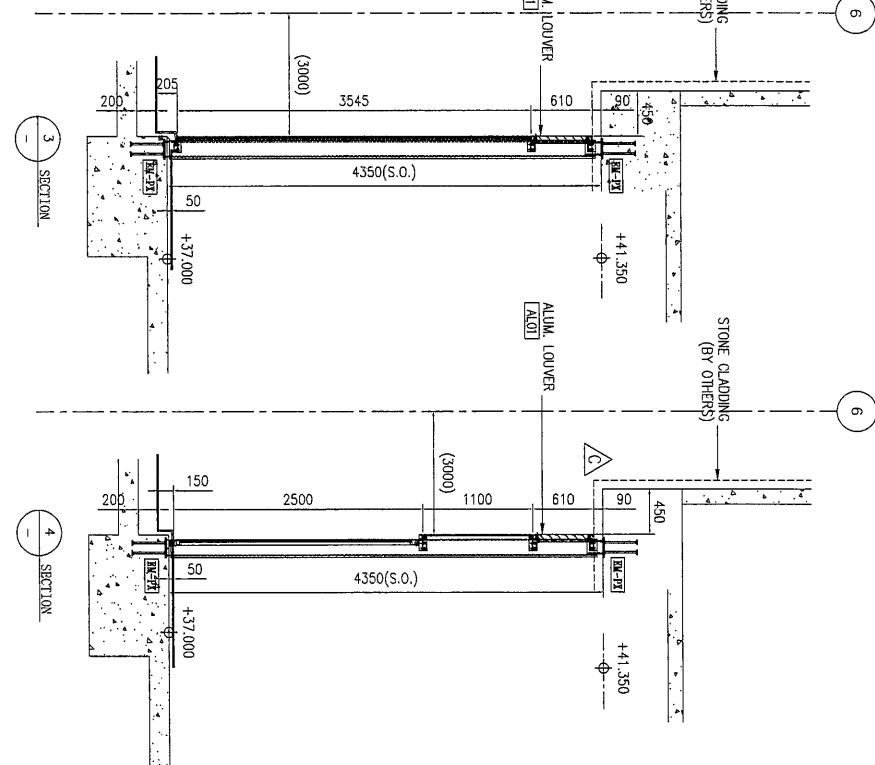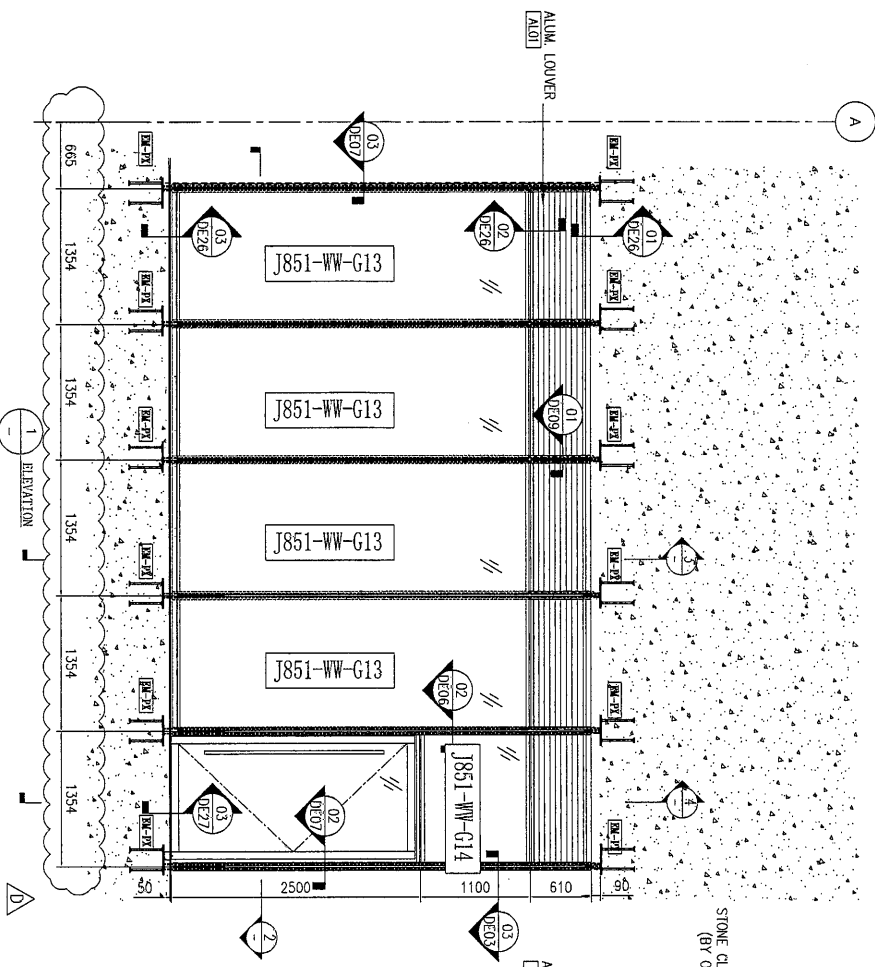
GLASS WALL MARK	SETTING AREA @ UPPER GROUND FLOOR
AMOUNT	NOS.
GLASS	GL1-12mm THK. CLEAR TEMPERED GLASS
COLOR CODE	LA01 - DARK GREY

LEGEND	
	VISION GLASS
	12mm THK. TEMPERED GLASS
	15mm THK. ALUM. FLASHING
	3mm THK. ALUM. CLADDING




B.D. REF :  
 F.S.D. REF :  
 Note:  
 1. All dimensions are in mm.  
 2. All elevations are viewed from outside.  
 3. All dimensions to be verified on site.  
 4. Site address: TOWN OF SHAN ROAD, TANG TOWN, COV.

- GENERAL NOTES
- Legend:
  - 1. FFL - Finished Floor Level
  - 2. SFL - Structural Floor Level
  - 3. RL - Reduced Level
  - 4. ( ) - Refer Sheet No.
  - X1 - RETAIL MARK NO.
  - X001 - REFER SHEET NO.
  - REVISIONS:
    - REV. 01 - CHANG TANG (P-2)
    - REV. 02 - CHANG TANG (P-2)
    - REV. 03 - CHANG TANG (P-2)
    - REV. 04 - CHANG TANG (P-2)
    - REV. 05 - CHANG TANG (P-2)

CLIENT : 佳明集團控股有限公司  
 GRAND HING GROUP HOLDINGS LIMITED  
 MAIN CONTRACTOR : GRAND TECH CONSTRUCTION CO. LTD.  
 ARCHITECT : WONG TING & PARTNERS LIMITED  
 STRUCTURAL ENGINEER : CMA C.M. WONG & ASSOCIATES LTD.  
 JOB NO. : J-951  
 DRAWN BY : LS  
 DATE : 22-06-2020  
 CHECK BY :  
 SCALE : AS SHOWN  
 DWG. NO. : J851-WW-P04  
 REV. : 0

美特銘實有限公司  
 MIDDI Architecture Partnership Ltd.  
 Units 6-8, Sunny Industrial Centre 1/F  
 810 Chee Koo Link, Road, Tseung Kwan O  
 Tel: 23480211-4 Fax: (853) 2727066  
 PROJECT : RESIDENTIAL DEVELOPMENT AT TANG TOWN, COV. SHAN ROAD

TITLE : PARTIAL ELEVATION, SECTION & PLAN FOR WINDOW WALL

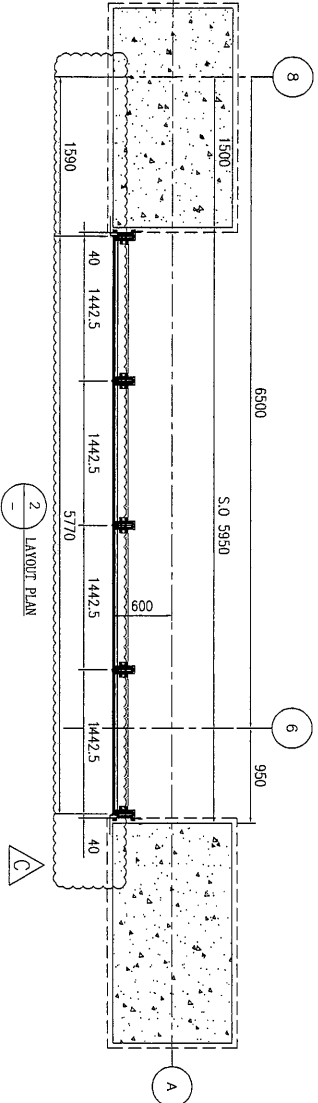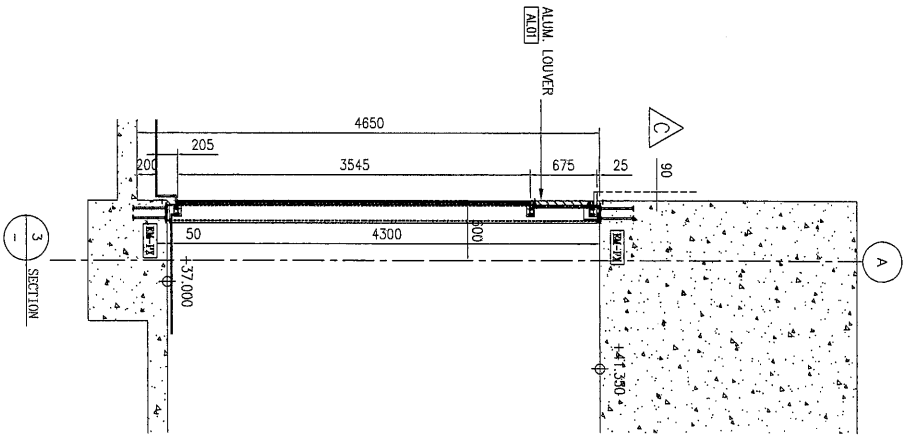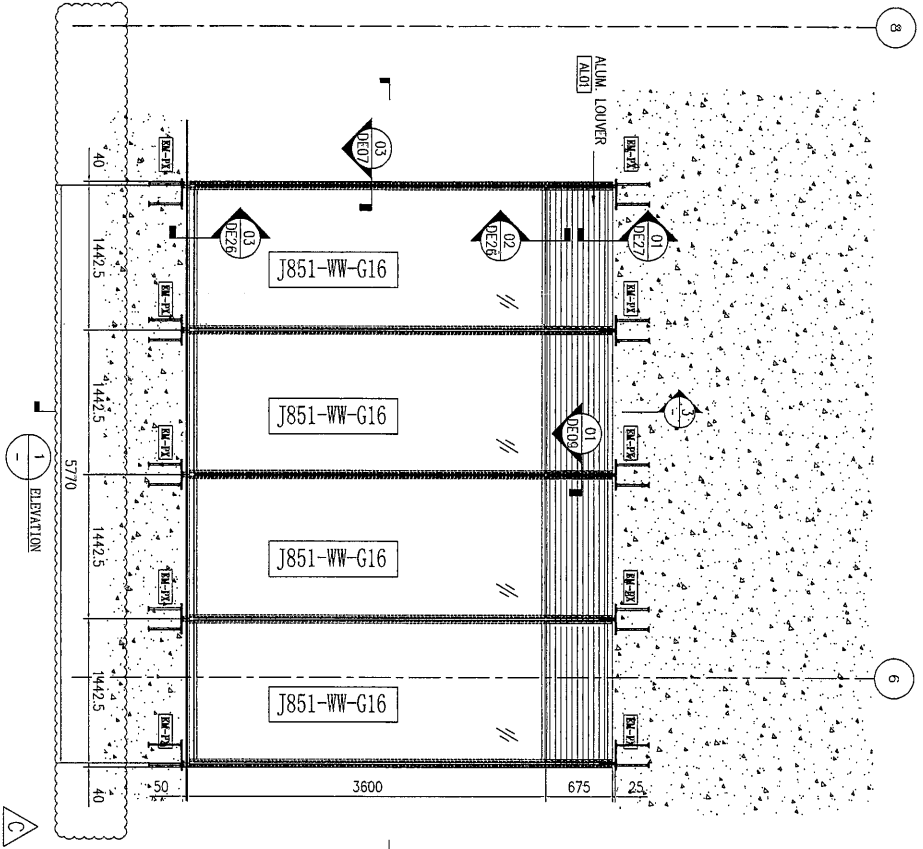

GLASS WALL MARK	VISION GLASS
LOCATION	SETTING AREA @ UPPER GROUND FLOOR
AMOUNT	INOS
GLASS	GL11-12mm THK. CLEAR TEMPERED GLASS
COLOR CODE	ALU11-D99R GREY

LEGEND	
	VISION GLASS
	12mm THK. TEMPERED GLASS
	3mm THK. ALUM. CLADDING
	15mm THK. ALUM. FLUSHING

JOB NO. :	J-851
DRAWN BY :	LS
DATE :	22-06-2020
CHKD BY :	SCALE A1: 1/50
DWG. NO. :	J851-WW-FRCS
REV. :	C

TITLE :  
PARTIAL ELEVATION, SECTION & PLAN  
FOR WINDOW WALL

PROJECT :  
RESIDENTIAL DEVELOPMENT AT  
TSSING YI TOWN LOT 170 SAI SHAN ROAD

MIDD 美特 投资有限公司  
MIDDI Architecture & Associates Ltd.  
Unit 6-4, Sunny Industrial Centre, 1/F  
616 Shek Lee Ave., TSSING YI TOWN  
Tel: (852) 2777656

STRUCTURAL ENGINEER :  
**CMA** C M WONG & ASSOCIATES LTD  
Architects & Engineers

ARCHITECT :  
**WONG YUNG & PARTNERS LIMITED**  
Architects & Engineers

CLIENT :  
佳明集團控股有限公司  
GRAND MING GROUP HOLDINGS LIMITED

MAIN CONTRACTOR :  
GRAND TECH CONSTRUCTION CO. LTD.

NO.	REV.	DESCRIPTION	DATE
1	01	GENERAL REVISION	2020-06-22
2	02	GENERAL REVISION	2020-06-22
3	03	GENERAL REVISION	2020-06-22

REVISION	DETAIL MARK NO.
RE-13	REVISION (P-1)
RE-14	REVISION (P-1)
RE-15	REVISION (P-2)
RE-16	REVISION (P-2)

GENERAL NOTES

1. All dimensions are in mm.
2. All dimensions are viewed from outside.
3. All dimensions to be verified on site before fabrication.

Legend :

1. F21 - Finished Floor Level
2. F10 - Structural Floor Level
3. F00 - Natural Ground

Legend :

- X11 - DETAIL MARK NO.
- X001 - REFER SHEET NO.

B.D. REF :  
 F.S.D. REF :  
 Note :  
 1. All dimensions are in mm.  
 2. All elevations are viewed from outside.  
 3. All dimensions to be verified on site before construction.  
 GENERAL NOTES

- Legend :
- 1. F.F.L. --- Finished floor level
  - 2. S.F.L. --- Structural floor level
  - 3. R --- Revised Detail
- X1 --- GENERAL MARK NO.  
 Y001 --- REFER SHEET NO.
- RM-101 --- Glass window-101  
 RM-102 --- Glass window-102  
 RM-103 --- Glass window-103  
 RM-104 --- Glass window-104  
 RM-105 --- Glass window-105  
 RM-106 --- Glass window-106  
 RM-107 --- Glass window-107  
 RM-108 --- Glass window-108  
 RM-109 --- Glass window-109  
 RM-110 --- Glass window-110

DATE : 22-06-2020  
 DRAWN BY : LS  
 CHECK BY : SCALE: A1: 1/50  
 DWG. NO. : J851-WW-FC06  
 REV. : C

PROJECT :  
 RESIDENTIAL DEVELOPMENT AT  
 TSIANG NI TOWN LOT 170 SHAN SHAN ROAD

CLIENT :  
 佳明集團控股有限公司  
 GRAND MING GROUP HOLDINGS LIMITED

MAIN CONTRACTOR :  
 GRAND TECH CONSTRUCTION CO. LTD.

ARCHITECT :  
 WONG TUNG & PARTNERS LIMITED  
 ARCHITECTS IN CHARGE

STRUCTURAL ENGINEER :  
 C M WONG & ASSOCIATES LTD

ADD NO. : J-851  
 DRAWN BY : LS  
 DATE : 22-06-2020  
 CHECK BY : SCALE: A1: 1/50  
 DWG. NO. : J851-WW-FC06  
 REV. : C

PROJECT :  
 RESIDENTIAL DEVELOPMENT AT  
 TSIANG NI TOWN LOT 170 SHAN SHAN ROAD

CLIENT :  
 美特經貿有限公司  
 MIDDI AUMONIK YUANGCOON LTD.  
 610 5th Floor, 500, King Road, Kowloon  
 Tel: 23488211-4 Fax: (852) 7727866

DATE : 22-06-2020  
 DRAWN BY : LS  
 CHECK BY : SCALE: A1: 1/50  
 DWG. NO. : J851-WW-FC06  
 REV. : C

PROJECT :  
 RESIDENTIAL DEVELOPMENT AT  
 TSIANG NI TOWN LOT 170 SHAN SHAN ROAD

CLIENT :  
 美特經貿有限公司  
 MIDDI AUMONIK YUANGCOON LTD.  
 610 5th Floor, 500, King Road, Kowloon  
 Tel: 23488211-4 Fax: (852) 7727866

DATE : 22-06-2020  
 DRAWN BY : LS  
 CHECK BY : SCALE: A1: 1/50  
 DWG. NO. : J851-WW-FC06  
 REV. : C




PROJECT :  
 RESIDENTIAL DEVELOPMENT AT  
 TSIANG NI TOWN LOT 170 SHAN SHAN ROAD

CLIENT :  
 美特經貿有限公司  
 MIDDI AUMONIK YUANGCOON LTD.  
 610 5th Floor, 500, King Road, Kowloon  
 Tel: 23488211-4 Fax: (852) 7727866

DATE : 22-06-2020  
 DRAWN BY : LS  
 CHECK BY : SCALE: A1: 1/50  
 DWG. NO. : J851-WW-FC06  
 REV. : C

PROJECT :  
 RESIDENTIAL DEVELOPMENT AT  
 TSIANG NI TOWN LOT 170 SHAN SHAN ROAD




CLIENT :  
 美特經貿有限公司  
 MIDDI AUMONIK YUANGCOON LTD.  
 610 5th Floor, 500, King Road, Kowloon  
 Tel: 23488211-4 Fax: (852) 7727866

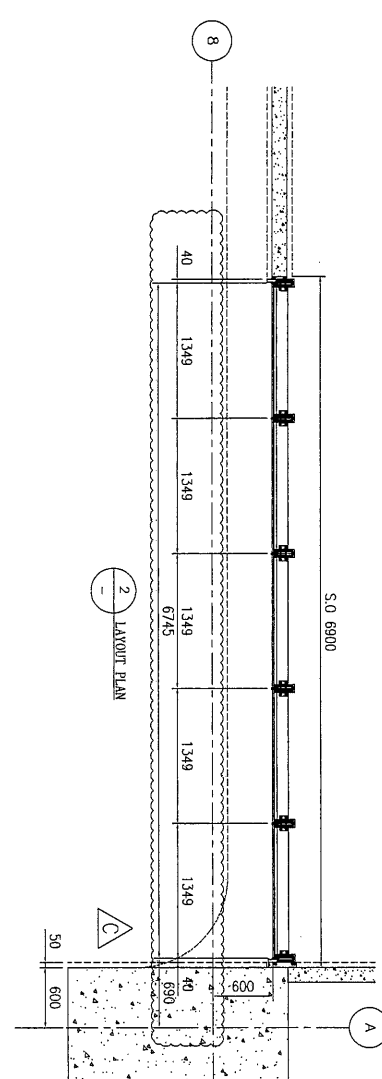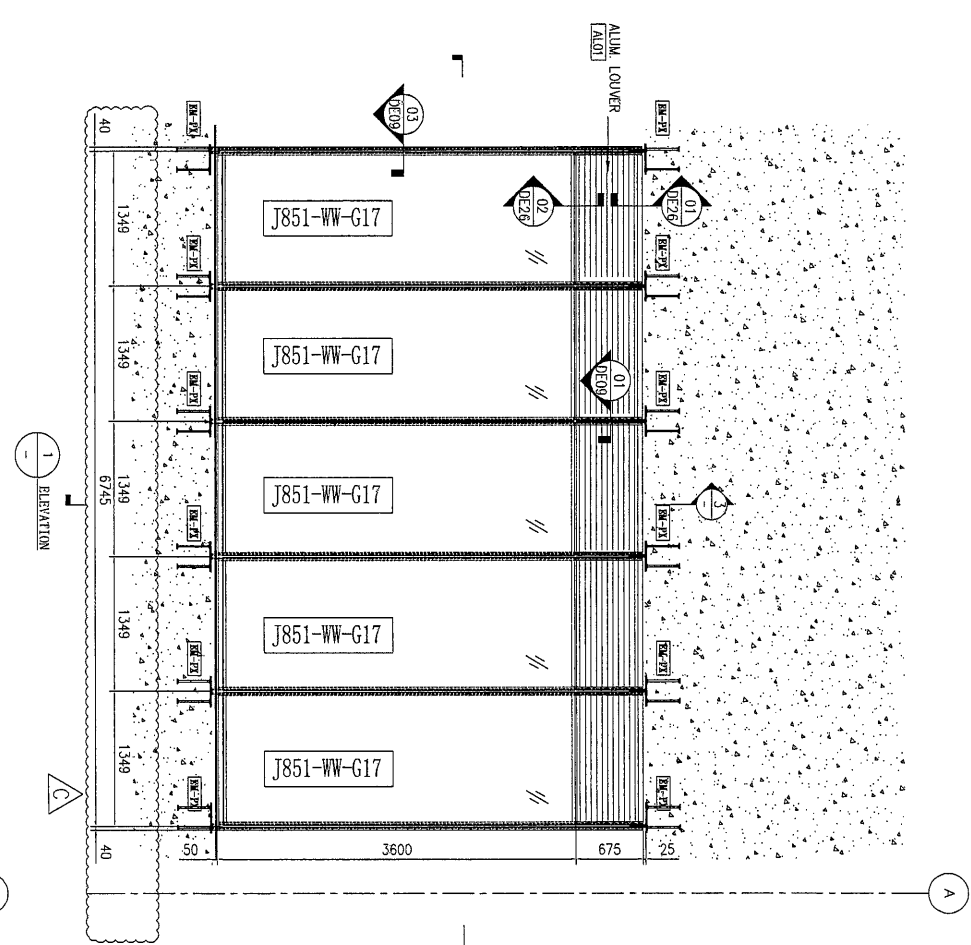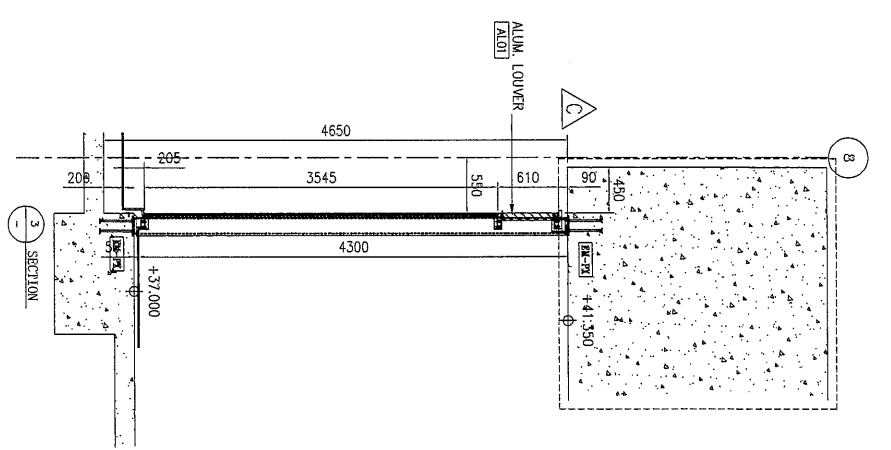

GLASS WALL MARK	SETTING AREA @ UPPER GROUND FLOOR	INS.	GLASS	COLOUR CODE
MINS TLC			G11-12mm THK. CLEAR TEMPERED GLASS	ZALU1-DARK GREY

LEGEND	DESCRIPTION
[Pattern]	VISION GLASS
[Pattern]	12mm THK. TEMPERED GLASS
[Pattern]	3mm THK. ALUM. CLADDING
[Pattern]	15mm THK. ALUM. FLASHING



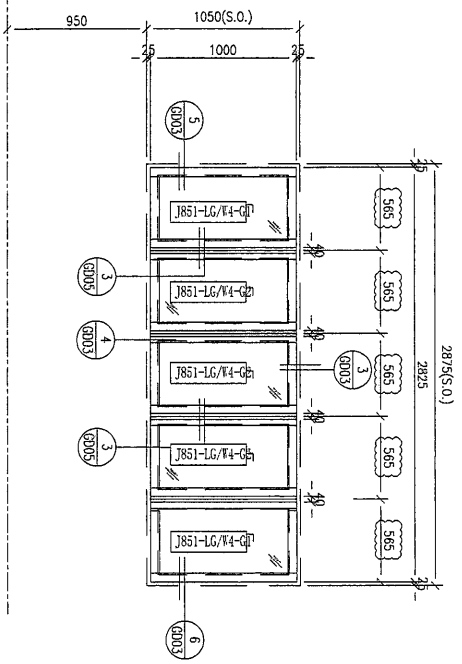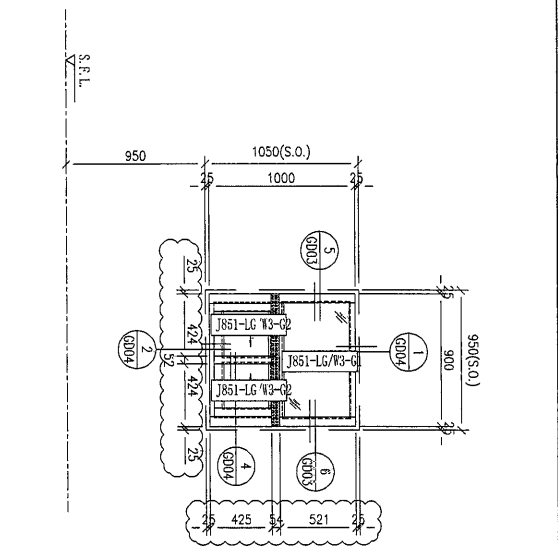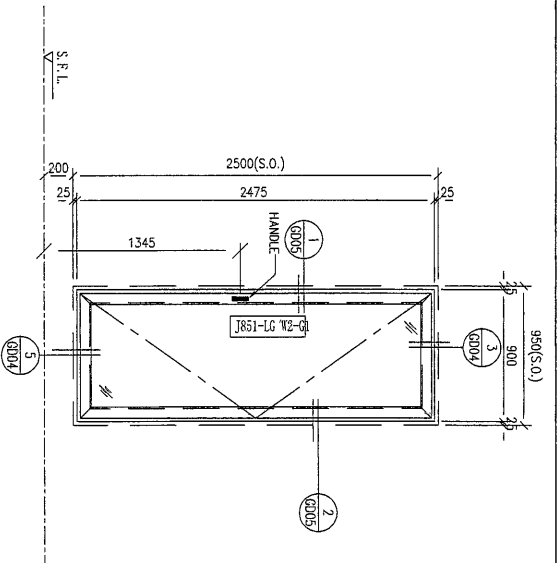

WINDOW MARK	1 no.	LOCATION	AF01 (DARK GREY)
GLAZING	10mm THK. FROSTED GLASS	FRAME	AF01 (DARK GREY)
REMARK	CLEAR SIZE MIN. 750(W)x2300(H)		

WINDOW MARK	1 no.	LOCATION	AF01 (DARK GREY)
GLAZING	10mm THK. CLEAR GLASS(FIX WINDOW)	FRAME	AF01 (DARK GREY)
REMARK	8mm THK. CLEAR GLASS		

**JOB NO.:** J-851  
**DATE:**  
**SCALE:** A1:100  
**REV.:** B

**CLIENT:** 住明集團控股有限公司  
 GRAND MING GROUP HOLDINGS LIMITED

**MAIN CONTRACTOR:** GRAND TECH CONSTRUCTION CO. LTD.

**ARCHITECT:** WONG TUNG & PARTNERS LIMITED

**STRUCTURAL ENGINEER:** C M WONG & ASSOCIATES LTD

**PROJECT:** RESIDENTIAL DEVELOPMENT AT TSIANG TSI TOWN LOT 191 SHAN SHAN ROAD

**CONTACT:** 11th Floor, Sunny Industrial Centre, 1/F, 610 Chee Lee Ling Road, Kowloon, Tel: 23498211-4, Fax: (852) 27721866

**WINDOW SCHEDULE FOR GUARD HOUSE**

- Legend:**  
 1. F.F.L. --- Finished Floor Level  
 2. S.F.L. --- Standard Floor Level  
 3. (Symbol) --- Reserved Detail
- Legend:**  
 X1 --- Detail Mark No.  
 YX001 --- Refer Sheet No.

**REVISIONS:**  
 1. All dimensions are in mm.  
 2. All dimensions are viewed from outside.  
 3. All dimensions to be verified on site before construction.

**GENERAL NOTES**