

工程指示 / 要求簡箋(E.I.)

工程指示編號: EI/ 2866 /20 修改版次:

工程編號: J851 工程名稱: 青衣明翹滙

工程項目: J851 各項目補地盤用配件

收件人: 林哥/阿基 發件人: Joe Chan

日期: 22/12/20

□要求提供 / □確認 事項:

- () 初步鋁料 B.M. () 加工拆圖, 然後生產 () 尺寸表
- () 正式鋁料 B.M. () 技術上資料 / 指示 () 報價
- () 配件 B.M. () 樣辦或貨品說明書 () 分判合約
- () 其他: _____

內容:

① M8 X 75 拉爆: 7000 套

② M8 X 35 圓頭機絲: 6000 套

③ # 10 焊枝: 150 小包

請在 31/12/2020 前完成上列要求。

附有關圖紙 / 文件:

14頁

以上項目為:

- 原合約工程包 原合約工程加 / 減賬 新工程報價

原因:-

分發東莞各部門:

- () 生產技術總監 連附件 () 技術部 連附件 () 生產部 連附件 () 機械設計部 連附件
- () 採購部 連附件 () 生產統籌部 連附件
- () 質檢部 連附件 () 會計部 連附件 () 報關組 連附件 () 其他 _____ 連附件

分發香港各部門:

- () 行政部 連附件 () 會計部 連附件 () 統籌部 連附件 () 工程部地盤科 連附件 林哥, 二室
- () 採購部 連附件 () QS 部 連附件 () 維修部 連附件 () 其他 _____ 連附件

傳遞編號:

發件人簽署:

項目經理簽署:

工程號:	J-851	計算:	xiaoyb	日期:	22/12/2020	送呈:	施哥
地盤名稱	TY190	核對:		日期:		副本:	
項目類別	外牆類補配件	批准:		日期:			


BM編號: 修改版次:
此BM依據 2020/07/21施工圖紙資料計算

序號	修改內容	配件圖號	物料編號	配件名稱	顏色	實用	後備	總數	單位	備 注
1			HULTI HST3-R	M8x75 拉爆螺絲	不銹鋼	7000	350	7350	粒	修鋁板角碼, 角鐵, 企飾線頂底拳板, 配1平墊, 彈墊, 螺帽
2				M8x35不銹鋼六角頭螺絲	A4-70	6000	300	6300	個	配1平墊, 1彈墊, 1螺帽
3				#8焊枝		150	5	155	小包	燒焊用
4										
5										
6										

(之前無引)

(2)

新增收口鋁窗
補M4技術爆

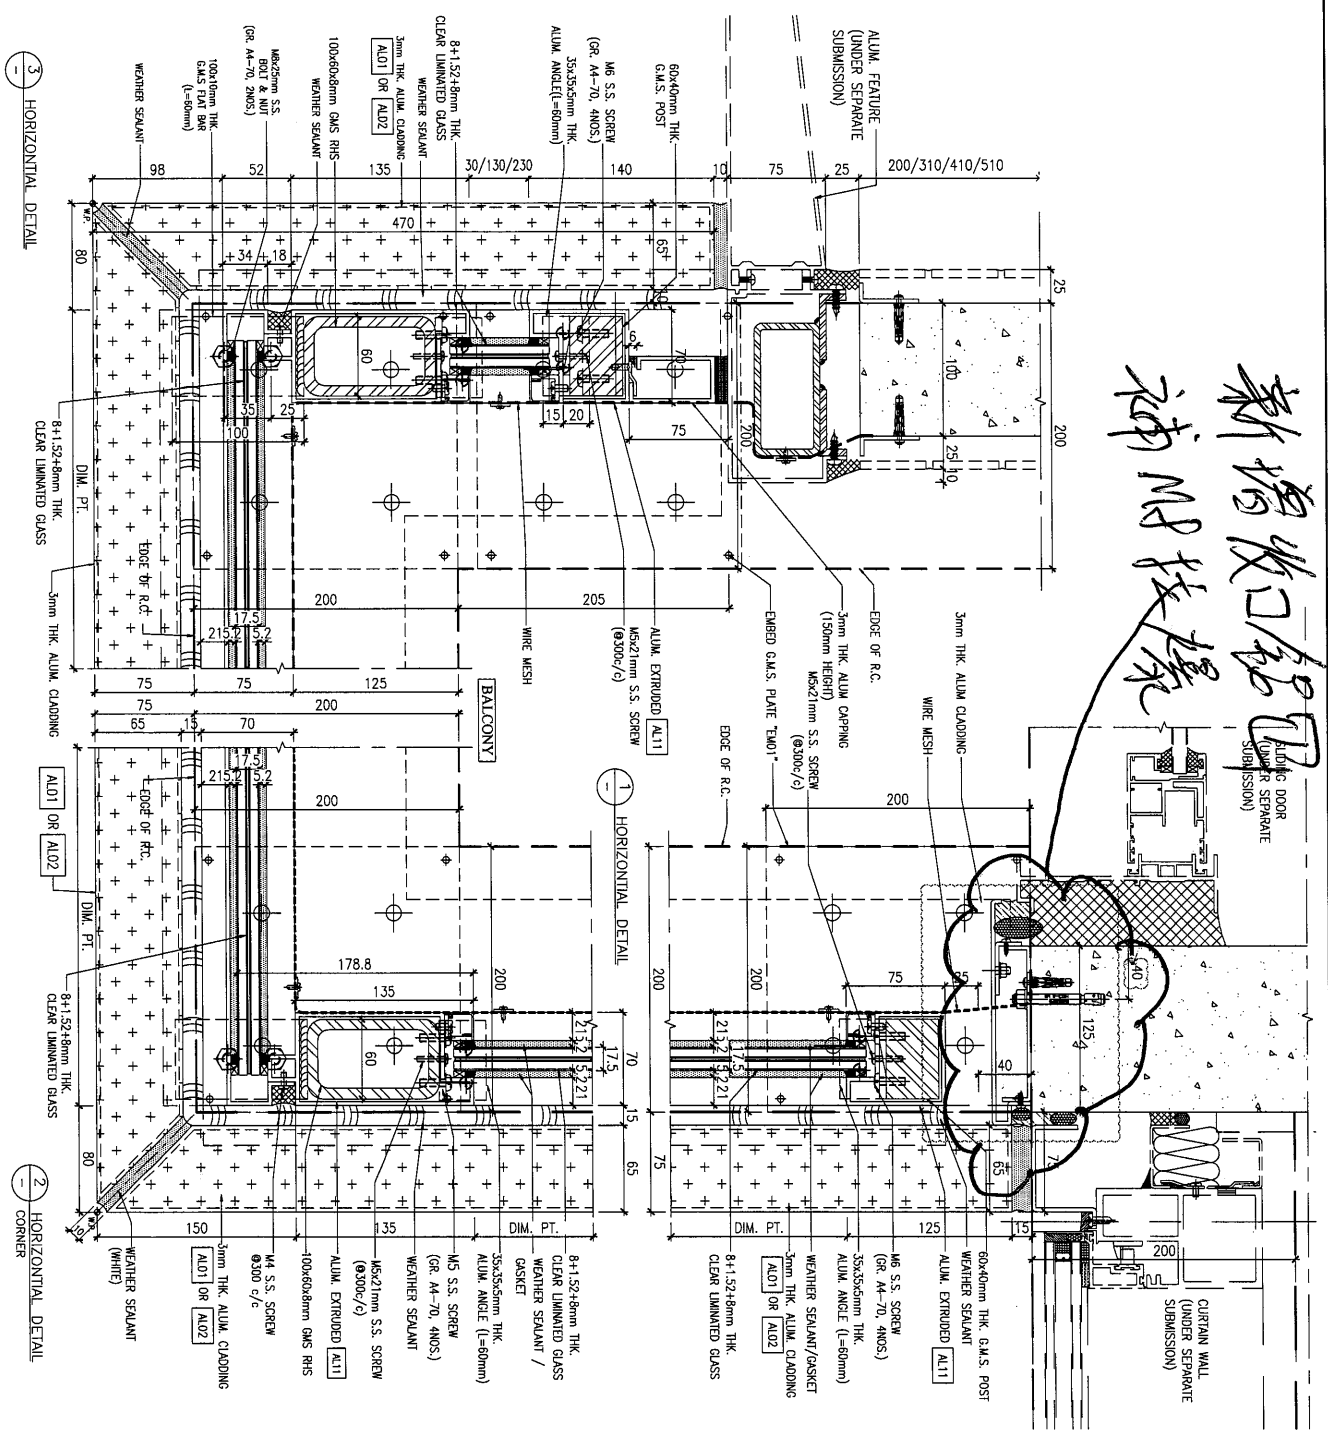

BDI REF :
F330 REF :
Note:
1. All dimensions are in mm.
2. All dimensions are to be verified on site before fabrication.

GENERAL NOTES
Legend :
1. Filled - Filled floor level
2. S.F. - Standard floor level
3. - - - - - Proposed level

REVISIONS
NO. DATE REVISION
A 23-11-2020 GENERAL REVISION
B 31-08-2020 GENERAL REVISION
C 11-08-2020 REVISION

CLIENT : 佳明集團控股有限公司
GRAND MING GROUP HOLDINGS LIMITED
MAIN CONTRACTOR : GRAND TECH CONSTRUCTION CO. LTD.
ARCHITECT : WATSON TUNG & PARTNERS LIMITED
STRUCTURAL ENGINEER : C.M. WONG & ASSOCIATES LTD

PROJECT : 11th & 8th Storey, Interlink Centre, 1/2 610 Des Voeux Road, Tsim Sha Tsui, Kowloon
RESIDENTIAL DEVELOPMENT AT TSIANG TI TOWN LOT 133 SH SHAN ROAD

TITLE : DETAIL OF GLASS BALUSTRADE AT BALCONY
JOB NO. : J-581
DRAWN BY : LS
DATE : 26-11-2019
CHECK BY : SCALE A1 : 1:3
DWG. NO. : J851-CB-0301
REV. : 8

