

工程指示 / 要求簡箋(E.I.)

工程指示編號：EI12896121

修改版次：-

工程編號：J851

工程名稱：青衣明翹匯

工程項目：幕牆單元件 - 鋁板位置加工次序

收件人：生統

發件人：Yancy Chen

日期：05/01/2021

要求提供 / 確認 事項：

- | | | |
|------------------------------------|-------------------------------------|-------------------------------|
| <input type="checkbox"/> 初步鋁料 B.M. | <input type="checkbox"/> 加工拆圖，然後生產 | <input type="checkbox"/> 尺寸表 |
| <input type="checkbox"/> 正式鋁料 B.M. | <input type="checkbox"/> 技術上資料 / 指示 | <input type="checkbox"/> 報價 |
| <input type="checkbox"/> 配件 B.M. | <input type="checkbox"/> 樣辦或貨品說明書 | <input type="checkbox"/> 分判合約 |
| <input type="checkbox"/> 其他：_____ | | |

內容：

根據地盤 1 月 4 日提出，向外街次序 1, 2, 3，如附件立面圖所示。

請東莞廠按地盤指示，了解鋁板位置之加工次序，確保出貨日期。

請在 15/1/2021 前完成上列要求。(如有問題，可諮詢積哥)

附：

1+ | 頁

以上項目為：

- | | | |
|---------------------------------|--------------------------------------|--------------------------------|
| <input type="checkbox"/> 原合約工程包 | <input type="checkbox"/> 原合約工程加 / 減賬 | <input type="checkbox"/> 新工程報價 |
|---------------------------------|--------------------------------------|--------------------------------|

原因：-

分發東莞各部門：

- | | | | |
|--|---|---|--|
| <input type="checkbox"/> 生產技術總監 <input type="checkbox"/> 連附件 | <input type="checkbox"/> 技術部 <input type="checkbox"/> 連附件 | <input type="checkbox"/> 生產部 <input type="checkbox"/> 連附件 | <input type="checkbox"/> 機械設計部 <input type="checkbox"/> 連附件 |
| <input type="checkbox"/> 採購部 <input type="checkbox"/> 連附件 | <input checked="" type="checkbox"/> 生產統籌部 <input checked="" type="checkbox"/> 連附件 | | |
| <input type="checkbox"/> 質檢部 <input type="checkbox"/> 連附件 | <input type="checkbox"/> 會計部 <input type="checkbox"/> 連附件 | <input type="checkbox"/> 報關組 <input type="checkbox"/> 連附件 | <input type="checkbox"/> 其他 _____ <input type="checkbox"/> 連附件 |

分發香港各部門：

- | | | | | |
|---|--|---|---|----|
| <input type="checkbox"/> 行政部 <input type="checkbox"/> 連附件 | <input type="checkbox"/> 會計部 <input type="checkbox"/> 連附件 | <input type="checkbox"/> 統籌部 <input type="checkbox"/> 連附件 | <input checked="" type="checkbox"/> 工程部地盤科文 <input checked="" type="checkbox"/> 連附件 | 積哥 |
| <input type="checkbox"/> 採購部 <input type="checkbox"/> 連附件 | <input type="checkbox"/> QS 部 <input type="checkbox"/> 連附件 | <input type="checkbox"/> 維修部 <input type="checkbox"/> 連附件 | <input type="checkbox"/> 其他 _____ <input type="checkbox"/> 連附件 | |

傳遞編號：

HK 0010 / 21

發件人簽署：


YC

項目經理簽署：

[Signature]

T1/T1A

T2/T2A

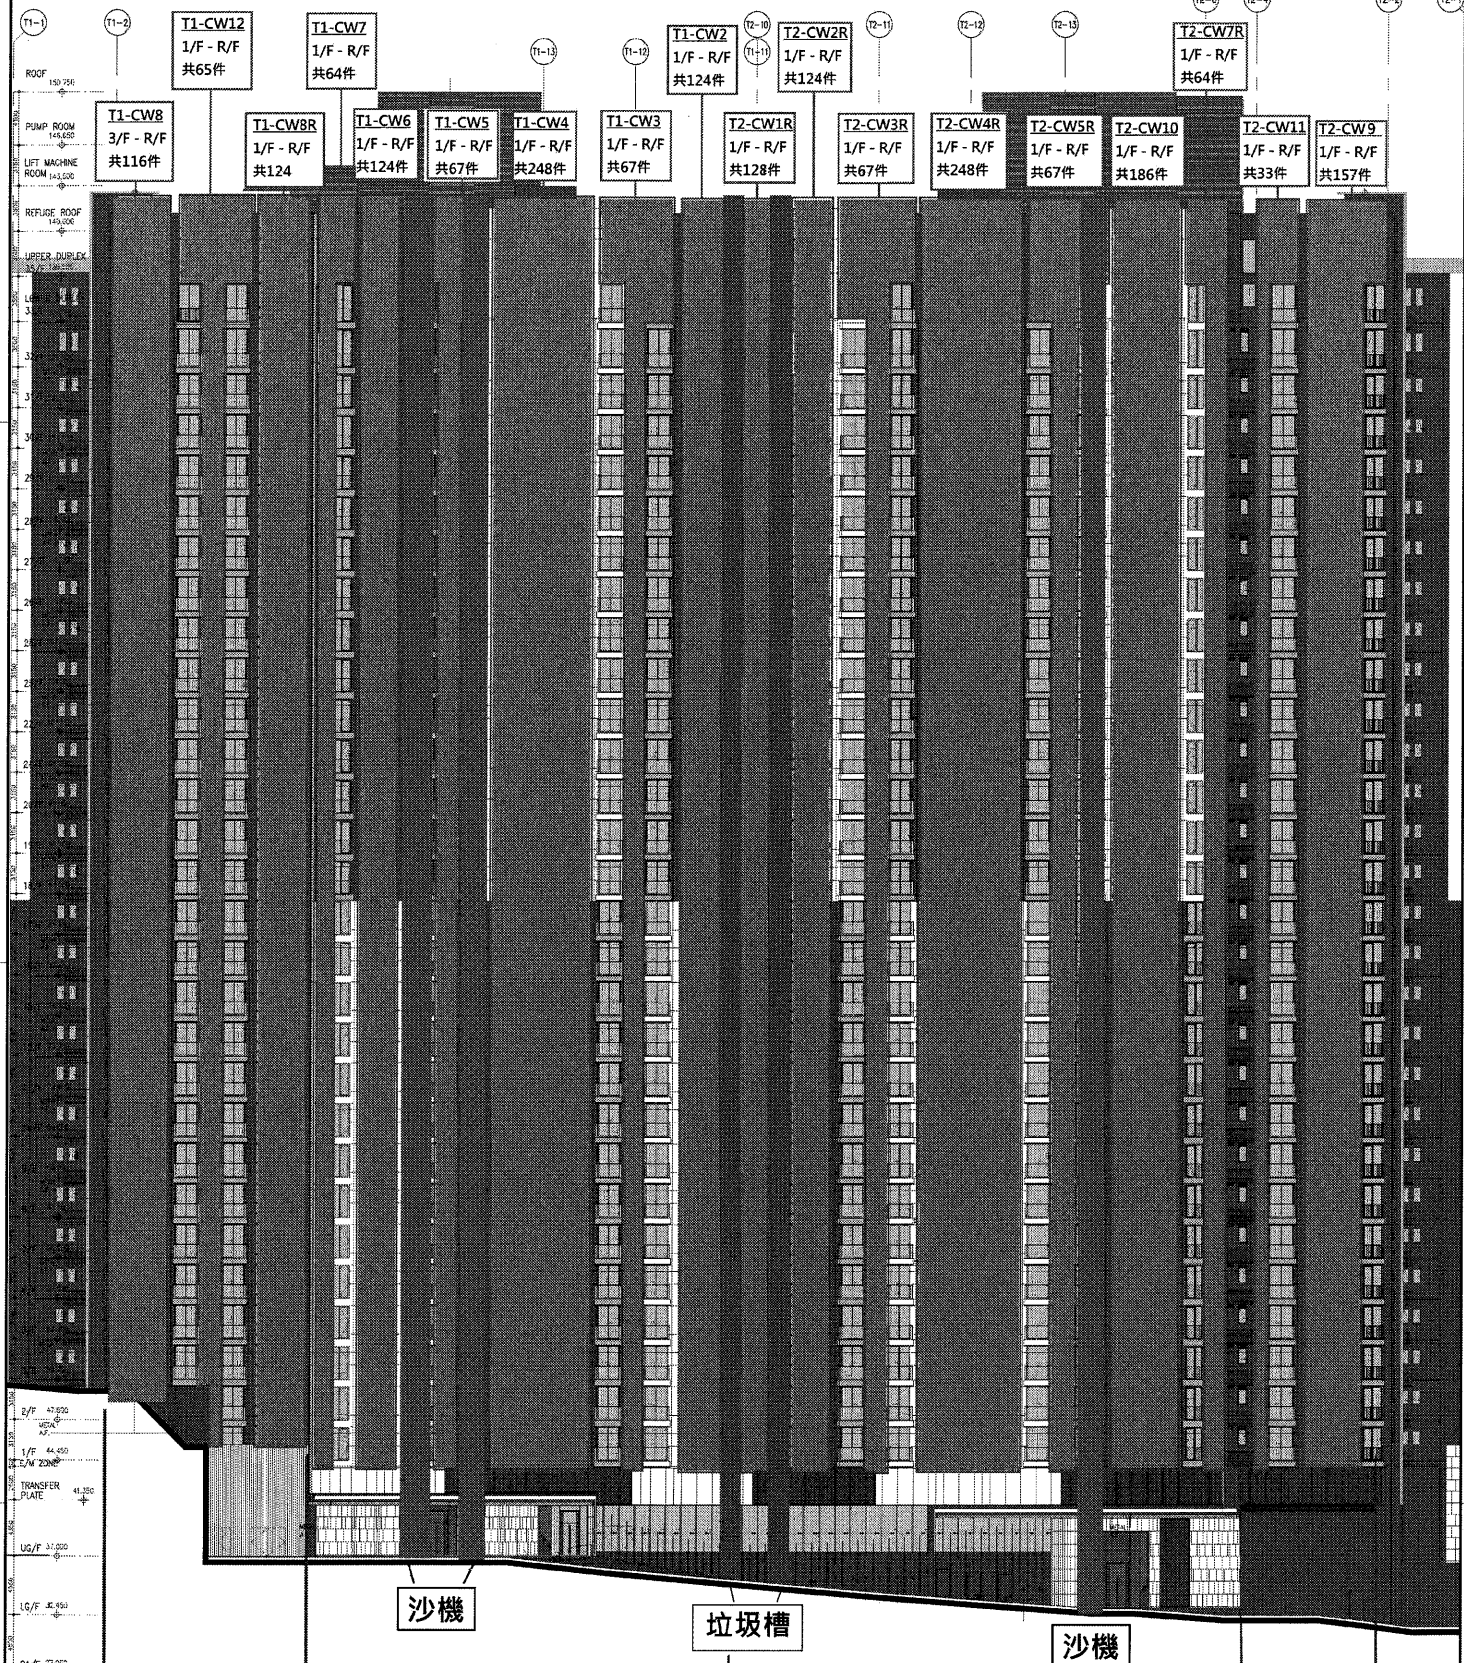

第1階段
次序1

第2階段
次序2

第3階段
次序3

第1階段
次序1

<p>YONG THING & PARTNERS LIMITED ARCHITECTS IN CHARGE 11/F, Times Square 2, Times Square, Hong Kong Tel: (852) 2538 8888 Fax: (852) 2538 8889 www.yongthing.com.hk</p>		<p>ST</p> <p>REVISIONS</p> <table border="1"> <tr><th>No.</th><th>Date</th><th>Description</th></tr> <tr><td> </td><td> </td><td> </td></tr> <tr><td> </td><td> </td><td> </td></tr> <tr><td> </td><td> </td><td> </td></tr> </table>	No.	Date	Description										<p>DATE: 07/2019 SCALE: 1:200 DRAWN BY: [Name] CHECKED BY: [Name] PROJECT NO: [Number] DRAWING NO: [Number] SHEET NO: 1/A31/101 (00)</p>	<p>NOTES: 1. ALL DIMENSIONS SHOWN ON THIS DRAWING SHALL BE TO FACE UNLESS OTHERWISE SPECIFIED. 2. ALL DIMENSIONS SHALL BE TO FACE UNLESS OTHERWISE SPECIFIED. 3. ALL DIMENSIONS SHALL BE TO FACE UNLESS OTHERWISE SPECIFIED. 4. ALL DIMENSIONS SHALL BE TO FACE UNLESS OTHERWISE SPECIFIED. 5. ALL DIMENSIONS SHALL BE TO FACE UNLESS OTHERWISE SPECIFIED. 6. ALL DIMENSIONS SHALL BE TO FACE UNLESS OTHERWISE SPECIFIED. 7. ALL DIMENSIONS SHALL BE TO FACE UNLESS OTHERWISE SPECIFIED. 8. ALL DIMENSIONS SHALL BE TO FACE UNLESS OTHERWISE SPECIFIED. 9. ALL DIMENSIONS SHALL BE TO FACE UNLESS OTHERWISE SPECIFIED. 10. ALL DIMENSIONS SHALL BE TO FACE UNLESS OTHERWISE SPECIFIED.</p>
No.	Date		Description													
<p>PROJECT: PROPOSED RESIDENTIAL DEVELOPMENT AT ISMNS VI TOWER 1/1A & 2/2A SAI SHAN ROAD</p>		<p>TITLE: TOWER 1/1A & 2/2A ELEVATION A</p>														