

工程指示 / 要求簡箋(E.I.)

工程指示編號：EI / 3043 / 21

修改版次：-

工程編號：J851

工程名稱：青衣明翹匯

工程項目：天面欄河 - 訂購玻璃 BM (35/F)

收件人：Maggie Lor (羅小姐)

發件人：Yancy Chen

日期：04/02/2021

要求提供 /  確認 事項：

- ( ) 初步鋁料 B.M.                      ( ) 加工拆圖，然後生產                      ( ) 尺寸表
- ( ) 正式鋁料 B.M.                      ( ) 技術上資料 / 指示                      ( ) 報價
- ( ) 配件 B.M.                              ( ) 樣辦或貨品說明書                      ( ) 分判合約
- ( ) 其他：\_\_\_\_\_

內容：

請按附件玻璃 BM 表及圖紙，不要加工，只作備料用。

(按則師意見，選用 19mm Low Iron Tempered + 2.28PVB + 19mm Low Iron Tempered Laminated Glass)

請在 1/3/2021 前完成上列要求。

附：

1+ 11 頁

以上項目為：

- 原合約工程包                       原合約工程加 / 減脹                       新工程報價

原因：-

分發東莞各部門：

- ( ) 生產技術總監  連附件    ( ) 技術部     連附件    ( ) 生產部     連附件    ( ) 機械設計部  連附件
- ( ) 採購部     連附件    ( ) 生產統籌部  連附件
- ( ) 質檢部     連附件    ( ) 會計部     連附件    ( ) 報關組     連附件    ( ) 其他 \_\_\_\_\_  連附件


分發香港各部門：

- ( ) 行政部  連附件    ( ) 會計部  連附件    ( ) 統籌部  連附件    ( ) 工程部地盤科文     連附件
- ( ) 採購部  連附件    ( ) QS 部     連附件    ( ) 維修部  連附件    ( ) 其他 \_\_\_\_\_  連附件

傳遞編號：

發件人簽署：

項目經理簽署：

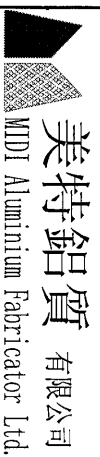


美特鋁質有限公司 Meite Aluminum Fabricator Ltd.	工程號: J-851	計算: Sam	日期: 20/01/2021	送呈: 施哥
地盤名稱: 青衣明邨匯	核對: 日期:	日期:	副本:	
項目類別: 35/F欄河	批准: 日期:	日期:	A/C Code:	

**地盤用玻璃B.M.表**

BM編號:	修改版次:	總計玻璃面積 (平方米):	164.102	此BM依據
-------	-------	---------------	---------	-------

序號	修改內容	玻璃圖號	顏色與類型	厚度 (mm)	玻璃尺寸		數量 (塊)	總面積 (平方米)	備注
					寬度 (mm)	高度 (mm)			
1		RG01-01		40.3	745.0	1200.0	2	1.788	
2		RG01-02		40.3	1062.5	1200.0	2	2.550	
3		RG01-03		40.3	1024.5	1200.0	8	9.835	
4		RG01-04		40.3	1016.0	1200.0	2	2.438	
5		RG01-05		40.3	1450.5	1200.0	2	3.481	
6		RG01-06		40.3	1443.0	1200.0	5	8.658	
7		RG01-07		40.3	554.5	1200.0	2	1.331	
8		RG01-08		40.3	350.0	1200.0	1	0.420	
9		RG01-09	19+2.28+19mm THK. TEMPERED LAMINATED CLEAR GLASS 樣品編號: D20120365	40.3	680.0	1200.0	2	1.632	
10		RG01-10		40.3	1303.0	1200.0	10	15.636	
11		RG01-11		40.3	1295.0	1200.0	5	7.770	
12		RG01-12		40.3	1232.5	1200.0	6	8.874	
13		RG01-13		40.3	1225.0	1200.0	9	13.230	
14		RG01-14		40.3	480.0	1200.0	8	4.608	
15		RG01-15		40.3	1072.5	1200.0	2	2.574	
16		RG01-16		40.3	1066.0	1200.0	3	3.838	
17		RG01-17		40.3	755.0	1200.0	1	0.906	
18		RG01-18		40.3	1410.0	1200.0	2	3.384	
19		RG01-19		40.3	324.5	1200.0	1	0.389	
20		RG01-20		40.3	1305.5	1200.0	2	3.133	

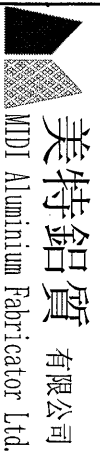

**美特鋁質** 有限公司  
MTDI Aluminium Fabricator Ltd.


工程號:	J-851	計算:	Sam	日期:	20/01/2021	送呈:	施哥
地盤名稱:	青衣明邨匯	核對:		日期:		副本:	

**地盤用玻璃B.M.表**

項目類別:	35/F欄河	批准:		日期:		A/C Code:	
-------	--------	-----	--	-----	--	-----------	--

BM編號:		修改版次:		總計玻璃面積 (平方米):	164.102	此BM依據	
-------	--	-------	--	---------------	---------	-------	--

序號	修改內容	玻璃圖號	顏色與類型	厚度 (mm)	玻璃尺寸			數量 (塊)	總面積 (平方米)	備注
					寬度 (mm)	高度 (mm)				
21		RG01-21		40.3	1298.0	1200.0	3	4.673		
22		RG01-22		40.3	1074.0	1200.0	4	5.155		
23		RG01-23		40.3	1480.0	1200.0	2	3.552		
24		RG01-24		40.3	1134.0	1200.0	2	2.722		
25		RG01-25		40.3	1126.5	1200.0	2	2.704		
26		RG01-26		40.3	1050.0	1200.0	1	1.260		
27		RG01-27		40.3	1275.0	1200.0	2	3.060		
28		RG01-28	19+2.28+19mm THK. TEMPERED LAMINATED	40.3	920.0	1200.0	2	2.208		
29		RG01-29	CLEAR GLASS 樣品編號: D20120365	40.3	1286.0	1200.0	2	3.086		
30		RG01-30		40.3	1278.5	1200.0	1	1.534		
31		RG01-31		40.3	1371.5	1200.0	2	3.292		
32		RG01-32		40.3	1364.0	1200.0	8	13.094		
33		RG01-33		40.3	1342.5	1200.0	2	3.222		
34		RG01-34		40.3	1335.0	1200.0	4	6.408		
35		RG01-35		40.3	1473.5	1200.0	2	3.536		
36		RG01-36		40.3	1466.0	1200.0	3	5.278		
37		RG01-37		40.3	940.0	1200.0	1	1.128		
38		RG01-38		40.3	1428.5	1200.0	1	1.714		
							小計	119	164.102	

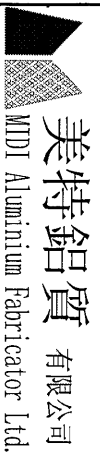

美特鋁質有限公司 MTDI Aluminium Fabricator Ltd.	工程號:	J-851	計算:	Sam	日期:	20/01/2021	送呈:	施哥
	地盤名稱:	青衣明邨匯	核對:		日期:		副本:	

### 地盤用玻璃B.M.表

項目類別:	35/F欄河	批准:	日期:	A/C Code:
-------	--------	-----	-----	-----------

BM編號:	修改版次:	總計玻璃面積 (平方米):	164.102	此BM依據
-------	-------	---------------	---------	-------


序號	修改內容	玻璃圖號	顏色與類型	厚度 (mm)	玻璃尺寸			數量 (塊)	總面積 (平方米)	備注
					寬度 (mm)	高度 (mm)	高度 (mm)			
1. 本表中所有玻璃對角線尺寸偏差要求不超過正負2mm。 2. 本表中玻璃要高度方向精磨邊，寬度方向粗磨邊。 3. 本表中所有強化玻璃均需HEAT SOAK TEST。 4. 本表中所有強化玻璃之入爐方向均以寬度方向進入。 5. 本表中所有玻璃成品均需注明室內外面及其玻璃編號，以便識別。										

加工注意事項:

圖則登記表  
DRAWING REGISTER

工程名稱 Project Title:		接收日期 Receiving Date (適用於客戶圖則)									
J851--FR顶层玻璃加工图		年	20								
(T1,T2)		月	10								
工程編號 Project No: J851		日	22								
圖則編號 Drg. No.	圖則名稱 Drawing Title	修訂編號 Revision No.									
J851-FR-PL01a	玻璃位置图	1	-								
J851-FR-PL02a	玻璃位置图	2	-								
J851-FR-PL03a	玻璃位置图	3	-								
J851-FR-PL04a	玻璃位置图	4	-								
J851-FR-SCH06a	玻璃位置图	5	-								
RG01	玻璃加工图	6	-								
			-								
			-								



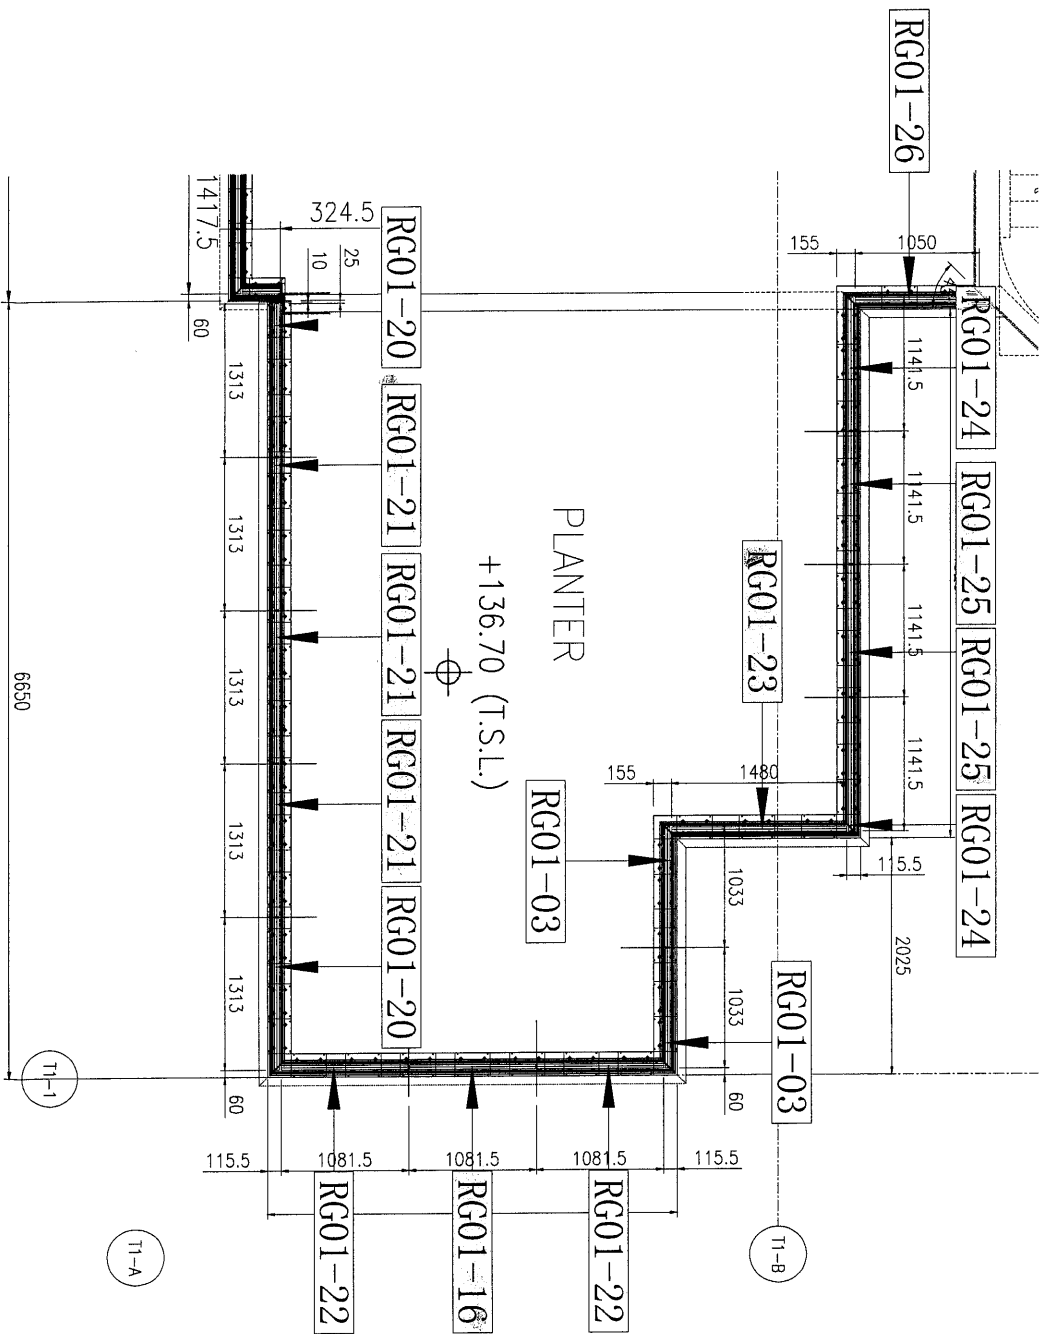

TYPE	TOWER	F.L.R.	FLAT	QTY
B17	T1	35/F	PLANTER	1

E.D. REF :  
 F.S.A. REF :  
 MARK :  
 1. All dimensions are in mm.  
 2. All dimensions are viewed from outside.  
 3. All dimensions to be verified on site.  
 4. Errors shall be corrected.

GENERAL NOTES

Legend :

1. F.L.L. - Finished Floor Level
2. S.F.L. - Structural Floor Level
3. (Symbol) - Shaded Area

(Symbol) HEALTH MARK NO.  
 (Symbol) HEAVY MARK NO.  
 (Symbol) HEAVY SHEET NO.

NO.	DATE	REVISION	BY
1.	08-07-2008	GENERAL REVISION	
2.			
3.			
4.			


CLIENT : 佳明集團控股有限公司  
 GRAND MING GROUP HOLDINGS LIMITED  
 MAIN CONTRACTOR : GRAND TECH CONSTRUCTION CO. LTD.

ARCHITECT : WONG TUNG & PARTNERS LIMITED  
 ARCHITECTS & PLANNERS  
 AMERICAN BANKERS

STRUCTURAL ENGINEER : C M WONG & ASSOCIATES LTD.  
 榮特經實有限公司  
 MIDIX Architectural Association Ltd.  
 Unit 6-8, Sunny Industrial Centre, 1/F  
 510 Cheong Yee Leq Road, Kowloon  
 HONG KONG (Tel: 27727888)

PROJECT : RESIDENTIAL DEVELOPMENT AT TSIING NI TOWN LOT 190 SHAN ROAD

TITLE : SCHEDULE OF GLASS BALUSTRADE AT FLAT ROOFTOWER 1 )  
 JOB NO. : J-851  
 DRAWN BY : LS DATE : 26-11-2018  
 CHECK BY : SCALE: AS SHOWN  
 DWG. NO. : J851-FR-PU20 REV : A

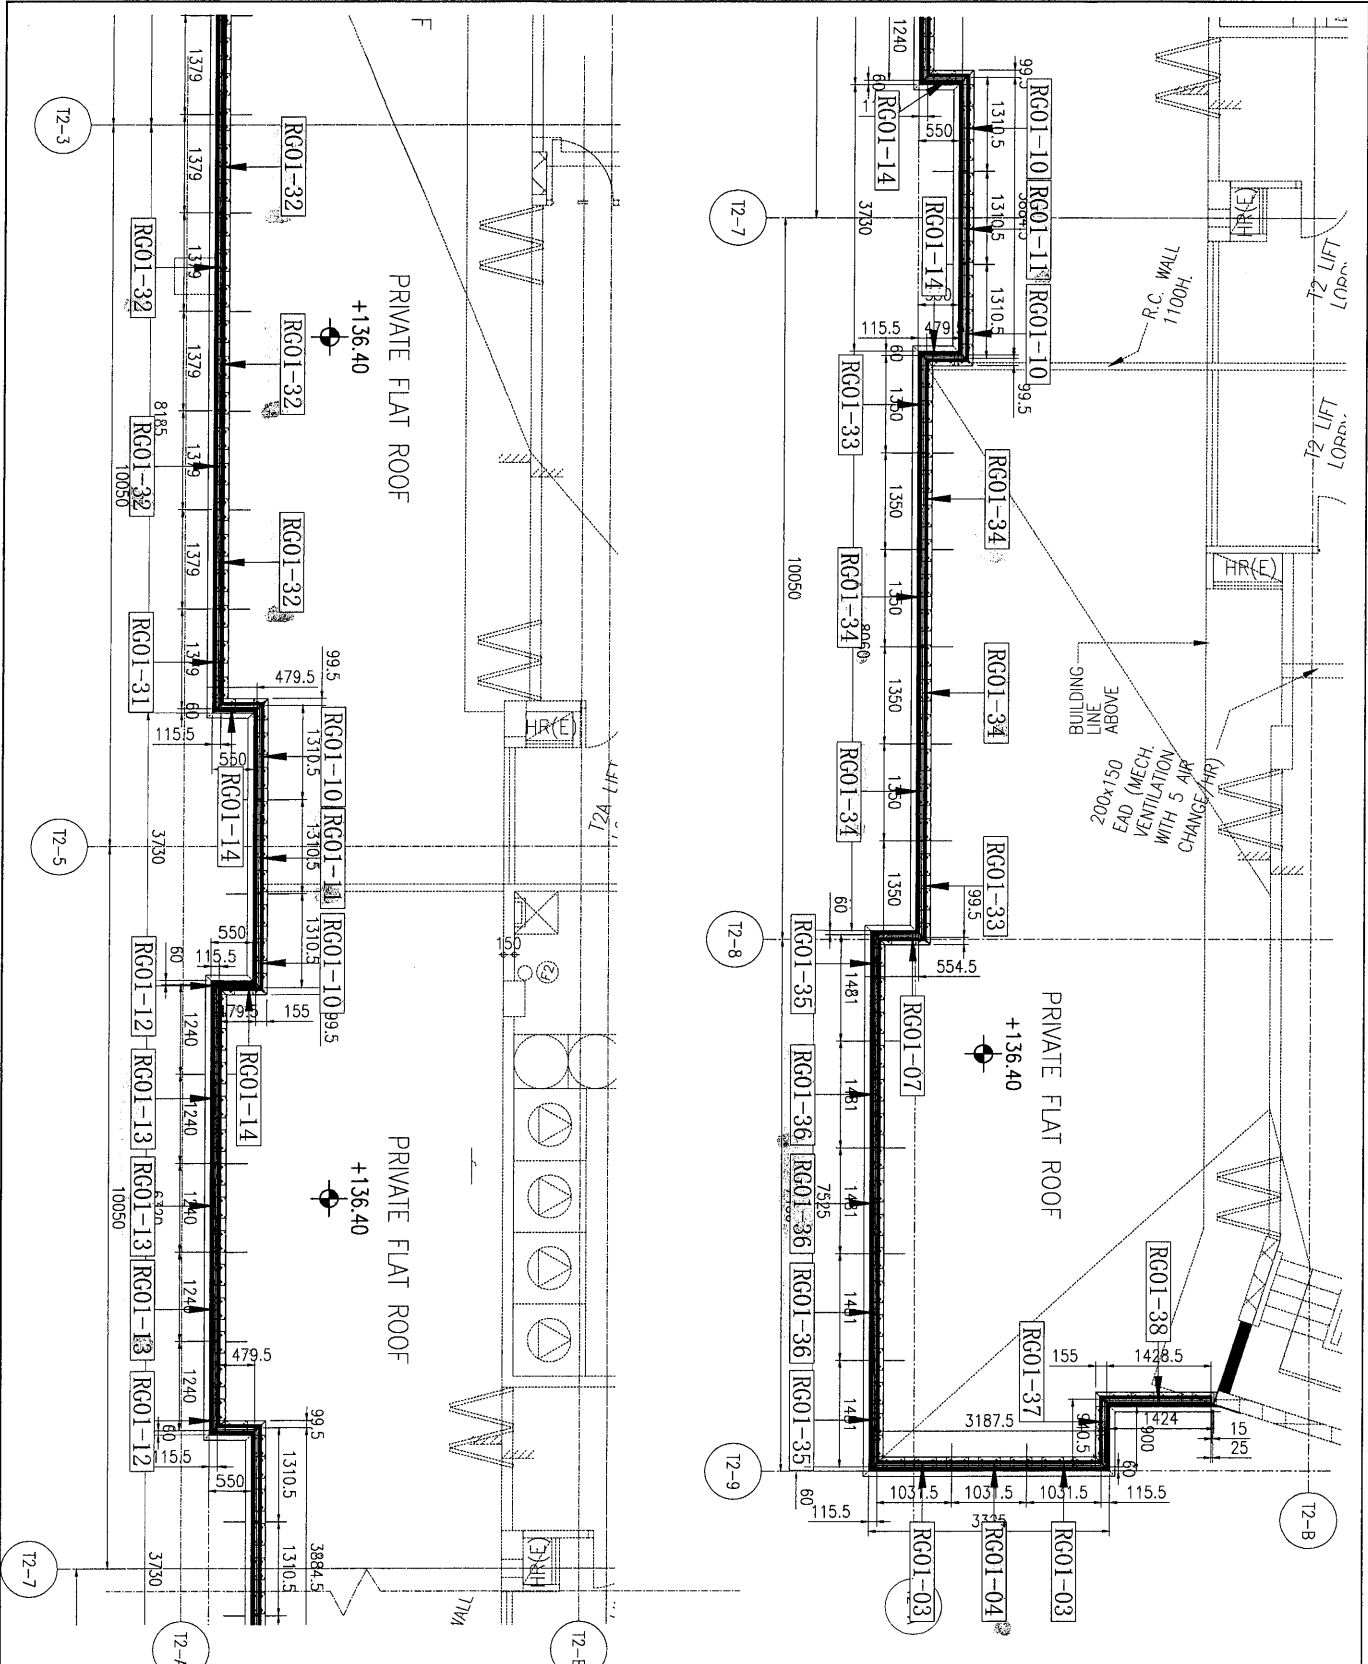

1. D.O. REF :  
 2. S.A. REF :  
 3. All dimensions are in mm.  
 4. All dimensions are viewed from outside.  
 5. All dimensions to be verified on site before fabrication.  
**GENERAL NOTES**  
**Legend :**  
 1. F.L. - Finished Floor Level  
 2. S.F.L. - Structure Floor Level  
 3. ( ) - Reserved Detail  
 (X1) - REF. TO WORK NO. 10239 SHEET NO. X001

**CLIENT :**  
 佳明集團控股有限公司  
 GRAND MING GROUP HOLDINGS LIMITED  
**MAIN CONTRACTOR :**  
 GRAND TECH CONSTRUCTION CO. LTD.  
**ARCHITECT :**  
 HONG TUNG & PARTNERS LIMITED  
 ARCHITECTS & PLANNERS  
**STRUCTURAL ENGINEER :**  
 C M WONG & ASSOCIATES LTD.

**PROJECT :**  
 RESIDENTIAL DEVELOPMENT AT  
 TUNG TOWN LOT 10050 SHAN ROAD  
**UNIT :**  
 SCHEDULE OF GLASS FAULSTRAKE  
 AT FLAT ROOFTOP (TOWER 2)  
**JOB NO. :** J-851  
**DRAWN BY :** LS  
**DATE :** 26-11-2019  
**SCALE :** A1 : 1/8  
**CHKD BY :** AS  
**REV. :** A  
**PKG. NO. :** J851-RR-FLD04

B.D. REF :  
 F.S.D. REF :  
 MARK :  
 1. All dimensions are in mm.  
 2. All elevations are viewed from outside.  
 3. All dimensions to be verified on site before construction.  
 GENERAL NOTES

Legend :  
 1. F.F.L. — Finished floor level  
 2. S.F.L. — Structural floor level  
 3. (Symbol) — Reserved detail  
 X1 — REFLECT MARK NO.  
 X001 — REFER SHEET NO.

NO.	REVISION	DATE	BY
1	ISSUE FOR PERMIT		
2	ISSUE FOR CONSTRUCTION		


CLIENT :  
 住明集團控股有限公司  
 GRAND MING GROUP HOLDINGS LIMITED  
 MAIN CONTRACTOR :  
 GRAND TECH CONSTRUCTION CO. LTD.  
 ARCHITECT :  
 HOKU TITANI & PARTNERS LIMITED  
 AMERICAN ARCHITECTS

STRUCTURAL ENGINEER :  
**C M WONG & ASSOCIATES** LTD.  
**美特堅有限公司**  
 MIDEL ENGINEERING CONSULTANTS LTD.  
 11th & 8th Street, Industrial Centre 1/F  
 510 Des Voeux Road, Hong Kong  
 Tel: 24248221-4 Fax: (852) 27275668

PROJECT :  
 RESIDENTIAL DEVELOPMENT AT  
 TSIANG TI TOWN LOT 150, 501 SHAN ROAD

TITLE :  
 SCHEDULE OF GLASS BALUSTRADE  
 AT FLAT ROOF (TOWER 2)

JOB NO. : J-451  
 DRAWN BY : LS DATE : 26-11-2019  
 CHECK BY : SCALE : AS SHOWN  
 DWG. NO. : J051-R-FL04d REV. : A

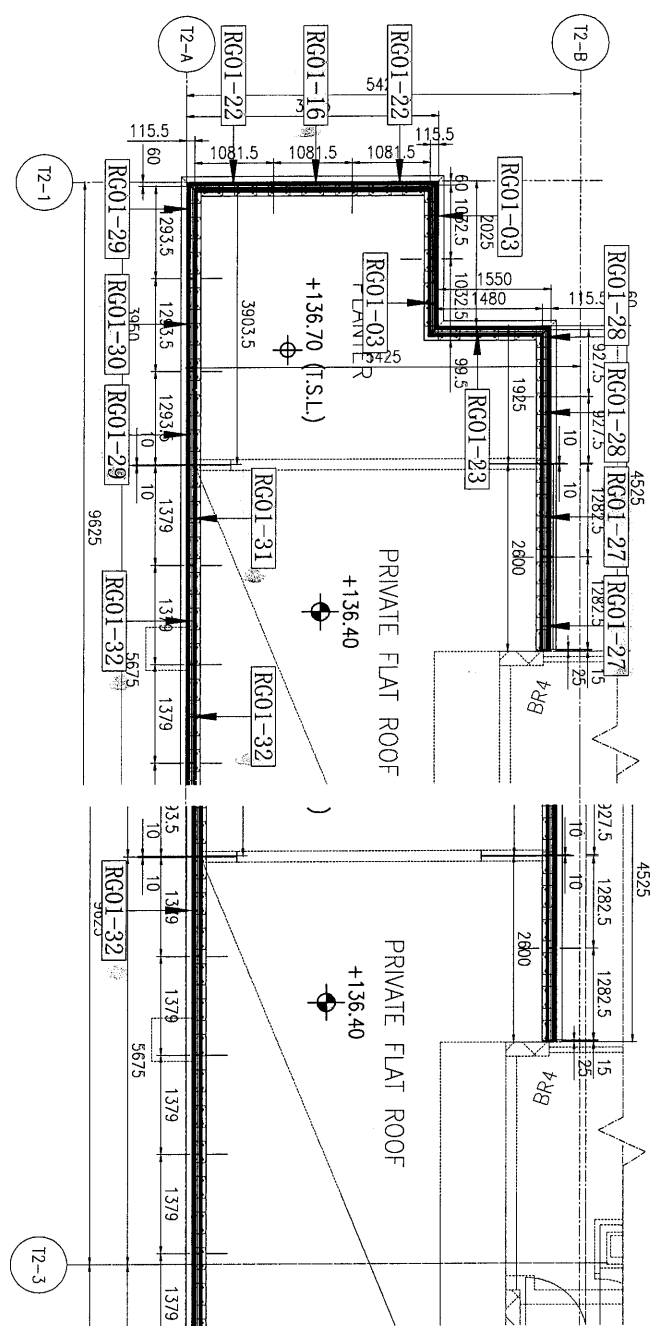

2 LAYOUT PLAN  
 B28 T2



TYPE	TOWER	FLR.	FLAT	QTY
B28	T2	35/F	PLANIER	1

1 LAYOUT PLAN  
 B27 T2

TYPE	TOWER	FLR.	FLAT	QTY
B27	T2	35/F	FLAT ROOF	1



 美特鋁質有限公司 MIDI Aluminium Fabricator Ltd.				工程號	J851	類別		物料號	-		
修改	-	-	-	地盤	青衣190	制圖	-	2020-04-24	圖號	RG01	
日期	-	-	-	採用工廠	✓	圖紙名稱	玻璃加工圖	復核	-	數量	-
				材料顏色	-	材料	GLASS	批准	-	單件重量	- (KG)

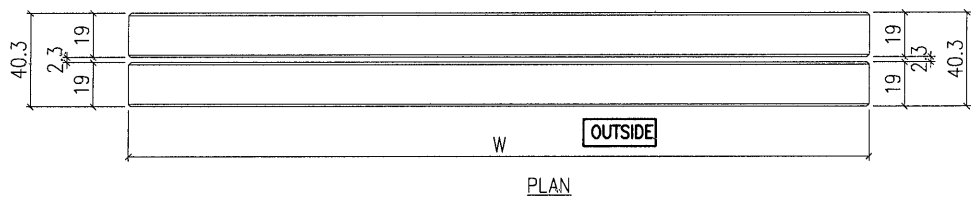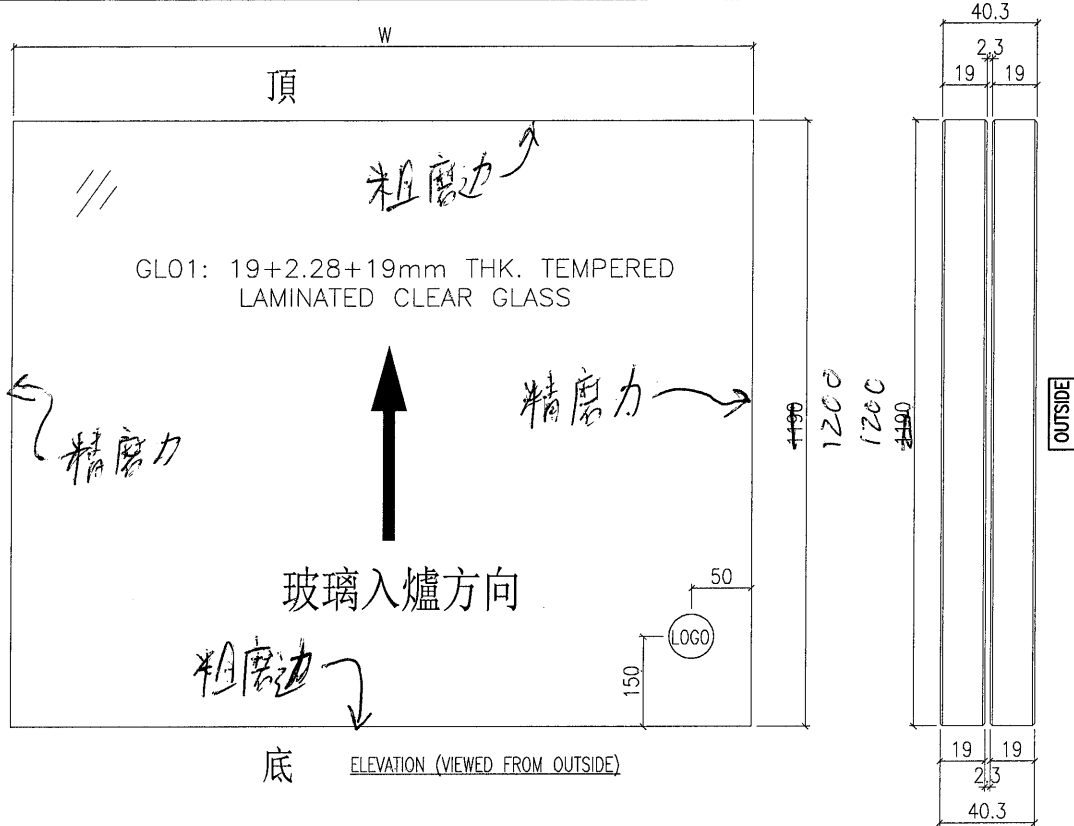

- NOTES
1. ALL DIMENSION IN mm
  2. ALL EDGE CHAMFER 1x1x45°

序号	玻璃图号	W	数量
20	RG01-20	1305.5	2
19	RG01-19	324.5	1
18	RG01-18	1410	2
17	RG01-17	755	1
16	RG01-16	1066	3
15	RG01-15	1072.5	2
14	RG01-14	480	8
13	RG01-13	1225	9
12	RG01-12	1232.5	6
11	RG01-11	1295	5
10	RG01-10	1303	10
9	RG01-09	680	2
8	RG01-08	350	1
7	RG01-07	554.5	2
6	RG01-06	1443	5
5	RG01-05	1450.5	2
4	RG01-04	1016	2
3	RG01-03	1024.5	8
2	RG01-02	1062.5	2
1	RG01-01	745	2

序号	玻璃图号	W	数量
40	RG01-40	1545	2
39	RG01-39	1228	2
38	RG01-38	1428.5	1
37	RG01-37	940	1
36	RG01-36	1466	3
35	RG01-35	1473.5	2
34	RG01-34	1335	4
33	RG01-33	1342.5	2
32	RG01-32	1364	8
31	RG01-31	1371.5	2
30	RG01-30	1278.5	1
29	RG01-29	1286	2
28	RG01-28	920	2
27	RG01-27	1275	2
26	RG01-26	1050	1
25	RG01-25	1126.5	2
24	RG01-24	1134	2
23	RG01-23	1480	2
22	RG01-22	1074	4
21	RG01-21	1298	3

序号	玻璃图号	W	数量
43	RG01-43	1489	2
42	RG01-42	1048	1
41	RG01-41	1484	9

序号39至43已出E12969

