

工程指示 / 要求簡箋(E.I.)

工程指示編號：EI/3411 /21 修改版次：  
 工程編號：J851 工程名稱：青衣明翹滙  
 工程項目：露台欄河補鋁板  
 收件人：生統 發件人：Joe Chan 日期：17/5/2021

要求提供 /  確認 事項：

- |                                    |                                     |                               |
|------------------------------------|-------------------------------------|-------------------------------|
| <input type="checkbox"/> 初步鋁料 B.M. | <input type="checkbox"/> 加工拆圖，然後生產  | <input type="checkbox"/> 尺寸表  |
| <input type="checkbox"/> 正式鋁料 B.M. | <input type="checkbox"/> 技術上資料 / 指示 | <input type="checkbox"/> 報價   |
| <input type="checkbox"/> 配件 B.M.   | <input type="checkbox"/> 樣辦或貨品說明書   | <input type="checkbox"/> 分判合約 |
| <input type="checkbox"/> 其他：_____  |                                     |                               |

內容：

生產鋁板 GB-A2-03G (15件)  
 GB-B1R-03W (15件)  
 送地盤

請在 ASAP 前完成上列要求。

附有關圖紙 / 文件：

14 頁

以上項目為：

- 原合約工程包       原合約工程加 / 減賬       新工程報價

原因：-

分發東莞各部門：

- ( ) 生產技術總監  連附件    ( ) 技術部  連附件    ( ) 生產部  連附件    ( ) 機械設計部  連附件  
 ( ) 採購部  連附件    ( ) 生產統籌部  連附件    梅軍  
 ( ) 質檢部  連附件    ( ) 會計部  連附件    ( ) 報關組  連附件    ( ) 其他 \_\_\_\_\_  連附件

分發香港各部門：


- ( ) 行政部  連附件    ( ) 會計部  連附件    ( ) 統籌部  連附件    ( ) 工程部地盤科  連附件    積哥, 2室  
 ( ) 採購部  連附件    ( ) QS 部  連附件    ( ) 維修部  連附件    ( ) 其他 \_\_\_\_\_  連附件



傳遞編號：HK 1097/21

發件人簽署：[Signature]  
 項目經理簽署：P.P. [Signature]

BM編號:		工程號: J-851		計算: JOE		日期: 17/5/2021		送呈: 施哥				
		修改版本: 樓河鋁板 18/F-33/F		核對: JOE <td colspan="2">日期: 17/5/2021 <td colspan="2">副本:</td> </td>		日期: 17/5/2021 <td colspan="2">副本:</td>		副本:				
MIDI Aluminium Fabricator Ltd.		項目類別:		批准:		日期:		此BM依據大圖計算				
序號	鋁板圖號	鋁板名稱	顏色	實用	後備	總數	總重量	單件展開面積	總展開面積	單件V.F.	總V.F.	備註
1	GB-A2-03G	2mm厚鋁板	UCT534509SG-3深灰色	15	0	15	13.228	0.163	2.441	0.163	2.441	
2	GB-B1R-03W	3mm厚鋁板	TUC43350 白色	15	0	15	76.756	0.629	9.441	0.603	9.051	
3			總數量	30		總重	90	總展開	12	總V.F	11	

2 (18)

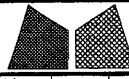 美特铝质有限公司 MIDI Aluminium Fabricator Ltd.			工程號 J851 地盘 青衣190	類別 制圖 W. E. X	物料號 - 2020-05-13	圖號 GB-B1R
修改 - 日期 -	採用工廠 材料颜色 -	地盤 <input checked="" type="checkbox"/>	图纸名称 铝板加工图 材料 3mm厚铝板	復核 - 批准 -	數量 - 單件重量 - (KG)	

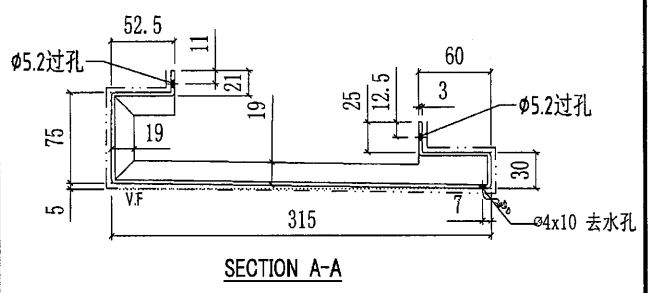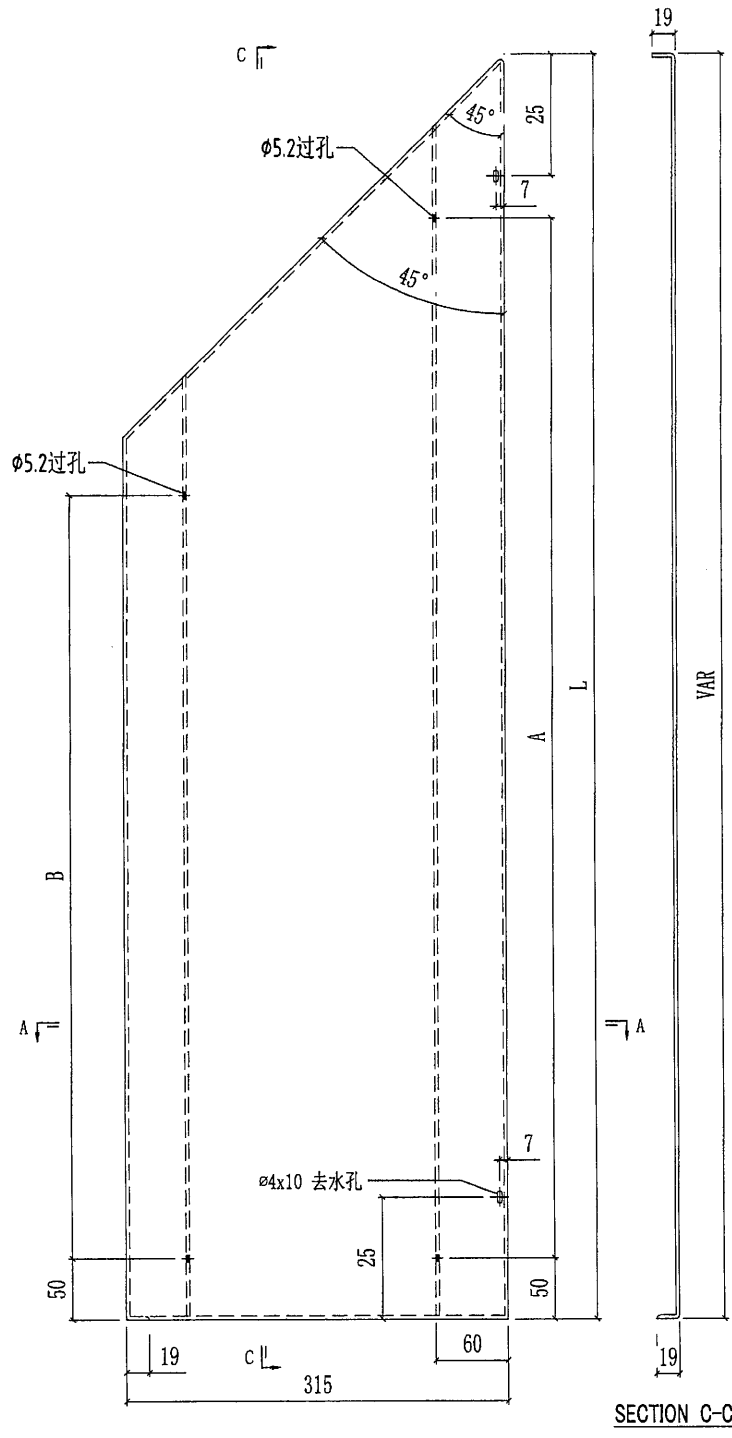


部件编号	L	A	B	颜色	颜色编号	数量
GB-B1R-03W	1060	@300X3	@300X2	WHITE	TUC43350	15


----- 喷涂面

3


16

 <b>美特鋁質有限公司</b> MIDI Aluminium Fabricator Ltd.				工程號	J851	類別	物料號 -		
				地盘	青衣190	制圖	W. E. X	2020-05-13	圖號 GB-A2
修改	-	-	-	採用工廠		地盤	✓	图纸名称	铝板加工图
日期	-	-	-	材料颜色	-	材料	1.5mm厚铝板	復核	-
						批准	-	數量	-
								單件重量	- (KG)

部件编号	L	颜色	颜色编号	数量
GB-A2-03G	2092	深灰色	UCT534509SC-3	15
C				

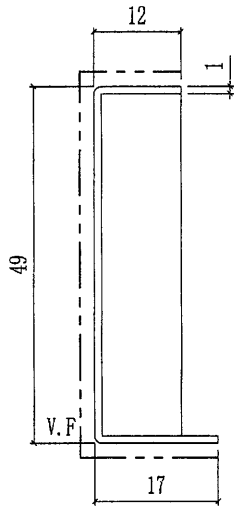

SECTION A-A


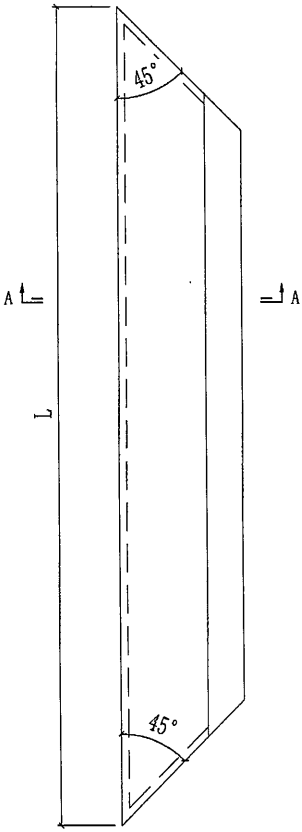


----- 噴塗面

補正件 (18/F-32/F)

28

4

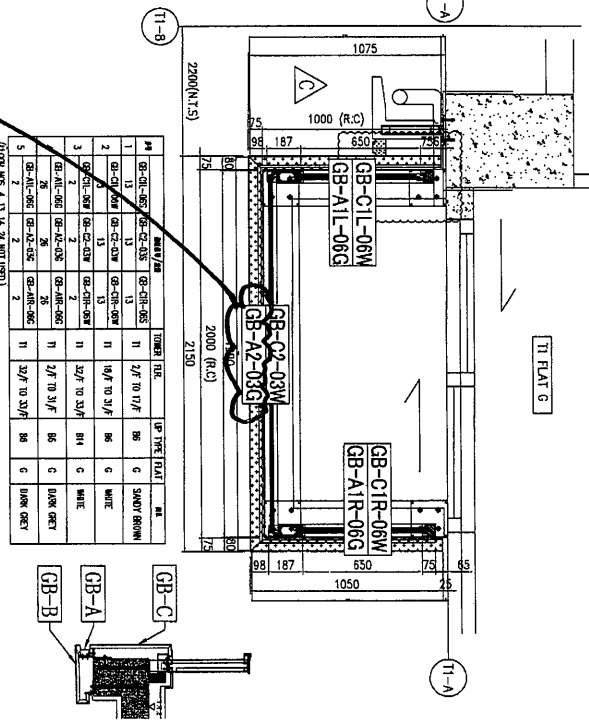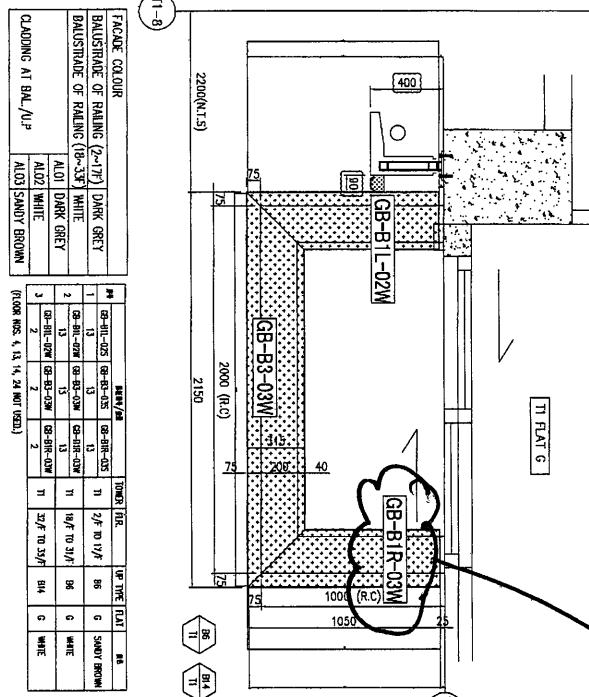

NO.	DESCRIPTION	UNIT	QTY	REMARKS
1	GB-B1-02M	1	1	
2	GB-B3-03W	1	1	
3	GB-B1R-03W	1	1	

NO.	DESCRIPTION	UNIT	QTY	REMARKS
1	GB-C1-08W	1	1	
2	GB-A11-06G	1	1	
3	GB-C2-03W	1	1	
4	GB-A2-03G	1	1	
5	GB-C1R-08W	1	1	
6	GB-A1R-06G	1	1	

補正件 (18/F-32/F)

**CLIENT :** 佳明集團控股有限公司  
GRAND MING GROUP HOLDINGS LIMITED

**MAIN CONTRACTOR :** GRAND TECH CONSTRUCTION CO. LTD.

**ARCHITECT :** HOKU-TSUNO & PARTNERS LIMITED

**STRUCTURAL ENGINEER :** C M WONG & ASSOCIATES LTD.

**PROJECT :** RESIDENTIAL DEVELOPMENT AT TINGS VI TOWN LOT 180 SHI SHAN ROAD

**TITLE :** SCHEDULE OF GLASS BALUSTRADE AT BALCONY

**JOB NO. :** J-451

**ISSUE NO. :** LS      **DATE :** 18-11-2019

**SCALE :** 1:50

**REV. :** -

**REVISIONS:**

NO.	DATE	REVISION

**GENERAL NOTES:**

1. F.F.L. - Finished Floor Level
2. S.F.L. - Structural Floor Level
3. All dimensions to be worked on site unless otherwise indicated.

**Legend :**

- 1. F.F.L. - Finished Floor Level
- 2. S.F.L. - Structural Floor Level
- 3. All dimensions to be worked on site unless otherwise indicated.

**Legend :**

- 1. F.F.L. - Finished Floor Level
- 2. S.F.L. - Structural Floor Level
- 3. All dimensions to be worked on site unless otherwise indicated.