



工程指示 / 要求簡箋(E.I.)

工程指示編號：EI / 1352 / 19

修改版次：A

工程編號：J - 852

工程名稱：亞皆老街中電

工程項目：CANOPY 地盤用預埋碼

收件人：MAGGIE

發件人：Pessie Lau

日期：16/12/2019

要求提供 / 確認 事項：

- | | | |
|------------------------------------|-------------------------------------|-------------------------------|
| <input type="checkbox"/> 初步鋁料 B.M. | <input type="checkbox"/> 加工拆圖，然後生產 | <input type="checkbox"/> 尺寸表 |
| <input type="checkbox"/> 正式鋁料 B.M. | <input type="checkbox"/> 技術上資料 / 指示 | <input type="checkbox"/> 報價 |
| <input type="checkbox"/> 配件 B.M. | <input type="checkbox"/> 樣辦或貨品說明書 | <input type="checkbox"/> 分判合約 |
| <input type="checkbox"/> 其他：_____ | | |

內容：

煩請按此修改預埋碼 (加開 4 個直徑為 5mm 的小孔以供預埋碼固定在釘板上)

已跟強記聯絡，以上改動並不會影響貨期，預算今天驗焊，周四送到香港

送 1/F

100% VISUAL

100% MPI

(Cantilever)

請在 19/12/19 前完成上列要求。

附有關圖紙 / 文件：

阿基：預埋碼星期四會送到 J-837
煩請安排送回銅 1/F

以上項目為：

- 原合約工程包 原合約工程加 / 減賬 新工程報價

原因：-

分發東莞各部門：

- () 生產技術總監 連附件 () 技術部 連附件 () 生產部 連附件 () 機械設計部 連附件
() 採購部 連附件 () 生產統籌部 連附件
() 質檢部 連附件 () 會計部 連附件 () 報關組 連附件 () 其他 _____ 連附件

分發香港各部門：

- () 行政部 連附件 () 會計部 連附件 () 統籌部 連附件 () 工程部地盤科文 連附件
() 採購部 連附件 () QS 部 連附件 () 維修部 連附件 () 其他 _____ 連附件

傳遞編號：

發件人簽署：

項目經理簽署：

修改版本: A

日期: 16/12/2019

B.D. REF :

CLIENT :

ARCHITECT :
AGC DESIGN LTD

MAIN CONTRACTOR :
Gammon

STRUCTURAL ENGINEER :
ARUP

FAÇADE CONSULTANT :
MEINHARDT

NOTE :
1. ALL DIMENSIONS ARE IN mm.
2. ALL ELEVATIONS ARE VIEWED FROM OUTSIDE.
3. ALL DIMENSIONS TO BE VERIFIED ON SITE BEFORE FABRICATION.

LEGEND :
x1 --- DETAIL MARK NO.
x001 --- REFER SHEET NO.

1. F.F.L. --- FINISHED FLOOR LEVEL
2. S.F.L. --- STRUCTURAL FLOOR LEVEL
3. (R) --- REVERSED DETAIL

NO.	DATE	REVISED	BY
-----	------	---------	----

JOB NO. : J-852

PROJECT :
PROPOSED RESIDENTIAL DEVELOPMENT
AT 139 - 147 ARGYLE STREET,
NKIL 6005, 6035 R.P., 6036 R.P.,
6037 R.P. & 6038 R.P.


TITLE :
EMBED DETAILS OF
CANOPY AT LG2
EB-CAN

DATE : 22-NOV-19 SCALE : 1:4


DRAWN BY : MN CHECKED BY : DW

美特鋁質有限公司
MIDI ALUMINIUM FABRICATOR LTD.
Units 6-8, Sunray Industrial Centre, 1/F
610 Cha Kwo Ling Road, Kowloon
Tel: 23489211-4 Fax: (852) 27727666
DWG NO. : J852-SD-CAN-9001 REV. : -


(100% Visual)
(100% MPI)

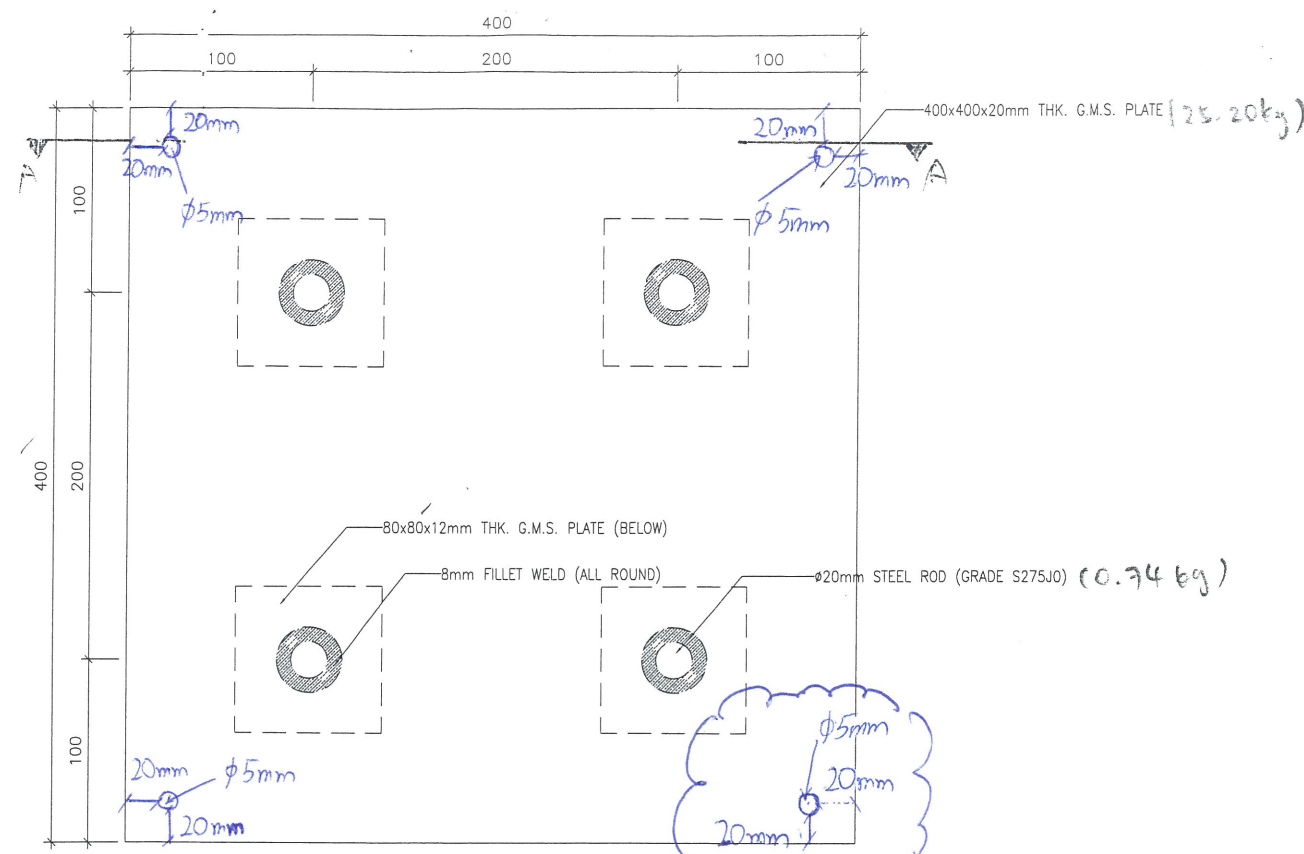

For 釘板時連同預埋端用鐵釘收
A 版本
鐵板四角加開小孔

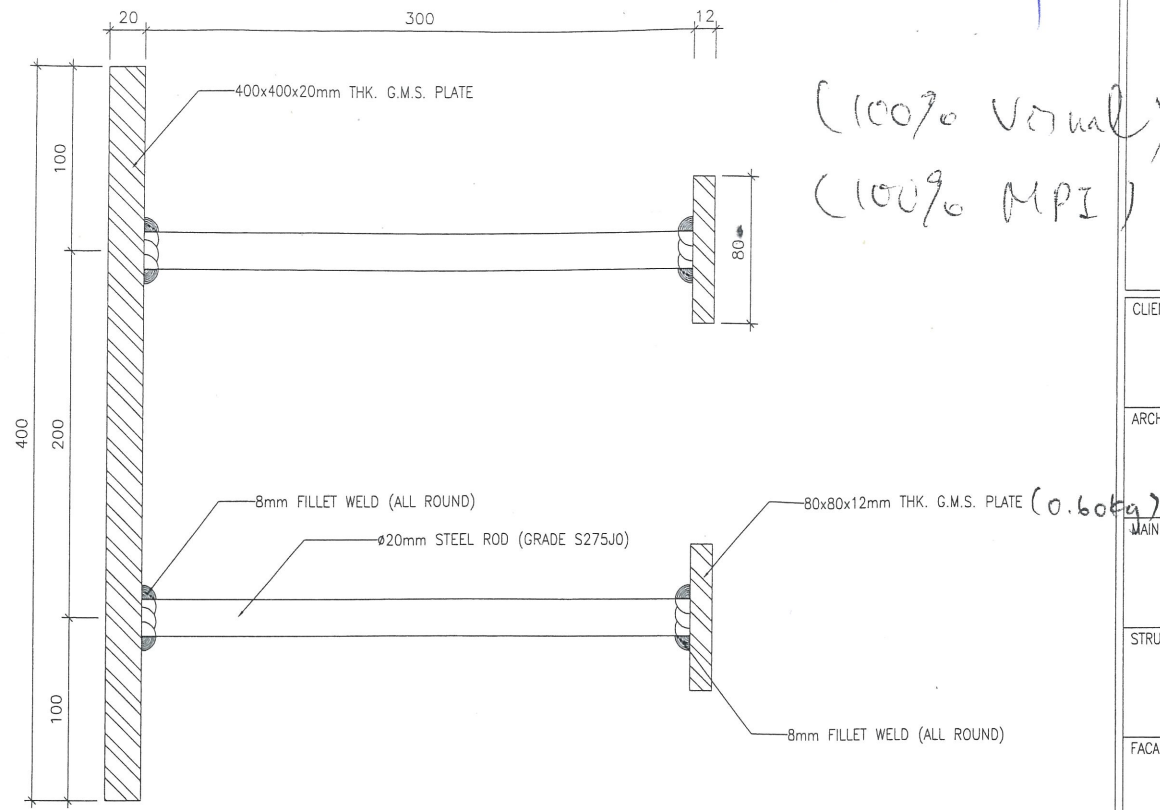

B-B

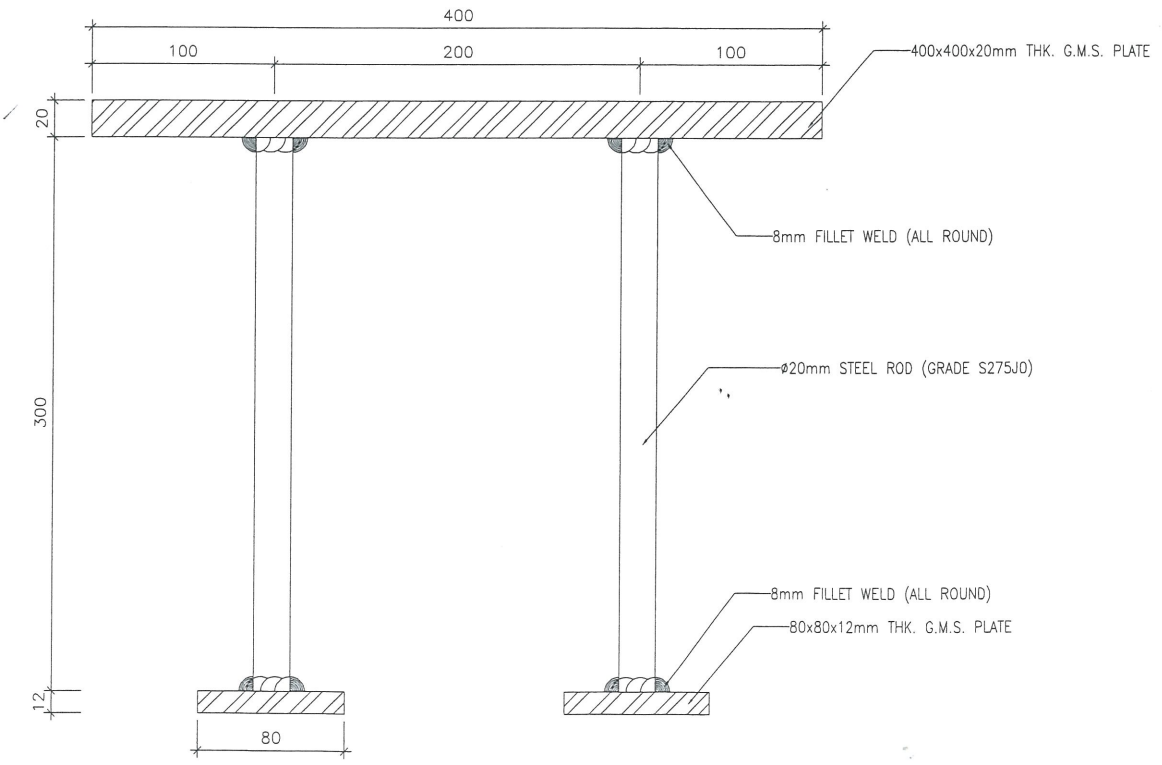

A-A

圖號: 6M01
名稱: 預埋件
材料: 如圖所示
顏色: 熱浸鋅
數量: 5件 + (1件(後備)) = 6件
單件重量 = 25.20 + (0.74 x 4) + (0.60 x 4)
= 30.56 kg
總數量 = 183.36 kg.

TYPE	DESCRIPTION	BOND LENGTH	LOCATION	CASE	MAX c/c
EB-CAN	400x400x20mm THK. G.M.S. CAST-IN EMBED	300	LG2 CANOPY	TYPICAL	--