

工程指示 / 要求簡箋(E.I.)

工程指示編號：EI / 1454 / 19

修改版次：

工程編號：J - 852

工程名稱：亞皆老街中電

工程項目：SHOWFLAT 趟門 / 隔音板路軌 / 欄河 / 天花鋁冚 配油漆

收件人：MAGGIE

發件人：Bessie Lau

日期：14/01/2020

□要求提供 / □確認 事項：

- | | | |
|------------------------------------|-------------------------------------|-------------------------------|
| <input type="checkbox"/> 初步鋁料 B.M. | <input type="checkbox"/> 加工拆圖，然後生產 | <input type="checkbox"/> 尺寸表 |
| <input type="checkbox"/> 正式鋁料 B.M. | <input type="checkbox"/> 技術上資料 / 指示 | <input type="checkbox"/> 報價 |
| <input type="checkbox"/> 配件 B.M. | <input type="checkbox"/> 樣辦或貨品說明書 | <input type="checkbox"/> 分判合約 |
| <input type="checkbox"/> 其他：_____ | | |

內容：

現附上色辦 1 件，煩請安排富昌配油共 1 公升(先配 1 公升，啱色再增訂)，另請於富昌訂購新勁牌合金底油共 1 公升 送 1/E，用後請退回色辦，謝謝！

(辦房後加工程已收 SI, 如附件)

COLOR: METALLIC BRONZE

(跟業主 JIMMY 指示辦房油漆按 1st submission of alum. cladding color sample MC/39226/852 配色)

請在 18/1/2020 前完成上列要求。

附有關圖紙 / 文件：

以上項目為：

 原合約工程包 原合約工程加 / 減賬 新工程報價

原因：-_____


分發東莞各部門：

- | | | | | | | | |
|---------------------------------|------------------------------|--------------------------------|------------------------------|------------------------------|------------------------------|-----------------------------------|------------------------------|
| <input type="checkbox"/> 生產技術總監 | <input type="checkbox"/> 連附件 | <input type="checkbox"/> 技術部 | <input type="checkbox"/> 連附件 | <input type="checkbox"/> 生產部 | <input type="checkbox"/> 連附件 | <input type="checkbox"/> 機械設計部 | <input type="checkbox"/> 連附件 |
| <input type="checkbox"/> 採購部 | <input type="checkbox"/> 連附件 | <input type="checkbox"/> 生產統籌部 | <input type="checkbox"/> 連附件 | | | | |
| <input type="checkbox"/> 質檢部 | <input type="checkbox"/> 連附件 | <input type="checkbox"/> 會計部 | <input type="checkbox"/> 連附件 | <input type="checkbox"/> 報關組 | <input type="checkbox"/> 連附件 | <input type="checkbox"/> 其他 _____ | <input type="checkbox"/> 連附件 |

分發香港各部門：

- | | | | | | | | |
|------------------------------|------------------------------|-------------------------------|------------------------------|------------------------------|------------------------------|-----------------------------------|------------------------------|
| <input type="checkbox"/> 行政部 | <input type="checkbox"/> 連附件 | <input type="checkbox"/> 會計部 | <input type="checkbox"/> 連附件 | <input type="checkbox"/> 統籌部 | <input type="checkbox"/> 連附件 | <input type="checkbox"/> 工程部地盤科文 | <input type="checkbox"/> 連附件 |
| <input type="checkbox"/> 採購部 | <input type="checkbox"/> 連附件 | <input type="checkbox"/> QS 部 | <input type="checkbox"/> 連附件 | <input type="checkbox"/> 維修部 | <input type="checkbox"/> 連附件 | <input type="checkbox"/> 其他 _____ | <input type="checkbox"/> 連附件 |

傳遞編號：

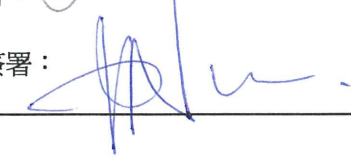發件人簽署：項目經理簽署：

Project: CLP Re-development Project

Site Instructions

S.I. No.: A.C.M. P.S. J.C. 120201 / 17 / 12:00
(Parties / Company / Issued Person / Year / Month / Date / Time)

To (Contractor): Midi Aluminium Fabricator Limited

Location : Exchange Tower Shaftfit Unit

Instructions:
Supply and install (1) noise screen rail
cover (2) Capping at Unit A Balcony
(3) Aluminium members at Unit C
Balcony ceiling and railing as per
attached sketches

For your immediate action on site (7 pages)
Drawing No. / Sketches No. 20200107-SI-Midi-SK01

Reasons for this Instruction:
Design development of Alu works.

Issued By: Jimmy Cheung
A.C.M.


Name, Title & Signature

Acknowledge Receipt: _____


Name, Title & Signature

Total Pages: _____


Contractor's Copy

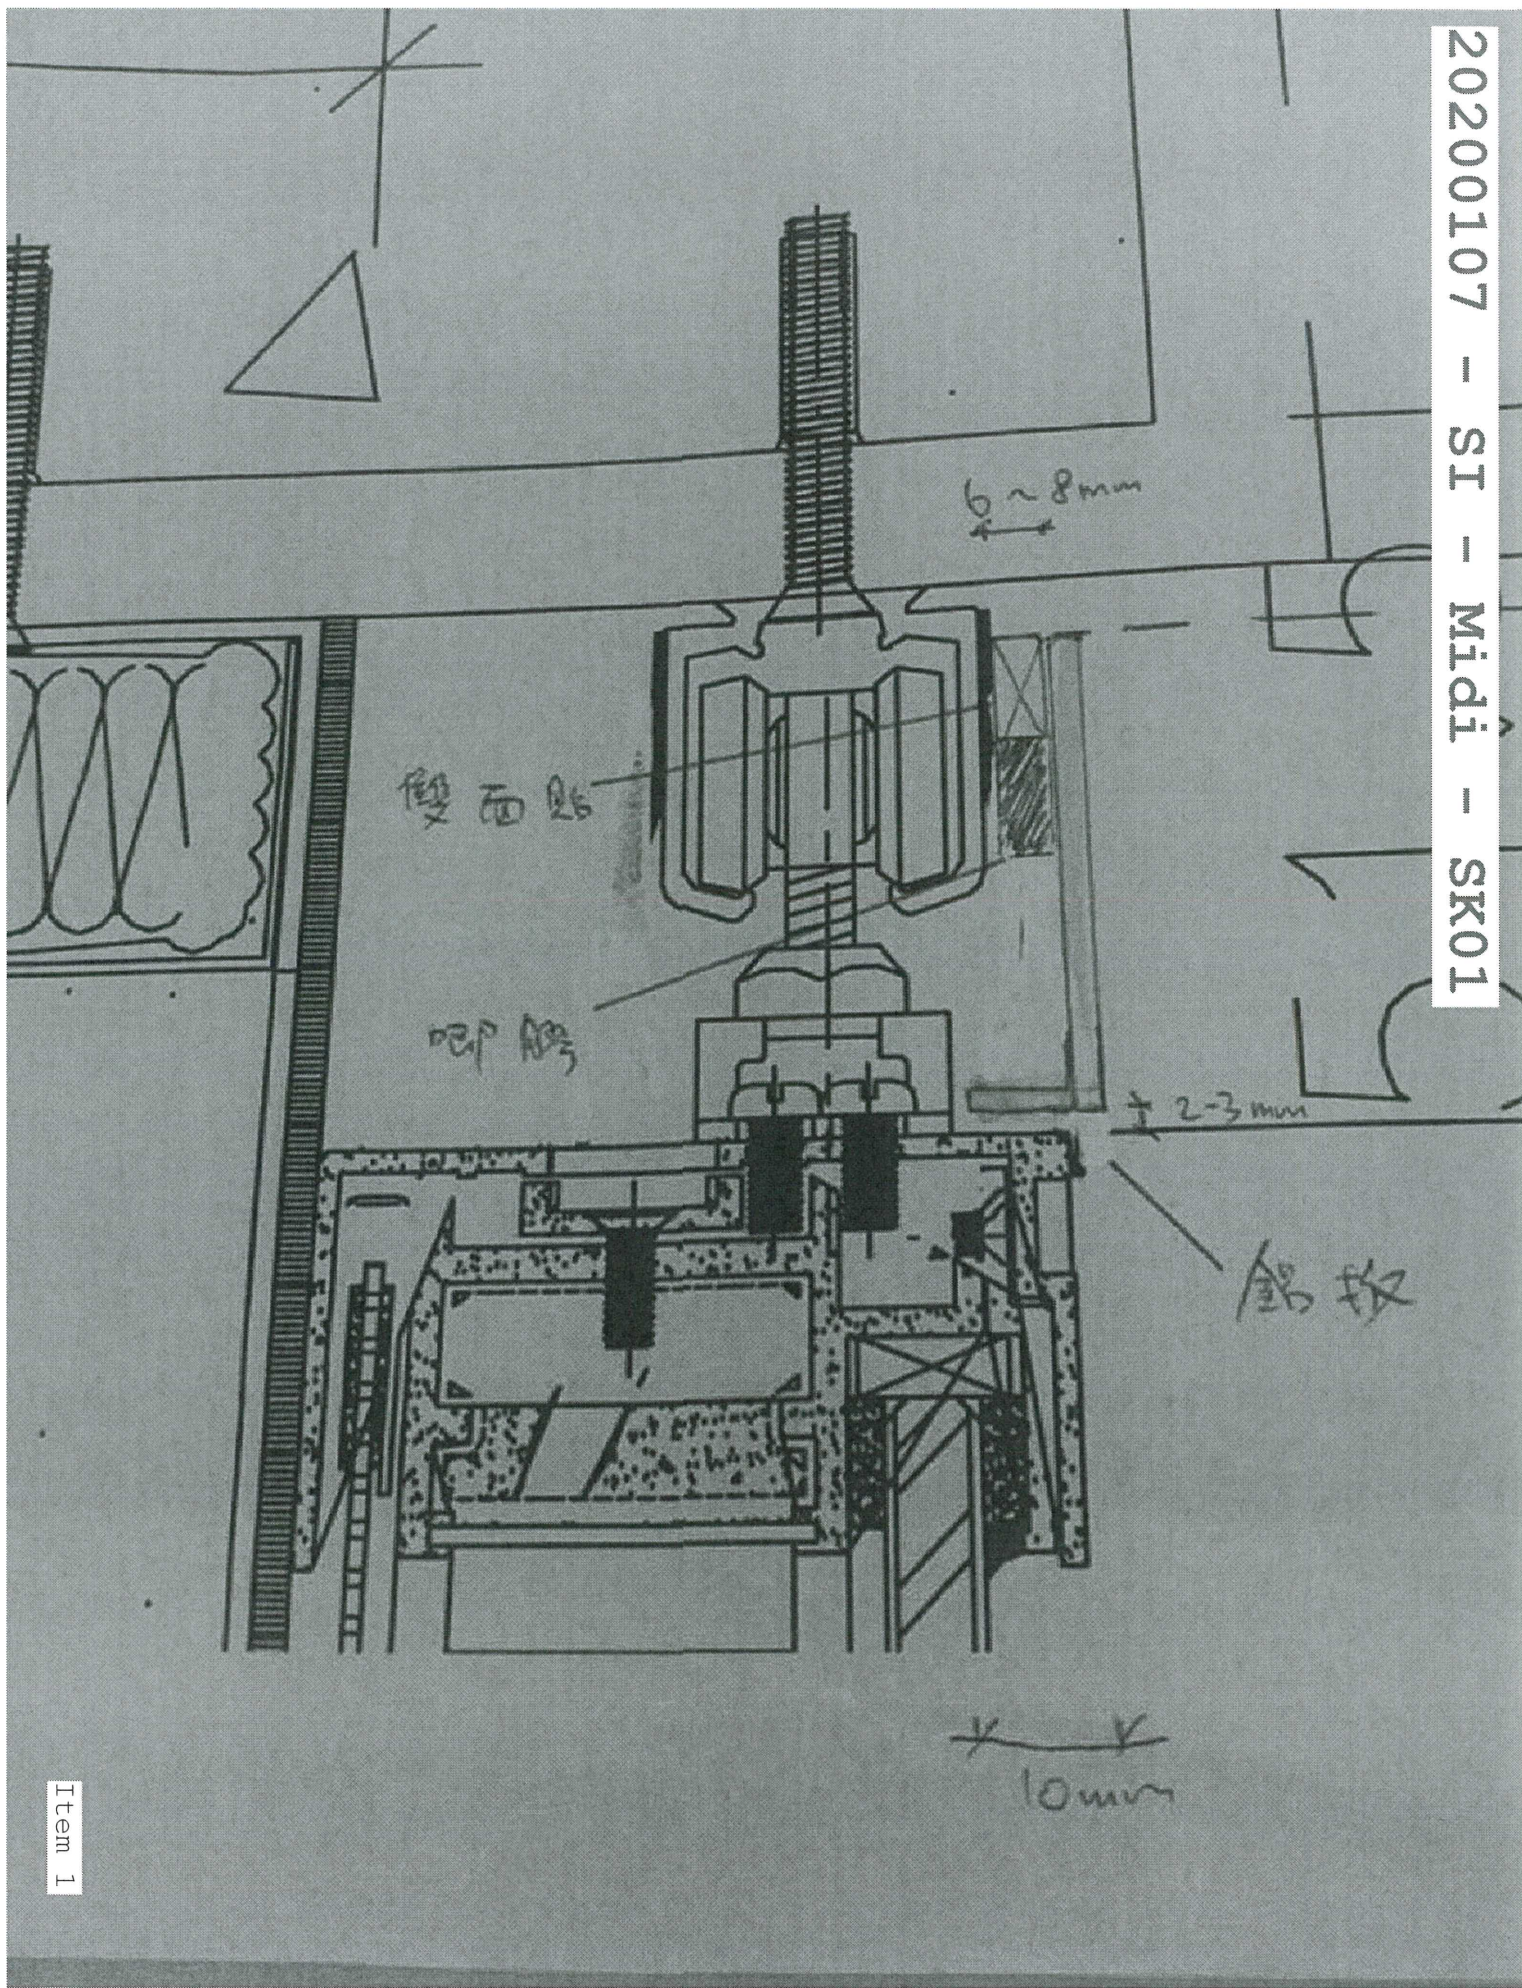

Additional Alum. Capping for Snowflant
(Flat A Balcony)

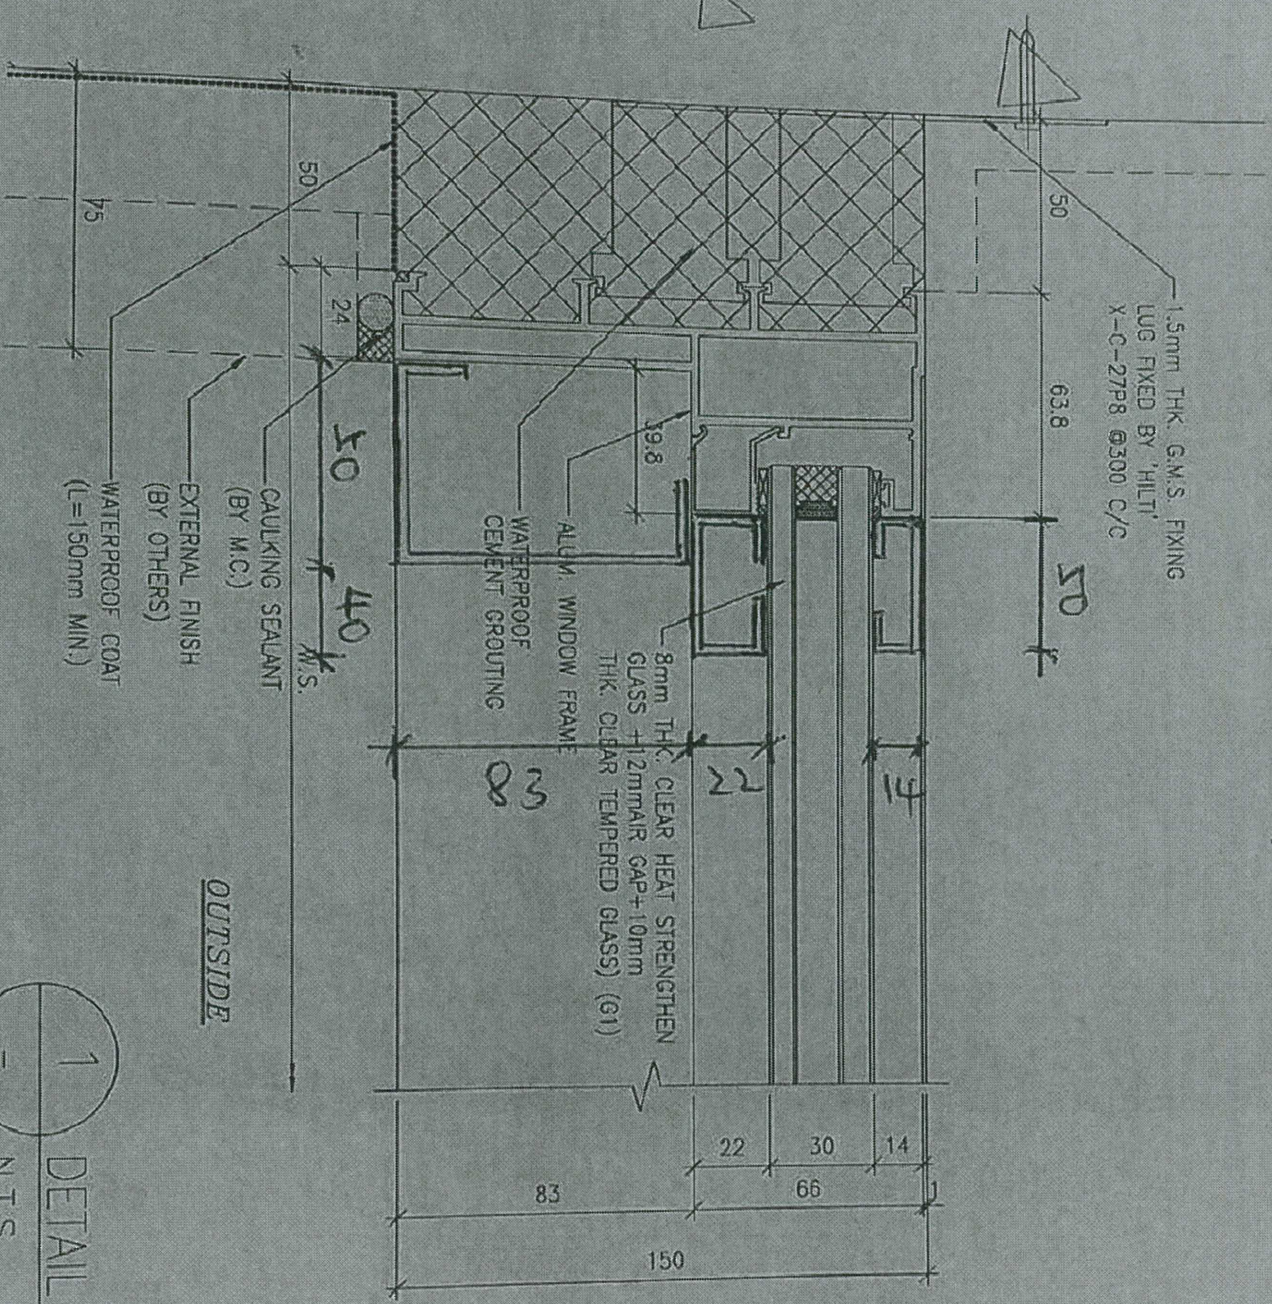

1
-
DETAIL
N.T.S.

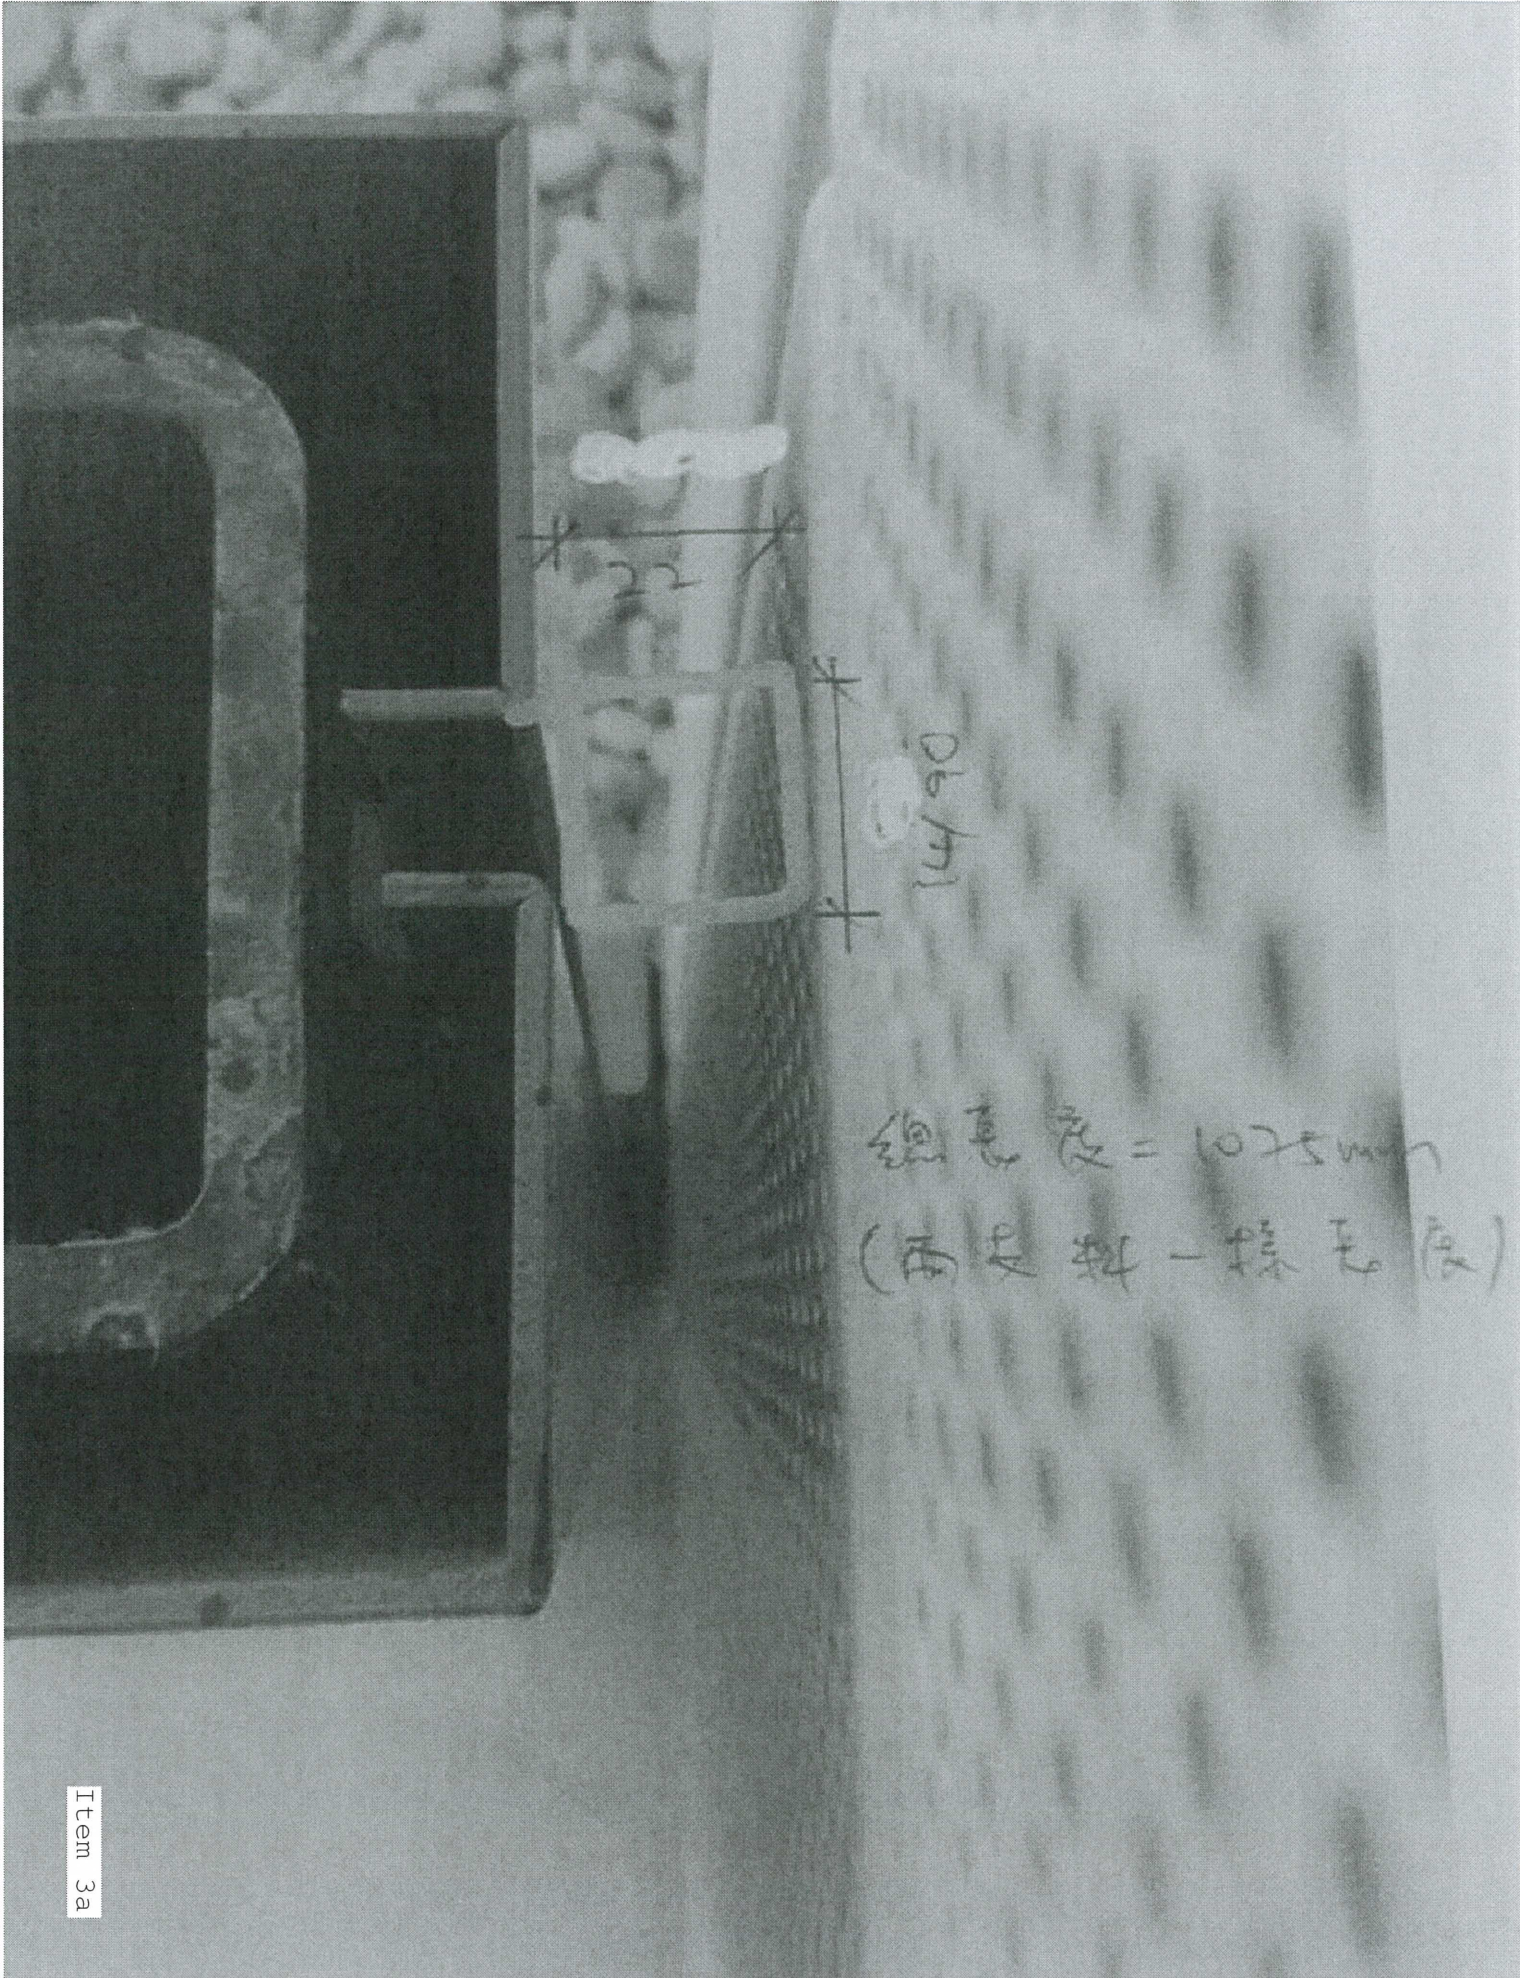


* 22 *

14790

總長度 = 1025mm
(兩段料一樣長度)

Item 3a

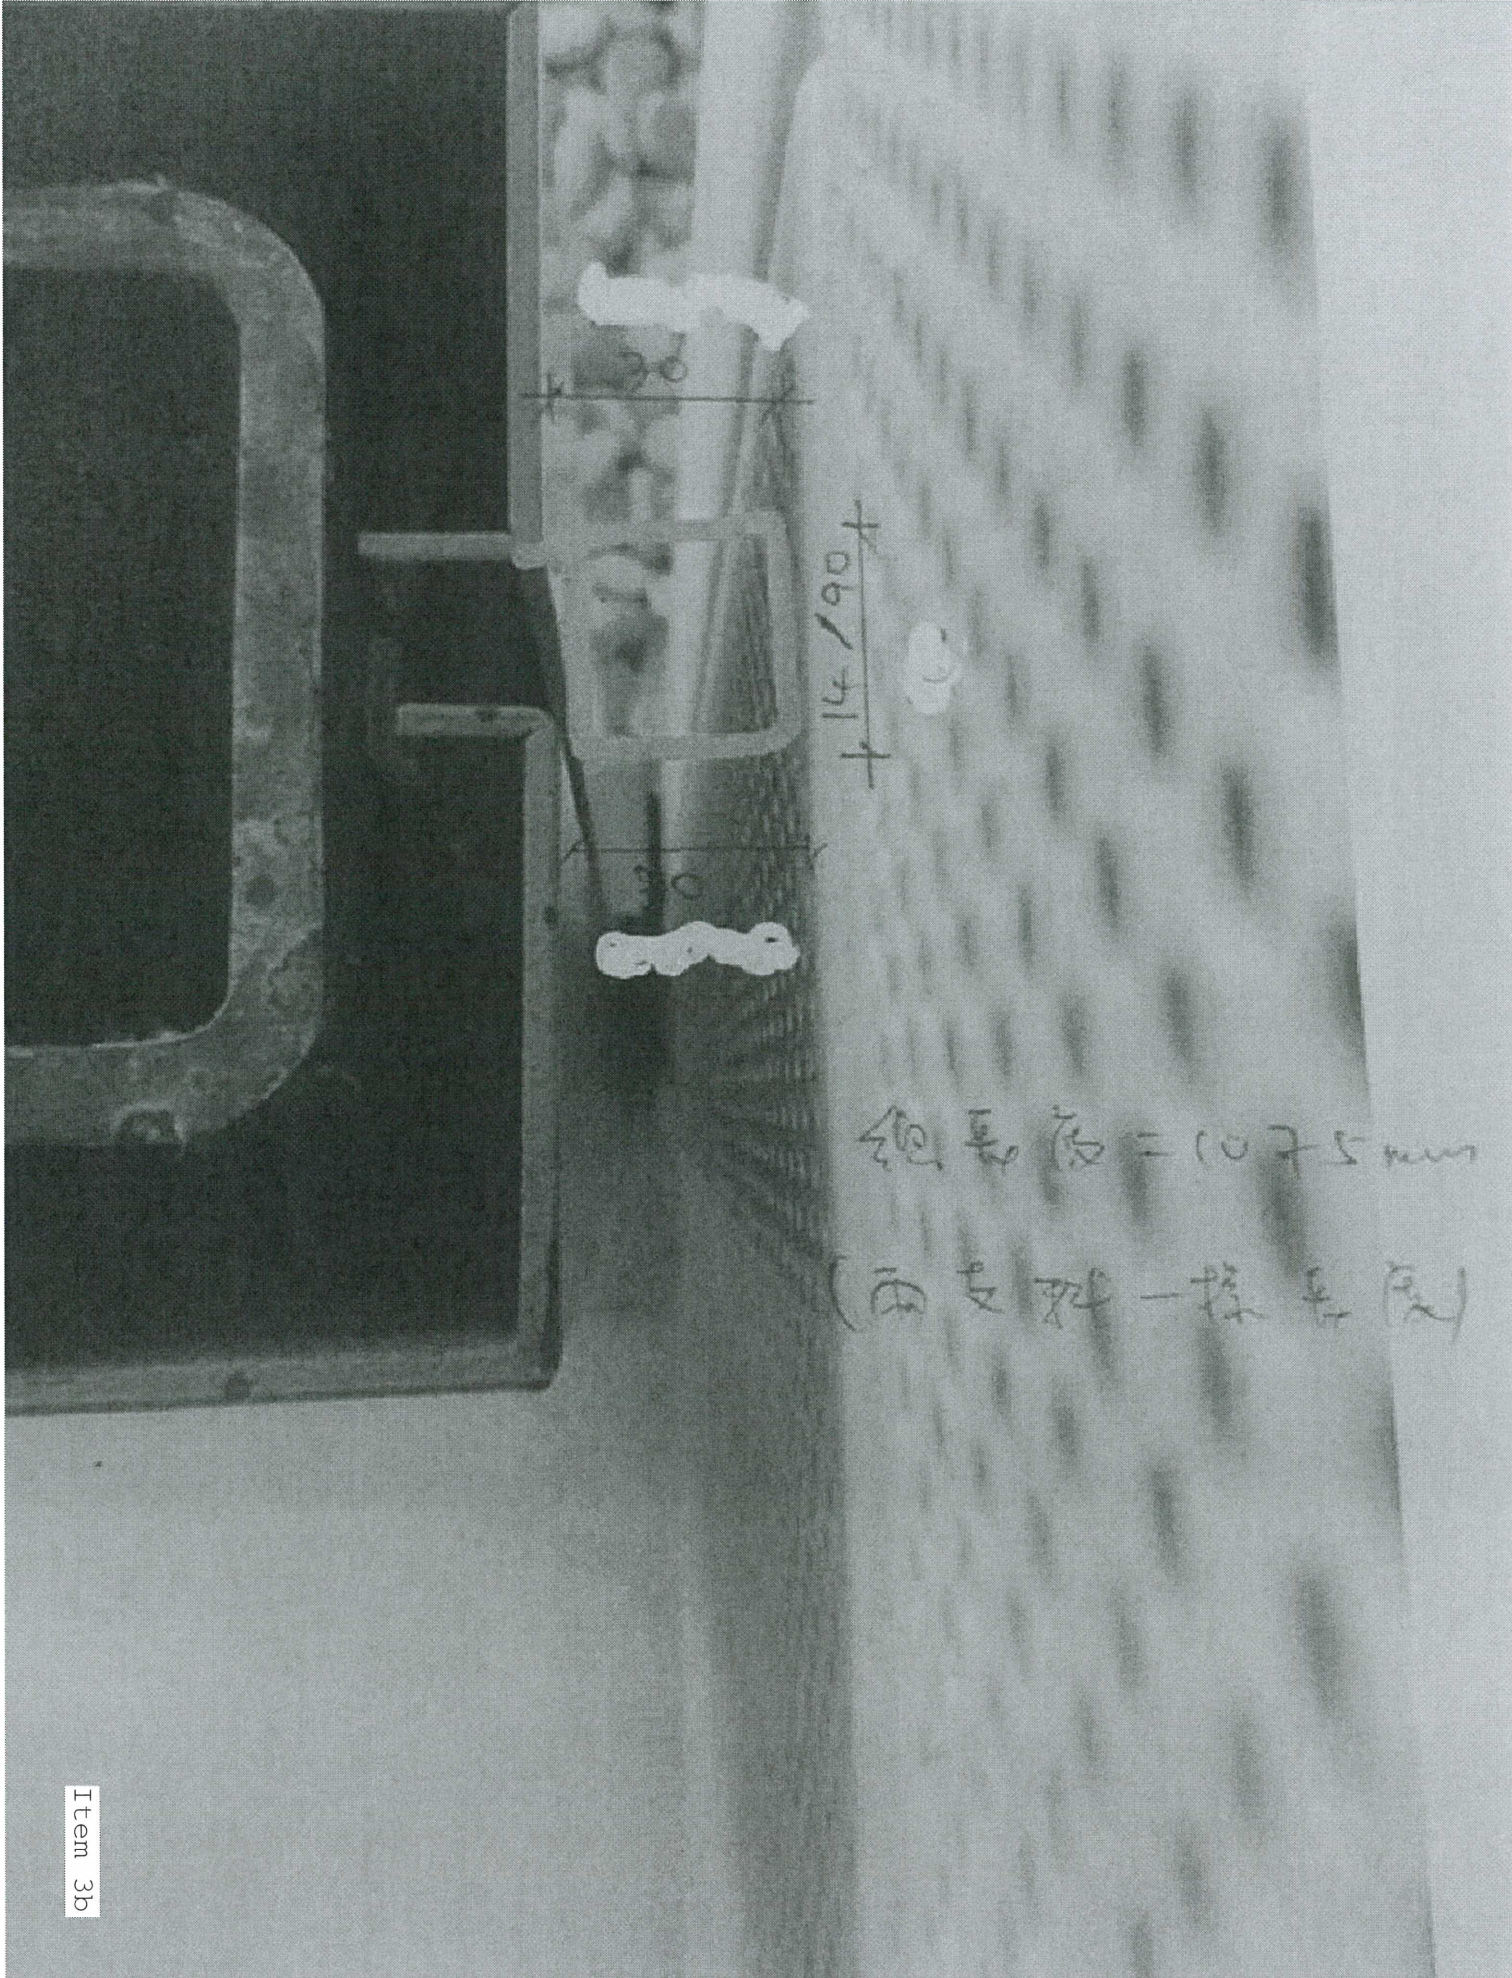

1490

30

30



總長為 = 1075 mm

(兩支料一揀長尺)




Item 3c

辦字房原有之鋸齒高度為 55mm

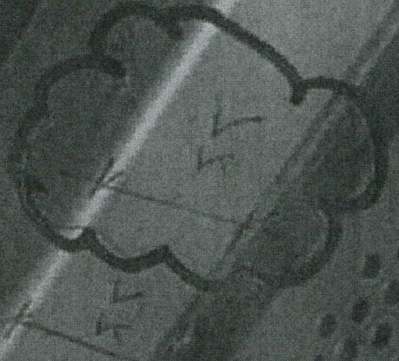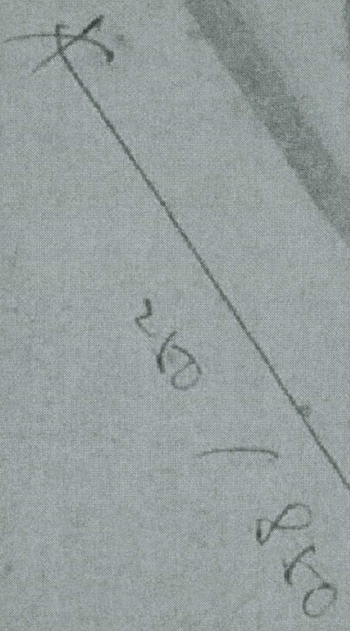

AT 1200 (H) FROM F.F.L.

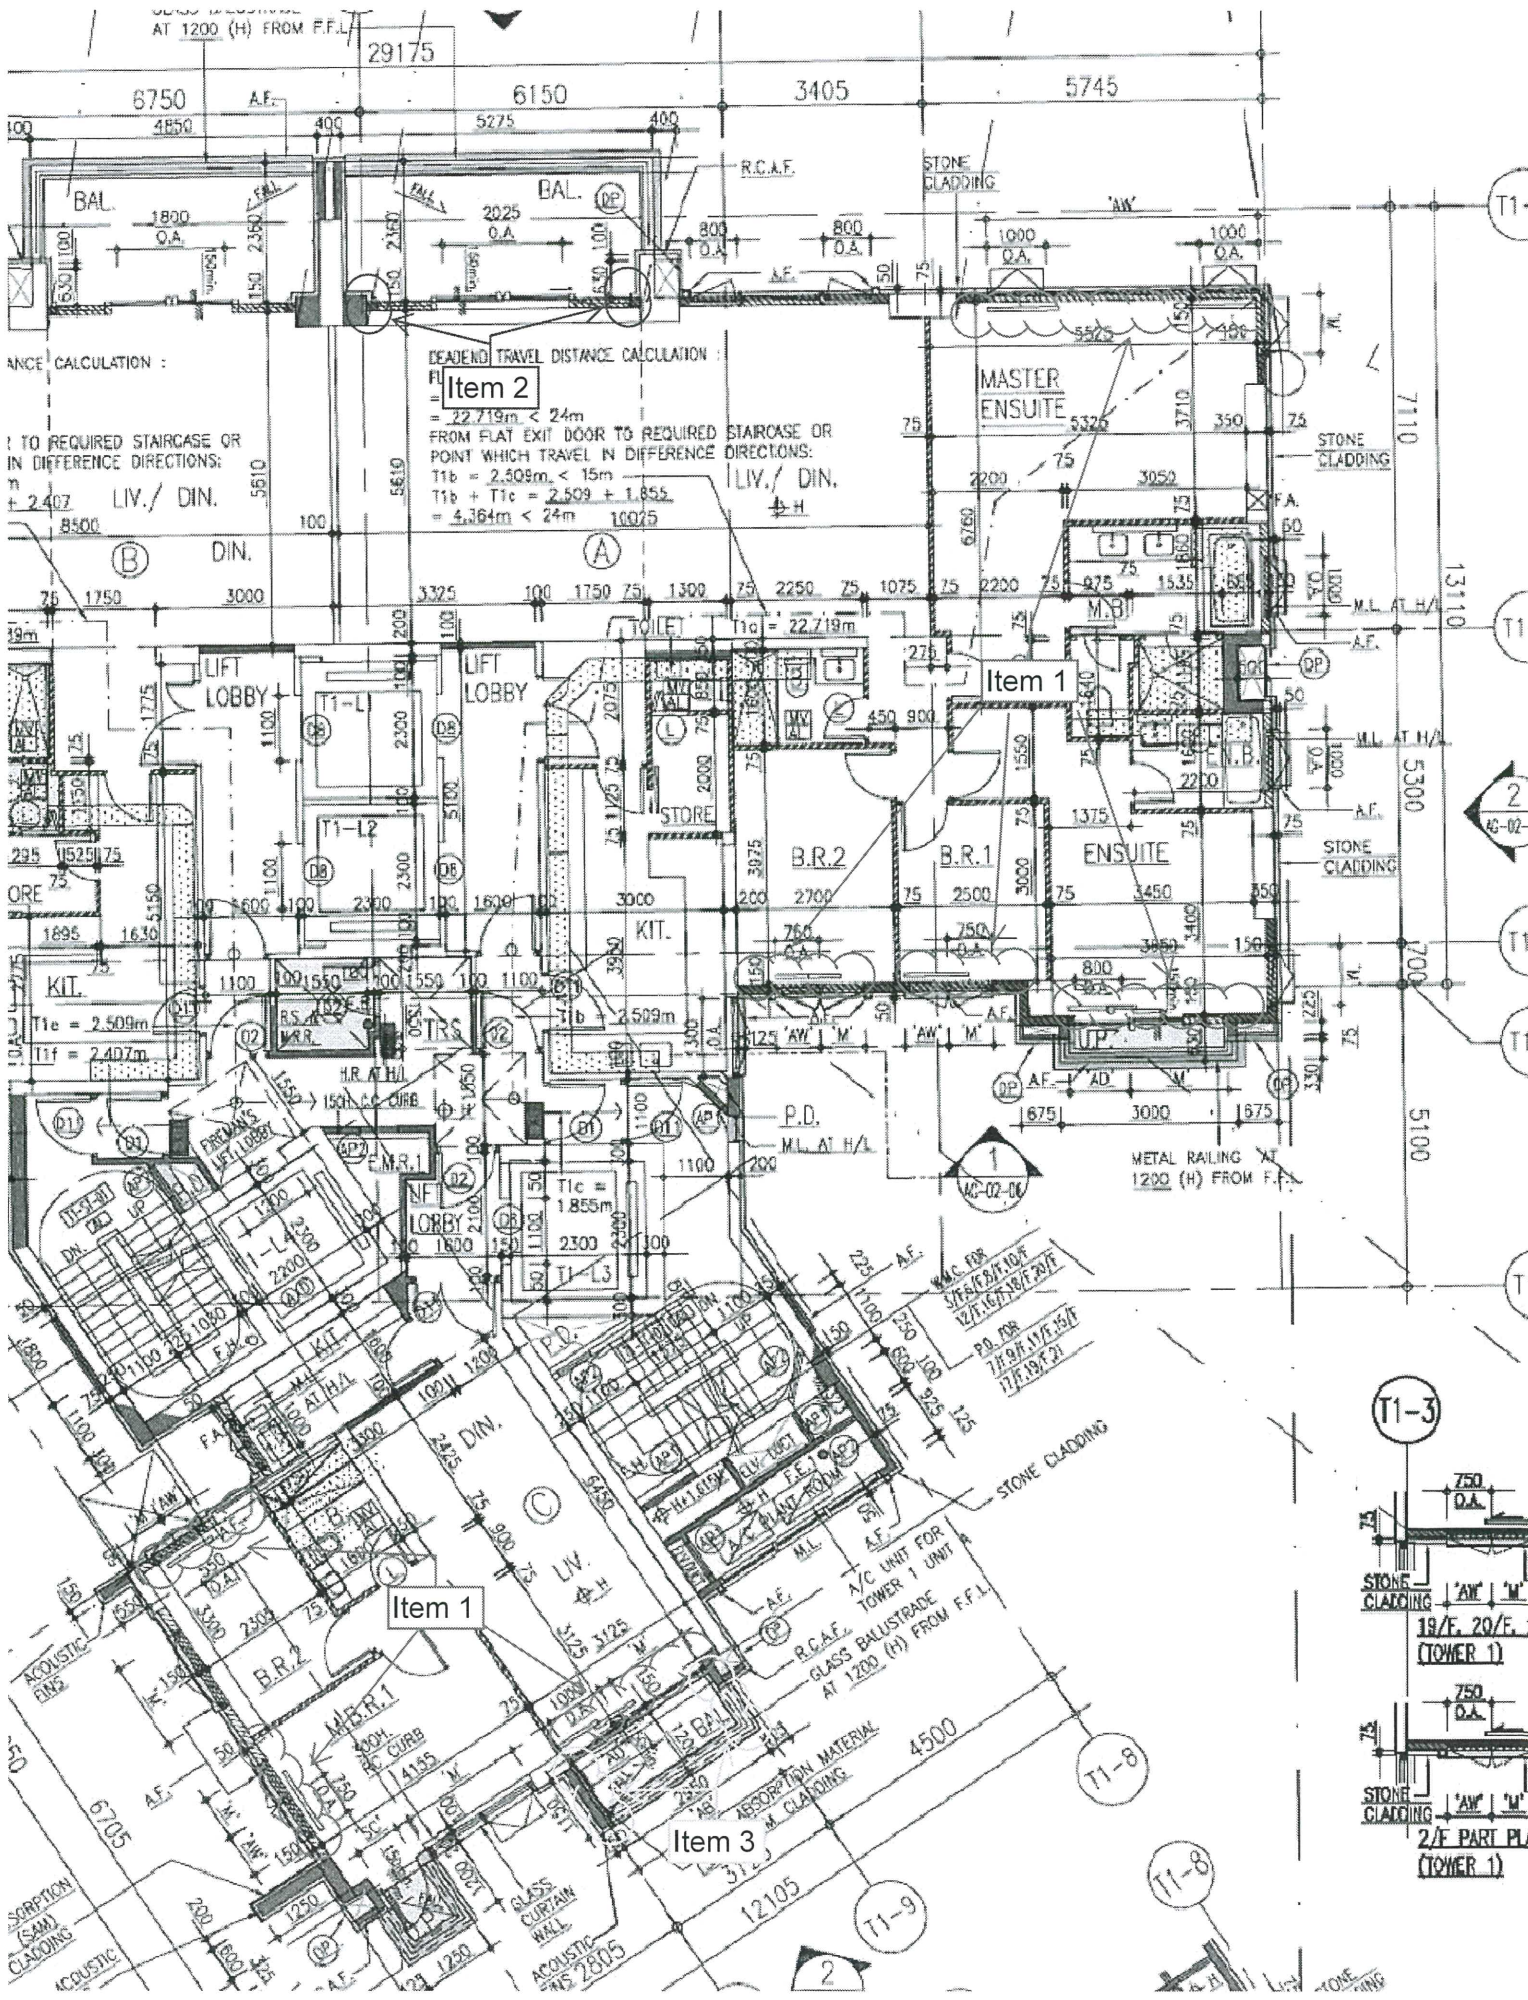

ANCE CALCULATION :


TO REQUIRED STAIRCASE OR IN DIFFERENCE DIRECTIONS:
n + 2.407 LIV./ DIN.

HEADEND TRAVEL DISTANCE CALCULATION :

Item 2
 $= 22.719m < 24m$
 FROM FLAT EXIT DOOR TO REQUIRED STAIRCASE OR POINT WHICH TRAVEL IN DIFFERENCE DIRECTIONS:
 $T1b = 2.309m < 15m$
 $T1b + T1c = 2.509 + 1.855$
 $= 4.364m < 24m$

MAC FOR STAIRCASE
 12/16/18/20/22
 PA FOR
 7/8/9/11/13/15/17/19/21

METAL RAILING AT 1200 (H) FROM F.F.L.

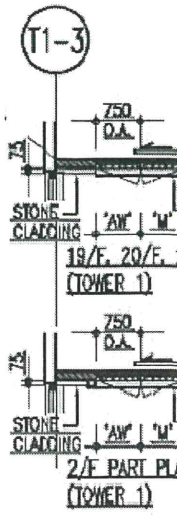

ACROUSTIC RING
ACROUSTIC RING

