

工程指示 / 要求簡箋(E.I.)

工程指示編號：EI / 1613 / 20 修改版次：

工程編號：J - 852 工程名稱：亞皆老街中電

工程項目：佛沙窗 - 鋁模生產 共 6 個

收件人：MAGGIE / 生統 發件人：Bessie Lau 日期：24/03/2020

要求提供 /  確認 事項：

- |                                    |                                     |                               |
|------------------------------------|-------------------------------------|-------------------------------|
| <input type="checkbox"/> 初步鋁料 B.M. | <input type="checkbox"/> 加工拆圖，然後生產  | <input type="checkbox"/> 尺寸表  |
| <input type="checkbox"/> 正式鋁料 B.M. | <input type="checkbox"/> 技術上資料 / 指示 | <input type="checkbox"/> 報價   |
| <input type="checkbox"/> 配件 B.M.   | <input type="checkbox"/> 樣辦或貨品說明書   | <input type="checkbox"/> 分判合約 |
| <input type="checkbox"/> 其他：_____  |                                     |                               |

內容：

煩請按此生產鋁模 共 6 個

請在 30/4/2020 前完成上列要求。

附有關圖紙 / 文件：1 張模圖總結表 + 6 張模圖

以上項目為：

- 原合約工程包                       原合約工程加 / 減賬                       新工程報價

原因：-

分發東莞各部門：

- |  |   |   |  |
|--|---|---|--|
| <input type="checkbox"/> 生產技術總監 <input type="checkbox"/> 連附件 | <input type="checkbox"/> 技術部 <input type="checkbox"/> 連附件                         | <input type="checkbox"/> 生產部 <input type="checkbox"/> 連附件 | <input type="checkbox"/> 機械設計部 <input type="checkbox"/> 連附件    |
| <input type="checkbox"/> 採購部 <input type="checkbox"/> 連附件    | <input checked="" type="checkbox"/> 生產統籌部 <input checked="" type="checkbox"/> 連附件 |   |  |
| <input type="checkbox"/> 質檢部 <input type="checkbox"/> 連附件    | <input type="checkbox"/> 會計部 <input type="checkbox"/> 連附件                         | <input type="checkbox"/> 報關組 <input type="checkbox"/> 連附件 | <input type="checkbox"/> 其他 _____ <input type="checkbox"/> 連附件 |

分發其他分判：

- 水洪  連附件

分發香港各部門：

- |   |  |   |  |
|---|--|---|--|
| <input type="checkbox"/> 行政部 <input type="checkbox"/> 連附件 | <input type="checkbox"/> 會計部 <input type="checkbox"/> 連附件  | <input type="checkbox"/> 統籌部 <input type="checkbox"/> 連附件 | <input type="checkbox"/> 工程部地盤科文 <input type="checkbox"/> 連附件  |
| <input type="checkbox"/> 採購部 <input type="checkbox"/> 連附件 | <input type="checkbox"/> QS 部 <input type="checkbox"/> 連附件 | <input type="checkbox"/> 維修部 <input type="checkbox"/> 連附件 | <input type="checkbox"/> 其他 _____ <input type="checkbox"/> 連附件 |

傳遞編號：

HK 0409 / 20

發件人簽署：


項目經理簽署：

Aluminium Die for J852

Item	Die no.		Member no.	Grade	畫模圖E11573			開模E1			Remark
					0	A	B	0	A	B	
1	X85759	LH0091232	AL-PW01(0)	6063 T6	v			v			
2	X85760	LH0091233	AL-PW01M(0)	6063 T6	v						
3	X85761	LH0091234	AL-PW02(0)	6063 T6	v			v			
4	X85762	LH0091235	AL-PW03(0)	6063 T6	v			v			
5	X85763	LH0091236	AL-PW04(0)	6063 T6	v						
6	X85764	LH0091237	AL-PW05(0)	6063 T6	v		v				
7	X85765	LH0091238	AL-PW11(0)	6063 T6	v						
8	X85766	LH0091239	AL-PW12(0)	6063 T6	v						
9	X85767	LH0091240	AL-PW21(0)	6063 T6	v						
10	X85768	LH0091241	AL-PW22(0)	6063 T6	v						
11	X85769	LH0091242	AL02(0)	6063 T6	v						
12	X85770	LH0091243	AL21(0)	6063 T6	v		v				
13	X85771	LH0091244	AL22(0)	6063 T6	v						200深企通, 未計數
14	X85772	LH0091245	AL23(0)	6063 T6	v			v			
15	X85773	LH0091246	AL24(0)	6063 T6	暫停	v					Gary Lam通知套鐵OK, 不用改模
16	X85774	LH0091247	AL25(0)	6063 T6	v						
17	X85775	LH0091248	AL26(0)	6063 T6	v						
18	X85776	LH0091249	AL27(0)	6063 T6	v						
19	X85777	LH0091250	AL30(0)	6063 T6	x	x					A取消 (in situ用)
20	X85778	LH0091251	AL32(0)	6063 T6	v			v			
21	X85779	LH0091252	AL33(0)	6063 T6	v						



CUSTOMER	HONGKONG CO.	CUSTOMER APPROVAL	CUST PART NO.	X85761
			SECTION NO.	LH0091234

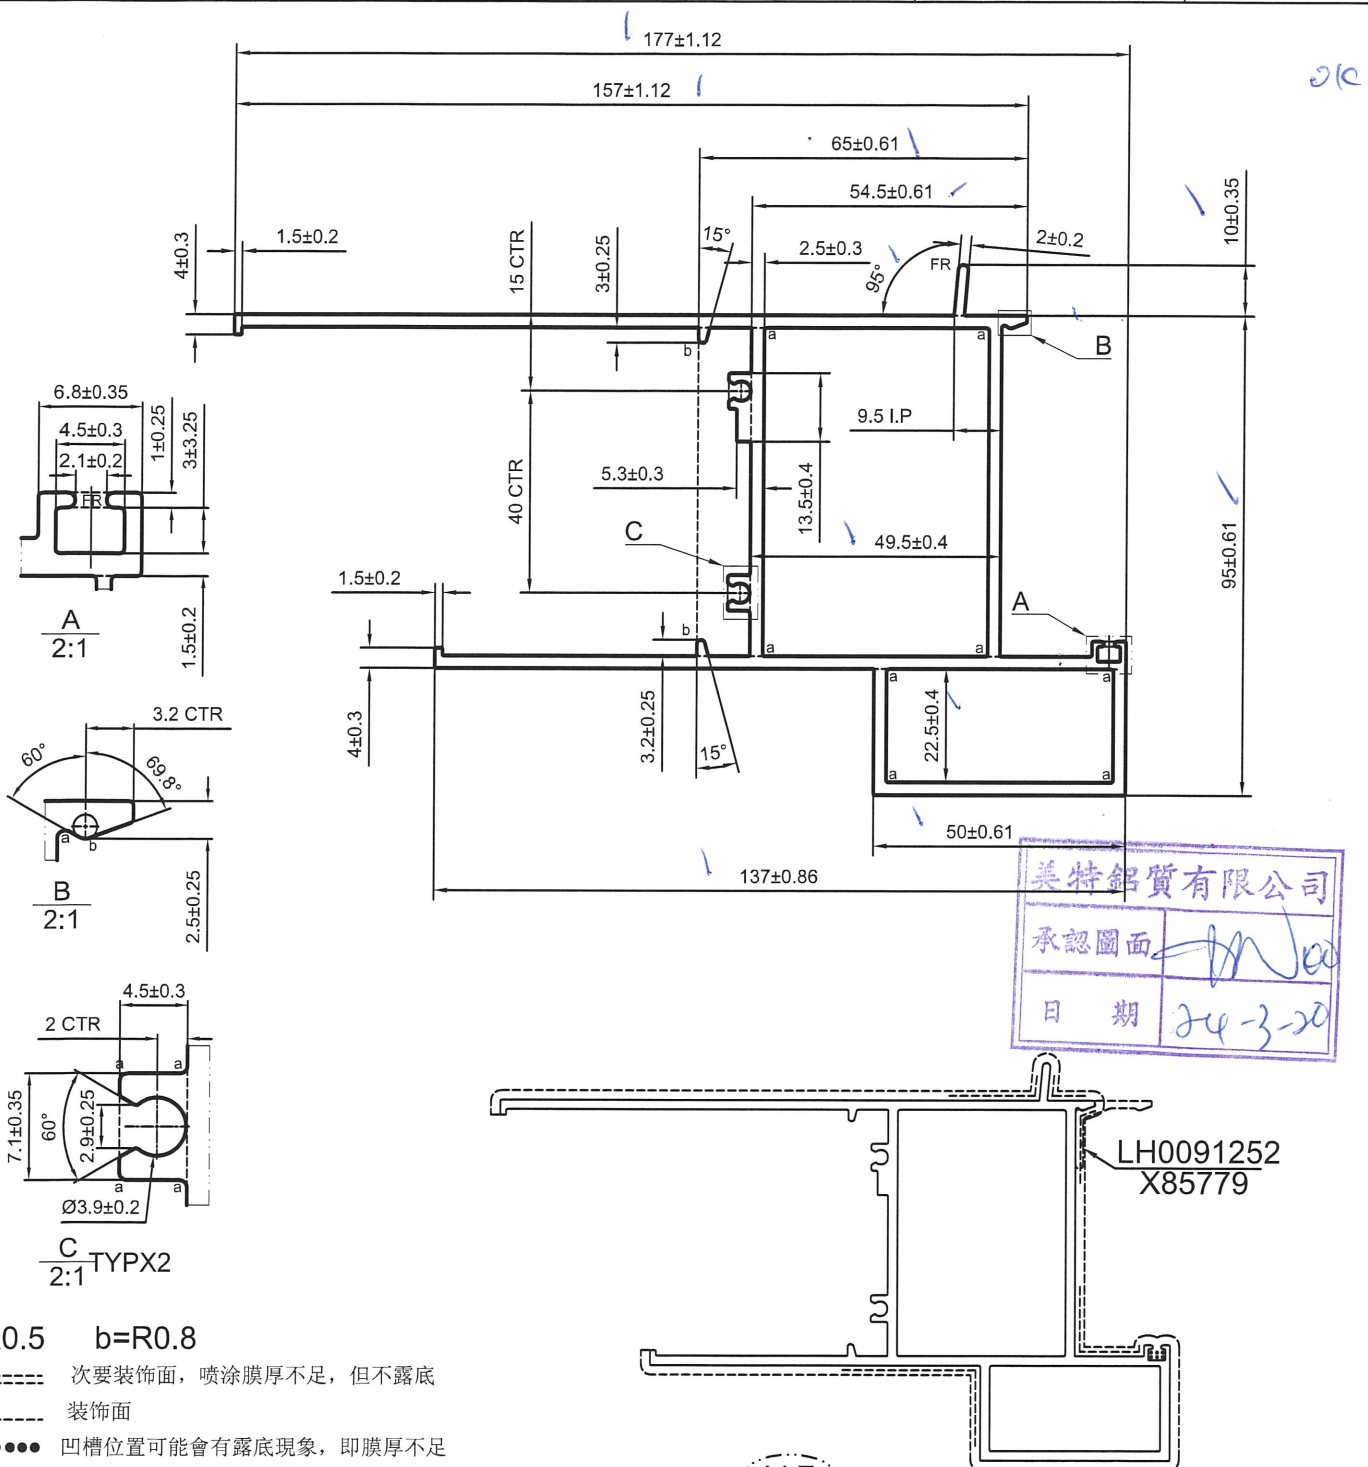

美特铝质有限公司  
 承認圖面  
 日期 24-3-20

a=R0.5 b=R0.8


- 次要装饰面, 喷涂膜厚不足, 但不露底
- 装饰面
- 凹槽位置可能会有露底现象, 即膜厚不足

\*配合尺寸以实物配合效果为准!

(V.F)




SCALE 1:2

SIGNATURE GRADEING	HIGH SIGNATURE GRADEING	C.C.DIA(MM)	Ø 200.65		喷涂收费周长(mm):		486.91		
AREA (SQ MM)	1388.04	UNSPECIFIED THICKNESS	2.5±0.25	PERIMETER (MM)	759	STANDARD	BS EN755	SCALE	1:1.5
MASS (KG/M)	3.762	UNSPECIFIED CORNERS	R 0.3	SURFACE AREA	486.91	ALLOY	6063-T6	VERSION	A
DRAWN		陈晓舒		DATE	2020-03-10	APELATION		-	
STANDARDIZATION				DATE					
TO SIGN		陈国提		DATE					
AUDITING				DATE					
MARKER	MODIFY	FILE NO	SIGNATURE	DATE	APPROV				

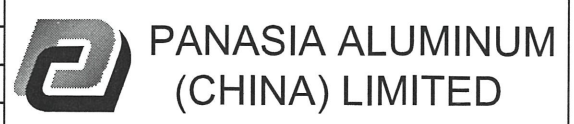



CUSTOMER	HONGKONG CO.	CUSTOMER APPROVAL	CUST PART NO.	X85772
			SECTION NO.	LH0091245

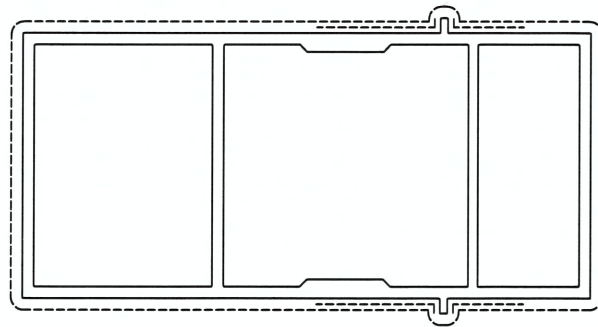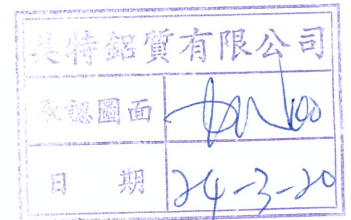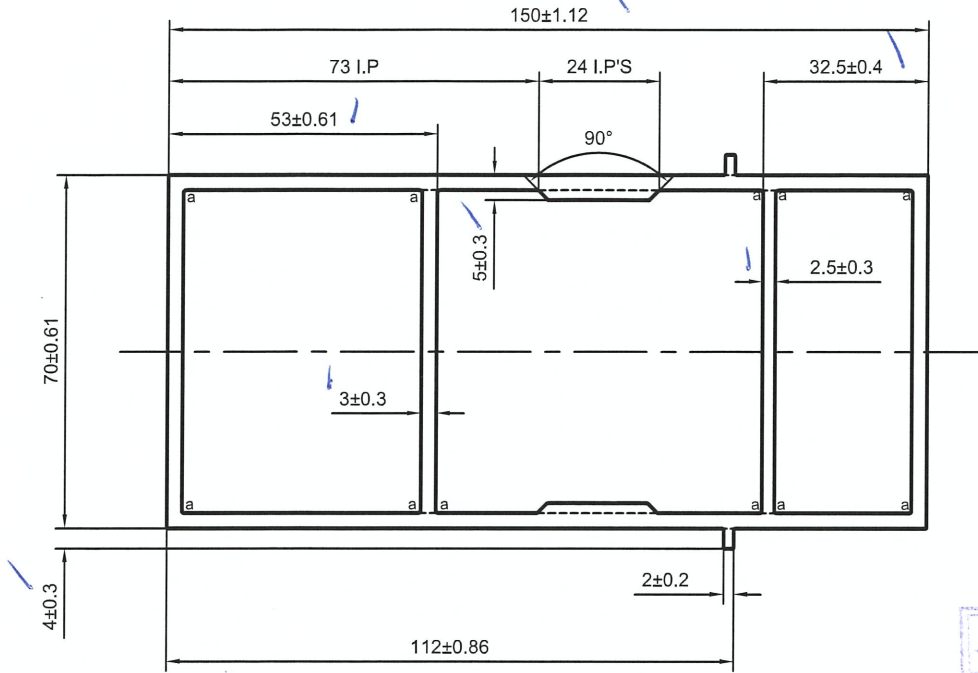

a=R0.5

----- 次要装饰面，喷涂膜厚不足，但不露底

----- 装饰面



备注：没有配合型号！

(V.F)


SCALE 1:2

SIGNATURE GRADEING	HIGH SIGNATURE GRADEING	C.C.DIA(MM)	Ø 165.33				喷涂收费周长(mm):		454.45	
AREA (SQ MM)	1740.57	UNSPECIFIED THICKNESS	3±0.25	PERIMETER (MM)	454.45	STANDARD	BS EN755	SCALE	1:1.5	
MASS (KG/M)	4.717	UNSPECIFIED CORNERS	R 0.3	SURFACE AREA	454.45	ALLOY	6063-T6	VERSION	A	
		DRAWN	陈晓舒	DATE	2020-03-10	APPELLATION	-	PAGE OF		
		STANDARDIZATION		DATE						
		TO SIGN	陈国提	DATE						
		AUDITING		DATE						
MARKER	MODIFY	FILE NO	SIGNATURE	DATE	APPROV					


CUSTOMER	HONGKONG CO.	CUSTOMER APPROVAL	CUST PART NO.	X85773
			SECTION NO.	LH0091246

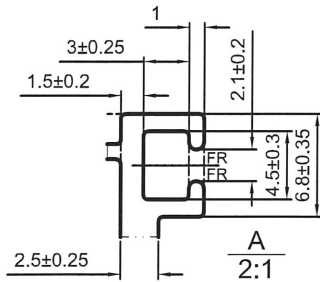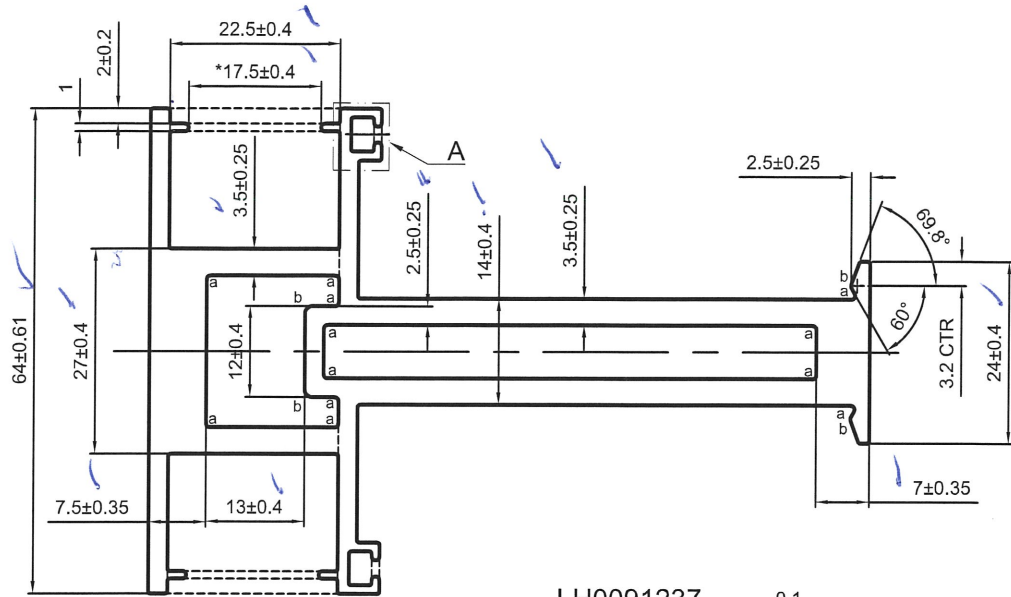

LH0091237  
X85764 0.1

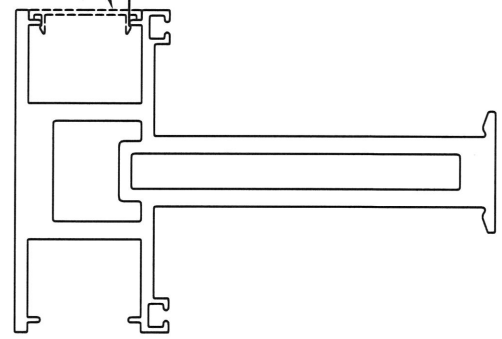

長特鋁質有限公司  
承認圖面  
日期 24-3-20

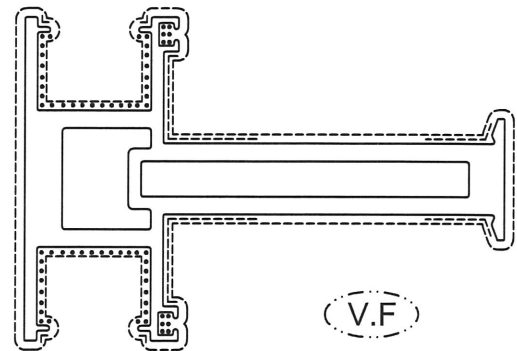

SCALE 1:2

a=R0.5 b=R1 c=R0.8

----- 次要装饰面，喷涂膜厚不足，但不露底

----- 装饰面

●●●●● 凹槽位置可能会有露底现象，即膜厚不足



\*配合尺寸以实物配合效果为准！

SIGNATURE GRADEING	HIGH SIGNATURE GRADEING	C.C.DIA(MM)	Ø 106.81		喷涂收费周长(mm):		460.5		
AREA (SQ MM)	1161.00	UNSPECIFIED THICKNESS	2.5±0.25	PERIMETER (MM)	460.5	STANDARD	BS EN755	SCALE	1:1
MASS (KG/M)	3.146	UNSPECIFIED CORNERS	R 0.3	SURFACE AREA	460.5	ALLOY	6063-T6	VERSION	A
			DRAWN	陈晓舒	DATE	2020-03-12	APELLATION	-	PAGE OF
			STANDARDIZATION		DATE				
			TO SIGN	陈国提	DATE				
			AUDITING		DATE				
MARKER	MODIFY	FILE NO	SIGNATURE	DATE	APPROV	DATE			



PANASIA ALUMINUM (CHINA) LIMITED

CUSTOMER	HONGKONG CO.	CUSTOMER APPROVAL	CUST PART NO.	X85778
			SECTION NO.	LH0091251

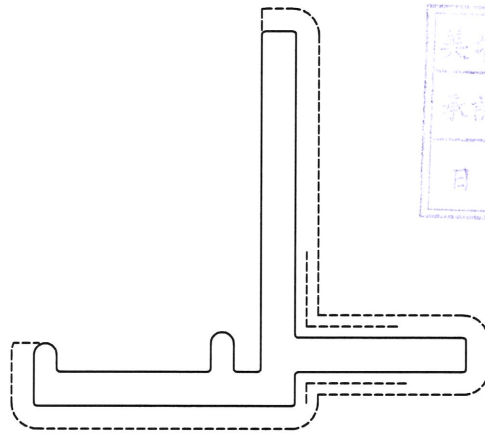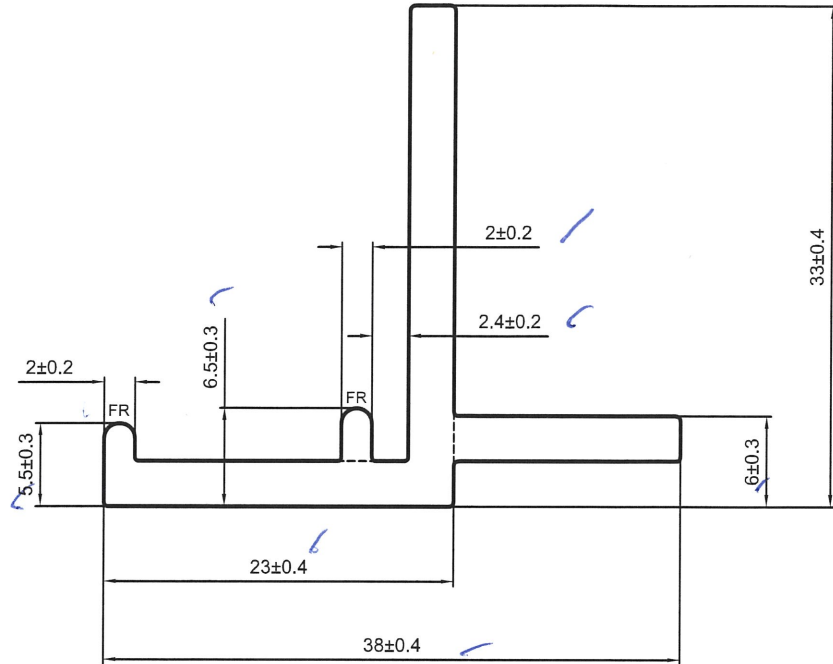

美特鋁質有限公司  
承認圖面  
日期 24-3-20

----- 次要裝飾面，噴塗膜厚不足，但不露底  
----- 裝飾面

备注：没有配合型号！

(V.F)

SCALE 1.5:1

SIGNATURE GRADEING	HIGH SIGNATURE GRADEING	C.C.DIA(MM)	Ø 43.22		噴塗收費周長(mm):		95.91	
AREA (SQ MM)	215.14	UNSPECIFIED THICKNESS	3±0.25	PERIMETER (MM)	150.74	STANDARD	BS EN755	SCALE 2:1
MASS (KG/M)	0.583	UNSPECIFIED CORNERS	R 0.3	SURFACE AREA	95.91	ALLOY	6063-T6	VERSION A
		DRAWN	陈晓舒	DATE	2020-03-10	APPELLATION	-	PAGE OF
		STANDARDIZATION		DATE				
		TO SIGN	陈国提	DATE				
		AUDITING		DATE				
MARKER	MODIFY	FILE NO	SIGNATURE	DATE	APPROV	DATE		



PANASIA ALUMINUM (CHINA) LIMITED