

工程指示 / 要求簡箋(E.I.)

工程指示編號：EI / 2006 / 20 修改版次：  
 工程編號：J - 852 工程名稱：亞皆老街中電  
 工程項目：制房百葉地盤用防水片 (LV SWITCH ROOM 1)  
 收件人：生統 發件人：Bessie Lau 日期：19/06/2020

要求提供 / 確認 事項：

- |                                    |                                     |                               |
|------------------------------------|-------------------------------------|-------------------------------|
| <input type="checkbox"/> 初步鋁料 B.M. | <input type="checkbox"/> 加工拆圖，然後生產  | <input type="checkbox"/> 尺寸表  |
| <input type="checkbox"/> 正式鋁料 B.M. | <input type="checkbox"/> 技術上資料 / 指示 | <input type="checkbox"/> 報價   |
| <input type="checkbox"/> 配件 B.M.   | <input type="checkbox"/> 樣辦或貨品說明書   | <input type="checkbox"/> 分判合約 |
| <input type="checkbox"/> 其他：_____  |                                     |                               |

內容：

煩請按此加工制房百葉地盤用防水片

*Handwritten signature/initials*

請在 15/7/2020 前完成上列要求。

附有關圖紙 / 文件：

以上項目為：

- 原合約工程包       原合約工程加 / 減賬       新工程報價

原因：-

分發東莞各部門：

- 生產技術總監  連附件     技術部  連附件     生產部  連附件     機械設計部  連附件  
 採購部  連附件     生產統籌部  連附件  
 質檢部  連附件     會計部  連附件     報關組  連附件     其他 \_\_\_\_\_  連附件

分發其他分判：

- 水洪  連附件

分發香港各部門：

- 行政部  連附件     會計部  連附件     統籌部  連附件     工程部地盤科文  連附件    *Handwritten initials*  
 採購部  連附件     QS 部  連附件     維修部  連附件     其他 \_\_\_\_\_  連附件

傳遞編號：

*Handwritten: HK1214/20*

發件人簽署：

項目經理簽署：


*Handwritten signatures*



BM編號:		工程號:	計算:	LHR	日期:	13/6/2020	送呈:				
地盤用鋁板B.M.表		地盤名稱:	核對:	亞皆老街	日期:		副本:				
修改內容		項目類別:	批准:	平臺百頁樣辦防水片	日期:						
修改圖號		修改版次:	A/C Code:	實用	總V.F.:	總重量:	9.12				
序號	鋁板圖號	鋁板名稱	顏色	總重量	單件展開面積	總展開面積	單件V.F.	總V.F.	備註	位置	
				後備	總數	平方米	平方米	平方米			
1	LVA-API-04	1.5mm厚鋁板	MILL	4	4	2.730	0.168	0.672	0.000	0.000	詳見位置圖
2	LVA-API-05	1.5mm厚鋁板	MILL	4	4	2.730	0.168	0.672	0.000	0.000	詳見位置圖
3	LVA-API-06	1.5mm厚鋁板	MILL	4	4	1.830	0.113	0.450	0.000	0.000	詳見位置圖
4	LVA-API-07	1.5mm厚鋁板	MILL	4	4	1.830	0.113	0.450	0.000	0.000	詳見位置圖
5				0	0	0.000	0.000	0.000	0.000	0.000	
6				0	0	0.000	0.000	0.000	0.000	0.000	
7				0	0	0.000	0.000	0.000	0.000	0.000	
8				0	0	0.000	0.000	0.000	0.000	0.000	
9				0	0	0.000	0.000	0.000	0.000	0.000	
10				0	0	0.000	0.000	0.000	0.000	0.000	
11				0	0	0.000	0.000	0.000	0.000	0.000	
12				0	0	0.000	0.000	0.000	0.000	0.000	
13				0	0	0.000	0.000	0.000	0.000	0.000	
14				0	0	0.000	0.000	0.000	0.000	0.000	
15				0	0	0.000	0.000	0.000	0.000	0.000	
				總計:	16	9.12	2.24	0.00	0.00	0.00	

總計: 16 9.12 2.24 0.00

# 派位圖

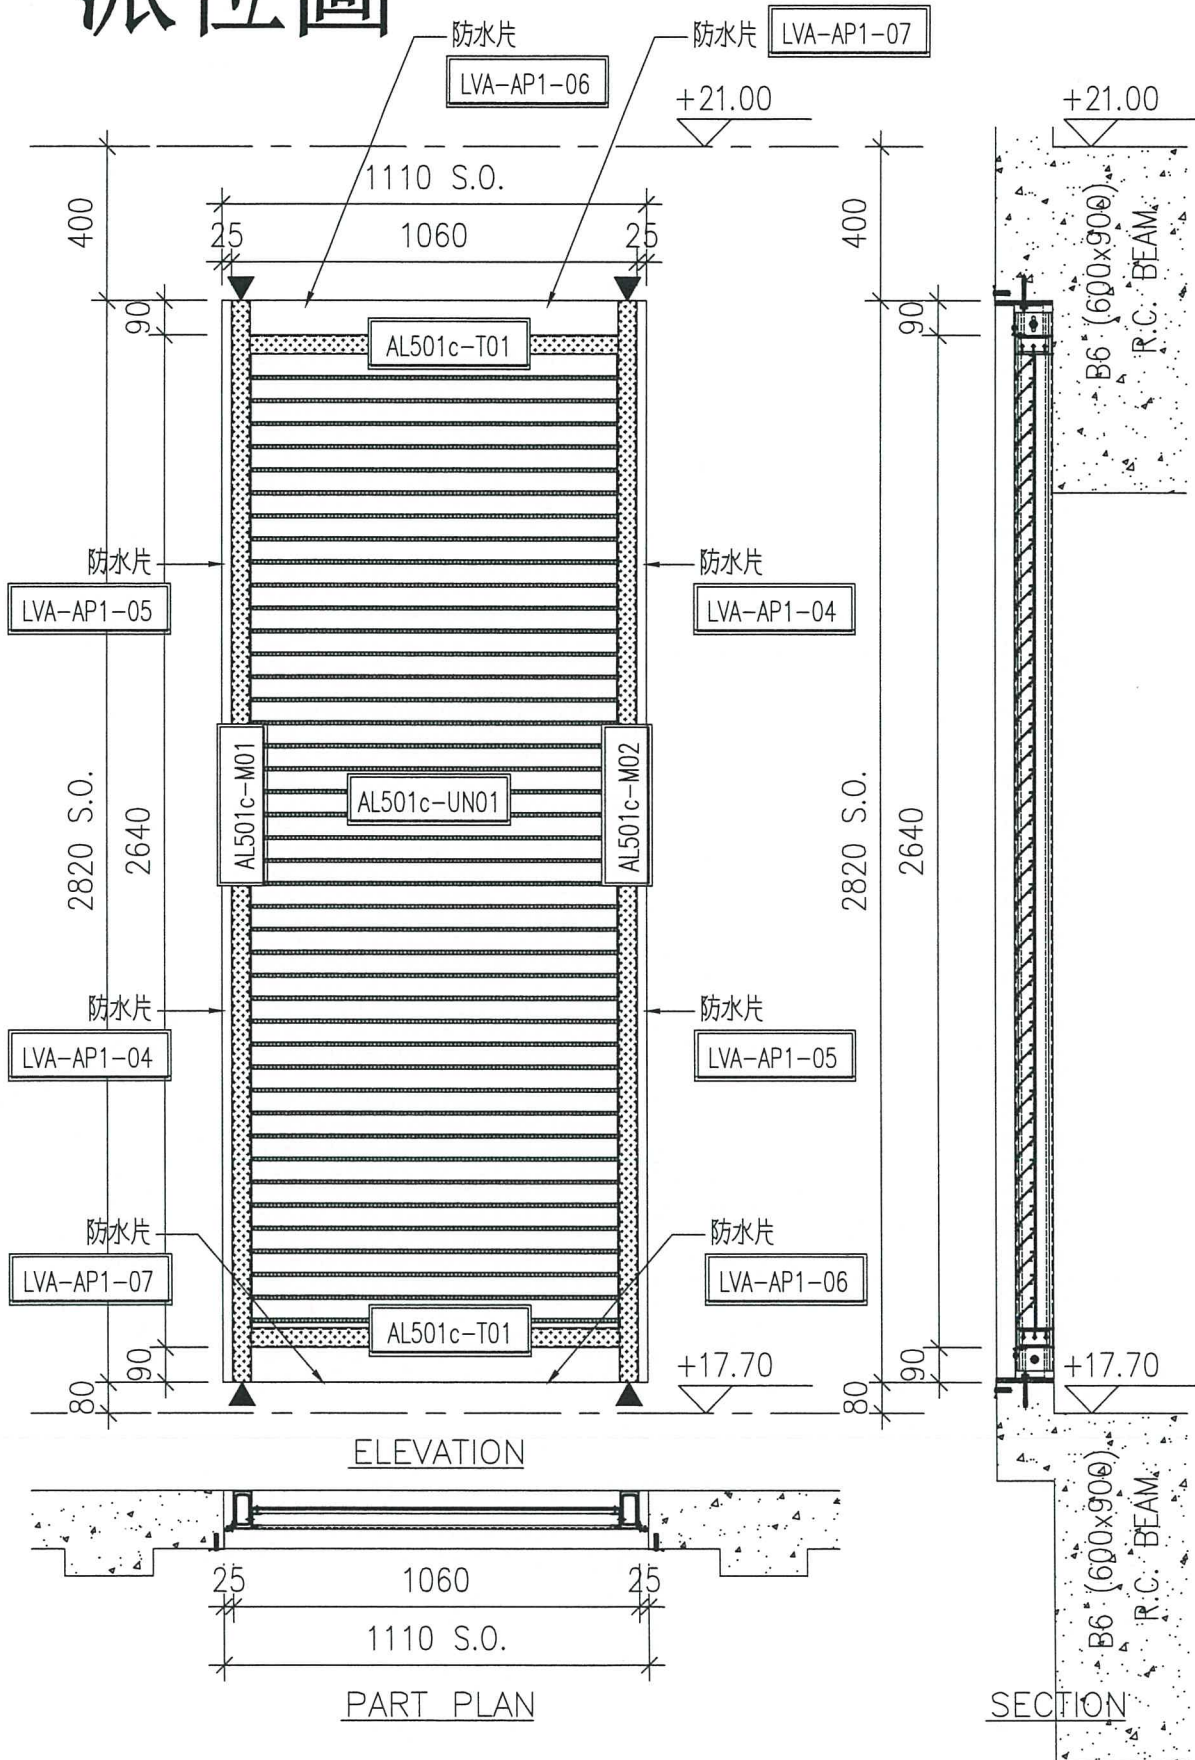

AL-501c

LG2/F

LV SWITCH ROOM 1

1

WEATHERPROOF LOUVER (60% FREE AREA)



B.D. REF.:

CLIENT:

ARCHITECT: **ASC**  
ARCHITECTS & ENGINEERS

MAIN CONTRACTOR: **Gammon**

STRUCTURAL ENGINEER: **ARUP**

FACADE CONSULTANT: **VEINHARDT**

NOTE:

- ALL DIMENSIONS ARE IN mm.
- ALL ELEVATIONS ARE VIEWED FROM OUTSIDE.
- ALL DIMENSIONS TO BE VERIFIED ON SITE.
- BEFORE FABRICATION.

LEGEND:

- XT DETAIL MARK NO.
- REF. SHEET NO.
- F.F.L. --- FINISHED FLOOR LEVEL
- S.F.L. --- STRUCTURAL FLOOR LEVEL
- REVERSED DETAIL

DATE	27/04/2020	GENERAL REVISED
NO.	19/02/2020	GENERAL REVISED
BY		

JRB NO.: J-852


PROJECT: RESIDENTIAL DEVELOPMENT  
 AT 139 - 147 ARGYLE STREET,  
 NKU 6005, 6035 R.P., 6036 R.P.,  
 6037 R.P. & 6038 R.P.

TITLE: LOCATION PLAN OF  
 ALUM. LOUVER  
 AT LG2/F

DATE: 9-Jan-2020 SCALE: 1:200  
 DRAWN BY: LHR CHECKED BY: DW

**美特铝业有限公司**  
**MIDI** ALUMINIUM FABRICATOR LTD.  
 1101-1102, Sunny Industrial Centre, 1/F  
 18, Cheong Chee Street, Singapore  
 Tel: 6548921-4 Fax: (65)2772666

DWG NO.: 852-SD-LVA-3001 REV.: B

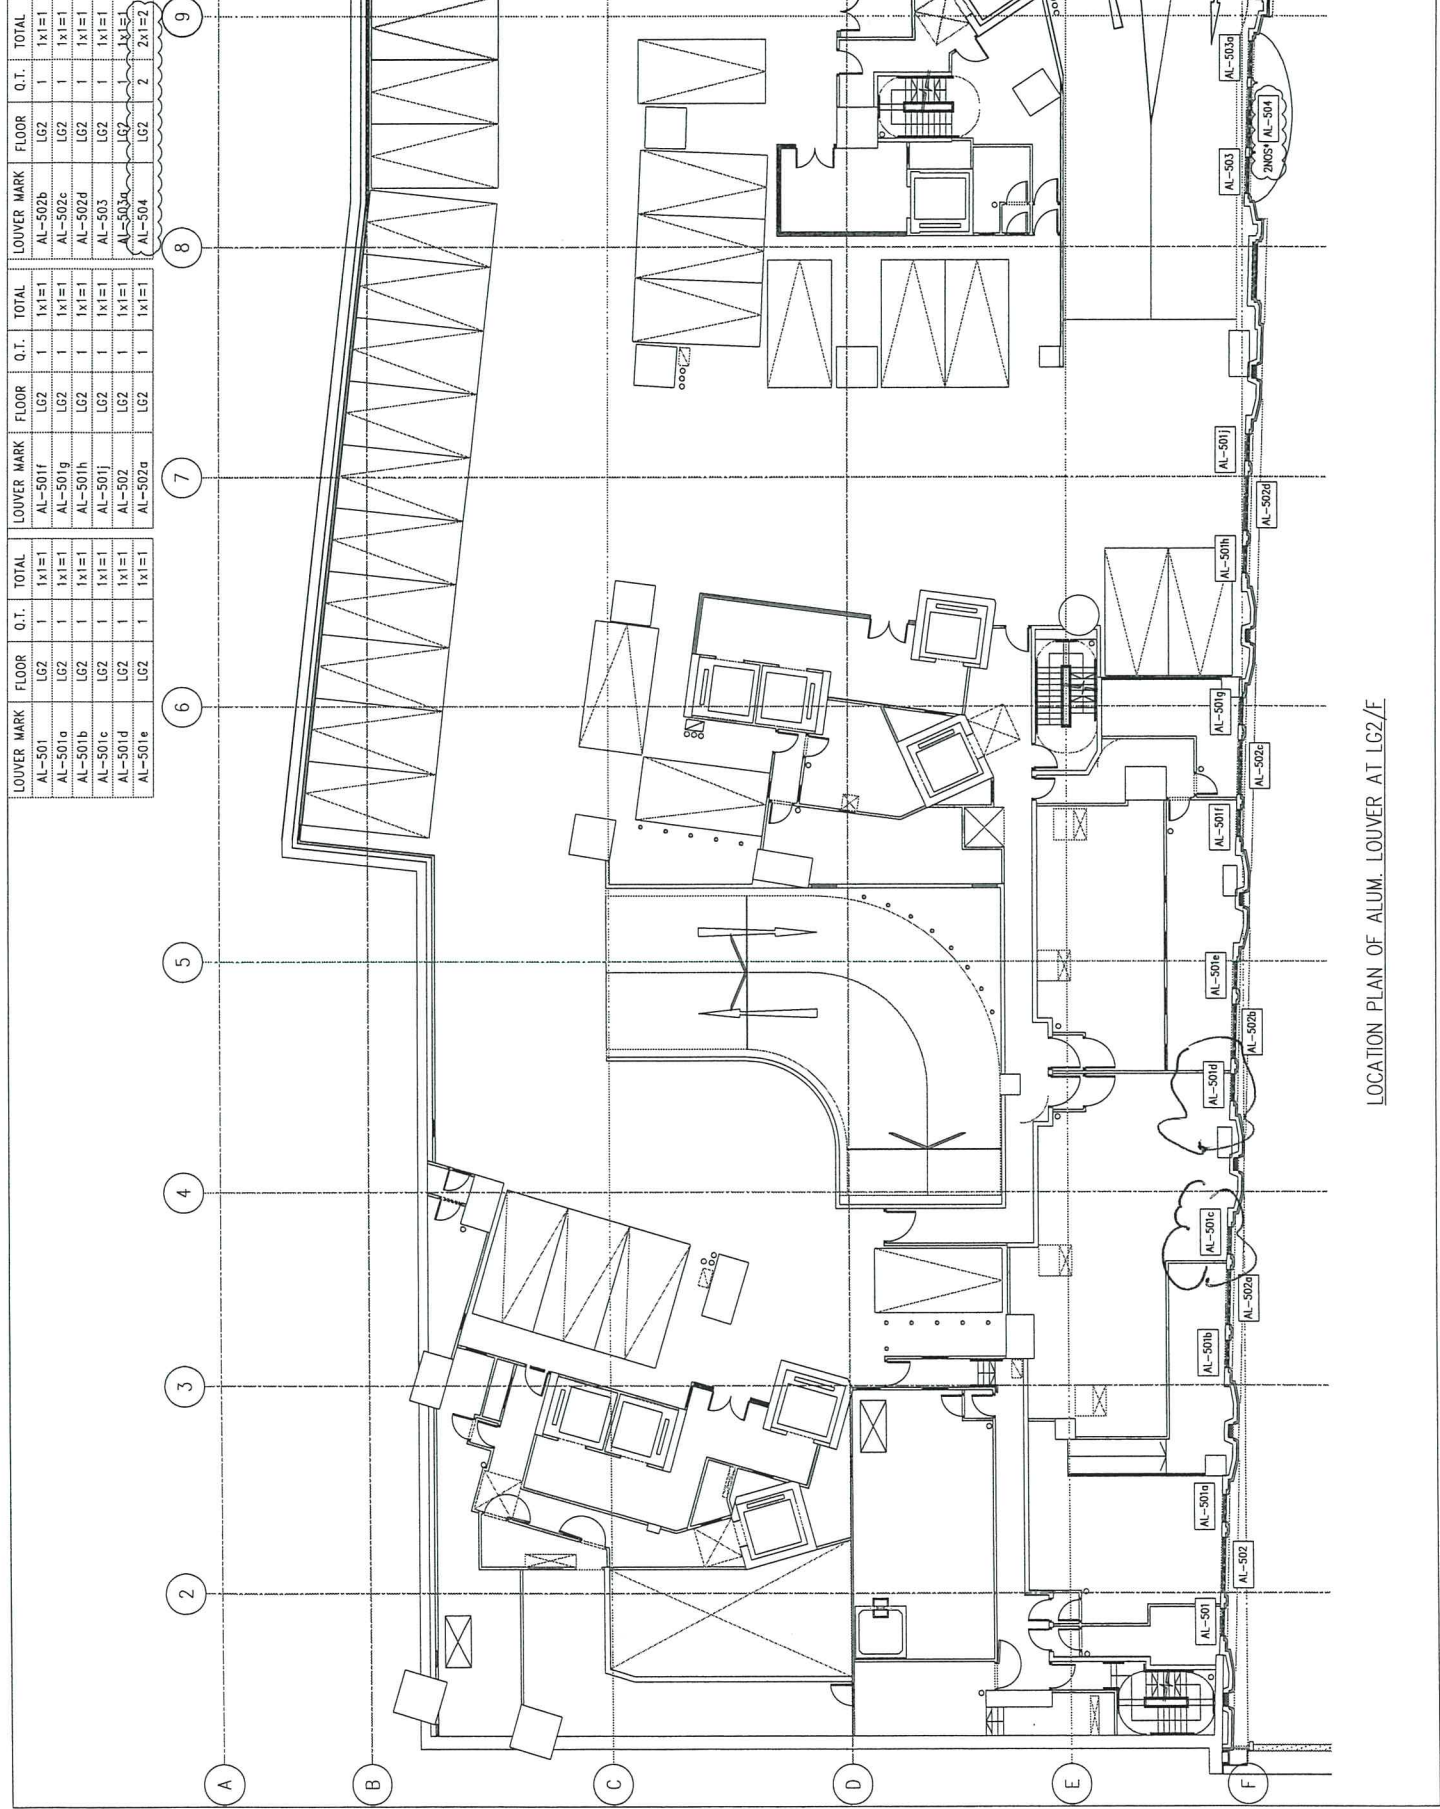

LOCATION PLAN OF ALUM. LOUVER AT LG2/F