



工程指示 / 要求簡箋(E.I.)

工程指示編號：EI / 2048 / 20

修改版次：

工程編號：J - 852

工程名稱：亞皆老街中電

工程項目：制房百葉 地盆用配件 BM

收件人：林哥

發件人：Bessie Lau

日期：02/07/2020

要求提供 / 確認 事項：

- | | | |
|------------------------------------|-------------------------------------|-------------------------------|
| <input type="checkbox"/> 初步鋁料 B.M. | <input type="checkbox"/> 加工拆圖，然後生產 | <input type="checkbox"/> 尺寸表 |
| <input type="checkbox"/> 正式鋁料 B.M. | <input type="checkbox"/> 技術上資料 / 指示 | <input type="checkbox"/> 報價 |
| <input type="checkbox"/> 配件 B.M. | <input type="checkbox"/> 樣辦或貨品說明書 | <input type="checkbox"/> 分判合約 |
| <input type="checkbox"/> 其他：_____ | | |

內容：

請按配件 BM 訂購，供優先要做樣板的 LG2 百葉 501 C,D 廠組裝用。

謝謝

請在 2020.07.10 前完成上列要求。

附有關圖紙 / 文件：1+3

以上項目為：

- 原合約工程包 原合約工程加 / 減賬 新工程報價

原因：-

分發東莞各部門：

- () 生產技術總監 連附件 () 技術部 連附件 () 生產部 連附件 () 機械設計部 連附件
 () 採購部 連附件 () 生產統籌部 連附件
 () 質檢部 連附件 () 會計部 連附件 () 報關組 連附件 () 其他 _____ 連附件

分發其他分判：

- (v) 水洪 連附件

分發香港各部門：

- () 行政部 連附件 () 會計部 連附件 () 統籌部 連附件 () 工程部地盤科文 連附件 李哥
 () 採購部 連附件 () QS 部 連附件 () 維修部 連附件 () 其他 _____ 連附件


傳遞編號：

HK / 20

發件人簽署：[Signature]


項目經理簽署：[Signature]

AL 2048

 美特鋁質有限公司 MIDI Aluminium Fabricator Ltd.	工程號: J852	計算:	wsh	日期:	2020.07.01	送呈:	
	地盤名稱: 亞街老街	核對:		日期:		副本:	
地盤用配件B.M.表	項目類別: 平臺百頁 (第一批次)	批准:		日期:		此BM依據施工圖 來計算	
BM編號:	A/C Code:						

序號	修改標示	配件圖號	物料編號	配件名稱	顏色	實用	後備	總數	單位	備注
1				M5x10圓頭機絲	A4-70	60	0	60	粒	防水片安裝
2				膠塞+#9x1"圓頭鋼牙	A4-70	120	0	120	套	防水片安裝
3				"HILTI" HST3-R M10 ANCHOR BOLTS	A4-70	20	40	20	套	鐵碼安裝
4			道康寧防水膠	Dowsil 791	Bronze	65		65	支	300mm/支, 用于防水片安裝位置
5										
6										
7										
8										
9										
10										
11										
12										
13										
14										
15										
							合計:	145		

LOUVER MARK	FLOOR	Q.T.	TOTAL	LOUVER MARK	FLOOR	Q.T.	TOTAL	LOUVER MARK	FLOOR	Q.T.	TOTAL
AL-501	LG2	1	1x1=1	AL-501f	LG2	1	1x1=1	AL-502b	LG2	1	1x1=1
AL-501a	LG2	1	1x1=1	AL-501g	LG2	1	1x1=1	AL-502c	LG2	1	1x1=1
AL-501b	LG2	1	1x1=1	AL-501h	LG2	1	1x1=1	AL-502d	LG2	1	1x1=1
AL-501c	LG2	1	1x1=1	AL-501j	LG2	1	1x1=1	AL-503	LG2	1	1x1=1
AL-501d	LG2	1	1x1=1	AL-502	LG2	1	1x1=1	AL-503a	LG2	1	1x1=1
AL-501e	LG2	1	1x1=1	AL-502a	LG2	1	1x1=1	AL-504	LG2	2	2x1=2

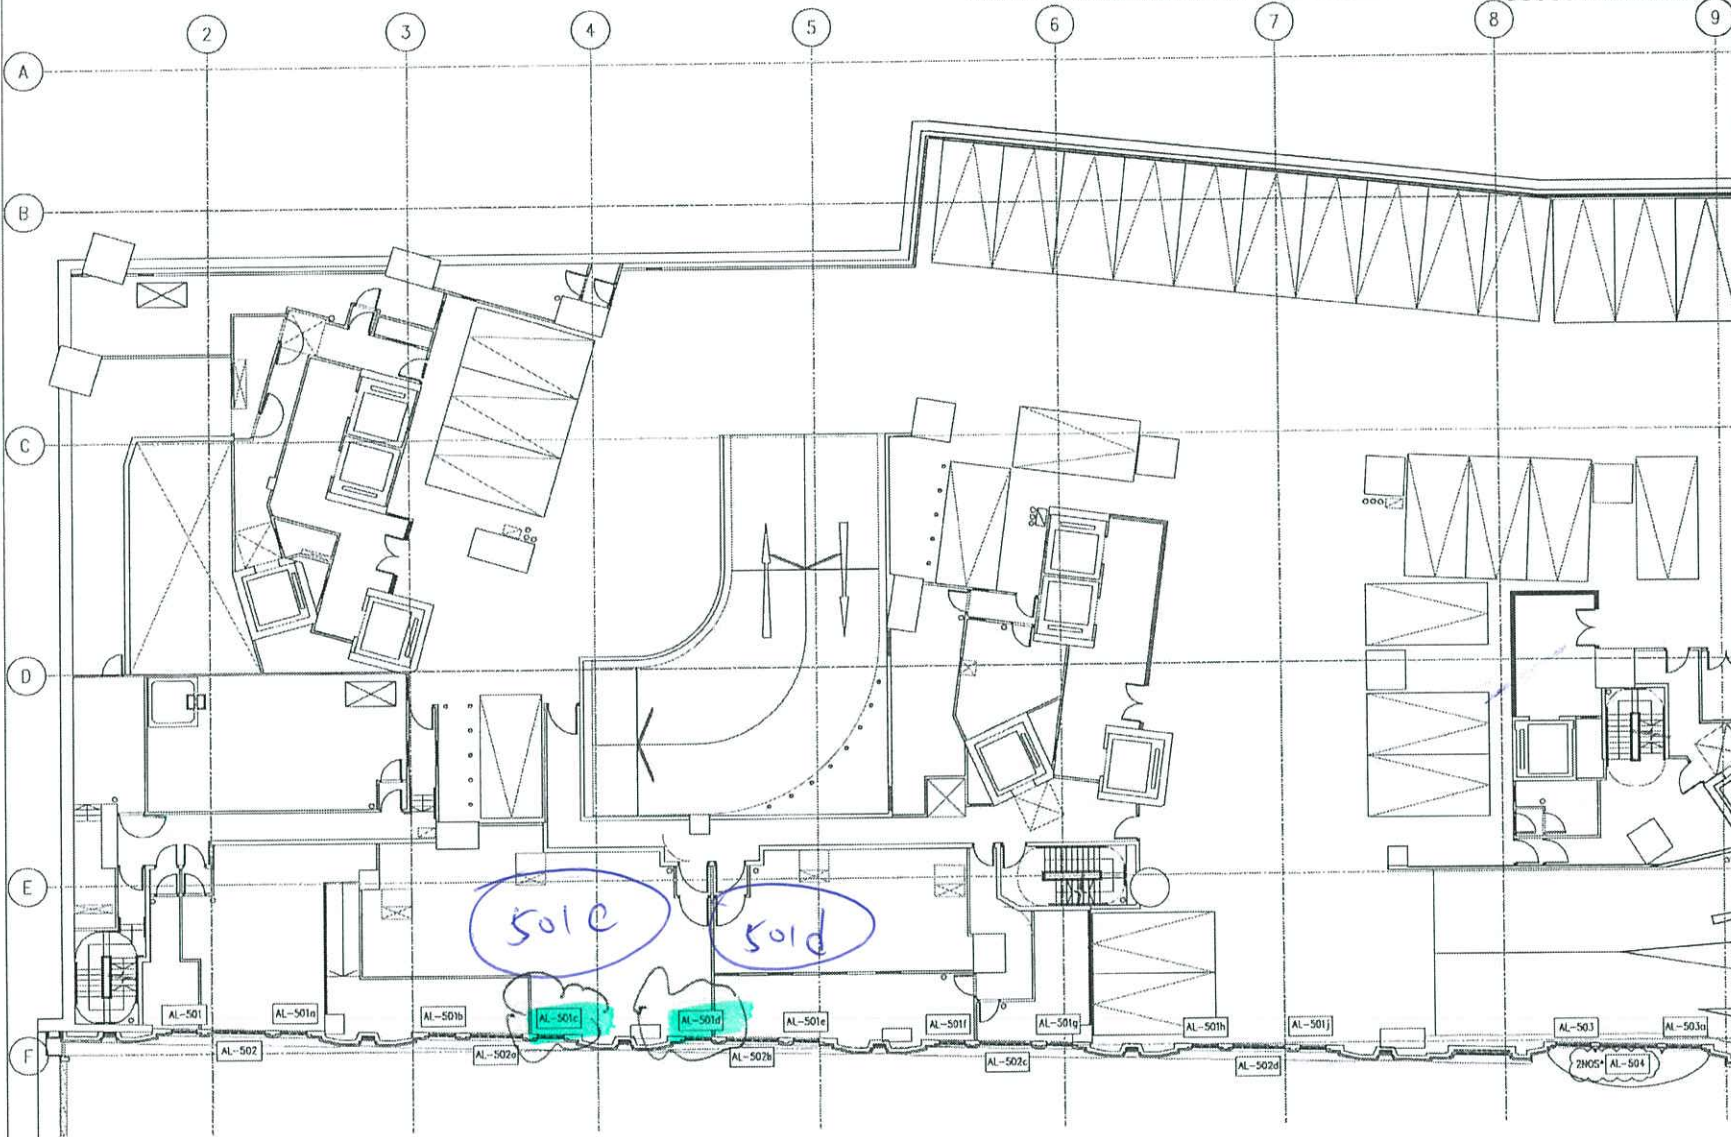

LOCATION PLAN OF ALUM. LOUVER AT LG2/F

B.D. REF. :

CLIENT :

ARCHITECT :

MAIN CONTRACTOR :

STRUCTURAL ENGINEER :

FACADE CONSULTANT :

NOTE :

- ALL DIMENSIONS ARE IN mm.
- ALL ELEVATIONS ARE VIEWED FROM OUTSIDE.
- ALL DIMENSIONS TO BE VERIFIED ON SITE BEFORE FABRICATION.

LEGEND :

- ST. DETAIL MARK NO.
- REFER SHEET NO.

- F.F.L. --- FINISHED FLOOR LEVEL.
- S.F.L. --- STRUCTURAL FLOOR LEVEL.
- ⊗ --- REVERSED DETAIL.

D	27/04/2020	GENERAL REVISED
A	19/02/2020	GENERAL REVISED
NO.	DATE	BY

JOB NO. : J-852

PROJECT :
 PROPOSED RESIDENTIAL DEVELOPMENT
 AT 139 - 147 ARGYLE STREET,
 NKIL 6005, 6035 R.P., 6036 R.P.,
 6037 R.P. & 6038 R.P.




TITLE :
 LOCATION PLAN OF
 ALUM. LOUVER
 AT LG2/F

DATE : 9-Jan-2020 **SCALE :** 1:200

DRAWN BY : LHR **CHECKED BY :** DW

MIDI ALUMINIUM FABRICATOR LTD.
 Units 6-8, Survey Industrial Centre, 1/
 610 Cha Kwo Ling Road, Kowloon
 Tel: 23489211-4 Fax: (852) 7727668

DWG NO. : JB52-SD-LVA-3001 **REV. :** B

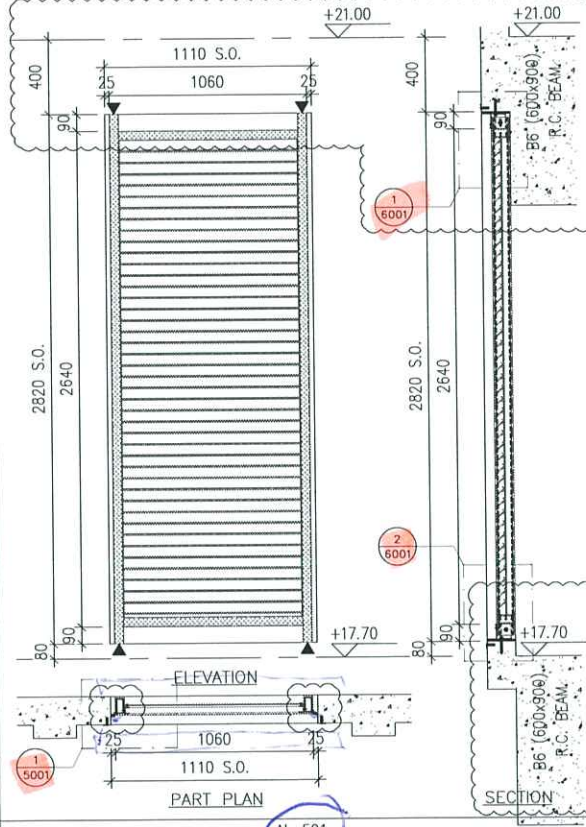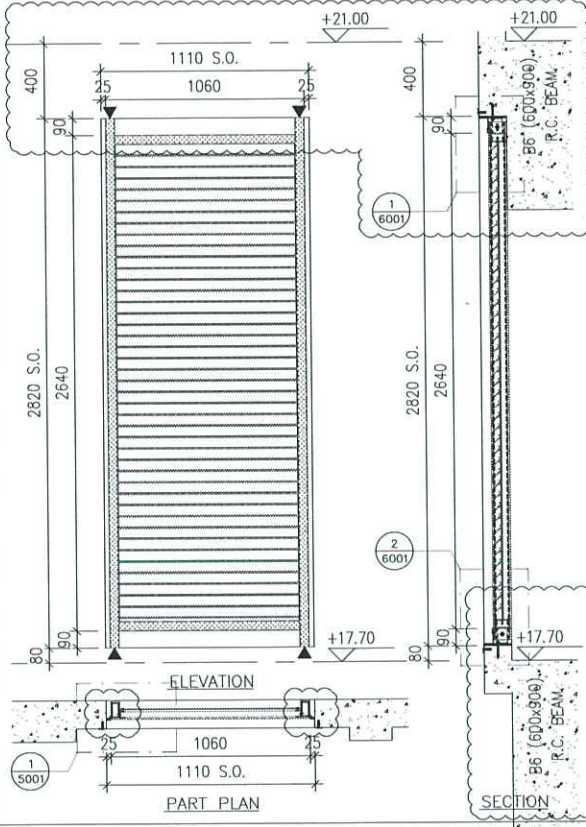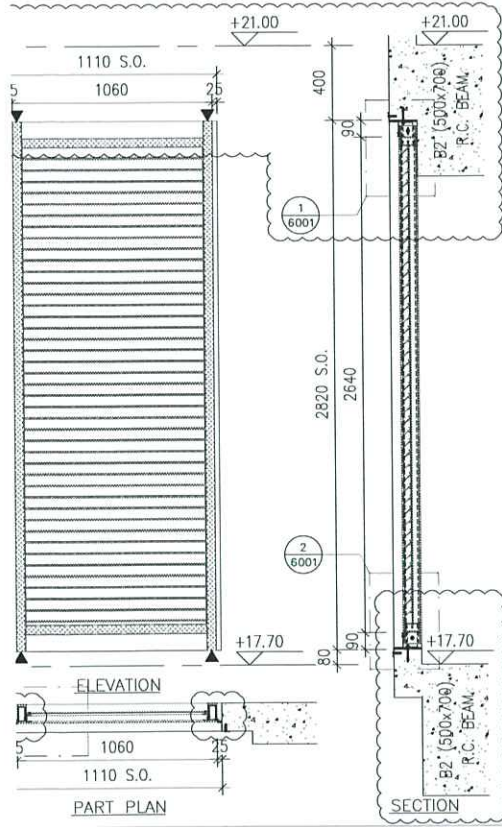

AL-501a
 LG2/F
 EMERGENCY GENSET ROOM
 1
 WEATHERPROOF LOUVER (60% FREE AREA)

AL-501b
 LG2/F
 EMERGENCY GENSET ROOM
 1
 WEATHERPROOF LOUVER (60% FREE AREA)

AL-501c
 LG2/F
 LV SWITCH ROOM 1
 1
 WEATHERPROOF LOUVER (60% FREE AREA)

CLIENT :

ARCHITECT :
AGC DESIGN LTD
architecture interior design landscape
 10/F, 10/F, Shuang Ping, 225 King's Road, North Point, Hong Kong
 Tel: (852) 22111188, Fax: (852) 22111133, Email: agc@agcdesign.com.hk

MAIN CONTRACTOR :
Gammon

STRUCTURAL ENGINEER :
ARUP




FAÇADE CONSULTANT:
MEINHARDT

- NOTE :
1. ALL DIMENSIONS ARE IN mm.
 2. ALL ELEVATIONS ARE VIEWED FROM OUTSIDE.
 3. ALL DIMENSIONS TO BE VERIFIED ON SITE BEFORE FABRICATION.
- LEGEND :
- (X1) ———— DETAIL MARK NO.

LG 503A 5
 603A 6
 703 704

603A.c

ELEVATION

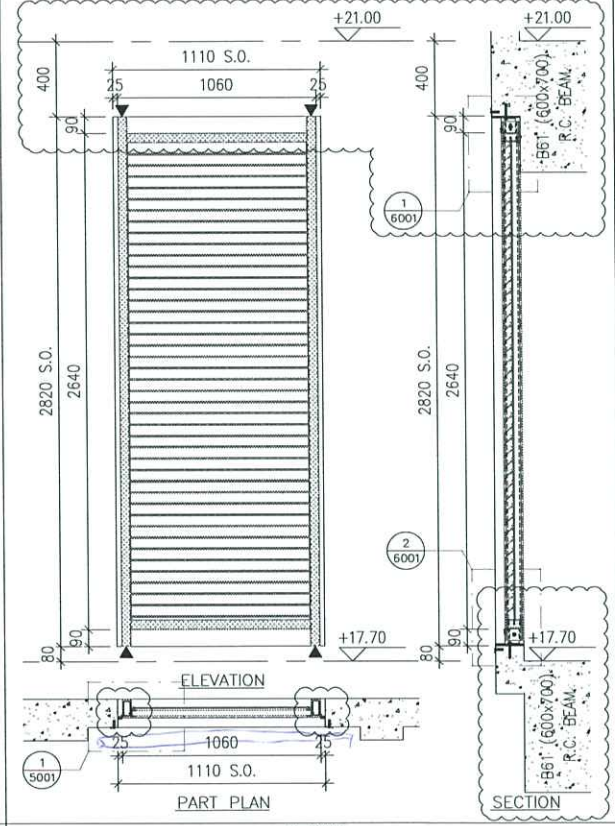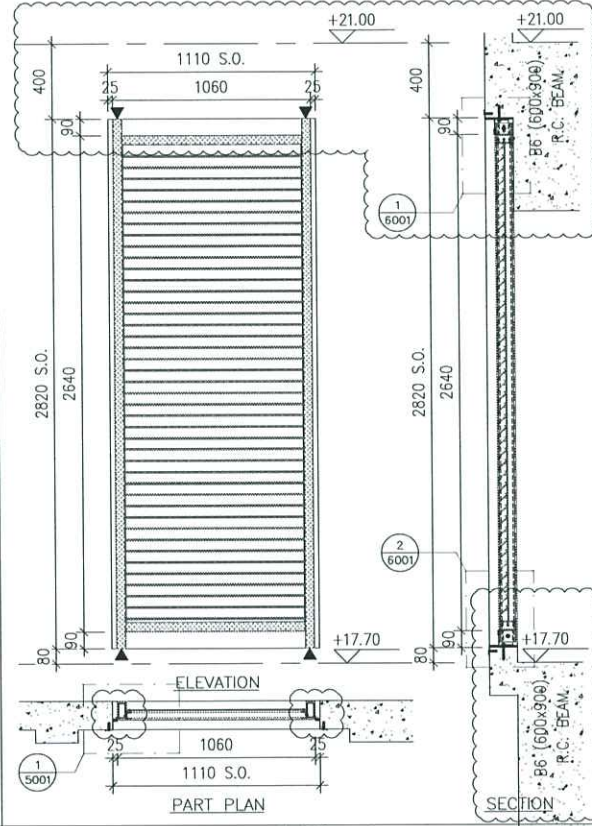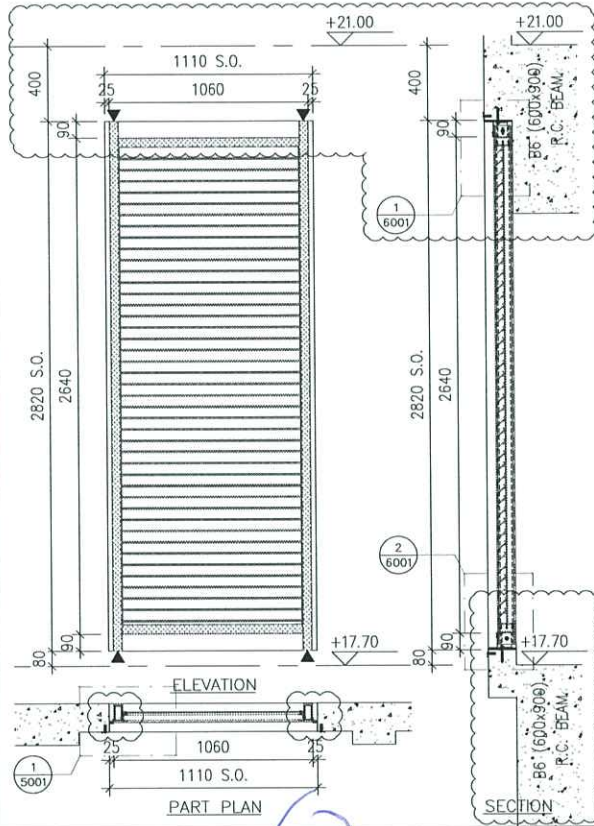

LOUVER MARK		AL-501d	AL-501e	AL-501f
LOCATION	FLOOR	LG2/F	LG2/F	LG2/F
	ROOM	LV SWITCH ROOM 1	A/C PLANT ROOM	A/C PLANT ROOM
QUANTITY		1	1	1
REMARKS		WEATHERPROOF LOUVER (60% FREE AREA)	WEATHERPROOF LOUVER (60% FREE AREA)	WEATHERPROOF LOUVER (60% FREE AREA)