

工程指示 / 要求簡箋(E.I.)

工程指示編號：EI / 2070 / 20

修改版次：-

工程編號：J - 852

工程名稱：亞皆老街中電

工程項目：欄河- 繪畫模圖 (11 個)

收件人：Maggie / 生統

發件人：Ant Yeung

日期：09/07/2020

要求提供 / 確認 事項：

- | | | |
|------------------------------------|-------------------------------------|-------------------------------|
| <input type="checkbox"/> 初步鋁料 B.M. | <input type="checkbox"/> 加工拆圖，然後生產 | <input type="checkbox"/> 尺寸表 |
| <input type="checkbox"/> 正式鋁料 B.M. | <input type="checkbox"/> 技術上資料 / 指示 | <input type="checkbox"/> 報價 |
| <input type="checkbox"/> 配件 B.M. | <input type="checkbox"/> 樣辦或貨品說明書 | <input type="checkbox"/> 分判合約 |

內容：

請繪畫加工模圖共 11 個作欄河-開模用。

欄河欠 1 個模圖 A12 (1/F Freestand，因則師新改此樣，未批)

請在 2020 / 07 / 13 前完成上列要求。

附：11 頁

以上項目為：

- | | | |
|---------------------------------|--------------------------------------|--------------------------------|
| <input type="checkbox"/> 原合約工程包 | <input type="checkbox"/> 原合約工程加 / 減賬 | <input type="checkbox"/> 新工程報價 |
|---------------------------------|--------------------------------------|--------------------------------|

原因：-

分發東莞各部門：

- | | | | |
|--|---|---|---|
| <input type="checkbox"/> 生產技術總監 <input type="checkbox"/> 連附件 | <input type="checkbox"/> 技術部 <input type="checkbox"/> 連附件 | <input type="checkbox"/> 生產部 <input type="checkbox"/> 連附件 | <input type="checkbox"/> 機械設計部 <input type="checkbox"/> 連附件 |
| <input type="checkbox"/> 採購部 <input type="checkbox"/> 連附件 | <input type="checkbox"/> 生產統籌部 <input type="checkbox"/> 連附件 | | |
| <input type="checkbox"/> 質檢部 <input type="checkbox"/> 連附件 | <input type="checkbox"/> 會計部 <input type="checkbox"/> 連附件 | <input type="checkbox"/> 報關組 <input type="checkbox"/> 連附件 | <input type="checkbox"/> 其他 <u>楊榮輝</u> <input type="checkbox"/> 連附件 |

分發其他分判：

- | |
|---|
| <input checked="" type="checkbox"/> 水洪 <input type="checkbox"/> 連附件 |
|---|

分發香港各部門：

- | | | | |
|---|--|---|--|
| <input type="checkbox"/> 行政部 <input type="checkbox"/> 連附件 | <input type="checkbox"/> 會計部 <input type="checkbox"/> 連附件 | <input type="checkbox"/> 統籌部 <input type="checkbox"/> 連附件 | <input type="checkbox"/> 工程部地盤科文 <input type="checkbox"/> 連附件 |
| <input type="checkbox"/> 採購部 <input type="checkbox"/> 連附件 | <input type="checkbox"/> QS 部 <input type="checkbox"/> 連附件 | <input type="checkbox"/> 維修部 <input type="checkbox"/> 連附件 | <input type="checkbox"/> 其他 _____ <input type="checkbox"/> 連附件 |

傳遞編號：

HK 1331 / 20

發件人簽署：

項目經理簽署：


④

Handwritten notes: 2020 HK1331


CUSTOMER	CUSTOMER APPROVAL	CUST PART NO.	A1(0)
		SECTION NO.	15805

Handwritten note: 285895

a=0.1r
b=0.2r
c=0.3r
d=0.4r
e=0.5r
f=0.8r

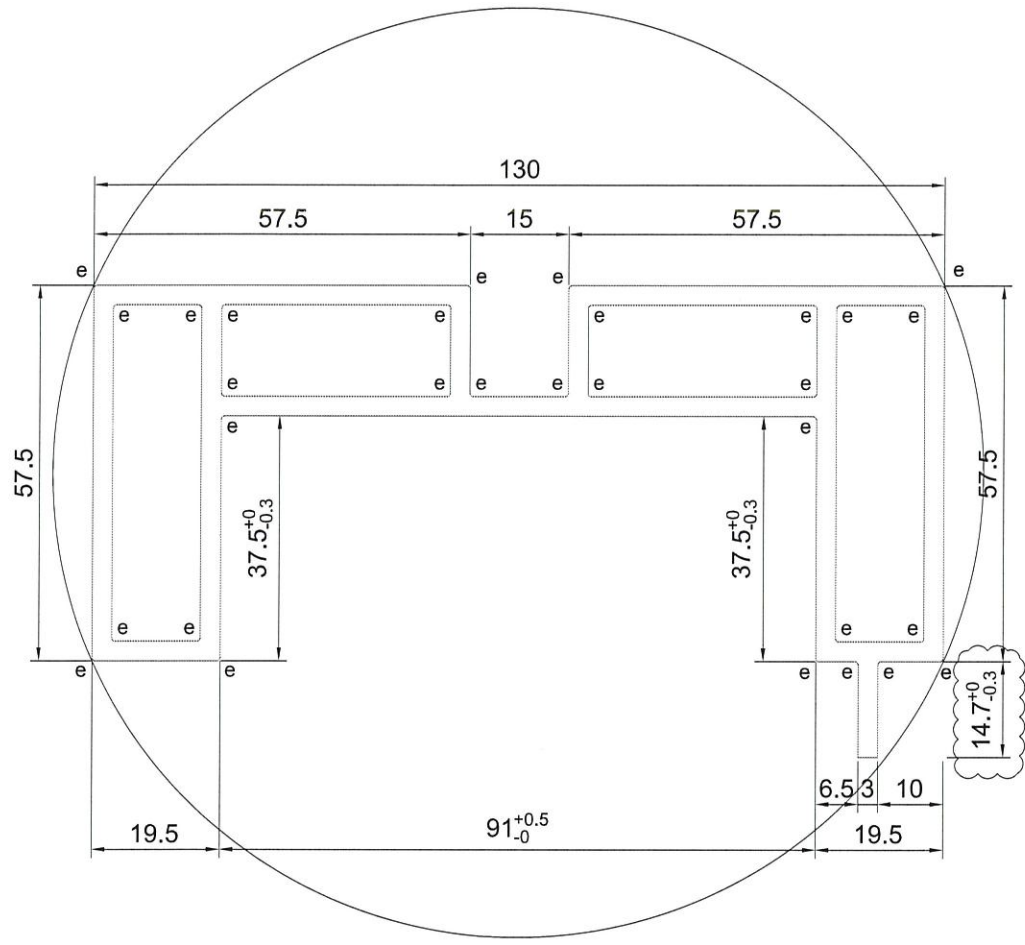

美特鋁質有限公司
承認圖面
日期 2020-7-20

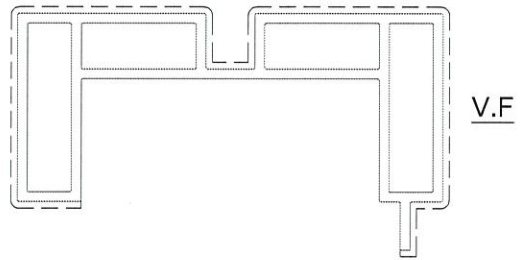

SCALE 1:2


SIGNATURE GRADEING	HIGH SIGNATURE GRADEING	C.C.DIA(MM)	142.15						
AREA (SQ MM)	1481.84	UNSPECIFIED THICKNESS	3.0	PERIMETER (MM)	510.40	STANDARD		SCALE	1:1
MASS (KG/M)	4.016	UNSPECIFIED CORNERS	-	SURFACE AREA	323.77	ALLOY	6063-T5	VERSION	
COMPANY ISSUE			DRAWN	LHR	DATE	APELATION		PAGE OF	
			STANDARDIZATION		DATE				
			TO SIGN		DATE				
			AUDITING		DATE				
MARKER	MODIFY	FILE NO	SIGNATURE	DATE	APPROV				

美特鋁質有限公司
MIDI Aluminium Fabricator Ltd.


CUSTOMER	CUSTOMER APPROVAL	CUST PART NO.	A2(0)
		SECTION NO.	<i>Handwritten signature</i>

x 25896

a=0.1r
b=0.2r
c=0.3r
d=0.4r
e=0.5r
f=0.8r

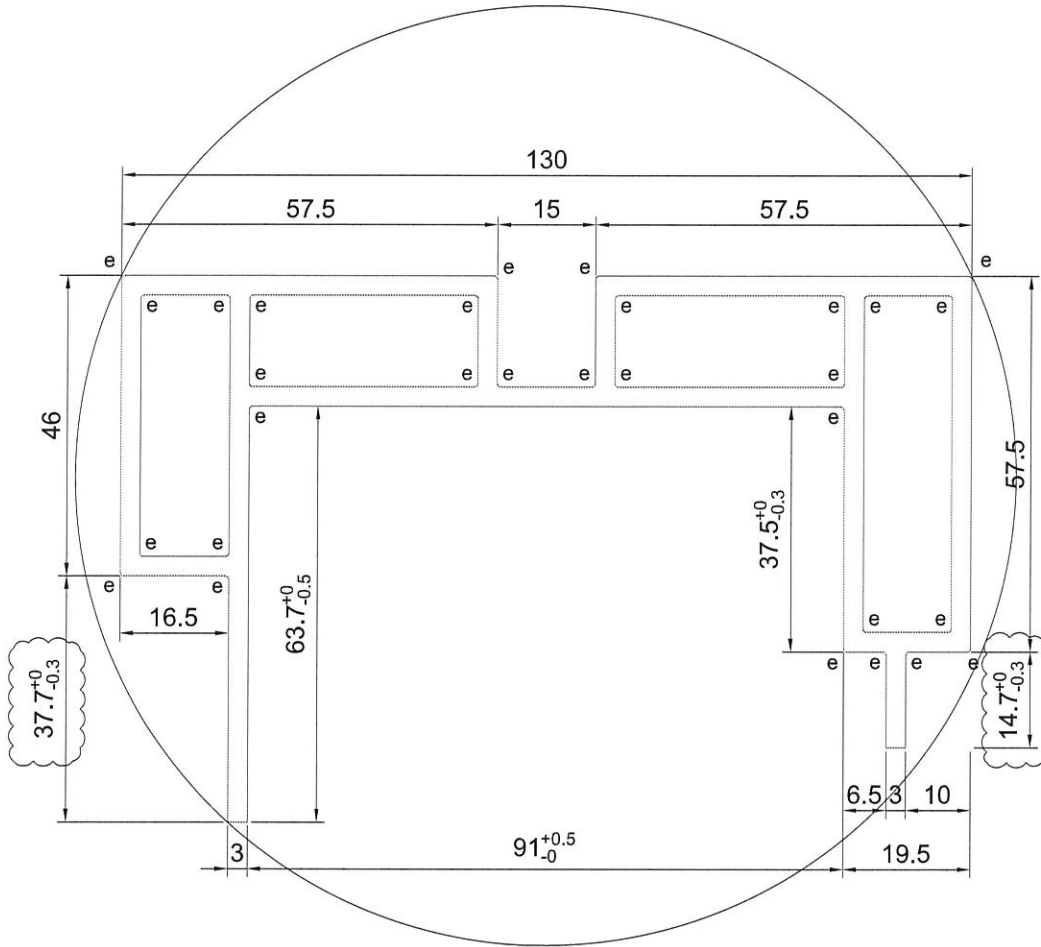

美特鋁質有限公司
承認圖面
日期 8-7-20

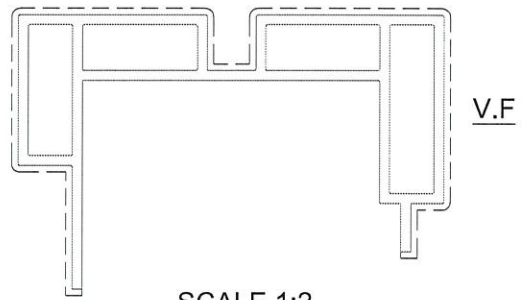

SCALE 1:2

SIGNATURE GRADEING	HIGH SIGNATURE GRADEING	C.C.DIA(MM)	143.74						
AREA (SQ MM)	1526.04	UNSPECIFIED THICKNESS	3.0	PERIMETER (MM)	562.80	STANDARD		SCALE	1:1
MASS (KG/M)	4.135	UNSPECIFIED CORNERS	-	SURFACE AREA	350.25	ALLOY	6063-T5	VERSION	
COMPANY ISSUE		DRAWA	LHR	DATE	2020-06-17	APELLATION	PAGE OF		
		STANDARDIZATION		DATE					
		TO SIGN		DATE					
		AUDITING		DATE					
MARKER	MODIFY	FILE NO	SIGNATURE	DATE	APPROV	DATE			




美特鋁質有限公司
MIDI Aluminium Fabricator Ltd.

2

CUSTOMER	CUSTOMER APPROVAL	CUST PART NO.	A3(0)
		SECTION NO.	-

Handwritten: 285897

a=0.1r
b=0.2r
c=0.3r
d=0.4r
e=0.5r
f=0.8r

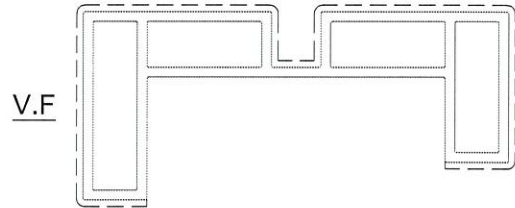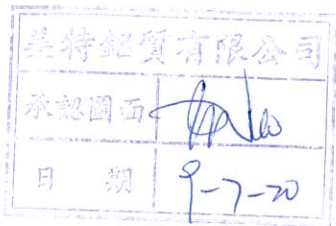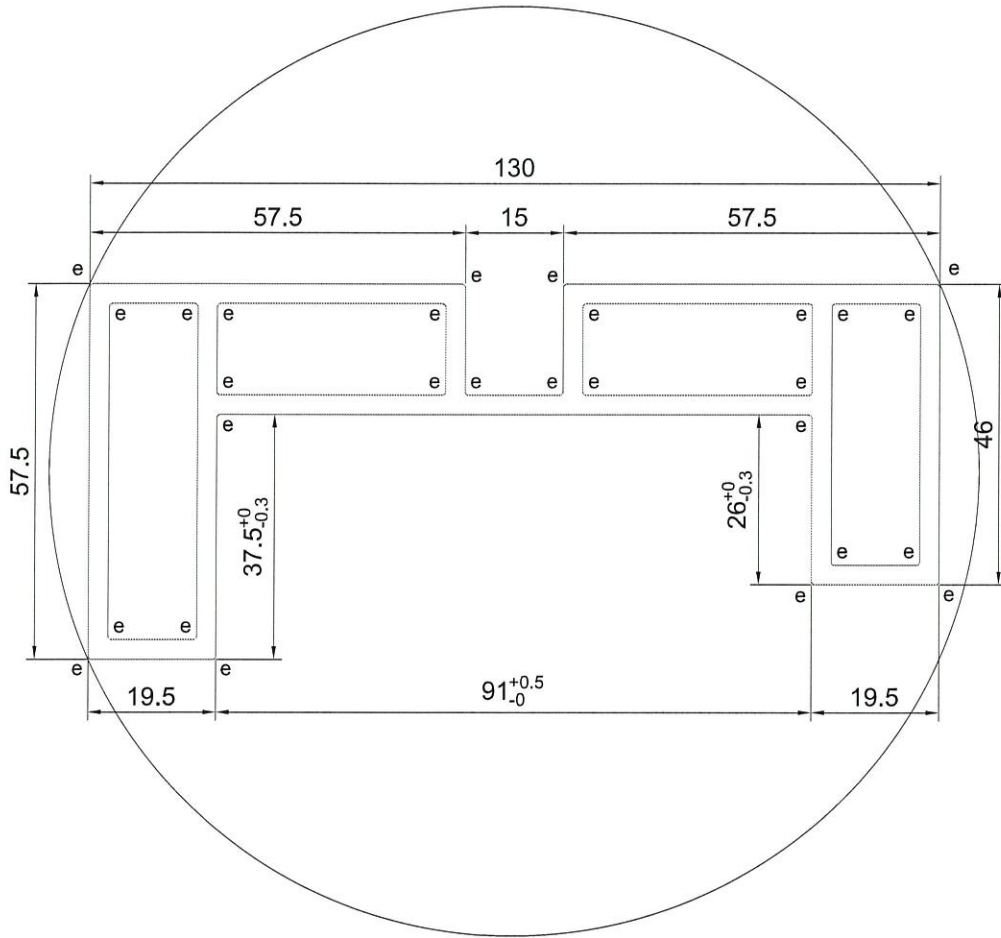

SCALE 1:2

SIGNATURE GRADEING	HIGH SIGNATURE GRADEING	C.C.DIA(MM)	142.15						
AREA (SQ MM)	1368.63	UNSPECIFIED THICKNESS	3.0	PERIMETER (MM)	458.42	STANDARD		SCALE	1:1
MASS (KG/M)	3.709	UNSPECIFIED CORNERS	-	SURFACE AREA	304.78	ALLOY	6063-T5	VERSION	
COMPANY ISSUE			DRAWA	LHR	DATE	2020-06-17	APELLATION	PAGE OF	
			STANDA-RDIZATION		DATE				
			TO SIGN		DATE				
			AUDITING		DATE				
MARKER	MODIFY	FILE NO	SIGNATURE	DATE	APPROV	DATE			


美特鋁質有限公司
MIDI Aluminium Fabricator Ltd.

Handwritten: 3


CUSTOMER	CUSTOMER APPROVAL	CUST PART NO.	A4(0)
		SECTION NO.	-

Handwritten signature

a=0.1r
b=0.2r
c=0.3r
d=0.4r
e=0.5r
f=0.8r

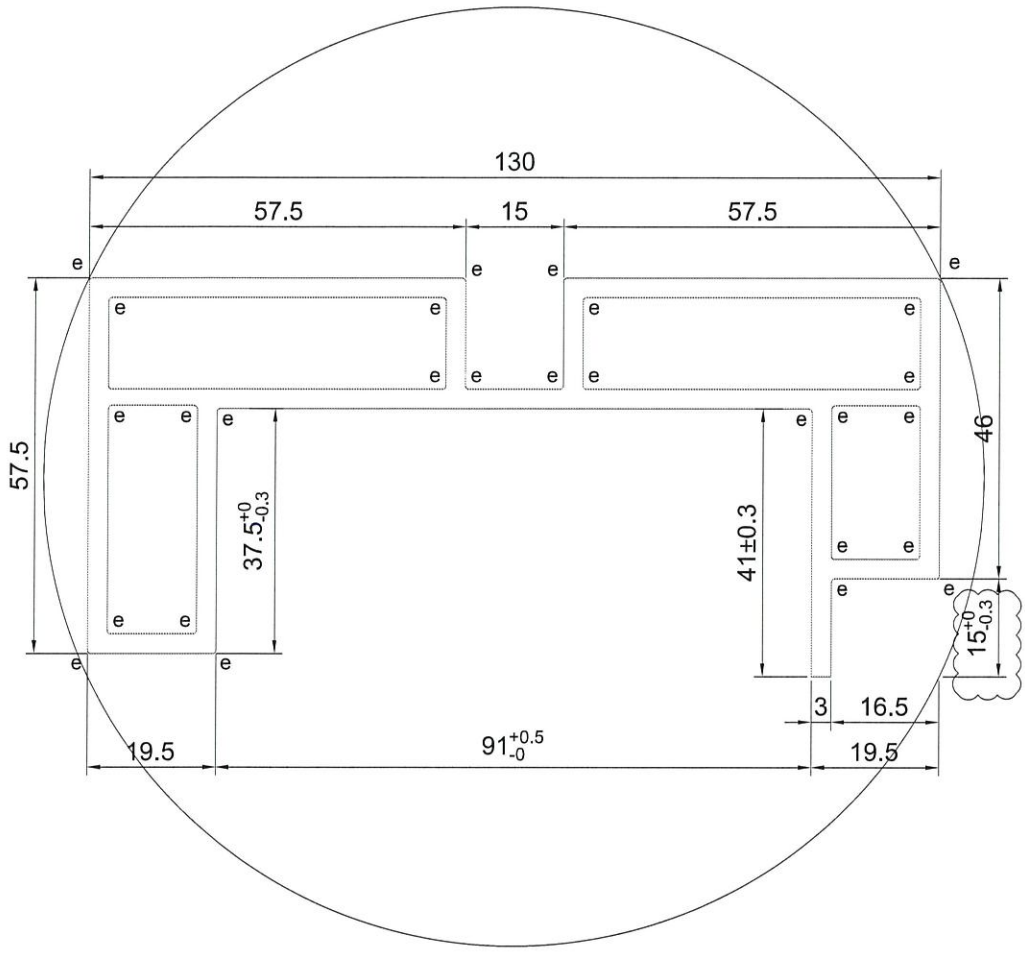

美特鋁質有限公司
承認圖面
日期 8-7-20

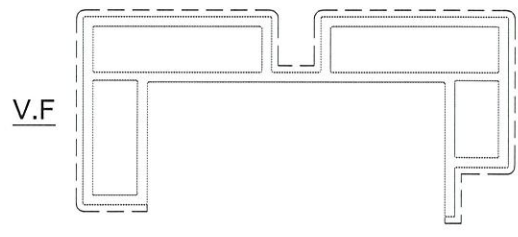


SCALE 1:2

SIGNATURE GRADEING	HIGH SIGNATURE GRADEING	C.C.DIA(MM)	143.60						
AREA (SQ MM)	1397.24	UNSPECIFIED THICKNESS	3.0	PERIMETER (MM)	488.42	STANDARD		SCALE	1:1
MASS (KG/M)	3.786	UNSPECIFIED CORNERS	-	SURFACE AREA	319.85	ALLOY	6063-T5	VERSION	
COMPANY ISSUE		DRAWA	LHR	DATE	2020-06-17	APELATION		PAGE OF	
		STANDA-RDIZATION		DATE		 美特鋁質有限公司 MIDI Aluminium Fabricator Ltd.			
		TO SIGN		DATE					
		AUDITING		DATE					
MARKER	MODIFY	FILE NO	SIGNATURE	DATE	APPROV				


CUSTOMER	CUSTOMER APPROVAL	CUST PART NO.	A5(0)
		SECTION NO.	-

85879

a=0.1r
b=0.2r
c=0.3r
d=0.4r
e=0.5r
f=0.8r

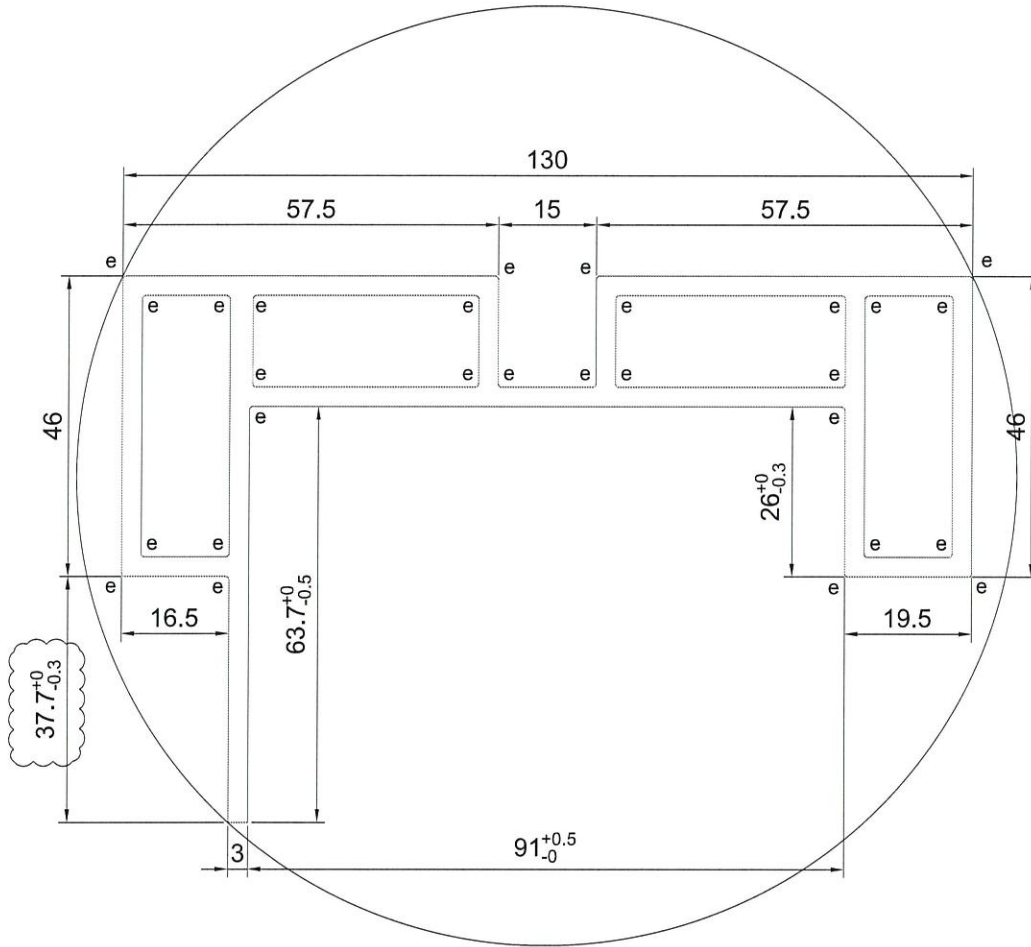

美特鋁質有限公司
承認圖面
日期 9-7-20

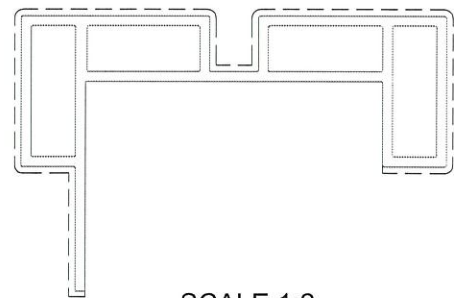

V.F

SCALE 1:2

SIGNATURE GRADEING	HIGH SIGNATURE GRADEING	C.C.DIA(MM)	143.74						
AREA (SQ MM)	1419.82	UNSPECIFIED THICKNESS	3.0	PERIMETER (MM)	510.82	STANDARD		SCALE	1:1
MASS (KG/M)	3.848	UNSPECIFIED CORNERS	-	SURFACE AREA	331.05	ALLOY	6063-T5	VERSION	
COMPANY ISSUE		DRAWA	LHR	DATE	2020-06-17	APELLATION	PAGE OF		
		STANDA- RDIZATION		DATE					
		TO SIGN		DATE					
		AUDITING		DATE					
MARKER MODIFY	FILE NO	SIGNATURE	DATE	APPROV		DATE			




美特鋁質有限公司
MIDI Aluminium Fabricator Ltd.

5

CUSTOMER	CUSTOMER APPROVAL	CUST PART NO.	A6(0)
		SECTION NO.	-

85900

a=0.1r
b=0.2r
c=0.3r
d=0.4r
e=0.5r
f=0.8r

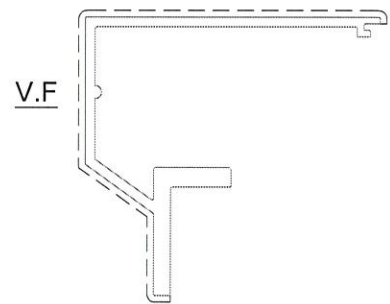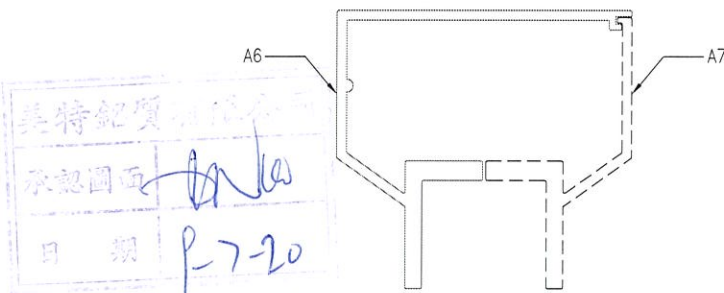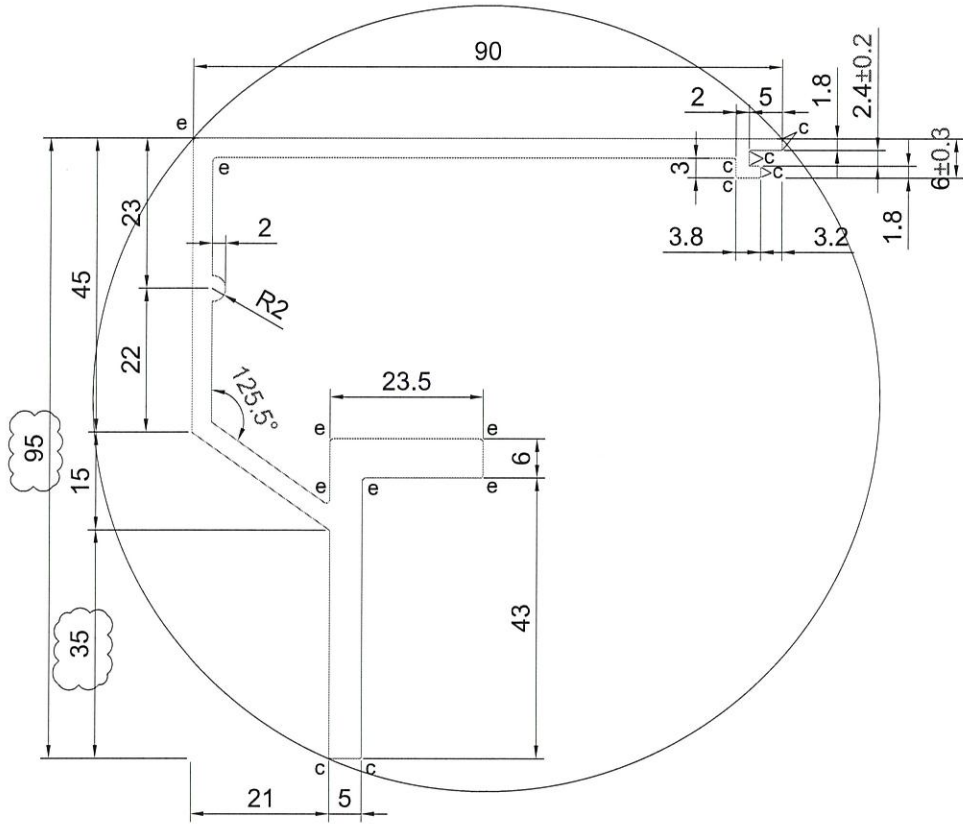

SCALE 1:2


SIGNATURE GRADEING	HIGH SIGNATURE GRADEING	C.C.DIA(MM)	120.25						
AREA (SQ MM)	831.13	UNSPECIFIED THICKNESS	3.0	PERIMETER (MM)	463.16	STANDARD		SCALE	1:1
MASS (KG/M)	2.253	UNSPECIFIED CORNERS	-	SURFACE AREA	202.48	ALLOY	6063-T6	VERSION	
COMPANY ISSUE			DRAWA	LHR	DATE	2020-06-17	APELLATION	PAGE OF	
			STANDA-		DATE				
			RDIZATION		DATE				
			TO SIGN		DATE				
			AUDITING		DATE				
MARKER	MODIFY	FILE NO	SIGNATURE	DATE	APPROV	DATE			

美特鋁質有限公司
MIDI Aluminium Fabricator Ltd.



CUSTOMER	CUSTOMER APPROVAL	CUST PART NO.	A7(0)
		SECTION NO.	-

85901

a=0.1r
b=0.2r
c=0.3r
d=0.4r
e=0.5r
f=0.8r

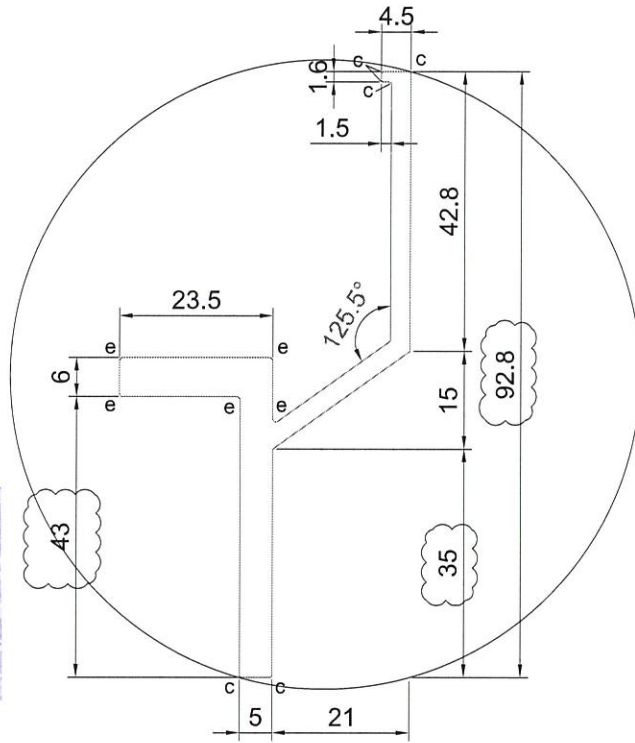

美特鋁質有限公司
承認圖面
日期 P-7-20

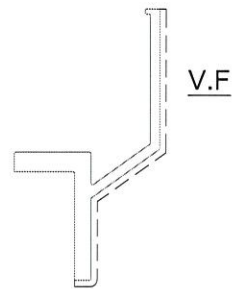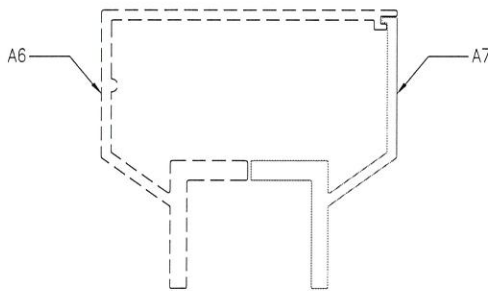


SCALE 1:2

SIGNATURE GRADEING	HIGH SIGNATURE GRADEING	C.C.DIA(MM)	96.38						
AREA (SQ MM)	556.40	UNSPECIFIED THICKNESS	3.0	PERIMETER (MM)	276.82	STANDARD		SCALE	1:1
MASS (KG/M)	1.507	UNSPECIFIED CORNERS	-	SURFACE AREA	108.82	ALLOY	6063-T6	VERSION	
COMPANY ISSUE			DRAWA	LHR	DATE	2020-06-17	APELLATION	PAGE OF	
			STANDAR-DIZATION		DATE				
			TO SIGN		DATE				
			AUDITING		DATE				
MARKER	MODIFY	FILE NO	SIGNATURE	DATE	APPROV				

美特鋁質有限公司
MIDI Aluminium Fabricator Ltd.

7

CUSTOMER	CUSTOMER APPROVAL	CUST PART NO.	A8(0)
		SECTION NO.	-

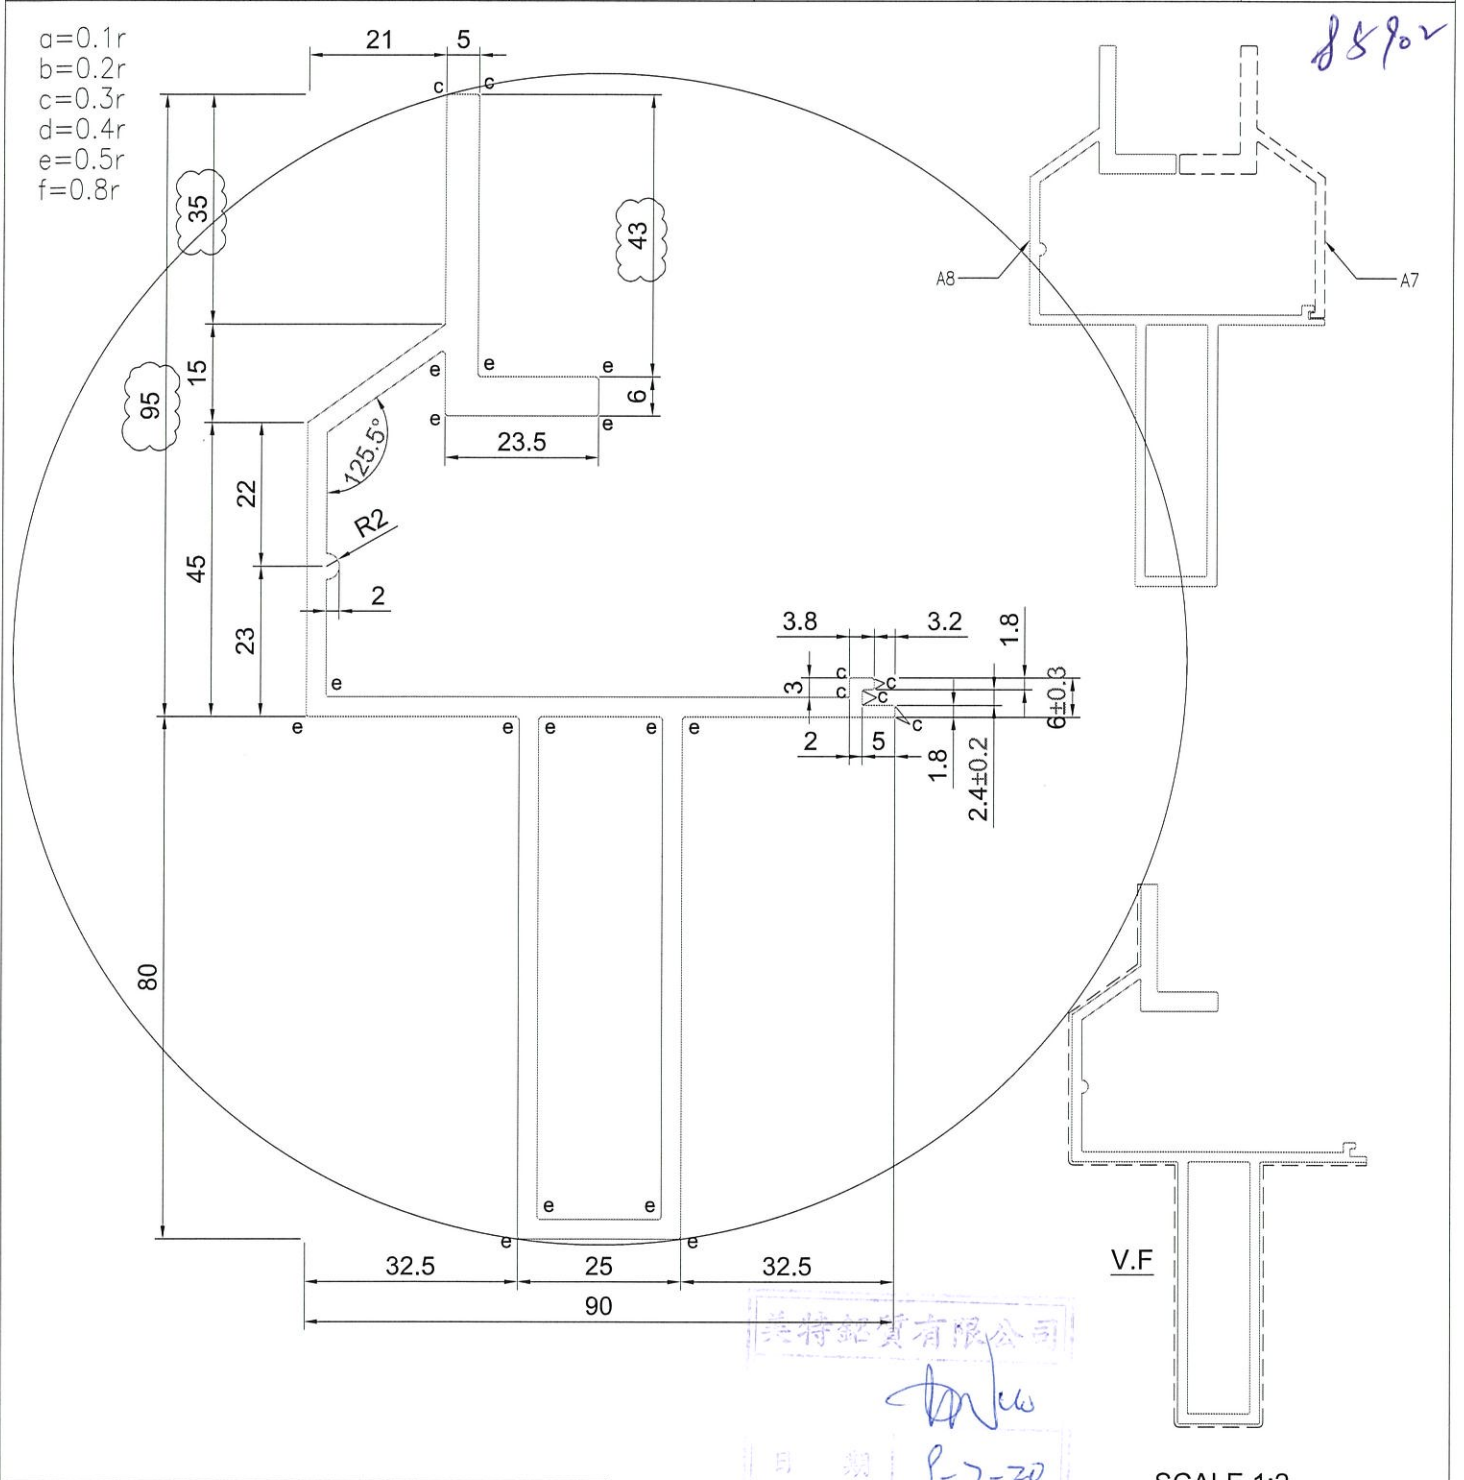

美特鋁質有限公司
日期 9-7-20

V.F

SCALE 1:2


SIGNATURE GRADEING	HIGH SIGNATURE GRADEING	C.C.DIA(MM)	179.16						
AREA (SQ MM)	1368.34	UNSPECIFIED THICKNESS	3.0	PERIMETER (MM)	813.44	STANDARD		SCALE	1:1
MASS (KG/M)	3.708	UNSPECIFIED CORNERS	-	SURFACE AREA	355.07	ALLOY	6063-T6	VERSION	
COMPANY ISSUE			DRAWN	LHR	DATE	2020-06-17	APELLATION	PAGE OF	
			STANDARDIZATION		DATE				
			TO SIGN		DATE				
			AUDITING		DATE				
MARKER MODIFY	FILE NO	SIGNATURE	DATE	APPROV		DATE			

美特鋁質有限公司
MIDI Aluminium Fabricator Ltd.


CUSTOMER	CUSTOMER APPROVAL	CUST PART NO.	A9(0)
		SECTION NO.	-

X 8903

a=0.1r
b=0.2r
c=0.3r
d=0.4r
e=0.5r
f=0.8r

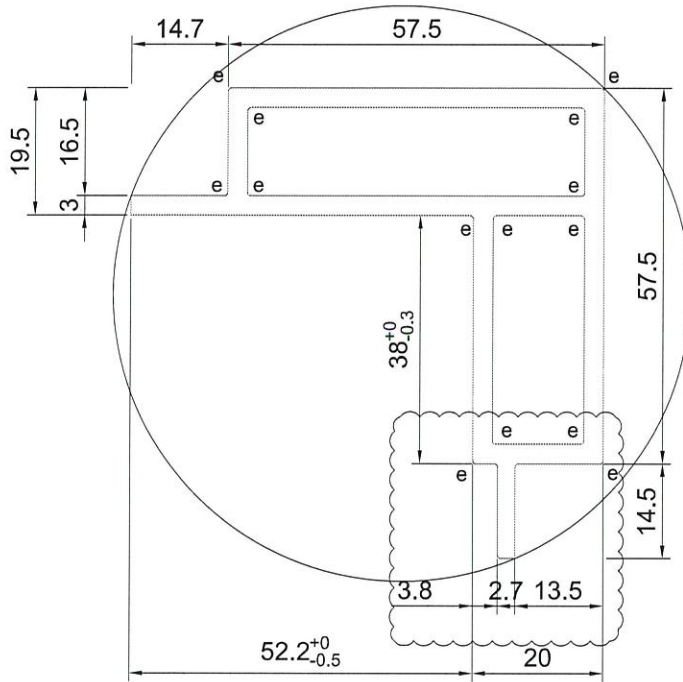

美特鋁質有限公司
承認圖面 *[Signature]*
日期 *8-7-20*

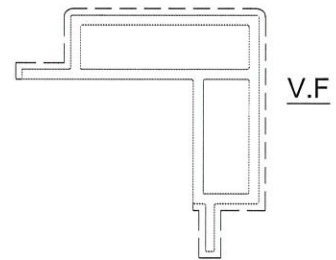

SCALE 1:2

SIGNATURE GRADEING	HIGH SIGNATURE GRADEING	C.C.DIA(MM)	88.08		SCALE 1:1				
AREA (SQ MM)	779.56	UNSPECIFIED THICKNESS	3.0	PERIMETER (MM)	512.54	STANDARD		SCALE	1:1
MASS (KG/M)	2.112	UNSPECIFIED CORNERS	-	SURFACE AREA	197.03	ALLOY	6063-T5	VERSION	
COMPANY ISSUE			DRAWA	LHR	DATE	2020-06-17	APELLATION	PAGE OF	
			STANDA- RDIZATION		DATE				
			TO SIGN		DATE				
			AUDITING		DATE				
MARKER	MODIFY	FILE NO	SIGNATURE	DATE	APPROV		DATE		


美特鋁質有限公司
MIDI Aluminium Fabricator Ltd.

[Handwritten mark]


CUSTOMER	CUSTOMER APPROVAL	CUST PART NO.	A10(0)
		SECTION NO.	-

6857.4

a=0.1r
b=0.2r
c=0.3r
d=0.4r
e=0.5r
f=0.8r

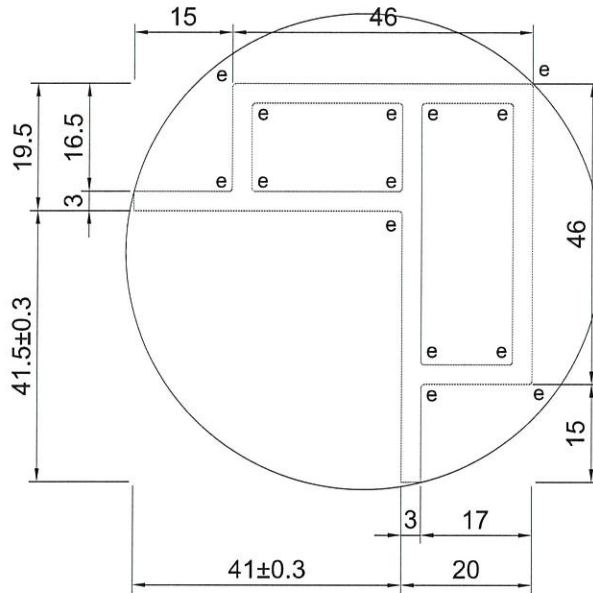

美特鋁質有限公司
承認圖面
日期 9-7-20

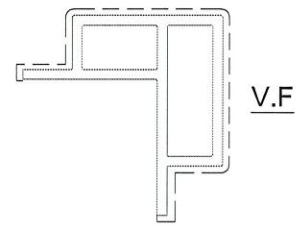

SCALE 1:2

SIGNATURE GRADEING	HIGH SIGNATURE GRADEING	C.C.DIA(MM)	72.80						
AREA (SQ MM)	646.93	UNSPECIFIED THICKNESS	3.0	PERIMETER (MM)	242.71	STANDARD		SCALE	1:1
MASS (KG/M)	1.753	UNSPECIFIED CORNERS	-	SURFACE AREA	160.43	ALLOY	6063-T5	VERSION	
COMPANY ISSUE		DRAWN	LHR	DATE	2020-06-17	APELLATION	PAGE OF		
		STANDARDIZATION		DATE		<p>美特鋁質有限公司 MIDI Aluminium Fabricator Ltd.</p>			
		TO SIGN		DATE					
		AUDITING		DATE					
MARKER	MODIFY	FILE NO	SIGNATURE	DATE	APPROV				

10

