



工程指示 / 要求簡箋(E.I.)

工程指示編號：EI/2265/20

修改版次：

工程編號：J-852

工程名稱：亞皆老街中電

工程項目：樣辦層 - 欄河 廠用配件 - 裝飾

收件人：生統 / MAGGIE

發件人：Bessie Lau

日期：07/08/2020

要求提供 /  確認 事項：

- ( ) 初步鋁料 B.M.
- ( ) 正式鋁料 B.M.
- ( ) 配件 B.M.
- ( ) 其他：\_\_\_\_\_
- ( ) 加工拆圖，然後生產
- ( ) 技術上資料 / 指示
- ( ) 樣辦或貨品說明書
- ( ) 尺寸表
- ( ) 報價
- ( ) 分判合約

內容：

煩請按此訂購欄河頂裝飾(2/F-5/F)送廠

開模做送廠噴色

請在 10/11/2020 前完成上列要求。

附有關圖紙 / 文件：

以上項目為：

- 原合約工程包
- 原合約工程加 / 減賬
- 新工程報價

原因：-

分發東莞各部門：

- ( ) 生產技術總監  連附件
- ( ) 技術部  連附件
- ( ) 生產部  連附件
- ( ) 機械設計部  連附件
- ( ) 採購部  連附件
- ( ) 生產統籌部  連附件
- ( ) 質檢部  連附件
- ( ) 會計部  連附件
- ( ) 報關組  連附件
- ( ) 其他 \_\_\_\_\_  連附件

分發其他分判：

- ( ) 水洪  連附件

分發香港各部門：

- ( ) 行政部  連附件
- ( ) 會計部  連附件
- ( ) 統籌部  連附件
- ( ) 工程部地盤科文  連附件
- ( ) 採購部  連附件
- ( ) QS 部  連附件
- ( ) 維修部  連附件
- ( ) 其他 \_\_\_\_\_  連附件

傳遞編號：

HK1713 / 20

發件人簽署：

項目經理簽署：



美特鋁質有限公司  
MIDI Aluminium Fabricator Ltd.

工程號: J852

計算: \_\_\_\_\_

日期: 2020.08.01

送呈: \_\_\_\_\_

wsh

日期: \_\_\_\_\_

副本: \_\_\_\_\_

廠  
修改  
廠

項目類別: 欄河 (2F~5F) 裝飾部


此BM依據“20200731提供的施工圖”來計算



BM編號:

A/C Code:

序號	修改標示	配件圖號	物料編號	配件名稱	顏色	實用	後備	總數	單位	備注
1		依Hung028圖		欄河頂裝飾料 (頂部)	Mill	162	8	170	套	用于直位 + 轉角位
2										
3										
4										
5										
6										
7										
8										
9										
10										
11										
							合計:	170		

做模  
出  
61.

B. REF. :	
CLIENT :	
ARCHITECT :	AGC DESIGN LTD 11/F, 110 Des Voeux Road, West, Hong Kong
MAIN CONTRACTOR :	Gammon
STRUCTURAL ENGINEER :	ARUP
FAÇADE CONSULTANT :	MEINHARDT
NOTE :	1. ALL DIMENSIONS ARE IN mm. 2. ALL ELEVATIONS ARE VIEWED FROM OUTSIDE. 3. DIMENSIONS TO BE VERIFIED ON SITE BEFORE PROCEEDING.
LEGEND :	① --- DETAIL MARK NO. ② --- REFER SHEET NO. 1. F.F.L. --- FINISHED FLOOR LEVEL 2. S.F.L. --- STRUCTURAL FLOOR LEVEL 3. (R) --- REVERSED DETAIL
JOB NO. :	J-852
PROJECT :	PROPOSED RESIDENTIAL DEVELOPMENT AT 139 - 147 ARGYLE STREET, NKIL 6005, 6035, 6036 R.P., 6036 R.P., 6037 R.P. & 6038 R.P.
TITLE :	TYPICAL DETAIL FOR DIE CAST FEATURE FOR BALUSTRADE
DATE :	28-NOV-19
SCALE :	1:4
DRAWN BY :	CF
CHECKED BY :	DW
 MTD Engineering & Construction Ltd. Units 8-9, Sunny Industrial Centre, 1/F, 610 Che Kwo Ling Road, Kowloon Tel: 23489211-4, Fax: (852) 2727859	
DWG NO. :	J852-SD-CB-7001
REV. :	-

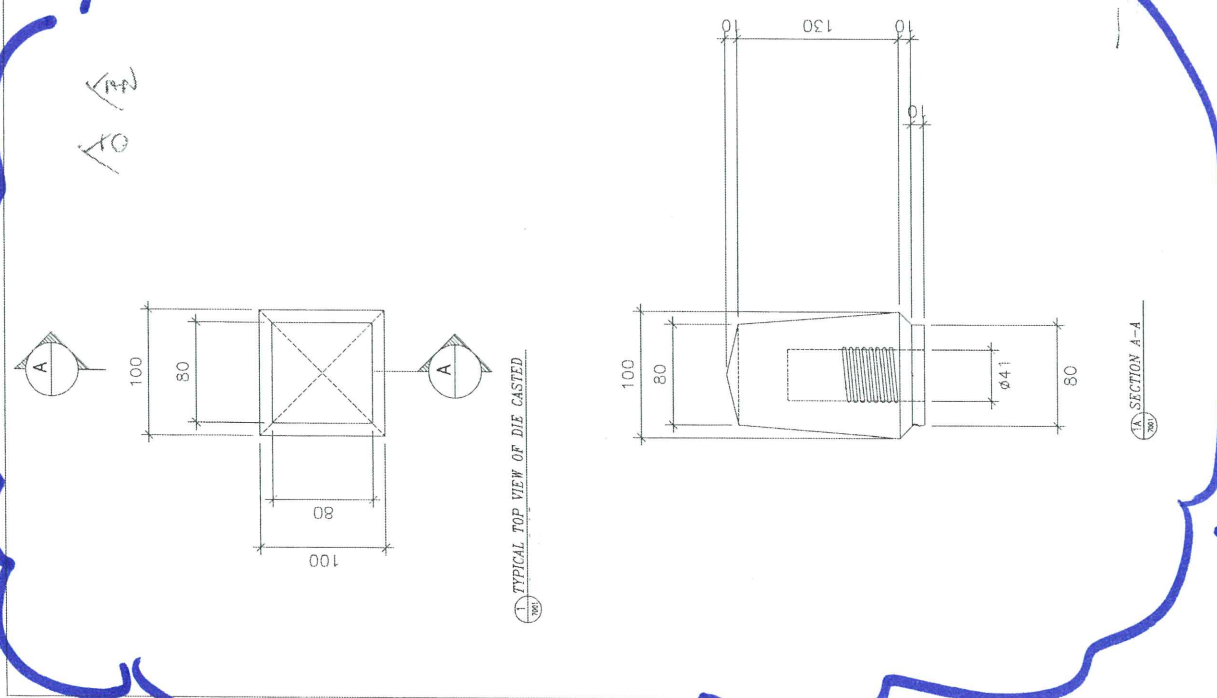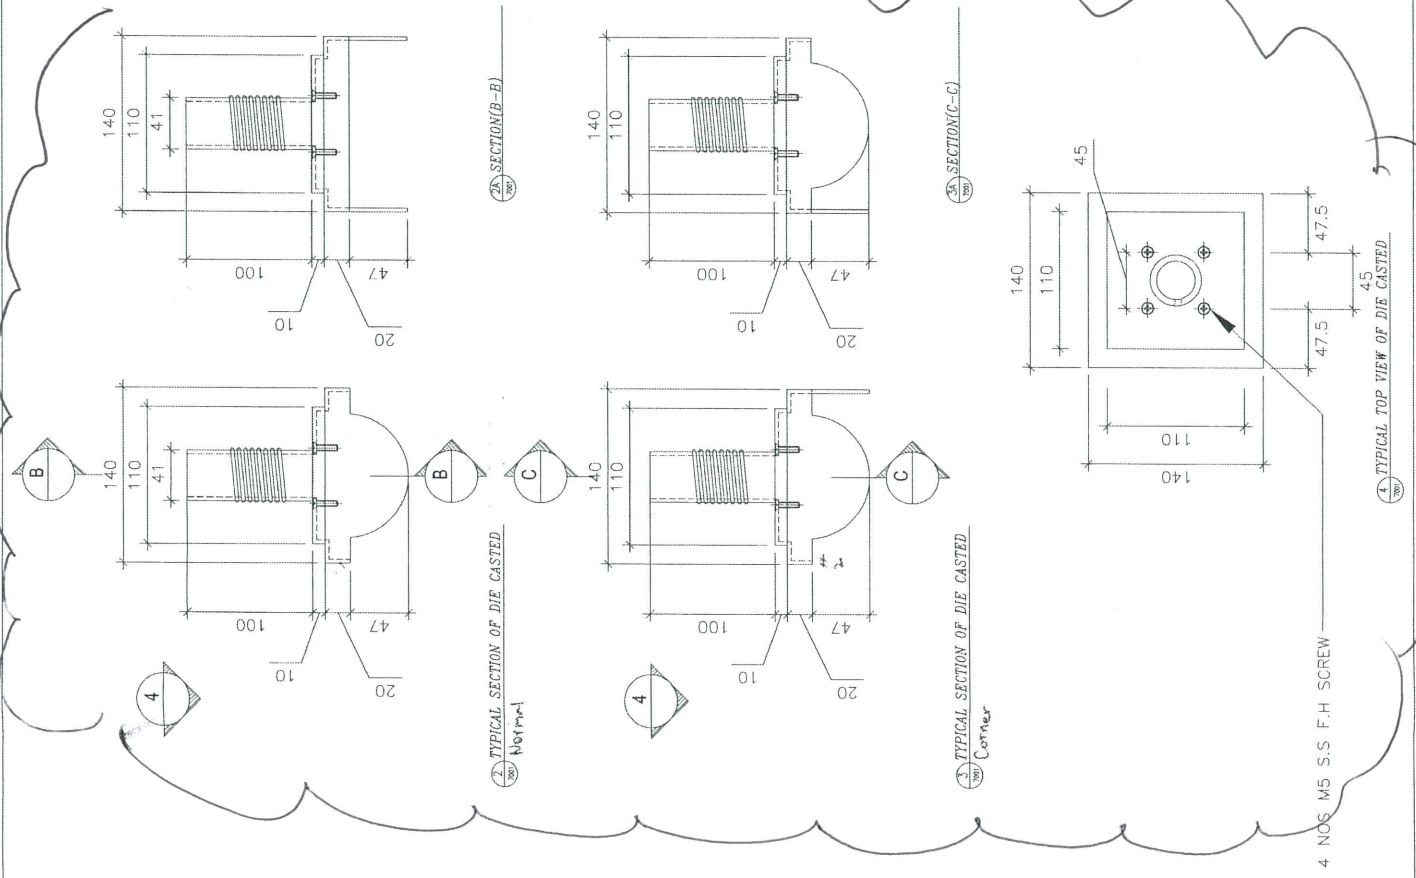

做模  
出  
61