



工程指示 / 要求簡箋(E.I.)

工程指示編號：EI / 2449 / 20

修改版次：

工程編號：J - 852

工程名稱：亞皆老街中電

工程項目：佛沙窗 主人房廁所窗加欄河玻璃

收件人：生統

發件人：Ant Yeung

日期：18/09/2020

□要求提供 / □確認 事項：

- | | | |
|------------------------------------|-------------------------------------|-------------------------------|
| <input type="checkbox"/> 初步鋁料 B.M. | <input type="checkbox"/> 加工拆圖，然後生產 | <input type="checkbox"/> 尺寸表 |
| <input type="checkbox"/> 正式鋁料 B.M. | <input type="checkbox"/> 技術上資料 / 指示 | <input type="checkbox"/> 報價 |
| <input type="checkbox"/> 配件 B.M. | <input type="checkbox"/> 樣辦或貨品說明書 | <input type="checkbox"/> 分判合約 |
| <input type="checkbox"/> 其他：_____ | | |

內容：

請按此加工圖生產給主人房廁所窗加欄河玻璃事宜。4 個窗號 玻璃托角 和 欄河槽蓋
 W4/T2A W4/T2B W4/T3B (1-3,5-7/F)，W4/T1B (1-3/F) 已出貨佛沙場，需要地盆安裝。
 W4/T1B (5-7/F) 未出貨，由廠做，原 EI 2273。

謝謝

請在 2020.09.23 前完成上列要求。

附有關圖紙 / 文件：

以上項目為：

- | | | |
|---------------------------------|--------------------------------------|--------------------------------|
| <input type="checkbox"/> 原合約工程包 | <input type="checkbox"/> 原合約工程加 / 減賬 | <input type="checkbox"/> 新工程報價 |
|---------------------------------|--------------------------------------|--------------------------------|

原因：-

分發東莞各部門：

- | | | | | | | | |
|---------------------------------|------------------------------|---|---|------------------------------|------------------------------|--------------------------------|------------------------------------|
| <input type="checkbox"/> 生產技術總監 | <input type="checkbox"/> 連附件 | <input type="checkbox"/> 技術部 | <input type="checkbox"/> 連附件 | <input type="checkbox"/> 生產部 | <input type="checkbox"/> 連附件 | <input type="checkbox"/> 機械設計部 | <input type="checkbox"/> 連附件 |
| <input type="checkbox"/> 採購部 | <input type="checkbox"/> 連附件 | <input checked="" type="checkbox"/> 生產統籌部 | <input checked="" type="checkbox"/> 連附件 | | | | |
| <input type="checkbox"/> 質檢部 | <input type="checkbox"/> 連附件 | <input type="checkbox"/> 會計部 | <input type="checkbox"/> 連附件 | <input type="checkbox"/> 報關組 | <input type="checkbox"/> 連附件 | <input type="checkbox"/> 其他 | _____ <input type="checkbox"/> 連附件 |

分發其他分判：

- | | |
|--|---|
| <input checked="" type="checkbox"/> 水洪 | <input checked="" type="checkbox"/> 連附件 |
|--|---|

分發香港各部門：

- | | | | | | | | | |
|------------------------------|------------------------------|-------------------------------|------------------------------|------------------------------|------------------------------|---|---|------------------------------|
| <input type="checkbox"/> 行政部 | <input type="checkbox"/> 連附件 | <input type="checkbox"/> 會計部 | <input type="checkbox"/> 連附件 | <input type="checkbox"/> 統籌部 | <input type="checkbox"/> 連附件 | <input checked="" type="checkbox"/> 工程部地盤科文 | <input checked="" type="checkbox"/> 連附件 | 祥哥 |
| <input type="checkbox"/> 採購部 | <input type="checkbox"/> 連附件 | <input type="checkbox"/> QS 部 | <input type="checkbox"/> 連附件 | <input type="checkbox"/> 維修部 | <input type="checkbox"/> 連附件 | <input type="checkbox"/> 其他 | _____ | <input type="checkbox"/> 連附件 |

傳遞編號：

HK 2126 / 20

發件人簽署：

項目經理簽署：

地富段

2091	W4 / T2A	1-3	5-7 / F
2092	W4 / T2B	1-3	5-7 / F
2093	W4 / T3B	1-3	5-7 / F
	W4 / T1B	1-3	1 / F

2091 T2AB, T3B 1-3

2092 T1 1-3





2254 T2AB, T3B 1-7

2273 T1 5-7.

做

W4 / T1B



5-7 / F

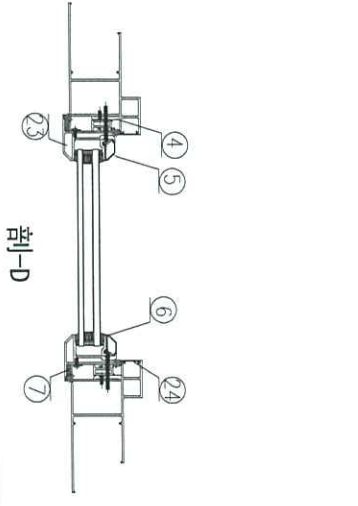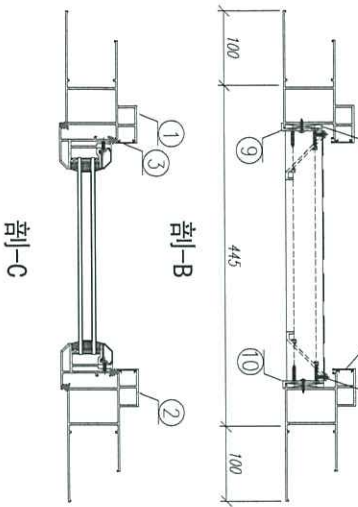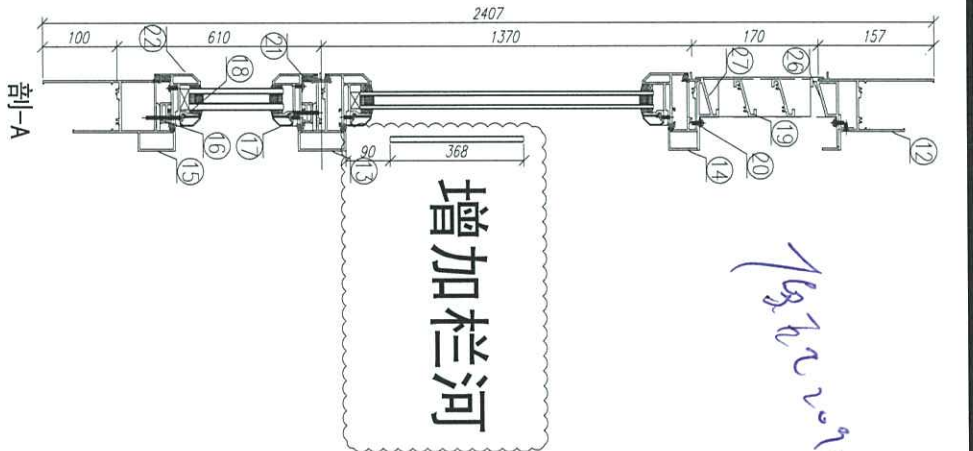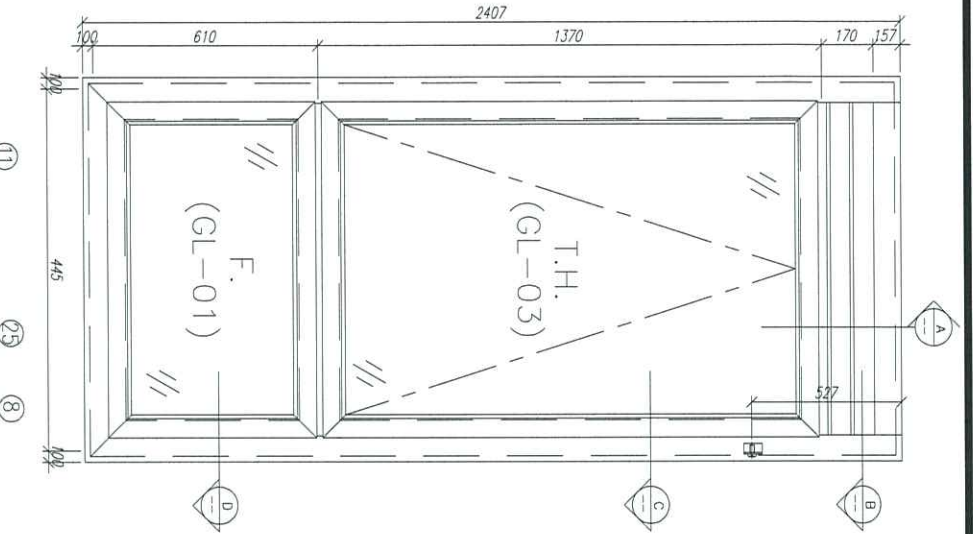

序號	材料編號	材料名稱	加工圖號	長度 L (MM)	單位	數量
1	X85759	70生窗邊框	PW01-03	2407	支	3
2	X85759	70生窗邊框	PW01-04	2407	支	3
3	X85764	70生窗拍蓋	直口開料	164.5	支	6
4	X85764	70生窗拍蓋	直口開料	89.5	支	6
4	X85764	70生窗拍蓋	直口開料	847.5	支	6
5	X85764	70生窗拍蓋	直口開料	500.5	支	6
6	X85761	70生窗頂框	PW01-19	347	支	3
7	X85775	70上生下生中橫	PW01-33	347	支	3
8	X85775	70上生下生中橫	PW01-34A	347	支	3
9	X85762	70生窗底框	PW01-22	645	支	3
10	X85840	百頁框頂	PW01-41	347	支	3
11	X85839	百頁框底	PW01-42	347	支	3
12	20*56*10*3mm	百頁五金鉸折角	PW01-AL01	144	支	3
13	20*56*10*3mm	百頁五金鉸折角	PW01-AL02	144	支	3
14	15*1, 6mm巴	雀仔細壓巴	PW01-44	171.5	支	6
15	50*5mm巴	百頁玉墊巴	PW01-43	120	支	6
16	X85838	百葉片	直口開料	324	支	6
17	20*20*3	百頁框頂鋸角	PW01-39	329	支	3
18	15*1, 6mm巴	雀仔細壓巴	PW01-44	329	支	6
如下為生窗玉料						
301	X85767	70生窗玉企	PW03-04	1360	支	3
302	X85767	70生窗玉企	PW03-05	1360	支	3
303	X85767	70生窗玉頂	PW03-01	345	支	3
304	X85767	70生窗玉底/拉手	PW03-03	345	支	3
401	X85834	70窗玻璃夾角企	PW02-06	1235	支	6
402	X85834	70窗玻璃夾角頂	PW02-06	271	支	3
403	X85834	70窗玻璃夾角底/角手	PW03-06	271	支	3
501	X85768	70窗玻璃線企	斜口開料	1255	支	6
502	X85768	70窗玻璃線頂	直口開料	271	支	3
503	X85768	70窗玻璃線底/拉手	PW03-07	271	支	3
601	X85824	多點鎖拉巴	PW03-8	93	支	3
602	X85824	多點鎖拉巴	PW03-8	75	支	3
如下為生窗煙玉料						
305	X85767	70生窗玉企	PW01-35	555	支	6
306	X85767	70生窗玉企	PW01-35	345	支	6
405	X85834	70窗玻璃夾角企	PW01-36	430	支	6
406	X85834	70窗玻璃夾角頂	PW01-36	271	支	6
505	X85768	70窗玻璃線企	斜口開料	450	支	6
506	X85768	70窗玻璃線頂	直口開料	271	支	6
701	X85785	生窗變框玉扣(玉)	PW01-40	495	支	6
702	X85785	生窗變框玉扣(玉)	PW01-40	285	支	6
801	X85786	生窗變框玉扣(框)	PW01-37	495	支	6
802	X85786	生窗變框玉扣(框)	PW01-37	285	支	6
901	15*13*1, 6角	遮膠角企	PW01-38	535	支	6
902	15*13*1, 6角	遮膠角橫	PW01-38	325	支	6

數量: 3
 材料: 详见本图附表
 表面處理: UG1806812XL-3
 日期: 2020.05.18
 校核: WSH
 审核:
 Rev: E
 美特铝質有限公司
 MIDU Aluminium Fabricator Ltd.
 工程名稱: 亞答老街 / 佛沙街
 圖名: W4/72A組裝圖
 圖號: W4/72A(1F~3F)

W4/72A
 C-3(F)

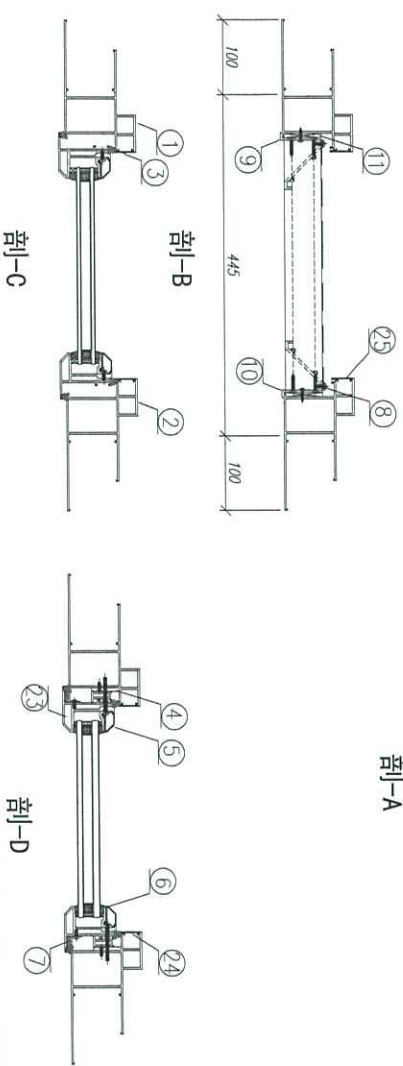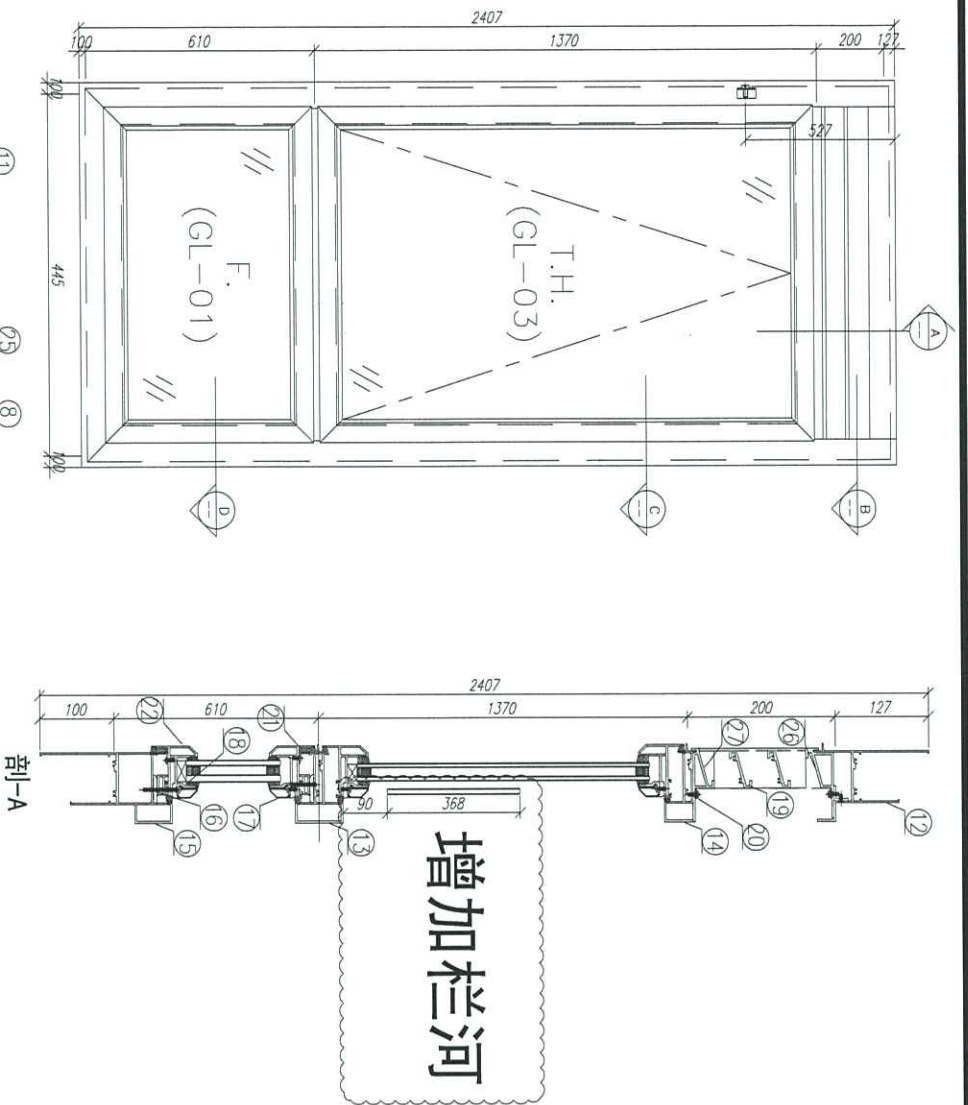

序號	材料編號	材料名稱	加工圖號	長度 L(MM)	單位	層數	小計
1	X85759	70生窗邊框	PW01-03	2107	支	1	3
2	X85759	70生窗邊框	PW01-04	2407	支	1	3
3	X85764	70生窗拍蓋	直口開料	164.5	支	2	6
4	X85764	70生窗拍蓋	直口開料	89.5	支	2	6
4	X85764	70生窗拍蓋	直口開料	847.5	支	2	6
5	X85764	70生窗拍蓋	直口開料	500.5	支	2	6
6	X85761	70生窗頂框	PW01-19	347	支	1	3
7	X85775	70上生下生中橫	PW01-33	347	支	1	3
8	X85775	70上生下生中橫	PW01-34A	347	支	1	3
9	X85762	70生窗底框	PW01-22	645	支	1	3
10	X85840	百頁框頂	PW01-41	347	支	1	3
11	X85839	百頁框底	PW01-42	347	支	1	3
12	20*56*10*3mm	百頁五金鉸折角	PW01-AL01	144	支	1	3
13	20*56*10*3mm	百頁五金鉸折角	PW01-AL02	144	支	1	3
14	15*1.6mm巴	雀仔鋼膠巴	PW01-44	171.5	支	2	6
15	50*5mm巴	百頁玉墊巴	PW01-43	120	支	2	6
16	X85838	百葉片	直口開料	324	支	2	6
17	20*20*3	白頁框頂鋁角	PW01-39	329	支	1	3
18	15*1.6mm巴	雀仔鋼膠巴	PW01-44	329	支	2	6

如下為生窗玉料

301	X85767	70生窗玉企	PW03-04	1360	支	1	3
302	X85767	70生窗玉企	PW03-05	1360	支	1	3
303	X85767	70生窗玉頂	PW03-01	345	支	1	3
304	X85767	70生窗玉底/拉手	PW03-03	345	支	1	3
401	X85834	70窗玻璃夾角企	PW02-06	1235	支	2	6
402	X85834	70窗玻璃夾角頂	PW02-06	271	支	1	3
403	X85834	70窗玻璃夾角底/拉手	PW03-06	271	支	1	3
501	X85768	70窗玻璃線企	斜口開料	1255	支	2	6
502	X85768	70窗玻璃線頂	直口開料	271	支	1	3
503	X85768	70窗玻璃線底/拉手	PW03-07	271	支	1	3
601	X85824	多點鎖拉把	PW03-8	93	支	1	3
602	X85824	多點鎖拉把	PW03-8	75	支	1	3





如下為生窗頂玉料

305	X85767	70生窗玉企	PW01-35	555	支	2	6
306	X85767	70生窗玉企	PW01-35	345	支	2	6
405	X85834	70窗玻璃夾角企	PW01-36	430	支	2	6
406	X85834	70窗玻璃夾角頂	PW01-36	271	支	2	6
505	X85768	70窗玻璃線企	斜口開料	450	支	2	6
506	X85768	70窗玻璃線頂	直口開料	271	支	2	6
701	X85785	生窗變便玉扣(玉)	PW01-40	495	支	2	6
702	X85785	生窗變便玉扣(玉)	PW01-40	285	支	2	6
801	X85786	生窗變便玉扣(框)	PW01-37	495	支	2	6
802	X85786	生窗變便玉扣(框)	PW01-37	285	支	2	6
901	15*1.3*1.6角	擋膠角企	PW01-38	535	支	2	6
902	15*1.3*1.6角	擋膠角橫	PW01-38	325	支	2	6

数量: 3
 材料: 详见本图附表
 表面处理: UCT806812XL-3
 制图: 郭上重
 日期: 2020.05.18
 审核: WSH
 Rev: E

工程名称: 亞皆老街 / 佛沙圍
 美特鋁質有限公司
 MIDI Aluminium Fabricator Ltd.
 图名: W4/12B組裝圖
 图号: W4/12B(F*3F)

W4/12B 1-3/F

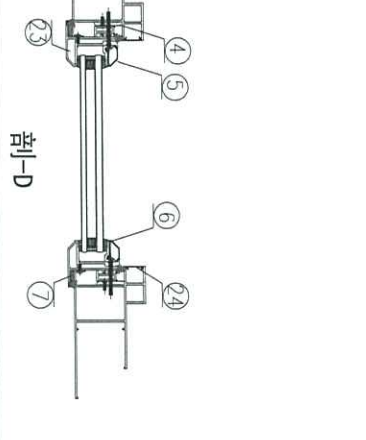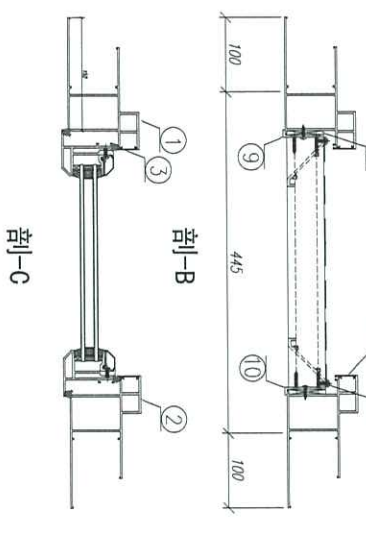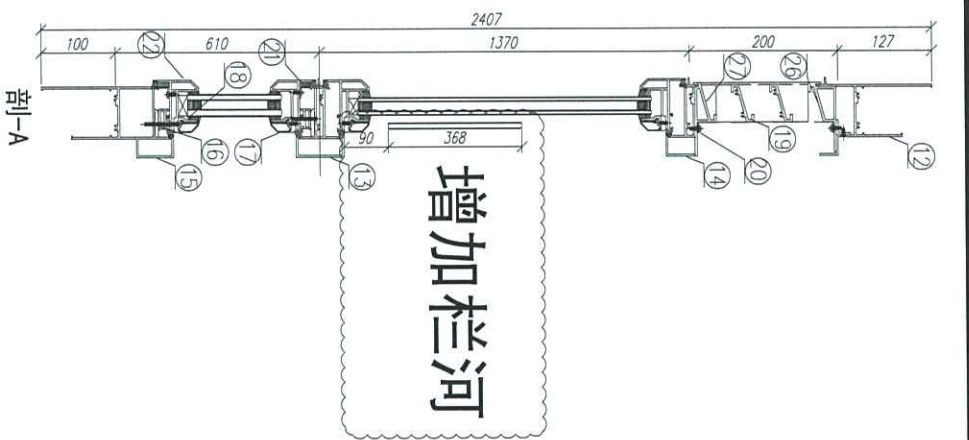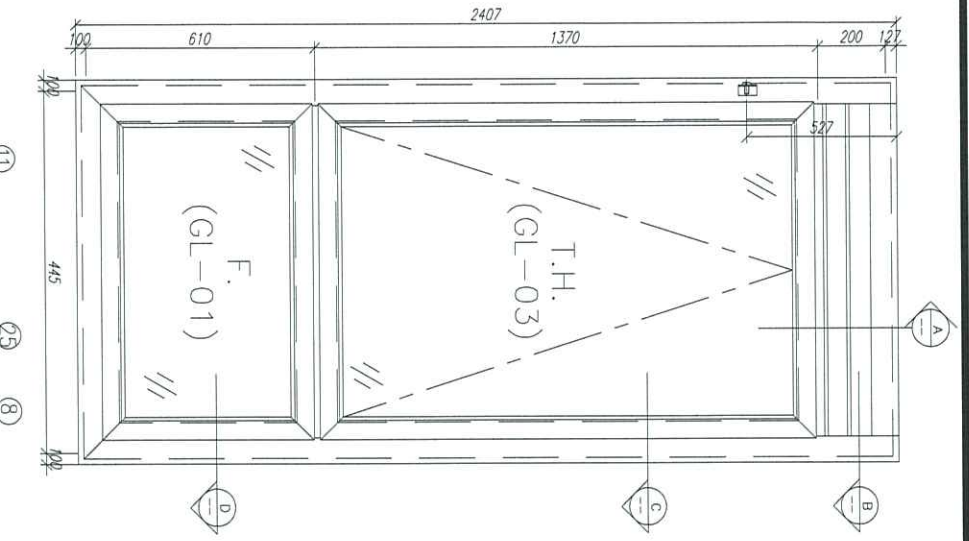


序號	材料編號	材料名稱	加工圖號	長度 L (MM)	單位	數量
1	X85759	70生窗邊框	PW01-03	2107	支	3
2	X85759	70生窗邊框	PW01-04	2407	支	3
3	X85764	70生窗拍蓋	直口開料	164.5	支	6
4	X85764	70生窗拍蓋	直口開料	89.5	支	6
4	X85764	70生窗拍蓋	直口開料	847.5	支	6
4	X85764	70生窗拍蓋	直口開料	500.5	支	6
5	X85764	70生窗拍蓋	直口開料	500.5	支	6
6	X85761	70生窗頂框	PW01-19	347	支	3
7	X85775	70上生下生中橫	PW01-33	347	支	3
8	X85775	70上生下生中橫	PW01-34A	347	支	3
9	X85762	70生窗成框	PW01-22	645	支	3
10	X85840	百頁框頂	PW01-41	347	支	3
11	X85839	百頁框底	PW01-42	347	支	3
12	20*56*10*3mm	百頁五金折角	PW01-A1.01	144	支	3
13	20*56*10*3mm	百頁五金折角	PW01-A1.02	144	支	3
14	15*1.6mm巴	雀仔銅膠巴	PW01-44	171.5	支	6
15	50*5mm巴	百頁玉熱巴	PW01-43	120	支	6
16	X85838	百頁片	直口開料	324	支	6
17	20*20*3	百頁框頂鋁角	PW01-39	329	支	3
18	15*1.6mm巴	雀仔銅膠巴	PW01-44	329	支	6
如下為生窗玉料						
301	X85767	70生窗玉企	PW03-04	1360	支	3
302	X85767	70生窗玉企	PW03-05	1360	支	3
303	X85767	70生窗玉頂	PW03-01	345	支	3
304	X85767	70生窗玉底/拉手	PW03-03	345	支	3
401	X85834	70窗玻璃夾角企	PW02-06	1235	支	6
402	X85834	70窗玻璃夾角頂	PW02-06	271	支	3
403	X85834	70窗玻璃夾角底/拉手	PW03-06	271	支	3
501	X85768	70窗玻璃線企	斜口開料	1255	支	6
502	X85768	70窗玻璃線頂	直口開料	271	支	3
503	X85768	70窗玻璃線底/拉手	PW03-07	271	支	3
601	X85824	多點鎖拉巴	PW03-8	93	支	3
602	X85824	多點鎖拉巴	PW03-8	75	支	1
如下為生窗框玉料						
305	X85767	70生窗玉企	PW01-35	555	支	6
306	X85767	70生窗玉企	PW01-35	345	支	6
405	X85834	70窗玻璃夾角企	PW01-36	430	支	6
406	X85834	70窗玻璃夾角頂	PW01-36	271	支	6
505	X85768	70窗玻璃線企	斜口開料	450	支	6
506	X85768	70窗玻璃線頂	直口開料	271	支	6
701	X85785	生窗變框玉扣(玉)	PW01-40	495	支	6
702	X85785	生窗變框玉扣(玉)	PW01-40	285	支	6
801	X85786	生窗變框玉扣(框)	PW01-37	495	支	6
802	X85786	生窗變框玉扣(框)	PW01-37	285	支	6
901	13*13*1.6角	攝膠角企	PW01-38	535	支	6
902	13*13*1.6角	攝膠角企	PW01-38	325	支	6

数量: 3
 材料: 详见本图附表
 表面处理: UCT806812XL-3
 制图: 郭上军
 日期: 2020.05.18
 校核: WSH
 审核:
 Rev. E
 工程名称: 亞皆老街 / 佛沙質
 图名: W4/T3B組裝圖
 图号: W4/T3B (1F-3F)





美特鋁業有限公司
 MID Aluminum Fabricator Ltd.
 WE/T3B 1-3F

編號	數量(支)	備註
W4/T2A	2407	3 點水螺絲孔
W5/T2A	2407	3 不點水螺絲孔
W4/T2B	2407	3 不點水螺絲孔
W5/T2B	2407	3 點水螺絲孔
W4/T3A	2407	3 不點水螺絲孔
W5/T3A	2407	3 點水螺絲孔
W4/T3B	2407	3 不點水螺絲孔
W5/T3B	2407	3 點水螺絲孔
合計:	24	

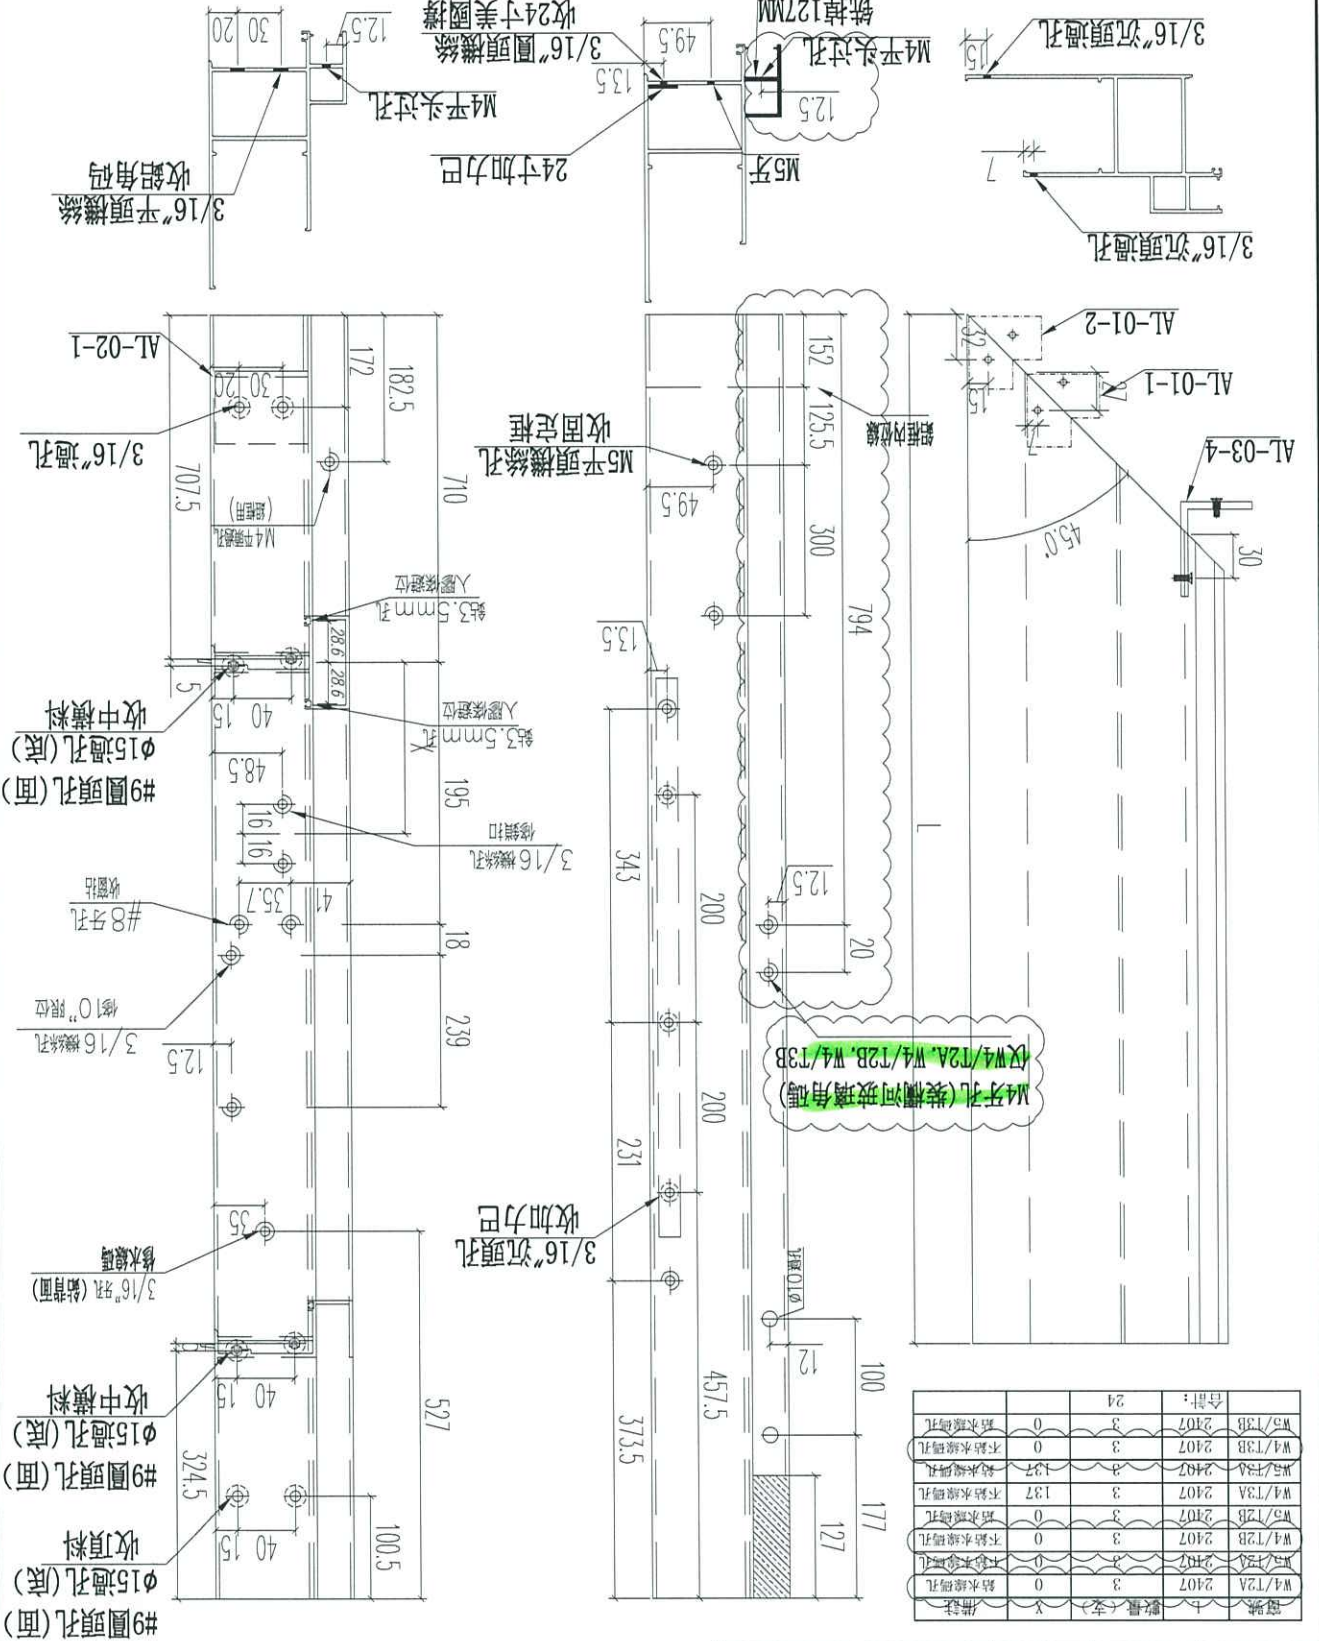

頂

名稱	70生窗邊框	制圖	JASON	2020.06.22	修改	D	E	C
材料	X85759	復核	WHS		日期	2020.08.25	2020.09.16	2020.07.25
顏色	UCT806812XL-3	批准			圖號			PW01-04

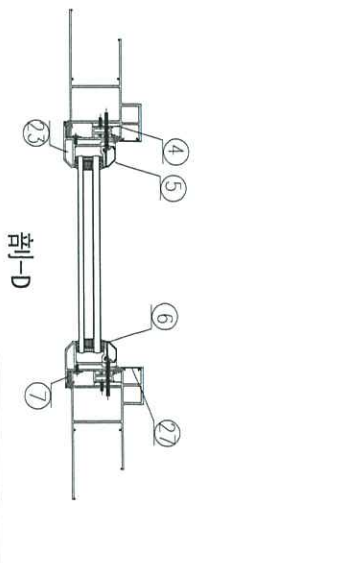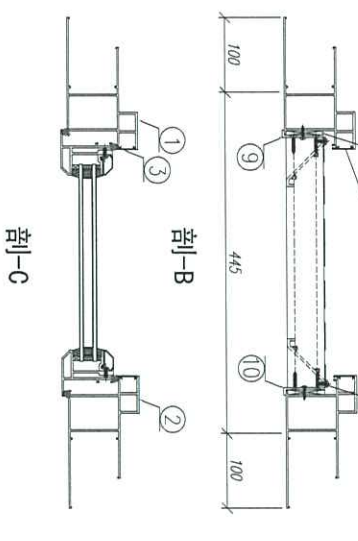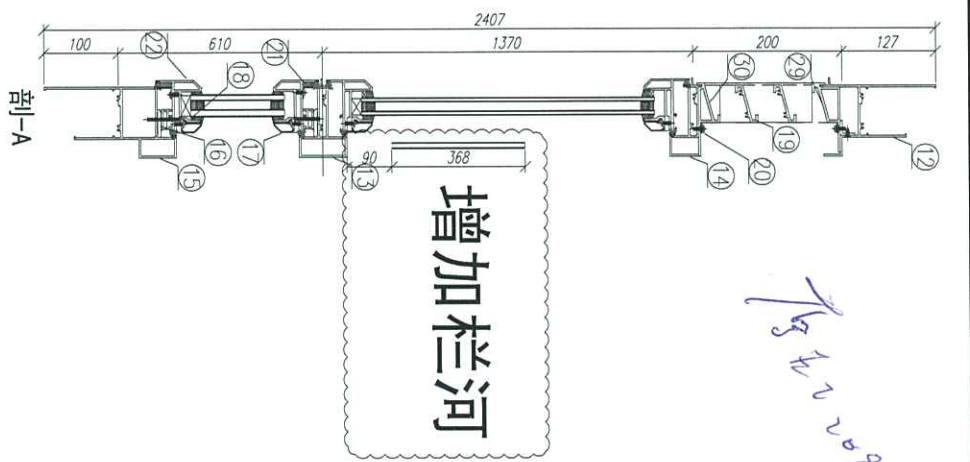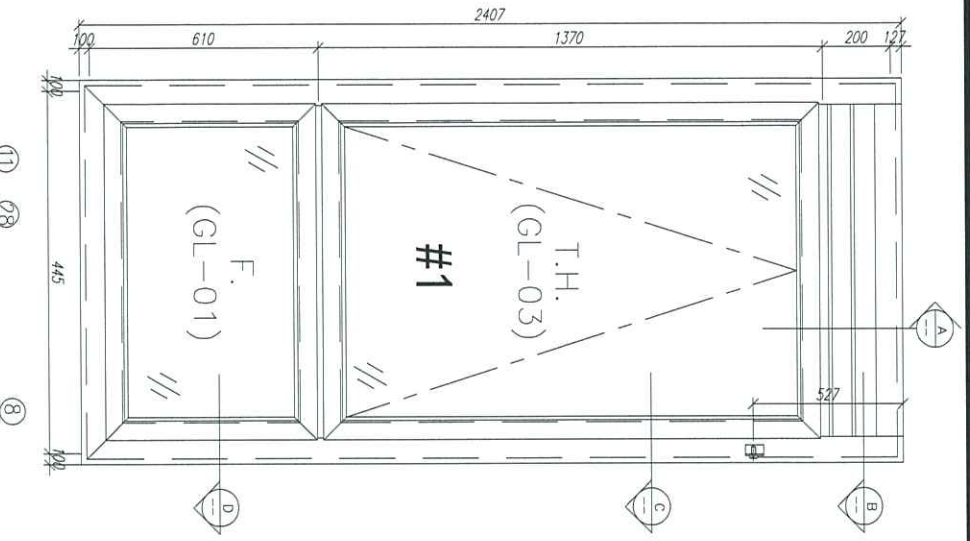

Handwritten signature and date: 2020.06.20

序號	材料編號	材料名稱	加工圖號	長度 L(MM)	單位	標數 單層	小計
1	X85759	70生窗邊框	PM01-03	2407	支	1	3
2	X85759	70生窗邊框	PM01-04	2407	支	1	3
3	X85764	70生窗拍蓋	直口開料	164.5	支	2	6
4	X85764	70生窗拍蓋	直口開料	89.5	支	2	6
4	X85764	70生窗拍蓋	直口開料	847.5	支	2	6
5	X85764	70生窗拍蓋	直口開料	500.5	支	2	6
6	X85761	70生窗頂框	PM01-19	347	支	1	3
7	X85775	70上生窗中橫	PM01-33	347	支	1	3
8	X85775	70上生窗中橫	PM01-34A	347	支	1	3
9	X85762	70生窗底框	PM01-22	645	支	1	3
10	X85840	百頁窗頂	PM01-41	347	支	1	3
11	X85839	百頁窗底	PM01-42	347	支	1	3
12	20*56*10*3mm	百頁五金鉸折角	PM01-A101	144	支	1	3
13	20*56*10*3mm	百頁五金鉸折角	PM01-A102	144	支	1	3
14	15*1.6mm巴	雀仔鋼壓巴	PM01-44	171.5	支	2	6
15	50*5mm巴	百頁玉墊巴	PM01-43	120	支	2	6
16	X85838	百葉片	直口開料	324	支	2	6
17	20*20*3	百頁窗頂鉸角	PM01-39	329	支	1	3
18	15*1.6mm巴	雀仔鋼壓巴	PM01-44	329	支	2	6
如下為生玉料							
301	X85767	70生窗玉企	PM03-04	1360	支	1	3
302	X85767	70生窗玉企	PM03-05	1360	支	1	3
303	X85767	70生窗玉頂	PM03-01	345	支	1	3
304	X85767	70生窗玉底/拉手	PM03-03	345	支	1	3
401	X85834	70窗玻璃夾角企	PM02-06	1235	支	2	6
402	X85834	70窗玻璃夾角頂	PM02-06	271	支	1	3
403	X85834	70窗玻璃夾角底/拉手	PM03-06	271	支	1	3
501	X85768	70窗玻璃線企	斜口開料	1255	支	2	6
502	X85768	70窗玻璃線頂	直口開料	271	支	1	3
503	X85768	70窗玻璃線底/拉手	PM03-07	271	支	1	3
601	X85824	多點鎖拉把	PM03-8	93	支	1	3
602	X85824	多點鎖拉把	PM03-8	75	支	1	3
如下為生雙樑玉料							
305	X85767	70生窗玉企	PM01-35	555	支	2	6
306	X85767	70生窗玉企	PM01-35	345	支	2	6
405	X85834	70窗玻璃夾角企	PM01-36	430	支	2	6
406	X85834	70窗玻璃夾角頂	PM01-36	271	支	2	6
505	X85768	70窗玻璃線企	斜口開料	450	支	2	6
506	X85768	70窗玻璃線頂	直口開料	271	支	2	6
701	X85785	生窗雙樑玉扣(玉)	PM01-10	495	支	2	6
702	X85785	生窗雙樑玉扣(玉)	PM01-10	285	支	2	6
801	X85786	生窗雙樑玉扣(樞)	PM01-37	495	支	2	6
802	X85786	生窗雙樑玉扣(樞)	PM01-37	285	支	2	6
901	15*1.3*1.6角	擋膠角企	PM01-38	535	支	2	6
902	15*1.3*1.6角	擋膠角企	PM01-38	325	支	2	6

数量: 3
 材料: 详见本图附表
 表面处理: UCT806812XL-3
 日期: 2020.06.20
 工程名称: 亞皆老街 / 佛沙窗
 制图: CJM
 日期: 2020.06.20
 校核: WSH
 审核: Rev. E
 图名: W4/T1B組裝圖
 图号: W4/T1B(QF-3F)






工程號 J852 地盤 亞皆老街

頂

窗號	尺寸 (MM)	數量 (支)	尺寸X (MM)	備註
W4/T1A	2407	3	137	不開水線碼孔
W5/T1A	2407	3	137	開水線碼孔
W4/T1B	2407	3	0	不開水線碼孔
W5/T1B	2407	3	0	開水線碼孔
合計:		12		

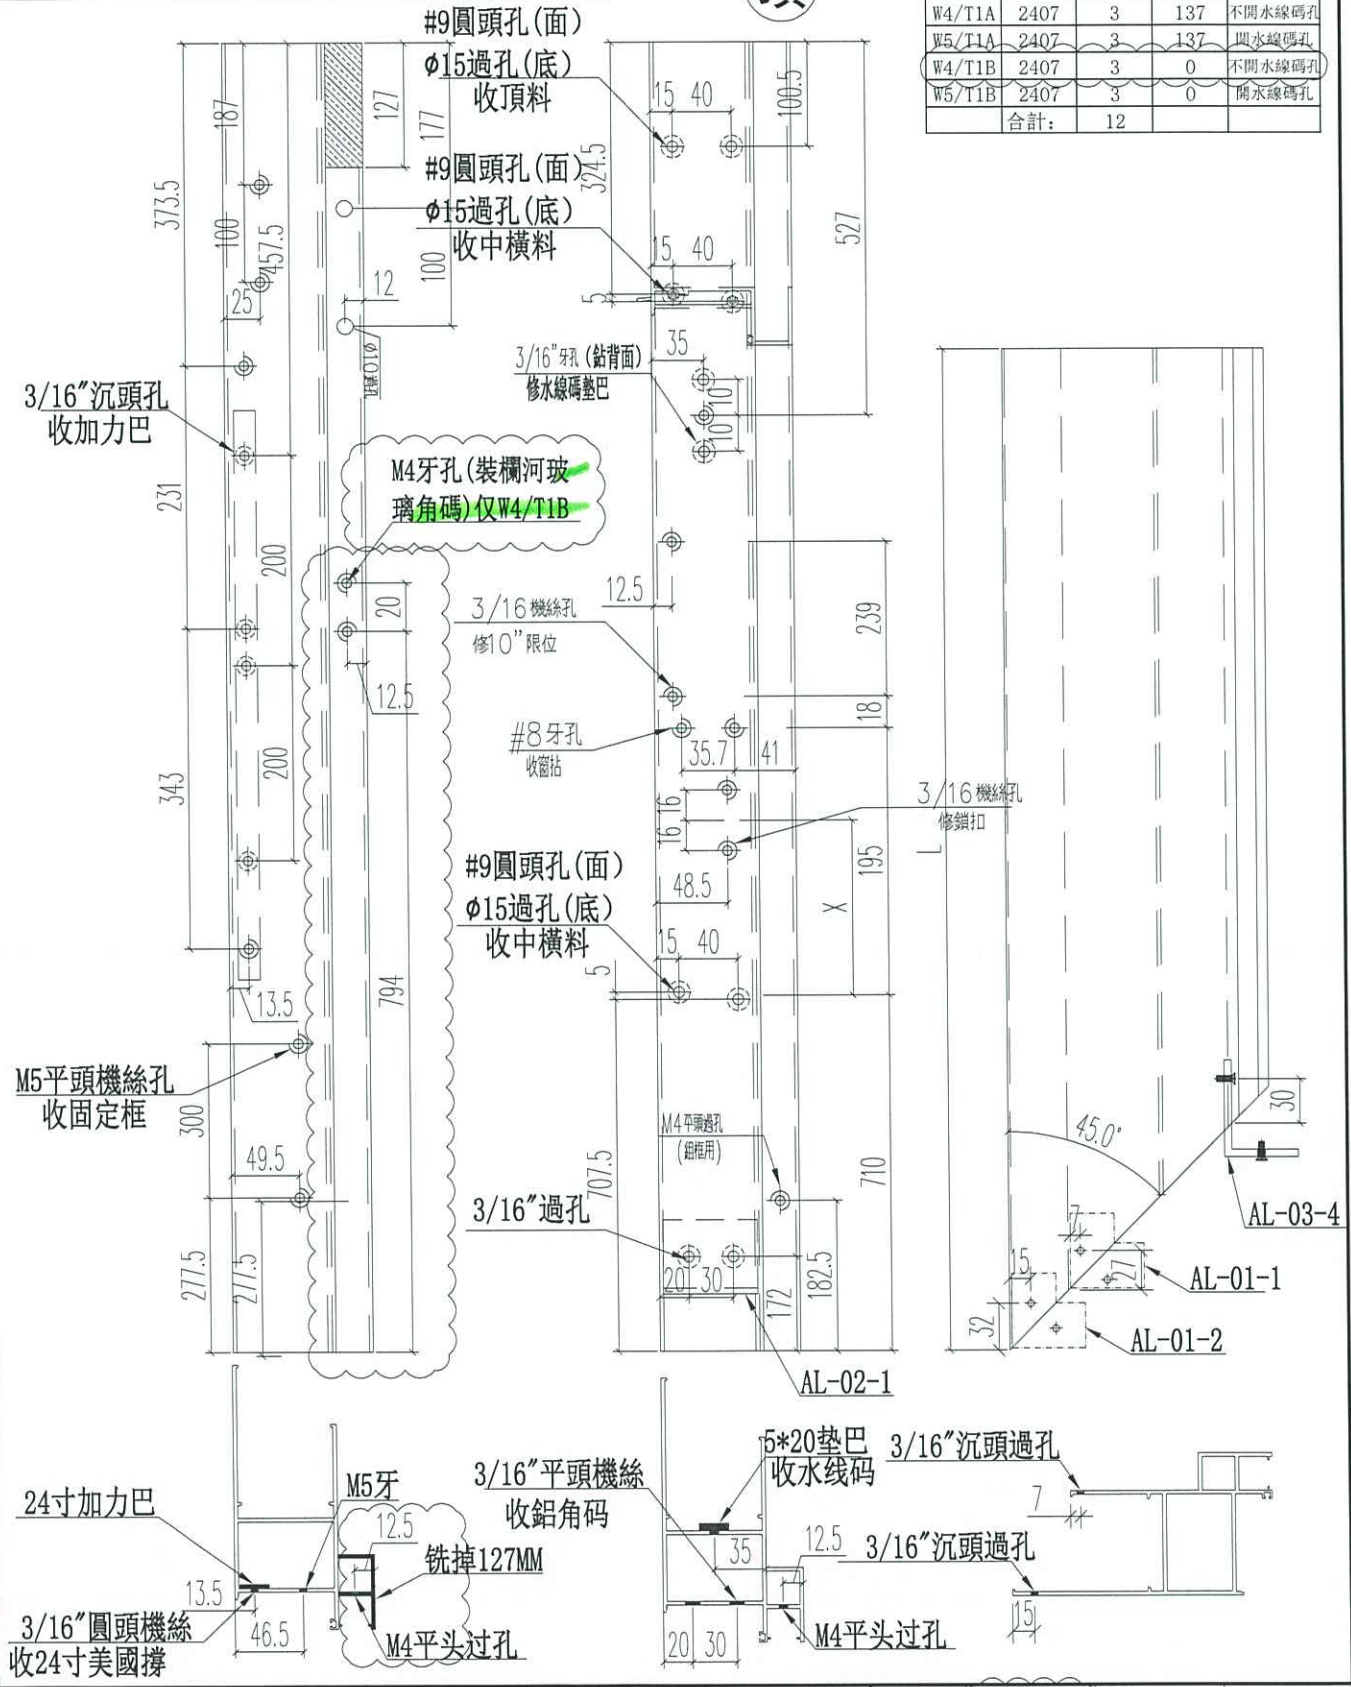


名稱	70生窗邊框	制圖	JASON	2020.06.22	修改	D	B	C
材料	X85759	復核	WHS		日期	2020.09.16	2020.07.27	2020.08.21
顏色	UCT806812XL-3	批准			圖號	PW01-03		



頂

工程號 J852 地盤 亞皆老街

窗號	尺寸 (MM)	數量 (支)	尺寸X (MM)	備註
W4/T1A	2407	3	137	開水線碼孔
W5/T1A	2407	3	137	不開水線碼孔
W4/T1B	2407	3	0	開水線碼孔
W5/T1B	2407	3	0	不開水線碼孔
合計:		12		

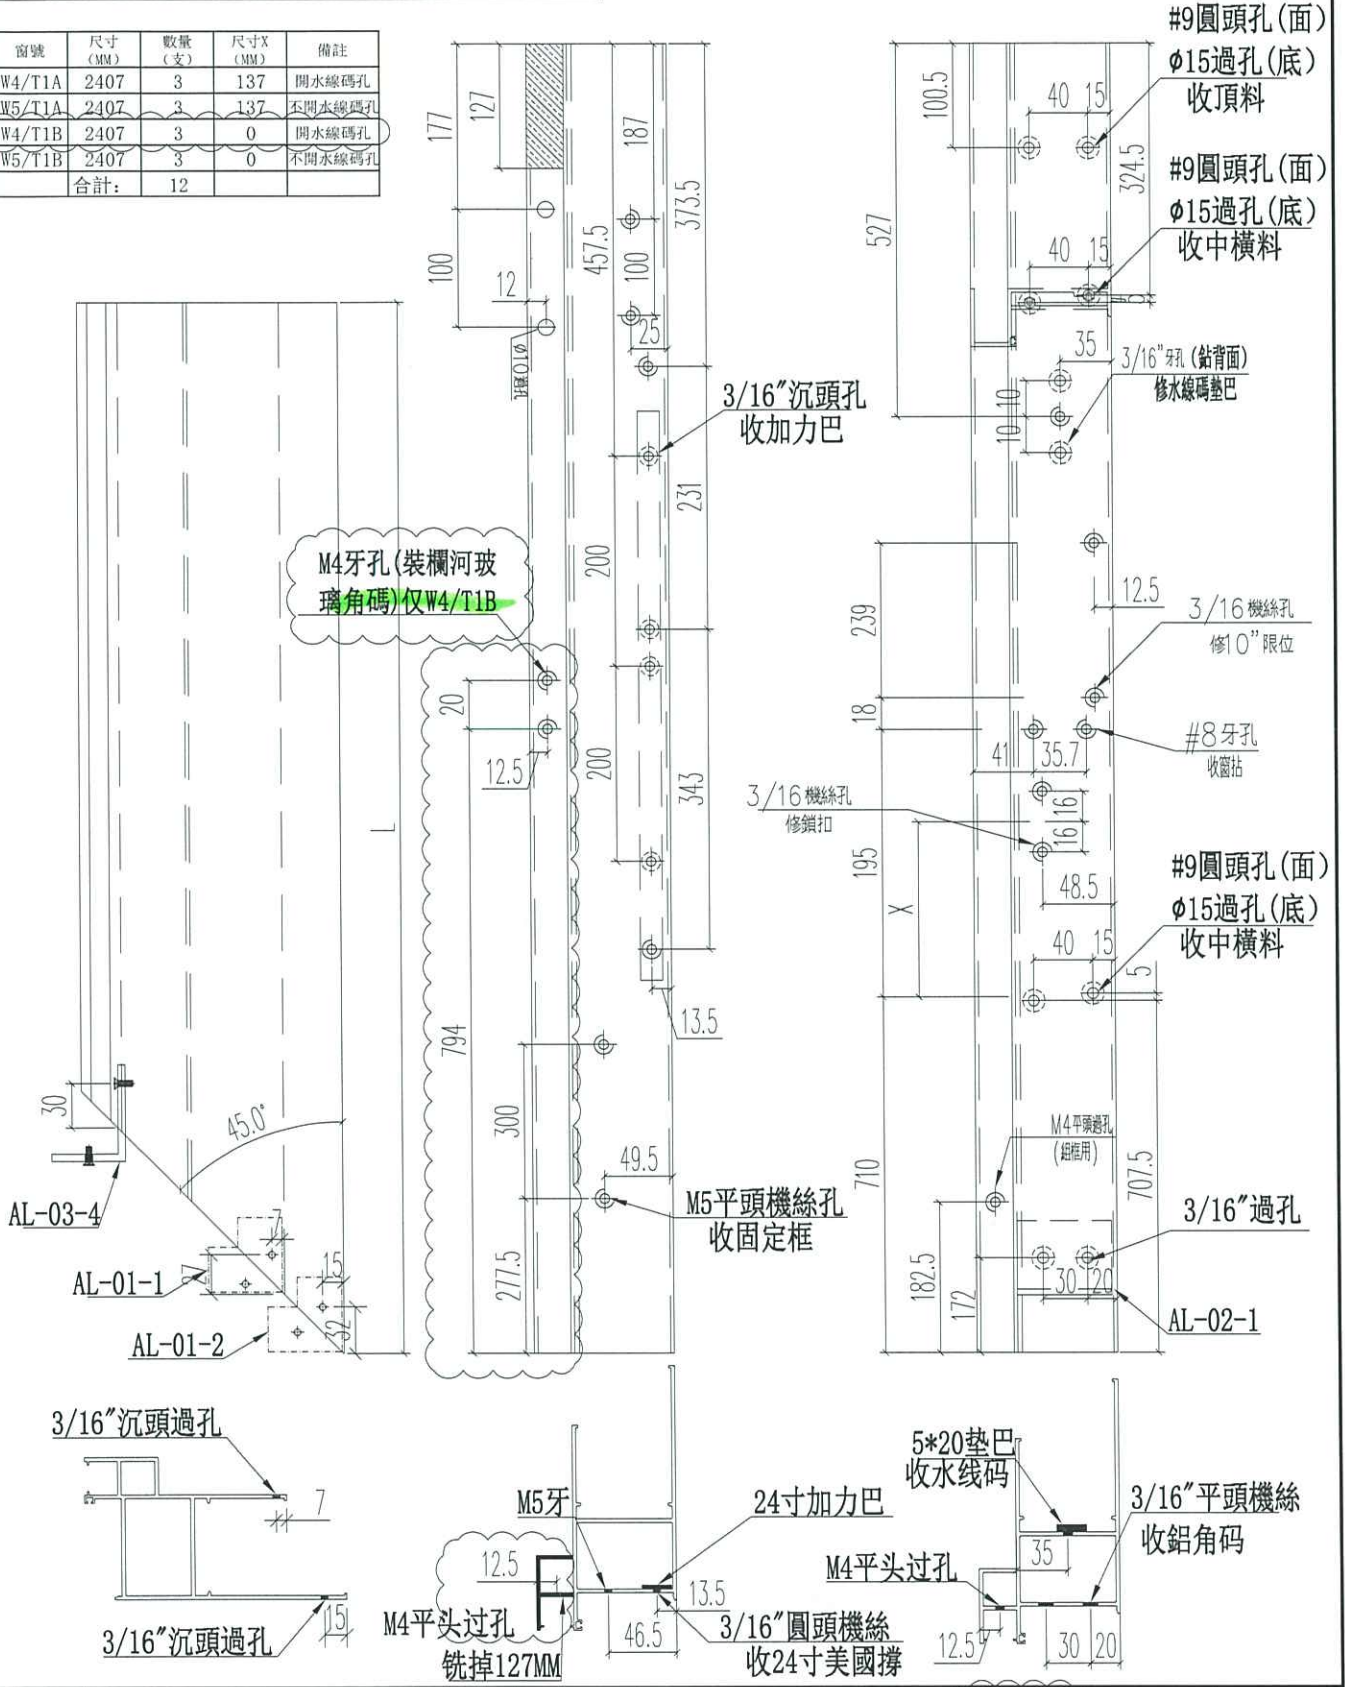

名稱	70生窗邊框	制圖	JASON	2020.06.22	修改	D	B	C
材料	X85759	復核	WHS		日期	2020.09.16	2020.07.27	2020.08.21
顏色	UCT806812XL-3	批准			圖號	PW01-04		




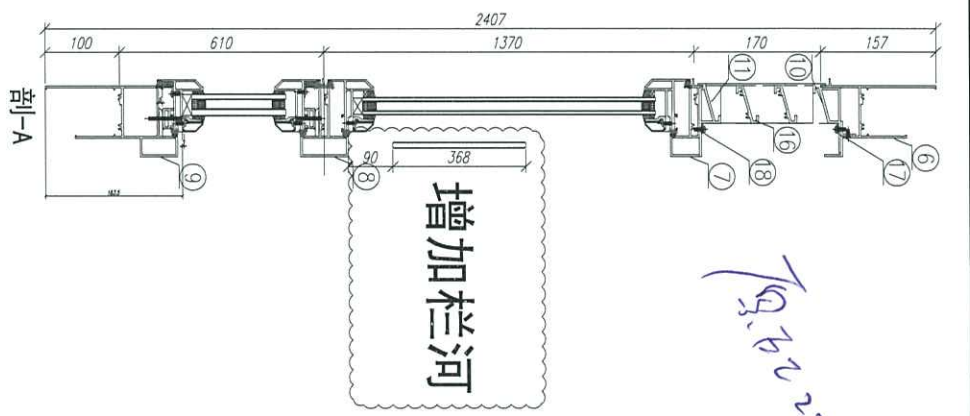


Fig. 19 20 22 25 26

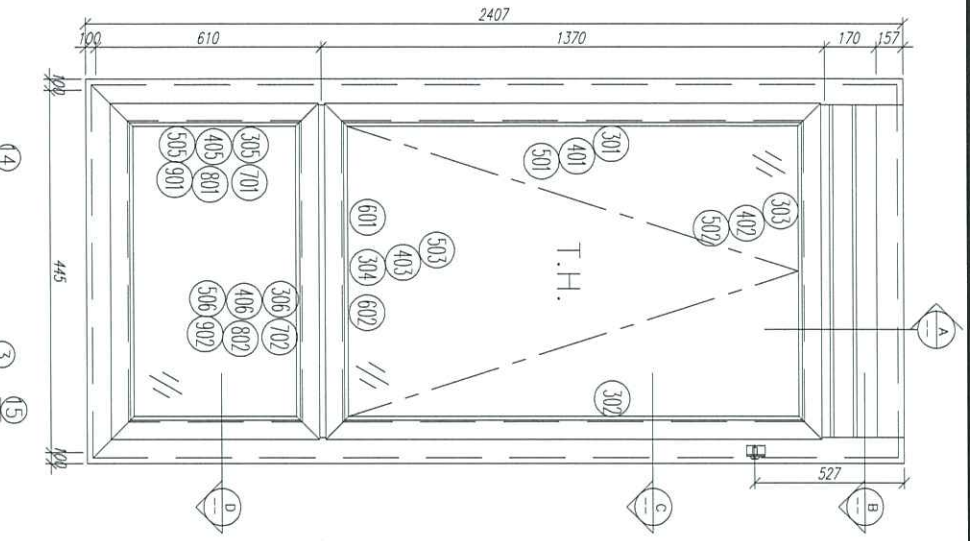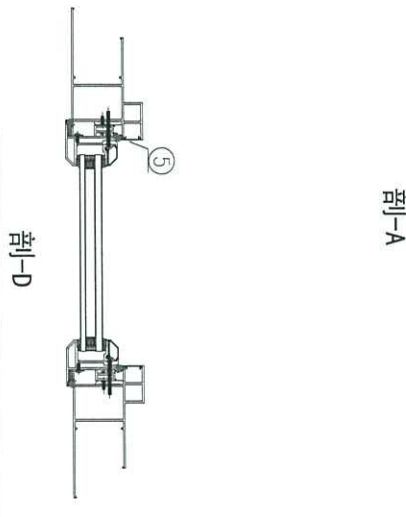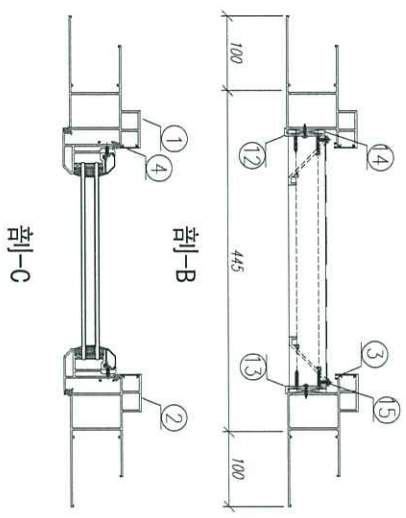

序號	材料編號	材料名稱	加工圖號	長度 L(MM)	單位	圖數	小計
1	X85759	70生窗邊框	PW01-03	2407	支	1	3
2	X85759	70生窗邊框	PW01-04	2407	支	1	3
3	X85764	70生窗拍蓋	直口開料	89.5	支	2	6
4	X85764	70生窗拍蓋	直口開料	847.5	支	2	6
5	X85764	70生窗拍蓋	直口開料	500.5	支	2	6
6	X85761	70生窗頂框	PW01-19	347	支	1	3
7	X85775	70上生窗中樑	PW01-33	347	支	1	3
8	X85775	70上生窗中樑	PW01-34A	347	支	1	3
9	X85762	70生窗底框	PW01-22	645	支	1	3
10	X85840	百頁框頂	PW01-41	347	支	1	3
11	X85839	百頁框底	PW01-42	347	支	1	3
12	20*56*10*3mm	百頁五金鉛折角	PW01-AL01	144	支	1	3
13	20*56*10*3mm	百頁五金鉛折角	PW01-AL02	144	支	1	3
14	15*1.6mm巴	雀仔鋼壓巴	PW01-44	171.5	支	2	6
15	50*5mm巴	百頁玉熱巴	PW01-43	120	支	2	6
16	X85838	百頁片	直口開料	324	支	2	6
17	20*20*3	雀仔鋼壓巴	PW01-39	329	支	1	3
18	15*1.6mm巴	雀仔鋼壓巴	PW01-44	329	支	2	6

如下為生玉料

序號	材料編號	材料名稱	加工圖號	長度 L(MM)	單位	圖數	小計
301	X85767	70生窗玉企	PW03-04	1360	支	1	3
302	X85767	70生窗玉企	PW03-05	1360	支	1	3
303	X85767	70生窗玉頂	PW03-01	345	支	1	3
304	X85767	70生窗玉底/拉手	PW03-03	345	支	1	3
401	X85834	70窗玻璃夾角企	PW02-06	1235	支	2	6
402	X85834	70窗玻璃夾角頂	PW02-06	271	支	1	3
403	X85834	70窗玻璃夾角底/拉手	PW03-06	271	支	1	3
501	X85768	70窗玻璃線頂	斜口開料	1255	支	2	6
502	X85768	70窗玻璃線頂	直口開料	271	支	1	3
503	X85768	70窗玻璃線底/拉手	PW03-07	271	支	1	3
601	X85824	多點鎖拉把	PW03-8	93	支	1	3
602	X85824	多點鎖拉把	PW03-8	75	支	1	3

如下為生變梗玉料




305	X85767	70生窗玉企	PW01-35	555	支	2	6
306	X85767	70生窗玉企	PW01-35	345	支	2	6
405	X85834	70窗玻璃夾角企	PW01-36	430	支	2	6
406	X85834	70窗玻璃夾角頂	PW01-36	271	支	2	6
505	X85768	70窗玻璃線企	斜口開料	450	支	2	6
506	X85768	70窗玻璃線頂	直口開料	271	支	2	6
701	X85785	生窗變梗玉扣(玉)	PW01-40	495	支	2	6
702	X85785	生窗變梗玉扣(玉)	PW01-40	285	支	2	6
801	X85786	生窗變梗玉扣(框)	PW01-37	495	支	2	6
802	X85786	生窗變梗玉扣(框)	PW01-37	285	支	2	6
901	15*13*1.6角	搖膠角企	PW01-38	535	支	2	6
902	15*13*1.6角	搖膠角樑	PW01-38	325	支	2	6

数量: 3
 材料: 详见本图附表
 表面处理: UCT80812XL-3
 日期: 2020.07.26
 校核: NSH
 审核:
 Rev: B


工程名称: 亞皆老街 / 佛沙道 (M02B)
 图名: W4/T2A組裝圖
 图号: W4/T2A

美特铝質 有限公司
 MIDU Aluminium Fabricator Ltd.

5-277

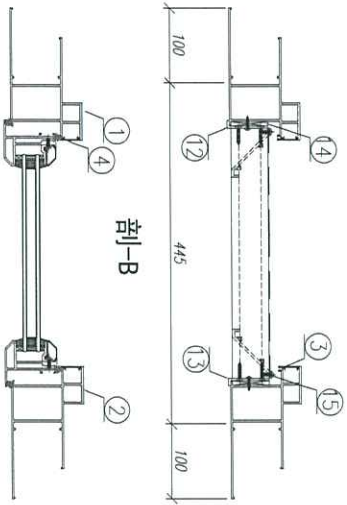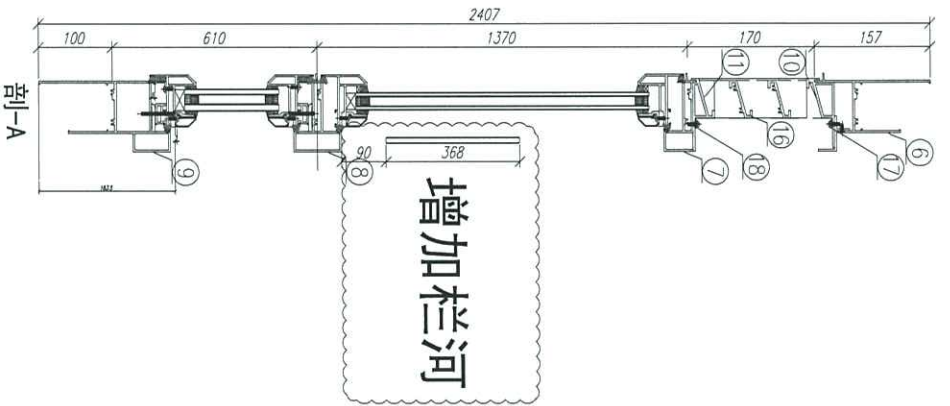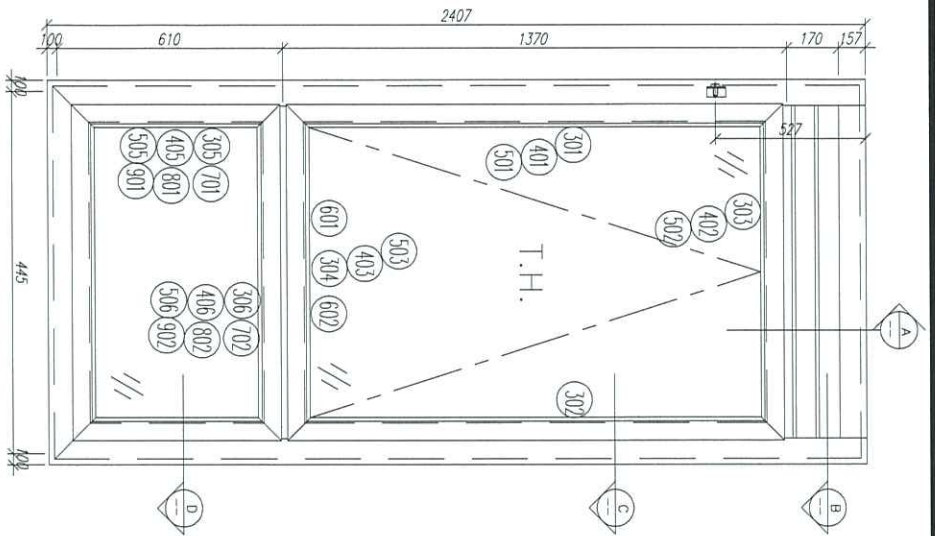


剖-A

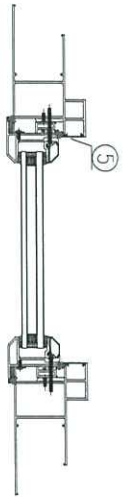

剖-B



剖-C

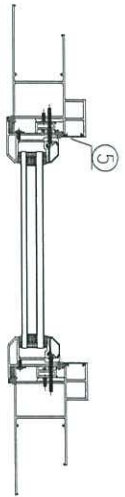

剖-D

序號	材料編號	材料名稱	加工圖號	長度 L (MM)	單位	數量	備註	小計
1	X85759	70生窗邊框	PW01-03	2407	支	1		3
2	X85759	70生窗邊框	PW01-04	2407	支	1		3
3	X85764	70生窗拍蓋	直口開料	164.5	支	2		6
4	X85764	70生窗拍蓋	直口開料	89.5	支	2		6
4	X85764	70生窗拍蓋	直口開料	847.5	支	2		6
5	X85764	70生窗拍蓋	直口開料	500.5	支	2		6
6	X85761	70生窗頂框	PW01-19	347	支	1		3
7	X85775	70上生窗中橫	PW01-33	347	支	1		3
8	X85775	70上生窗下中橫	PW01-34A	347	支	1		3
9	X85762	70生窗底框	PW01-22	645	支	1		3
10	X85840	百頁窗頂	PW01-41	347	支	1		3
11	X85839	百頁窗底	PW01-42	347	支	1		3
12	20*56*10*3mm	百頁五金鉸折角	PW01-AL01	144	支	1		3
13	20*56*10*3mm	百頁五金鉸折角	PW01-AL02	144	支	1		3
14	15*1.6mm巴	雀仔鋼條巴	PW01-44	171.5	支	2		6
15	50*5mm巴	百頁玉墊巴	PW01-43	120	支	2		6
16	X85838	百葉片	直口開料	324	支	2		6
17	20*20*3	百頁窗頂鋁角	PW01-39	329	支	1		3
18	15*1.6mm巴	雀仔鋼條巴	PW01-44	329	支	2		6

如下為生玉料

序號	材料編號	材料名稱	加工圖號	長度 L (MM)	單位	數量	備註	小計
301	X85767	70生窗玉企	PW03-04	1360	支	1		3
302	X85767	70生窗玉企	PW03-05	1360	支	1		3
303	X85767	70生窗玉頂	PW03-01	345	支	1		3
304	X85767	70生窗玉底/拉手	PW03-03	345	支	1		3
401	X85834	70窗玻璃夾角企	PW02-06	1235	支	2		6
402	X85834	70窗玻璃夾角頂	PW02-06	271	支	1		3
403	X85834	70窗玻璃夾角底/拉手	PW03-06	271	支	1		3
501	X85768	70窗玻璃線頂	斜口開料	1255	支	2		6
502	X85768	70窗玻璃線頂	直口開料	271	支	1		3
503	X85768	70窗玻璃線底/拉手	PW03-07	271	支	1		3
601	X85824	多點鎖拉巴	PW03-8	93	支	1		3
602	X85824	多點鎖拉巴	PW03-8	75	支	1		3

如下為生變硬玉料




305	X85767	70生窗玉企	PW01-35	555	支	2		6
306	X85767	70生窗玉企	PW01-35	345	支	2		6
405	X85834	70窗玻璃夾角企	PW01-36	430	支	2		6
406	X85834	70窗玻璃夾角頂	PW01-36	271	支	2		6
505	X85768	70窗玻璃線企	斜口開料	450	支	2		6
506	X85768	70窗玻璃線頂	直口開料	271	支	2		6
701	X85785	生窗變硬玉扣(玉)	PW01-40	495	支	2		6
702	X85785	生窗變硬玉扣(玉)	PW01-40	285	支	2		6
801	X85786	生窗變硬玉扣(框)	PW01-37	495	支	2		6
802	X85786	生窗變硬玉扣(框)	PW01-37	285	支	2		6
901	15*13*1.6角	搖膠角企	PW01-38	535	支	2		6
902	15*13*1.6角	搖膠角企	PW01-38	325	支	2		6

5-712


数量: 3
材料: 详见本图附表
表面处理: UC1806812XL-3
制图: 郭上军
日期: 2020.07.26
审核: WSH
Rev: B

工程名称: 亞崙老街 / 佛沙窗 (M02B)
MIDI Aluminium Fabricator Ltd.
图名: W4/12B組裝圖
图号: W4/12B

美特铝业 有限公司
MIDI Aluminium Fabricator Ltd.

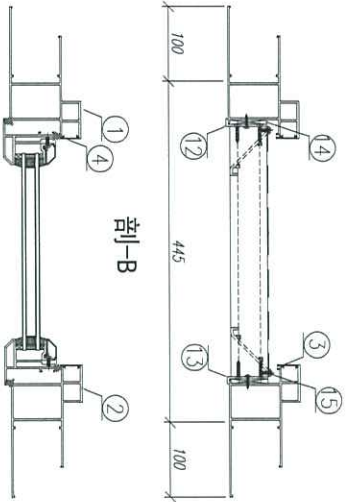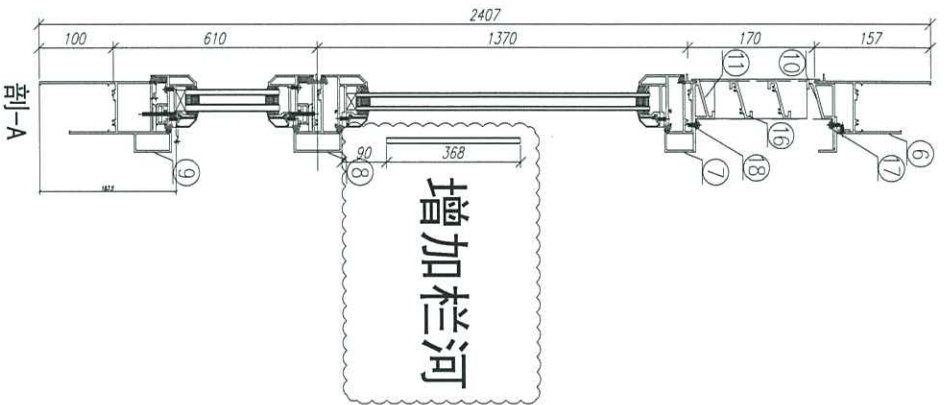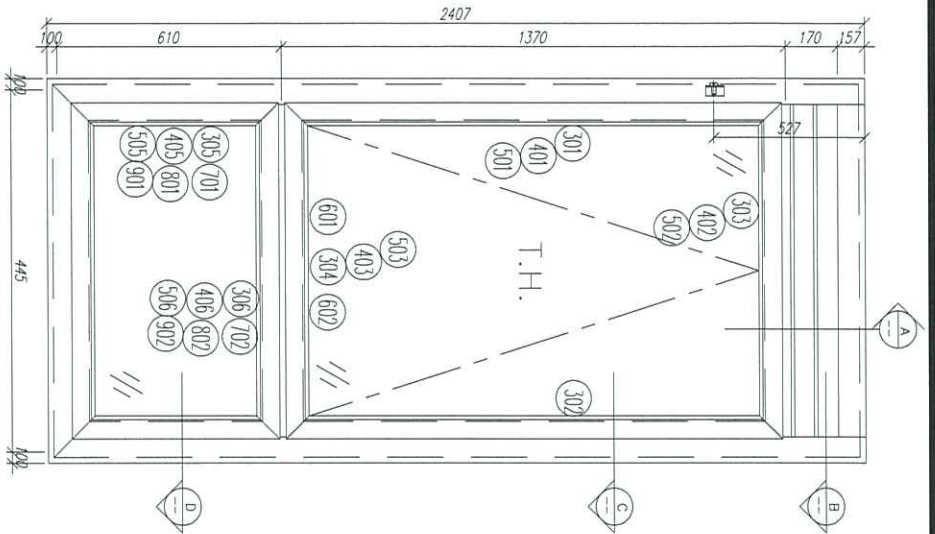

剖面-B

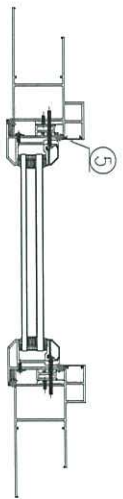

剖面-C

序號	材料編號	材料名稱	加工圖號	長度 L(MM)	單位	備註 單樘小計
1	X85759	70生窗邊框	PM01-03	2407	支	1
2	X85759	70生窗邊框	PM01-04	2407	支	1
3	X85764	70生窗拍蓋	直口開料	164.5	支	2
4	X85764	70生窗拍蓋	直口開料	89.5	支	2
4	X85764	70生窗拍蓋	直口開料	847.5	支	2
5	X85764	70生窗拍蓋	直口開料	500.5	支	2
6	X85761	70生窗頂框	PM01-19	347	支	1
7	X85775	70上生窗中橫	PM01-33	347	支	1
8	X85775	70上生窗中橫	PM01-34A	347	支	1
9	X85762	70生窗底框	PM01-22	645	支	1
10	X85840	百頁框頂	PM01-41	347	支	1
11	X85839	百頁框底	PM01-42	347	支	1
12	20*56*10*3mm	百頁五金鉛折角	PM01-AL01	144	支	1
13	20*56*10*3mm	百頁五金鉛折角	PM01-AL02	144	支	1
14	15*1.6mm巴	雀仔銅膠巴	PM01-44	171.5	支	2
15	50*5mm巴	百頁玉轆巴	PM01-43	120	支	2
16	X85838	百葉片	直口開料	324	支	2
17	20*20*3	雀仔框頂鋁角	PM01-39	329	支	1
18	15*1.6mm巴	雀仔銅膠巴	PM01-44	329	支	2

如下為生玉料

301	X85767	70生窗玉企	PM03-04	1360	支	1
302	X85767	70生窗玉企	PM03-05	1360	支	1
303	X85767	70生窗玉頂	PM03-01	345	支	1
304	X85767	70生窗玉底/拉手	PM03-03	345	支	1
401	X85834	70窗玻璃夾角企	PM02-06	1235	支	2
402	X85834	70窗玻璃夾角頂	PM02-06	271	支	1
403	X85834	70窗玻璃夾角底/拉手	PM03-06	271	支	1
501	X85768	70窗玻璃線頂	斜口開料	1255	支	2
502	X85768	70窗玻璃線頂	直口開料	271	支	1
503	X85768	70窗玻璃線底/拉手	PM03-07	271	支	1
601	X85824	多點鎖拉巴	PM03-8	93	支	1
602	X85824	多點鎖拉巴	PM03-8	75	支	1

如下為生變框玉料

305	X85767	70生窗玉企	PM01-35	555	支	2
306	X85767	70生窗玉企	PM01-35	345	支	2
405	X85834	70窗玻璃夾角企	PM01-36	430	支	2
406	X85834	70窗玻璃夾角頂	PM01-36	271	支	2
505	X85768	70窗玻璃線企	斜口開料	450	支	2
506	X85768	70窗玻璃線頂	直口開料	271	支	2
701	X85785	生窗變框玉扣(玉)	PM01-40	495	支	2
702	X85785	生窗變框玉扣(玉)	PM01-40	285	支	2
801	X85786	生窗變框玉扣(框)	PM01-37	495	支	2
802	X85786	生窗變框玉扣(框)	PM01-37	285	支	2
901	15*13*1.6角	搖膠角企	PM01-38	535	支	2
902	15*13*1.6角	搖膠角企	PM01-38	325	支	2

数量: 3
 材料: 详见本图附表
 表面处理: UCT806812XL-3
 制图: 郭上军
 日期: 2020.07.26
 校核: WSH
 审核: Rev: B

工程名称: 亞答老街 / 佛沙窗 (M02B)
 图名: W4/738組裝圖
 图号: W4/738



美特鋁質有限公司
 MIDI Aluminium Fabricator Ltd.


5-27





工程號 J852 地盤 亞皆老街

頂

窗號	L	數量(支)	X	備註
W4/T2A	2407	3	0	鉗水線碼孔
W5/T2A	2407	3	0	不鉗水線碼孔
W4/T2B	2407	3	0	不鉗水線碼孔
W5/T2B	2407	3	0	鉗水線碼孔
W4/T3A	2407	3	137	不鉗水線碼孔
W5/T3A	2407	3	137	鉗水線碼孔
W4/T3B	2407	3	0	不鉗水線碼孔
W5/T3B	2407	3	0	鉗水線碼孔
合計:		24		

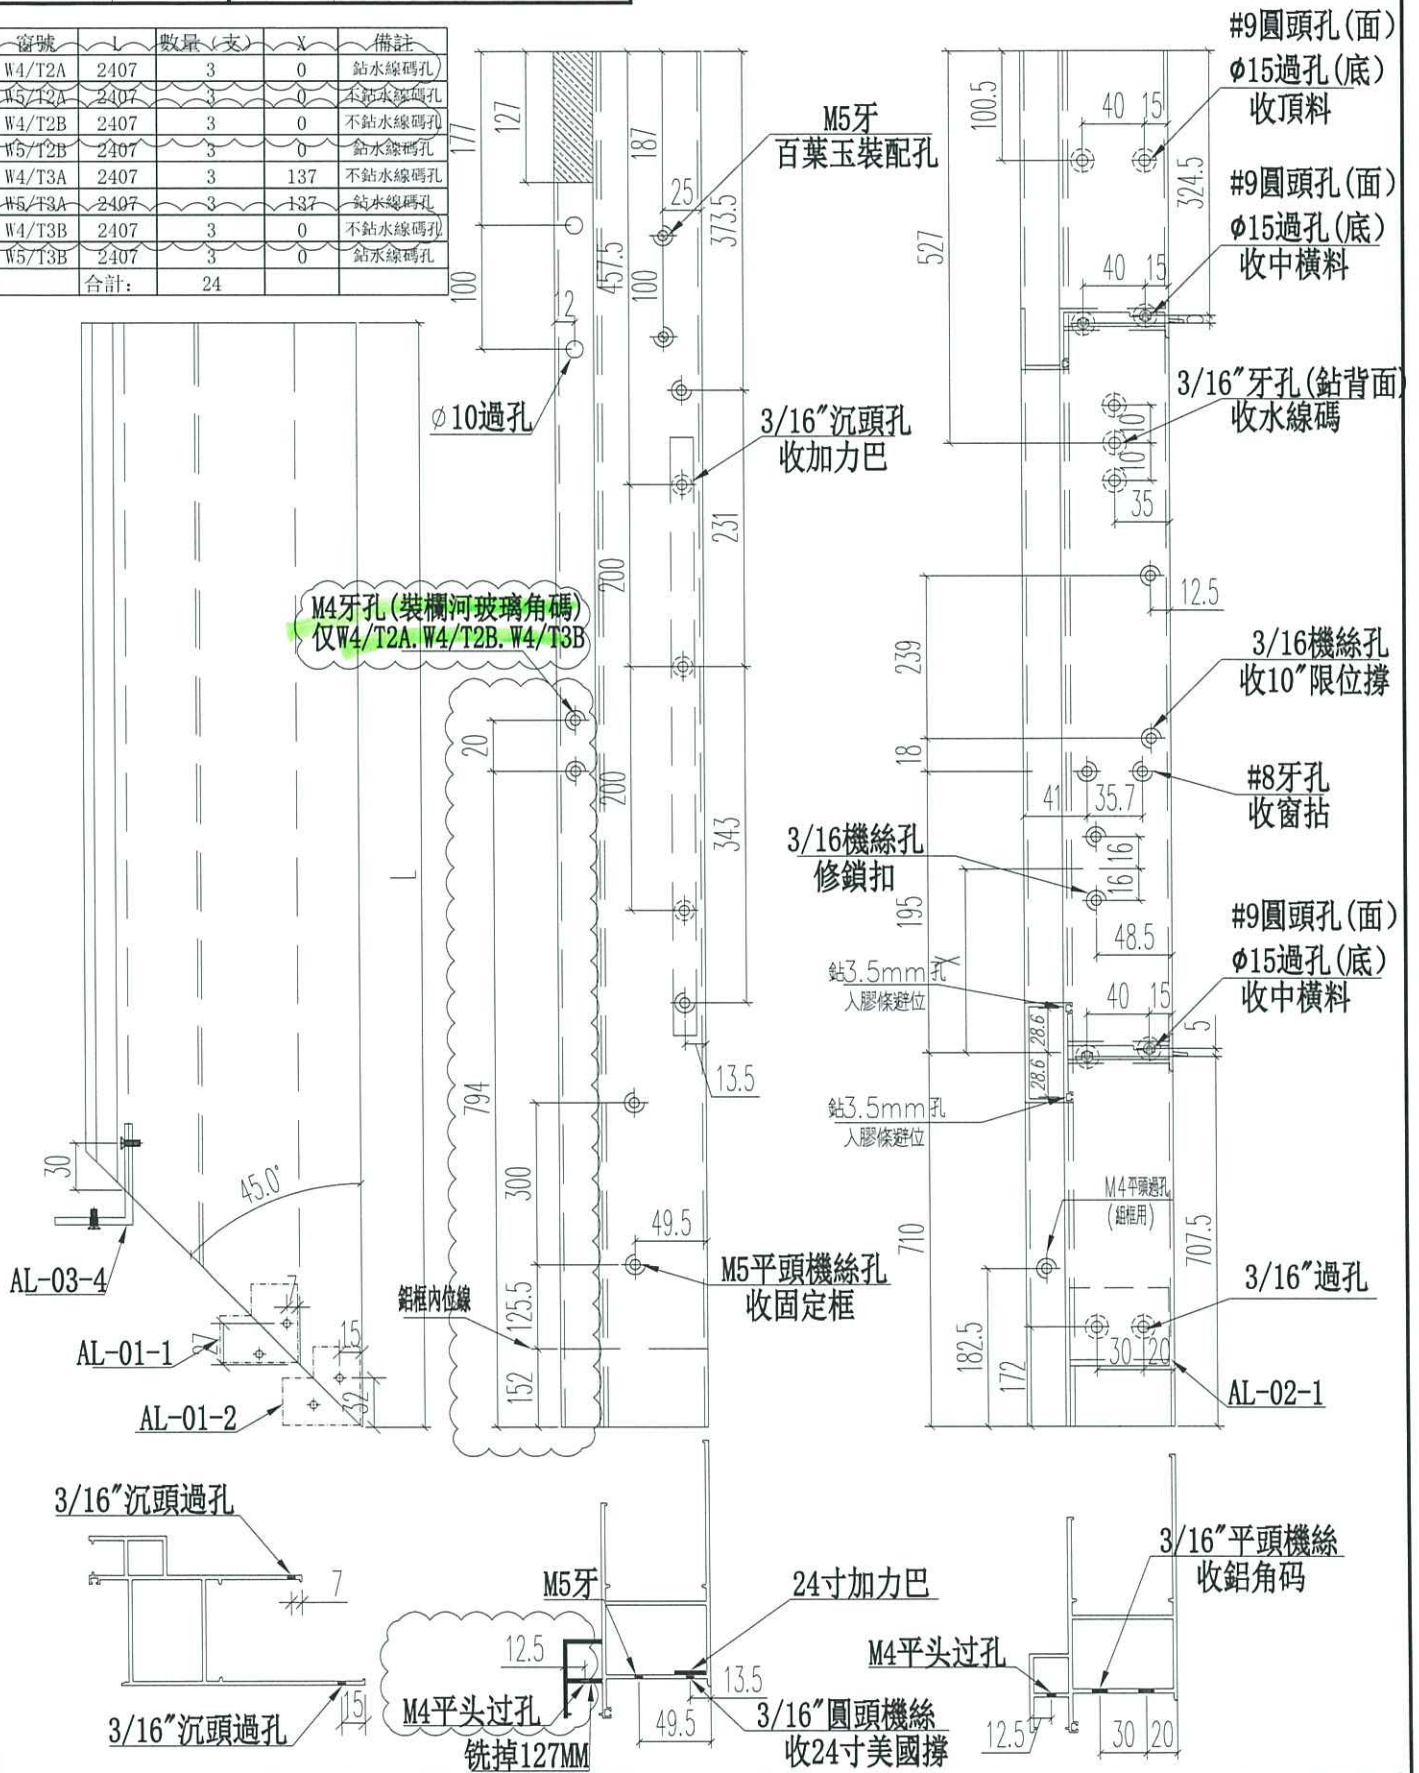

名稱	70生窗邊框	制圖	JASON	2020.06.22	修改	A	B	C
材料	X85759	復核	WHS		日期	2020.08.21	2020.08.25	2020.09.16
顏色	UCT806812XL-3	批准			圖號	PW01-04		

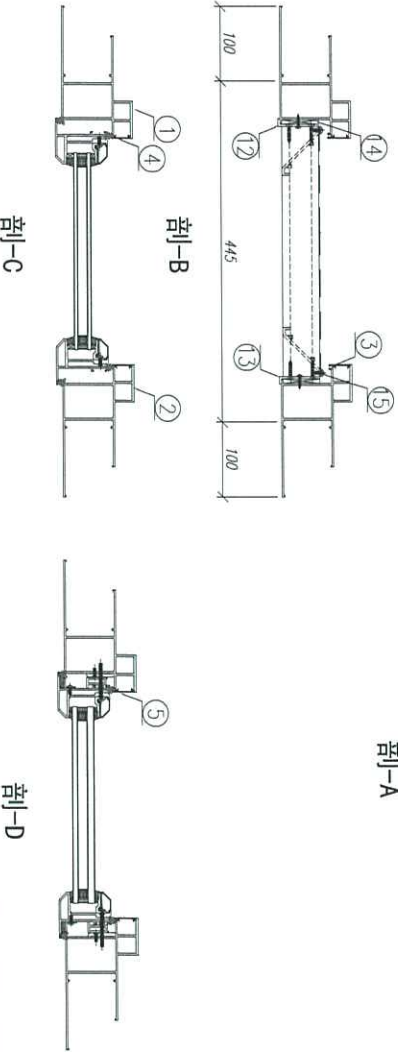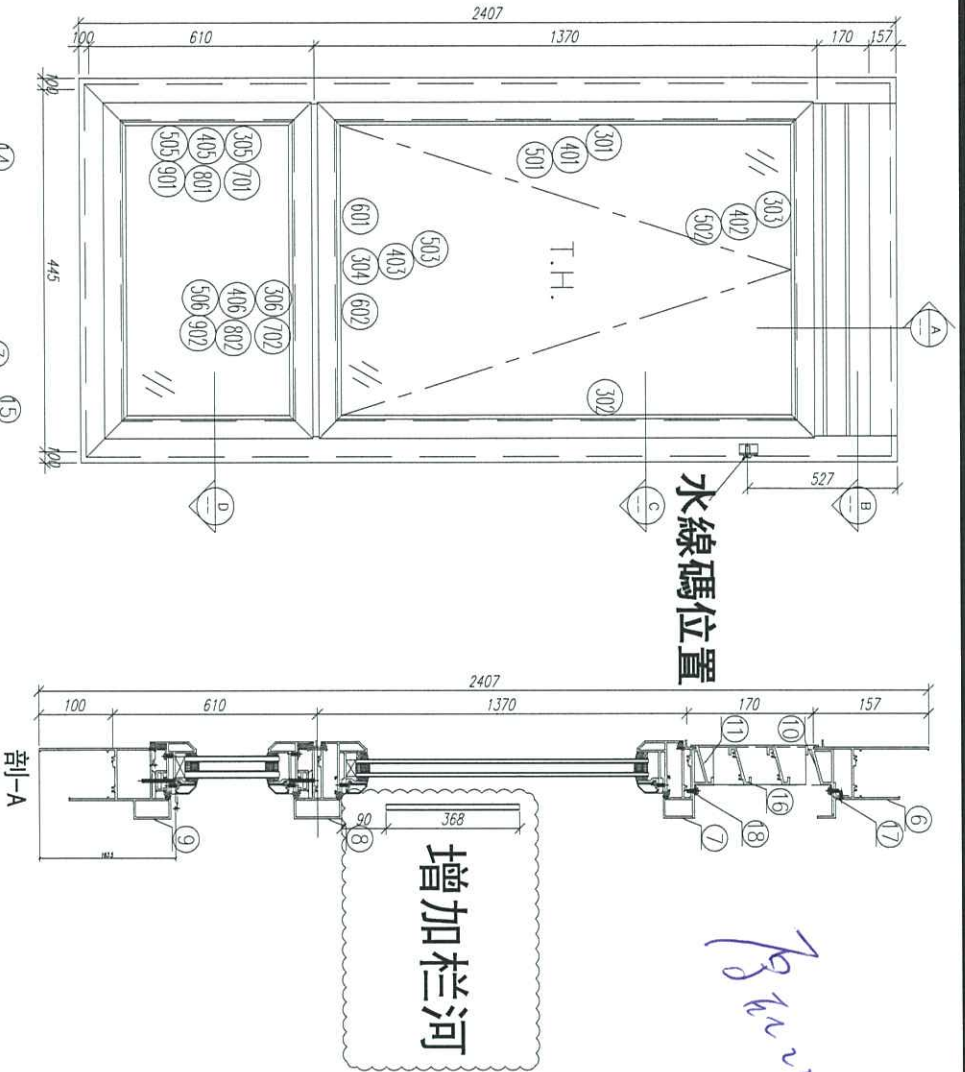

序號	材料編號	材料名稱	加工圖號	長度 L(MM)	單位	幅數	小計
1	X85759	70牛窗邊框	PM01-03	2407	支	1	3
2	X85759	70牛窗邊框	PM01-04	2407	支	1	3
3	X85764	70牛窗拍蓋	直口開料	104.5	支	2	6
4	X85764	70牛窗拍蓋	直口開料	89.5	支	2	6
5	X85764	70牛窗拍蓋	直口開料	847.5	支	2	6
6	X85764	70牛窗拍蓋	直口開料	500.5	支	2	6
7	X85775	70上生牛窗中橫	PM01-33	347	支	1	3
8	X85775	70上生牛窗中橫	PM01-34A	347	支	1	3
9	X85762	70牛窗底框	PM01-222	645	支	1	3
10	X85840	百頁窗頂	PM01-41	347	支	1	3
11	X85839	百頁窗底	PM01-42	347	支	1	3
12	20*56*10*3mm	百頁五金鉸折角	PM01-AL01	144	支	1	3
13	20*56*10*3mm	百頁五金鉸折角	PM01-AL02	144	支	1	3
14	15*1, 6mm巴	雀仔鋼線巴	PM01-44	171.5	支	2	6
15	50*5mm巴	百頁玉墊巴	PM01-43	120	支	2	6
16	X85838	百葉片	直口開料	324	支	2	6
17	20*20*3	雀仔窗頂鉸角	PM01-39	329	支	1	3
18	15*1, 6mm巴	雀仔鋼線巴	PM01-44	329	支	2	6

如下為生窗玉料

序號	材料編號	材料名稱	加工圖號	長度 L(MM)	單位	幅數	小計
301	X85767	70生窗玉企	PM03-04	1360	支	1	3
302	X85767	70生窗玉企	PM03-05	1360	支	1	3
303	X85767	70生窗玉頂	PM03-01	345	支	1	3
304	X85767	70生窗玉底/拉手	PM03-03	345	支	1	3
401	X85834	70窗玻璃夾角企	PM02-06	1235	支	2	6
402	X85834	70窗玻璃夾角頂	PM02-06	271	支	1	3
403	X85834	70窗玻璃夾角底/拉手	PM03-06	271	支	1	3
501	X85768	70窗玻璃線企	斜口開料	1255	支	2	6
502	X85768	70窗玻璃線頂	直口開料	271	支	1	3
503	X85768	70窗玻璃線底/拉手	PM03-07	271	支	1	3
601	X85824	多點鋼拉巴	PM03-8	93	支	1	3
602	X85824	多點鋼拉巴	PM03-8	75	支	1	3

如下為生窗玉料

序號	材料編號	材料名稱	加工圖號	長度 L(MM)	單位	幅數	小計
305	X85767	70生窗玉企	PM01-35	555	支	2	6
306	X85767	70生窗玉企	PM01-35	345	支	2	6
405	X85834	70窗玻璃夾角企	PM01-36	430	支	2	6
406	X85834	70窗玻璃夾角頂	PM01-36	271	支	2	6
505	X85768	70窗玻璃線企	斜口開料	450	支	2	6
506	X85768	70窗玻璃線頂	直口開料	271	支	2	6
701	X85785	生窗變壓玉扣(玉)	PM01-40	495	支	2	6
702	X85785	生窗變壓玉扣(玉)	PM01-40	285	支	2	6
801	X85786	生窗變壓玉扣(框)	PM01-37	495	支	2	6
802	X85786	生窗變壓玉扣(框)	PM01-37	285	支	2	6
901	15*13*1, 6角	擋膠角企	PM01-38	535	支	2	6
902	15*13*1, 6角	擋膠角企	PM01-38	325	支	2	6

数量: 3
 材料: 详见本图附表
 表面处理: UCT1806812XL-3
 制图: 郭上平
 日期: 2020.08.05
 校核: WSH
 审核:
 Rev: A

工程名称: 亞皆老街 / 佛沙質 (M020)
 图名: W4/T18組裝圖
 图号: W4/T18




美特鋁質有限公司
 MTD Aluminum Fabricator Ltd.

5-211



頂

窗號	L	數量 (支)	備註
W4/T1A	2407	3	不銑水線碼孔
W5/T1A	2407	3	銑水線碼孔
W4/T1B	2407	3	不銑水線碼孔
W5/T1B	2407	3	銑水線碼孔
合計:		12	

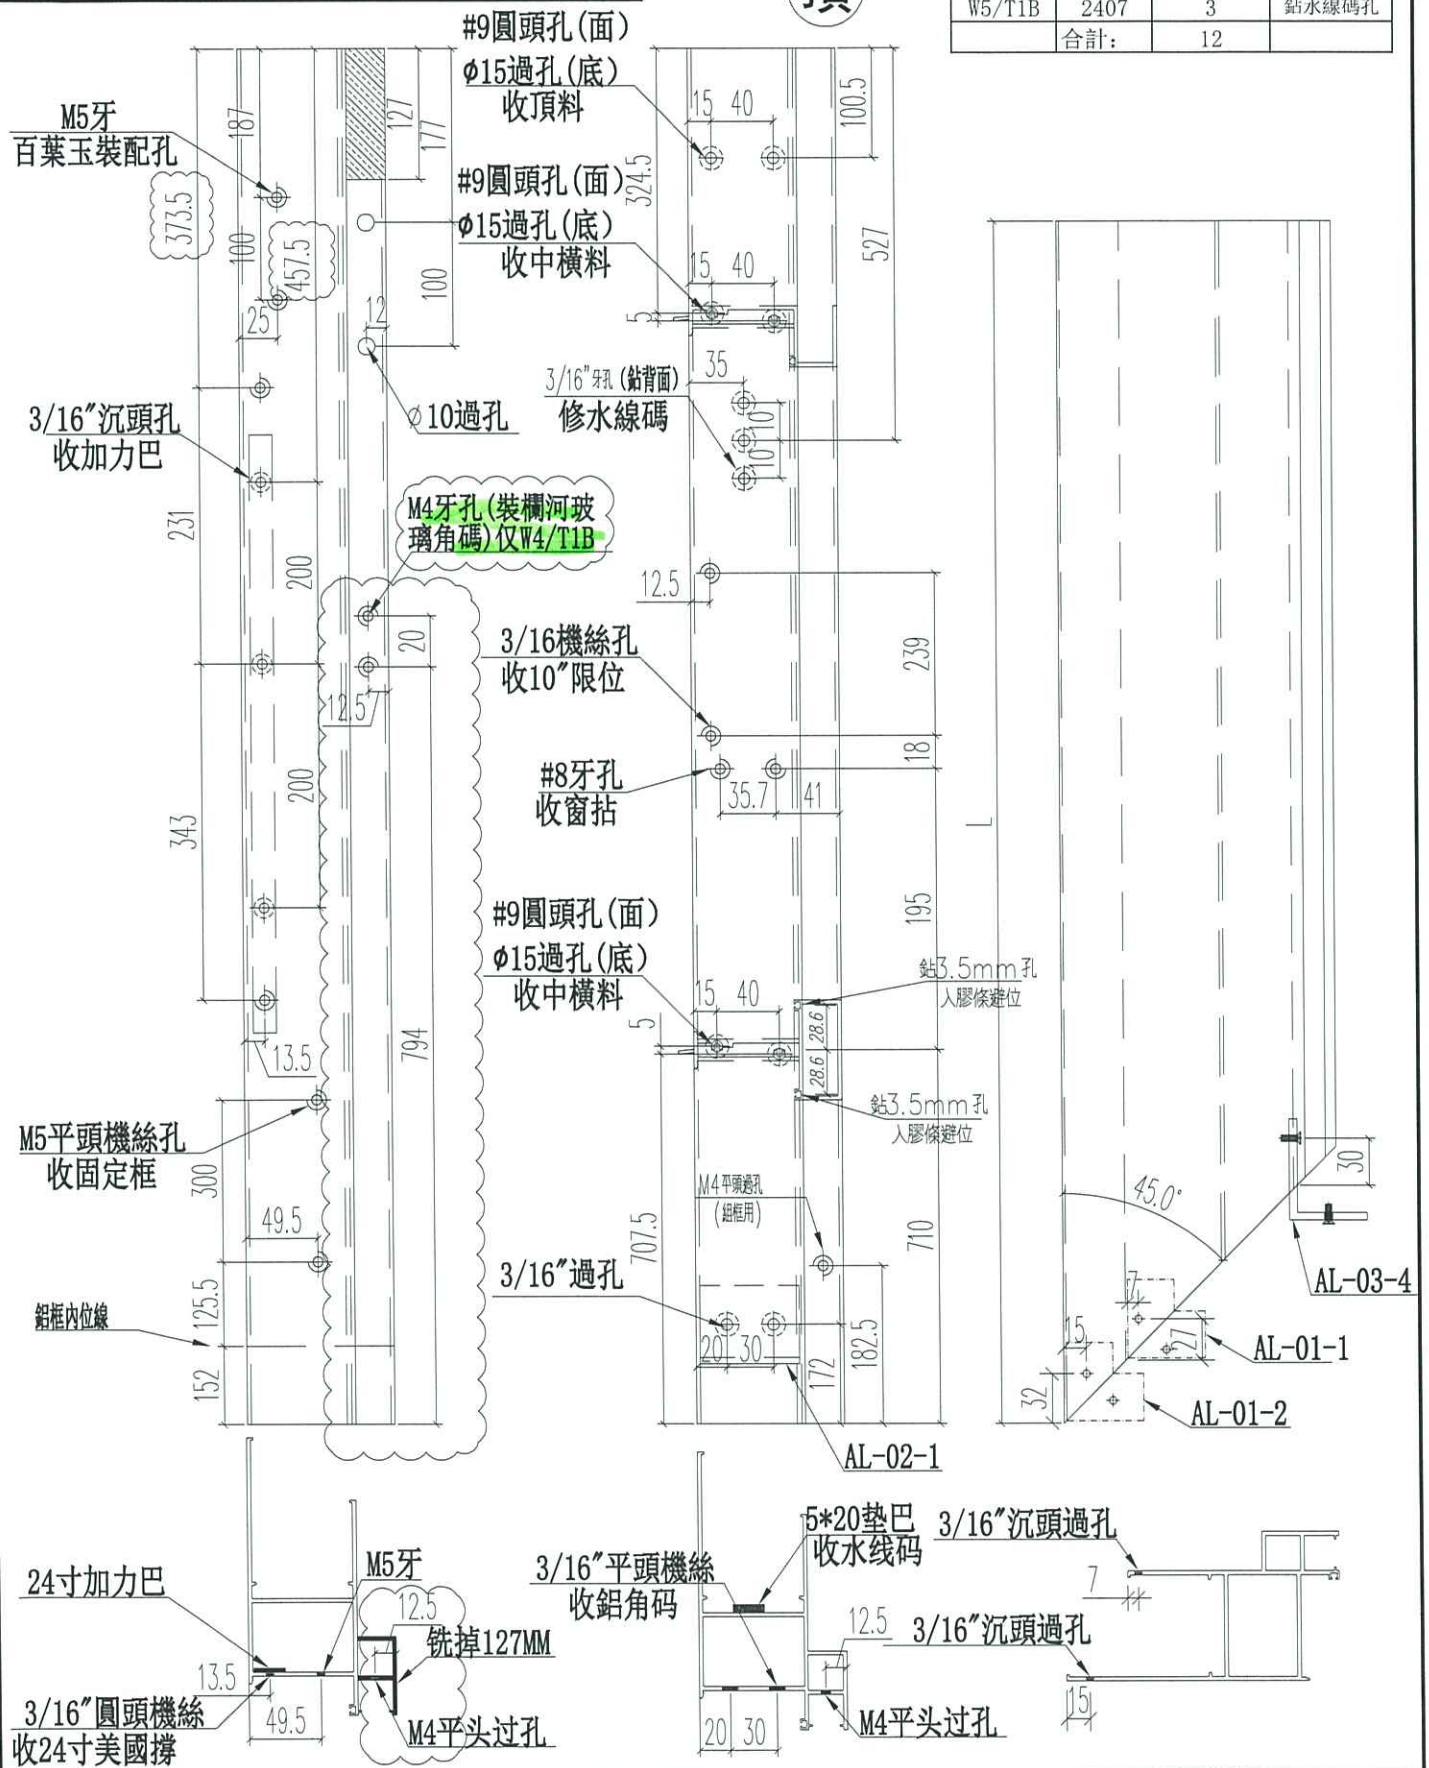


名稱	70生窗邊框	制圖	JASON	2020.06.22	修改	A	B
材料	X85759	復核	WHS		日期	2020.08.21	2020.09.16
顏色	UCT806812XL-3	批准			圖號	PW01-03	



工程號 J852 地盤 亞皆老街

窗號	L	數量 (支)	備註
W4/T1A	2407	3	鉗水線碼孔
W5/T1A	2407	3	不鉗水線碼孔
W4/T1B	2407	3	鉗水線碼孔
W5/T1B	2407	3	不鉗水線碼孔
合計:		12	

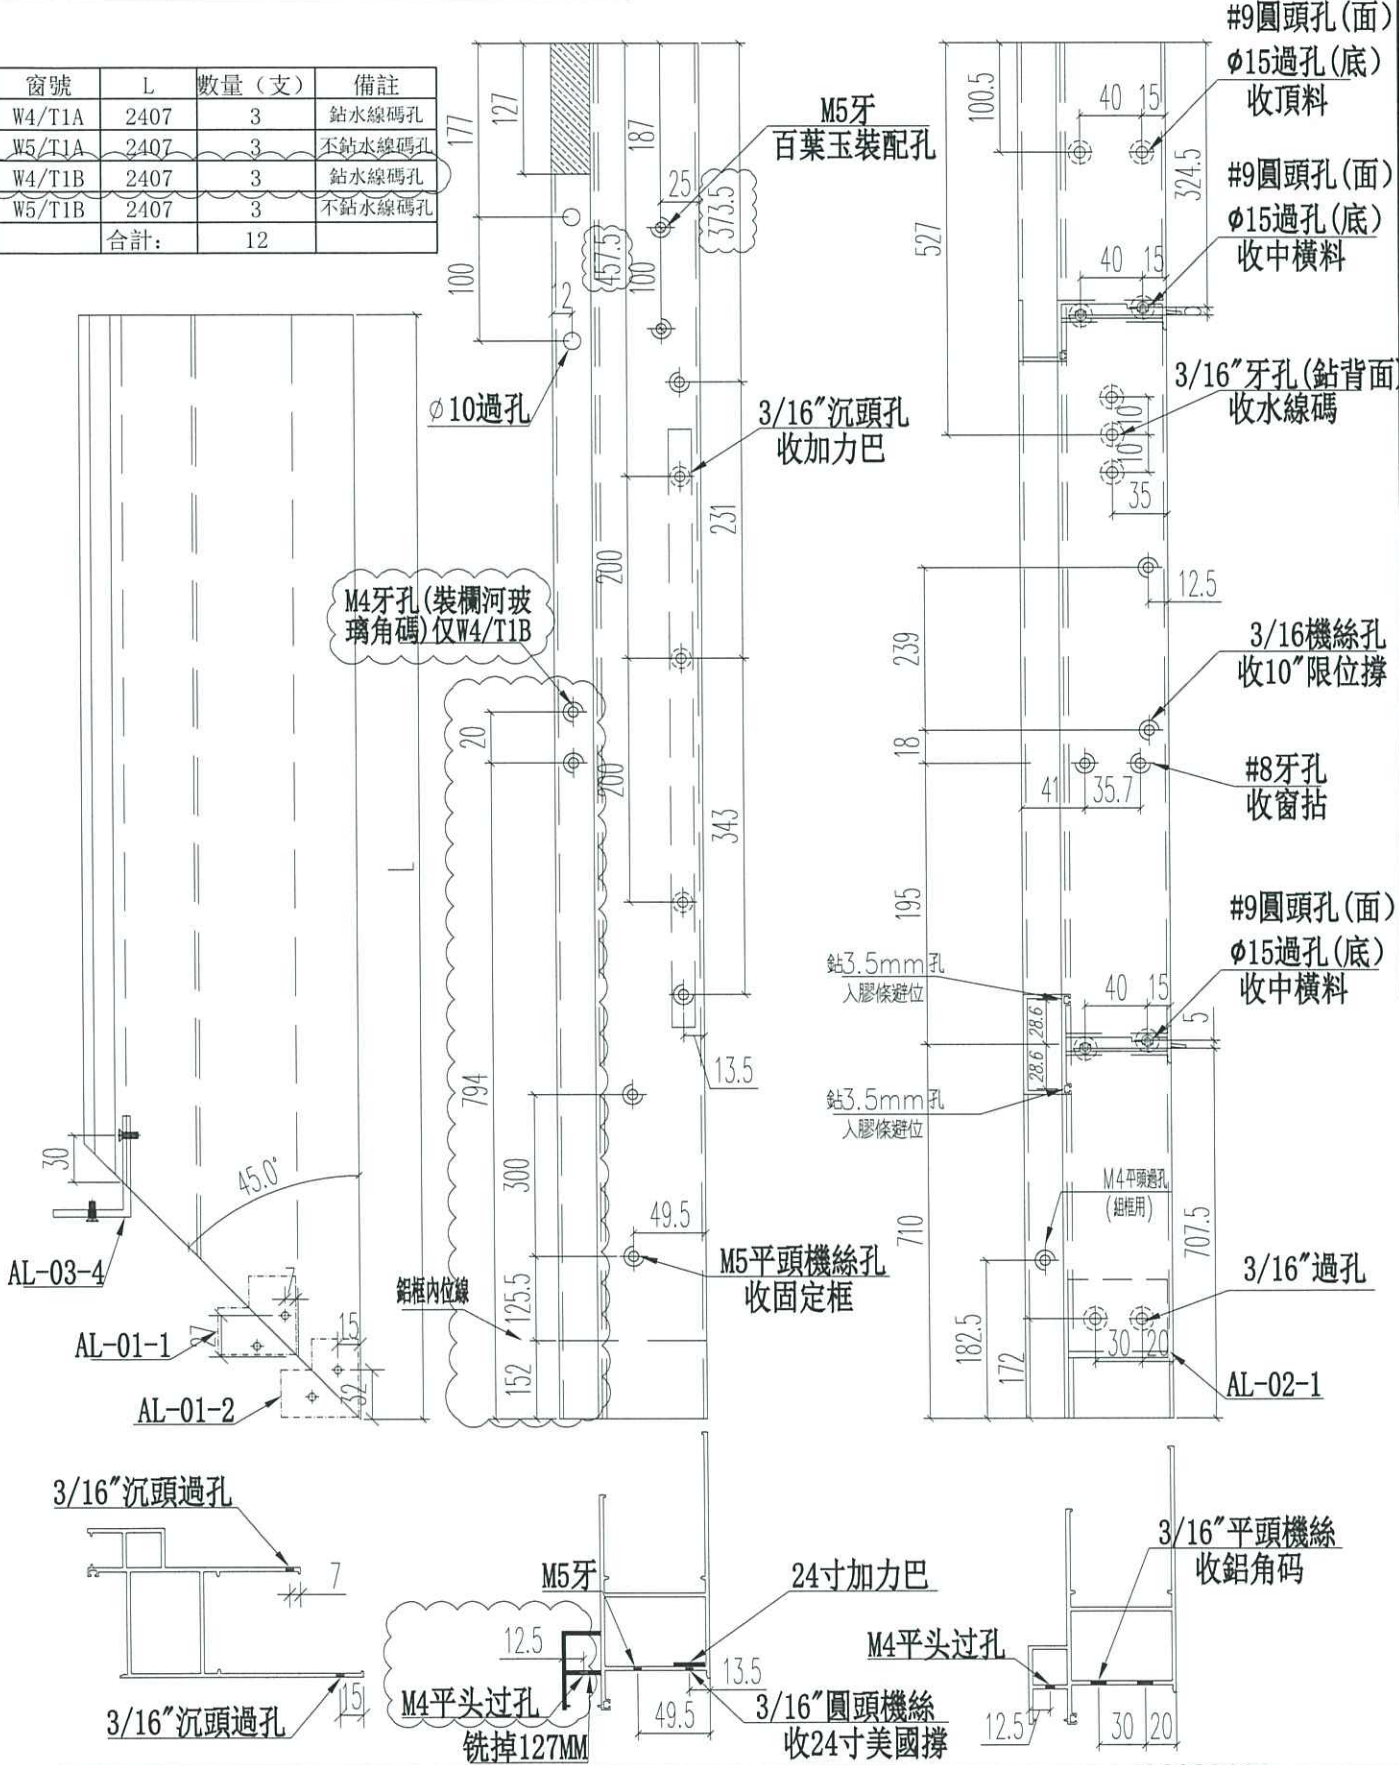

名稱	70生窗邊框	制圖	JASON	2020.06.22	修改	A	B
材料	X85759	復核	WHS		日期	2020.08.21	2020.09.16
顏色	UCT806812XL-3	批准			圖號	PW01-04	



J3860 - Proposed Residential Development,
At 139 - 147 Argyle Street, Kowloon
For record purpose only
All works should be instructed by A.I.

CONFIRMATION LETTER

To : Ms Grace Cheng / Mr Raymond Ho
AGC Design Limited
Room 1601, Olympia Plaza,
255 King's Road, North Point,
Hong Kong

No. CL/A/109 (Rev. 0)

Ref. J3860/304.1/D05683

Date: 24 August 2020

REQUIRED APPROVAL DATE: 7 September 2020

Subject Description: Additional Glass barrier inside Master Bathrooms of Unit A, B of Tower 2, Unit B of T1 and T3 on Typical Floors; Master Bathrooms of Unit A, B of Tower 2 on 22/F; Ensuite Bathroom 3 of Unit A of Tower 2 on 23/F

We confirm the following verbal / written instruction(s) given by Mr Billy Tang of Pacific Shine and Mr Raymond Ho of AGC on 31 July 2020 to our Mr Jackson Mok and Ms Penny Chau which are being complied with.

Please refer to attached self-explanatory e-mail correspondences and marked up drawings for your confirmation.

Implication:	
<input type="checkbox"/> Time Description:	J J 2
<input checked="" type="checkbox"/> Cost Description: To be advised	
<input type="checkbox"/> Abortive Works Description:	

Hung 43

2020.8.29

到/房/厨/窗/台/浴室/加/欄/河/玻璃

→ 改 Shop Draw

→ 改 拆 圍

4/8



J3860 - Proposed Residential Development,
At 139 – 147 Argyle Street, Kowloon
For record purpose only
All works should be instructed by A.I.

CONFIRMATION LETTER

To : Ms Grace Cheng / Mr Raymond Ho
AGC Design Limited
Room 1601, Olympia Plaza,
255 King's Road, North Point,
Hong Kong

No. CL/A/109 (Rev. 0)
Ref. J3860/304.1/D05683

Date: 24 August 2020

REQUIRED APPROVAL DATE: 7 September 2020

Yours faithfully
For and on behalf of
Gammon Engineering &
Construction Company Limited


Dick Yuen
Senior Project Manager

DY/MS/wym

Encl

Consultant's Response: [] Time Implication
[] Cost Implication

Comments:

Confirmed

by: Date:

- | | | | |
|----|-------------------------------------|---------------|---|
| cc | <input checked="" type="checkbox"/> | Pacific Shine | - Mr Billy Tang / Mr Kocher Wong / Mr Edwin Chow / Mr Simon Chung / Mr Ross Pau / Mr Ken Ng / Mr Wyman Fong / Mr Jimmy Cheung / Mr C F Lee / Mr Peter Chong |
| | <input type="checkbox"/> | ARUP (Stru) | - Mr Johnson Po / Mr Don Ho / Ms Jessy Zhang |
| | <input checked="" type="checkbox"/> | W&O | - Mr Nier Chan / Mr Anson Lau |
| | <input checked="" type="checkbox"/> | Arcadis | - Ms Brenda Mok / Ms Emily Chu |
| | <input checked="" type="checkbox"/> | AXXA | - Ms Siuman Hung / Ms Sammy Tang / Mr Oscar Leung / Ms Yvonne Yau |
| | <input checked="" type="checkbox"/> | MFT | - Mr Brian Leung / Ms Yoanna Chan / Mr Nigel Lo |
| | <input type="checkbox"/> | WSP | - Ms Anthea Ng / Mr Dennis Tse |
| | <input type="checkbox"/> | RE | - Mr Andrew Tai / Mr Yang Li / Mr Oscar Tam |
| | <input checked="" type="checkbox"/> | OSR | - Mr K M Pang / Mr H T Tseung / Mr Poon Tsz Kit / Mr S T Chan / Mr Ben Li |
| | <input type="checkbox"/> | BSI (Sino) | - Mr Kelvin Tam |
| | <input type="checkbox"/> | RBSE (W&O) | - Mr Kevin Lee |
| | <input checked="" type="checkbox"/> | GECCL | - DY / QS / Setting Out |
| | <input checked="" type="checkbox"/> | S/C | - Midi / Sundart (By E-mail) |

**Remarks: w/encl. w/o encl.
(Page 2 of 10)

Jackson Chor Chiu Mok

From: midi@midiltd.com.hk
Sent: 06 August, 2020 3:45 PM
To: Jackson Chor Chiu Mok; Billy Tang (Development)
Cc: Marco Tam; bessie.lps.midi@gmail.com; Jimmy Cheung Ngai Hang; Peter Chong; J554 AGC; Raymond Ho (raymondho@agcdesign.com.hk); Eliot Chan (eliotchan@agcdesign.com.hk); brian.leung@mfacade.com; Nigel Lo; terence@motysdesign.com.hk; ringo@motysdesign.com.hk; Yoanna Chan; Man Dick Yuen; Chris Ching Wa Kwok; Penny Pui Ying Chau
Subject: [E] Re: CLP - Precast Windows - Additional glass barrier for Master Bathrooms

This email is from **EXTERNAL** - be cautious with any link and attachment

Dear Billy Gor / Jackson,

It is feasible to add glass barrier for master bathroom at T1B, T2A, T2B and T3B. Please issue A.I. to cover the additional works for confirmation. Moreover, as precast windows for master bathroom at T2A, T2B and T3B (1/F to 3/F) were delivered to facade factory, please note that these windows would be rectified at site.

Regards,
Bessie

From: "Billy Tang (Development)" <billytang@sino.com>
To: Jackson Chor Chiu Mok <Jackson.Mok@gammonconstruction.com>, "midi@midiltd.com.hk" <midi@midiltd.com.hk>
Copies to: Marco Tam <marcotam@midiltd.com.hk>, "bessie.lps.midi@gmail.com" <bessie.lps.midi@gmail.com>, Jimmy Cheung Ngai Hang <jimmynhcheung@sino.com>, Peter Chong <peterchong@sino.com>, J554 AGC <j554@agcdesign.com.hk>, "Raymond Ho (raymondho@agcdesign.com.hk)" <raymondho@agcdesign.com.hk>, "Eliot Chan (eliotchan@agcdesign.com.hk)" <eliotchan@agcdesign.com.hk>, "brian.leung@mfacade.com" <brian.leung@mfacade.com>, Nigel Lo <nigel.lo@mfacade.com>, "terence@motysdesign.com.hk" <terence@motysdesign.com.hk>, "ringo@motysdesign.com.hk" <ringo@motysdesign.com.hk>, Yoanna Chan <yoanna.chan@mfacade.com>, "Man Dick Yuen" <ManDick.Yuen@gammonconstruction.com>, Chris Ching Wa Kwok <Chris.Kwok@gammonconstruction.com>, Penny Pui Ying Chau <Penny.Chau@gammonconstruction.com>
Subject: Re: CLP - Precast Windows - Additional glass barrier for Master Bathrooms
Date sent: Fri, 31 Jul 2020 08:21:03 +0000

Dear Marco

Please check feasibility .

BT

Get [Outlook for iOS](#)

From: Jackson Chor Chiu Mok <Jackson.Mok@gammonconstruction.com>
Sent: Friday, July 31, 2020 4:13:21 PM
To: midi@midiltd.com.hk <midi@midiltd.com.hk>
Cc: Marco Tam <marcotam@midiltd.com.hk>; bessie.lps.midi@gmail.com <bessie.lps.midi@gmail.com>; Billy Tang (Development) <billytang@sino.com>; Jimmy Cheung Ngai Hang <jimmynhcheung@sino.com>; Peter Chong <peterchong@sino.com>; J554 AGC <j554@agcdesign.com.hk>; Raymond Ho (raymondho@agcdesign.com.hk) <raymondho@agcdesign.com.hk>; Eliot Chan (eliotchan@agcdesign.com.hk) <eliotchan@agcdesign.com.hk>; brian.leung@mfacade.com <brian.leung@mfacade.com>; Nigel Lo <nigel.lo@mfacade.com>; terence@motysdesign.com.hk <terence@motysdesign.com.hk>; ringo@motysdesign.com.hk <ringo@motysdesign.com.hk>; Yoanna Chan <yoanna.chan@mfacade.com>; Man Dick Yuen <ManDick.Yuen@gammonconstruction.com>; Chris Ching Wa Kwok <Chris.Kwok@gammonconstruction.com>; Penny Pui Ying Chau <Penny.Chau@gammonconstruction.com>
Subject: RE: CLP - Precast Windows - Additional glass barrier for Master Bathrooms

Re-sent to include Moty.

?

From: Jackson Chor Chiu Mok
Sent: 31 July, 2020 4:11 PM
To: midi@midiltd.com.hk
Cc: Marco Tam <marcotam@midiltd.com.hk>; bessie.lps.midi@gmail.com; 'Billy Tang (Development)' <billytang@sino.com>; 'Jimmy Cheung Ngai Hang' <jimmynhcheung@sino.com>; Peter Chong <peterchong@sino.com>; 'j554@agcdesign.com.hk' <j554@agcdesign.com.hk>; 'Raymond Ho (raymondho@agcdesign.com.hk)' <raymondho@agcdesign.com.hk>; 'Eliot Chan (eliotchan@agcdesign.com.hk)' <eliotchan@agcdesign.com.hk>; brian.leung@mfacade.com; nigel.lo@mfacade.com; Yoanna Chan <yoanna.chan@mfacade.com>; Man Dick Yuen <ManDick.Yuen@gammonconstruction.com>; Chris Ching Wa Kwok <Chris.Kwok@gammonconstruction.com>; Penny Pui Ying Chau <Penny.Chau@gammonconstruction.com>
Subject: CLP - Precast Windows - Additional glass barrier for Master Bathrooms

Dear Michael (Midi),

?

Further to our discussion just now, please advise if it is technically feasible to add an additional glass barrier as per attached sketch as per Pacific Shine (Sino)'s request during timber mock up visit this morning.

?

The additional glass barrier shall be applied to T1B, T2A, T2B and T3B on typical floors.

?

Thanks.

?

Dear AGC/ Moty,

?

Please feel free to supplement and comment on the sketch.


?

Best Regards,

Jackson

[Legal Disclaimer](#)


This email (and any attachments) is confidential and subject to copyright. It may be subject to legal or other professional privilege. It is intended for use by the addressee(s) only and if you have received it in error, please notify the sender immediately by return email and delete it from your system. Any personal data in this email must be handled in accordance with applicable privacy laws.

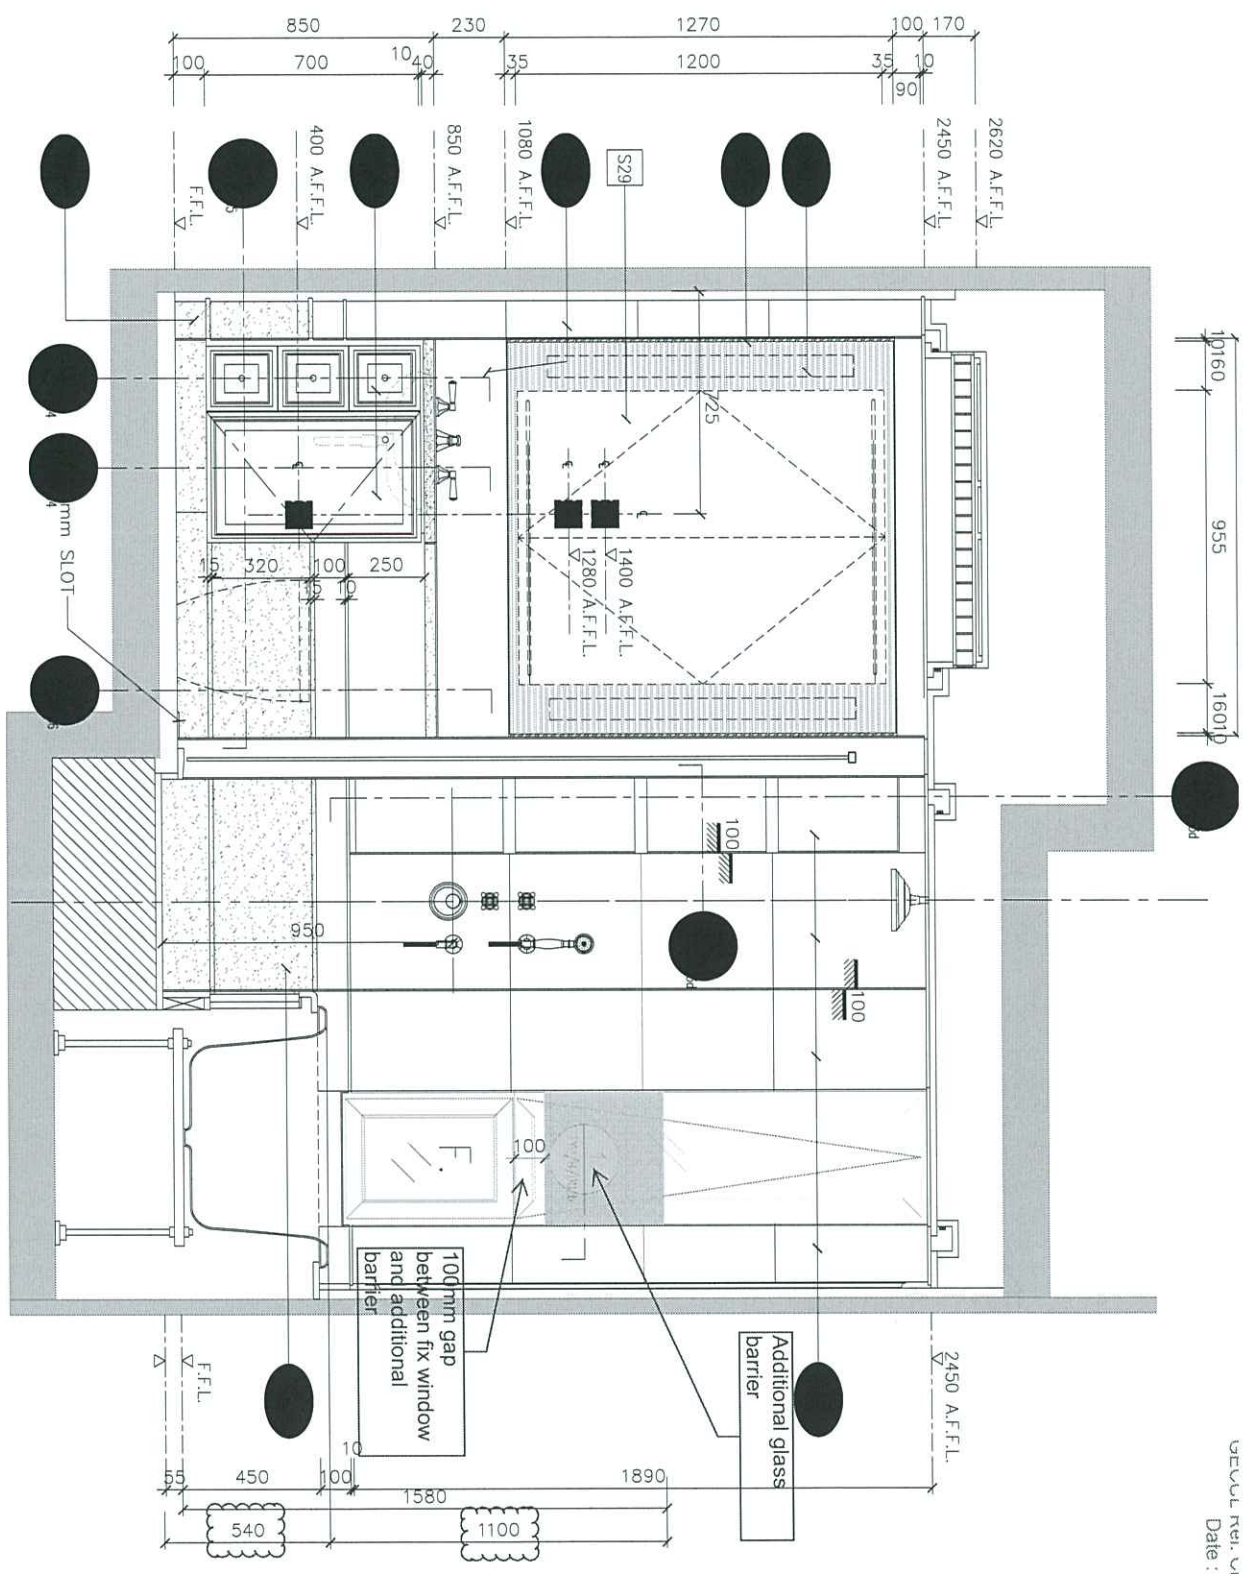

**ELEVATION OF
T3B (SHOULD
BE HANDED)**

A ELEVATION
SCALE 1: 20


Additional glass barrier to aluminium windows

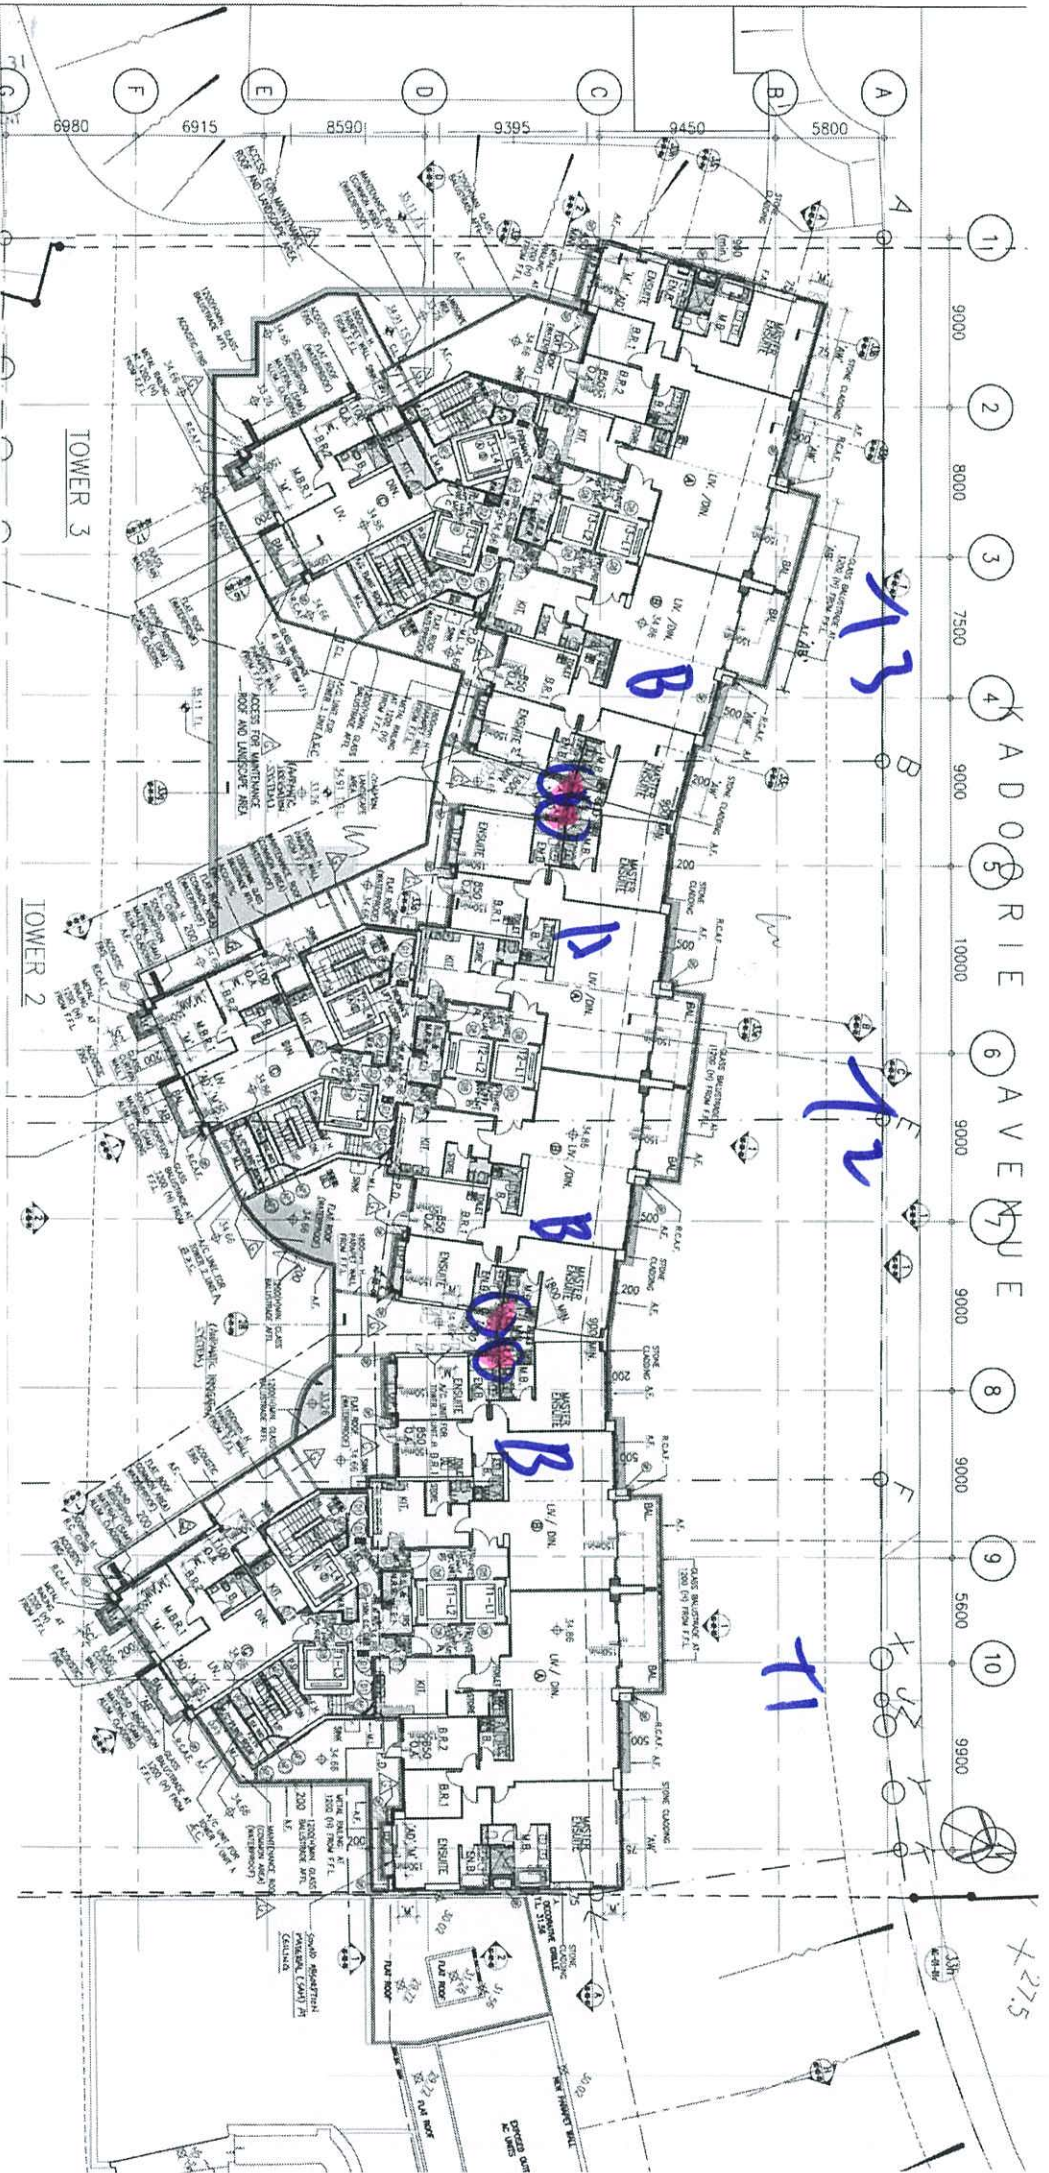

1/F Plan

Additional glass barrier to aluminium windows

DATE: 21 AUGUST 2020

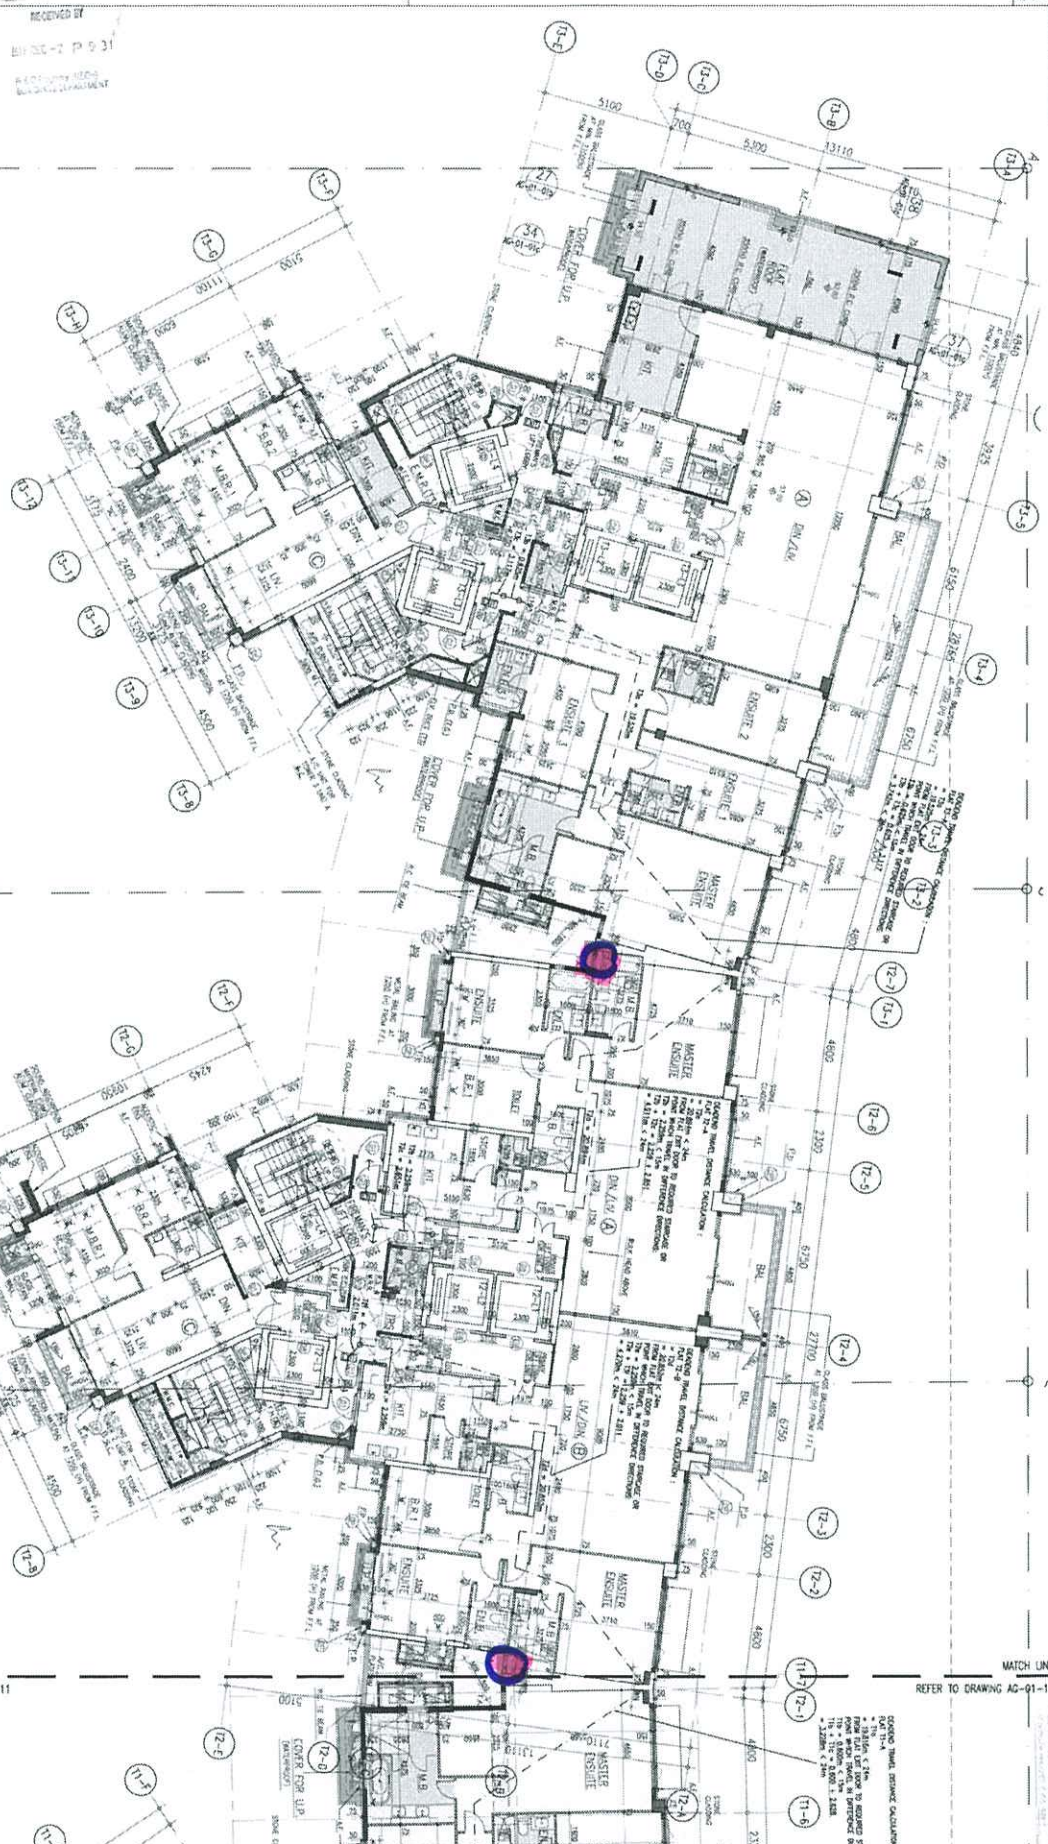

22/F Plan

TOWER 3

TOWER 2

22/F PLAN FOR TOWER 2 & TOWER 3

SCALE: 1:100

THE WORK SHOWN ON THESE PLANS ARE THE PROPERTY OF AGC DESIGN LTD. ANY REUSE OR MODIFICATION OF THESE PLANS WITHOUT THE WRITTEN PERMISSION OF AGC DESIGN LTD. IS STRICTLY PROHIBITED. THE CLIENT ACCEPTS FULL RESPONSIBILITY FOR THE ACCURACY OF THE INFORMATION PROVIDED TO AGC DESIGN LTD. AND THE CLIENT'S OBLIGATION TO PROVIDE ALL NECESSARY INFORMATION TO AGC DESIGN LTD. IN A TIMELY MANNER.

MATCH LINE
REFER TO DRAWING AG-01-11

MATCH LINE
REFER TO DRAWING AG-01-11

AGC DESIGN LTD

PROPOSED RESIDENTIAL DEVELOPMENT
AT 139-147 ARDLE STREET,
KOWLOON INLAND LOT NOS. 6035,
6035 R.P., 6036 R.P., 6037 R.P.
& 6038 R.P.

AMENDED PLAN 22/F B/C 2019

BD

WONG YU-PAN
Senior Building Surveyor
FOR BUILDING AUTHORITY
30 DEC 2019


Mark Cheung

Change Year/Very Close
Approved Building
Listed Building

NO.	DESCRIPTION	DATE	BY	CHECKED
1	3D/3D-REVISION	2019/12/24/11	DC	
2	3D/3D-REVISION	2019/12/24/11	DC	
3	3D/3D-REVISION	2019/12/24/11	DC	
Additional glass barrier to aluminium windows

DATE: 24 AUGUST 2020

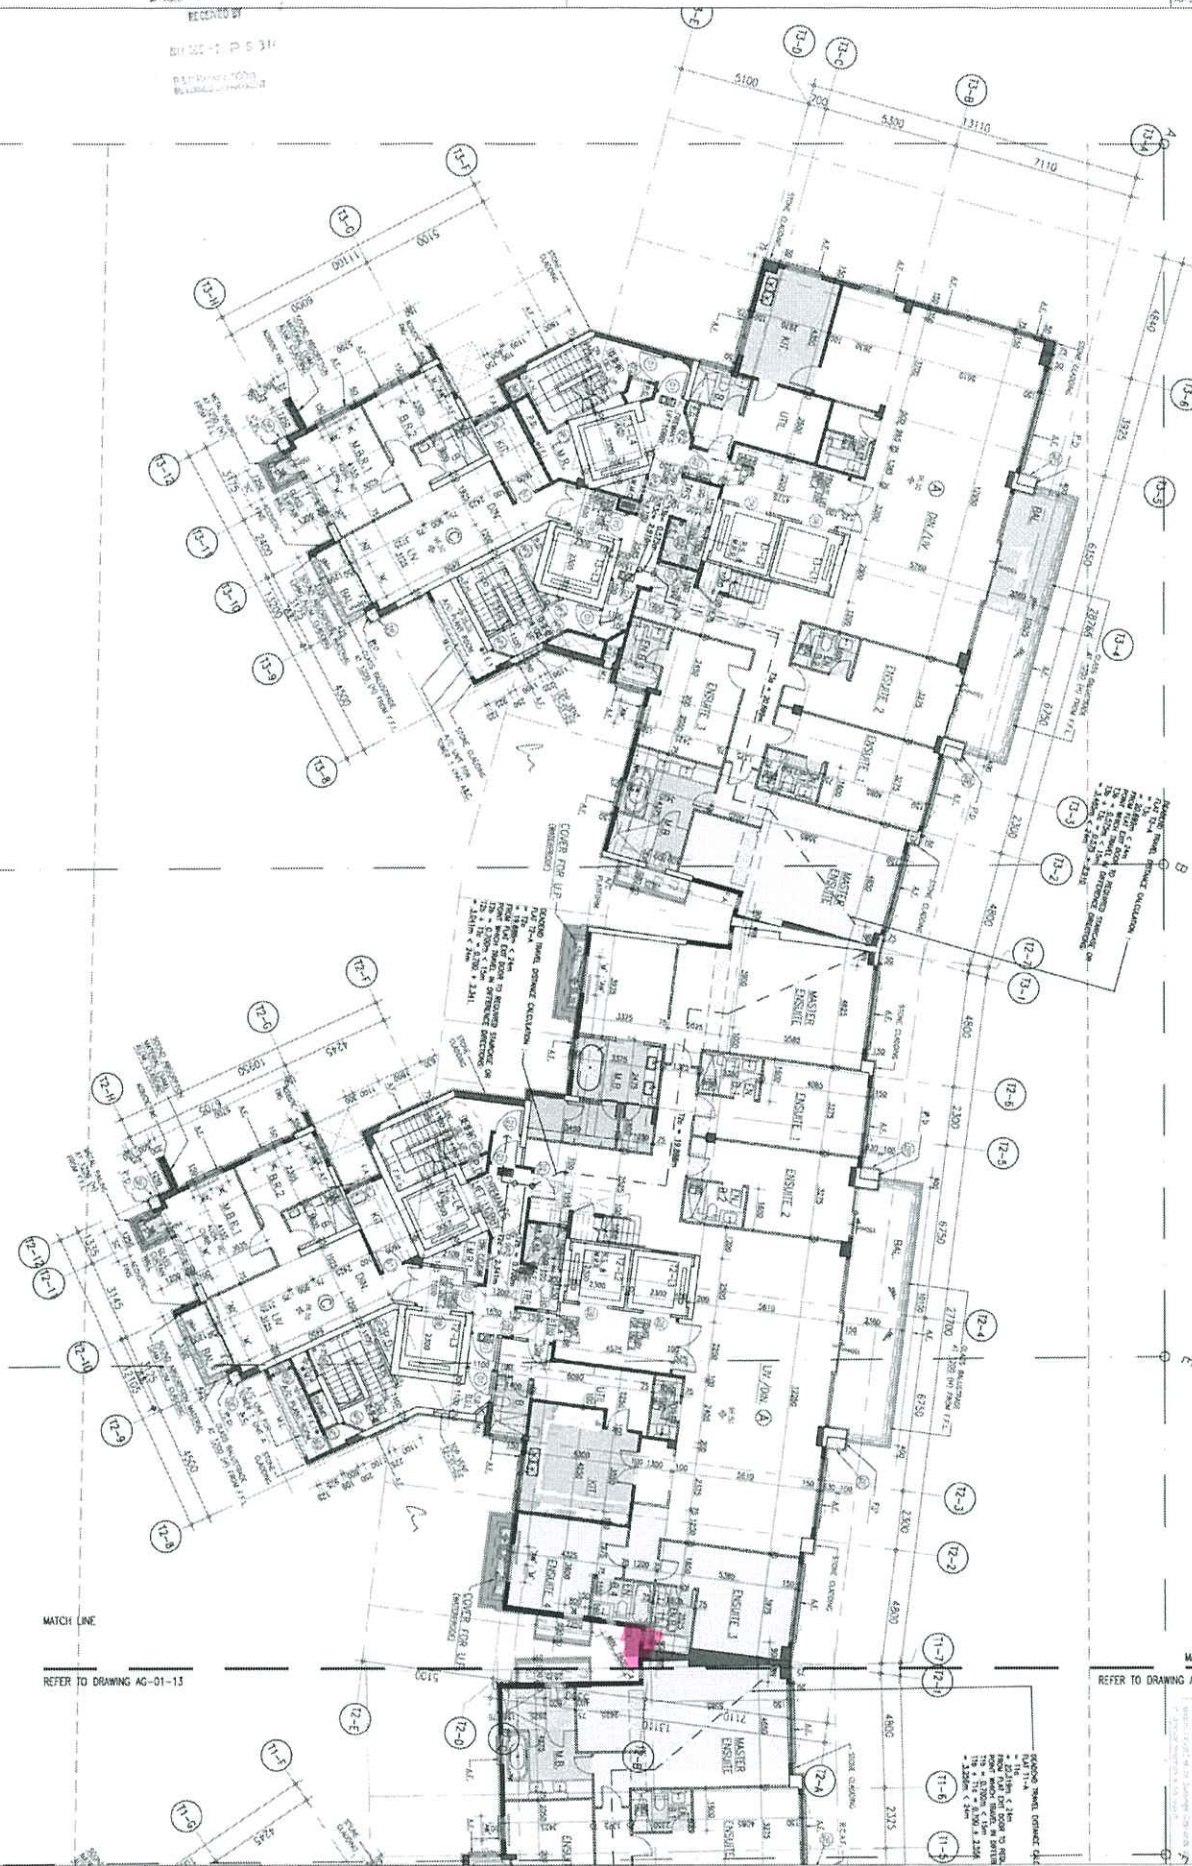

23/F Plan

TOWER 3

TOWER 2 & TOWER 3

TOWER 2

MATCH LINE
REFER TO DRAWING AG-01-13

MATCH LINE
REFER TO DRAWING AG-01-13

LEGEND

- PREFER FLOOR
- MAX 300mm STAINLESS STEEL
- COMMON ACCESS ROADS FOR MAINTENANCE WORKS ONLY
- ACCEDE BRACKET
- ACCEDE DOOR FRAME FIBRE
- ACCEDE WINDOW
- FINE GRATE FOR WINDOW
- FINE GRATE FOR WINDOW
- SA SOUND ABSORBENT MATERIAL
- O.A. WINDOW SCREEN AREA
- A.E. INTERIOR FINISH

WONG YAM YAN
Senior Building Surveyor
FOR BUILDING AUTHORITY
30 DEC 2019

Wong Yam Yan

AMENDED PLAN

NO.	REVISION	DATE
1	AS PER SUBMISSION	19/07/2019
2	MAJOR AMENDMENT	19/07/2019
3	MINOR AMENDMENT	19/07/2019
4	MINOR AMENDMENT	19/07/2019
5	MINOR AMENDMENT	19/07/2019
6	MINOR AMENDMENT	19/07/2019
7	MINOR AMENDMENT	19/07/2019
8	MINOR AMENDMENT	19/07/2019
9	MINOR AMENDMENT	19/07/2019
10	MINOR AMENDMENT	19/07/2019

AGC DESIGN LTD

PROPOSED RESIDENTIAL DEVELOPMENT
AT 139-147 ARGYLE STREET,
KOWLOON INLAND LOT NO. 6005,
6035 R.P., 6036 R.P., 6037 R.P.
& 6038 R.P.

23th FLOOR PLAN
(SHEET 1)

Page 10 of 10