

工程指示 / 要求簡箋(E.I.)

工程指示編號：EI / 2569 / 20

修改版次：-

工程編號：J - 852

工程名稱：亞皆老街中電

工程項目：鋁飾線 模圖批核 (3 個) X85922-X85924

收件人：Maggie Lor / 生統 / 王良

發件人：Ant Yeung

日期：14/10/2020

要求提供 / 確認 事項：

- | | | |
|------------------------------------|-------------------------------------|-------------------------------|
| <input type="checkbox"/> 初步鋁料 B.M. | <input type="checkbox"/> 加工拆圖，然後生產 | <input type="checkbox"/> 尺寸表 |
| <input type="checkbox"/> 正式鋁料 B.M. | <input type="checkbox"/> 技術上資料 / 指示 | <input type="checkbox"/> 報價 |
| <input type="checkbox"/> 配件 B.M. | <input type="checkbox"/> 樣辦或貨品說明書 | <input type="checkbox"/> 分判合約 |

請按加工圖生產鋁模給鋁飾線用。

X85922，X85923，X85924

請在 2020.11.14 前完成上列要求。

附：3 張模圖 + CAD

原合約工程包

原合約工程加 / 減賬

新工程報價

原因：-

分發東莞各部門：

- () 生產技術總監 連附件 () 技術部 連附件 () 生產部 連附件 () 機械設計部 連附件
 () 採購部 連附件 () 生產統籌部 連附件
 () 質檢部 連附件 () 會計部 連附件 () 報關組 連附件 () 其他 _____ 連附件
 其他分判 (水洪) 連附件

分發香港各部門：

- () 行政部 連附件 () 會計部 連附件 () 統籌部 連附件 () 工程部地盤科文 連附件
 () 採購部 連附件 () QS 部 連附件 () 維修部 連附件 () 其他 _____ 連附件

傳遞編號：

HK 2348 / 20


發件人簽署：

項目經理簽署：

Aluminium Die for J852 Cladding

Item	Die no. (midi)	Die no. ()	Member no.	Grade	畫模圖 EI-2504				開模 EI 2569				Remark		
					0	A	B	C	D	0	A	B		C	D
1	X85921	LH0091566	AL-47	6063 T6	1	1					0				
2	X85922	LH0091567	AL-48	6063 T6	1	1					1				
3	X85923	LH0091568	AL-49	6063 T6	1						1				
4	X85924	LH0091569	AL-50	6063 T6	1						1				

CUSTOMER	HONGKONG CO.	CUSTOMER APPROVAL	CUST PART NO.	X85922
			SECTION NO.	LH0091567

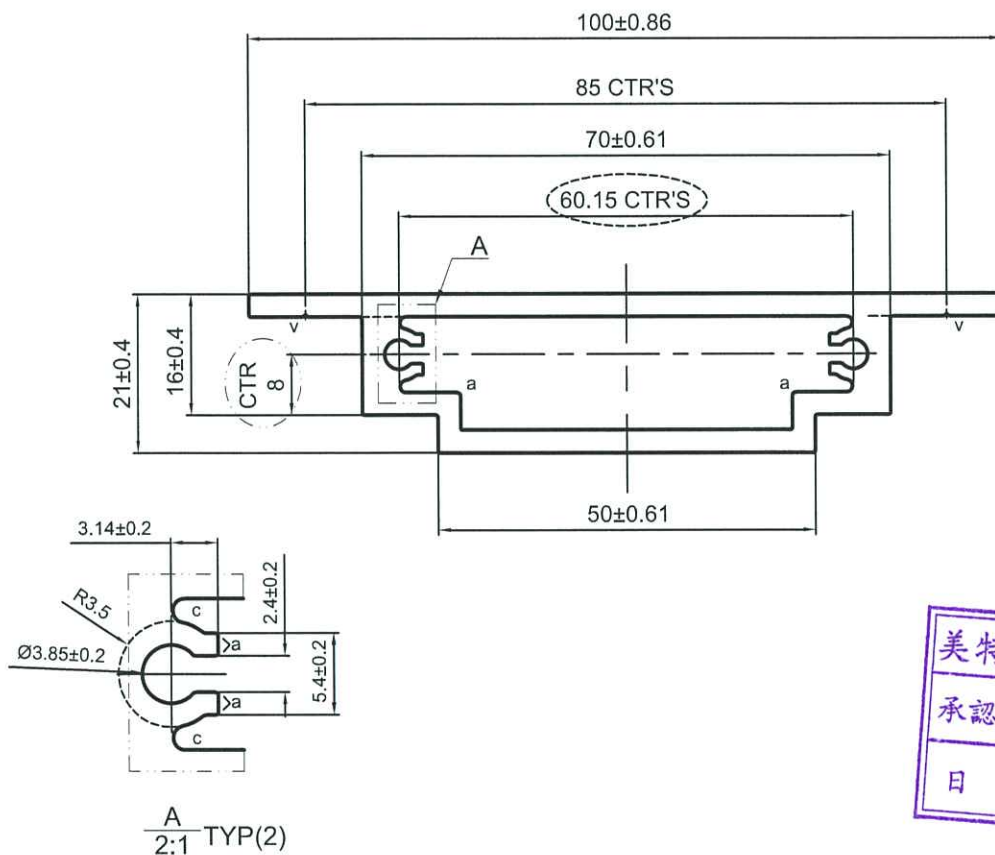

美特鋁質有限公司
承認圖面
日期 14-10-20



v=0.3X90°

a=R0.2 b=R0.5 c=R0.8

----- 次要裝飾面，噴塗膜厚不足，但不露底

----- 裝飾面



备注：没有配合型号！

V.F
SCALE 1:1

SIGNATURE GRADEING	HIGH SIGNATURE GRADEING	C.C.DIA(MM)	Ø 100.03		噴塗收費周長(mm):		144.54	
AREA (SQ MM)	648.79	UNSPECIFIED THICKNESS	3±0.25	PERIMETER (MM)	240.90	STANDARD	BS EN755	SCALE 1:1
MASS (KG/M)	1.758	UNSPECIFIED CORNERS	R 0.3	SURFACE AREA	141.50	ALLOY	6063-T6	VERSION B
COMPANY ISSUE	A	DRAWA	蔡曉婷	DATE	2020-10-12	APELLATION	-	PAGE OF
		STANDA-RDIZATION		DATE				
		TO SIGN	王添明	DATE				
		AUDITING		DATE				
MARKER	MODIFY	FILE NO	SIGNATURE	DATE	APPROV			

 PANASIA ALUMINUM (CHINA) LIMITED

CUSTOMER	HONGKONG CO.	CUSTOMER APPROVAL	CUST PART NO.	X85923
			SECTION NO.	LH0091568

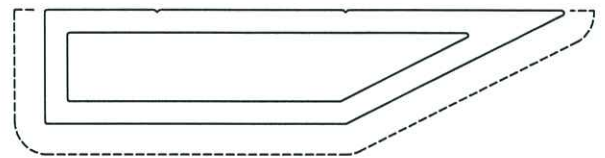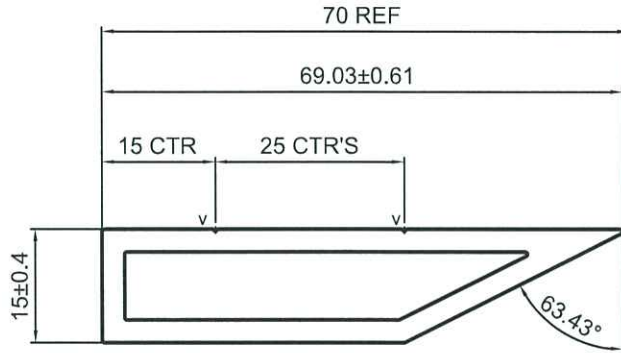

v=0.3X90°

备注：没有配合型号！

V.F


SCALE 1:1

SIGNATURE GRADEING	HIGH SIGNATURE GRADEING	C.C.DIA(MM)	Ø 70.53					喷涂收费周长(mm):	94.19
AREA (SQ MM)	417.19	UNSPECIFIED THICKNESS	3±0.25	PERIMETER (MM)	156.99	STANDARD	BS EN755	SCALE	1:1
MASS (KG/M)	1.131	UNSPECIFIED CORNERS	R 0.3	SURFACE AREA	88.11	ALLOY	6063-T6	VERSION	A
COMPANY ISSUE		A	DRAWA	蔡晓婷	DATE	2020-09-28	APELLATION	-	PAGE OF
			STANDA-RDIZATION		DATE				
			TO SIGN	王添明	DATE				
			AUDITING		DATE				
MARKER	MODIFY	FILE NO	SIGNATURE	DATE	APPROV				




PANASIA ALUMINUM (CHINA) LIMITED

CUSTOMER	HONGKONG CO.	CUSTOMER APPROVAL	CUST PART NO.	X85924
			SECTION NO.	LH0091569

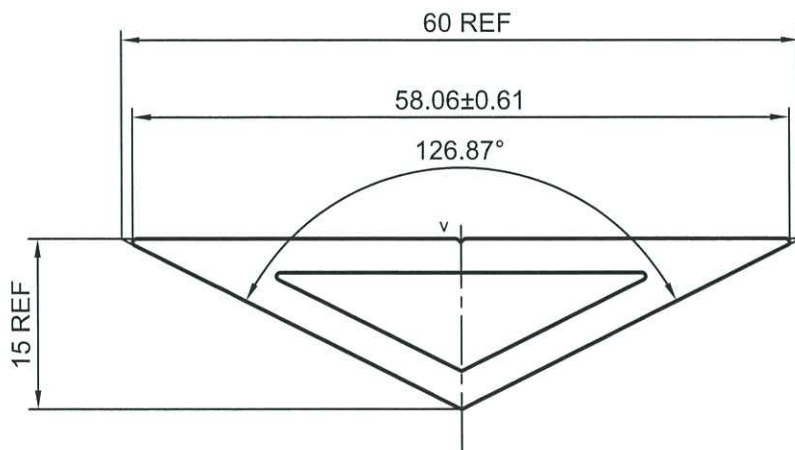

美特鋁質有限公司
承認圖面
日期 14-10-20

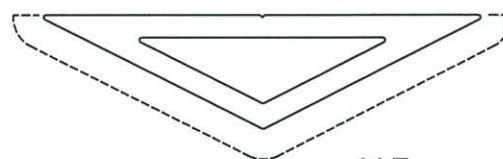

V.F

SCALE 1:1

v=0.3X90°


备注：没有配合型号！

SIGNATURE GRADEING	HIGH SIGNATURE GRADEING	C.C.DIA(MM)	Ø 58.06					喷涂收费周长(mm):	74.29
AREA (SQ MM)	300.40	UNSPECIFIED THICKNESS	3±0.25	PERIMETER (MM)	123.81	STANDARD	BS EN755	SCALE	1.5:1
MASS (KG/M)	0.814	UNSPECIFIED CORNERS	R 0.3	SURFACE AREA	66.13	ALLOY	6063-T6	VERSION	A
COMPANY ISSUE		A	DRAWA	蔡晓婷	DATE	2020-09-28	APPELLATION	-	PAGE OF
			STANDA-RDIZATION		DATE				
			TO SIGN	王添明	DATE				
			AUDITING		DATE				
MARKER	MODIFY FILE NO	SIGNATURE	DATE	APPROV		DATE			


 PANASIA ALUMINUM (CHINA) LIMITED

2020/10/13

此处尺寸过窄，无法成型，建议修改

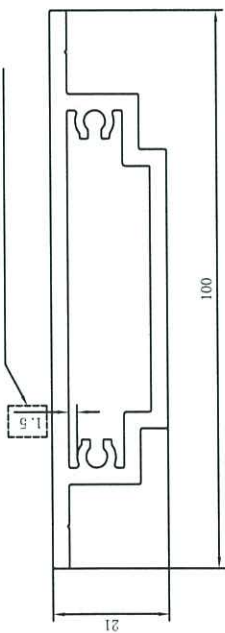

建议修改如右图所示

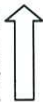

X85922

LH0091567

