



工程指示 / 要求簡箋(E.I.)

工程指示編號：EI / 2873 20 修改版次：
 工程編號：J - 852 工程名稱：亞皆老街中電
 工程項目：平台百葉 Design Change 報價 (改為 GLASS WALL)
 收件人：QS 發件人：Bessie Lau 日期：15/10/2020

要求提供 / 確認 事項：

- | | | |
|------------------------------------|-------------------------------------|-------------------------------|
| <input type="checkbox"/> 初步鋁料 B.M. | <input type="checkbox"/> 加工拆圖，然後生產 | <input type="checkbox"/> 尺寸表 |
| <input type="checkbox"/> 正式鋁料 B.M. | <input type="checkbox"/> 技術上資料 / 指示 | <input type="checkbox"/> 報價 |
| <input type="checkbox"/> 配件 B.M. | <input type="checkbox"/> 樣辦或貨品說明書 | <input type="checkbox"/> 分判合約 |
| <input type="checkbox"/> 其他：_____ | | |

內容：

LG4/F GYM AREA 百葉改為 GLASS WALL, AI 後補

請在 _____ 前完成上列要求。

By Memhard 電郵

附有關圖紙 / 文件：

以上項目為：

- 原合約工程包 原合約工程加 / 減賬 新工程報價

原因：-

分發東莞各部門：

- 生產技術總監 連附件 技術部 連附件 生產部 連附件 機械設計部 連附件
 採購部 連附件 生產統籌部 連附件
 質檢部 連附件 會計部 連附件 報關組 連附件 其他 _____ 連附件

分發香港各部門：

- 行政部 連附件 會計部 連附件 統籌部 連附件 工程部地盤科文 連附件
 採購部 連附件 QS 部 連附件 維修部 連附件 其他 _____ 連附件

傳遞編號：

發件人簽署：

項目經理簽署：

From: Yoanna Chan <yoanna.chan@mfacade.com>
To: "midi@midiltd.com.hk" <midi@midiltd.com.hk>
Subject: CLP - glass wall detail
Date sent: Wed, 14 Oct 2020 11:27:49 +0000
Copies to: "billytang@sino.com" <billytang@sino.com>, "jimmyhcheung@sino.com" <jimmyhcheung@sino.com>, "raymondho@agcdesign.com.hk" <raymondho@agcdesign.com.hk>, "eliotchan@agcdesign.com.hk" <eliotchan@agcdesign.com.hk>, Man Dick Yuen <ManDick.Yuen@gammonconstruction.com>, Angel Nga Chi Man <Angel.Man@gammonconstruction.com>, Jackson Chor Chiu Mok <Jackson.Mok@gammonconstruction.com>, Penny Pui Ying Chau <Penny.Chau@gammonconstruction.com>, Brian Leung <brian.leung@mfacade.com>

Dear Midi,


Detail of glass wall is attached for your drawing preparation.

Thanks & Regards,
Yoanna

TOWER 3

TOWER 2

TOWER 1

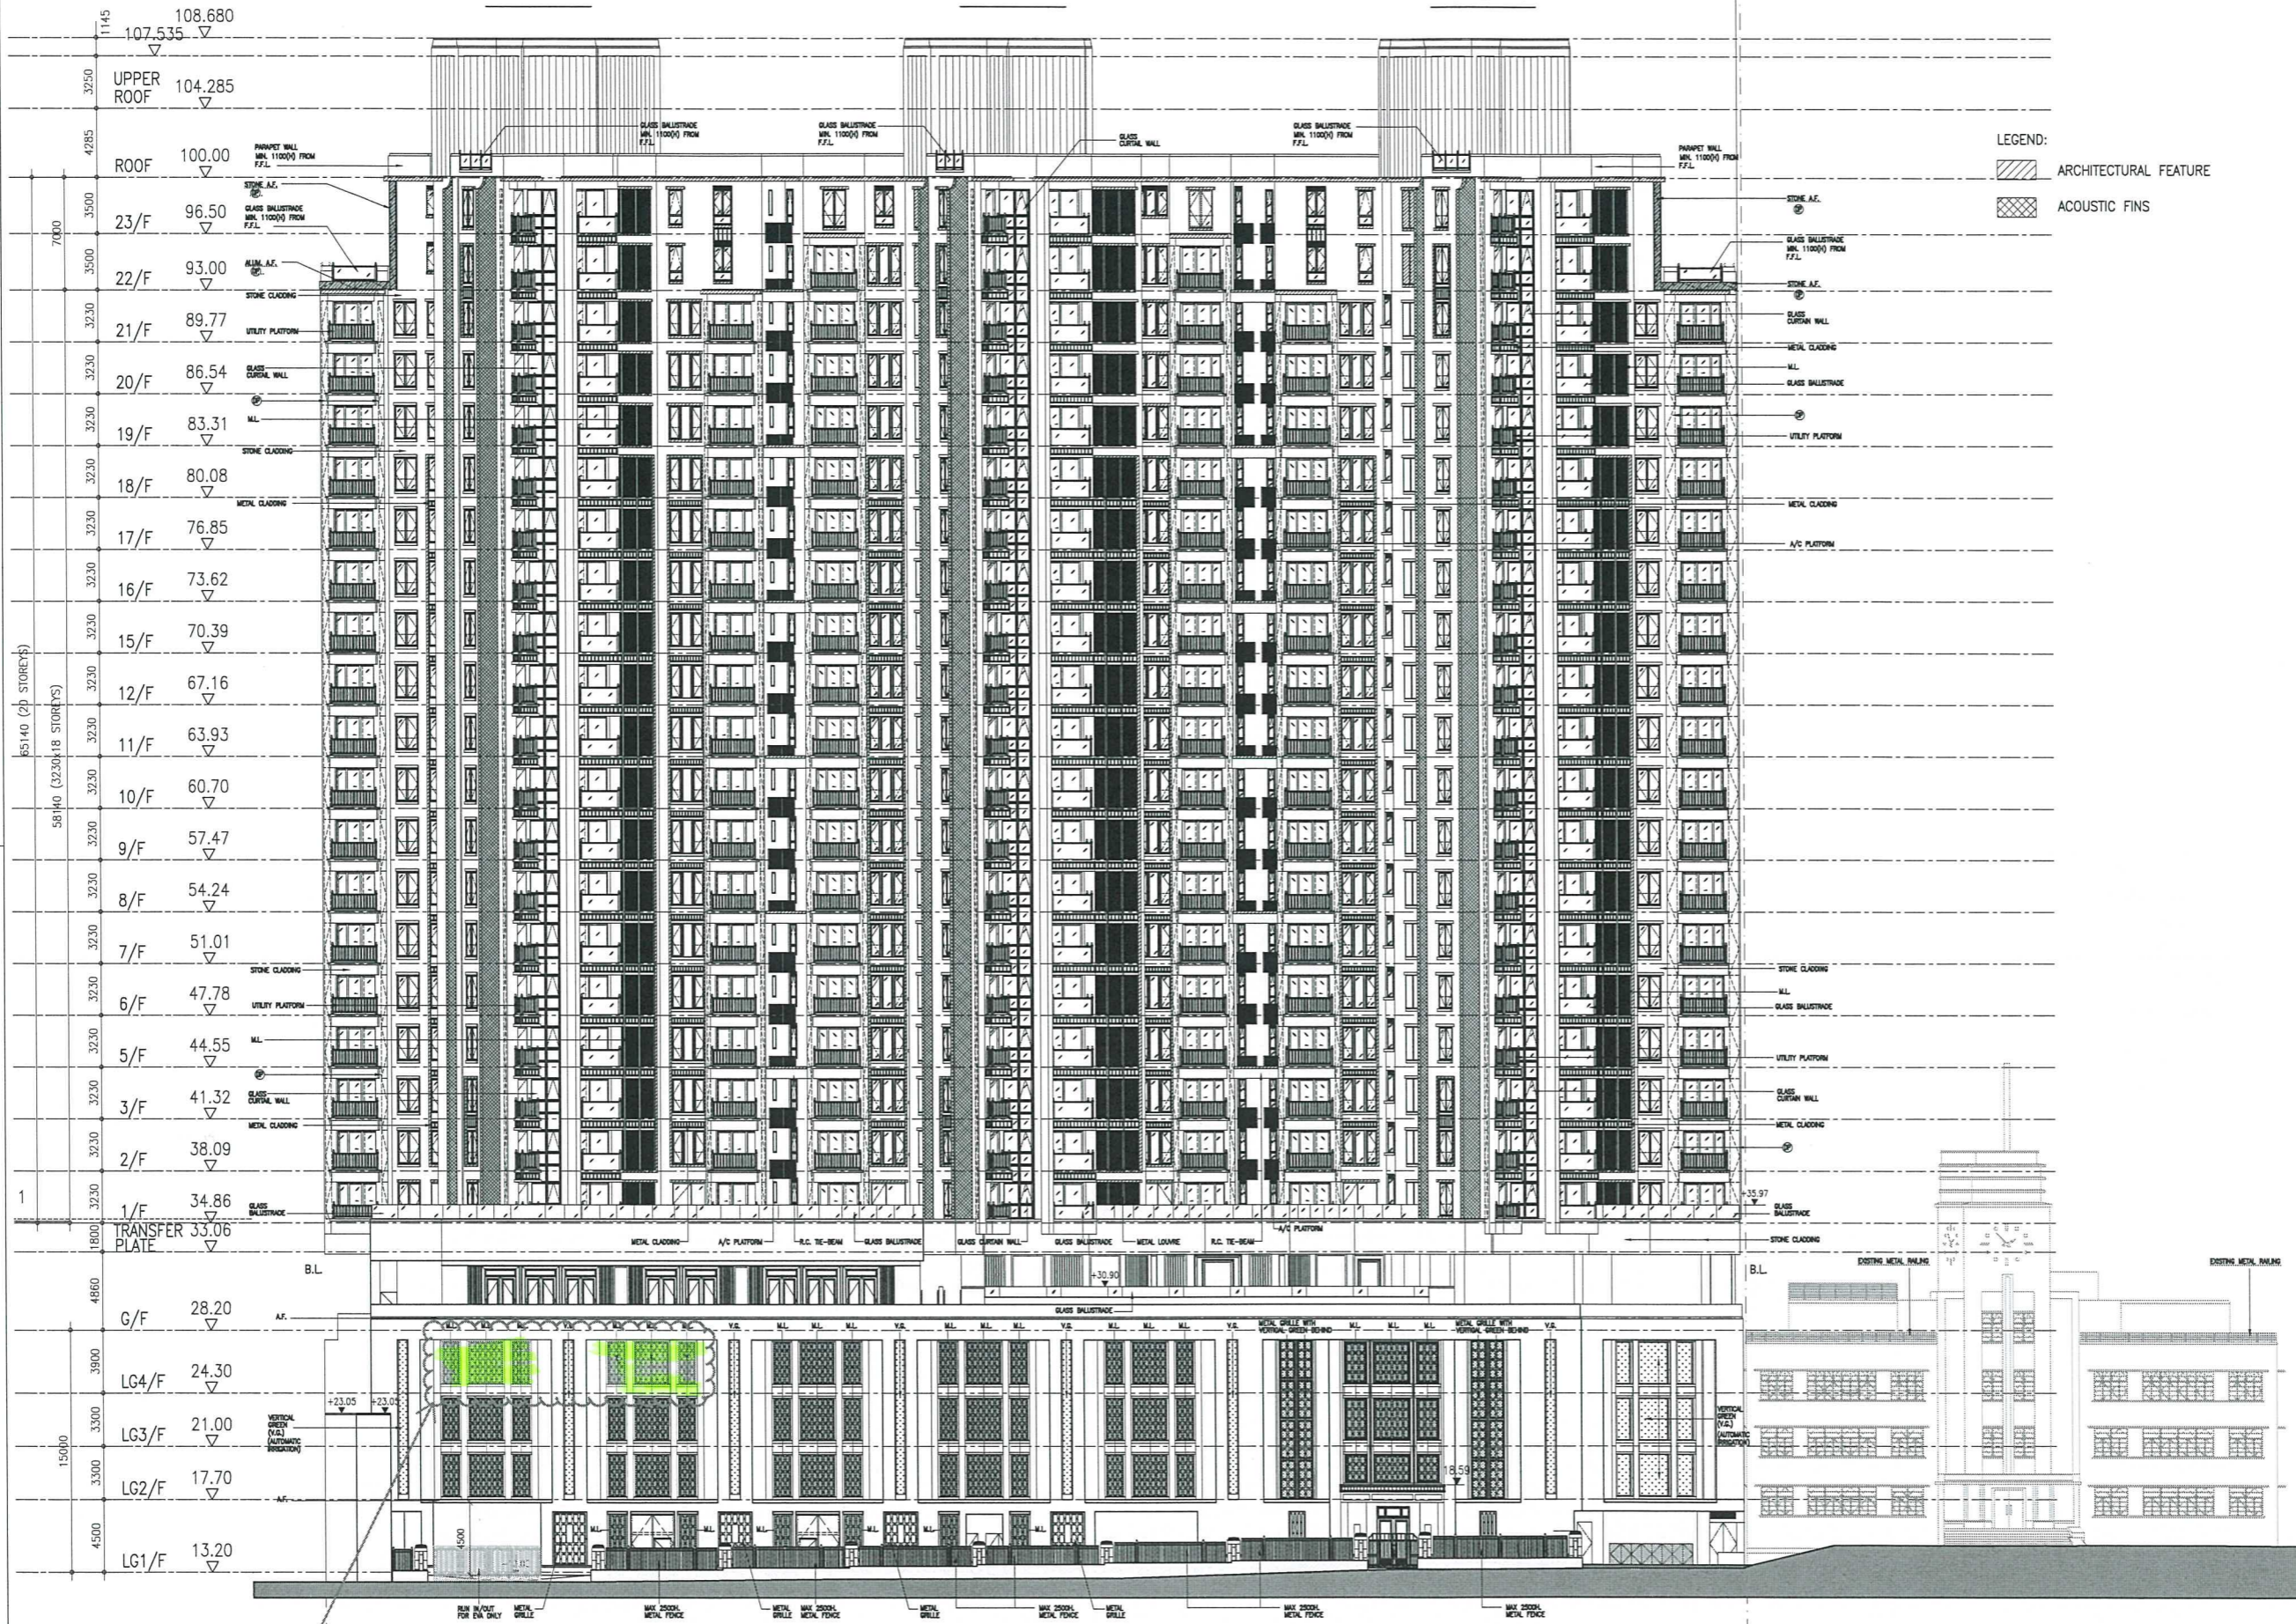

LEGEND:
 [Pattern] ARCHITECTURAL FEATURE
 [Pattern] ACOUSTIC FINIS

AMENDED PLAN 21 AUG 2020

A	BD RE-SUBMISSION	QJ	02.2011	GC
B	MAJOR AMENDMENT	QJ	03.2011	GC
C	MAJOR AMENDMENT	QJ	11.2011	GC
D	MINOR AMENDMENT	NKK	4.2013	GC
E	MINOR AMENDMENT	CYM	11.2013	GC
F	MINOR AMENDMENT	NKK	07.2015	GC
G	AMENDMENT	AL	05.2018	GC
H	AMENDMENT	MCK	07.2018	GC
J	AMENDMENT	AC	10.2019	GC
K	AMENDMENT	AC	12.2019	GC
L	AMENDMENT	AC	03.2020	GC
M	AMENDMENT	AC	08.2020	GC
N	AMENDMENT	AC	09.2020	GC

REVISION	DESCRIPTION	BY	DATE	APPROVED

ORIGINATOR
AGC DESIGN LTD
 architecture urban design interior

創智建築師有限公司
 1601, 16/F, Olympic Plaza, 255 King's Road, North Point, Hong Kong
 Tel: (852)22197185, Fax: (852)22197133, Email: agc@agcdesign.com.hk


DEVELOPMENT
 PROPOSED RESIDENTIAL DEVELOPMENT
 AT 139-147 ARGYLE STREET,
 KOWLOON INLAND LOT Nos. 6005,
 6035 R.P., 6036 R.P., 6037 R.P.
 & 6038 R.P.

TITLE
 ELEVATION 1

ELEVATION 1 (FACING ARGYLE STREET)

"THE WORKS SHOWN ON THESE PLANS ARE TYPE II WORKS (GENERAL BUILDING WORKS) IN RESPECT OF WHICH CONSENT IS APPLIED FOR THE PURPOSE OF FAST TRACK CONSENT APPLICATION UNDER REGULATION 33 OF THE BUILDING (ADMINISTRATIVE) REGULATIONS."

SCALE	DATE	NOV 2010	CAD REF	AG-02-01.dwg
DRAWN	QJ	DESIGNED	CMS	DRAWING NO.
CHECKED	CMS	APPROVED	GC	AC-02-01
REV	N			

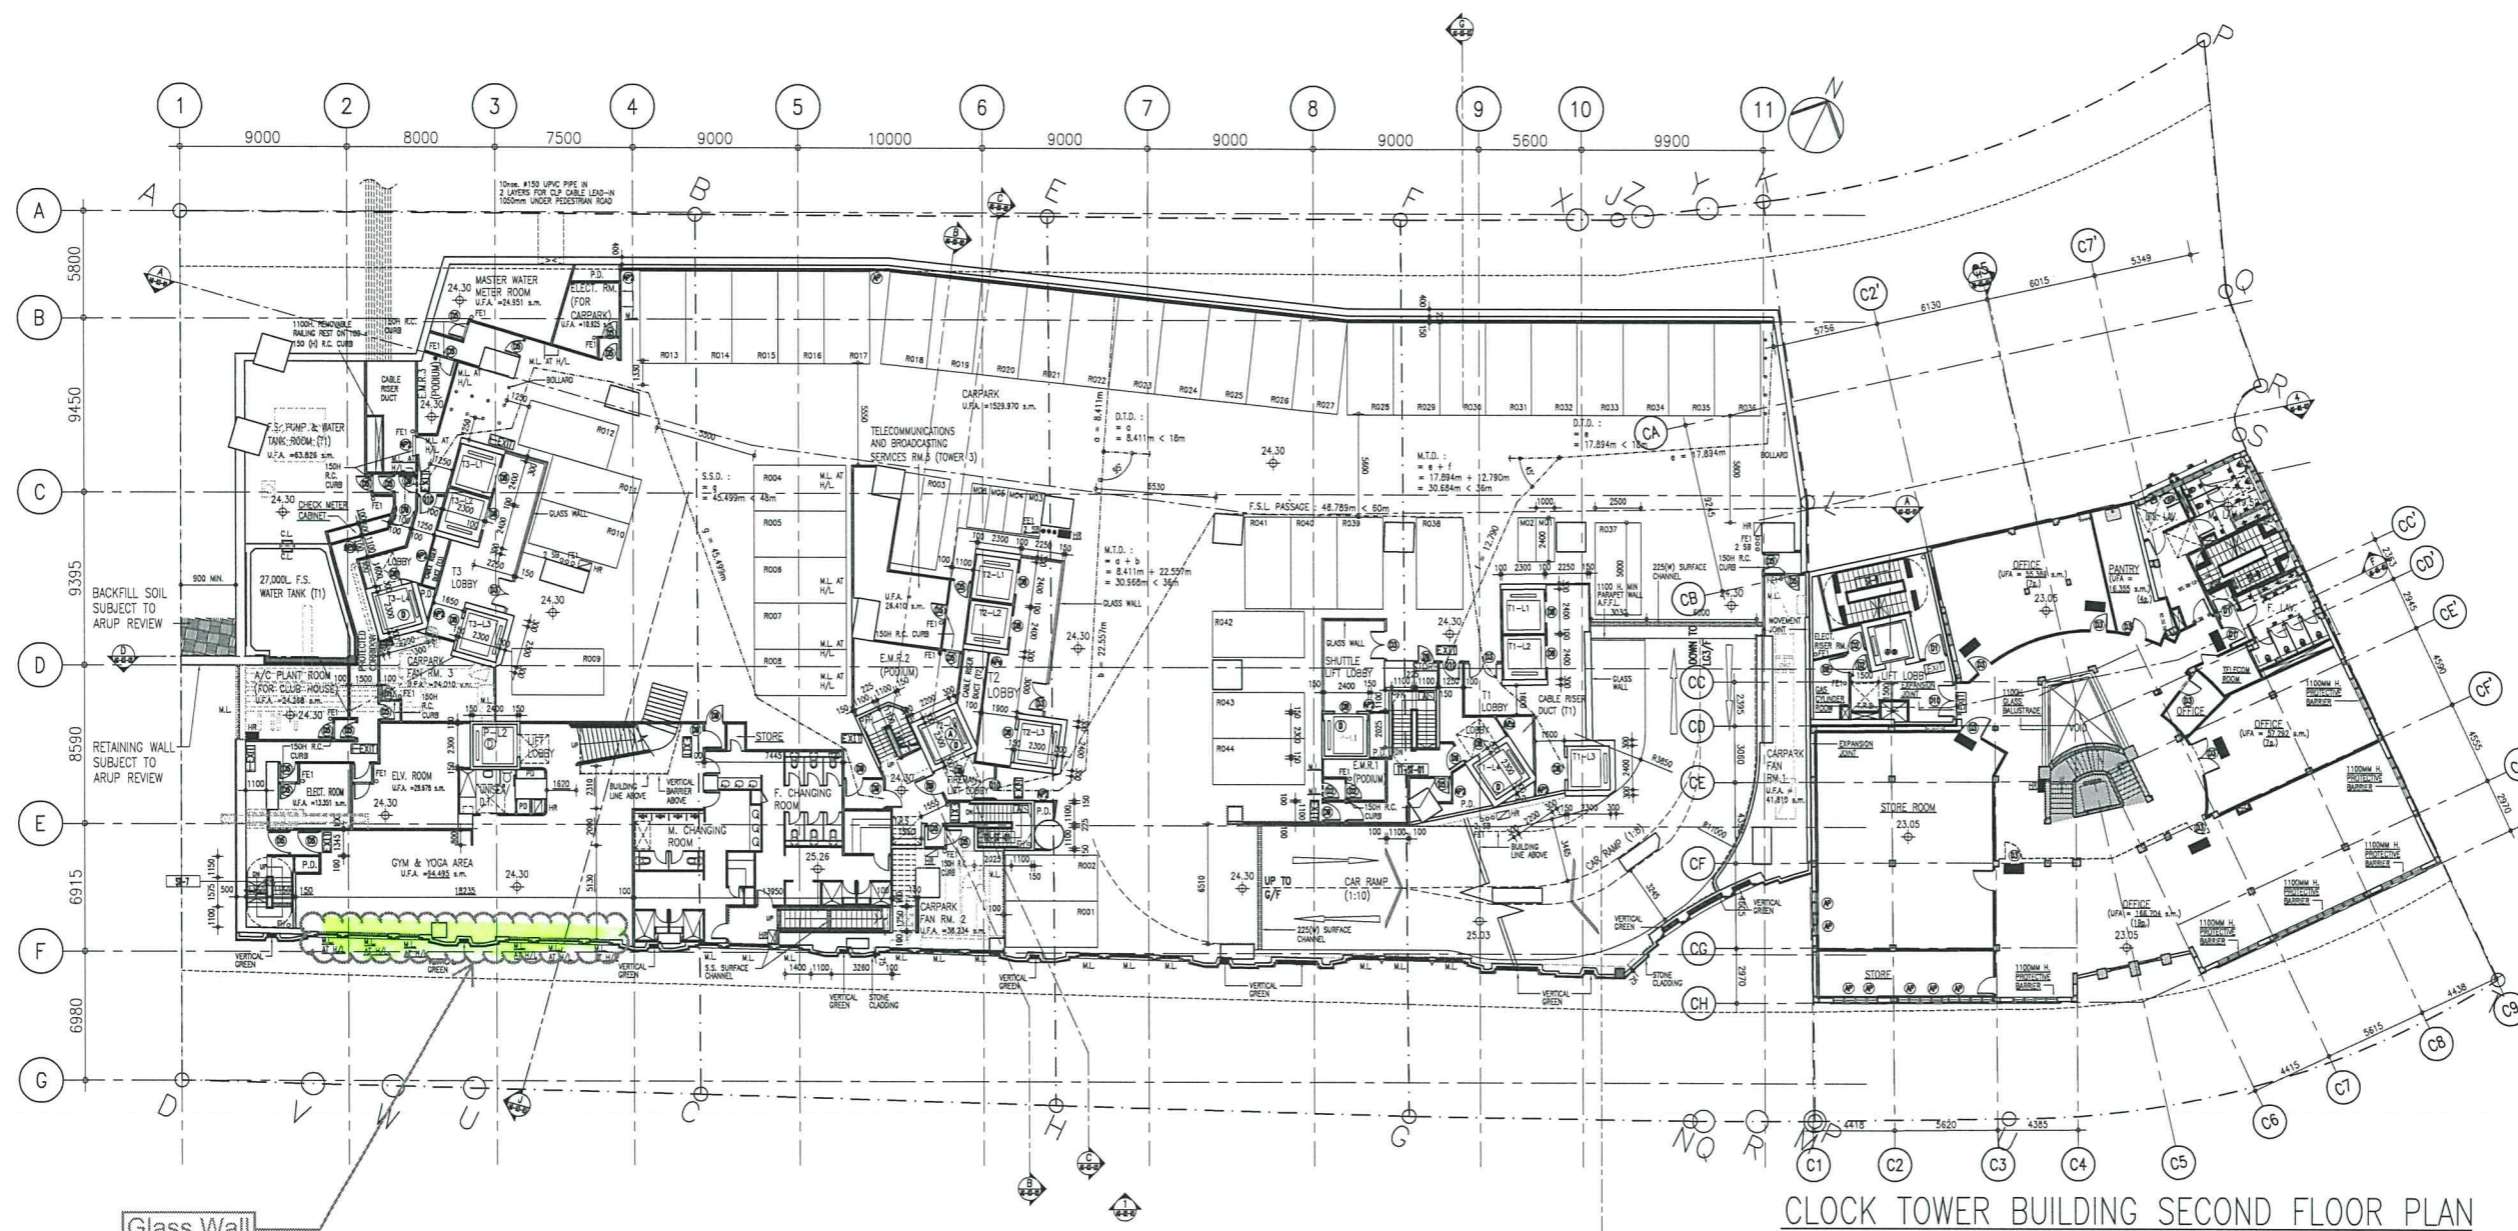

CLOCK TOWER BUILDING SECOND FLOOR PLAN

LOWER GROUND 4 FLOOR PLAN

SUPERIMPOSED LOAD OF CARPARK & CLUBHOUSE AREA : 5kPa
NO. OF RESIDENTIAL CARPARK SPACES (R) = 44 (INCLUDING 1 DIS. CP)
(W) x (L) = 2.5M x 5.0M ; MINIMUM HEADROOM 2.4M
NO. OF MOTORCYCLE SPACES (M) = 6
(W) x (L) = 1.5M x 2.4M ; MINIMUM HEADROOM 2.4M
AUTOMATIC SPRINKLER SYSTEM TO BE PROVIDED
ALL DIMENSIONS REFER TO LG1 PLAN UNLESS NOTED OTHERWISE

"THE WORKS SHOWN ON THESE PLANS ARE TYPE II WORKS (GENERAL BUILDING WORKS) IN RESPECT OF WHICH CONSENT IS APPLIED FOR THE PURPOSE OF FAST TRACK CONSENT APPLICATION UNDER REGULATION 33 OF THE BUILDING (ADMINISTRATION) REGULATIONS."

AMENDED PLAN 21 AUG 2020

REVISION	DESCRIPTION	BY	DATE	APPROVED
A	BD RE-SUBMISSION		YMY 02.2011	GC
B	MAJOR AMENDMENT		YMY 03.2011	GC
C	MAJOR AMENDMENT		YMY 11.2011	GC
D	MINOR AMENDMENT		NKK 4.2013	GC
E	MINOR AMENDMENT		NKK 5.2013	GC
F	MINOR AMENDMENT		CYM 11.2013	GC
G	MINOR AMENDMENT		NKK 07.2015	GC
H	MINOR AMENDMENT		NKK 07MAR17	GC
K	AMENDMENT		CTS 07.2018	GC
L	AMENDMENT		AC 10.2019	GC
M	AMENDMENT		AC 12.2019	GC
N	AMENDMENT		AC 00.2020	GC


ORIGINATOR
AGC DESIGN LTD
architecture
urban design
interior

創智建築師有限公司
1601, 16/F, Olympia Plaza, 253 King's Road, North Point, Hong Kong
Tel: (852)22191188, Fax: (852)22197133, Email: agc@agcdesign.com.hk

DEVELOPER
PROPOSED RESIDENTIAL DEVELOPMENT
AT 139-147 ARGYLE STREET,
KOWLOON INLAND LOT Nos. 6005,
6035 R.P., 6036 R.P., 6037 R.P.
& 6038 R.P.

TITLE
LOWER GROUND 4 FLOOR PLAN
(LG4/F)

SCALE	DATE	NOV 2010	CHK REF	AG-01-05.dwg
1:200				
DRAWN	YMY	DESIGNED	CMS	DRAWING NO
CHECKED	CMS	APPROVED	GC	AG-01-05
				REV
				N

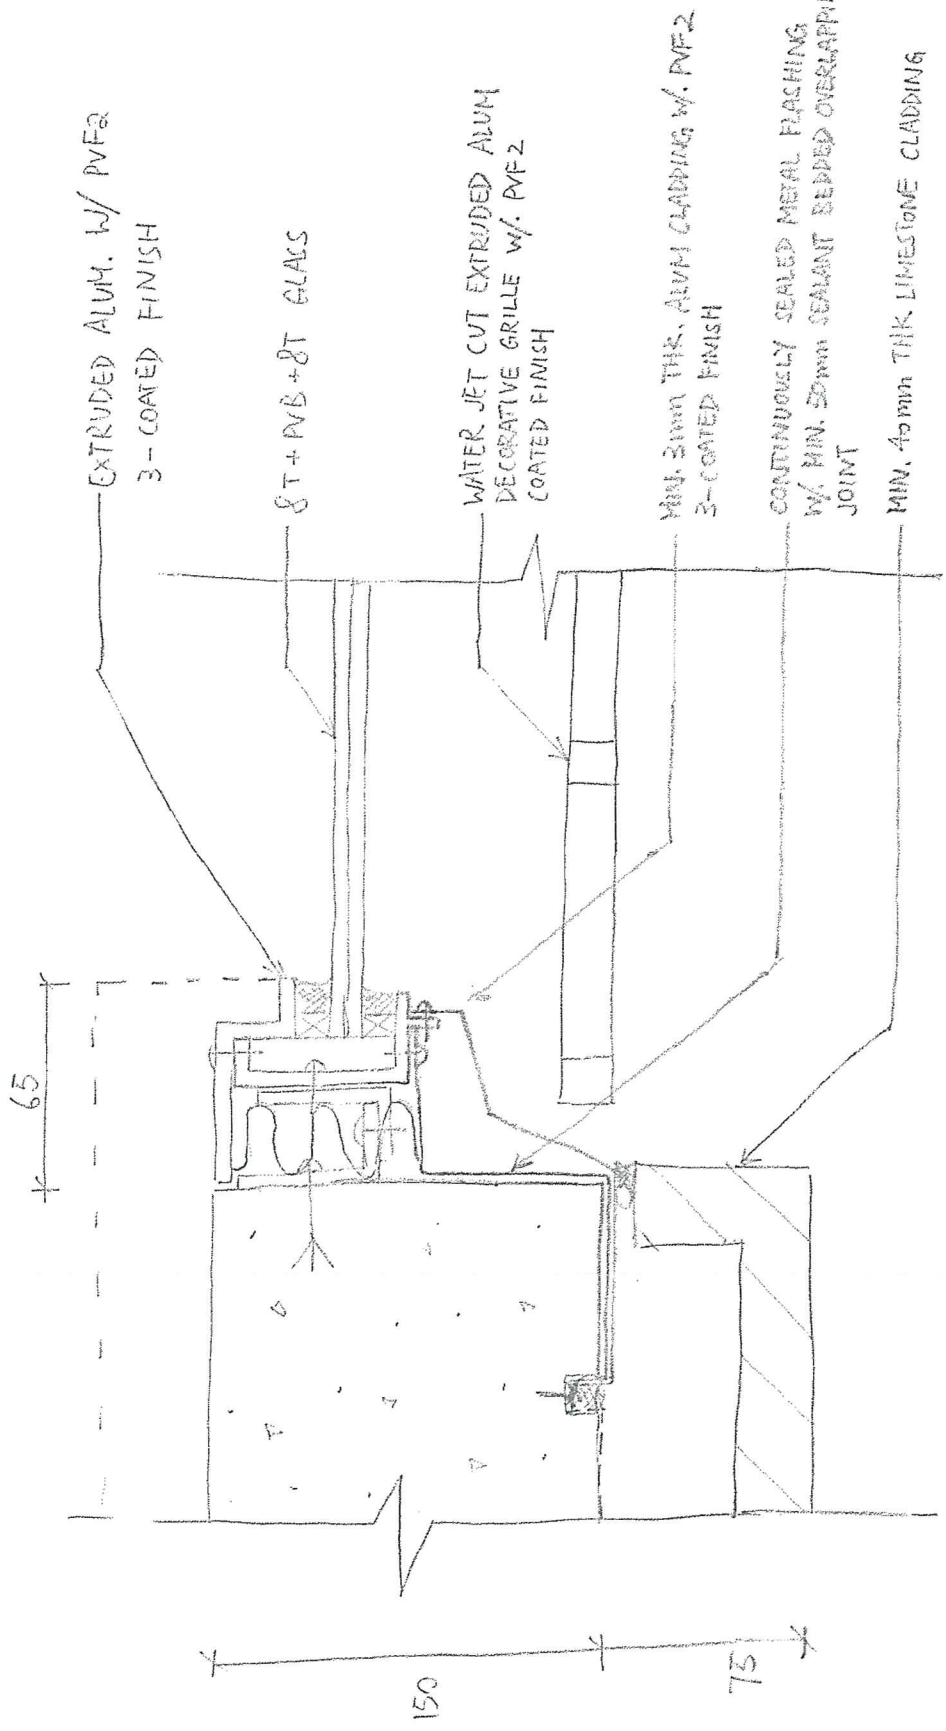

EXTRUDED ALUM. W/ PVFa
3-COATED FINISH

8T + PVB + 8T GLASS

WATER JET CUT EXTRUDED ALUM.
DECORATIVE GRILLE W/ PVFa
COATED FINISH

MIN. 3mm THK. ALUM CLADDING W/ PVFa
3-COATED FINISH

CONTINUOUSLY SEALED METAL FLASHING
W/ MIN. 50mm BEDDED OVERLAPPING
JOINT

MIN. 40mm THK LIMESTONE CLADDING

HORIZONTAL DETAIL OF GLASS WALL AT ARGYLE STREET

M.T.S.

PROJECT : ARGYLE STREET - CLP
SKETCH NO : MFT-20201014 -SK01
DATE : 14 OCT 2020