



工程指示 / 要求簡箋(E.I.)

工程指示編號：EI / 2619 / 20

修改版次：A

工程編號：J - 852

工程名稱：亞皆老街中電

工程項目：幕牆 Mockup 用玻璃 B.M. (3,5,6/F) T1

收件人：Maggie

發件人：Ant Yeung

日期：02/11/2020

要求提供 / 確認 事項：

- | | | |
|------------------------------------|-------------------------------------|-------------------------------|
| <input type="checkbox"/> 初步鋁料 B.M. | <input type="checkbox"/> 加工拆圖，然後生產 | <input type="checkbox"/> 尺寸表 |
| <input type="checkbox"/> 正式鋁料 B.M. | <input type="checkbox"/> 技術上資料 / 指示 | <input type="checkbox"/> 報價 |
| <input type="checkbox"/> 配件 B.M. | <input type="checkbox"/> 樣辦或貨品說明書 | <input type="checkbox"/> 分判合約 |
| <input type="checkbox"/> 其他：_____ | | |

內容：

請按 B.M. 訂購(3,5,6/F)用玻璃直送地盆 (T1)

A 版：死牆玻璃為 8mm 單片反光，已詢問玻璃未生產。

請在 2021 / 01 / 10 前完成上列要求。

附：1 頁 B.M.，~~1 頁 B.M. 參考~~，4 頁加工圖，1 頁位置圖。

以上項目為：

原合約工程包 原合約工程加 / 減賬 新工程報價

分發東莞各部門：

- () 生產技術總監 連附件 () 技術部 連附件 () 生產部 連附件 () 機械設計部 連附件
 () 採購部 連附件 () 生產統籌部 連附件
 () 質檢部 連附件 () 會計部 連附件 () 報關組 連附件 () 其他 楊榮輝 連附件

分發香港各部門：

- () 行政部 連附件 () 會計部 連附件 () 統籌部 連附件 () 工程部地盤科文 連附件 祥哥
 () 採購部 連附件 () QS 部 連附件 () 維修部 連附件 () 其他 _____ 連附件

傳遞編號：


HK / 20

發件人簽署：

項目經理簽署：

美特鋁質有限公司 MIDI Aluminium Fabricator Ltd.		工程號:	J852	計算:	LHR	日期:	2020.09.09	送呈:		
地盤名稱:		核對:	wsh <td>核對:</td> <td> <td>日期:</td> <td>2020.09.10</td> <td>副本:</td> </td>	核對:	<td>日期:</td> <td>2020.09.10</td> <td>副本:</td>	日期:	2020.09.10	副本:		
項目類別:		批准:		批准:		日期:		A/C Code:		
修改版次:		A(2020.09.14)		總計玻璃面積 (平方米):		18.54				
序號	修改內容	玻璃圖號	顏色與類型	厚度 (mm)	玻璃尺寸		數量 (塊)	總面積 (平方米)	使用位置	加工圖參考
					寬度 (W mm)	高度 (H mm)				
1		GL01-T1-T01	8mm+12mm AIR GAP+10mm THK I.G.U. P20070681	30.0	703.0	1113.0	3	2.35	生窗位	GL01-01
						合計:	3	2.35		
2		GL01-T1-F01			906.0	1236.0	3	3.36	大梗窗位	GL01-01
3		GL01-T1-F02	8mm+12mm AIR GAP+10mm THK I.G.U. P20070681	30.0	906.0	646.0	3	1.76	梗窗位	GL01-01
4		GL01-T1-F03			826.0	646.0	3	1.60	梗窗位	GL01-01
						合計:	9	6.72		
5		GL02-T1-F01	10mm THK. HEAT STRENGTHENED GLASS P20070681	10.0	906.0	976.0	3	2.65	上格間牆位	GL02-01
6		GL02-T1-F02			826.0	976.0	3	2.42	上格間牆位	GL02-01
						合計:	6	5.07		
7	A-縮小尺寸	GL04-T1-T01	10mm THK. TEMPERED GLASS (PROTECTIVE BARRIER) P20070686	10.0	765.0	163.0	3	0.37	生窗欄河位	GL04-01
						合計:	3	0.37		
8		GL05-T1-FD01	6mm THK. HEAT STRENGTHENED GLASS+12mm AIR GAP+8mm THK. TEMPERED GLASS I.G.U. P20070687	26.0	591.0	2276.0	3	4.04	FD門位	GL05-01
						合計:	3	4.04		
						總合計:	24	18.5		
1). 本表中之所有玻璃顏色待定。										
2). 本表中所有玻璃對角線尺寸偏差要求不超過負2mm。										
3). 本表中玻璃要求粗磨邊處理並倒棱角，而所有玻璃之人爐方向需保持一致。										
4). 本表中所有玻璃成品均需做雙面保護，用透明靜電膠紙加四周一寸FK白膠紙做雙面加固保護處理。										
5). 本表中所有玻璃成品均需注明室內外及其玻璃編號，以便識別。										
加工注意事項:										



J852-幕牆樣辦層 (T1-3F~6F) 玻璃位置圖

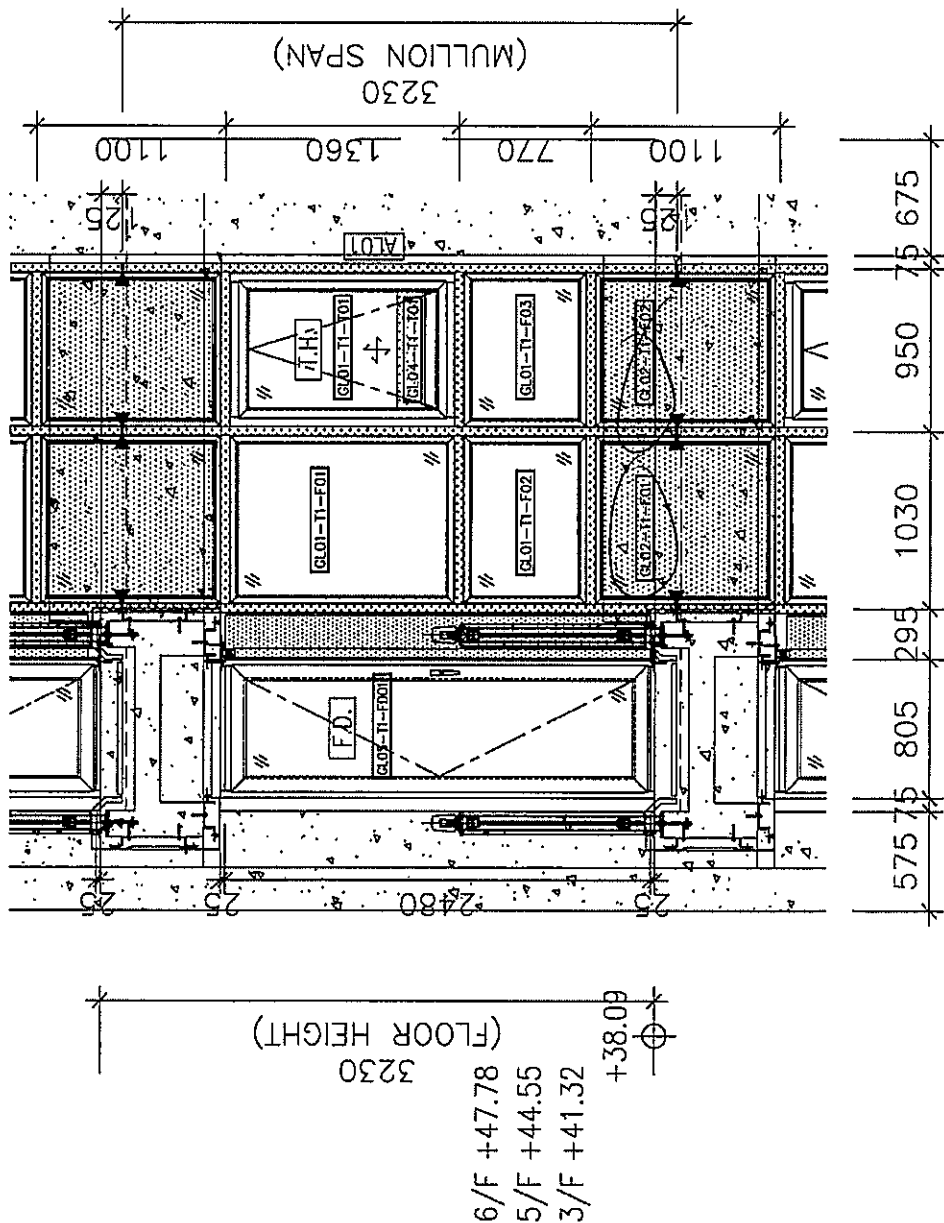

1 PARTIAL ELEVATION OF CURTAIN WALL
4001 TOWER 1

NO. REF:	
CLIENT:	
ARCHITECT:	M&C
MAIN CONTRACTOR:	Gammon
STRUCTURAL ENGINEER:	ARUP
FAÇADE CONSULTANT:	MEINHARDT
NOTE:	<ol style="list-style-type: none"> 1. ALL DIMENSIONS ARE IN METERS. 2. ALL ELEVATIONS ARE VIEWED FROM OUTSIDE. 3. ALL DIMENSIONS TO BE VERIFIED ON SITE BEFORE FABRICATING.
LEGEND:	<p>REF. MARK NO. — REFER SHEET NO.</p> <p>1. FFL — FINISHED FLOOR LEVEL</p> <p>2. SFL — STRUCTURAL FLOOR LEVEL</p> <p>3. Ⓞ — REINFORCED DETAIL</p>
JOB NO.:	J-852
PROJECT:	<p>PROPOSED RESIDENTIAL DEVELOPMENT 170-178, 147 JARDINE STREET, HONG KONG, 6033 R.F., 6036 R.F., 6037 R.F. & 6038 R.F.</p>
TITLE:	<p>PART ELEVATION, PLAN & SECTION FOR CURTAIN WALL TOWER 1 AND TOWER 2</p>
DATE:	22-NOV-19
SCALE:	1:100
DRAWN BY:	SUN
CHECKED BY:	OW
DESIGNED BY:	
DATE:	
SCALE:	
PROJECT:	
TITLE:	
DATE:	
SCALE:	
DRAWN BY:	
CHECKED BY:	
DESIGNED BY:	
DATE:	
SCALE:	
PROJECT:	
TITLE:	
DATE:	
SCALE:	
DRAWN BY:	
CHECKED BY:	
DESIGNED BY:	
DATE:	
SCALE:	
PROJECT:	
TITLE:	
DATE:	
SCALE:	
DRAWN BY:	
CHECKED BY:	
DESIGNED BY:	
DATE:	
SCALE:	
PROJECT:	
TITLE:	
DATE:	
SCALE:	
DRAWN BY:	
CHECKED BY:	
DESIGNED BY:	
DATE:	
SCALE:	
PROJECT:	
TITLE:	
DATE:	
SCALE:	
DRAWN BY:	
CHECKED BY:	
DESIGNED BY:	
DATE:	
SCALE:	
PROJECT:	
TITLE:	

 美特鋁質 有限公司 MIDI Aluminium Fabricator Ltd.				類別		物料號	
				制圖	LHR	2020-09-09	圖號 GL02-01
修改				復核			數量 一
日期				批准			位置 幕牆樣辦層

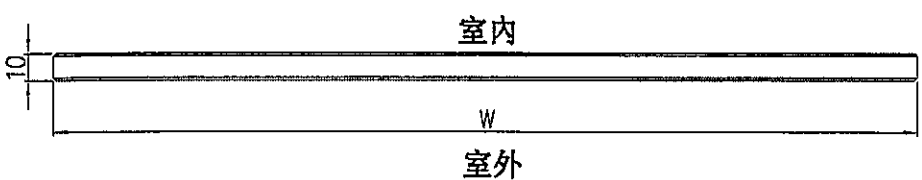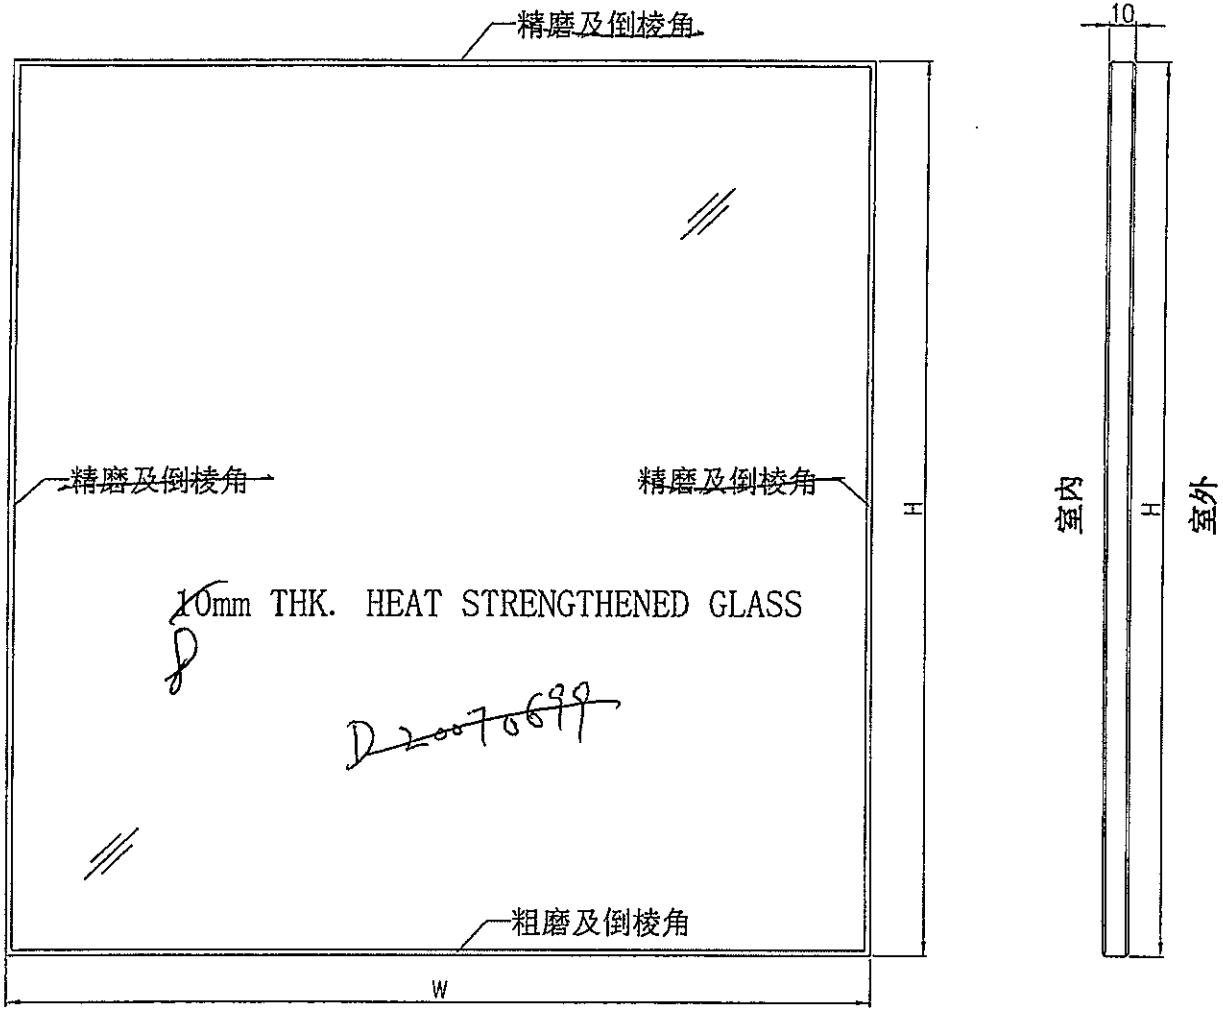

工程號	J-852	地盤	亞皆老街	附 件
名稱	玻璃加工圖		採用	
材料	10mm THK. HEAT STRENGTHENED GLASS		地盤 <input checked="" type="checkbox"/>	
顏色	-		工廠 <input type="checkbox"/>	