



工程指示 / 要求簡箋(E.I.)

工程指示編號：EI / 2721 / 20

修改版次：C

工程編號：J - 852

工程名稱：亞皆老街中電

工程項目：百葉 廠用鋁板+背板(平台)

收件人：生統 / 王良

發件人：Ant Yeung

日期：03/09/2021

要求提供 / 確認 事項：

- | | | |
|------------------------------------|-------------------------------------|-------------------------------|
| <input type="checkbox"/> 初步鋁料 B.M. | <input type="checkbox"/> 加工拆圖，然後生產 | <input type="checkbox"/> 尺寸表 |
| <input type="checkbox"/> 正式鋁料 B.M. | <input type="checkbox"/> 技術上資料 / 指示 | <input type="checkbox"/> 報價 |
| <input type="checkbox"/> 配件 B.M. | <input type="checkbox"/> 樣辦或貨品說明書 | <input type="checkbox"/> 分判合約 |
| <input type="checkbox"/> 其他：_____ | | |

內容：

C 版：705 百葉玉用鋁板顏色為鋁料色(UCT201498XL(A)-3)，請已噴塗黑色的鋁板送出返噴(見加工圖)

B 版：前版背板顏色有誤，百葉背板顏色為黑色 (TUC40577-3)

A 版：已新增中企改款加工圖(鋸齒形中企鋁板)+修改 BM 表加工圖

中企百葉玉鋁板用 UCT-201498XL(A)-3 顏色

請按加工圖生產鋁板供廠組裝，部分位置無背板。

請先生產電制房 10 隻百葉用鋁板供廠組裝，已在加工圖標示，其餘接住生產

謝謝。

請在 2021.09.10 前完成上列要求。

附：4 頁 手寫

以上項目為：

- 原合約工程包 原合約工程加 / 減賬 新工程報價

原因：-

分發東莞各部門：

- () 生產技術總監 連附件 () 技術部 連附件 () 生產部 連附件 () 機械設計部 連附件
 () 採購部 連附件 (✓) 生產統籌部 連附件 抄 () 小羅&清 連附件
 () 質檢部 連附件 () 會計部 連附件 () 報關組 連附件 () 其他 楊榮輝 連附件

分發其他分判：

- (v) 水洪 連附件

分發香港各部門：

- () 行政部 連附件 () 會計部 連附件 () 統籌部 連附件 () 工程部地盤科文 連附件 祥哥
 () 採購部 連附件 () QS 部 連附件 () 維修部 連附件 () 其他 _____ 連附件


傳遞編號：

HK 1740 / 21

發件人簽署：

項目經理簽署：

Ant Yeung
Project Manager


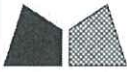


美特鋁質 有限公司
MIDI Aluminium Fabricator Ltd.

序號	物料編號	數量	使用位置	樓層
01	AP1-10-2	3	工廠組裝區第五	

工程號 J852 地盤 亞皆老街

工廠用

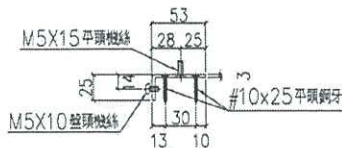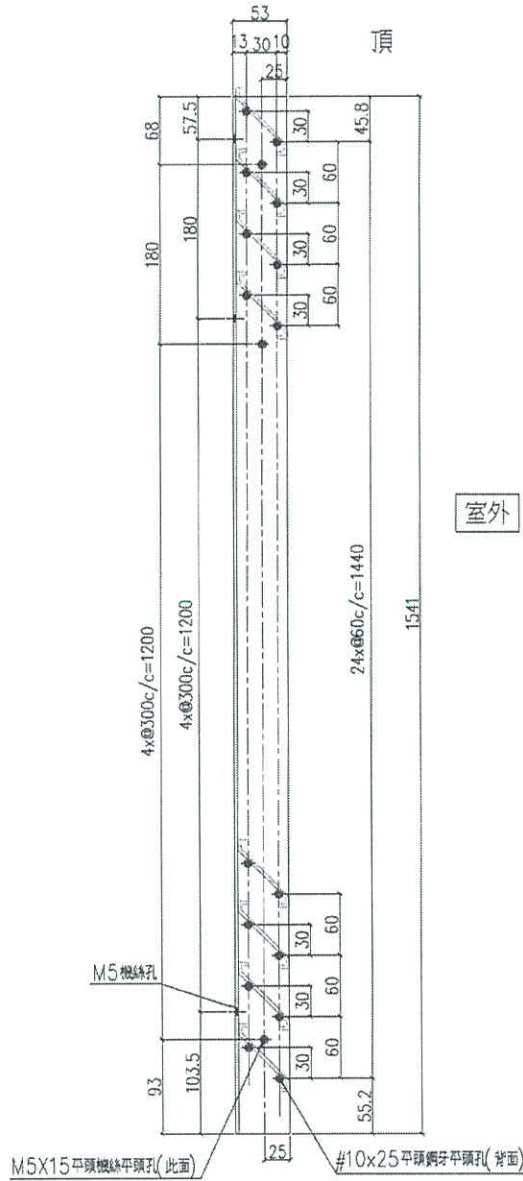

SCALE 2:1

UCT201498XL(A)-3
~~UCT201498XL(A)-3 (藍色)~~

名稱	鋁折件加工圖	制圖	Ivan	2020.11.13	修改		
材料	3mm厚鋁板 (3003H14)	復核	-	-	日期		
顏色	UCT201498XL(A)-3	批準			圖號	J852-LVA-AP1-10-2	

1. ALL DIMENSIONS ARE IN mm.
2. ALL ELEVATIONS ARE VIEWED FROM OUTSIDE.
3. ALL DIMENSIONS TO BE VIEWED ON SITE BEFORE FABRICATION.

LEGEND:

- ① DETAIL MARK NO.
- ② REFER SHEET NO.

1. F.F.L. --- FINISHED FLOOR LEVEL
2. S.F.L. --- STRUCTURAL FLOOR LEVEL
3. S.O. --- STRUCTURAL OPENING
4. ▲ --- FIXING LOCATION
5. ▮ --- STRUCTURAL FLOOR LEVEL MARK

NO.	DATE	REVISION	BY
D	24-10-2020	REVISION SUBJECT TO COMMENTS	MM
C	05-06-2020	REVISION SUBJECT TO COMMENTS	MM
B	27-04-2020	REVISION SUBJECT TO COMMENTS	MM
A	19-02-2020	REVISION SUBJECT TO COMMENTS	MM
NO.	DATE	REVISION	BY

JOB NO. : J-852

PROJECT :
 PROPOSED RESIDENTIAL DEVELOPMENT
 AT 139 - 147 ARCOLE STREET,
 NKIL 6005, 6035 R.P., 6036 R.P.,
 6037 R.P. & 6038 R.P.

TITLE :
 LOUVER SCHEDULE FOR
 ALUM. LOUVER

DATE : 12-Feb-2020 SCALE : 1:40

DRAWN BY : LHR CHECKED BY : DW



Units 6-8, Sunroy Industrial Centre, 1/F
 610 Cha Kwo Ling Road, Kowloon
 Tel: 23489211-4 Fax: (852) 2727666

DWG NO. : JB52-SD-LVA-4009 REV. : D

