



工程指示 / 要求簡箋(E.I.)

工程指示編號：EI / 271 / 20

修改版次：-

工程編號：J - 852

工程名稱：亞皆老街中電

工程項目：百葉 廠用鋁板+背板(平台)

收件人：生統 /

發件人：Ant Yeung

日期：20/11/2020

要求提供 / 確認 事項：

- | | | |
|------------------------------------|-------------------------------------|-------------------------------|
| <input type="checkbox"/> 初步鋁料 B.M. | <input type="checkbox"/> 加工拆圖，然後生產 | <input type="checkbox"/> 尺寸表 |
| <input type="checkbox"/> 正式鋁料 B.M. | <input type="checkbox"/> 技術上資料 / 指示 | <input type="checkbox"/> 報價 |
| <input type="checkbox"/> 配件 B.M. | <input type="checkbox"/> 樣辦或貨品說明書 | <input type="checkbox"/> 分判合約 |
| <input type="checkbox"/> 其他：_____ | | |

內容：

請按加工圖生產鋁板供廠組裝

請先生產電制房 10 隻百葉用鋁板供廠組裝，已在加工圖標示，其餘接住生產

謝謝。

請在 2020.11.27 前完成上列要求。

部份位置無背板

附：1 頁，2 頁 BM，2 頁圖登，32 頁加工圖

部份背板 = TUC40577
(中在百葉五折件點)

以上項目為：

- 原合約工程包 原合約工程加 / 減賬 新工程報價

原因：-

分發東莞各部門：

- | | | | |
|--|---|--|---|
| <input type="checkbox"/> 生產技術總監 <input type="checkbox"/> 連附件 | <input type="checkbox"/> 技術部 <input type="checkbox"/> 連附件 | <input type="checkbox"/> 生產部 <input type="checkbox"/> 連附件 | <input type="checkbox"/> 機械設計部 <input type="checkbox"/> 連附件 |
| <input type="checkbox"/> 採購部 <input type="checkbox"/> 連附件 | <input checked="" type="checkbox"/> 生產統籌部 <input checked="" type="checkbox"/> 連附件 | <input checked="" type="checkbox"/> 小羅 & 清 <input checked="" type="checkbox"/> 連附件 | |
| <input type="checkbox"/> 質檢部 <input type="checkbox"/> 連附件 | <input type="checkbox"/> 會計部 <input type="checkbox"/> 連附件 | <input type="checkbox"/> 報關組 <input type="checkbox"/> 連附件 | <input type="checkbox"/> 其他 <u>楊榮輝</u> <input type="checkbox"/> 連附件 |

分發其他分判：

- 水洪 連附件

分發香港各部門：

- | | | | | |
|---|--|---|--|----|
| <input type="checkbox"/> 行政部 <input type="checkbox"/> 連附件 | <input type="checkbox"/> 會計部 <input type="checkbox"/> 連附件 | <input type="checkbox"/> 統籌部 <input type="checkbox"/> 連附件 | <input type="checkbox"/> 工程部地盤科文 <input type="checkbox"/> 連附件 | 祥哥 |
| <input type="checkbox"/> 採購部 <input type="checkbox"/> 連附件 | <input type="checkbox"/> QS 部 <input type="checkbox"/> 連附件 | <input type="checkbox"/> 維修部 <input type="checkbox"/> 連附件 | <input type="checkbox"/> 其他 _____ <input type="checkbox"/> 連附件 | |

傳遞編號：

HK 2663 / 20

發件人簽署：

項目經理簽署：



ELEVATION 2 (FACING ARGYLE STREET)

UNUSED LOUVRE TO BE BLANKED OFF BY BUILDER


LEGEND



B.S. CONSULTANT:
 WONG & OUYANG (BU)
 MAIN CONTRACTOR:
 GAMMON ENGINEERING COMPANY LIMITED
 ELECT. SUB-CONTRACTOR:
 kei KEIO ENGINEERING INC. (2023) REGISTERED
 GENSET SUB-CONTRACTOR:
 P POT POWERCO I
 PROJECT:
 PROPOSED RESIDENTIAL 139-147 ARGYLE ST KOWLOON ISLAND TD 6035 R.P., 6036 R.F. 6038 R.P.
 DRAWING TITLE:
 ELEVATION 2 (POBUIA)
 DRAWN: Y.L.DWNG
 CHECKED: W.K.LIA
 SCALE: 1:100 @ A1
 CAD REF: 02555-313 ELEV.DWG

(Handwritten signature)

BM編號:		工程號:	J852	計算:	Ivan	日期:	2020.11.20	送呈:				
修改版次:		地盤名稱:	亞皆老街	核對:		日期:		副本:				
廠用鋁板B.M.表		項目類別:	百頁平台廠用鋁板									
修改內容		鋁板名稱	顏色	實用	後備	總數	總重量	單件展開面積	總展開面積	單件V.F.	總V.F.	備註
序號	鋁板圖號	鋁板名稱	顏色	實用	後備	總數	總重量	單件展開面積	總展開面積	單件V.F.	總V.F.	備註
平方米												
位置												
1	J852-LVA-API-01-1	3.0mm厚鋁板	UCT201498XL(A)-3	45		45	66.661	0.182	8.199	0.135	6.086	百葉平台
2	J852-LVA-API-01-2	3.0mm厚鋁板	UCT201498XL(A)-3	45		45	66.661	0.182	8.199	0.123	5.554	百葉平台
3	J852-LVA-API-02-1	3.0mm厚鋁板	UCT201498XL(A)-3	45		45	66.661	0.182	8.199	0.135	6.086	百葉平台
4	J852-LVA-API-02-2	3.0mm厚鋁板	UCT201498XL(A)-3	45		45	66.661	0.182	8.199	0.123	5.554	百葉平台
5	J852-LVA-API-03-1	3.0mm厚鋁板	UCT201498XL(A)-3	13		13	13.664	0.129	1.681	0.257	3.344	百葉平台
6	J852-LVA-API-03-2	3.0mm厚鋁板	UCT201498XL(A)-3	13		13	12.469	0.118	1.534	0.235	3.052	百葉平台
7	J852-LVA-API-03-3	3.0mm厚鋁板	UCT201498XL(A)-3	2		2	1.612	0.198	0.396	0.257	0.514	百葉平台
8	J852-LVA-API-03-4	3.0mm厚鋁板	UCT201498XL(A)-3	2		2	1.471	0.181	0.362	0.235	0.469	百葉平台
9	J852-LVA-API-04-1	3.0mm厚鋁板	UCT201498XL(A)-3	13		13	10.476	0.198	2.577	0.257	3.344	百葉平台
10	J852-LVA-API-04-2	3.0mm厚鋁板	UCT201498XL(A)-3	13		13	9.559	0.181	2.352	0.235	3.052	百葉平台
11	J852-LVA-API-04-3	3.0mm厚鋁板	UCT201498XL(A)-3	2		2	1.612	0.198	0.396	0.257	0.514	百葉平台
12	J852-LVA-API-04-4	3.0mm厚鋁板	UCT201498XL(A)-3	2		2	1.471	0.181	0.362	0.235	0.469	百葉平台
13	J852-LVA-API-05-1	3.0mm厚鋁板	UCT201498XL(A)-3	3		3	1.246	0.102	0.307	0.080	0.241	百葉平台
14	J852-LVA-API-05-2	3.0mm厚鋁板	UCT201498XL(A)-3	3		3	1.460	0.120	0.359	0.094	0.282	百葉平台
15	J852-LVA-API-06-1	3.0mm厚鋁板	UCT201498XL(A)-3	3		3	1.246	0.102	0.307	0.080	0.241	百葉平台
16	J852-LVA-API-06-2	3.0mm厚鋁板	UCT201498XL(A)-3	3		3	1.460	0.120	0.359	0.094	0.282	百葉平台
17	J852-LVA-API-07-1	3.0mm厚鋁板	UCT201498XL(A)-3	1		1	0.478	0.118	0.118	0.152	0.152	百葉平台
18	J852-LVA-API-07-2	3.0mm厚鋁板	UCT201498XL(A)-3	1		1	0.560	0.138	0.138	0.179	0.179	百葉平台
19	J852-LVA-API-08-1	3.0mm厚鋁板	UCT201498XL(A)-3	1		1	0.478	0.118	0.118	0.152	0.152	百葉平台
20	J852-LVA-API-08-2	3.0mm厚鋁板	UCT201498XL(A)-3	1		1	0.560	0.138	0.138	0.179	0.179	百葉平台

		美特鋁質有限公司 MIDI Aluminium Fabricator Ltd.		工程號:	J852	計算:	Ivan	日期:	2020.11.20	送呈:	
地盤名稱:		亞皆老街		核對:		日期:		日期:		副本:	
BM編號:		廠用鋁板B.M.表		A/C Code:		總重量:	1201.67	總重量:	1201.67	此BM依據**拆圖資料計算	
修改內容		鋁板名稱		實用	後備	總數	總重量	單件展開面積	總展開面積	單件V.F.	總V.F.
修改內容		鋁板圖號		顏色		平方米		平方米		平方米	
修改內容		鋁板圖號		顏色		總重量		總重量		總重量	

序號	修改內容	鋁板圖號	鋁板名稱	顏色	實用	後備	總數	總重量	單件展開面積	總展開面積	單件V.F.	總V.F.	備註	位置	
				平方米		平方米		平方米		平方米		平方米		平方米	
21		J852-LVA-API-09-1	3.0mm厚鋁板	UCT201498XL(A)-3	3		3	2.388	0.196	0.587	0.154	0.461		百葉平台	
22		J852-LVA-API-09-2	3.0mm厚鋁板	UCT201498XL(A)-3	3		3	2.443	0.200	0.601	0.157	0.472		百葉平台	
23		J852-LVA-API-10-1	3.0mm厚鋁板	UCT201498XL(A)-3	3		3	2.388	0.196	0.587	0.154	0.461		百葉平台	
24		J852-LVA-API-10-2	3.0mm厚鋁板	UCT201498XL(A)-3	3		3	2.443	0.200	0.601	0.157	0.472		百葉平台	
25		J852-LVA-API-17-1	3.0mm厚鋁板	UCT201498XL(A)-3	52		52	281.972	1.334	69.366	2.538	131.974		百葉平台	
26		J852-LVA-API-17-2	3.0mm厚鋁板	UCT201498XL(A)-3	52		52	257.304	1.217	63.298	2.316	120.429		百葉平台	
27		J852-LVA-API-18-1	3.0mm厚鋁板	UCT201498XL(A)-3	26		26	145.190	1.374	35.717	2.618	68.056		百葉平台	
28		J852-LVA-API-18-2	3.0mm厚鋁板	UCT201498XL(A)-3	26		26	132.489	1.254	32.593	2.389	62.102		百葉平台	
29		J852-LVA-API-19-1	3.0mm厚鋁板	UCT201498XL(A)-3	2		2	16.015	1.970	3.940	3.792	7.584		百葉平台	
30		J852-LVA-API-19-2	3.0mm厚鋁板	UCT201498XL(A)-3	2		2	16.387	2.016	4.031	3.880	7.760		百葉平台	
31		J852-LVA-API-20-1	3.0mm厚鋁板	UCT201498XL(A)-3	1		1	8.001	1.968	1.968	3.789	3.789		百葉平台	
32		J852-LVA-API-20-2	3.0mm厚鋁板	UCT201498XL(A)-3	1		1	8.187	2.014	2.014	3.877	3.877		百葉平台	

總計: 430 1201.67 259.60 447.18




美特鋁質 有限公司
MIDI Aluminium Fabricator Ltd.

序號	物料編號	數量	使用位置
01	AP1-01-1	45	工廠組裝百葉窗



工程號	J852	地盤	亞答老街
-----	------	----	------

工廠用

室外

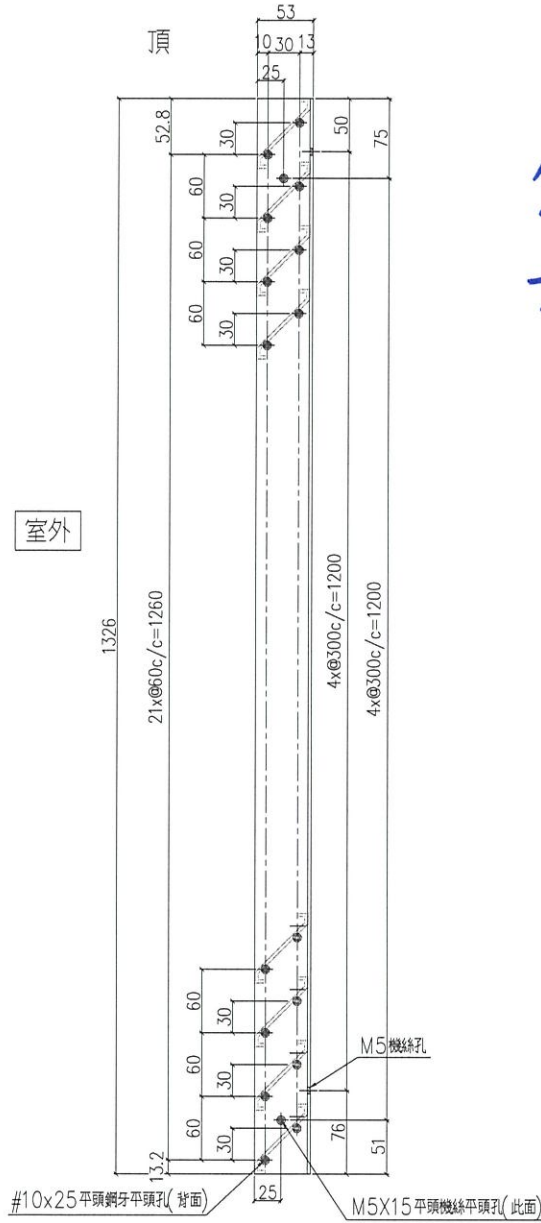

先出10件
其餘接住 生產

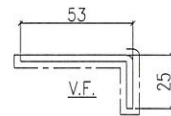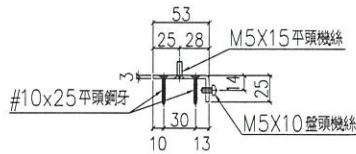

SCALE 2:1

名稱	鋁折件加工圖	制圖	Ivan	2020.11.13	修改		
材料	3mm厚鋁板 (3003H14)	復核	-	-	日期		
顏色	UCT201498XL(A)-3	批准			圖號	J852-LVA-AP1-01-1	





美特鋁質 有限公司
MIDI Aluminium Fabricator Ltd.



序號	物料編號	數量	使用位置
01	AP1-03-2	13	工廠組裝百葉

工程號	J852	地盤	亞答老街
-----	------	----	------

工廠用

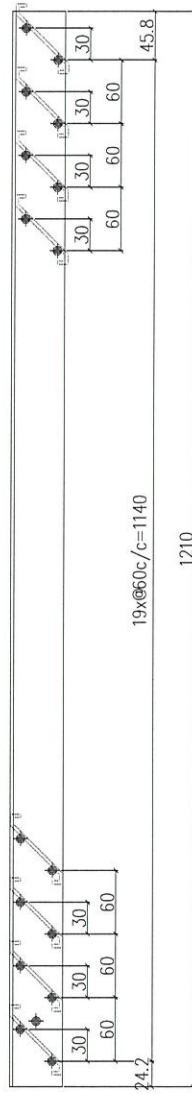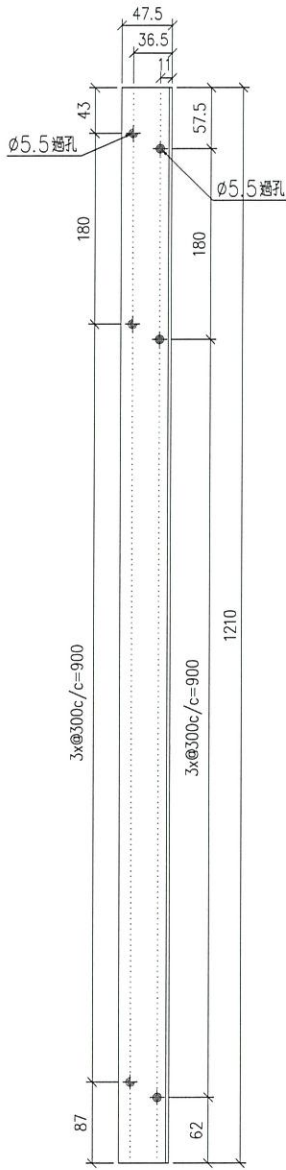

先生產4件
其餘接住生產

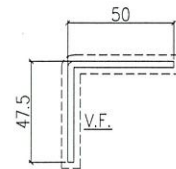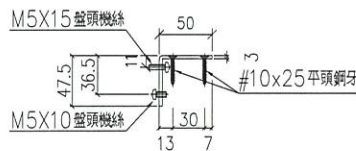

SCALE 2:1

TUC40577-3 (單包)

名稱	鋁折件加工圖	制圖	Ivan	2020.11.13	修改		
材料	3mm厚鋁板 (3003H14)	復核	-	-	日期		
顏色	UCT201498XL(A)-3	批準			圖號	J852-LVA-AP1-03-2	






美特鋁質 有限公司
MIDI Aluminium Fabricator Ltd.

序號	物料編號	數量	使用位置
01	AP1-03-3	2	工廠組裝百葉五

工程號	J852	地盤	亞皆老街
-----	------	----	------

工廠用

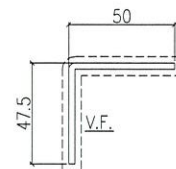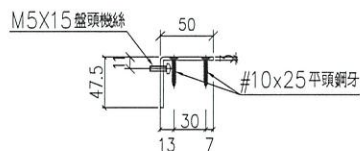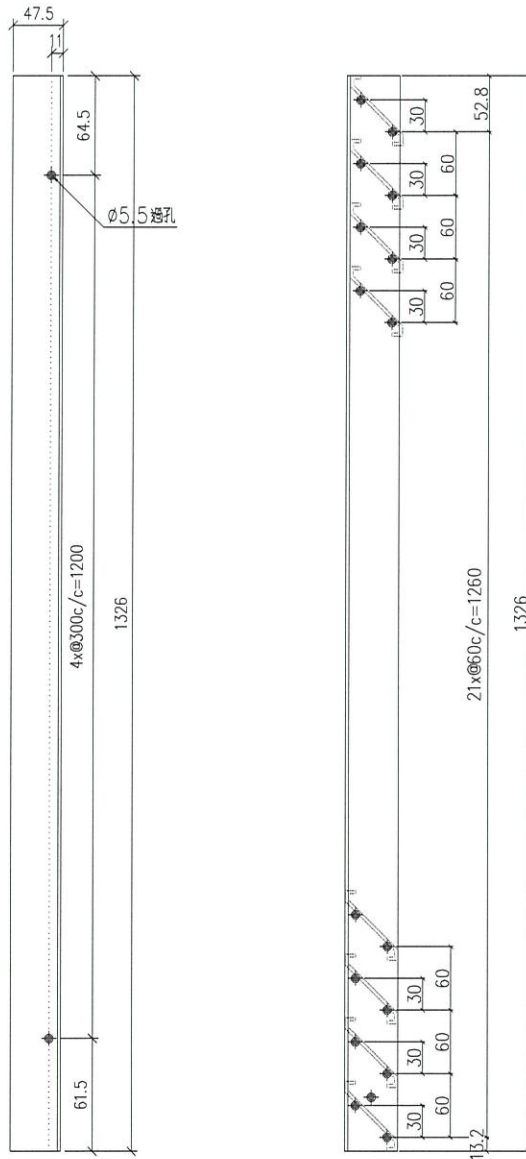

SCALE 2:1

TUC49577-3 (型包)

名稱	鋁折件加工圖	制圖	Ivan	2020.11.13	修改		
材料	3mm厚鋁板 (3003H14)	復核	-	-	日期		
顏色	UCT201498XL(A)-3	批準			圖號	J852-LVA-AP1-03-3	







美特鋁質 有限公司
MIDI Aluminium Fabricator Ltd.

序號	物料編號	數量	使用位置
01	AP1-04-1	13	工廠組裝百葉玉

工程號	J852	地盤	亞答老街
-----	------	----	------



先生產4件
其餘接住生產

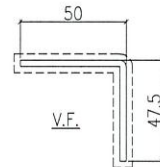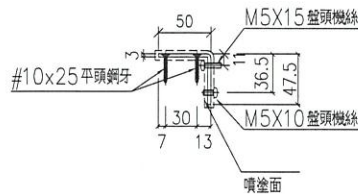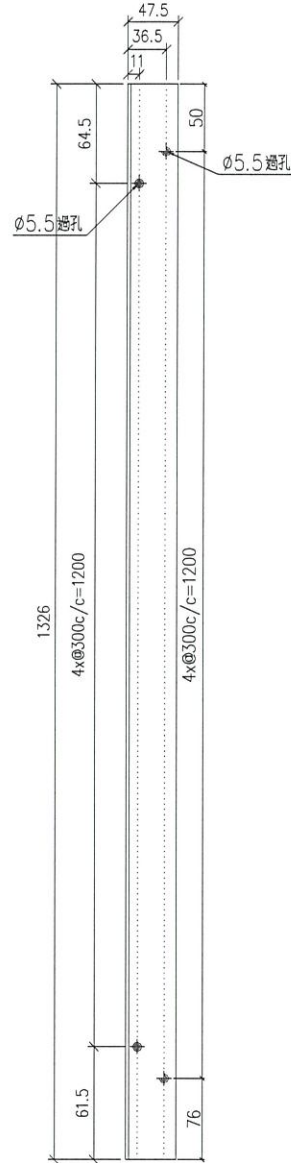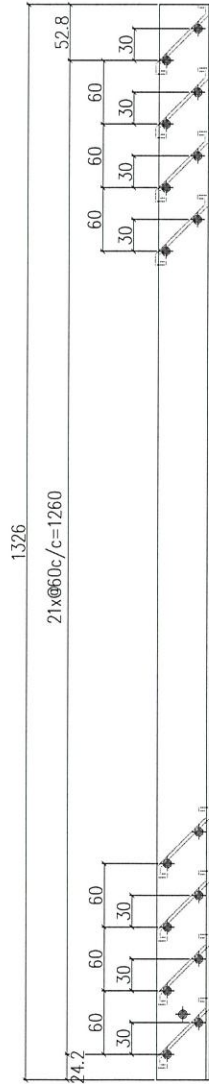

SCALE 2:1

TUC49577-3 (單包)

名稱	鋁折件加工圖	制圖	Ivan	2020.11.13	修改		
材料	3mm厚鋁板 (3003H14)	復核	-	-	日期		
顏色	UCT201498XL(A)-3	批準			圖號	J852-LVA-AP1-04-1	






美特鋁質 有限公司
MIDI Aluminium Fabricator Ltd.

序號	物料編號	數量	使用位置
01	AP1-04-2	13	工廠組裝百葉窗

工程號	J852	地盤	亞皆老街
-----	------	----	------

工廠用

先生產4件
其餘接住生產

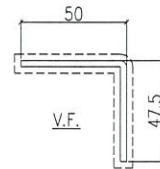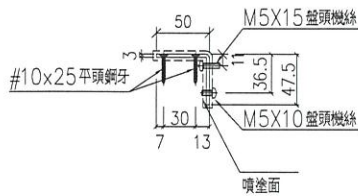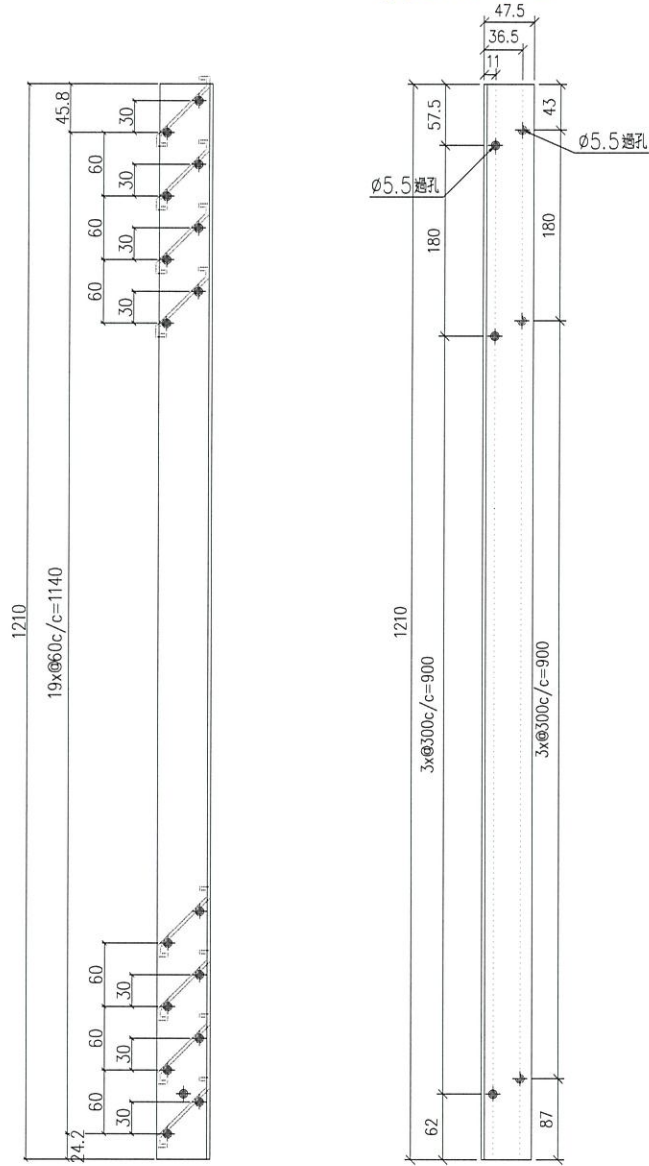

SCALE 2:1

TUC40577-3 (藍色)

名稱	鋁折件加工圖	制圖	Ivan	2020.11.13	修改		
材料	3mm厚鋁板 (3003H14)	復核	-	-	日期		
顏色	UCT201498XL(A) 3	批準			圖號	J852-LVA-AP1-04-2	





美特鋁質 有限公司
MIDI Aluminium Fabricator Ltd.

序號	物料編號	數量	使用位置
01	AP1-04-3	2	工廠組裝百葉窗

工程號	J852	地盤	亞皆老街
-----	------	----	------

工廠用

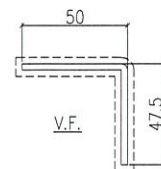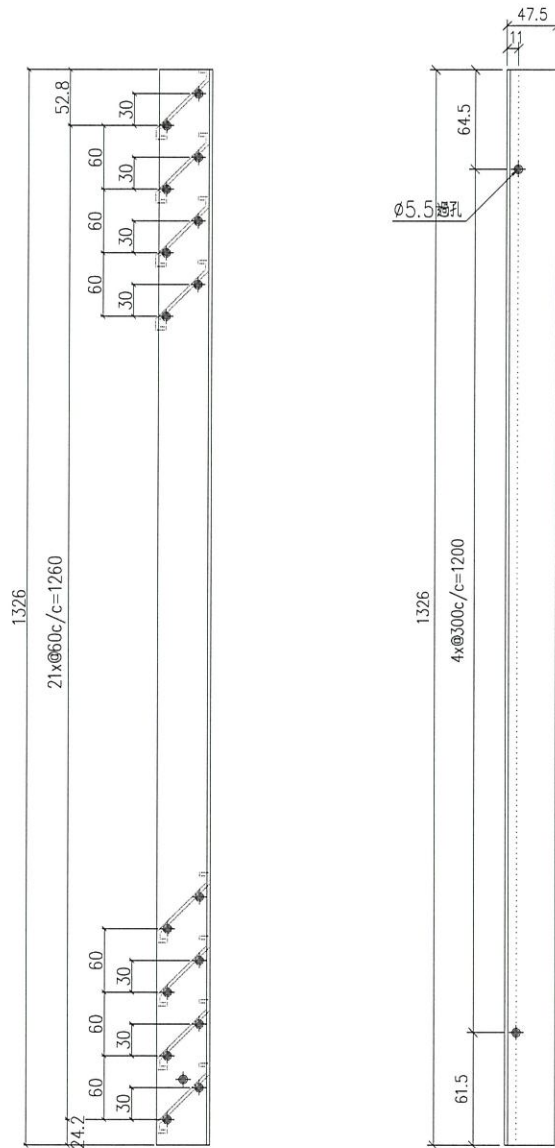

SCALE 2:1

TUC40577-3 (包)

名稱	鋁折件加工圖	制圖	Ivan	2020.11.13	修改		
材料	3mm厚鋁板 (3003H14)	復核	-	-	日期		
顏色	UCT201498XL(A)-3	批準			圖號	J852-LVA-AP1-04-3	






美特鋁質 有限公司
MIDI Aluminium Fabricator Ltd.

序號	物料編號	數量	使用位置
01	AP1-04-4	2	工廠組裝百葉窗

工程號	J852	地盤	亞皆老街
-----	------	----	------

工廠用

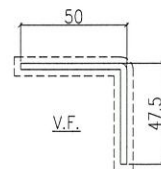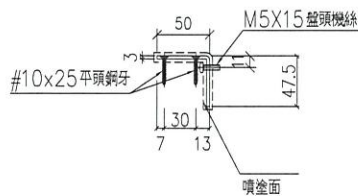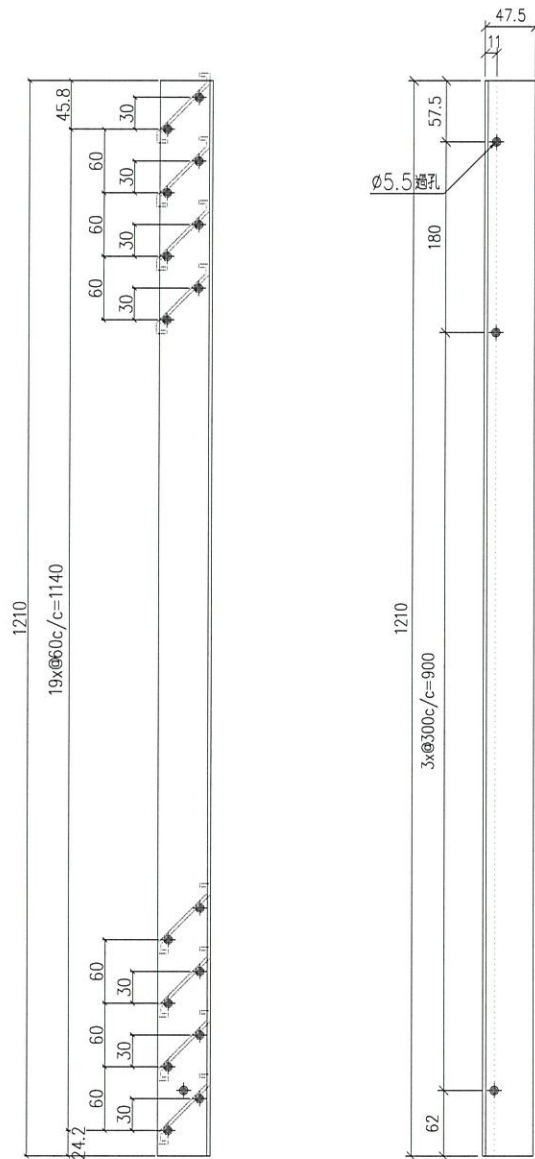

SCALE 2:1

TUC40577-3(藍色)

名稱	鋁折件加工圖	制圖	Ivan	2020.11.13	修改		
材料	3mm厚鋁板 (3003H14)	復核	-	-	日期		
顏色	UCT201498XL(A)-3	批準			圖號	J852-LVA-AP1-04-4	




美特鋁質 有限公司
MIDI Aluminium Fabricator Ltd.



序號	物料編號	數量	使用位置
01	AP1-05-1	3	工廠組裝百葉五

工程號	J852	地盤	亞皆老街
-----	------	----	------

工廠用

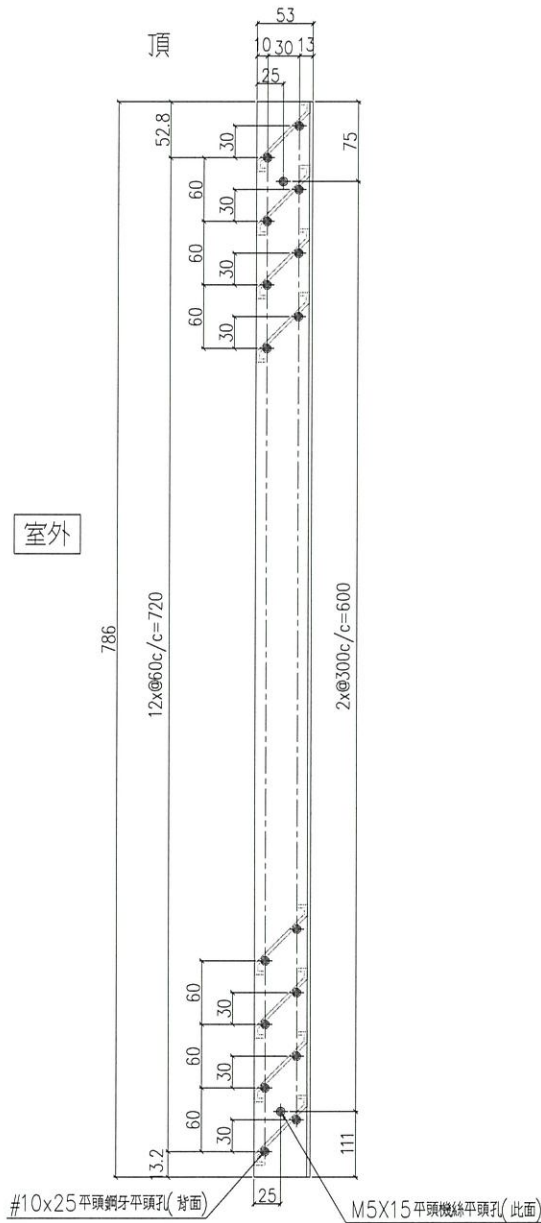

室外

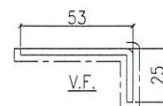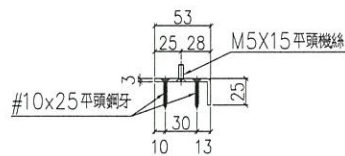

SCALE 2:1

名稱	鋁折件加工圖	制圖	Ivan	2020.11.13	修改		
材料	3mm厚鋁板 (3003H14)	復核	-	-	日期		
顏色	UCT201498XL(A)-3	批準			圖號	J852-LVA-AP1-05-1	






美特鋁質 有限公司
MIDI Aluminium Fabricator Ltd.

序號	物料編號	數量	使用位置
01	AP1-05-2	3	工廠組裝百葉窗

工程號	J852	地盤	亞皆老街
-----	------	----	------

工廠用

室外

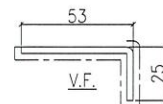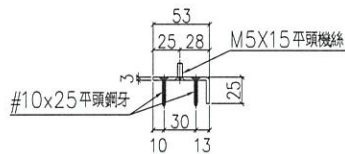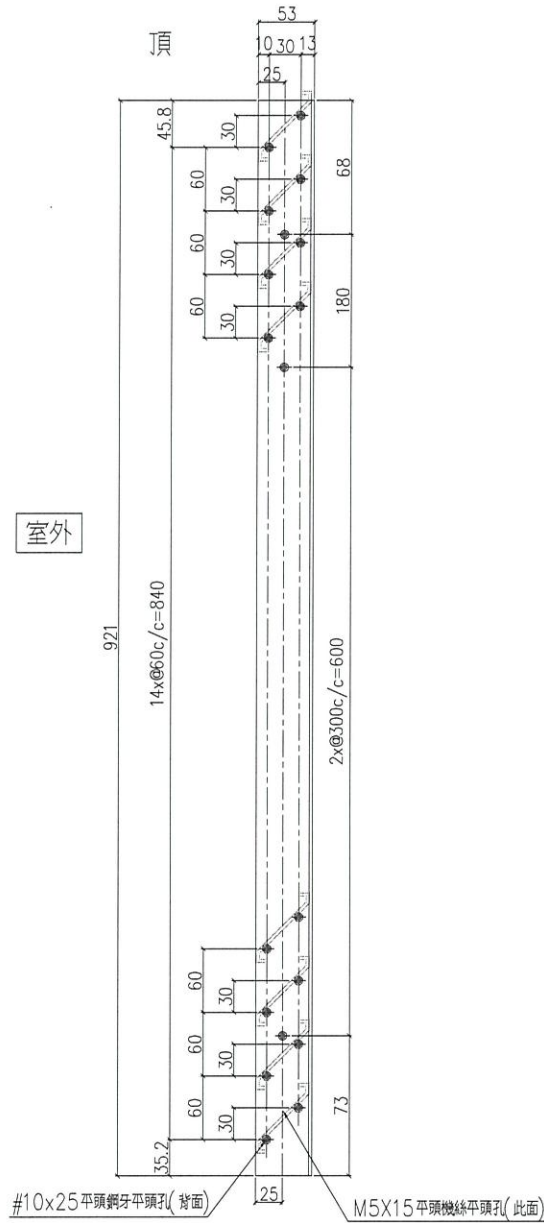

SCALE 2:1

名稱	鋁折件加工圖	制圖	Ivan	2020.11.13	修改		
材料	3mm厚鋁板 (3003H14)	復核	-	-	日期		
顏色	UCT201498XL(A)-3	批準			圖號	J852-LVA-AP1-05-2	






美特鋁質 有限公司
MIDI Aluminium Fabricator Ltd.

序號	物料編號	數量	使用位置	樓層
01	AP1-06-2	3	工廠組裝百葉窗	

工程號	J852	地盤	亞皆老街
-----	------	----	------

工廠用

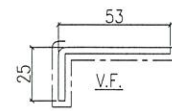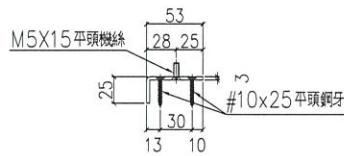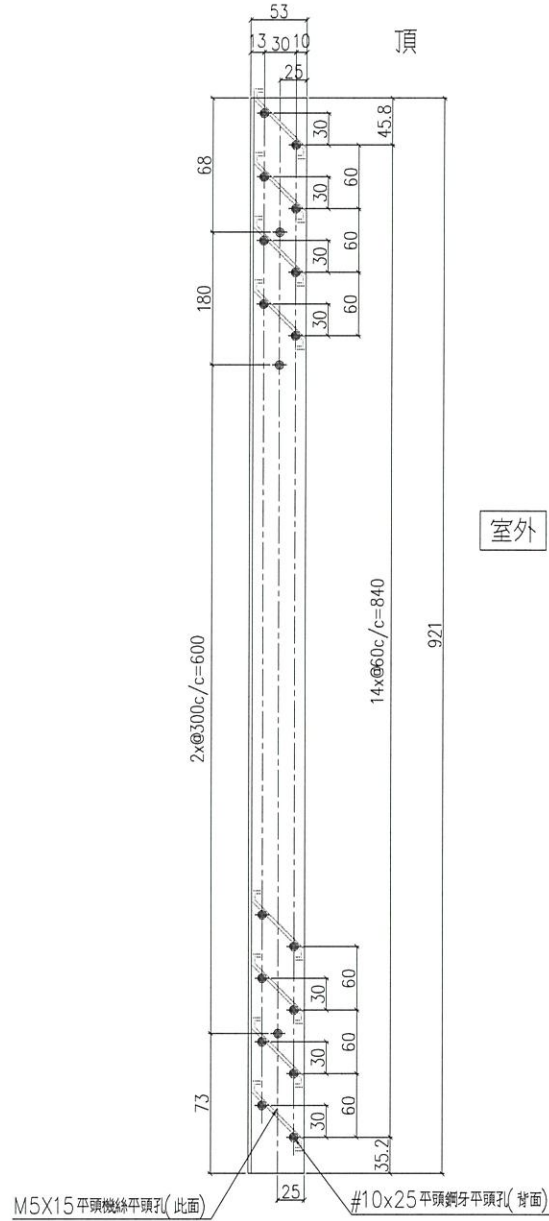

SCALE 2:1




名稱	鋁折件加工圖	制圖	Ivan	2020.11.13	修改		
材料	3mm厚鋁板 (3003H14)	復核	-	-	日期		
顏色	UCT201498XL(A)-3	批準			圖號	J852-LVA-AP1-06-2	



美特鋁質 有限公司
MIDI Aluminium Fabricator Ltd.

序號	物料編號	數量	使用位置
01	AP1-07-1	1	工廠組裝百葉窗

工程號	J852	地盤	亞皆老街
-----	------	----	------

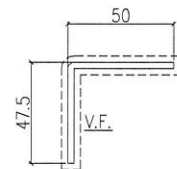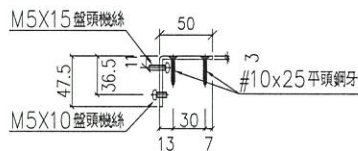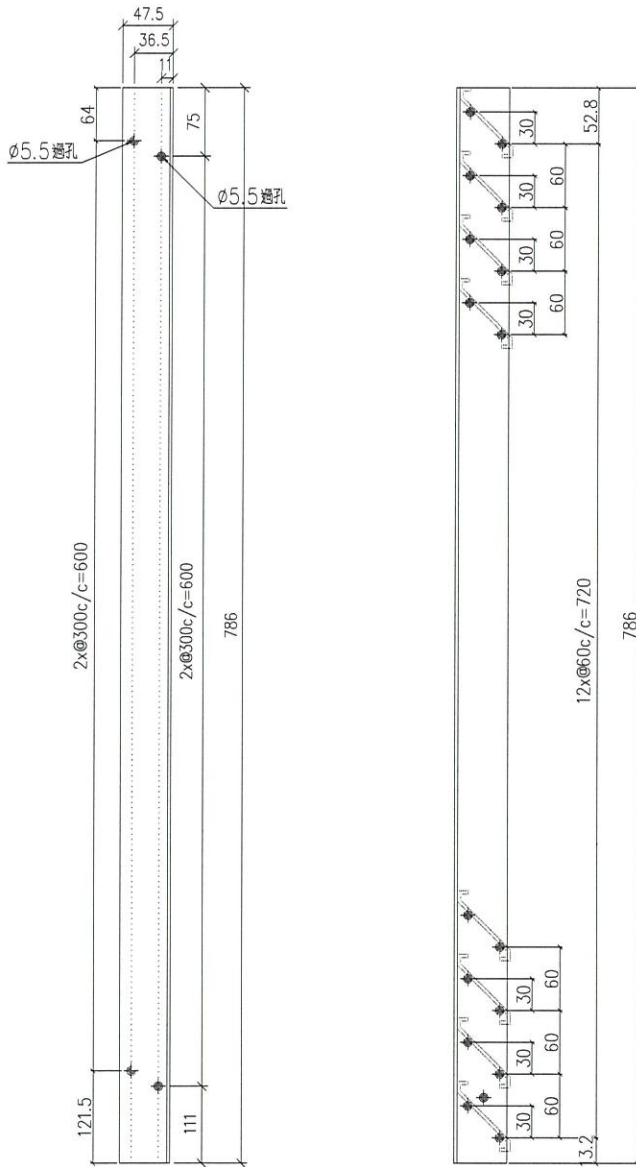

SCALE 2:1

7UC40577-3 (黑色)

名稱	鋁折件加工圖	制圖	Ivan	2020.11.13	修改		
材料	3mm厚鋁板 (3003H14)	復核	-	-	日期		
顏色	UCT201498XL(A)=3	批準			圖號	J852-LVA-AP1-07-1	






美特鋁質 有限公司
MIDI Aluminium Fabricator Ltd.

序號	物料編號	數量	使用位置
01	AP1-07-2	1	工廠組裝百萬玉

工程號 J852 地盤 亞皆老街

工廠用

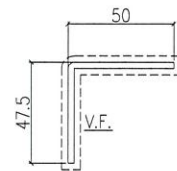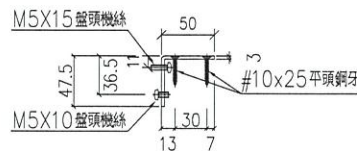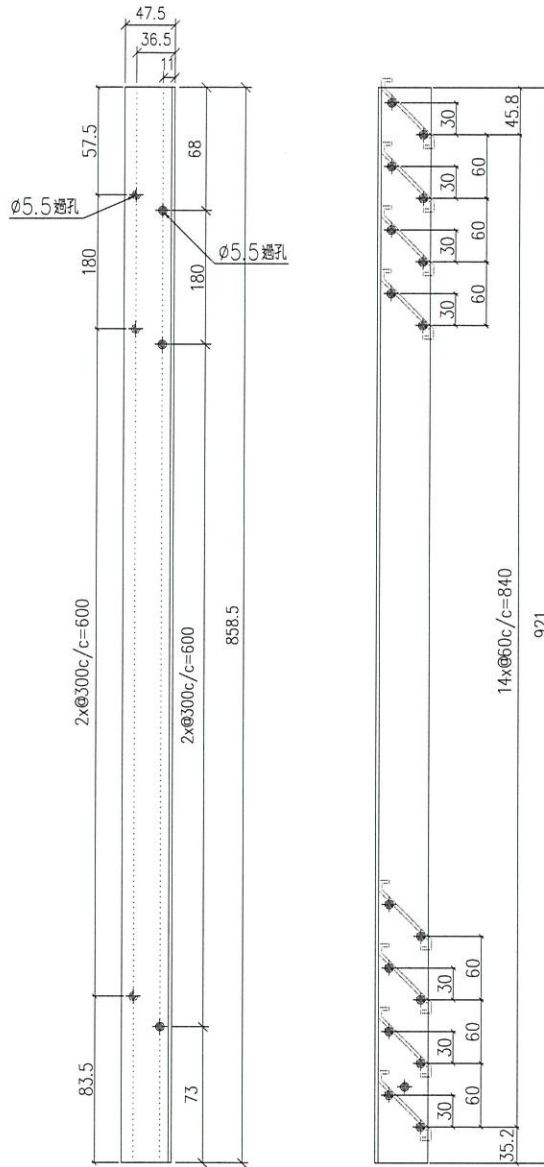

SCALE 2:1

TUC4057子-3(跑)




名稱	鋁折件加工圖	制圖	Ivan	2020.11.13	修改		
材料	3mm厚鋁板 (3003H14)	復核	-	-	日期		
顏色	UCT201498XL(A)-3	批準			圖號	J852-LVA-AP1-07-2	



美特鋁質 有限公司
MIDI Aluminium Fabricator Ltd.

序號	物料編號	數量	使用位置
01	AP1-08-1	1	工廠組裝百葉玉

工程號	J852	地盤	亞答老街
-----	------	----	------

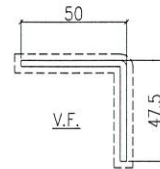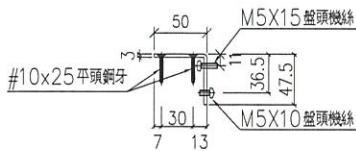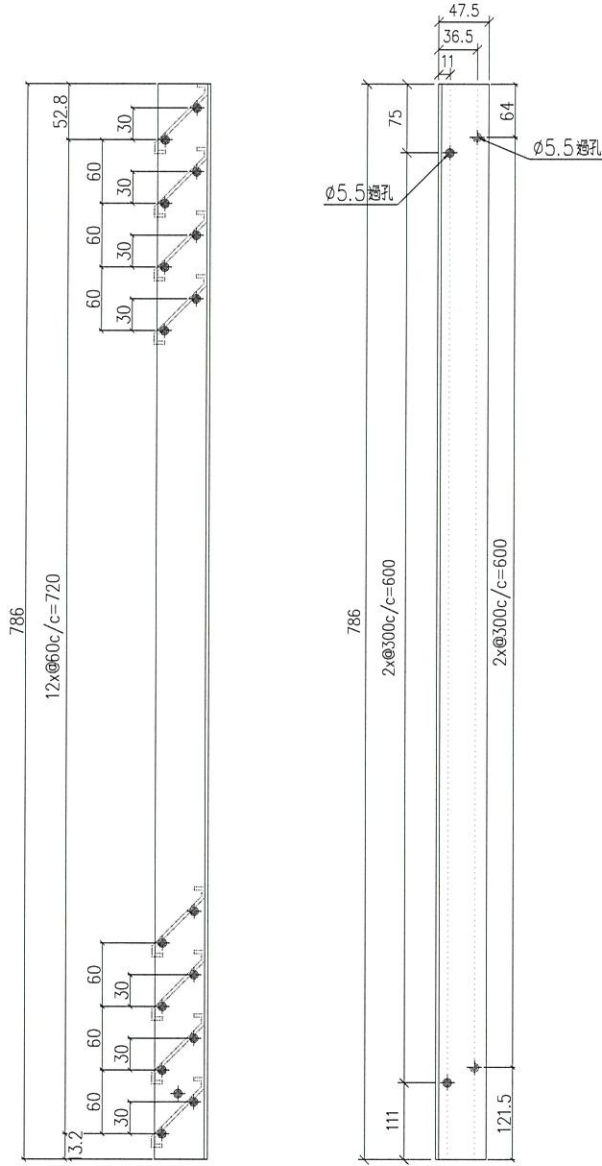

SCALE 2:1

TUC49577-3 (跑)




名稱	鋁折件加工圖	制圖	Ivan	2020.11.13	修改		
材料	3mm厚鋁板 (3003H14)	復核	-	-	日期		
顏色	UCT201498XL(A)-3	批準			圖號	J852-LVA-AP1-08-1	



美特鋁質 有限公司
MIDI Aluminium Fabricator Ltd.

序號	物料編號	數量	使用位置
01	AP1-08-2	1	工廠組裝百葉窗

工程號	J852	地盤	亞答老街
-----	------	----	------

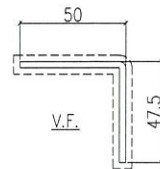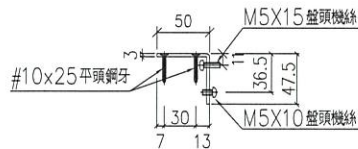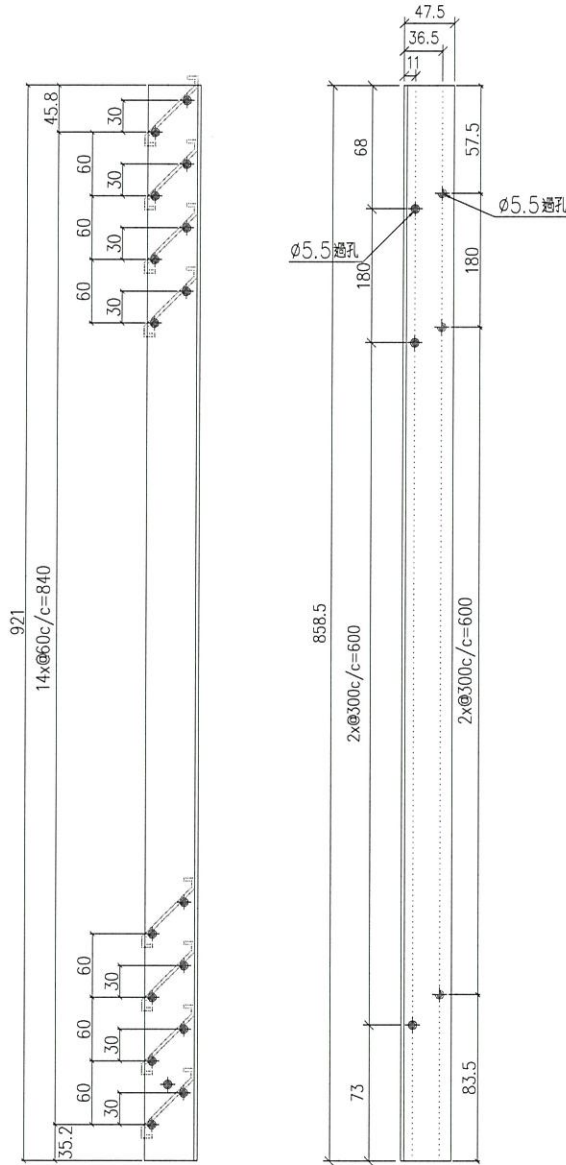

SCALE 2:1

TUC 405 77-3 (雙包)




名稱	鋁折件加工圖	制圖	Ivan	2020.11.13	修改		
材料	3mm厚鋁板 (3003H14)	復核	-	-	日期		
顏色	UCT201498XL(A) 3	批準			圖號	J852-LVA-AP1-08-2	



美特鋁質 有限公司
MIDI Aluminium Fabricator Ltd.

序號	物料編號	數量	使用位置
01	AP1-09-1	3	工廠組裝百葉窗

工程號 J852 地盤 亞皆老街

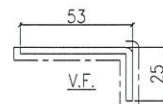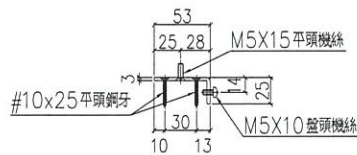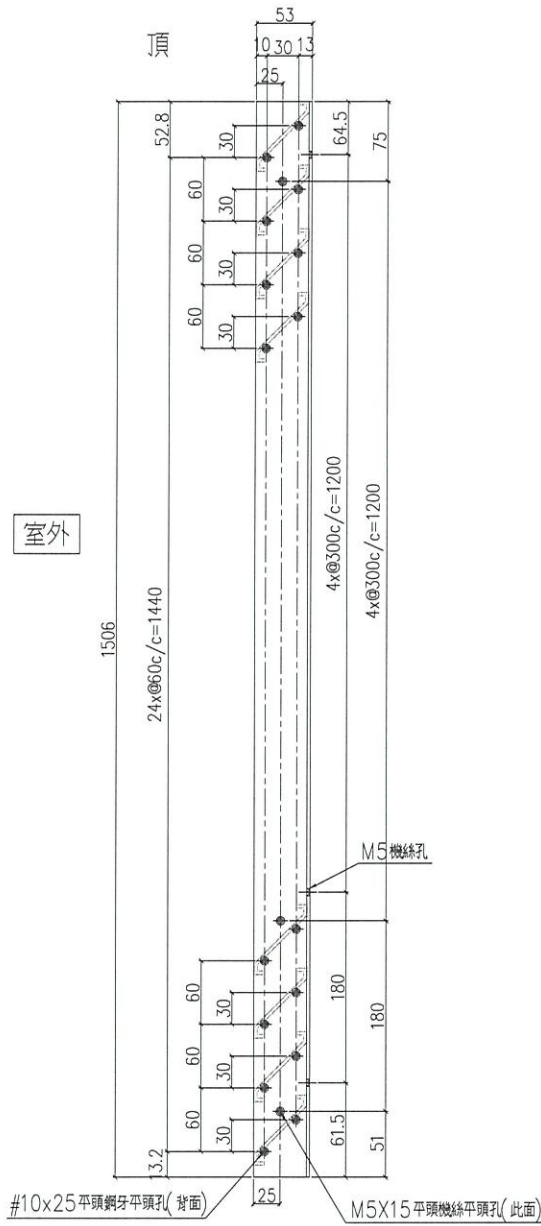

SCALE 2:1

TUC40577-3 (藍色)

名稱	鋁折件加工圖	制圖	Ivan	2020.11.13	修改		
材料	3mm厚鋁板 (3003H14)	復核	-	-	日期		
顏色	UCT201498XL(A)-3	批準			圖號	J852-LVA-AP1-09-1	






美特鋁質 有限公司
MIDI Aluminium Fabricator Ltd.

序號	物料編號	數量	使用位置
01	AP1-09-2	3	工廠組裝百葉窗

工程號	J852	地盤	亞皆老街
-----	------	----	------

工廠用

室外

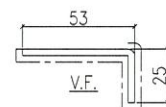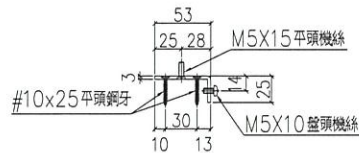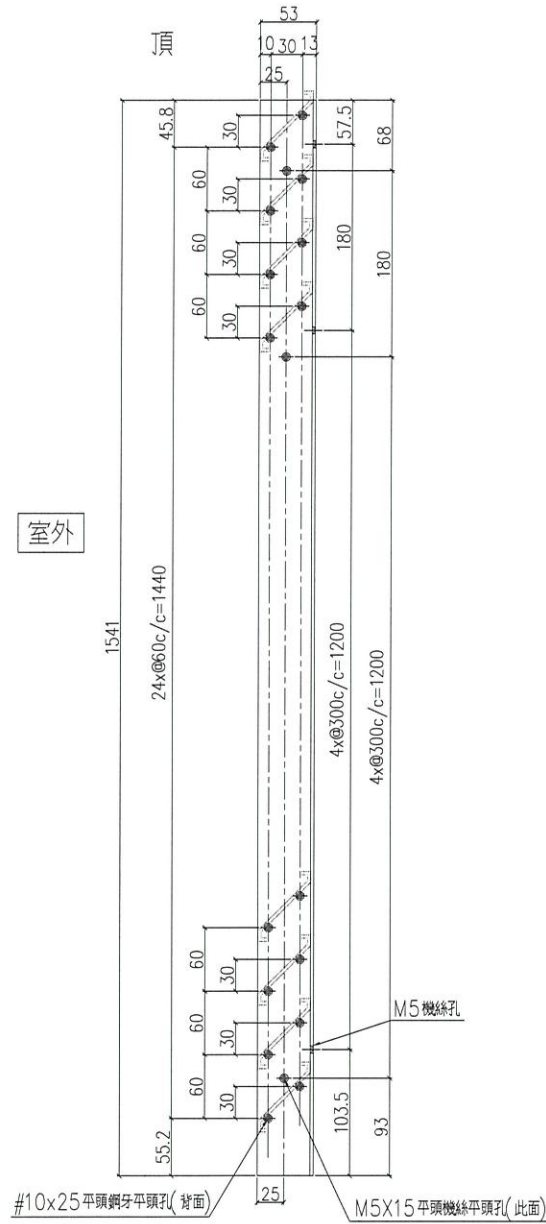

SCALE 2:1

↑ UC40577-3 (跑)

名稱	鋁折件加工圖	制圖	Ivan	2020.11.13	修改		
材料	3mm厚鋁板 (3003H14)	復核	-	-	日期		
顏色	UCT201498XL(A)-3	批準			圖號	J852-LVA-AP1-09-2	





美特鋁質 有限公司
MIDI Aluminium Fabricator Ltd.

序號	物料編號	數量	使用位置	樓層
01	AP1-10-1	3	工廠組裝百葉五	

工程號	J852	地盤	亞皆老街
-----	------	----	------

工廠用

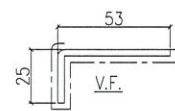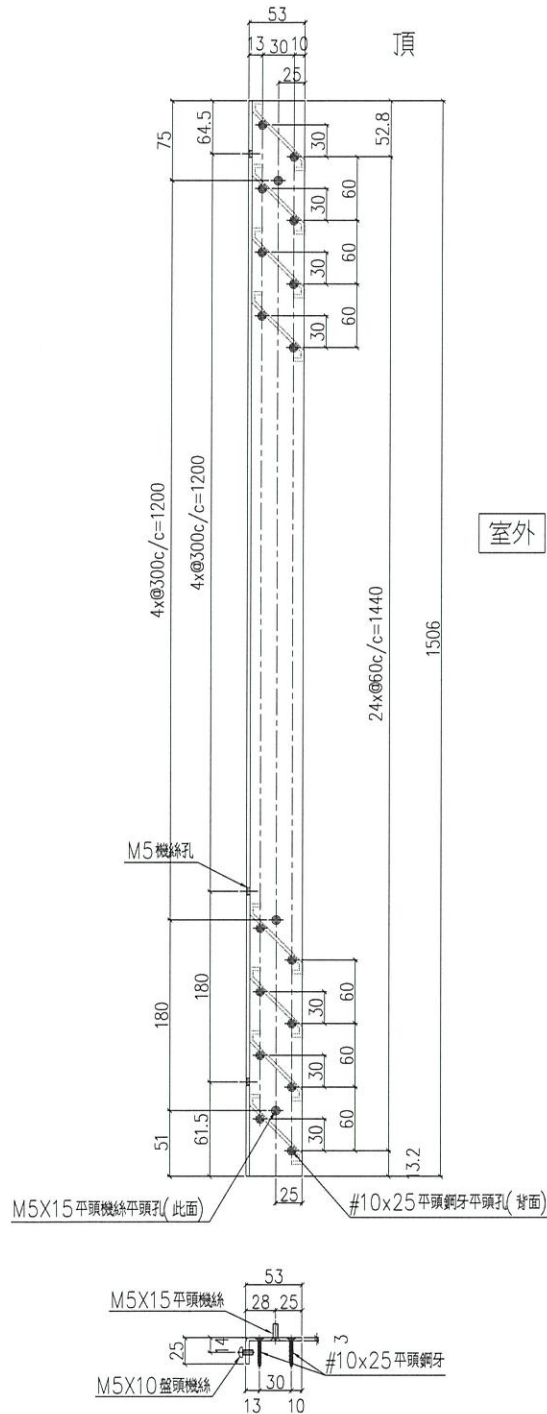

SCALE 2:1

TVC40577-3(單色)

名稱	鋁折件加工圖	制圖	Ivan	2020.11.13	修改		
材料	3mm厚鋁板 (3003H14)	復核	-	-	日期		
顏色	UCT201498XL(A)-3	批准			圖號	J852-LVA-AP1-10-1	




美特鋁質 有限公司
MIDI Aluminium Fabricator Ltd.

序號	物料編號	數量	使用位置	樓層
01	AP1-10-2	3	工廠組裝百葉窗	

工程號	J852	地盤	亞皆老街
-----	------	----	------

工廠用

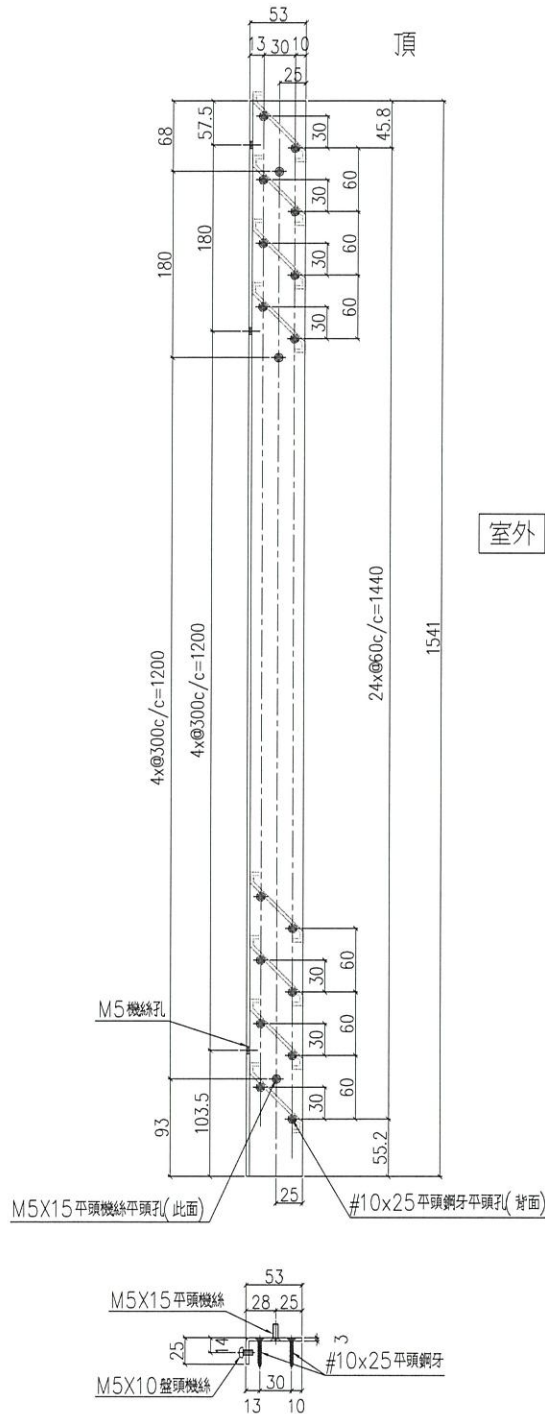

SCALE 2:1

TUC0577-3 (黑色)

名稱	鋁折件加工圖	制圖	Ivan	2020.11.13	修改		
材料	3mm厚鋁板 (3003H14)	復核	-	-	日期		
顏色	UCT201498XL(A)=3	批準			圖號	J852-LVA-AP1-10-2	



美特鋁質 有限公司
MIDI Aluminium Fabricator Ltd.


序號	物料編號	數量	使用位置	樓層
01	AP1-17-1	57	工廠組裝百葉玉	

工程號	J852	地盤	亞皆老街
-----	------	----	------

工廠用

先生產 6 件
其餘接住生產

頂

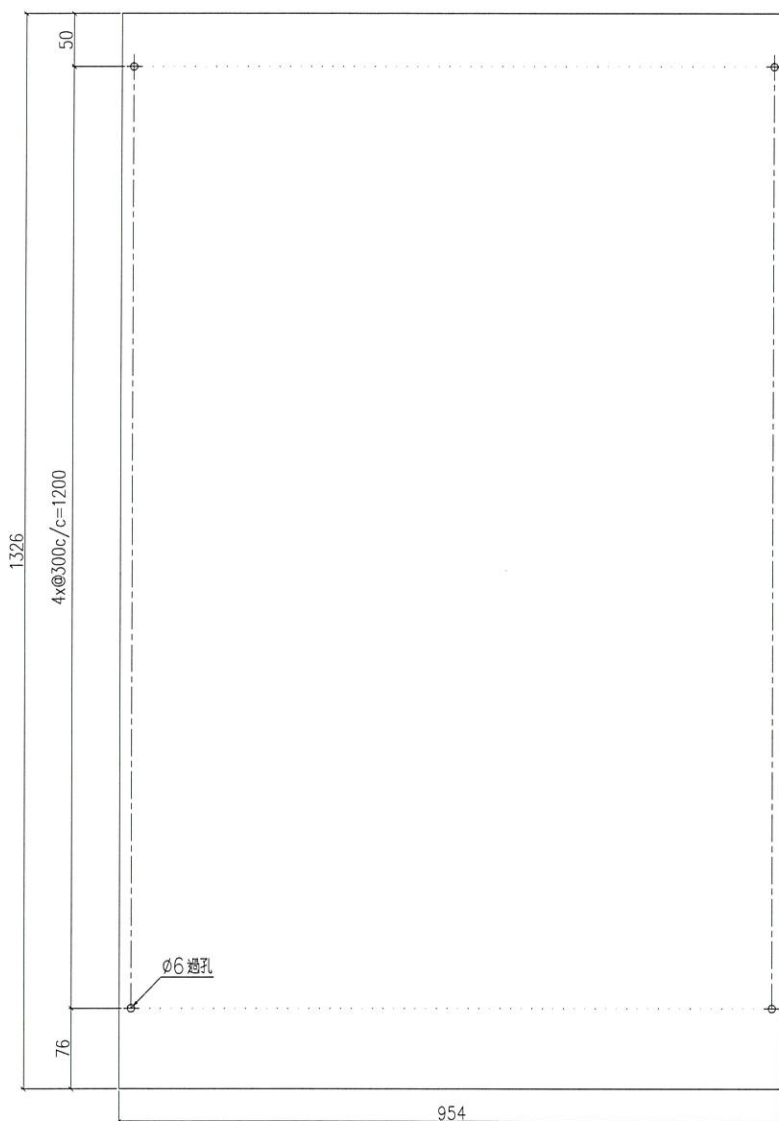

室外

To c 605 77 黑色

名稱	鋁背板加工圖	制圖	Ivan	2020.11.13	修改		
材料	3mm厚鋁板 (3003H14)	復核	-	-	日期		
顏色	UGT201498XL(A)-3	批准			圖號	J852-LVA-AP1-17-1	



美特鋁質 有限公司
MIDI Aluminium Fabricator Ltd.


序號	物料編號	數量	使用位置	樓層
01	AP1-17-2	52	工廠組裝百葉窗	

工程號	J852	地盤	亞皆老街
-----	------	----	------



先生產6件
其餘擔任生產

頂

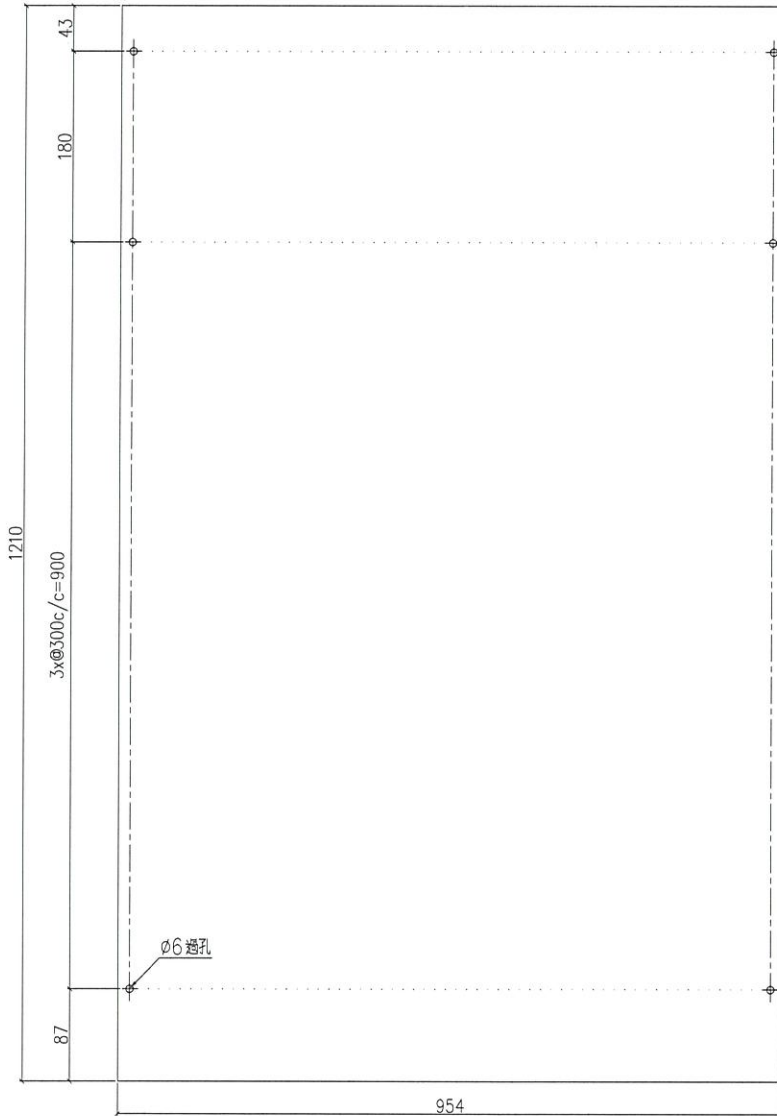

室外

TUC40577-3 藍色

名稱	鋁背板加工圖	制圖	Ivan	2020.11.13	修改		
材料	3mm厚鋁板 (3003H14)	復核	-	-	日期		
顏色	UCT201498XL(A) 3	批准			圖號	J852-LVA-AP1-17-2	

TUC40577-3 (藍色)



美特鋁質 有限公司
MIDI Aluminium Fabricator Ltd.

序號	物料編號	數量	使用位置	樓層
01	AP1-18-1	26	工廠組裝百葉窗	


工程號 J852 地盤 亞皆老街



先生產 8 件
其餘接位生產

(Handwritten signatures and marks)

頂

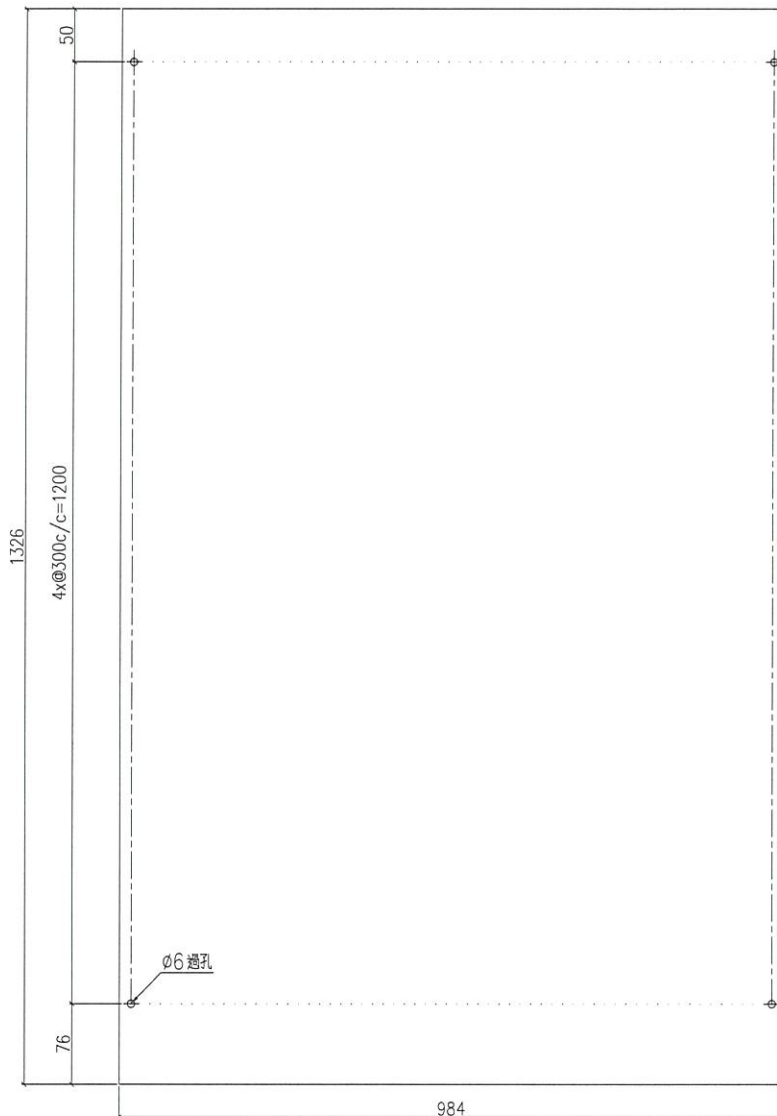

室外

TUC 40577-3 (藍色)

名稱	鋁背板加工圖	制圖	Ivan	2020.11.13	修改		
材料	3mm厚鋁板 (3003H14)	復核	-	-	日期		
顏色	UCT201498XL(A)-3 TUC 40577-3 (藍色)	批准			圖號	J852-LVA-AP1-18-1	



美特鋁質 有限公司
MIDI Aluminium Fabricator Ltd.

序號	物料編號	數量	使用位置	樓層
01	AP1-18-2		工廠組裝百葉玉	

工程號	J852	地盤	亞皆老街
-----	------	----	------


14



工廠用

先生產 8 件
其餘接住生產

頂

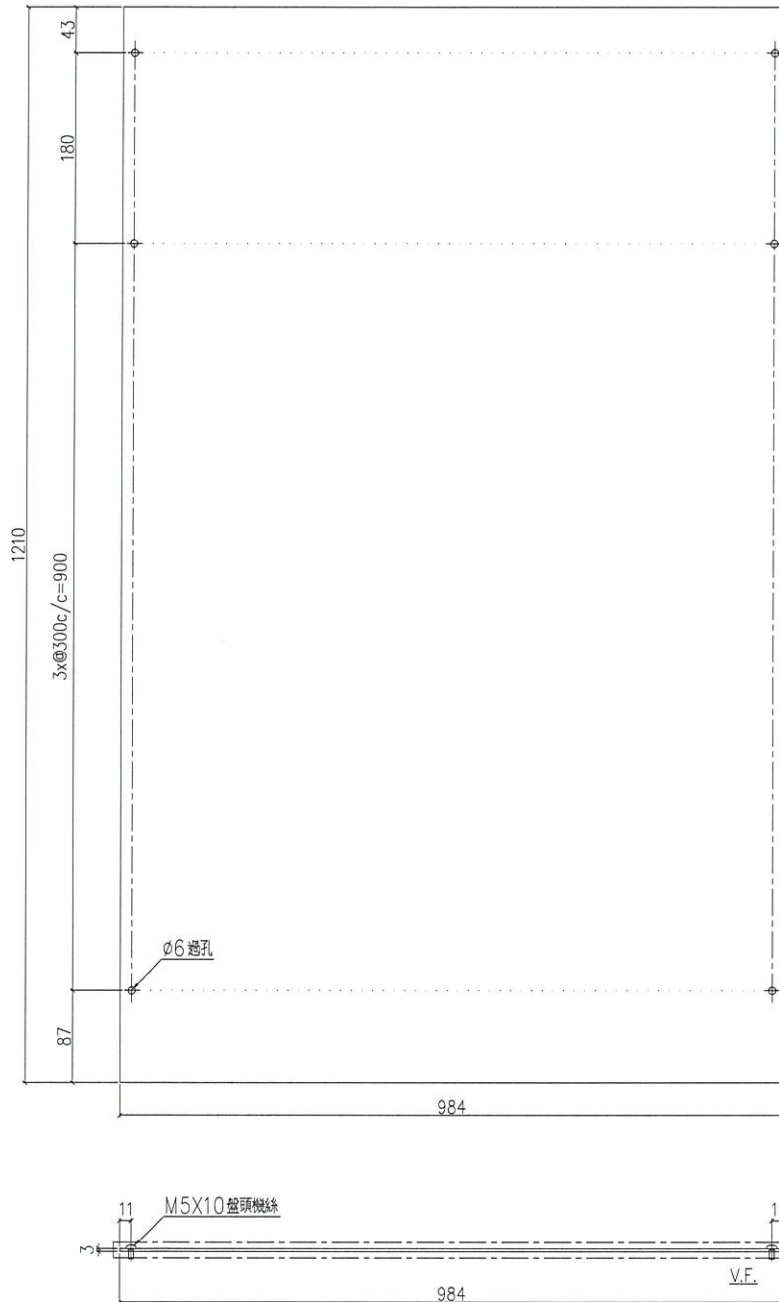

室外

TVC40577-3 (藍色)

名稱	鋁背板加工圖	制圖	Ivan	2020.11.13	修改		
材料	3mm厚鋁板 (3003H14)	復核	-	-	日期		
顏色	UCT201498XL(A)-3-1	批準			圖號	J852-LVA-AP1-18-2	

TVC40577-3 (藍色)




美特鋁質 有限公司
MIDI Aluminium Fabricator Ltd.

序號	物料編號	數量	使用位置	樓層
01	AP1-19-1	2	工廠組裝百葉玉	

工程號	J852	地盤	亞皆老街
-----	------	----	------

工廠用

頂

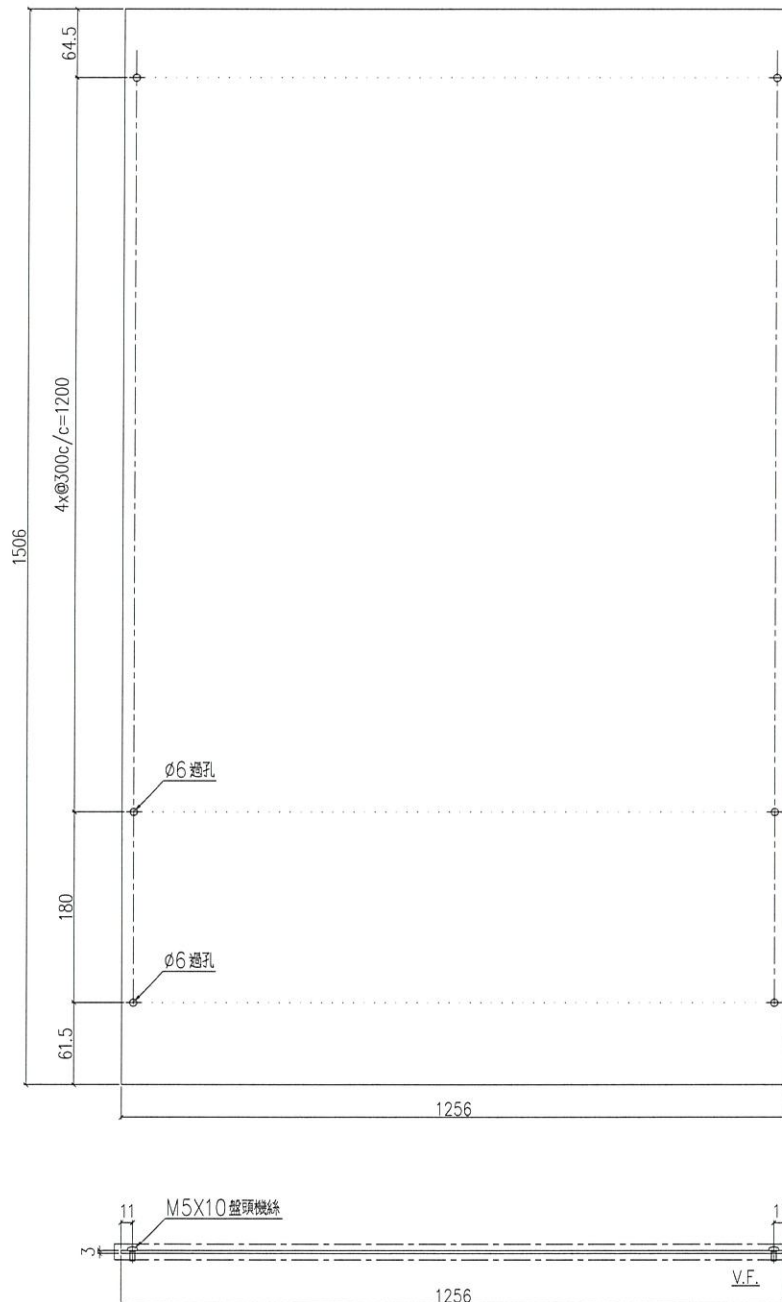

室外

名稱	鋁背板加工圖	制圖	Ivan	2020.11.13	修改		
材料	3mm厚鋁板 (3003H14)	復核	-	-	日期		
顏色	UCT201498XL(A)-3	批準			圖號	J852-LVA-AP1-19-1	




美特鋁質 有限公司
MIDI Aluminium Fabricator Ltd.

序號	物料編號	數量	使用位置	樓層
01	AP1-19-2	2	工廠組裝百葉玉	

工程號	J852	地盤	亞皆老街
-----	------	----	------



頂

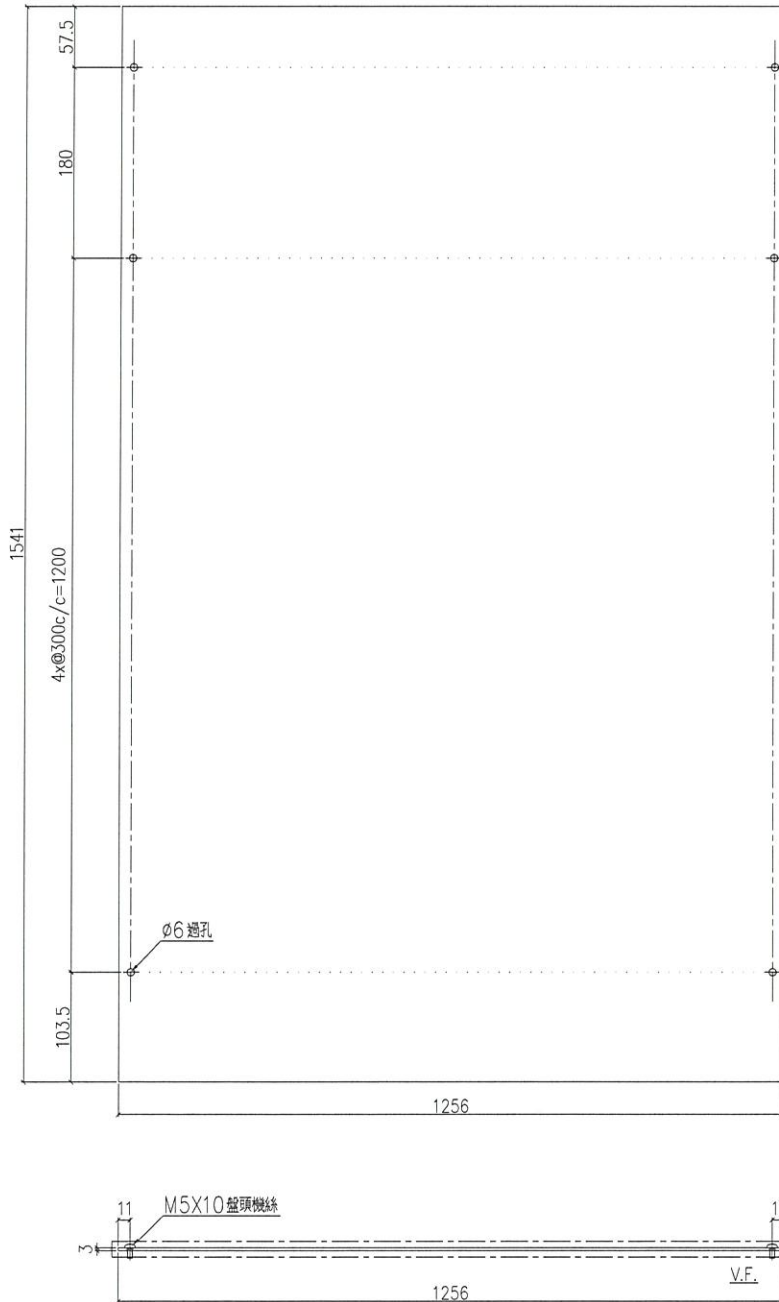

室外

TUC 40577-3 (藍色)

名稱	鋁背板加工圖	制圖	Ivan	2020.11.13	修改		
材料	3mm厚鋁板 (3003H14)	復核	-	-	日期		
顏色	UCT201498XL(A) 3	批準			圖號	J852-LVA-AP1-19-2	




美特鋁質 有限公司
MIDI Aluminium Fabricator Ltd.

序號	物料編號	數量	使用位置	樓層
01	AP1-20-1	1	工廠組裝百葉窗	

工程號	J852	地盤	亞皆老街
-----	------	----	------



頂

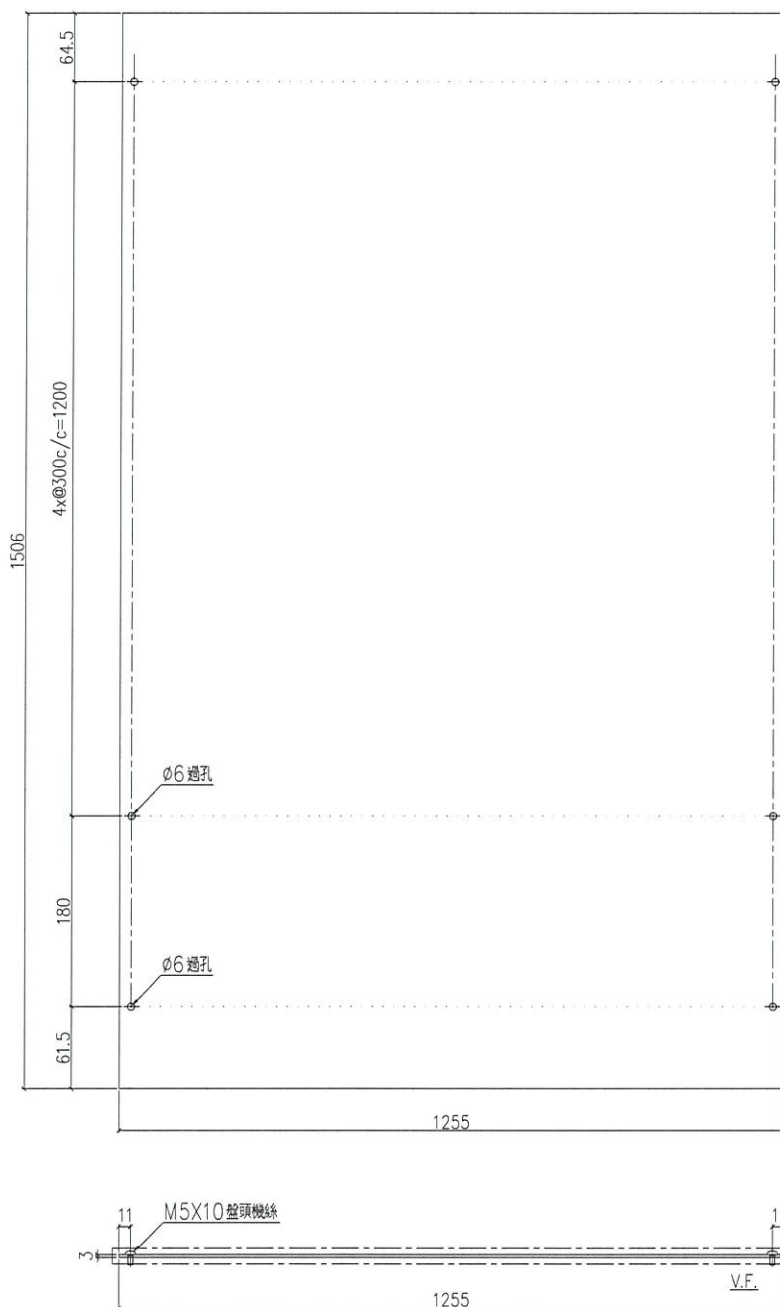

室外

TUC 40577-3 (黑色)

名稱	鋁背板加工圖	制圖	Ivan	2020.11.13	修改		
材料	3mm厚鋁板 (3003H14)	復核	-	-	日期		
顏色	UCT201498XL(A) 3	批準			圖號	J852-LVA-AP1-20-1	




美特鋁質 有限公司
MIDI Aluminium Fabricator Ltd.

序號	物料編號	數量	使用位置	樓層
01	AP1-20-2	1	工廠組裝百葉玉	

工程號	J852	地盤	亞皆老街
-----	------	----	------

工廠用


頂

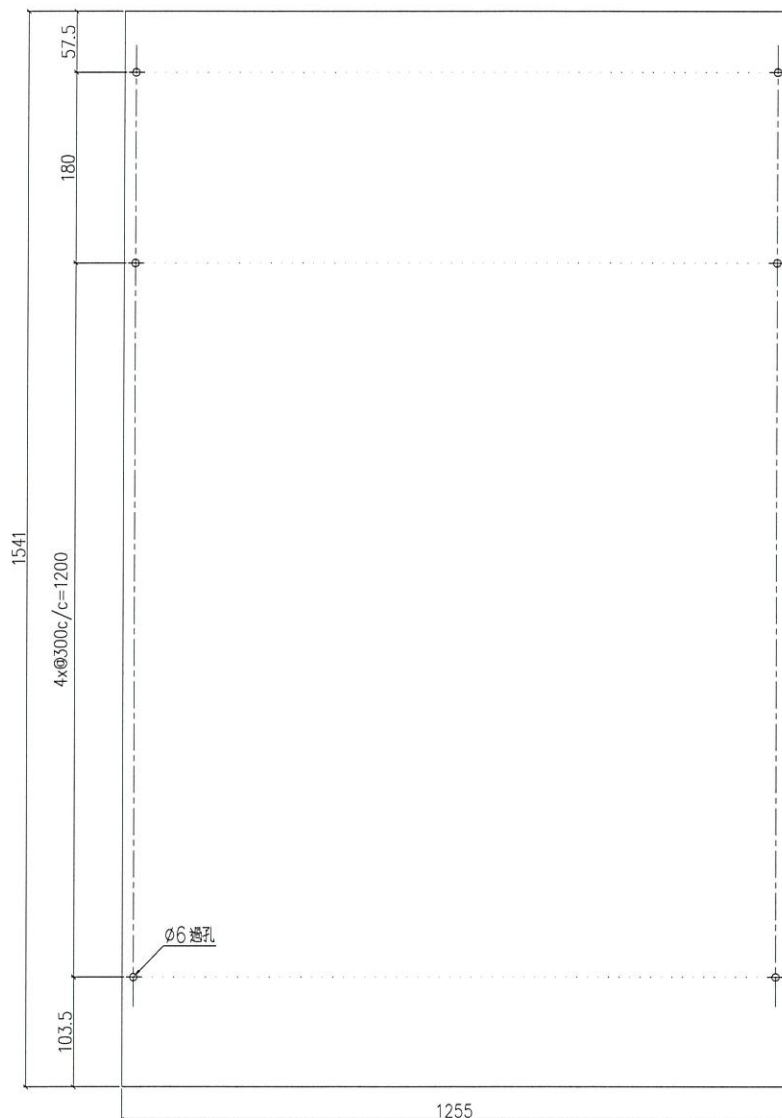


室外

TUC40577-3 (藍色)

名稱	鋁背板加工圖	制圖	Ivan	2020.11.13	修改		
材料	3mm厚鋁板 (3003H14)	復核	-	-	日期		
顏色	UCT201498XL(A)-3	批準			圖號	J852-LVA-AP1-20-2	

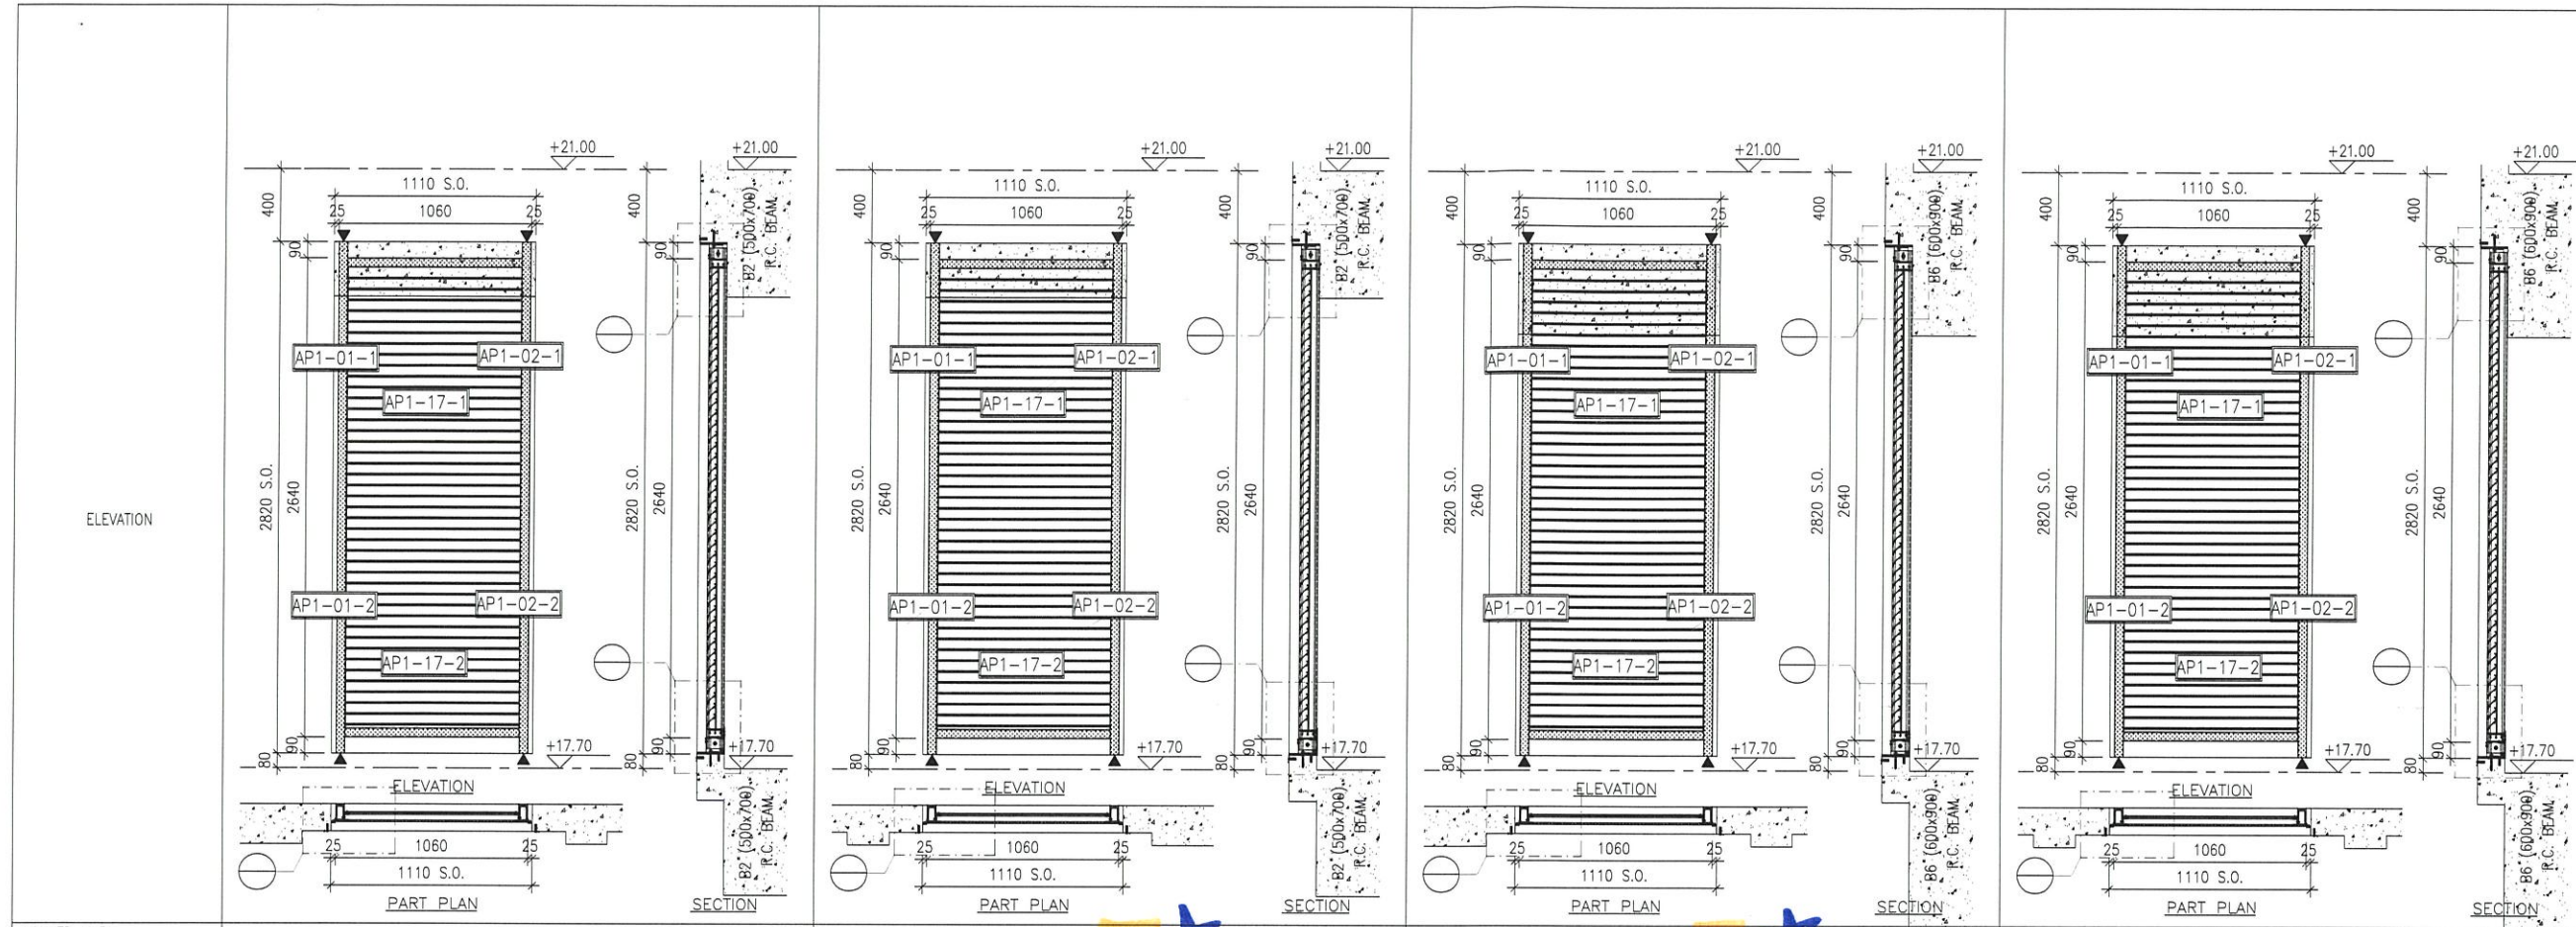

LOUVER MARK	AL-501	AL-501a	AL-501b	AL-501c
LOCATION FLOOR ROOM	LG2/F FAN ROOM	LG2/F EMERGENCY GENSET ROOM	LG2/F EMERGENCY GENSET ROOM	LV SWITCH ROOM 1
QUANTITY	1	1	1	1
REMARKS	WEATHERPROOF LOUVER (60% FREE AREA)	WEATHERPROOF LOUVER (60% FREE AREA)	WEATHERPROOF LOUVER (60% FREE AREA)	WEATHERPROOF LOUVER (60% FREE AREA)

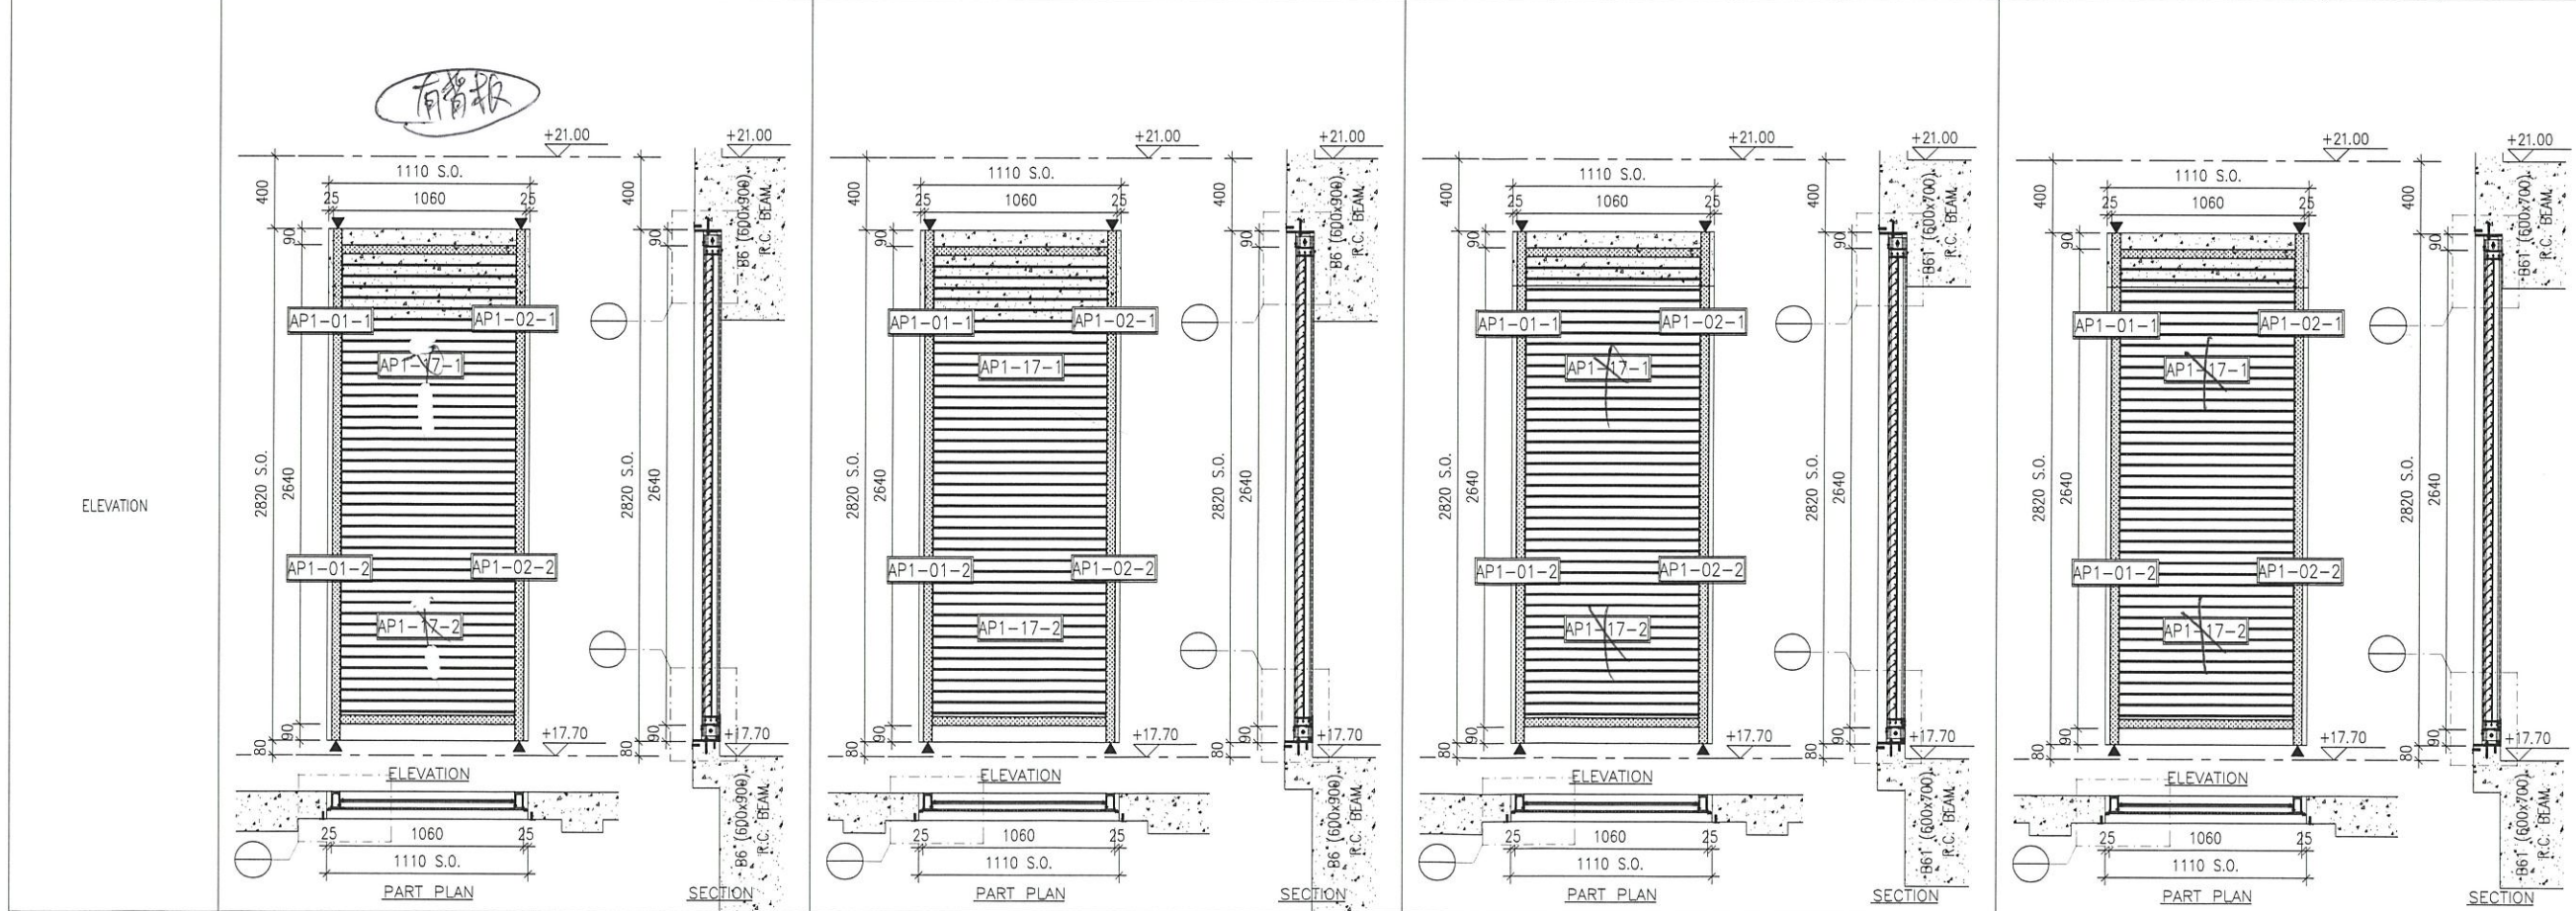

LOUVER MARK	AL-501d	AL-501e	AL-501f	AL-501g
LOCATION FLOOR ROOM	LG2/F LV SWITCH ROOM 1	LG2/F A/C PLANT ROOM	LG2/F A/C PLANT ROOM	LG2/F CARPARK FAN ROOM
QUANTITY	1	1	1	1
REMARKS	WEATHERPROOF LOUVER (60% FREE AREA)	WEATHERPROOF LOUVER (60% FREE AREA)	WEATHERPROOF LOUVER (60% FREE AREA)	WEATHERPROOF LOUVER (60% FREE AREA)

B.D. REF :

CLIENT :

ARCHITECT : **AGC DESIGN LTD**

MAIN CONTRACTOR : **Gammon**

STRUCTURAL ENGINEER : **ARUP**

FAÇADE CONSULTANT : **MEINHARDT**

NOTE :

- ALL DIMENSIONS ARE IN mm.
- ALL ELEVATIONS ARE VIEWED FROM OUTSIDE.
- ALL DIMENSIONS TO BE VERIFIED ON SITE BEFORE FABRICATION.

LEGEND :

x1 — DETAIL MARK NO.
x001 — REFER SHEET NO.

- F.F.L. — FINISHED FLOOR LEVEL
- S.F.L. — STRUCTURAL FLOOR LEVEL
- S.O. — STRUCTURAL OPENING
- ▲ — FIXING LOCATION
- ▽ — STRUCTURAL FLOOR LEVEL MARK

C	05-06-2020	REVISION SUBJECT TO COMMENTS	MN
B	27-04-2020	REVISION SUBJECT TO COMMENTS	MN
A	19-02-2020	REVISION SUBJECT TO COMMENTS	MN
NO.	DATE	REVISED	BY

JOB NO. : J-852

PROJECT : PROPOSED RESIDENTIAL DEVELOPMENT AT 139 - 147 ARGYLE STREET, NKIL 6005, 6035 R.P., 6036 R.P., 6037 R.P. & 6038 R.P.

TITLE : LOUVER SCHEDULE FOR ALUM. LOUVER




DATE : 12-Feb-2020 SCALE : 1:40

DRAWN BY : LHR CHECKED BY : DW

美特鋁質有限公司
MIDI ALUMINUM FABRICATOR LTD.
Units 6-8, Sunray Industrial Centre, 1/F
610 Cha Kwo Ling Road, Kowloon
Tel:23489211-4 Fax:(852)27727666

DWG NO. : J852-SD-LVA-4001 REV. : C

ELEVATION

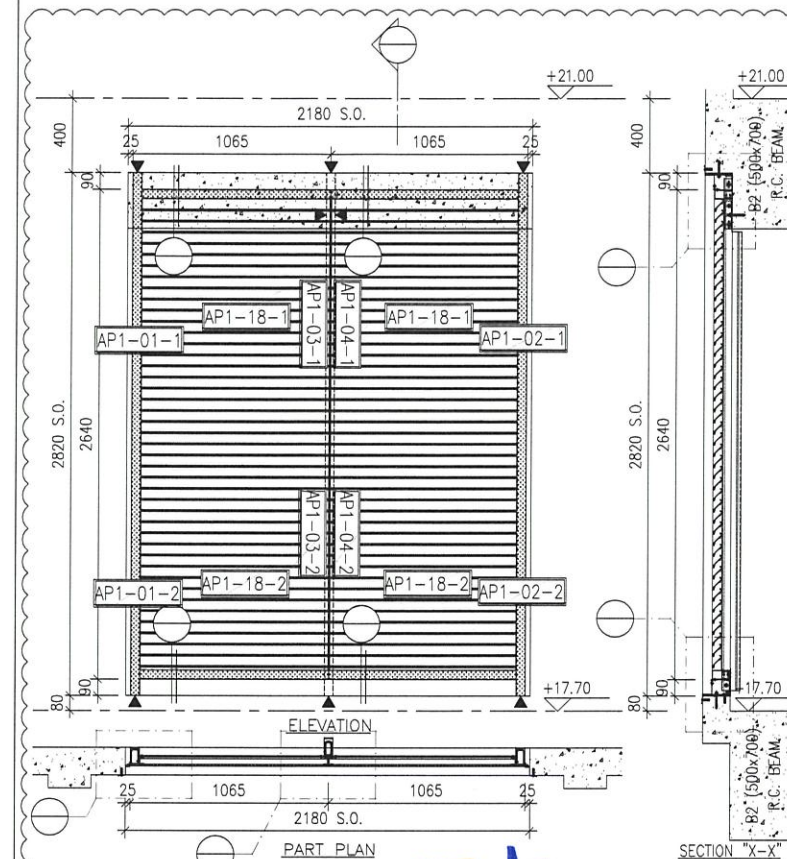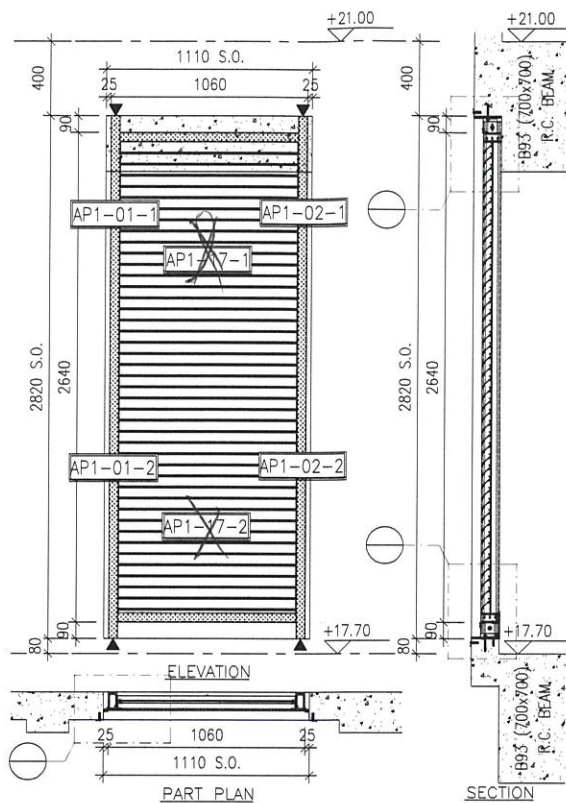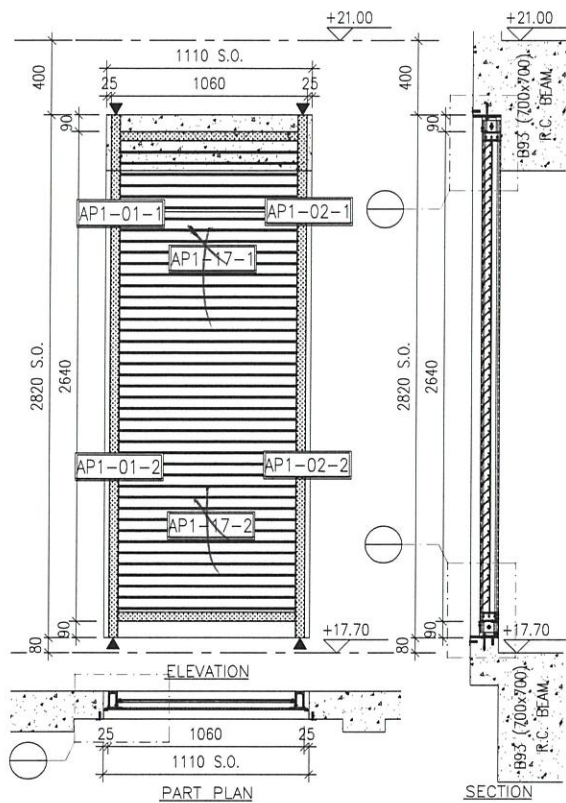

LOUVER MARK	AL-501h
FLOOR ROOM	LG2/F CARPARK
QUANTITY	1
REMARKS	WEATHERPROOF LOUVER (60% FREE AREA)


LOUVER MARK	AL-501j
FLOOR ROOM	LG2/F CARPARK
QUANTITY	1
REMARKS	WEATHERPROOF LOUVER (60% FREE AREA)

LOUVER MARK	AL-502
FLOOR ROOM	EMERGENCY GENSET ROOM
QUANTITY	1
REMARKS	WEATHERPROOF LOUVER (60% FREE AREA)

CLIENT :


ARCHITECT :
AGC DESIGN LTD
 181, 183, 185, 4075, 407

ELEVATION

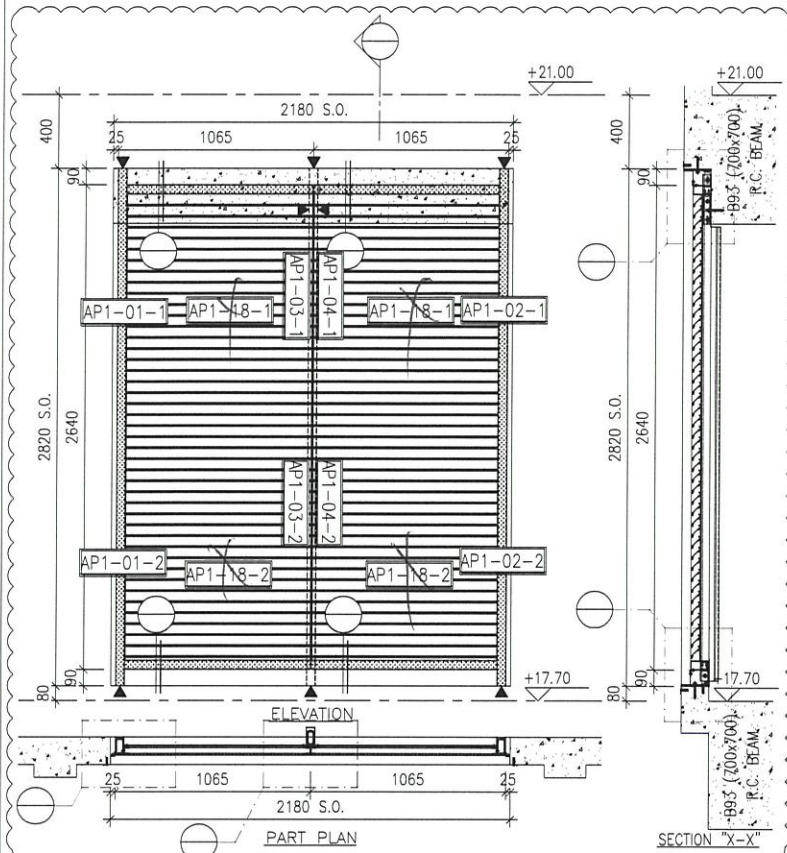


LOUVER MARK	AL-502d
LOCATION	LG2/F
FLOOR ROOM	CARPARK
QUANTITY	1
REMARKS	WEATHERPROOF LOUVER (60% FREE AREA)

ELEVATION

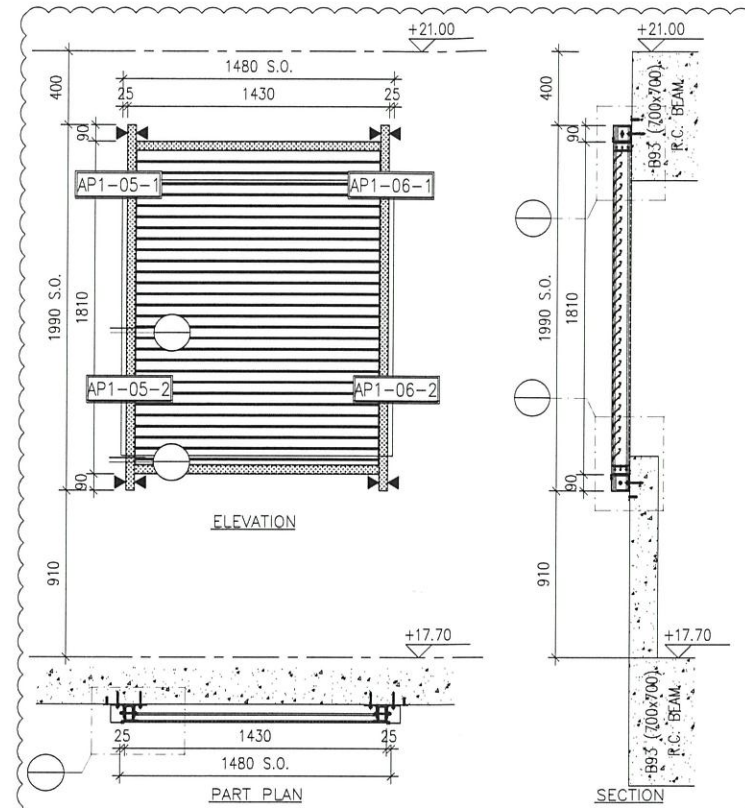


LOUVER MARK	AL-503
LOCATION	LG2/F
FLOOR ROOM	CAR RAMP
QUANTITY	1
REMARKS	WEATHERPROOF LOUVER (60% FREE AREA)

ELEVATION

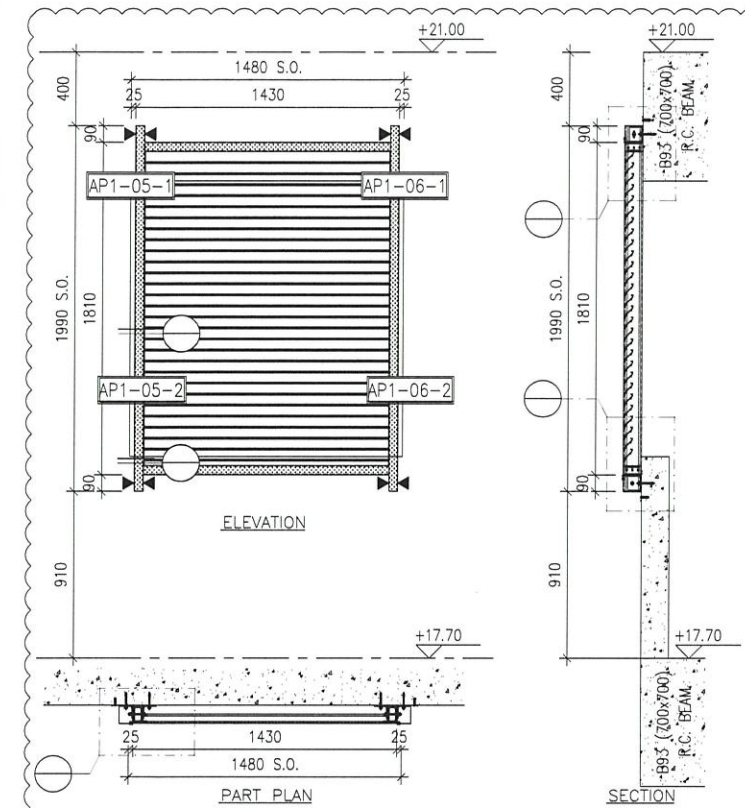

LOUVER MARK	AL-503g
LOCATION	LG2/F
FLOOR ROOM	CAR RAMP
QUANTITY	1
REMARKS	WEATHERPROOF LOUVER (60% FREE AREA)

ELEVATION

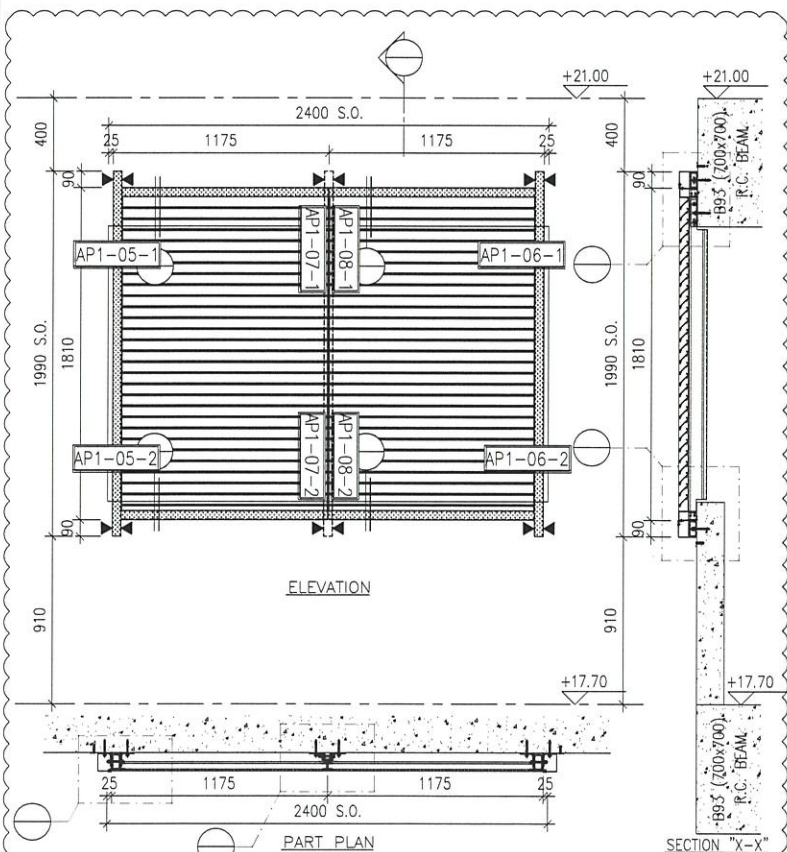

LOUVER MARK	AL-504
LOCATION	LG2/F
FLOOR ROOM	CAR RAMP
QUANTITY	1
REMARKS	WEATHERPROOF LOUVER (60% FREE AREA)

B.D. REF :

CLIENT :

ARCHITECT :



MAIN CONTRACTOR :



STRUCTURAL ENGINEER :



FACADE CONSULTANT :



NOTE :

1. ALL DIMENSIONS ARE IN mm.
2. ALL ELEVATIONS ARE VIEWED FROM OUTSIDE.
3. ALL DIMENSIONS TO BE VERIFIED ON SITE BEFORE FABRICATION.

LEGEND :

- X1 — DETAIL MARK NO.
- X001 — REFER SHEET NO.

1. F.F.L. --- FINISHED FLOOR LEVEL
2. S.F.L. --- STRUCTURAL FLOOR LEVEL
3. S.O. --- STRUCTURAL OPENING
4. ▲ --- FIXING LOCATION
5. ▽ --- STRUCTURAL FLOOR LEVEL MARK

NO.	DATE	REVISION	BY
D	29-10-2020	REVISION SUBJECT TO COMMENTS	MN
C	05-06-2020	REVISION SUBJECT TO COMMENTS	MN
B	27-04-2020	REVISION SUBJECT TO COMMENTS	MN
A	19-02-2020	REVISION SUBJECT TO COMMENTS	MN

JOB NO. : J-852

PROJECT :
PROPOSED RESIDENTIAL DEVELOPMENT
AT 139 - 147 ARGYLE STREET,
NKIL 6005, 6035 R.P., 6036 R.P.,
6037 R.P. & 6038 R.P.


TITLE :
LOUVER SCHEDULE FOR
ALUM. LOUVER

DATE : 12-Feb-2020 SCALE : 1:40


DRAWN BY : LHR CHECKED BY : DW



DWG NO. : J852-SD-LVA-4003 REV. : D

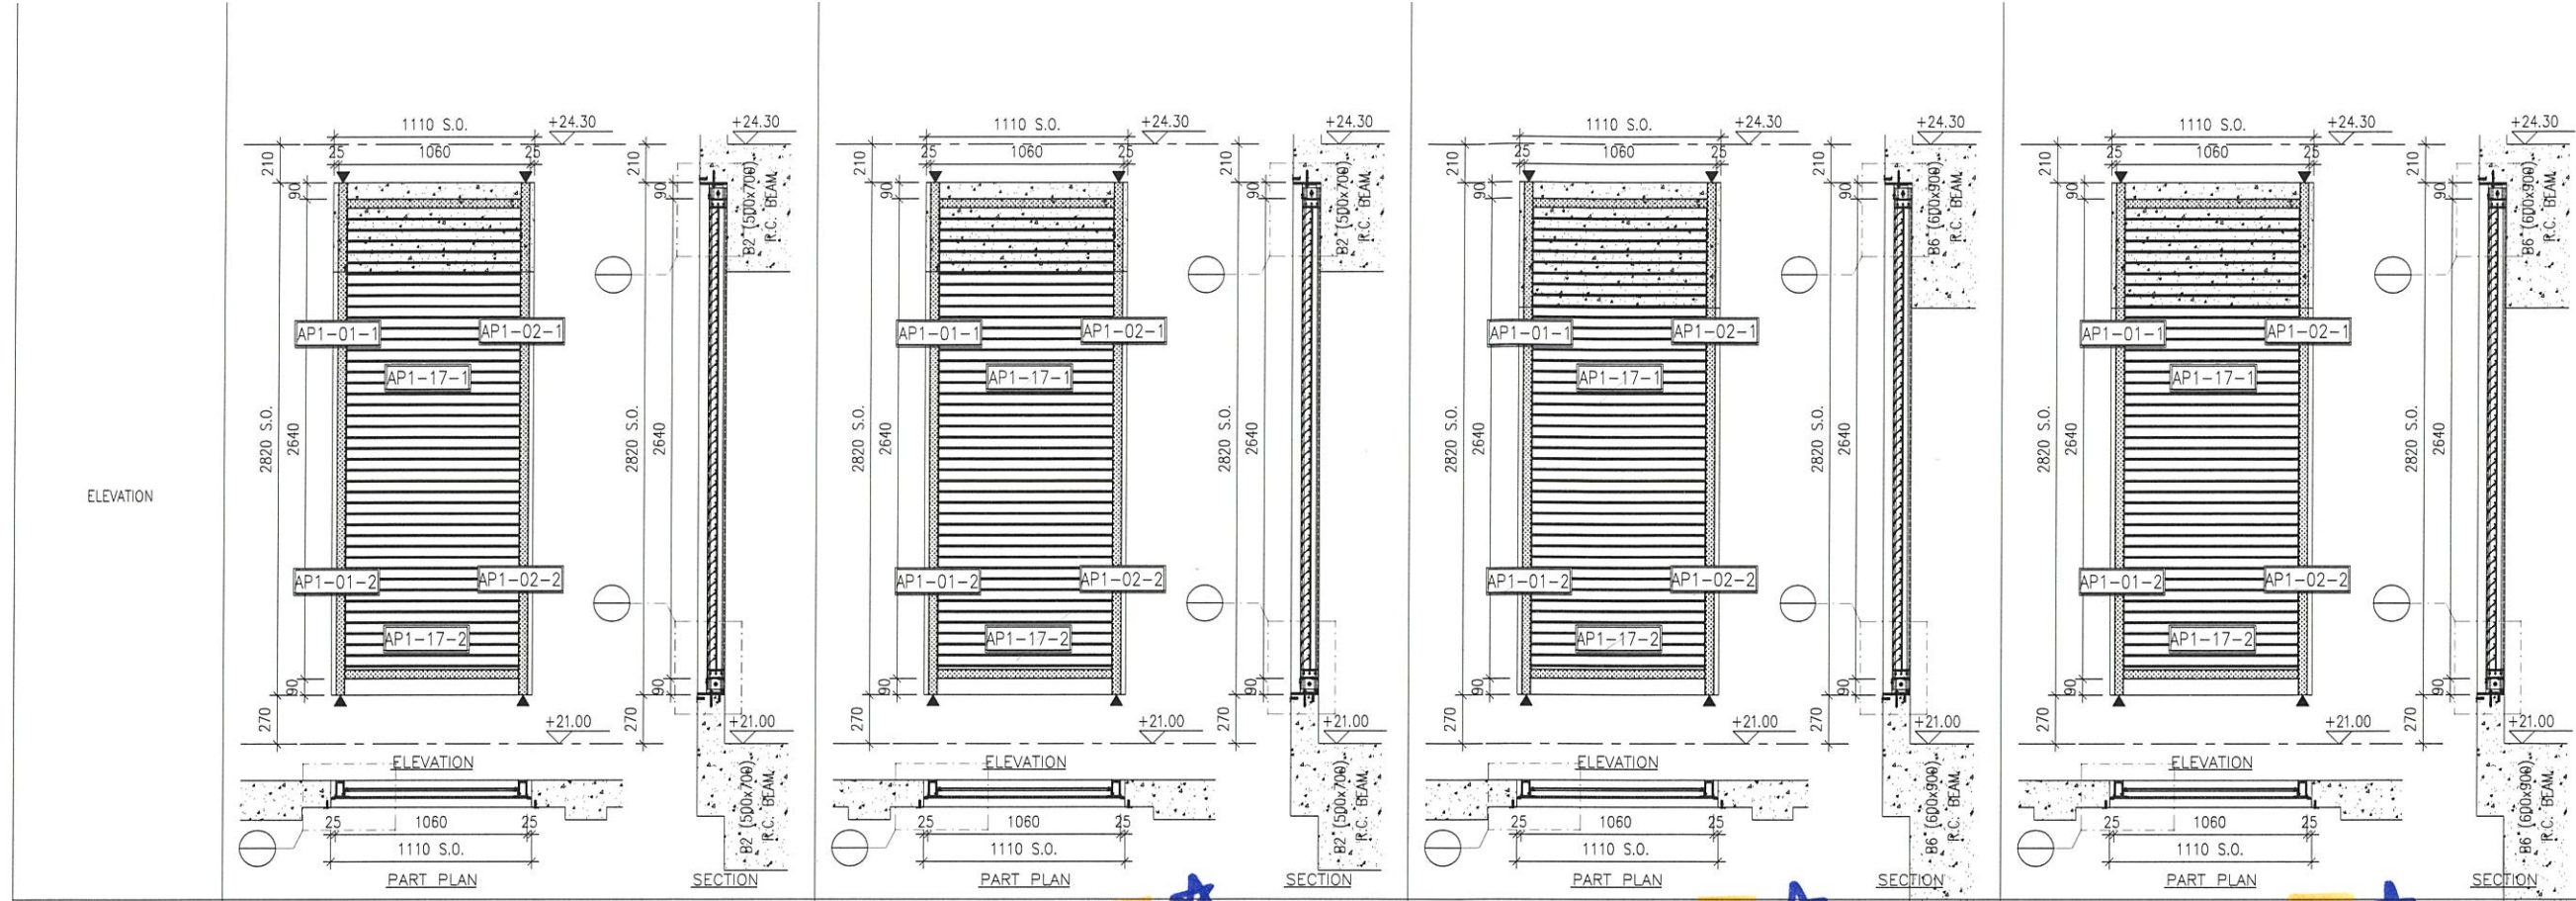

LOUVER MARK	AL-601	AL-601a	AL-601b	AL-601c
FLOOR ROOM	LG3/F	LG3/F	LG3/F	LG3/F
LOCATION	CARPARK FAN ROOM 3	UPPER PART OF EMERGENCY GENSET ROOM	UPPER PART OF EMERGENCY GENSET ROOM	FUEL TANK ROOM
QUANTITY	1	1	1	1
REMARKS	WEATHERPROOF LOUVER (60% FREE AREA)	WEATHERPROOF LOUVER (60% FREE AREA)	WEATHERPROOF LOUVER (60% FREE AREA)	WEATHERPROOF LOUVER (60% FREE AREA)

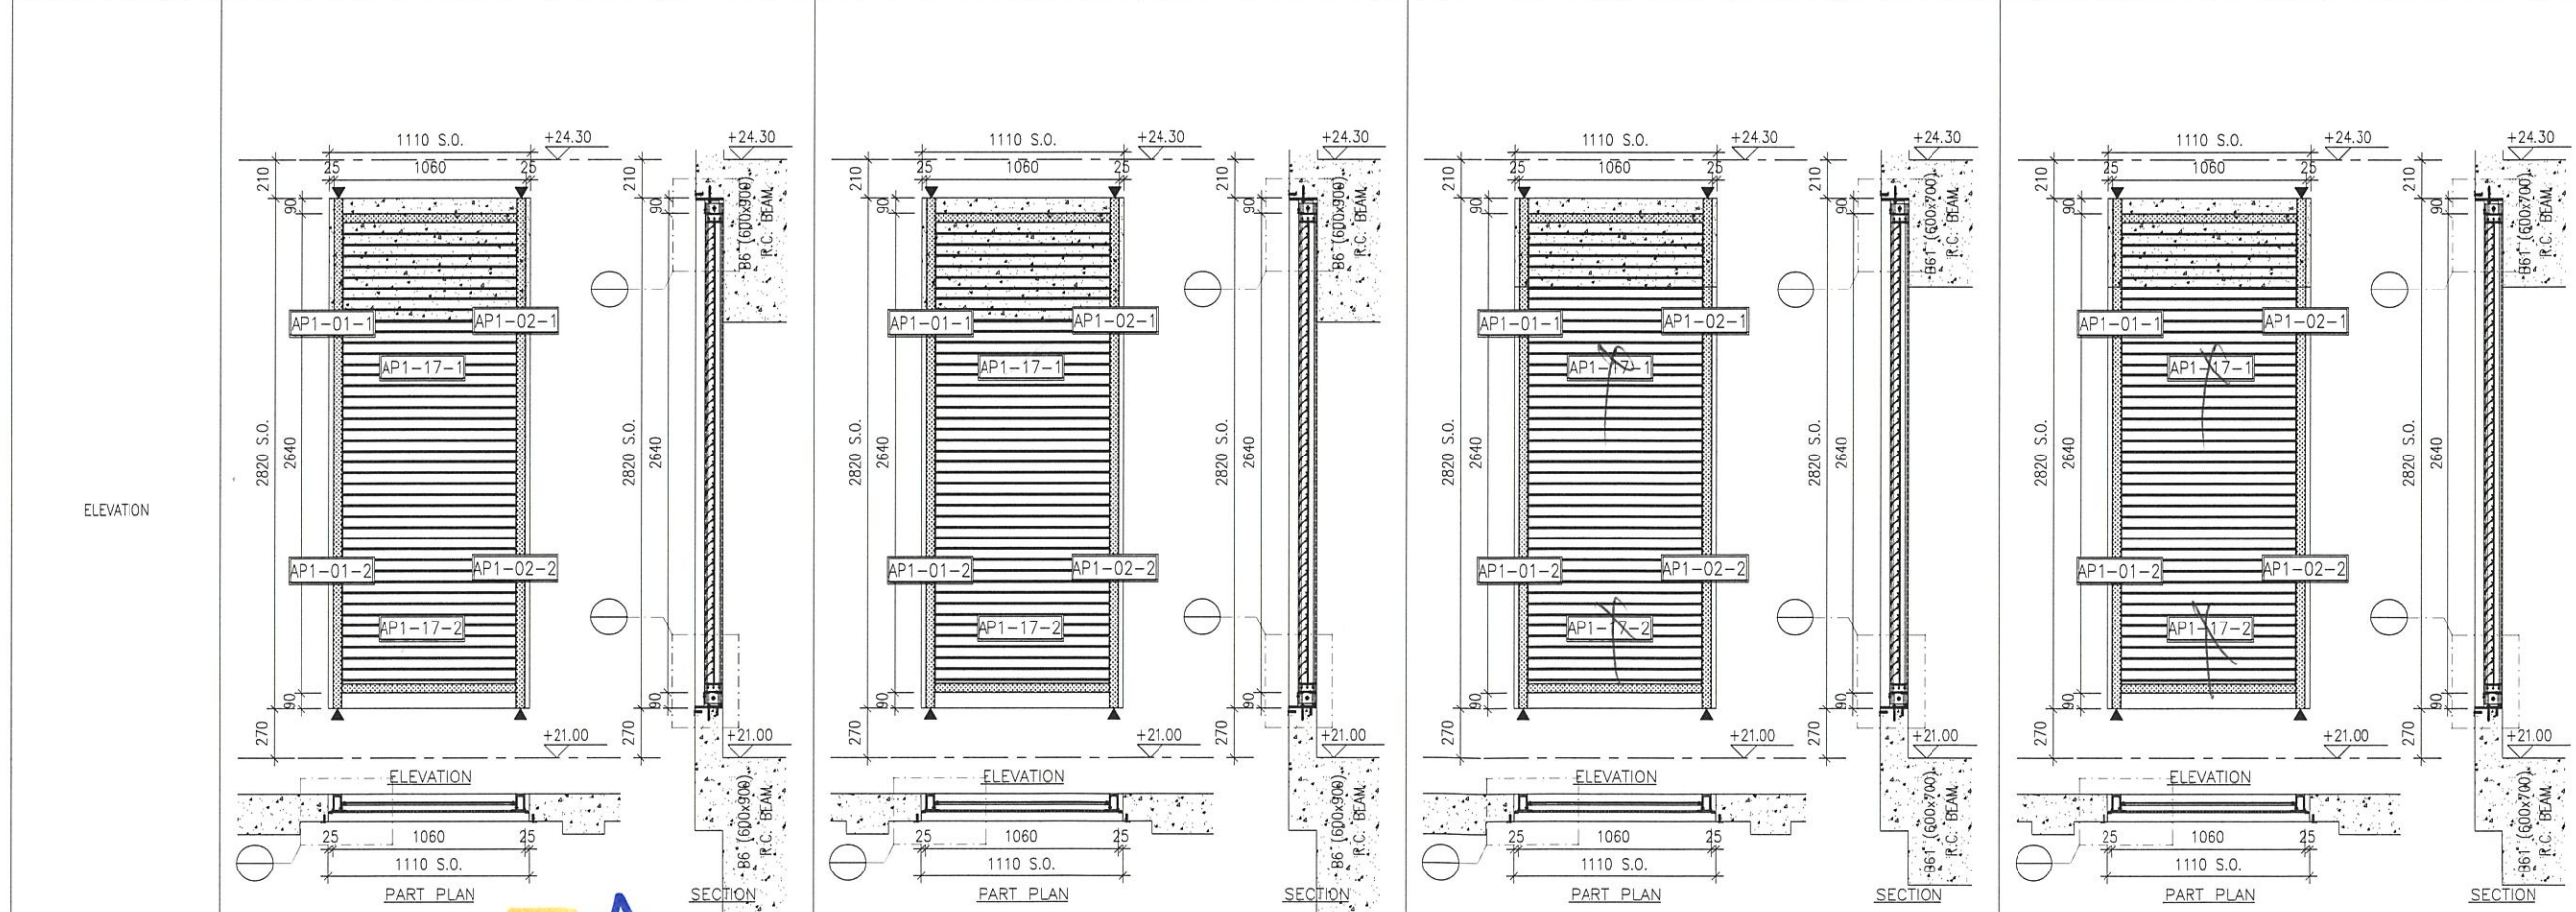

LOUVER MARK	AL-601d	AL-601e	AL-601f	AL-601g
FLOOR ROOM	LG3/F	LG3/F	LG3/F	LG3/F
LOCATION	A/C PLANT ROOM 1	A/C PLANT ROOM 1	CARPARK FAN ROOM 3	UPPER PART OF EMERGENCY GENSET ROOM
QUANTITY	1	1	1	1
REMARKS	WEATHERPROOF LOUVER (60% FREE AREA)	WEATHERPROOF LOUVER (60% FREE AREA)	WEATHERPROOF LOUVER (60% FREE AREA)	WEATHERPROOF LOUVER (60% FREE AREA)

CLIENT :

ARCHITECT : **AGC DESIGN LTD**

MAIN CONTRACTOR : **Gammon**

STRUCTURAL ENGINEER : **ARUP**

FAÇADE CONSULTANT : **MEINHARDT**

- NOTE :
- ALL DIMENSIONS ARE IN mm.
 - ALL ELEVATIONS ARE VIEWED FROM OUTSIDE.
 - ALL DIMENSIONS TO BE VERIFIED ON SITE BEFORE FABRICATION.
- LEGEND :
- X1 --- DETAIL MARK NO.
 - X001 --- REFER SHEET NO.
 - F.F.L. --- FINISHED FLOOR LEVEL
 - S.F.L. --- STRUCTURAL FLOOR LEVEL
 - S.O. --- STRUCTURAL OPENING
 - ▲ --- FIXING LOCATION
 - ▽ --- STRUCTURAL FLOOR LEVEL MARK

C	05-06-2020	REVISION SUBJECT TO COMMENTS	MN
B	27-04-2020	REVISION SUBJECT TO COMMENTS	MN
A	19-02-2020	REVISION SUBJECT TO COMMENTS	MN
NO.	DATE	REVISED	BY

JOB NO. : J-852

PROJECT : PROPOSED RESIDENTIAL DEVELOPMENT AT 139 - 147 ARGYLE STREET, NKIL 6005, 6035 R.P., 6036 R.P., 6037 R.P. & 6038 R.P.

TITLE : LOUVER SCHEDULE FOR ALUM. LOUVER




DATE : 12-Feb-2020 SCALE : 1:40

DRAWN BY : LHR CHECKED BY : DW

美特鋁質有限公司
MIDI ALUMINIUM FABRICATOR LTD.
 Units 6-8, Sunray Industrial Centre, 1/F
 610 Cho Kwo Ling Road, Kowloon
 Tel:23489211-4 Fax:(852)27727666

DWG NO. : J852-SD-LVA-4004 REV. : C

ELEVATION

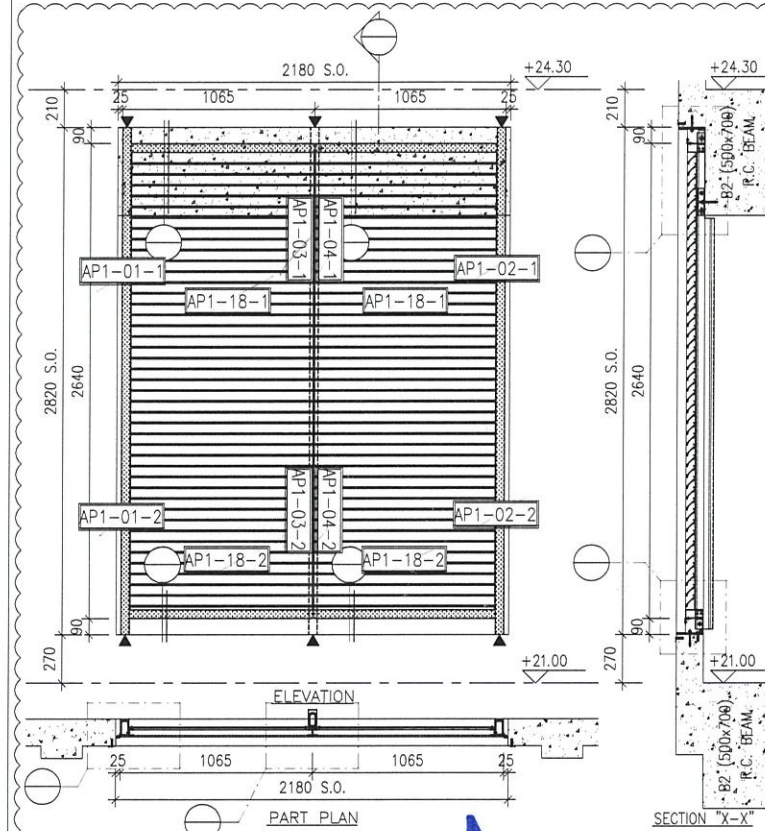
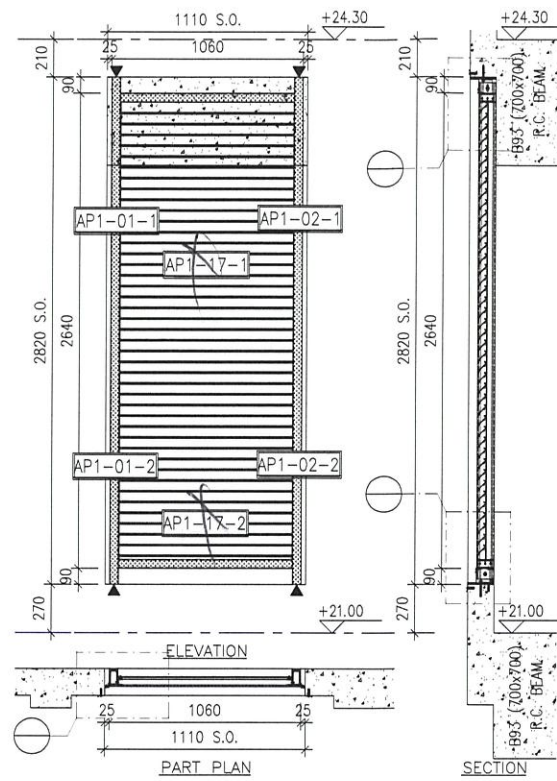
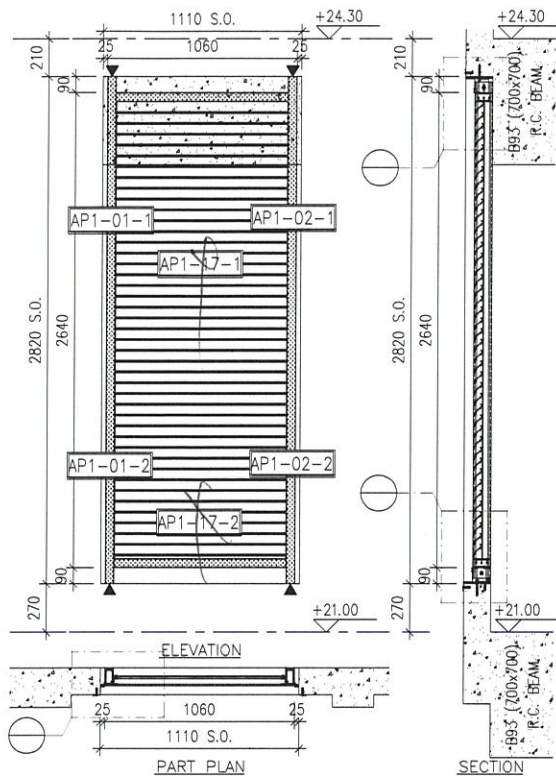


LOUVER MARK	AL-601h
LOCATION FLOOR ROOM	LG3/F CARPARK
QUANTITY	1
REMARKS	WEATHERPROOF LOUVER (60% FREE AREA)

LOUVER MARK	AL-601j
LOCATION FLOOR ROOM	LG3/F CARPARK
QUANTITY	1
REMARKS	WEATHERPROOF LOUVER (60% FREE AREA)

LOUVER MARK	AL-602
LOCATION FLOOR ROOM	LG3/F UPPER PART OF EMERGENCY GENSET ROOM
QUANTITY	1
REMARKS	WEATHERPROOF LOUVER (60% FREE AREA)

ELEVATION

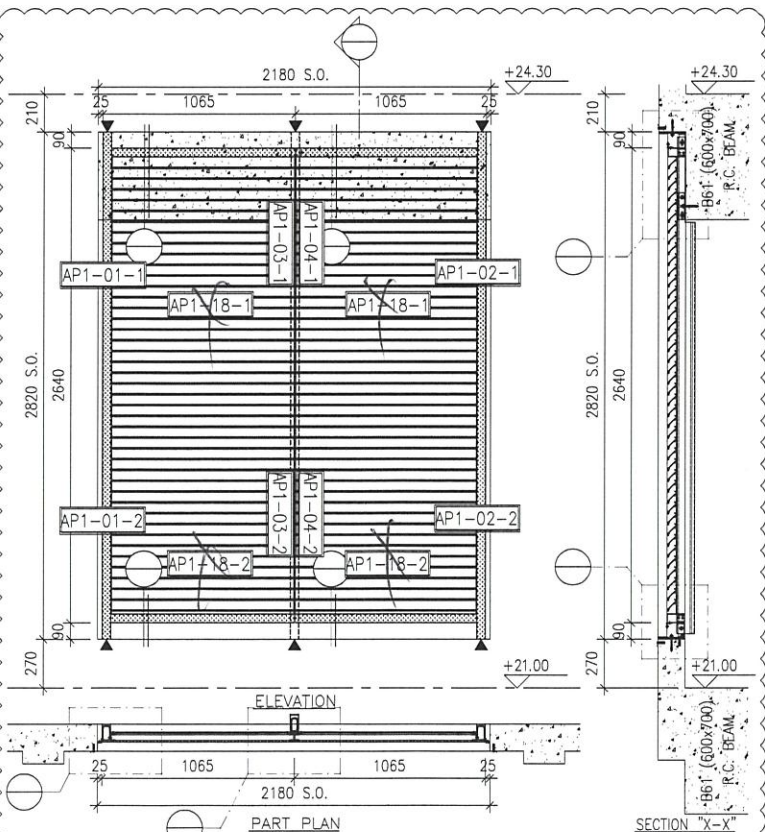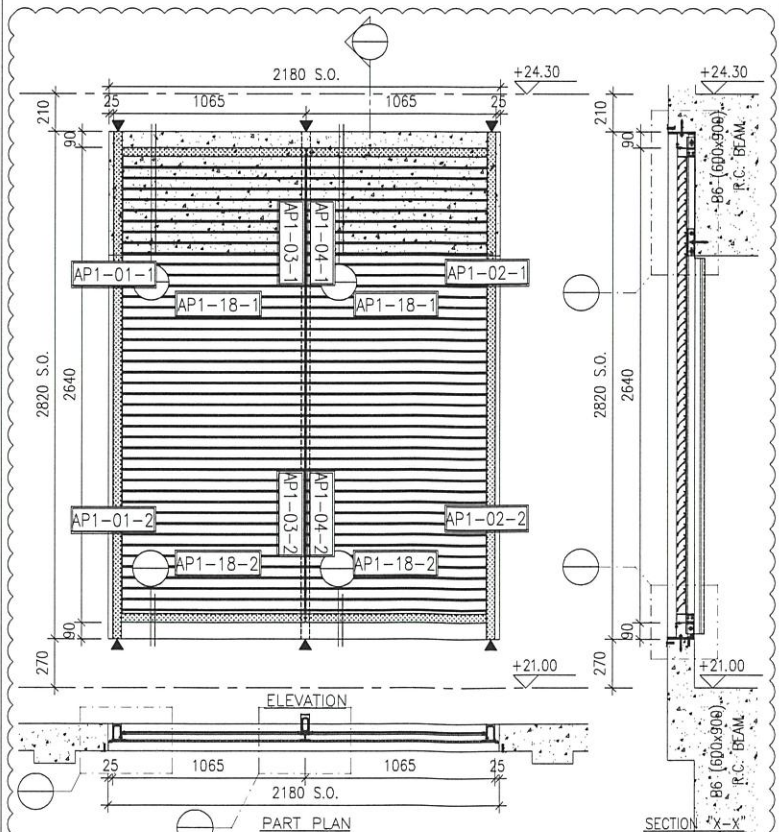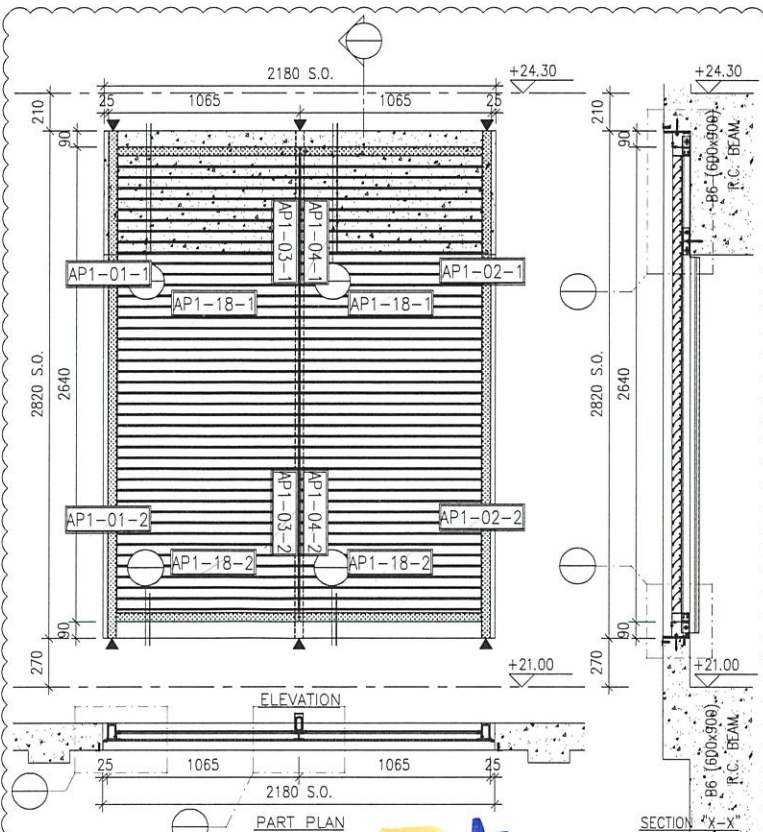

LOUVER MARK	AL-602a
LOCATION FLOOR ROOM	LG3/F UPPER PART OF EMERGENCY GENSET ROOM
QUANTITY	1
REMARKS	WEATHERPROOF LOUVER (60% FREE AREA)

LOUVER MARK	AL-602b
LOCATION FLOOR ROOM	LG3/F A/C PLANT ROOM 1
QUANTITY	1
REMARKS	WEATHERPROOF LOUVER (60% FREE AREA)

LOUVER MARK	AL-602c
LOCATION FLOOR ROOM	LG3/F CARPARK FAN ROOM 2
QUANTITY	1
REMARKS	WEATHERPROOF LOUVER (60% FREE AREA)

B.D. REF :

CLIENT :

ARCHITECT :
AGC DESIGN LTD

MAIN CONTRACTOR :
Gammon

STRUCTURAL ENGINEER :
ARUP

FACADE CONSULTANT :
MEIN-HARDT

NOTE :

- ALL DIMENSIONS ARE IN mm.
- ALL ELEVATIONS ARE VIEWED FROM OUTSIDE.
- ALL DIMENSIONS TO BE VERIFIED ON SITE BEFORE FABRICATION.

LEGEND :

X1 --- DETAIL MARK NO.
X001 --- REFER SHEET NO.

- F.F.L. --- FINISHED FLOOR LEVEL
- S.F.L. --- STRUCTURAL FLOOR LEVEL
- S.O. --- STRUCTURAL OPENING
- ▲ --- FIXING LOCATION
- ▽ --- STRUCTURAL FLOOR LEVEL MARK

NO.	DATE	REVISED	BY
D	29-10-2020	REVISION SUBJECT TO COMMENTS	MN
C	05-06-2020	REVISION SUBJECT TO COMMENTS	MN
B	27-04-2020	REVISION SUBJECT TO COMMENTS	MN
A	19-02-2020	REVISION SUBJECT TO COMMENTS	MN

JOB NO. : J-852

PROJECT : PROPOSED RESIDENTIAL DEVELOPMENT AT 139 - 147 ARGYLE STREET, NKIL 6005, 6035 R.P., 6036 R.P., 6037 R.P. & 6038 R.P.

TITLE : LOUVER SCHEDULE FOR ALUM. LOUVER


DATE : 12-Feb-2020 SCALE : 1:40

DRAWN BY : LHR CHECKED BY : DW

美特鋁質有限公司
MIDI ALUMINIUM FABRICATOR LTD.
 Units 6-8, Sunray Industrial Centre, 1/F
 610 Cha Kwo Ling Road, Kowloon
 Tel:23489211-4 Fax:(852)27727666


DWG NO. : J852-SD-LVA-4005 REV. : D

ELEVATION

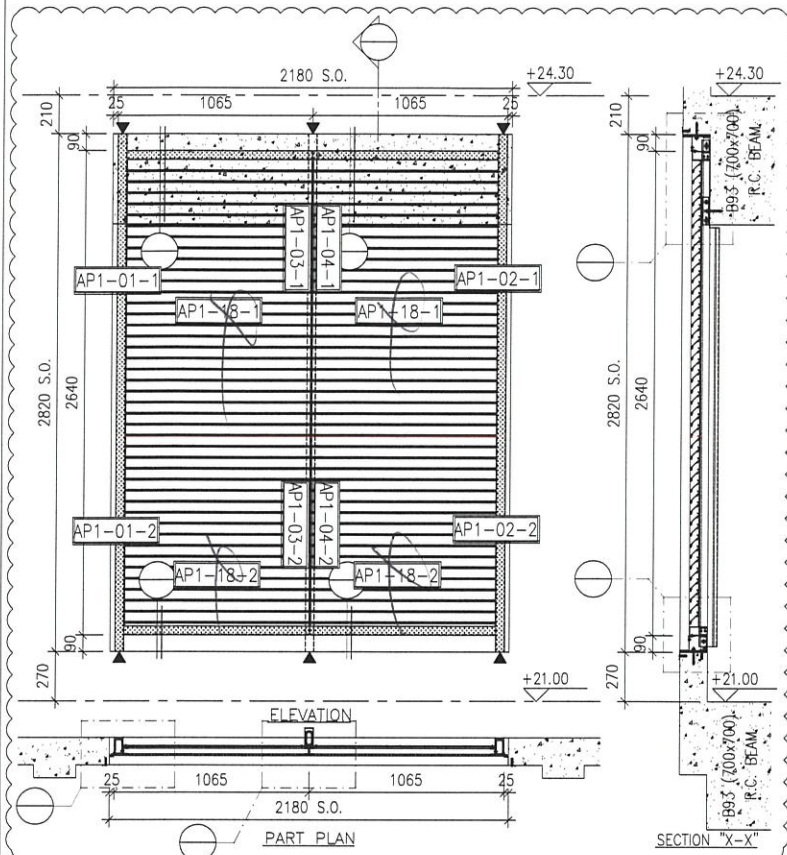


LOUVER MARK	AL-602a
LOCATION	LG3/F
FLOOR ROOM	CARPARK
QUANTITY	1
REMARKS	WEATHERPROOF LOUVER (60% FREE AREA)


ELEVATION

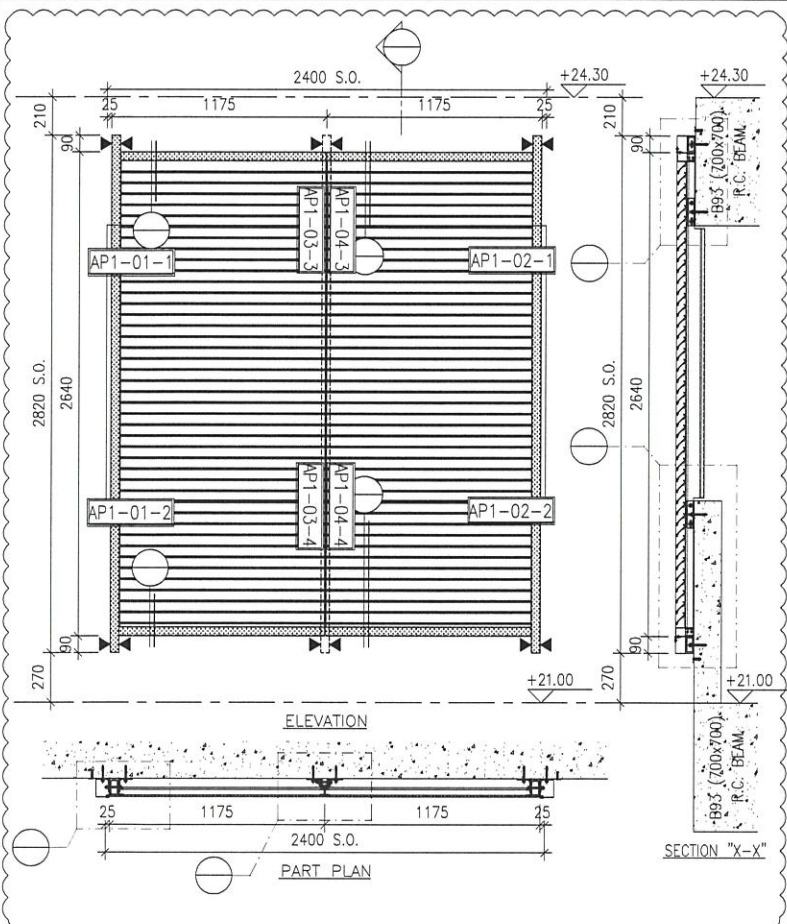

LOUVER MARK	AL-604
LOCATION	LG3/F
FLOOR ROOM	CARPARK
QUANTITY	1
REMARKS	WEATHERPROOF LOUVER (60% FREE AREA)

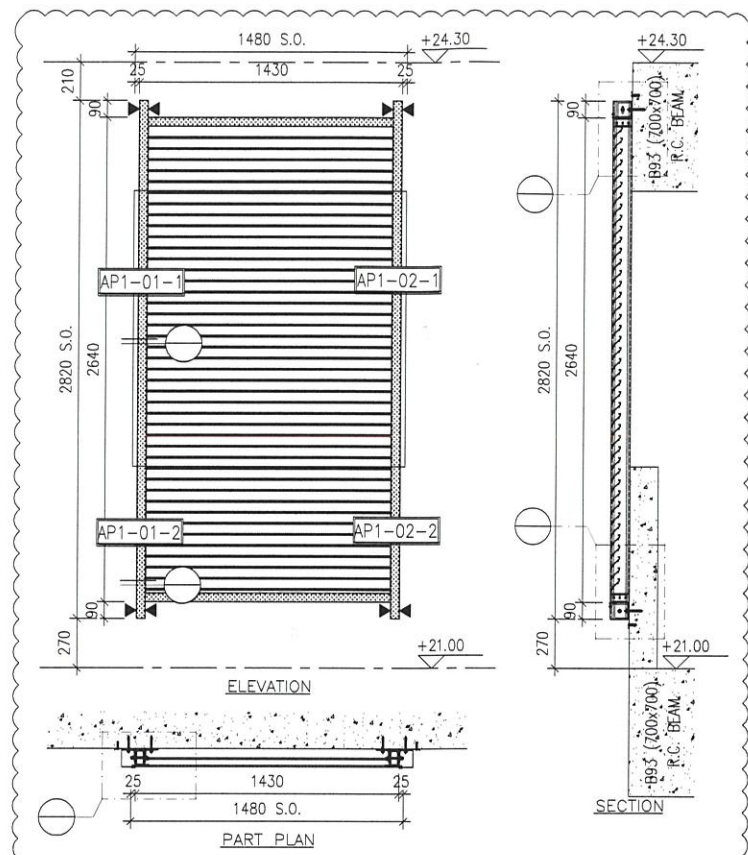

LOUVER MARK	AL-603
LOCATION	LG3/F
FLOOR ROOM	CAR RAMP
QUANTITY	1
REMARKS	WEATHERPROOF LOUVER (60% FREE AREA)

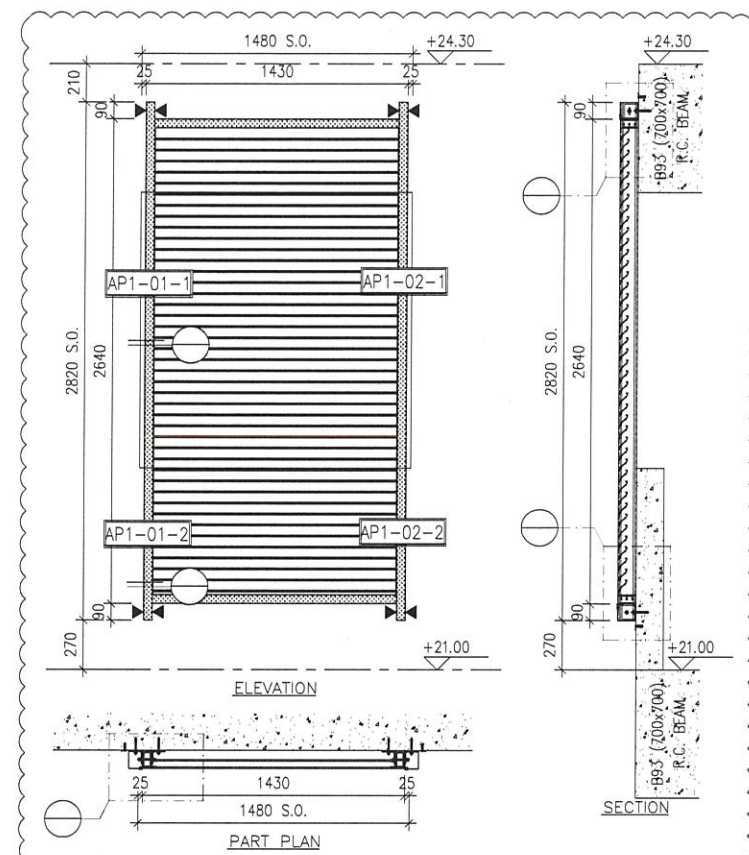

LOUVER MARK	AL-603a
LOCATION	LG3/F
FLOOR ROOM	CAR RAMP
QUANTITY	1
REMARKS	WEATHERPROOF LOUVER (60% FREE AREA)

B.D. REF :

CLIENT :

ARCHITECT :
AGC DESIGN LTD
 10/F, 147 Argyle Street, Kowloon, Hong Kong
 Tel: 23489211-4 Fax: (852) 27727666

MAIN CONTRACTOR :
Gammon

STRUCTURAL ENGINEER :
ARUP
 FACADE CONSULTANT:
MEINHARDT

NOTE :
 1. ALL DIMENSIONS ARE IN mm.
 2. ALL ELEVATIONS ARE VIEWED FROM OUTSIDE.
 3. ALL DIMENSIONS TO BE VERIFIED ON SITE BEFORE FABRICATION.

LEGEND :
 (x1) --- DETAIL MARK NO.
 (x001) --- REFER SHEET NO.
 1. F.F.L. --- FINISHED FLOOR LEVEL
 2. S.F.L. --- STRUCTURAL FLOOR LEVEL
 3. S.O. --- STRUCTURAL OPENING
 4. ▲ --- FIXING LOCATION
 5. ▽ --- STRUCTURAL FLOOR LEVEL MARK

NO.	DATE	REVISION	BY
D	29-10-2020	REVISION SUBJECT TO COMMENTS	MN
C	05-05-2020	REVISION SUBJECT TO COMMENTS	MN
B	27-04-2020	REVISION SUBJECT TO COMMENTS	MN
A	19-02-2020	REVISION SUBJECT TO COMMENTS	MN


JOB NO. : J-852
 PROJECT : PROPOSED RESIDENTIAL DEVELOPMENT AT 139 - 147 ARGYLE STREET, NKIL 6005, 6035 R.P., 6036 R.P., 6037 R.P. & 6038 R.P.

TITLE : LOUVER SCHEDULE FOR ALUM. LOUVER


DATE : 12-Feb-2020 SCALE : 1:40
 DRAWN BY : LHR CHECKED BY : DW

MIDI ALUMINIUM FABRICATOR LTD.
 Units 6-8, Sunray Industrial Centre, 1/F
 610 Cha Kwo Ling Road, Kowloon
 Tel: 23489211-4 Fax: (852) 27727666

DWG NO. : J852-SD-LVA-4006 REV. : D

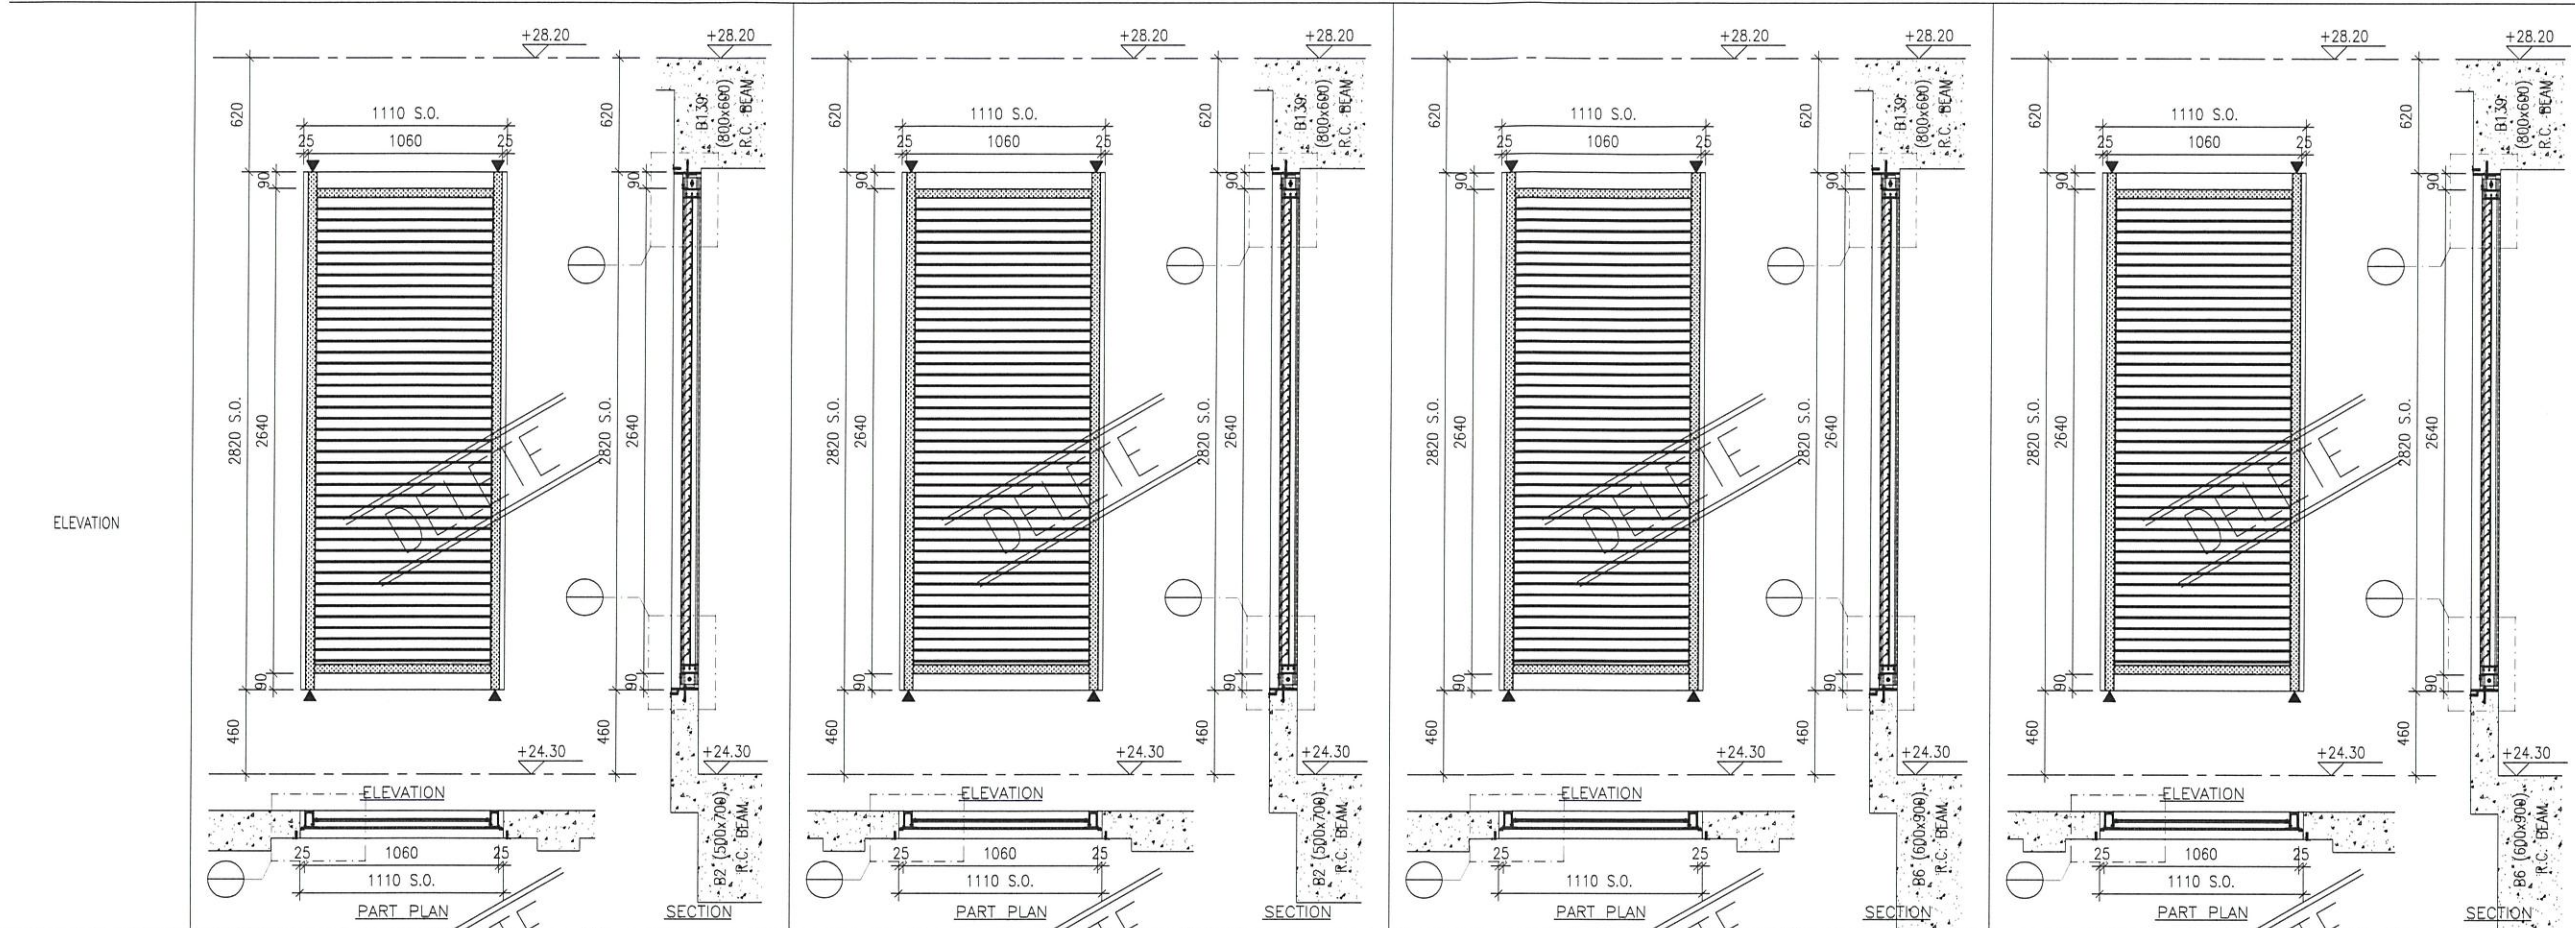

LOUVER MARK	FLOOR	LOCATION	ROOM	QUANTITY	REMARKS
AL-70x	LG4/F	BYM & YOGA AREA		1	WEATHERPROOF LOUVER (60% FREE AREA)
AL-70y	LG4/F	BYM & YOGA AREA		1	WEATHERPROOF LOUVER (60% FREE AREA)
AL-70z	LG4/F	BYM & YOGA AREA		1	WEATHERPROOF LOUVER (60% FREE AREA)
AL-70c	LG4/F	BYM & YOGA AREA		1	WEATHERPROOF LOUVER (60% FREE AREA)

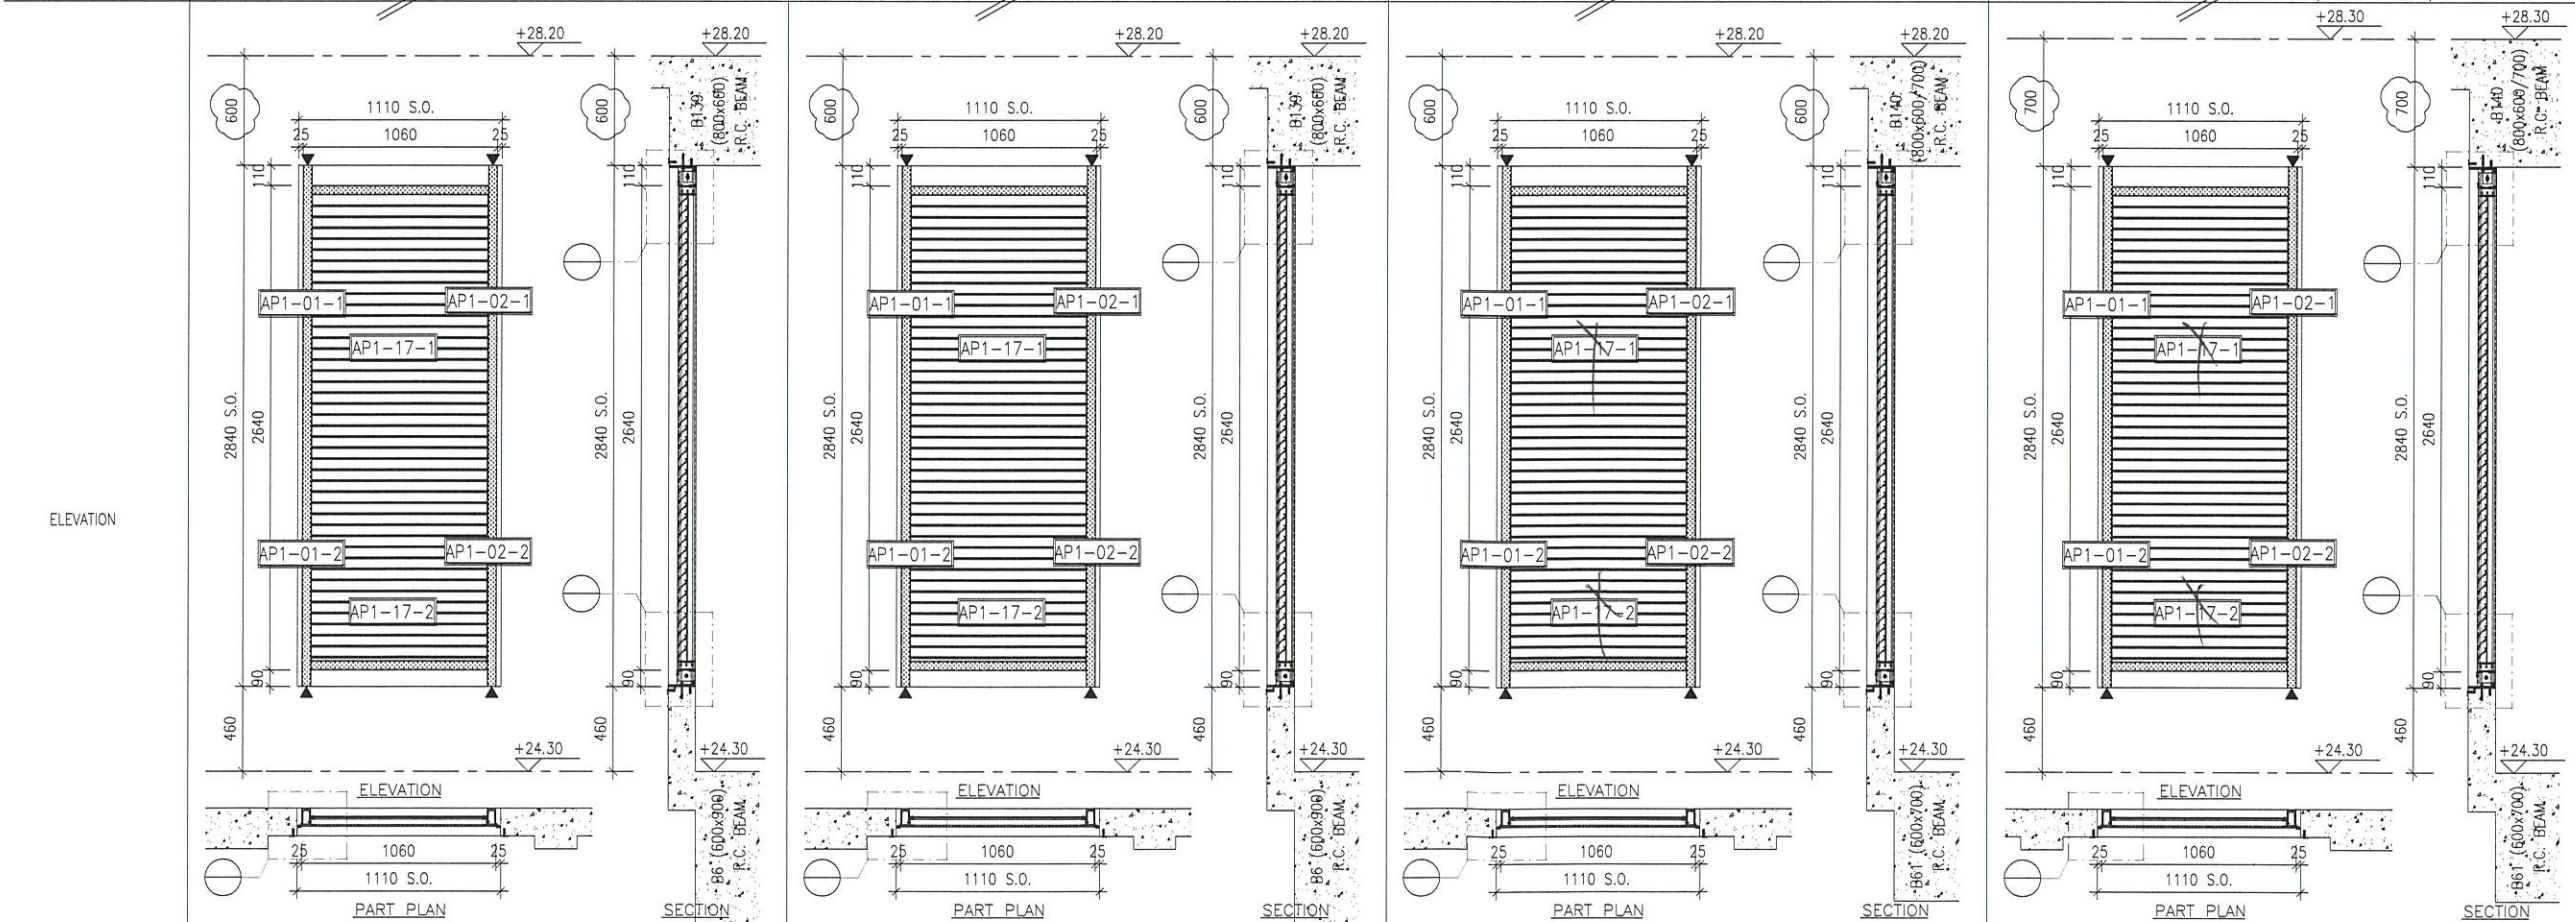

LOUVER MARK	FLOOR	LOCATION	ROOM	QUANTITY	REMARKS
AL-701d	LG4/F	M. CHANGING ROOM		1	WEATHERPROOF LOUVER (60% FREE AREA)
AL-701e	LG4/F	CAR PARK FAN ROOM 2		1	WEATHERPROOF LOUVER (60% FREE AREA)
AL-701f	LG4/F	CAR PARK FAN ROOM 2		1	WEATHERPROOF LOUVER (60% FREE AREA)
AL-701g	LG4/F	CAR PARK FAN ROOM 2		1	WEATHERPROOF LOUVER (60% FREE AREA)

B.D. REF :

CLIENT :

ARCHITECT : **AGC DESIGN LTD**

MAIN CONTRACTOR : **Gammon**

STRUCTURAL ENGINEER : **ARUP**

FAÇADE CONSULTANT : **MEINHARDT**

- NOTE :
- ALL DIMENSIONS ARE IN MM.
 - ALL ELEVATIONS ARE VIEWED FROM OUTSIDE.
 - ALL DIMENSIONS TO BE VERIFIED ON SITE BEFORE FABRICATION.

- LEGEND :
- x1 -- DETAIL MARK NO.
 - x001 -- REFER SHEET NO.
 - F.F.L. -- FINISHED FLOOR LEVEL
 - S.F.L. -- STRUCTURAL FLOOR LEVEL
 - S.O. -- STRUCTURAL OPENING
 - ▲ -- FIXING LOCATION
 - ▽ -- STRUCTURAL FLOOR LEVEL MARK


NO.	DATE	REVISED	BY
D	29-10-2020	REVISION SUBJECT TO COMMENTS	MN
C	05-06-2020	REVISION SUBJECT TO COMMENTS	MN
B	27-04-2020	REVISION SUBJECT TO COMMENTS	MN
A	19-02-2020	REVISION SUBJECT TO COMMENTS	MN

JOB NO. : J-852


PROJECT : PROPOSED RESIDENTIAL DEVELOPMENT AT 139 - 147 ARGYLE STREET, NKIL 6005, 6035 R.P., 6036 R.P., 6037 R.P. & 6038 R.P.

TITLE : LOUVER SCHEDULE FOR ALUM. LOUVER


DATE : 12-Feb-2020	SCALE : 1:40
DRAWN BY : LHR	CHECKED BY : DW
美特铝质有限公司 MIDI ALUMINIUM FABRICATOR LTD.	
Units 6-8, Sunray Industrial Centre, 1/F 610 Cha Kwo Ling Road, Kowloon Tel: 23489211-4 Fax: (852) 2727666	
DWG NO. : J852-SD-LVA-4007	REV. : D

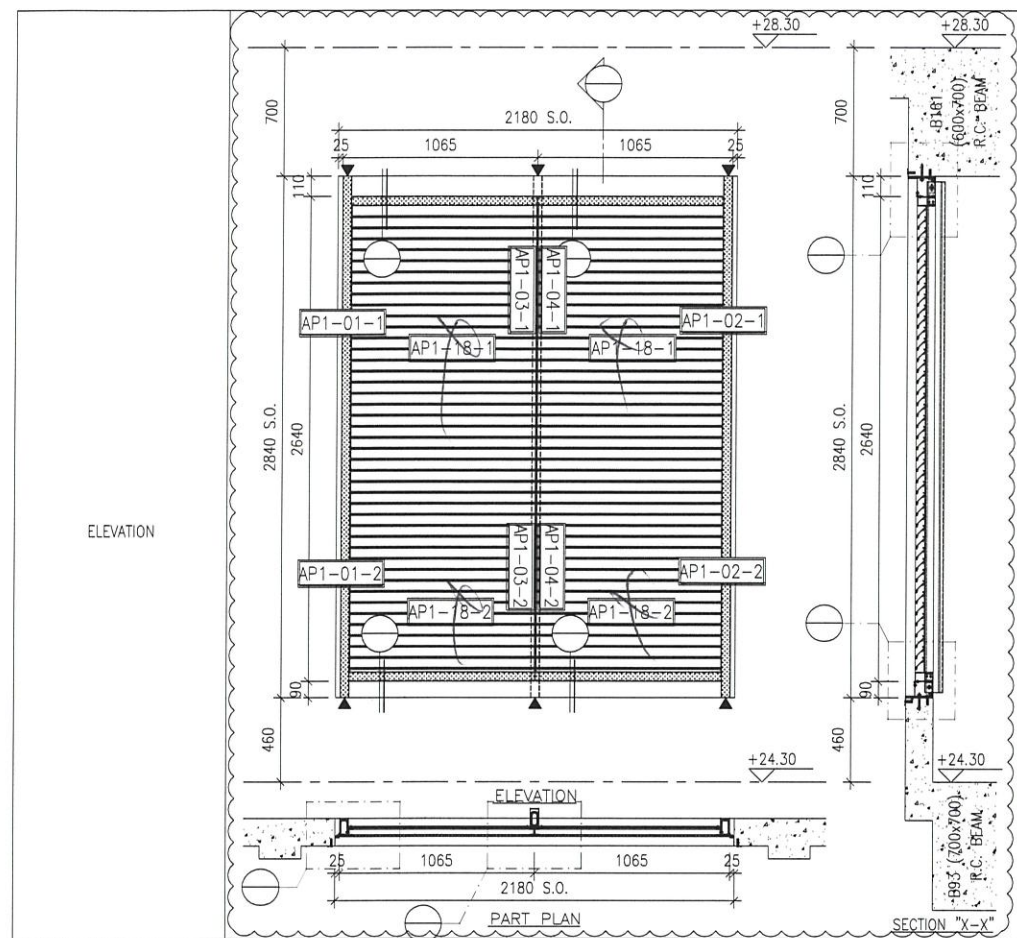


LOUVER MARK	AL-702d
LOCATION	LG4/F
FLOOR ROOM	CAR RAMP
QUANTITY	1
REMARKS	WEATHERPROOF LOUVER (60% FREE AREA)

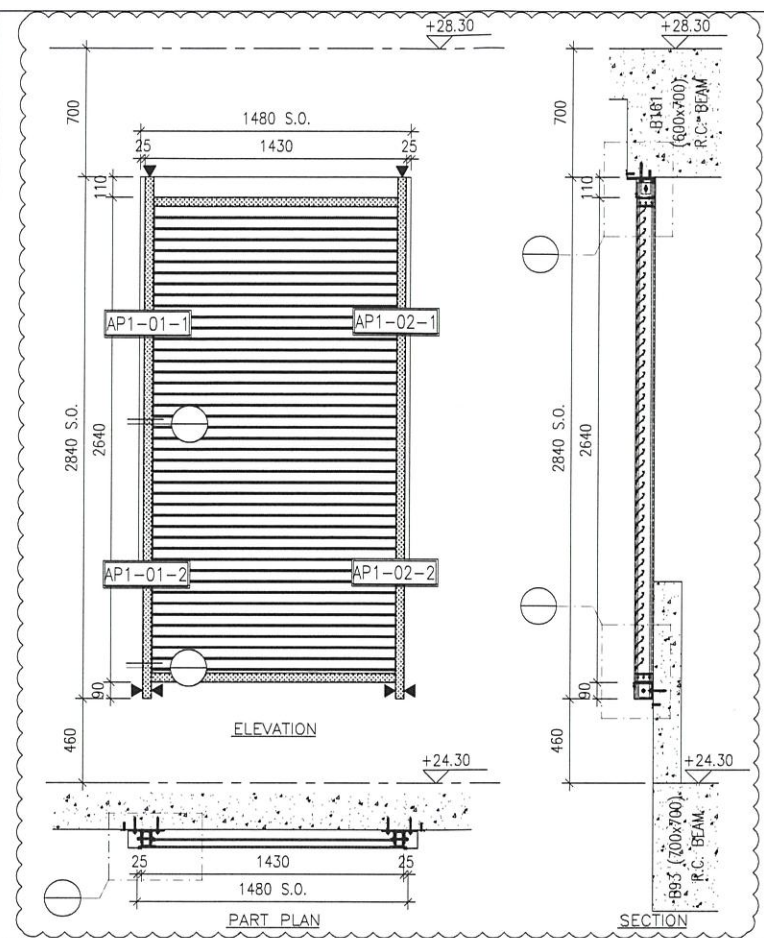


LOUVER MARK	AL-703
LOCATION	LG4/F
FLOOR ROOM	CAR RAMP
QUANTITY	1
REMARKS	WEATHERPROOF LOUVER (60% FREE AREA)

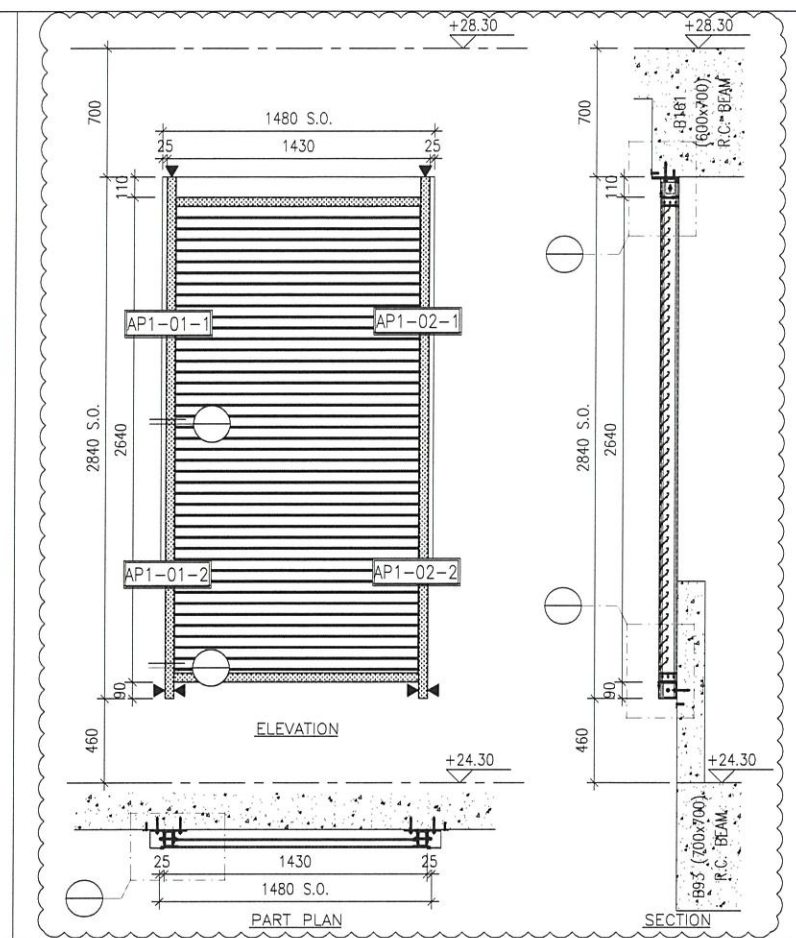

LOUVER MARK	AL-703a
LOCATION	LG4/F
FLOOR ROOM	CAR RAMP
QUANTITY	1
REMARKS	WEATHERPROOF LOUVER (60% FREE AREA)

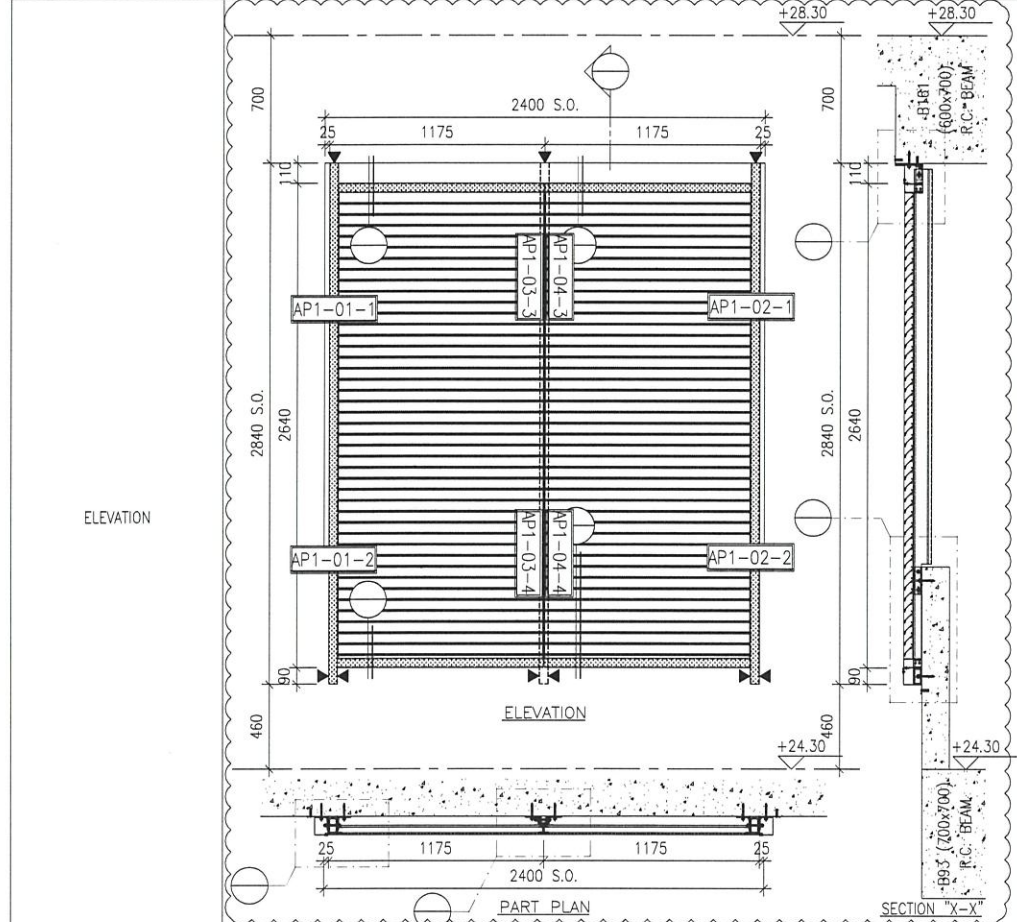

LOUVER MARK	AL-704
LOCATION	LG4/F
FLOOR ROOM	CAR RAMP
QUANTITY	1
REMARKS	WEATHERPROOF LOUVER (60% FREE AREA)

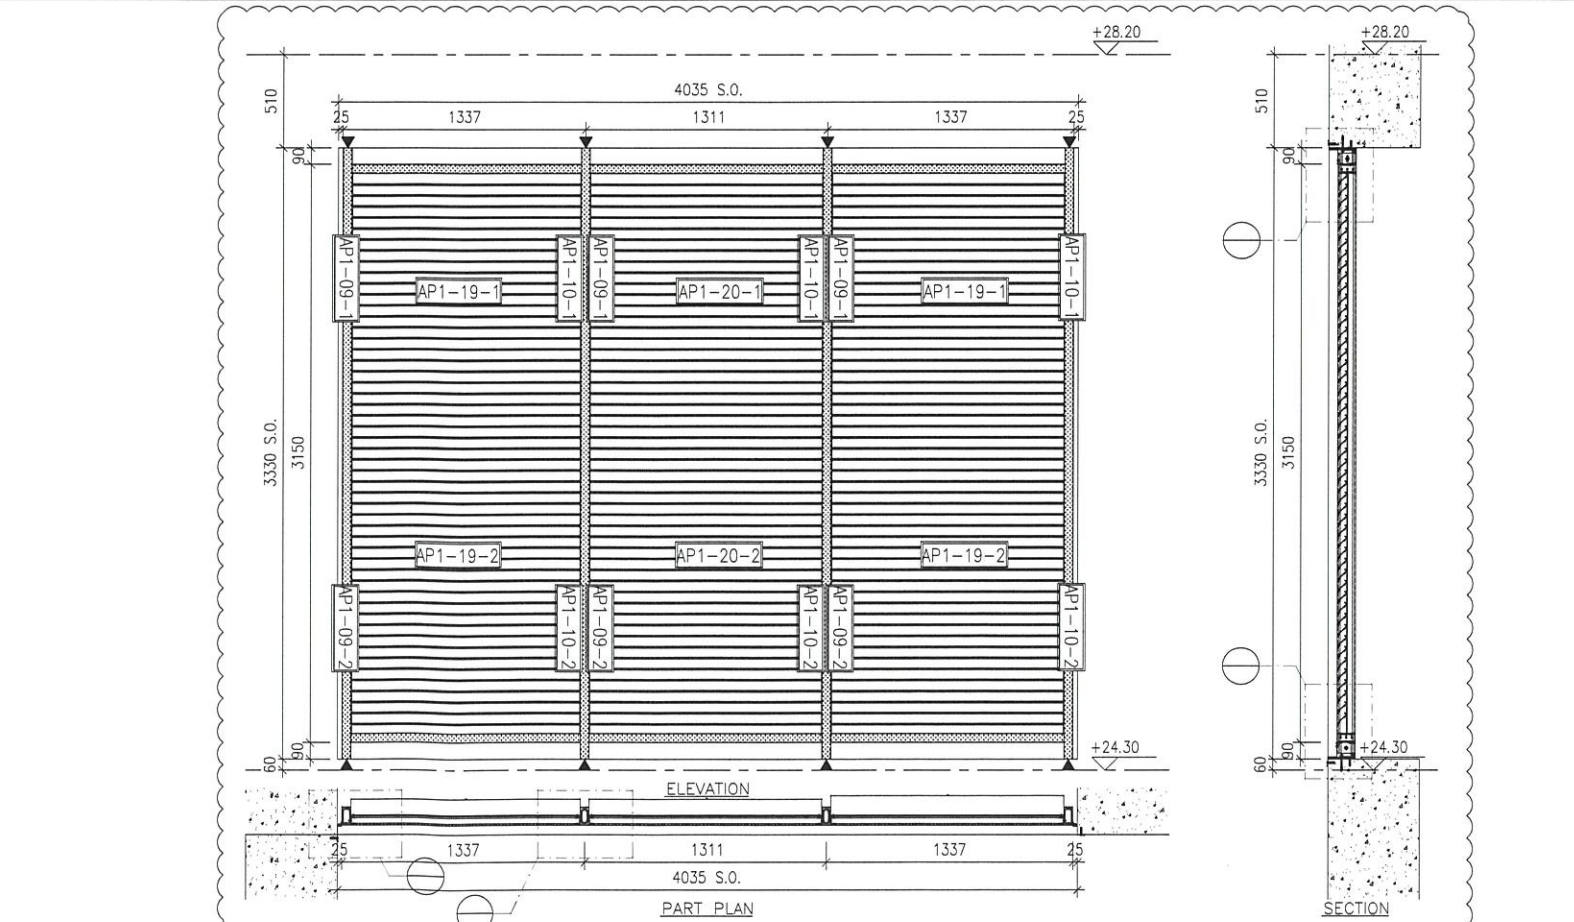

LOUVER MARK	AL-705
LOCATION	LG4/F
FLOOR ROOM	A/C PLANT ROOM
QUANTITY	1
REMARKS	WEATHERPROOF LOUVER (60% FREE AREA)

B.D. REF :

CLIENT :

ARCHITECT :

AGC DESIGN LTD

MAIN CONTRACTOR :

Gammon

STRUCTURAL ENGINEER :

ARUP

FAÇADE CONSULTANT :

MEINHARDT

NOTE :

- ALL DIMENSIONS ARE IN mm.
- ALL ELEVATIONS ARE VIEWED FROM OUTSIDE.
- ALL DIMENSIONS TO BE VERIFIED ON SITE BEFORE FABRICATION.

LEGEND :

X1 -- DETAIL MARK NO.
 X001 -- REFER SHEET NO.

- F.F.L. -- FINISHED FLOOR LEVEL
- S.F.L. -- STRUCTURAL FLOOR LEVEL
- S.O. -- STRUCTURAL OPENING
- ▲ -- FIXING LOCATION
- ▽ -- STRUCTURAL FLOOR LEVEL MARK

NO.	DATE	REVISED	BY
D	29-10-2020	REVISION SUBJECT TO COMMENTS	MN
C	05-06-2020	REVISION SUBJECT TO COMMENTS	MN
B	27-04-2020	REVISION SUBJECT TO COMMENTS	MN
A	19-02-2020	REVISION SUBJECT TO COMMENTS	MN

JOB NO. : J-852



PROJECT :

PROPOSED RESIDENTIAL DEVELOPMENT
 AT 139 - 147 ARGYLE STREET,
 NKIL 6005, 6035 R.P., 6036 R.P.,
 6037 R.P. & 6038 R.P.

TITLE : LOUVER SCHEDULE FOR ALUM. LOUVER

DATE : 12-Feb-2020	SCALE : 1:40
DRAWN BY : LHR	CHECKED BY : DW
<p>MIDI ALUMINIUM FABRICATOR LTD. Units 6-8, Sunray Industrial Centre, 1/F 610 Cha Kwo Ling Road, Kowloon Tel:23489211-4 Fax:(852)27727666</p>	
DWG NO. : J852-SD-LVA-4009	REV. : D


ELEVATION

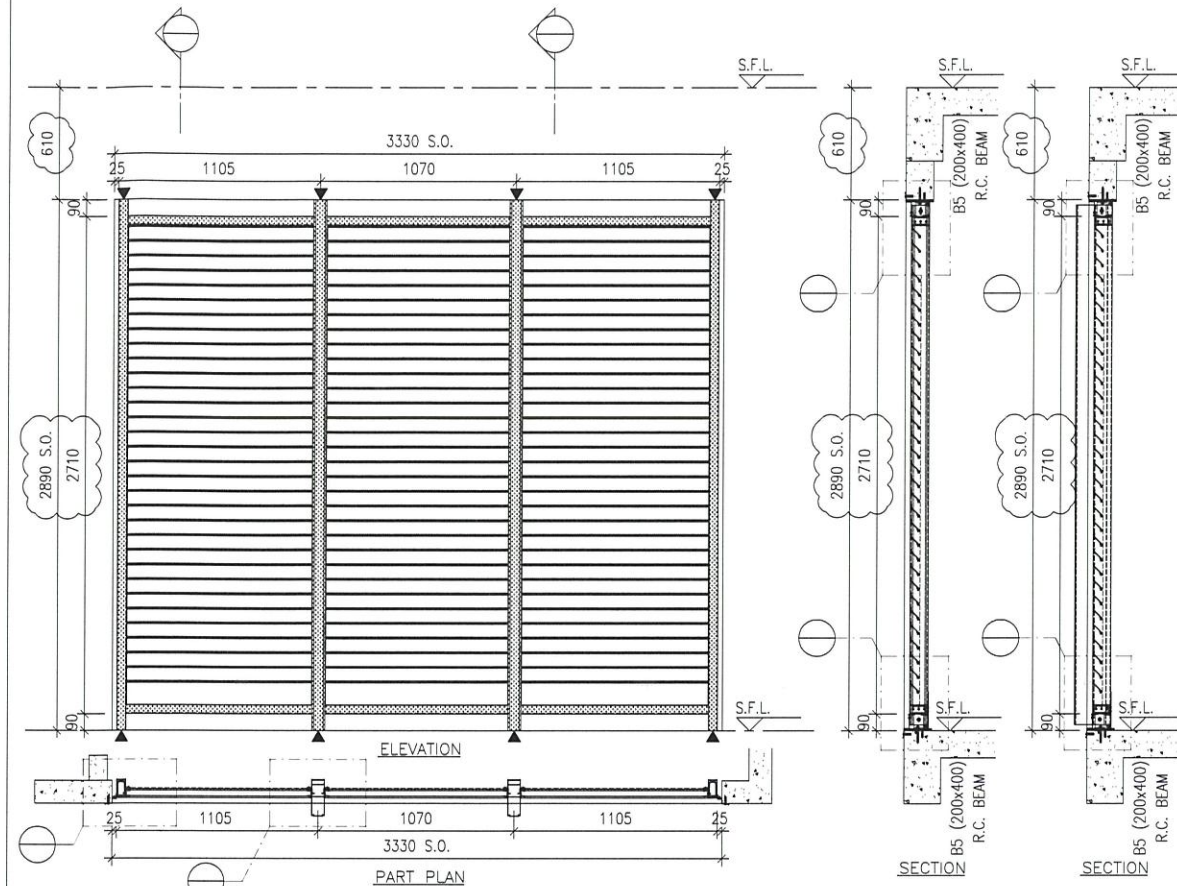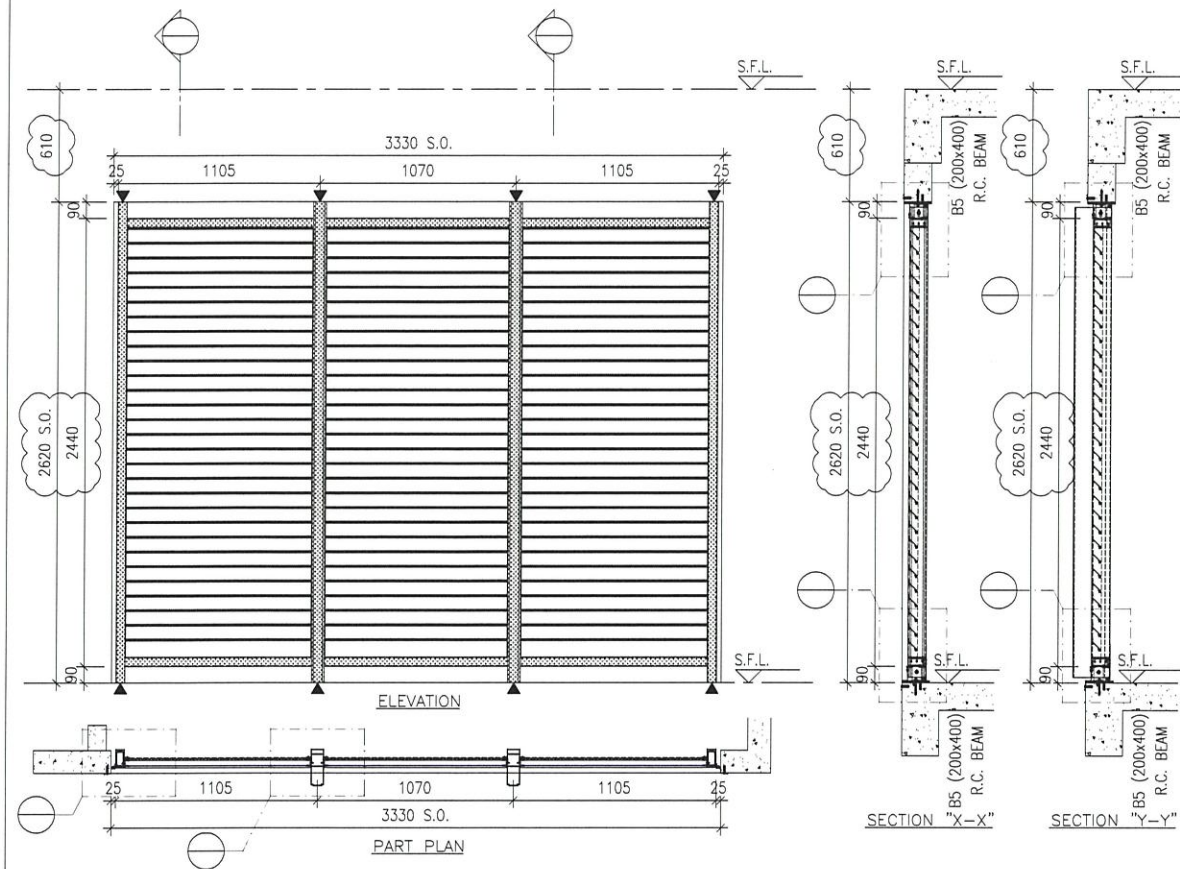

LOUVER MARK	LLC
LOCATION	2/F ~ 21/F (4, 13, 14 OMITTED) (TOWER 1 & 2 & 3) A/C PLANT ROOM
QUANTITY	51
REMARKS	WEATHERPROOF LOUVER (70% FREE AREA)

LOUVER MARK	LLCg
LOCATION	22/F ~ 23/F (TOWER 1 & 2 & 3) A/C PLANT ROOM
QUANTITY	6
REMARKS	WEATHERPROOF LOUVER (70% FREE AREA)

ELEVATION

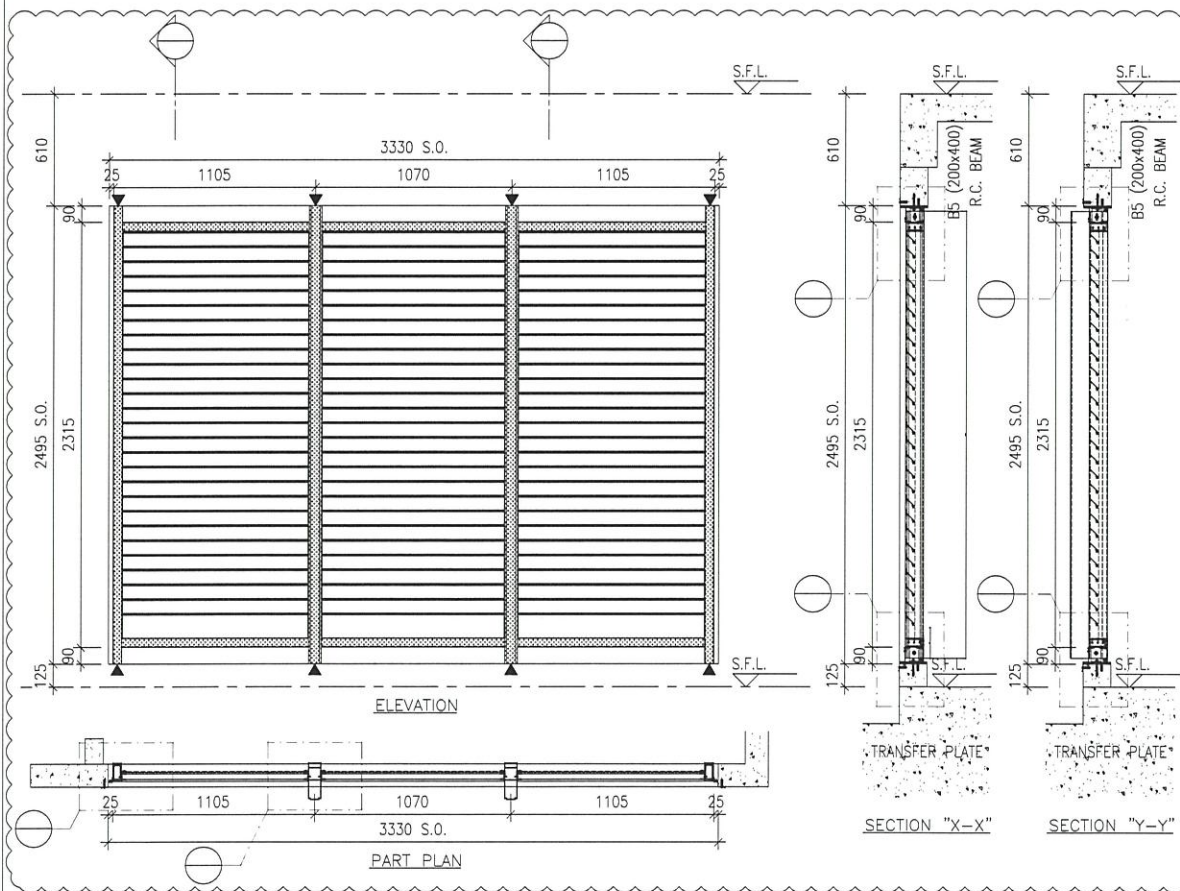

LOUVER MARK	LLCb
LOCATION	1/F (TOWER 1 & 2 & 3) A/C PLANT ROOM
QUANTITY	3
REMARKS	WEATHERPROOF LOUVER (70% FREE AREA)

B.D. REF :

CLIENT :

ARCHITECT :



MAIN CONTRACTOR :



STRUCTURAL ENGINEER :



FAÇADE CONSULTANT :



NOTE :

1. ALL DIMENSIONS ARE IN mm.
2. ALL ELEVATIONS ARE VIEWED FROM OUTSIDE.
3. ALL DIMENSIONS TO BE VERIFIED ON SITE BEFORE FABRICATION.

LEGEND :

- X1 — DETAIL MARK NO.
- X001 — REFER SHEET NO.

1. F.F.L. — FINISHED FLOOR LEVEL
2. S.F.L. — STRUCTURAL FLOOR LEVEL
3. S.O. — STRUCTURAL OPENING
4. ▲ — FIXING LOCATION
5. ▽ — STRUCTURAL FLOOR LEVEL MARK

D	29-10-2020	REVISION SUBJECT TO COMMENTS	MN
C	05-06-2020	REVISION SUBJECT TO COMMENTS	MN
B	27-04-2020	REVISION SUBJECT TO COMMENTS	MN
NO.	DATE	REVISED	BY

JOB NO. : J-852

PROJECT :
PROPOSED RESIDENTIAL DEVELOPMENT
AT 139 - 147 ARGYLE STREET,
NKIL 6005, 6035 R.P., 6036 R.P.,
6037 R.P. & 6038 R.P.

TITLE :
LOUVER SCHEDULE FOR
ALUM. LOUVER

DATE : 27-Apr-2020 SCALE : 1:40

DRAWN BY : LHR CHECKED BY : DW

美特铝质有限公司
MIDI ALUMINIUM FABRICATOR LTD.
Units 6-8, Sunray Industrial Centre, 1/F
610 Cha Kwo Ling Road, Kowloon
Tel:23489211-4 Fax:(852)27727666

DWG NO. : J852-SD-LVA-4010 REV. : D