

工程指示 / 要求簡箋(E.I.)

工程指示編號：EI / 222 / 20

修改版次：-

工程編號：J - 852

工程名稱：亞皆老街中電

工程項目：百葉地盤用鋁板+踢腳板(平台)

收件人：生統

發件人：Ant Yeung

日期：20/11/2020

要求提供 / 確認 事項：

- | | | |
|------------------------------------|-------------------------------------|-------------------------------|
| <input type="checkbox"/> 初步鋁料 B.M. | <input type="checkbox"/> 加工拆圖，然後生產 | <input type="checkbox"/> 尺寸表 |
| <input type="checkbox"/> 正式鋁料 B.M. | <input type="checkbox"/> 技術上資料 / 指示 | <input type="checkbox"/> 報價 |
| <input type="checkbox"/> 配件 B.M. | <input type="checkbox"/> 樣辦或貨品說明書 | <input type="checkbox"/> 分判合約 |
| <input type="checkbox"/> 其他：_____ | | |

內容：

請按加工圖生產鋁板送地盤安裝

請先生產電制房 10 隻百葉用鋁板送地盤，已在加工圖標示，其餘接住生產

謝謝。

請在 2020.11.27 前完成上列要求。

附：1 頁，2 頁 BM，2 頁圖登，27 頁加工圖

以上項目為：

- 原合約工程包 原合約工程加 / 減賬 新工程報價

原因：-

分發東莞各部門：

- | | | | |
|--|---|---|---|
| <input type="checkbox"/> 生產技術總監 <input type="checkbox"/> 連附件 | <input type="checkbox"/> 技術部 <input type="checkbox"/> 連附件 | <input type="checkbox"/> 生產部 <input type="checkbox"/> 連附件 | <input type="checkbox"/> 機械設計部 <input type="checkbox"/> 連附件 |
| <input type="checkbox"/> 採購部 <input type="checkbox"/> 連附件 | <input checked="" type="checkbox"/> 生產統籌部 <input checked="" type="checkbox"/> 連附件 | <input checked="" type="checkbox"/> 小羅 & 清 <input type="checkbox"/> 連附件 | |
| <input type="checkbox"/> 質檢部 <input type="checkbox"/> 連附件 | <input type="checkbox"/> 會計部 <input type="checkbox"/> 連附件 | <input type="checkbox"/> 報關組 <input type="checkbox"/> 連附件 | <input type="checkbox"/> 其他 <u>楊榮輝</u> <input type="checkbox"/> 連附件 |

分發其他分判：

- 水洪 連附件

分發香港各部門：

- | | | | |
|---|--|---|---|
| <input type="checkbox"/> 行政部 <input type="checkbox"/> 連附件 | <input type="checkbox"/> 會計部 <input type="checkbox"/> 連附件 | <input type="checkbox"/> 統籌部 <input type="checkbox"/> 連附件 | <input checked="" type="checkbox"/> 工程部地盤科文 <input checked="" type="checkbox"/> 連附件 <u>祥哥</u> |
| <input type="checkbox"/> 採購部 <input type="checkbox"/> 連附件 | <input type="checkbox"/> QS 部 <input type="checkbox"/> 連附件 | <input type="checkbox"/> 維修部 <input type="checkbox"/> 連附件 | <input type="checkbox"/> 其他 _____ <input type="checkbox"/> 連附件 |

傳遞編號：

HK 2664 / 20

發件人簽署：Ant Yeung

項目經理簽署：祥哥

B.S. CONSULTANT:

WONG & OUYANG (BU)

MAIN CONTRACTOR:

GAMMON ENGINEERING COMPANY LIMITED

ELECT. SUB-CONTRACT



GENSET SUB-CONTRACT



PROJECT: PROPOSED RESIDENTIAL 139-147 ARGYLE ST KOWLOON ISLAND LD 6035 R.P., 6036 R.F. 6038 R.P.

DRAWING FILE:

ELEVATION 2 (POD)A

DRAWN: Y.L.FUNG

CHECKED: W.Y.MA

SCALE: 1:100 @ A1

CAD REF.: BQ2552-313 ELEV.DWG.



ELEVATION 2 (FACING ARGYLE STREET)

Handwritten signature in a circle: (02/2/17)

圖則登記表
DRAWING REGISTER

		接收日期 Receiving Date (適用於客戶圖則)						
工程名稱 Project Title:	亞畢老街	年						
	平臺百頁地盤鋁板	月						
工程編號 Project No:	J-852	日						
分發予 Distributed To		發出日期 Issued Date						
		年	20					
		月	11					
		日	20					
圖則編號 Drg. No.	圖則名稱 Drawing Title	修訂編號 Revision No.						
	圖則登記表	1	-					
	圖則登記表	2	-					
	BM表	3	-					
	BM表	4	-					
J852-LVA-API-24	2mm厚鋁板加工圖	5	-					
J852-LVA-API-25	2mm厚鋁板加工圖	6	-					
J852-LVA-API-26	2mm厚鋁板加工圖	7	-					
J852-LVA-API-27	2mm厚鋁板加工圖	8	-					
J852-LVA-API-28	2mm厚鋁板加工圖	9	-					
J852-LVA-API-29	2mm厚鋁板加工圖	10	-					
J852-LVA-API-30	2mm厚鋁板加工圖	11	-					
J852-LVA-API-31	2mm厚鋁板加工圖	12	-					
J852-LVA-API-32	2mm厚鋁板加工圖	13	-					
J852-LVA-API-33	2mm厚鋁板加工圖	14	-					
J852-LVA-API-34	2mm厚鋁板加工圖	15	-					
J852-LVA-API-35	2mm厚鋁板加工圖	16	-					
J852-LVA-API-36	2mm厚鋁板加工圖	17	-					
J852-LVA-API-37	2mm厚鋁板加工圖	18	-					
J852-LVA-API-38	2mm厚鋁板加工圖	19	-					
J852-LVA-API-39	2mm厚鋁板加工圖	20	-					
J852-LVA-API-40	2mm厚鋁板加工圖	21	-					
J852-LVA-API-41	2mm厚鋁板加工圖	22	-					
J852-LVA-API-42	2mm厚鋁板加工圖	23	-					
J852-LVA-API-43	2mm厚鋁板加工圖	24	-					
J852-LVA-API-44	2mm厚鋁板加工圖	25	-					
J852-LVA-API-45	2mm厚鋁板加工圖	26	-					
J852-LVA-API-46	2mm厚鋁板加工圖	27	-					

BM編號:		工程號:		J852		計算:		Ivan		日期:		2020.11.20		送呈:											
修改內容		鋁板名稱		鋁板圖號		鋁板名稱		顏色		實用		後備		總數		總重量		總展開面積		單件V.F.		總V.F.		備註	
序號	修改內容	鋁板圖號	鋁板名稱	顏色	實用	後備	總數	總重量	單件展開面積	總展開面積	單件V.F.	總V.F.	備註	位置											
1		J852-LVA-API-24	2.0mm厚鋁板	MILL	10		10	9.346	0.115	1.150	0.000	0.000		百葉平台											
2		J852-LVA-API-25	2.0mm厚鋁板	MILL	5		5	4.819	0.119	0.593	0.000	0.000		百葉平台											
3		J852-LVA-API-26	2.0mm厚鋁板	MILL	5		5	4.819	0.119	0.593	0.000	0.000		百葉平台											
4		J852-LVA-API-27	2.0mm厚鋁板	UCT201498XL(A)-3	16		16	14.954	0.115	1.839	0.057	0.920		百葉平台											
5		J852-LVA-API-28	2.0mm厚鋁板	UCT201498XL(A)-3	8		8	7.711	0.119	0.948	0.059	0.474		百葉平台											
6		J852-LVA-API-29	2.0mm厚鋁板	UCT201498XL(A)-3	8		8	7.711	0.119	0.948	0.059	0.474		百葉平台											
7		J852-LVA-API-30	2.0mm厚鋁板	UCT201498XL(A)-3	1		1	0.615	0.151	0.151	0.076	0.076		百葉平台											
8		J852-LVA-API-31	2.0mm厚鋁板	UCT201498XL(A)-3	1		1	0.614	0.151	0.151	0.076	0.076		百葉平台											
9		J852-LVA-API-32	2.0mm厚鋁板	UCT201498XL(A)-3	1		1	0.615	0.151	0.151	0.076	0.076		百葉平台											
10		J852-LVA-API-33	2.0mm厚鋁板	MILL	60		60	29.795	0.122	7.330	0.000	0.000		百葉平台											
11		J852-LVA-API-34	2.0mm厚鋁板	MILL	60		60	29.209	0.120	7.186	0.000	0.000		百葉平台											
12		J852-LVA-API-35	2.0mm厚鋁板	MILL	60		60	29.795	0.122	7.330	0.000	0.000		百葉平台											
13		J852-LVA-API-36	2.0mm厚鋁板	UCT201498XL(A)-3	6		6	2.804	0.115	0.690	0.057	0.345		百葉平台											
14		J852-LVA-API-37	2.0mm厚鋁板	UCT201498XL(A)-3	3		3	1.446	0.119	0.356	0.059	0.178		百葉平台											
15		J852-LVA-API-38	2.0mm厚鋁板	UCT201498XL(A)-3	3		3	1.446	0.119	0.356	0.059	0.178		百葉平台											
16		J852-LVA-API-39	2.0mm厚鋁板	UCT201498XL(A)-3	2		2	1.296	0.159	0.319	0.080	0.159		百葉平台											
17		J852-LVA-API-40	2.0mm厚鋁板	UCT201498XL(A)-3	1		1	0.536	0.132	0.132	0.066	0.066		百葉平台											
18		J852-LVA-API-41	2.0mm厚鋁板	UCT201498XL(A)-3	1		1	0.536	0.132	0.132	0.066	0.066		百葉平台											
19		J852-LVA-API-42	2.0mm厚鋁板	UCT201498XL(A)-3	1		1	0.615	0.151	0.151	0.076	0.076		百葉平台											
20		J852-LVA-API-43	2.0mm厚鋁板	UCT201498XL(A)-3	1		1	0.614	0.151	0.151	0.076	0.076		百葉平台											

BM編號:		工程號:		計算:		日期:		送呈:					
美特鋁質 MIDI Aluminium Fabricator Ltd.		J852		Ivan		2020.11.20		副本:					
地盤名稱:		亞皆老街		核對:		日期:		副本:					
項目類別:		百頁平台地盤用鋁板		A/C Code:		總V.F.:		總重量:					
修改版次:						17.51		255.95					
序號	修改內容	鋁板圖號	鋁板名稱	顏色	實用	後備	總數	總重量	總展開面積		備註	位置	
									單件展開面積	總展開面積			單件V.F.
					平方米	平方米		平方米					
21		J852-LVA-API-44	2.0mm厚鋁板	UCT201498XL(A)-3	1		1	0.615	0.151	0.151	0.076	0.076	百葉平台
22		J852-LVA-API-45	2.0mm厚鋁板	UCT201498XL(A)-3	60		60	29.795	0.122	7.330	0.061	3.665	百葉平台
23		J852-LVA-API-46	2.0mm厚鋁板	UCT201498XL(A)-3	60		60	29.209	0.120	7.186	0.060	3.593	百葉平台
24		J852-LVA-API-47	3.0mm厚鋁板	UCT201498XL(A)-3	60		60	29.795	0.122	7.330	0.061	3.665	百葉平台
25		J852-LVA-API-48	3.0mm厚鋁板	UCT201498XL(A)-3	10		10	8.704	0.214	2.141	0.165	1.654	百葉平台
26		J852-LVA-API-49	3.0mm厚鋁板	UCT201498XL(A)-3	5		5	4.270	0.210	1.050	0.162	0.811	百葉平台
27		J852-LVA-API-50	3.0mm厚鋁板	UCT201498XL(A)-3	5		5	4.270	0.210	1.050	0.162	0.811	百葉平台

總計: 454 255.95 56.89 17.51



美特鋁質 有限公司
MIDI Aluminium Fabricator Ltd.

工程號



J852

地盤

亞皆老街

序號	物料編號	數量
01	AP1-24	10

先出2件
其餘按位生產

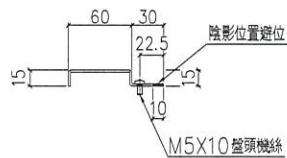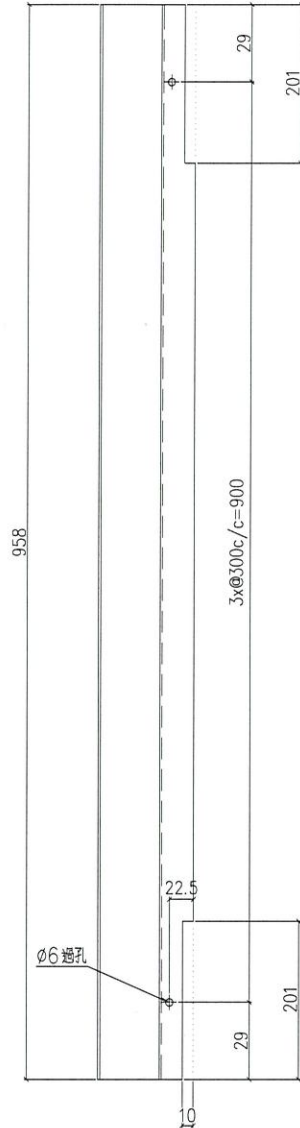

室外

名稱	鋁折件加工圖	制圖	Ivan	2020.11.13	修改			
材料	2mm厚鋁板	復核	-	-	日期			
顏色	MILL	批準			圖號	J852-LVA-AP1-24		



美特鋁質 有限公司
MIDI Aluminium Fabricator Ltd.


工程號

J852


地盤

亞皆老街

序號	物料編號	數量
01	AP1-25	5

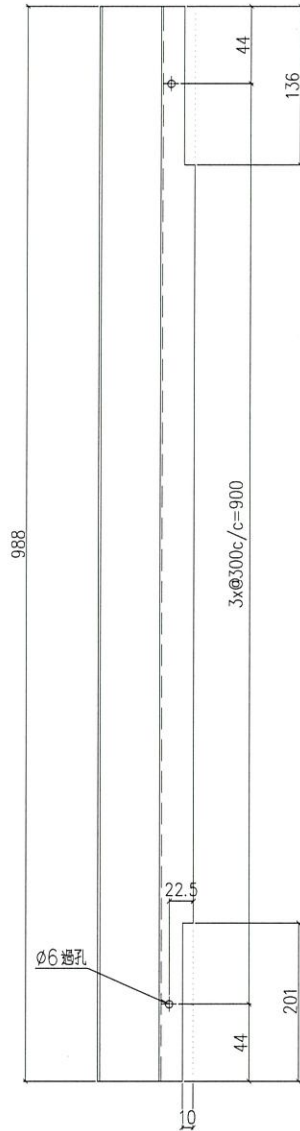

先做 2 件
其餘接位

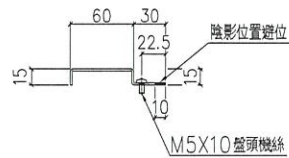

室外

名稱	鋁折件加工圖	制圖	Ivan	2020.11.13	修改			
材料	2mm厚鋁板	復核	-	-	日期			
顏色	MILL	批準			圖號	J852-LVA-AP1-25		



美特鋁質 有限公司
MIDI Aluminium Fabricator Ltd.


工程號

J852


地盤

亞皆老街

序號	物料編號	數量
01	AP1-26	5

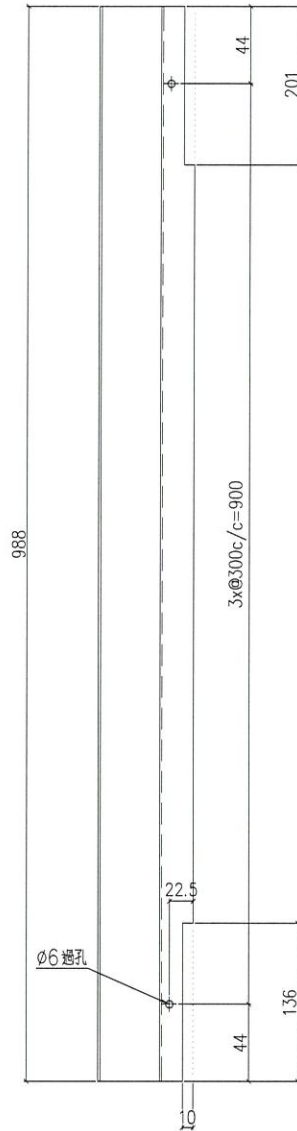

先鑄 2 件
其餘按位鑄

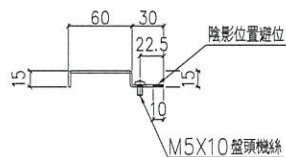

室外


名稱	鋁折件加工圖	制圖	Ivan	2020.11.13	修改			
材料	2mm 厚鋁板	復核	-	-	日期			
顏色	MILL	批準			圖號	J852-LVA-AP1-26		




美特鋁質 有限公司
MIDI Aluminium Fabricator Ltd.

工程號 J852 地盤 亞皆老街

序號	物料編號	數量
01	AP1-27	16

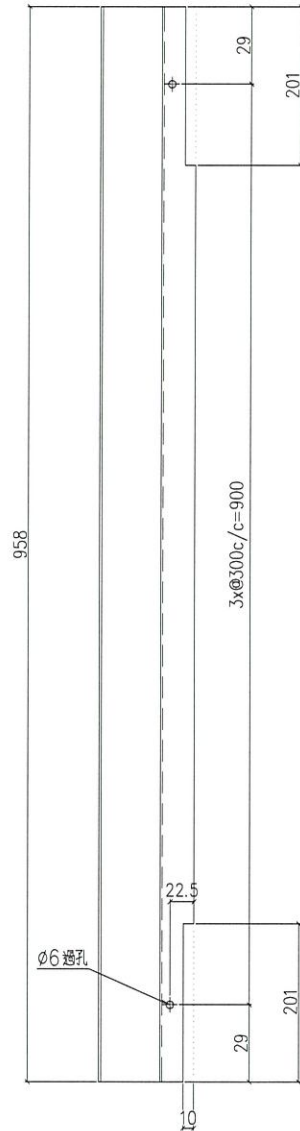

共生產4件
共線接位生產

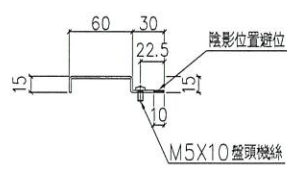

室外



SCALE 2:1

名稱	鋁折件加工圖	制圖	Ivan	2020.11.13	修改		
材料	2mm厚鋁板	復核	-	-	日期		
顏色	UCT201498XL(A)-3	批準			圖號	J852-LVA-AP1-27	



美特鋁質 有限公司
MIDI Aluminium Fabricator Ltd.

工程號

J852

地盤

亞皆老街

序號



物料編號

數量

01

AP1-28

8

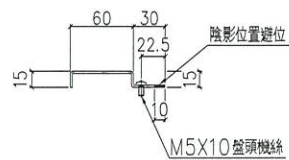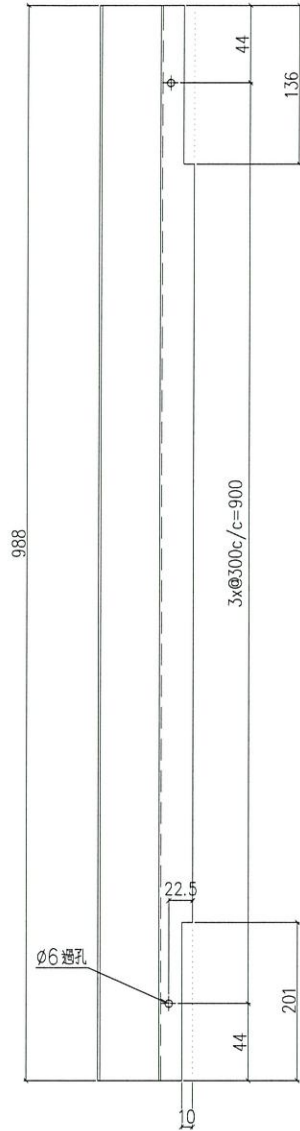

室外

先車直 2 件
螺絲接位生產



SCALE 2:1

名稱	鋁折件加工圖	制圖	Ivan	2020.11.13	修改		
材料	2mm 厚鋁板	復核	-	-	日期		
顏色	UCT201498XL(A)-3	批準			圖號	J852-LVA-AP1-28	



美特鋁質 有限公司
MIDI Aluminium Fabricator Ltd.

工程號

J852

地盤

亞皆老街

序號


物料編號

數量


01

AP1-29


8

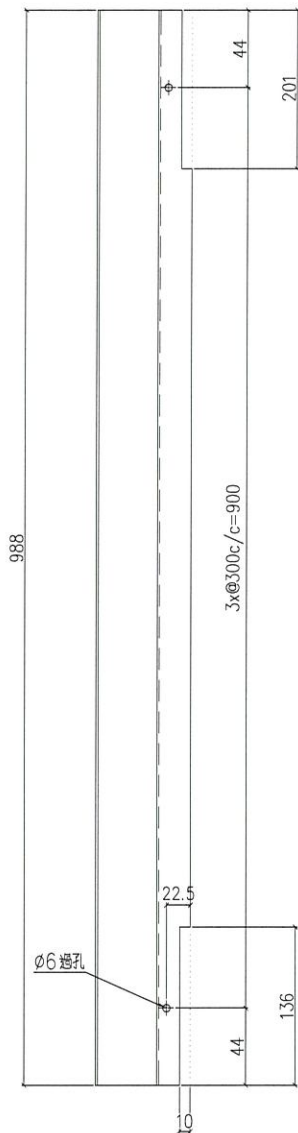

先生產2件
其餘接位生產

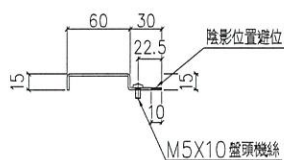

室外

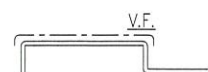

SCALE 2:1

名稱	鋁折件加工圖	制圖	Ivan	2020.11.13	修改			
材料	2mm厚鋁板	復核	-	-	日期			
顏色	UCT201498XL(A)-3	批準			圖號	J852-LVA-AP1-29		



美特鋁質 有限公司
MIDI Aluminium Fabricator Ltd.

工程號

J852

地盤

亞皆老街

序號



物料編號

數量

01

AP1-30

1

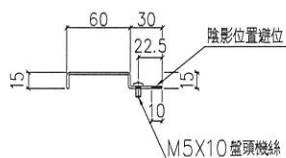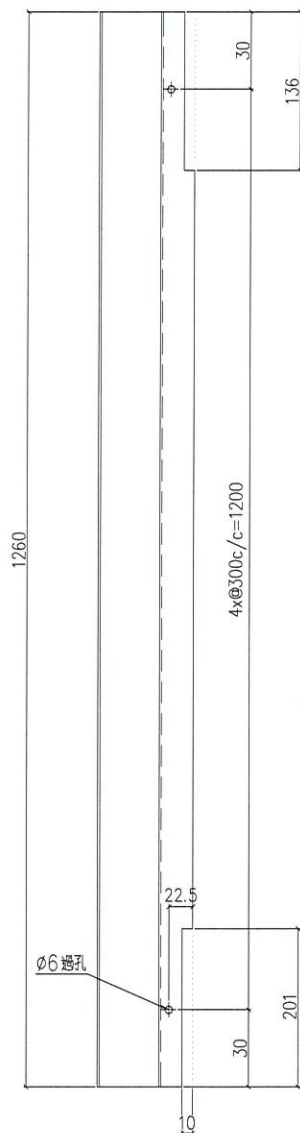

室外



SCALE 2:1

名稱	鋁折件加工圖	制圖	Ivan	2020.11.13	修改		
材料	2mm厚鋁板	復核	-	-	日期		
顏色	UCT201498XL(A)-3	批準			圖號	J852-LVA-AP1-30	



美特鋁質 有限公司
MIDI Aluminium Fabricator Ltd.

工程號

J852

地盤

亞皆老街

序號



物料編號

數量

01

AP1-31

1

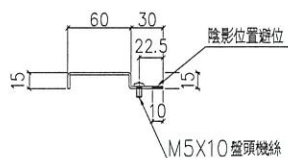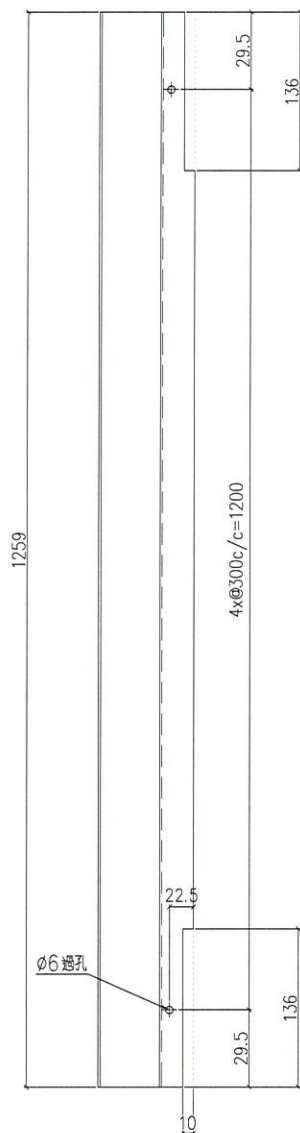

室外



SCALE 2:1



名稱	鋁折件加工圖	制圖	Ivan	2020.11.13	修改			
材料	2mm厚鋁板	復核	-	-	日期			
顏色	UCT201498XL(A)-3	批准			圖號	J852-LVA-AP1-31		




美特鋁質 有限公司
MIDI Aluminium Fabricator Ltd.

工程號 J852 地盤 亞皆老街

序號	物料編號	數量
01	AP1-32	1

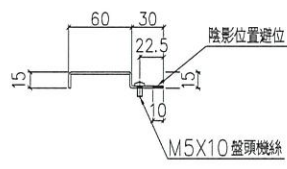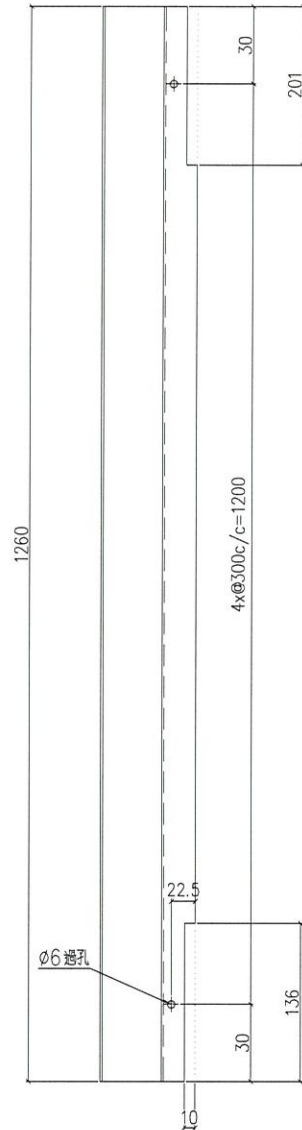

室外

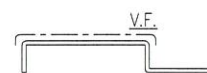

SCALE 2:1

名稱	鋁折件加工圖	制圖	Ivan	2020.11.13	修改			
材料	2mm厚鋁板	復核	-	-	日期			
顏色	UCT201498XL(A)-3	批準			圖號	J852-LVA-AP1-32		



美特鋁質 有限公司
MIDI Aluminium Fabricator Ltd.

工程號

J852

地盤

亞皆老街

序號



物料編號

數量

01

AP1-33

60

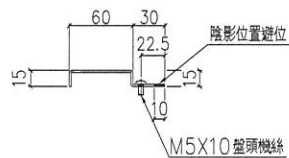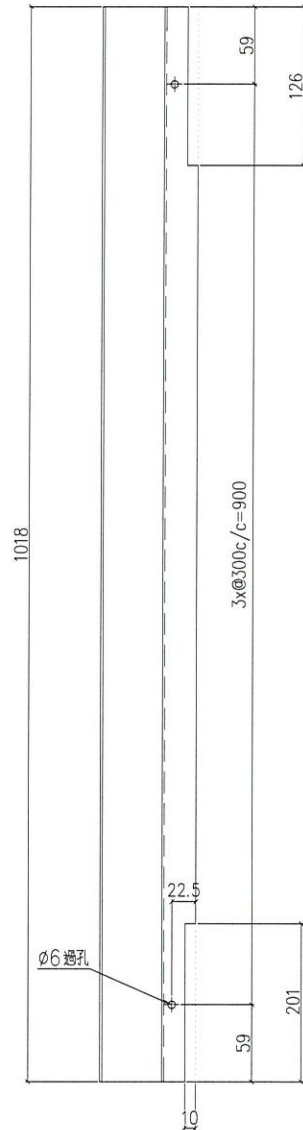

室外

名稱	鋁折件加工圖	制圖	Ivan	2020.11.13	修改			
材料	2mm厚鋁板	復核	-	-	日期			
顏色	MILL	批準			圖號	J852-LVA-AP1-33		



美特鋁質 有限公司
MIDI Aluminium Fabricator Ltd.



工程號

J852

地盤

亞皆老街

序號	物料編號	數量
01	AP1-34	60

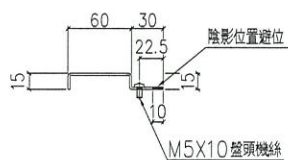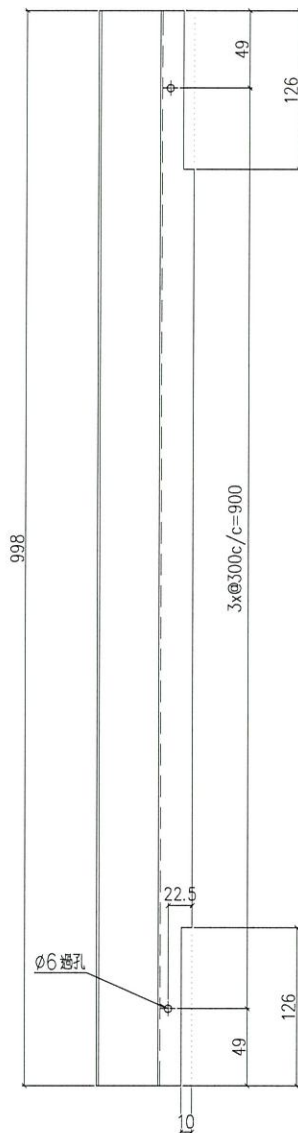

室外



名稱	鋁折件加工圖	制圖	Ivan	2020.11.13	修改			
材料	2mm厚鋁板	復核	-	-	日期			
顏色	MILL	批準			圖號	J852-LVA-AP1-34		



美特鋁質 有限公司
MIDI Aluminium Fabricator Ltd.

工程號 J852 地盤 亞皆老街

序號	物料編號	數量
01	AP1-35	60

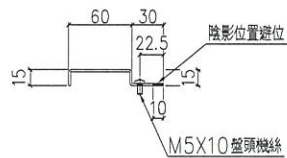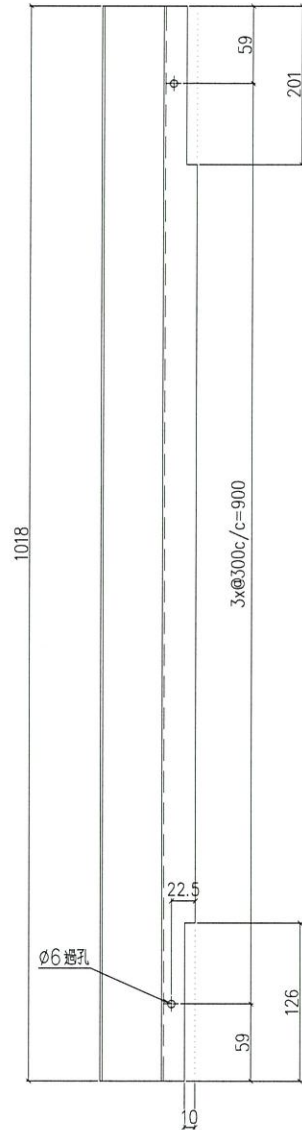

室外

名稱	鋁折件加工圖	制圖	Ivan	2020.11.13	修改			
材料	2mm厚鋁板	復核	-	-	日期			
顏色	MILL	批準			圖號	J852-LVA-AP1-35		



美特鋁質 有限公司
MIDI Aluminium Fabricator Ltd.

工程號

J852

地盤

亞皆老街

序號



物料編號

數量

01

AP1-36

6

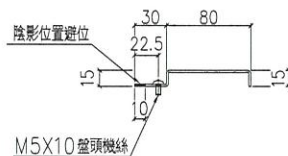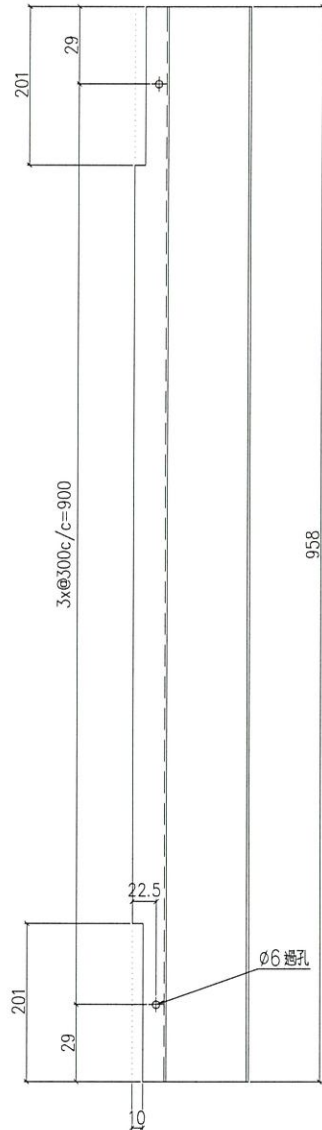

室外



SCALE 2:1



名稱	鋁折件加工圖	制圖	Ivan	2020.11.13	修改			
材料	2mm厚鋁板	復核	-	-	日期			
顏色	UCT201498XL(A)-3	批準			圖號	J852-LVA-AP1-36		



美特鋁質 有限公司
MIDI Aluminium Fabricator Ltd.

工程號 J852 地盤 亞皆老街

序號	物料編號	數量
01	AP1-37	3

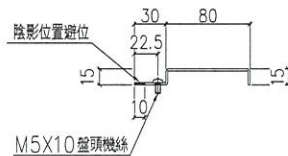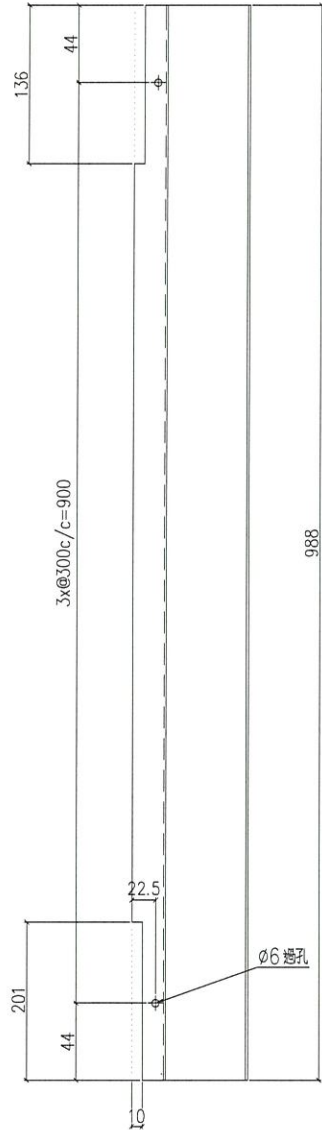

室外



SCALE 2:1

名稱	鋁折件加工圖	制圖	Ivan	2020.11.13	修改		
材料	2mm厚鋁板	復核	-	-	日期		
顏色	UCT201498XL(A)-3	批準			圖號	J852-LVA-AP1-37	



美特鋁質 有限公司
MIDI Aluminium Fabricator Ltd.

工程號

J852

地盤

亞皆老街

序號



物料編號

數量


01

AP1-38

3

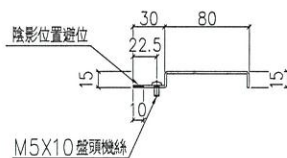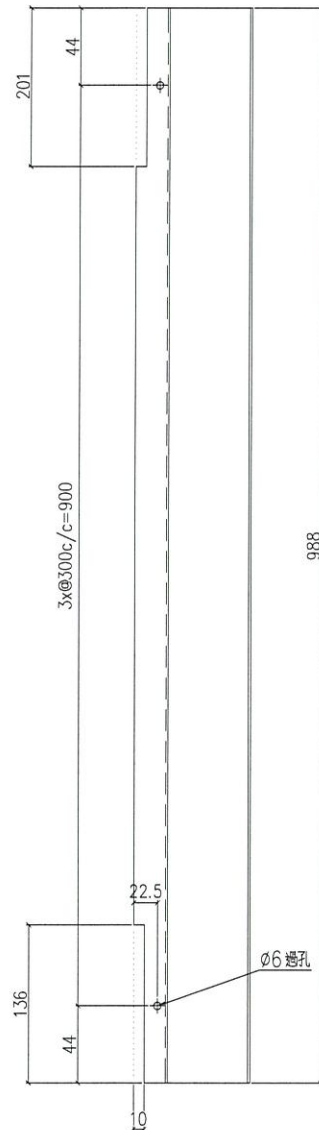

室外

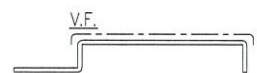

SCALE 2:1

名稱	鋁折件加工圖	制圖	Ivan	2020.11.13	修改			
材料	2mm厚鋁板	復核	-	-	日期			
顏色	UCT201498XL(A)-3	批準			圖號	J852-LVA-AP1-38		



美特鋁質 有限公司
MIDI Aluminium Fabricator Ltd.

工程號

J852

地盤

亞皆老街

序號



物料編號

數量


01

AP1-39

2

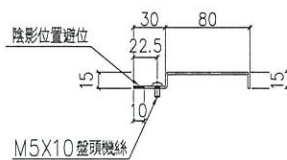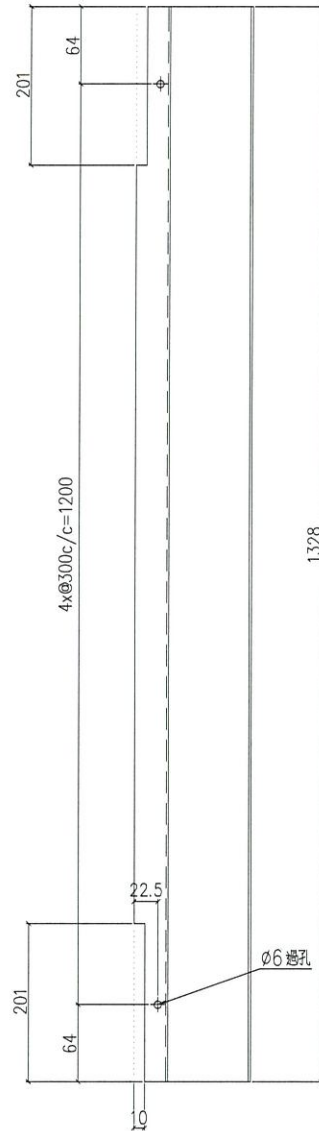

室外

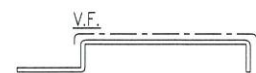

SCALE 2:1



名稱	鋁折件加工圖	制圖	lvn	2020.11.13	修改		
材料	2mm厚鋁板	復核	-	-	日期		
顏色	UCT201498XL(A)-3	批準			圖號	J852-LVA-AP1-39	



美特鋁質 有限公司
MIDI Aluminium Fabricator Ltd.

工程號 J852 地盤 亞皆老街

序號	物料編號	數量
01	AP1-40	1

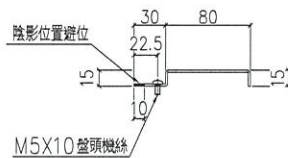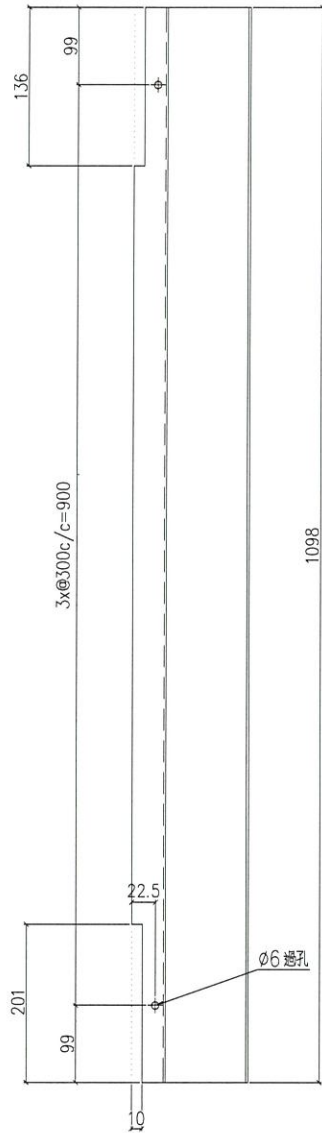

室外



SCALE 2:1

名稱	鋁折件加工圖	制圖	Ivan	2020.11.13	修改			
材料	2mm厚鋁板	復核	-	-	日期			
顏色	UCT201498XL(A)-3	批準			圖號	J852-LVA-AP1-40		



美特鋁質 有限公司
MIDI Aluminium Fabricator Ltd.

工程號

J852

地盤

亞皆老街

序號



物料編號

數量


01

AP1-41

1

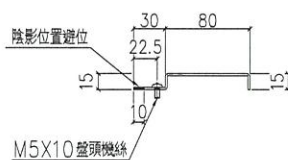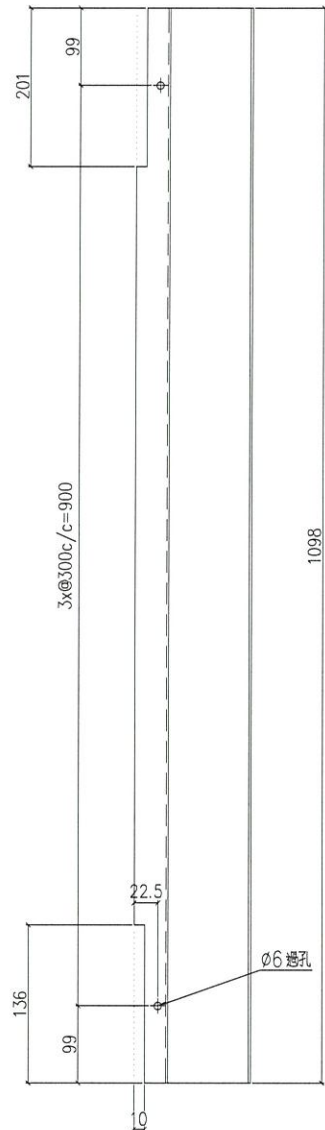

室外

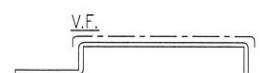

SCALE 2:1

名稱	鋁折件加工圖	制圖	Ivan	2020.11.13	修改			
材料	2mm厚鋁板	復核	-	-	日期			
顏色	UCT201498XL(A)-3	批準			圖號	J852-LVA-AP1-41		



美特鋁質 有限公司
MIDI Aluminium Fabricator Ltd.

工程號

J852

地盤

亞皆老街

序號



物料編號

數量


01

AP1-42

1

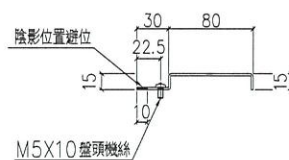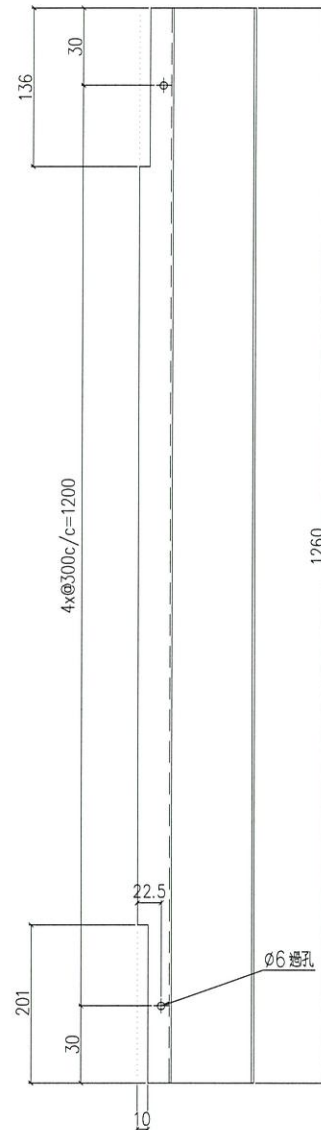

室外

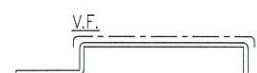

SCALE 2:1



名稱	鋁折件加工圖	制圖	Ivan	2020.11.13	修改			
材料	2mm厚鋁板	復核	-	-	日期			
顏色	UCT201498XL(A)-3	批準			圖號	J852-LVA-AP1-42		



美特鋁質 有限公司
MIDI Aluminium Fabricator Ltd.

工程號 J852 地盤 亞皆老街

序號	物料編號	數量
01	AP1-43	1

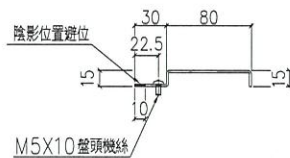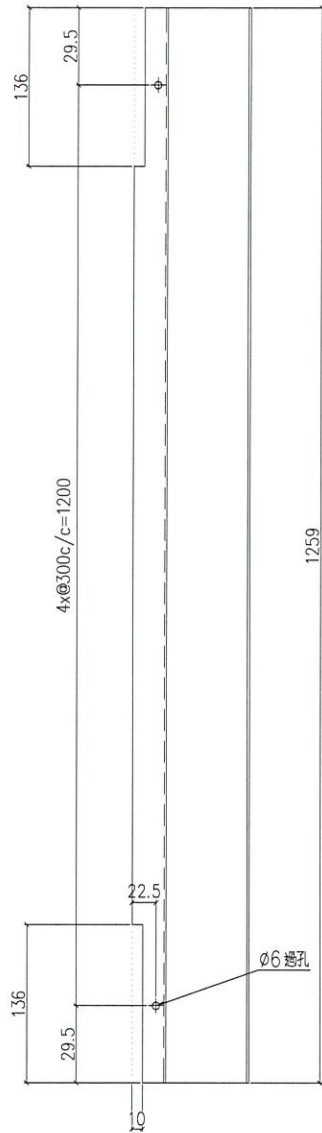

室外



SCALE 2:1



名稱	鋁折件加工圖	制圖	Ivan	2020.11.13	修改		
材料	2mm厚鋁板	復核	-	-	日期		
顏色	UCT201498XL(A)-3	批準			圖號	J852-LVA-AP1-43	



美特鋁質 有限公司
MIDI Aluminium Fabricator Ltd.

工程號 J852 地盤 亞皆老街

序號	物料編號	數量
01	AP1-44	1

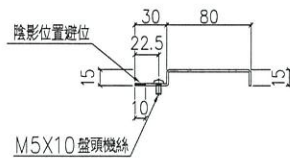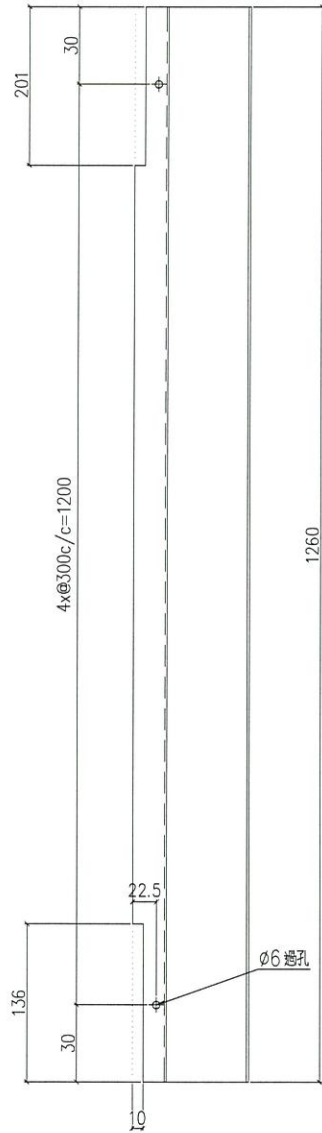

室外



SCALE 2:1



名稱	鋁折件加工圖	制圖	Ivan	2020.11.13	修改			
材料	2mm厚鋁板	復核	-	-	日期			
顏色	UCT201498XL(A)-3	批準			圖號	J852-LVA-AP1-44		



美特鋁質 有限公司
MIDI Aluminium Fabricator Ltd.

序號	物料編號	數量
01	AP1-45	60

工程號	J852	地盤	亞皆老街
-----	------	----	------

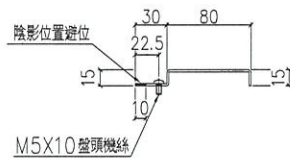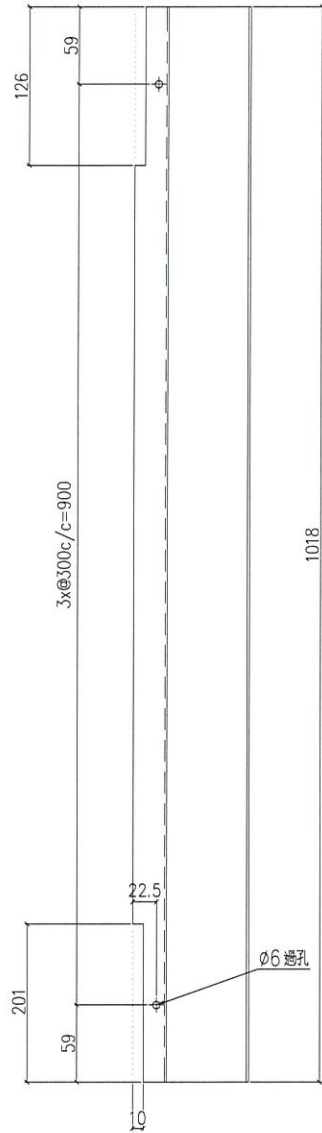

室外



SCALE 2:1

名稱	鋁折件加工圖	制圖	Ivan	2020.11.13	修改		
材料	2mm厚鋁板	復核	-	-	日期		
顏色	UCT201498XL(A)-3	批準			圖號	J852-LVA-AP1-45	



美特鋁質 有限公司
MIDI Aluminium Fabricator Ltd.

工程號

J852

地盤

亞皆老街

序號



物料編號

數量

01

AP1-46

60

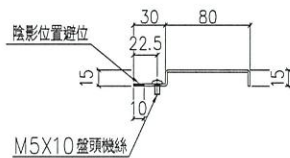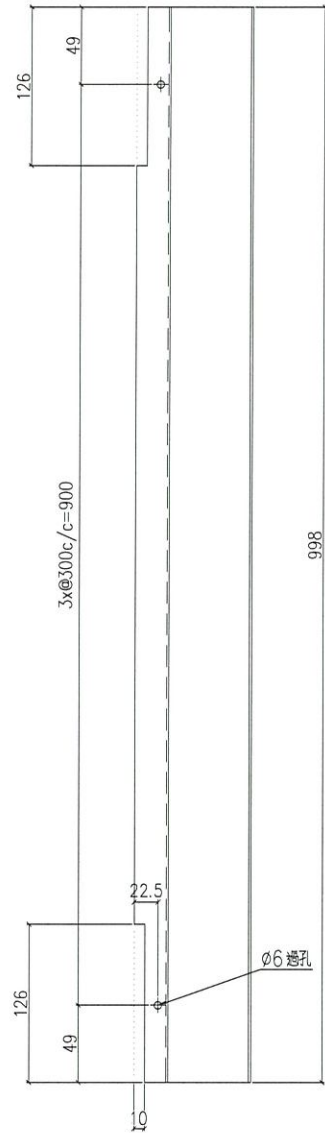

室外



SCALE 2:1



名稱	鋁折件加工圖	制圖	Ivan	2020.11.13	修改			
材料	2mm厚鋁板	復核	-	-	日期			
顏色	UCT201498XL(A)-3	批準			圖號	J852-LVA-AP1-46		



美特鋁質 有限公司
MIDI Aluminium Fabricator Ltd.

工程號 J852 地盤 亞皆老街

序號	物料編號	數量
01	AP1-47	60

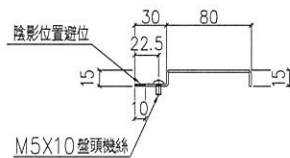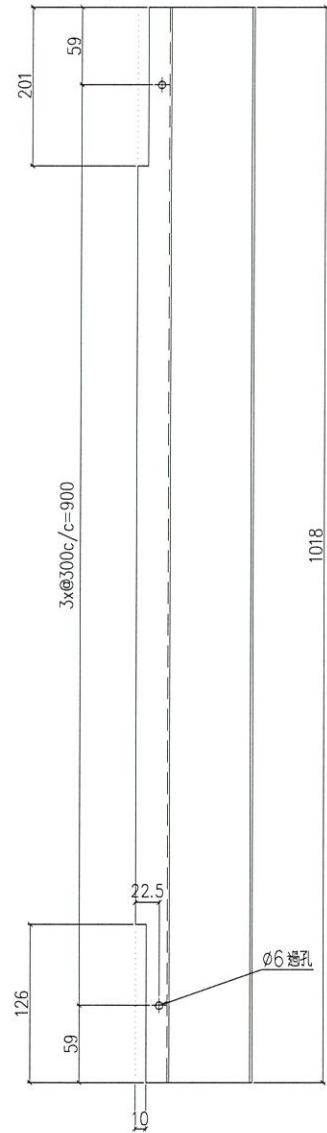

室外



SCALE 2:1


名稱	鋁折件加工圖	制圖	Ivan	2020.11.13	修改		
材料	2mm厚鋁板	復核	-	-	日期		
顏色	UCT201498XL(A)-3	批准			圖號	J852-LVA-AP1-47	




美特鋁質 有限公司
MIDI Aluminium Fabricator Ltd.

序號	物料編號	數量
01	AP1-48	10

工程號	J852	地盤	亞皆老街
-----	------	----	------

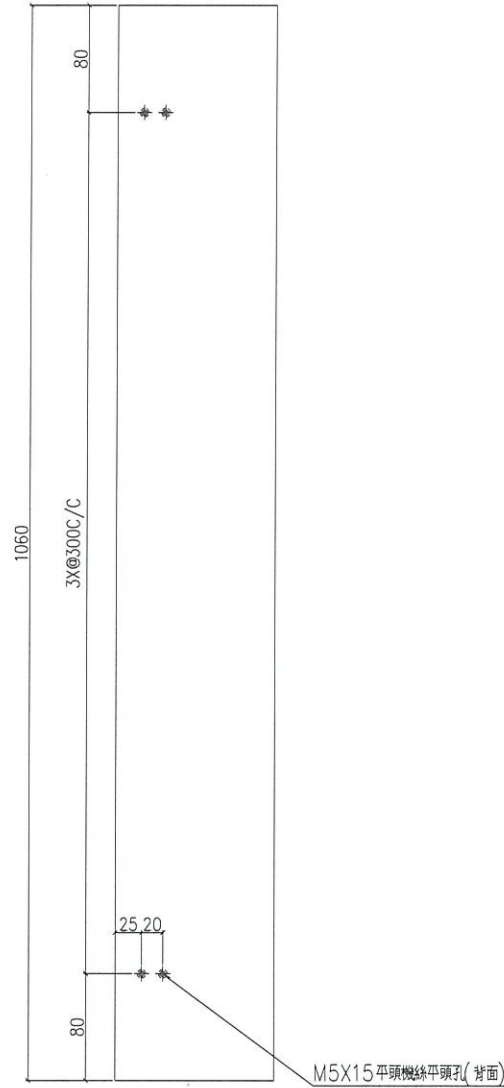

先鑿2件
其餘接自鑿

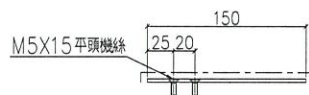


名稱	鋁折件加工圖	制圖	Ivan	2020.11.13	修改		
材料	3mm厚鋁板 (3003H14)	復核	-	-	日期		
顏色	UCT201498XL(A)-3	批準			圖號	J852-LVA-AP1-48	




美特鋁質 有限公司
MIDI Aluminium Fabricator Ltd.

序號	物料編號	數量
01	AP1-49	5

工程號	J852	地盤	亞皆老街
-----	------	----	------

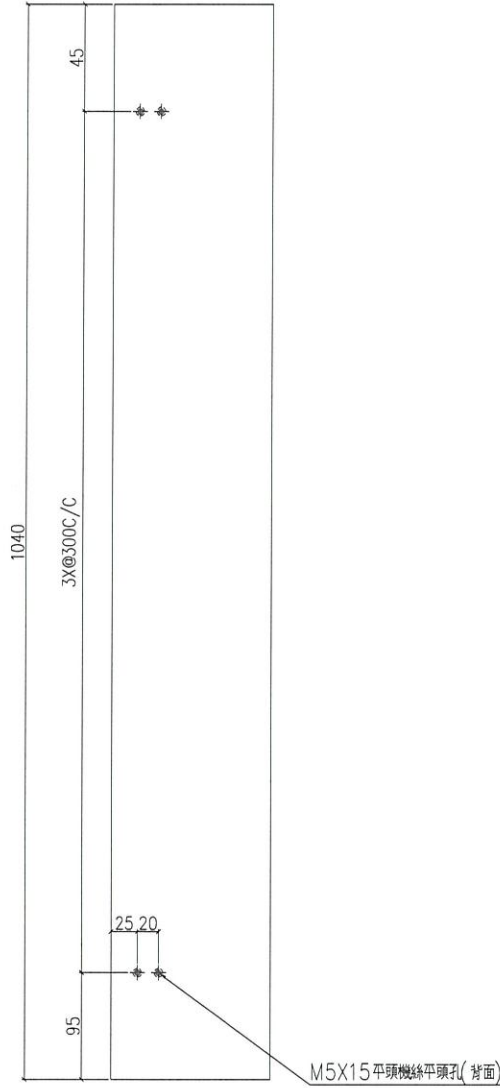

共2件
其餘全生產

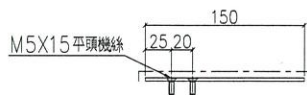

名稱	鋁折件加工圖	制圖	Ivan	2020.11.13	修改		
材料	3mm厚鋁板 (3003H14)	復核	-	-	日期		
顏色	UCT201498XL(A)-3	批準			圖號	J852-LVA-AP1-49	



美特鋁質 有限公司
MIDI Aluminium Fabricator Ltd.

工程號

J852

地盤

亞皆老街

序號


物料編號

數量


01

AP1-50


5

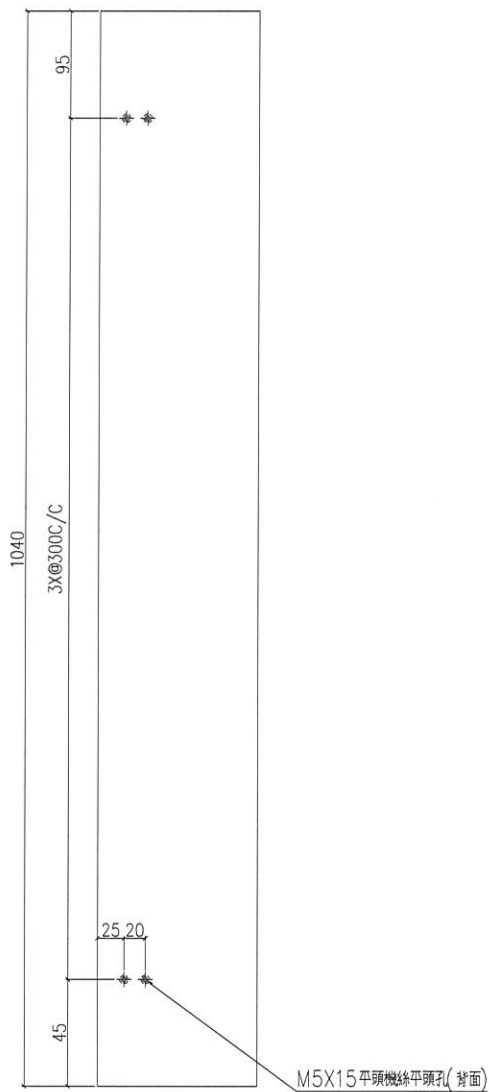


先鑿 2 件
其後接位 鑿

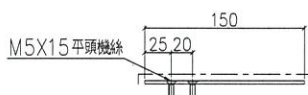

名稱	鋁折件加工圖	制圖	Ivan	2020.11.13	修改			
材料	3mm厚鋁板 (3003H14)	復核	-	-	日期			
顏色	UCT201498XL(A)-3	批準			圖號	J852-LVA-AP1-50		

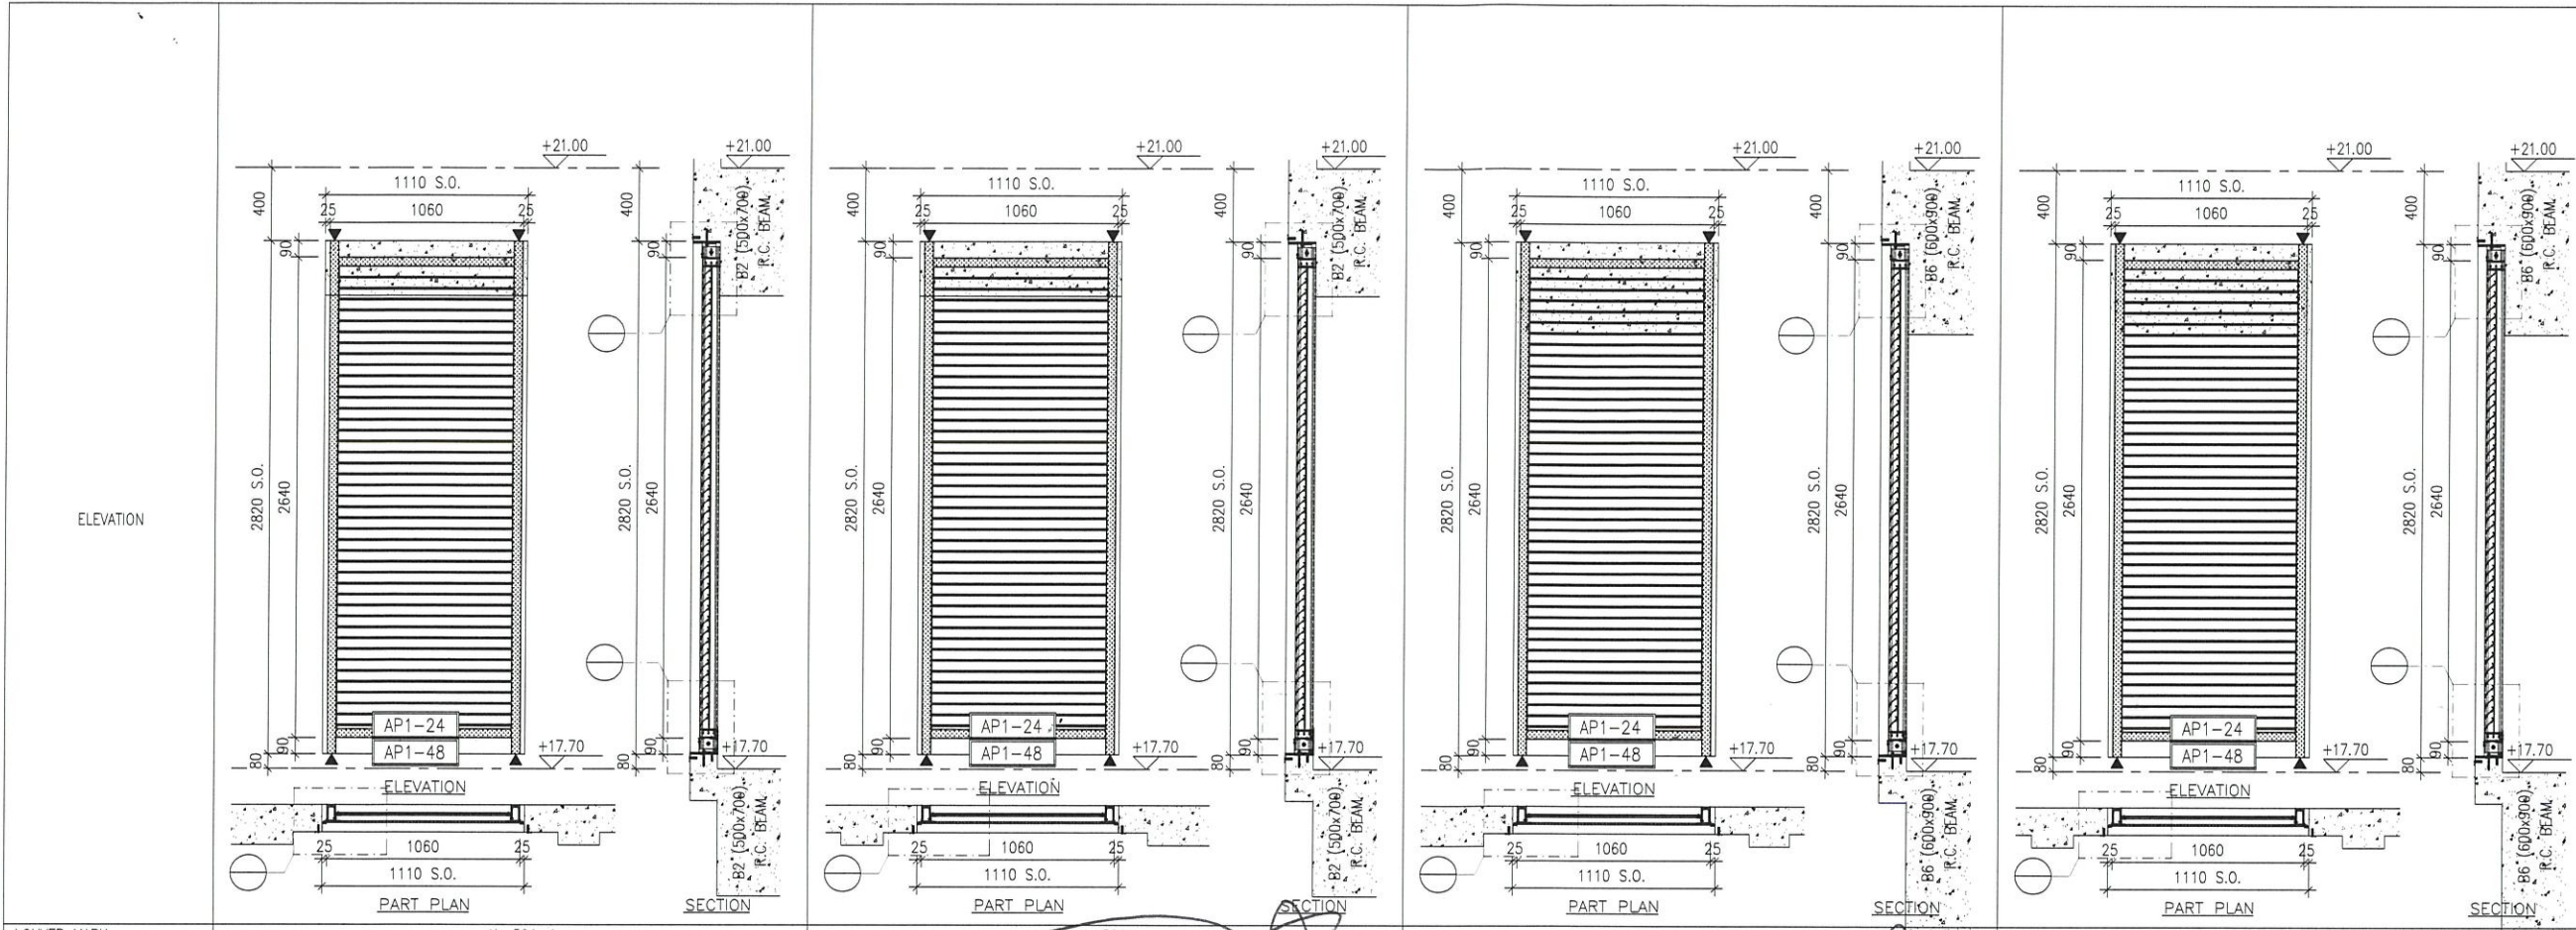

LOUVER MARK	AL-501	AL-501a	AL-501b	AL-501c
LOCATION	FLOOR LG2/F	FLOOR LG2/F	FLOOR LG2/F	FLOOR LG2/F
ROOM	FAN ROOM	EMERGENCY GENSET ROOM	EMERGENCY GENSET ROOM	LV SWITCH ROOM 1
QUANTITY	1	1	1	1
REMARKS	WEATHERPROOF LOUVER (60% FREE AREA)	WEATHERPROOF LOUVER (60% FREE AREA)	WEATHERPROOF LOUVER (60% FREE AREA)	WEATHERPROOF LOUVER (60% FREE AREA)

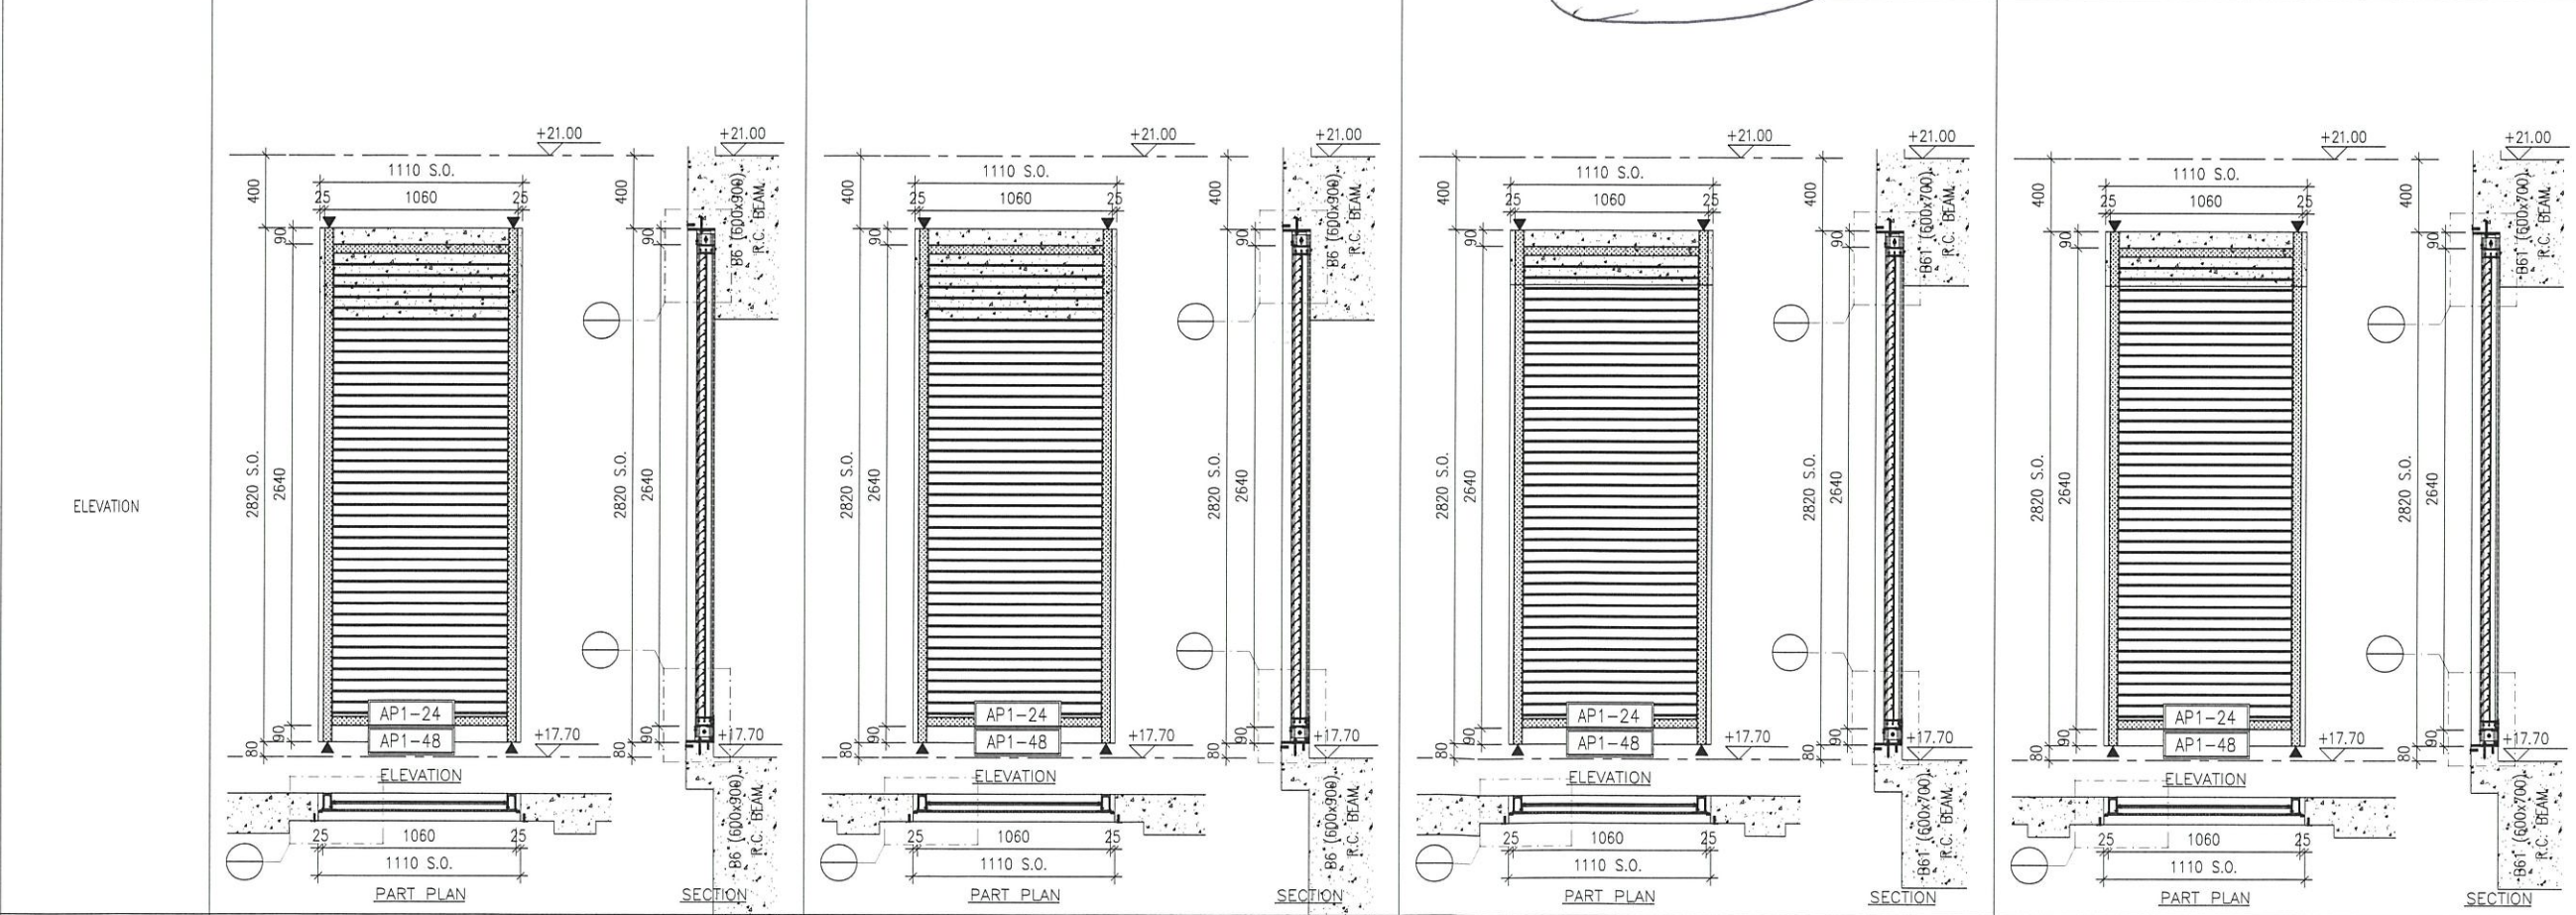

LOUVER MARK	AL-501d	AL-501e	AL-501f	AL-501g
LOCATION	FLOOR LG2/F	FLOOR LG2/F	FLOOR LG2/F	FLOOR LG2/F
ROOM	LV SWITCH ROOM 1	A/C PLANT ROOM	A/C PLANT ROOM	CARPARK FAN ROOM
QUANTITY	1	1	1	1
REMARKS	WEATHERPROOF LOUVER (60% FREE AREA)	WEATHERPROOF LOUVER (60% FREE AREA)	WEATHERPROOF LOUVER (60% FREE AREA)	WEATHERPROOF LOUVER (60% FREE AREA)

B.D. REF :

CLIENT :

ARCHITECT : **AGC DESIGN LTD**

MAIN CONTRACTOR : **Gammon**

STRUCTURAL ENGINEER : **ARUP**

FAÇADE CONSULTANT : **MEINHARDT**

NOTE :

- ALL DIMENSIONS ARE IN mm.
- ALL ELEVATIONS ARE VIEWED FROM OUTSIDE.
- ALL DIMENSIONS TO BE VERIFIED ON SITE BEFORE FABRICATION.

LEGEND :

X1 --- DETAIL MARK NO.
X001 --- REFER SHEET NO.

- F.F.L. --- FINISHED FLOOR LEVEL
- S.F.L. --- STRUCTURAL FLOOR LEVEL
- S.O. --- STRUCTURAL OPENING
- ▲ --- FIXING LOCATION
- ▽ --- STRUCTURAL FLOOR LEVEL MARK

NO.	DATE	REVISION	BY
C	05-06-2020	REVISION SUBJECT TO COMMENTS	MN
B	27-04-2020	REVISION SUBJECT TO COMMENTS	MN
A	19-02-2020	REVISION SUBJECT TO COMMENTS	MN

JOB NO. : J-852

PROJECT : PROPOSED RESIDENTIAL DEVELOPMENT AT 139 - 147 ARGYLE STREET, NKIL 6005, 6035 R.P., 6036 R.P., 6037 R.P. & 6038 R.P.

TITLE : LOUVER SCHEDULE FOR ALUM. LOUVER




DATE : 12-Feb-2020 SCALE : 1:40

DRAWN BY : LHR CHECKED BY : DW

美特铝质有限公司
MIDI ALUMINIUM FABRICATOR LTD.
Units 6-8, Sunray Industrial Centre, 1/F
610 Cha Kwo Ling Road, Kowloon
Tel:23489211-4 Fax:(852)2772666

DWG NO. : J852-SD-LVA-4001 REV. : C

ELEVATION

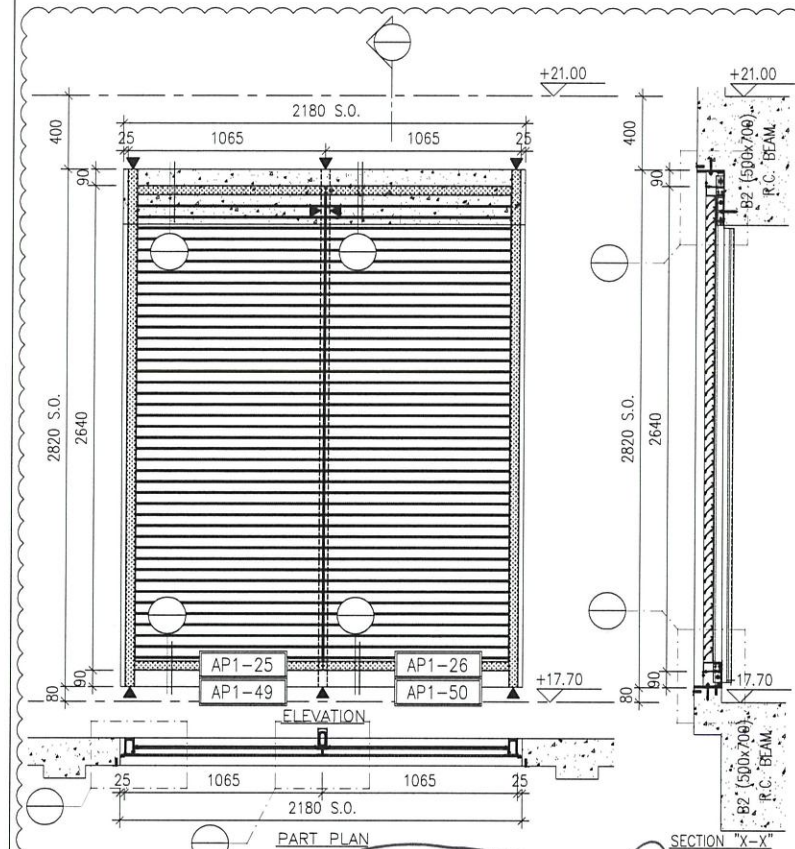
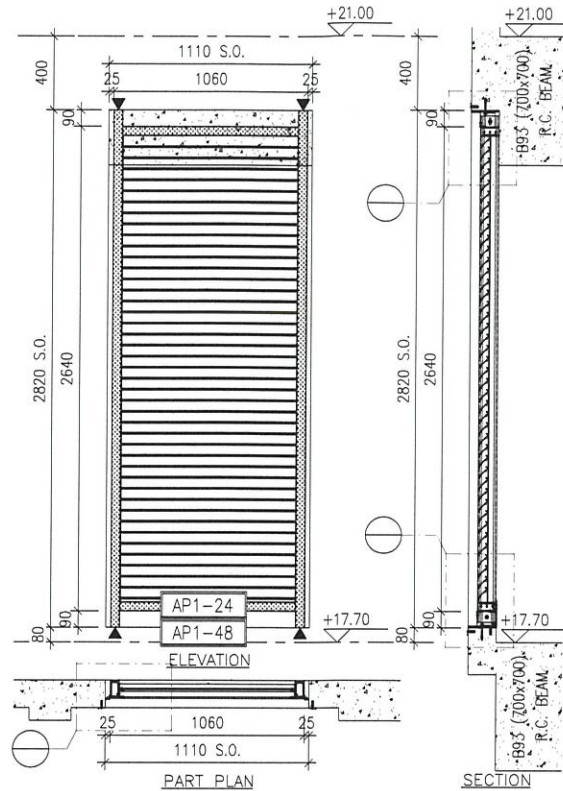
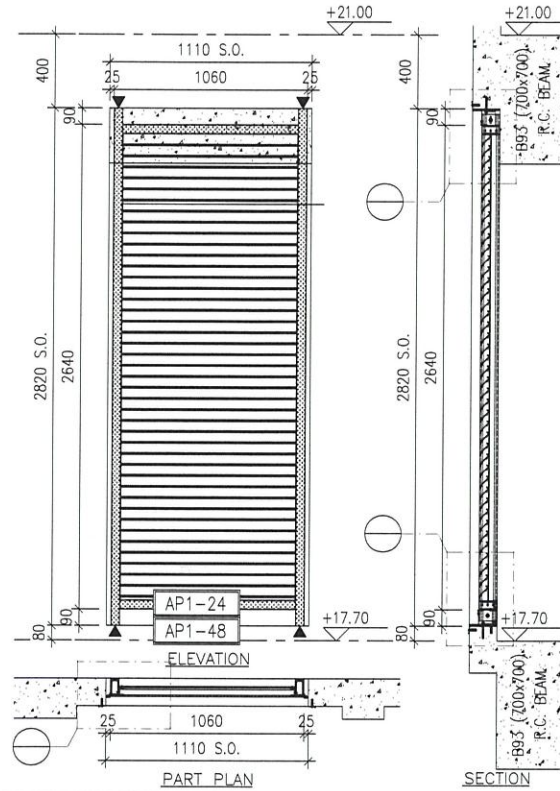


LOUVER MARK	AL-501h
LOCATION	LG2/F
FLOOR ROOM	CARPARK
QUANTITY	1
REMARKS	WEATHERPROOF LOUVER (60% FREE AREA)

LOUVER MARK	AL-501j
LOCATION	LG2/F
FLOOR ROOM	CARPARK
QUANTITY	1
REMARKS	WEATHERPROOF LOUVER (60% FREE AREA)

LOUVER MARK	AL-502
LOCATION	LG2/F
FLOOR ROOM	EMERGENCY GENSET ROOM
QUANTITY	1
REMARKS	WEATHERPROOF LOUVER (60% FREE AREA)

ELEVATION

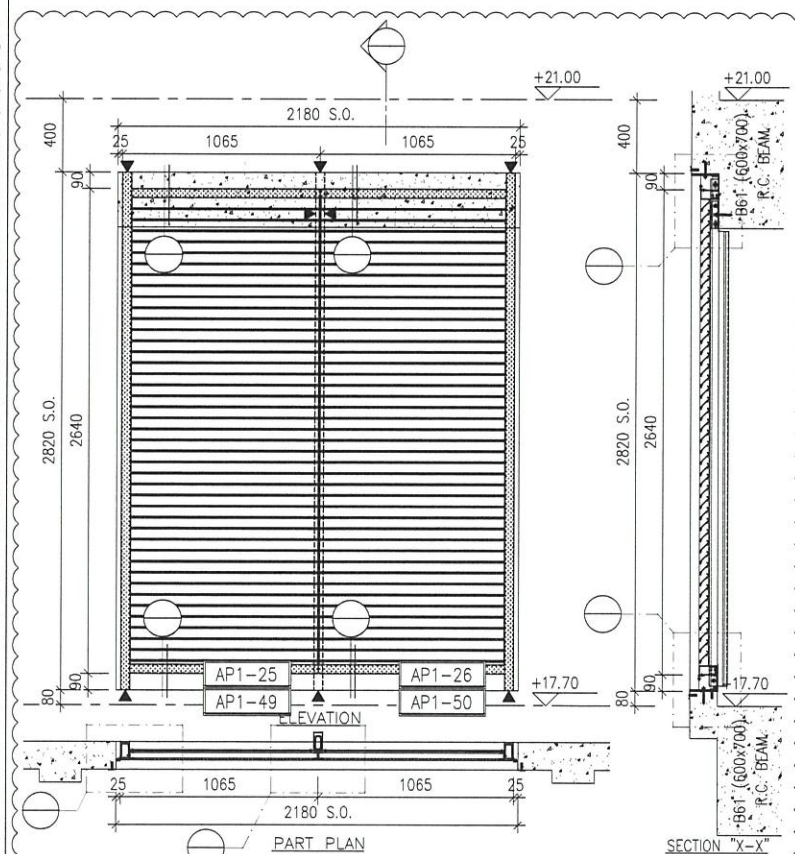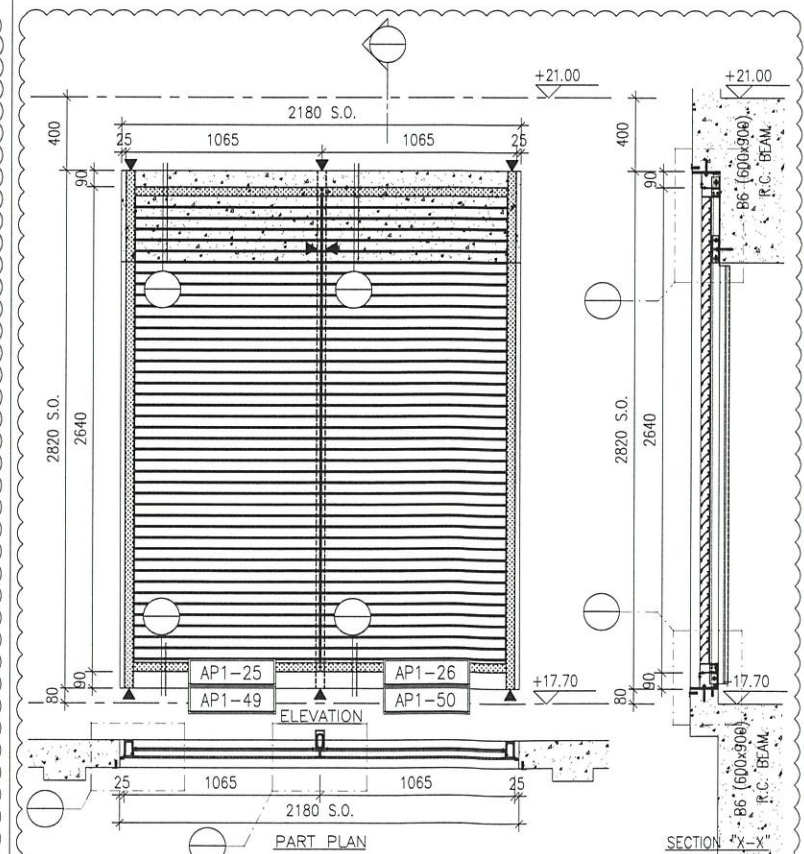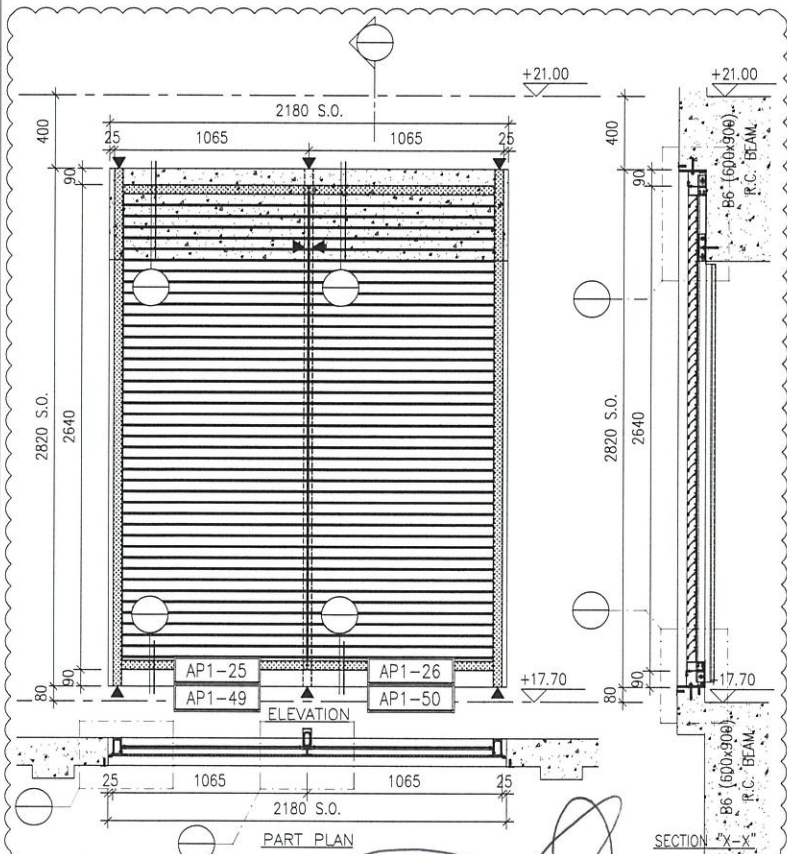

LOUVER MARK	AL-502a
LOCATION	LG2/F
FLOOR ROOM	EMERGENCY GENSET ROOM
QUANTITY	1
REMARKS	WEATHERPROOF LOUVER (60% FREE AREA)

LOUVER MARK	AL-502b
LOCATION	LG2/F
FLOOR ROOM	A/C PLANT ROOM
QUANTITY	1
REMARKS	WEATHERPROOF LOUVER (60% FREE AREA)

LOUVER MARK	AL-502c
LOCATION	LG2/F
FLOOR ROOM	CARPARK FAN ROOM
QUANTITY	1
REMARKS	WEATHERPROOF LOUVER (60% FREE AREA)

B.D. REF :

CLIENT :



MAIN CONTRACTOR :



STRUCTURAL ENGINEER :



FAÇADE CONSULTANT :



NOTE :

1. ALL DIMENSIONS ARE IN mm.
2. ALL ELEVATIONS ARE VIEWED FROM OUTSIDE.
3. ALL DIMENSIONS TO BE VERIFIED ON SITE BEFORE FABRICATION.

LEGEND :

- X1 - DETAIL MARK NO.
- X001 - REFER SHEET NO.

1. F.F.L. -- FINISHED FLOOR LEVEL
2. S.F.L. -- STRUCTURAL FLOOR LEVEL
3. S.O. -- STRUCTURAL OPENING
4. ▲ -- FIXING LOCATION
5. ▽ -- STRUCTURAL FLOOR LEVEL MARK

D	29-10-2020	REVISION SUBJECT TO COMMENTS	MN
C	05-06-2020	REVISION SUBJECT TO COMMENTS	MN
B	27-04-2020	REVISION SUBJECT TO COMMENTS	MN
A	19-02-2020	REVISION SUBJECT TO COMMENTS	MN
NO.	DATE	REVISED	BY

JOB NO. : J-852
 PROJECT : PROPOSED RESIDENTIAL DEVELOPMENT
 AT 139 - 147 ARGYLE STREET,
 NKIL 6005, 6035 R.P., 6036 R.P.,
 6037 R.P. & 6038 R.P.

TITLE : LOUVER SCHEDULE FOR ALUM. LOUVER

DATE : 12-Feb-2020 SCALE : 1:40

DRAWN BY : LHR CHECKED BY : DW



DWG NO. : J852-SD-LVA-4002 REV. : D

B.D. REF :

CLIENT :

ARCHITECT :
AGC DESIGN LTD

MAIN CONTRACTOR :
Gammon

STRUCTURAL ENGINEER :
ARUP

FACADE CONSULTANT :
MEINHARDT

NOTE :

1. ALL DIMENSIONS ARE IN mm.
2. ALL ELEVATIONS ARE VIEWED FROM OUTSIDE.
3. ALL DIMENSIONS TO BE VERIFIED ON SITE BEFORE FABRICATION.

LEGEND :

X1 — DETAIL MARK NO.
 X001 — REFER SHEET NO.

1. F.F.L. — FINISHED FLOOR LEVEL
2. S.F.L. — STRUCTURAL FLOOR LEVEL
3. S.O. — STRUCTURAL OPENING
4. ▲ — FIXING LOCATION
5. ▽ — STRUCTURAL FLOOR LEVEL MARK

NO.	DATE	REVISED	BY
D	29-10-2020	REVISION SUBJECT TO COMMENTS	MN
C	05-06-2020	REVISION SUBJECT TO COMMENTS	MN
B	27-04-2020	REVISION SUBJECT TO COMMENTS	MN
A	19-02-2020	REVISION SUBJECT TO COMMENTS	MN


JOB NO. : J-852
 PROJECT :
 PROPOSED RESIDENTIAL DEVELOPMENT
 AT 139 - 147 ARGYLE STREET,
 NKIL 6005, 6035 R.P., 6036 R.P.,
 6037 R.P. & 6038 R.P.

TITLE :
 LOUVER SCHEDULE FOR
 ALUM. LOUVER


DATE : 12-Feb-2020 SCALE : 1:40
 DRAWN BY : LHR CHECKED BY : DW

美特鋁質有限公司
MIDI ALUMINIUM FABRICATOR LTD.
 Units 6-8, Sunray Industrial Centre, 1/F
 610 Cha Kwo Ling Road, Kowloon
 Tel:23489211-4 Fax:(852)27727666


DWG NO. : J852-SD-LVA-4003 REV. : D

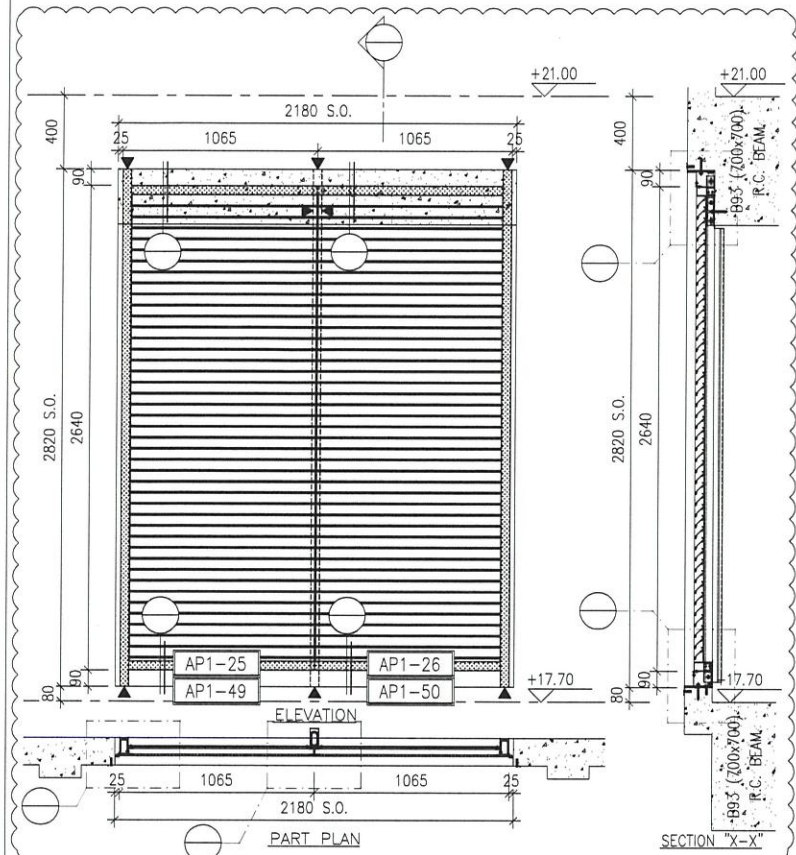


LOUVER MARK	AL-502d
LOCATION	LG2/F
FLOOR ROOM	CARPARK
QUANTITY	1
REMARKS	WEATHERPROOF LOUVER (60% FREE AREA)

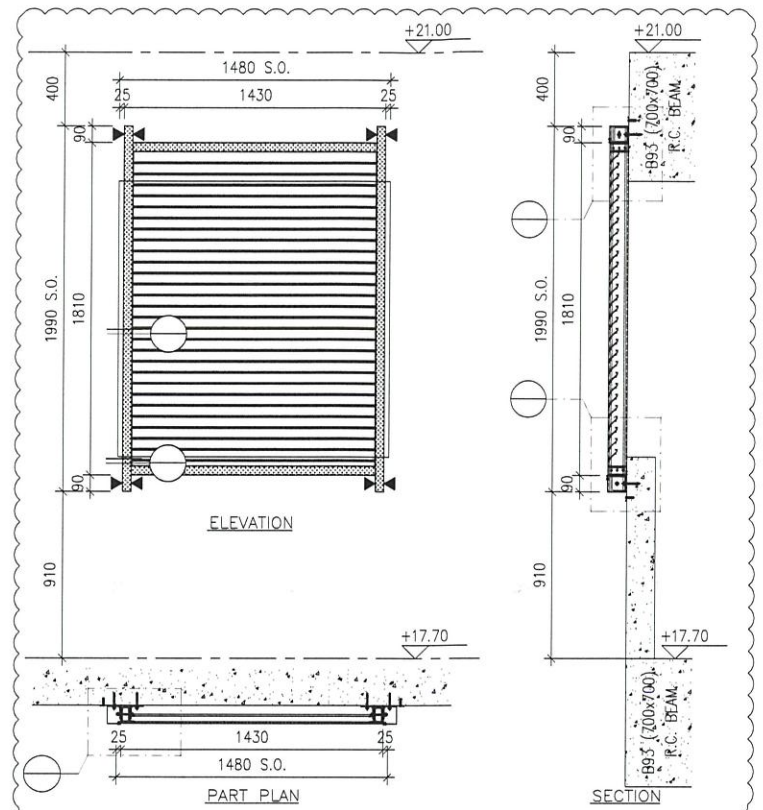

LOUVER MARK	AL-503
LOCATION	LG2/F
FLOOR ROOM	CAR RAMP
QUANTITY	1
REMARKS	WEATHERPROOF LOUVER (60% FREE AREA)




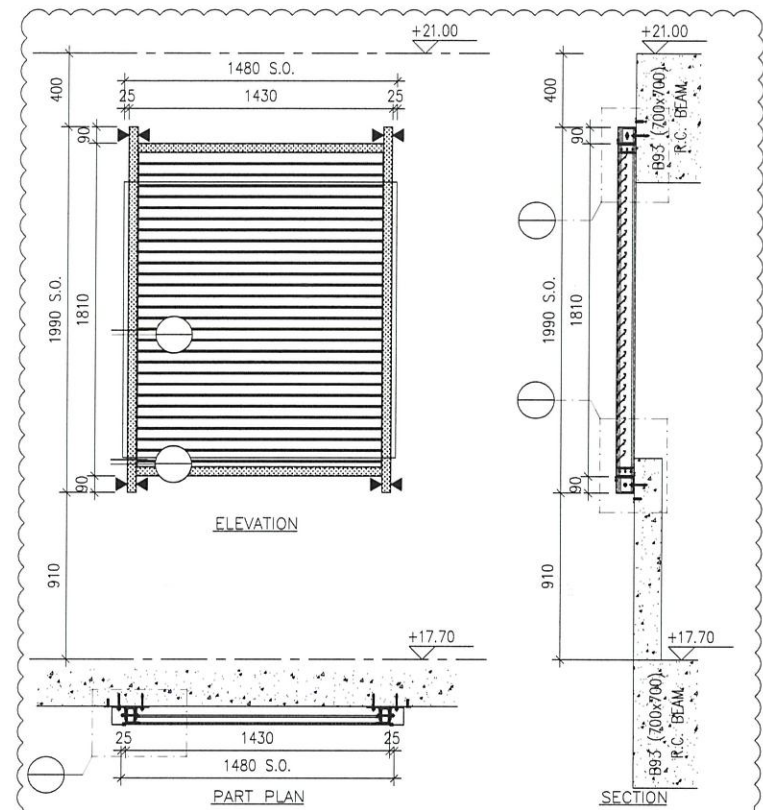


LOUVER MARK	AL-503a
LOCATION	LG2/F
FLOOR ROOM	CAR RAMP
QUANTITY	1
REMARKS	WEATHERPROOF LOUVER (60% FREE AREA)




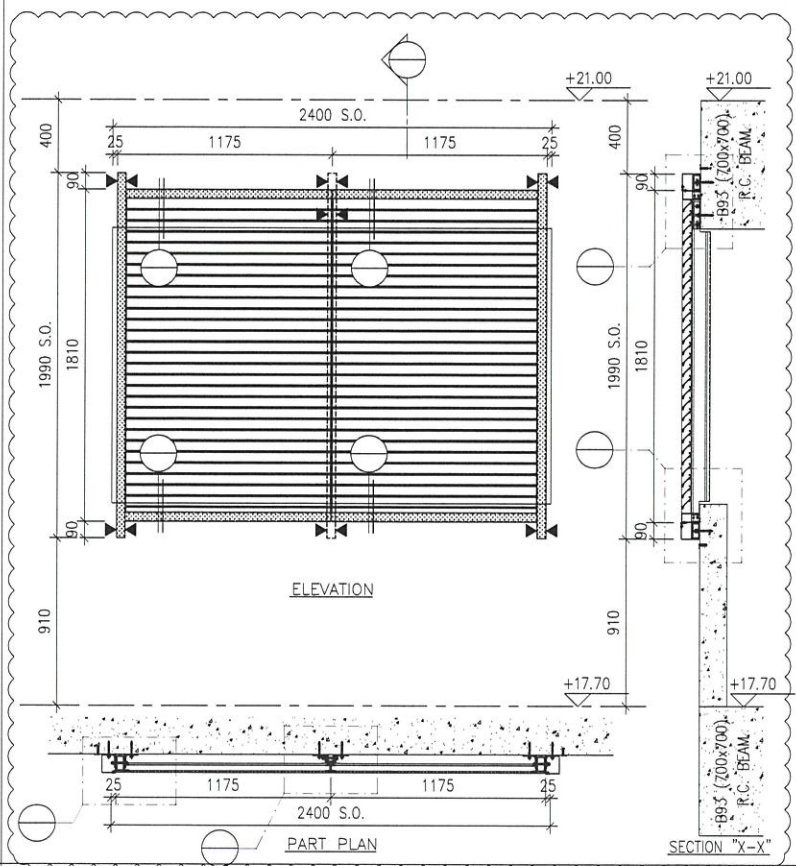


LOUVER MARK	AL-504
LOCATION	LG2/F
FLOOR ROOM	CAR RAMP
QUANTITY	1
REMARKS	WEATHERPROOF LOUVER (60% FREE AREA)

ELEVATION

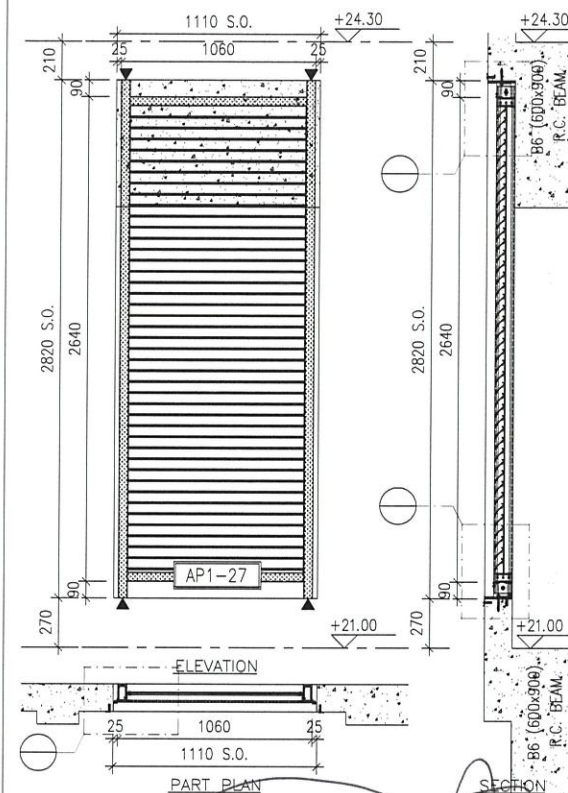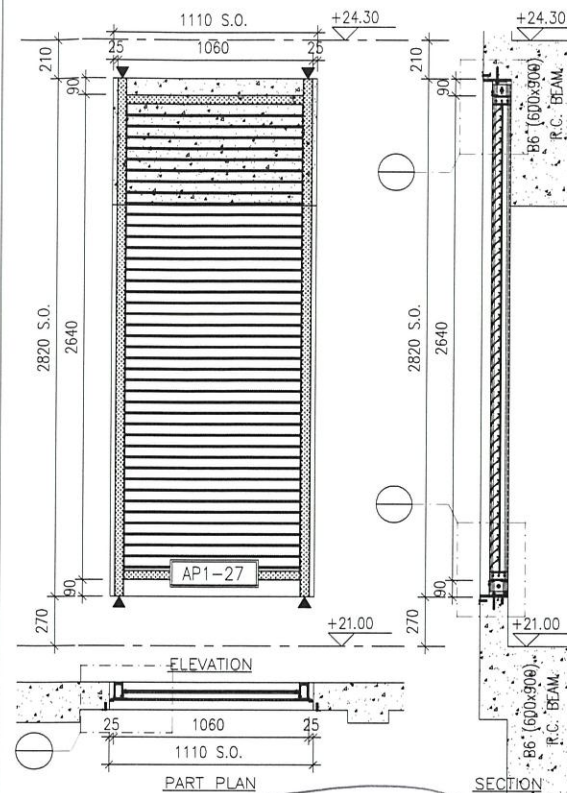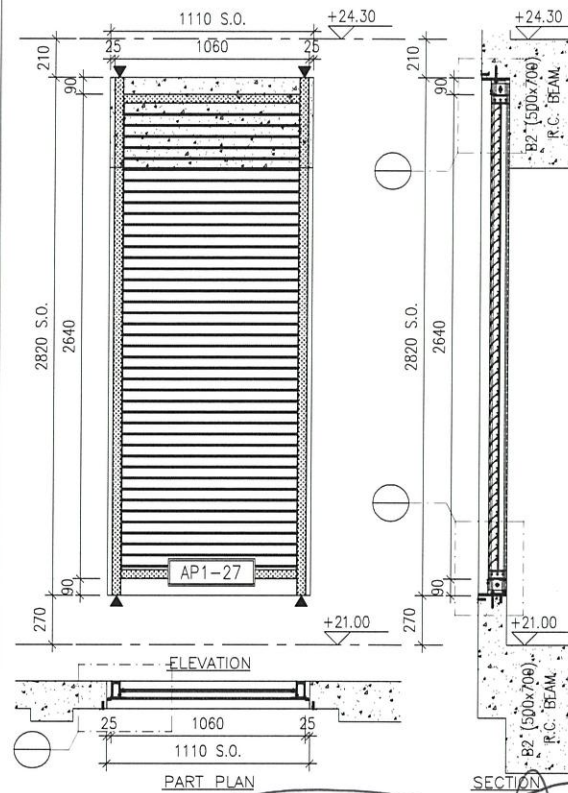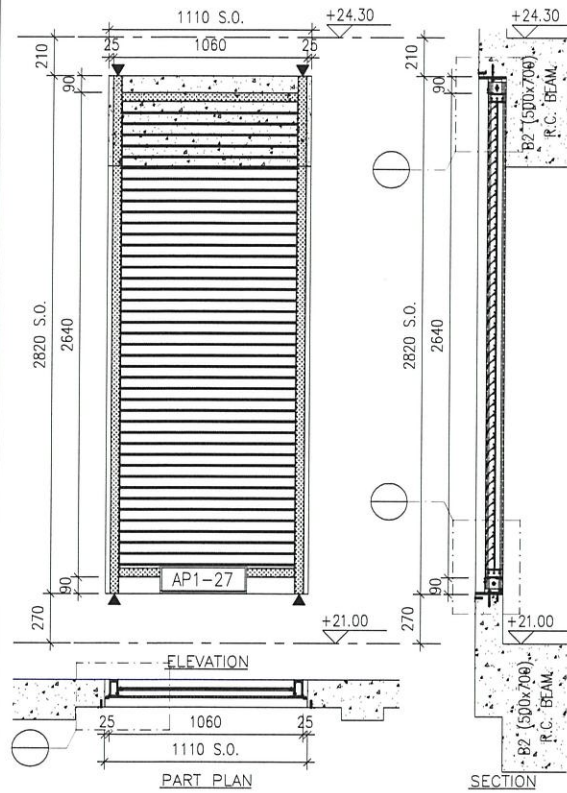

LOUVER MARK	AL-601
FLOOR	LG3/F
ROOM	CARPARK FAN ROOM 3
QUANTITY	1
REMARKS	WEATHERPROOF LOUVER (60% FREE AREA)

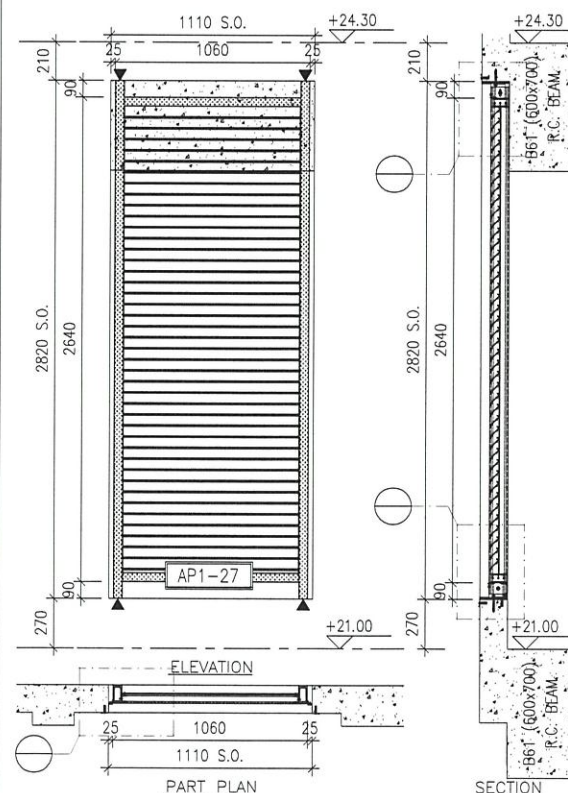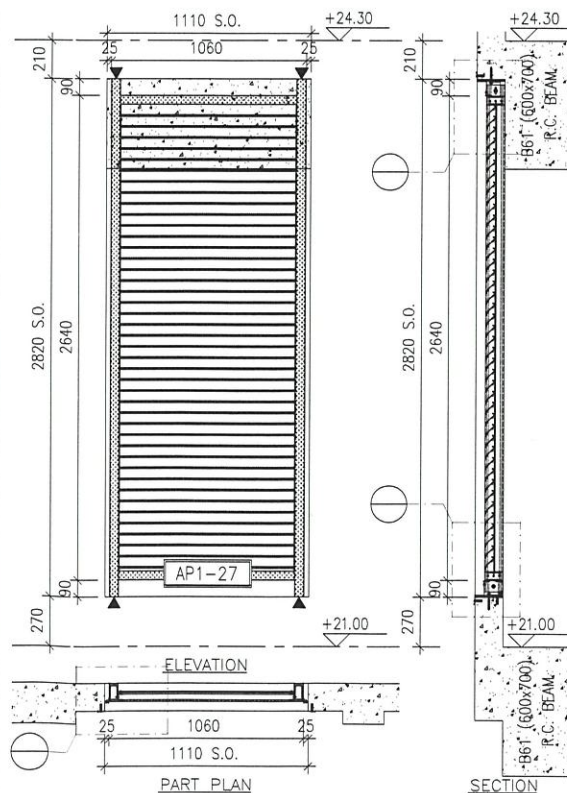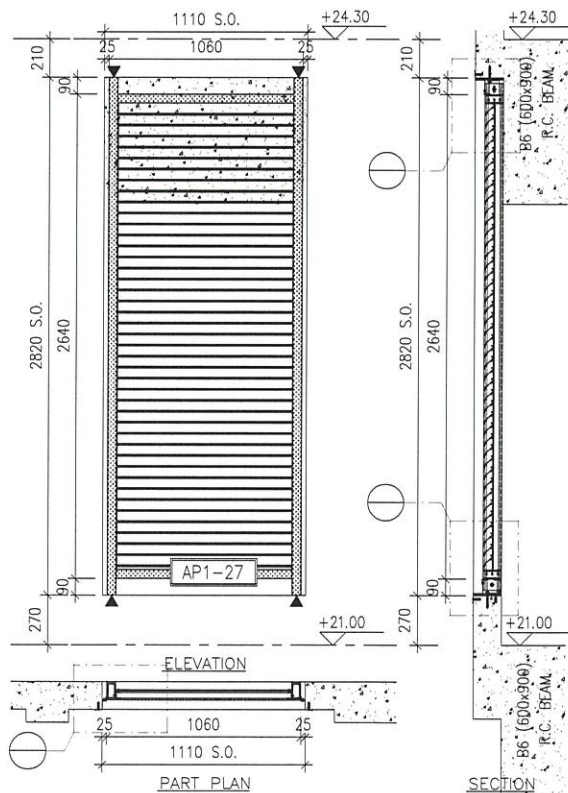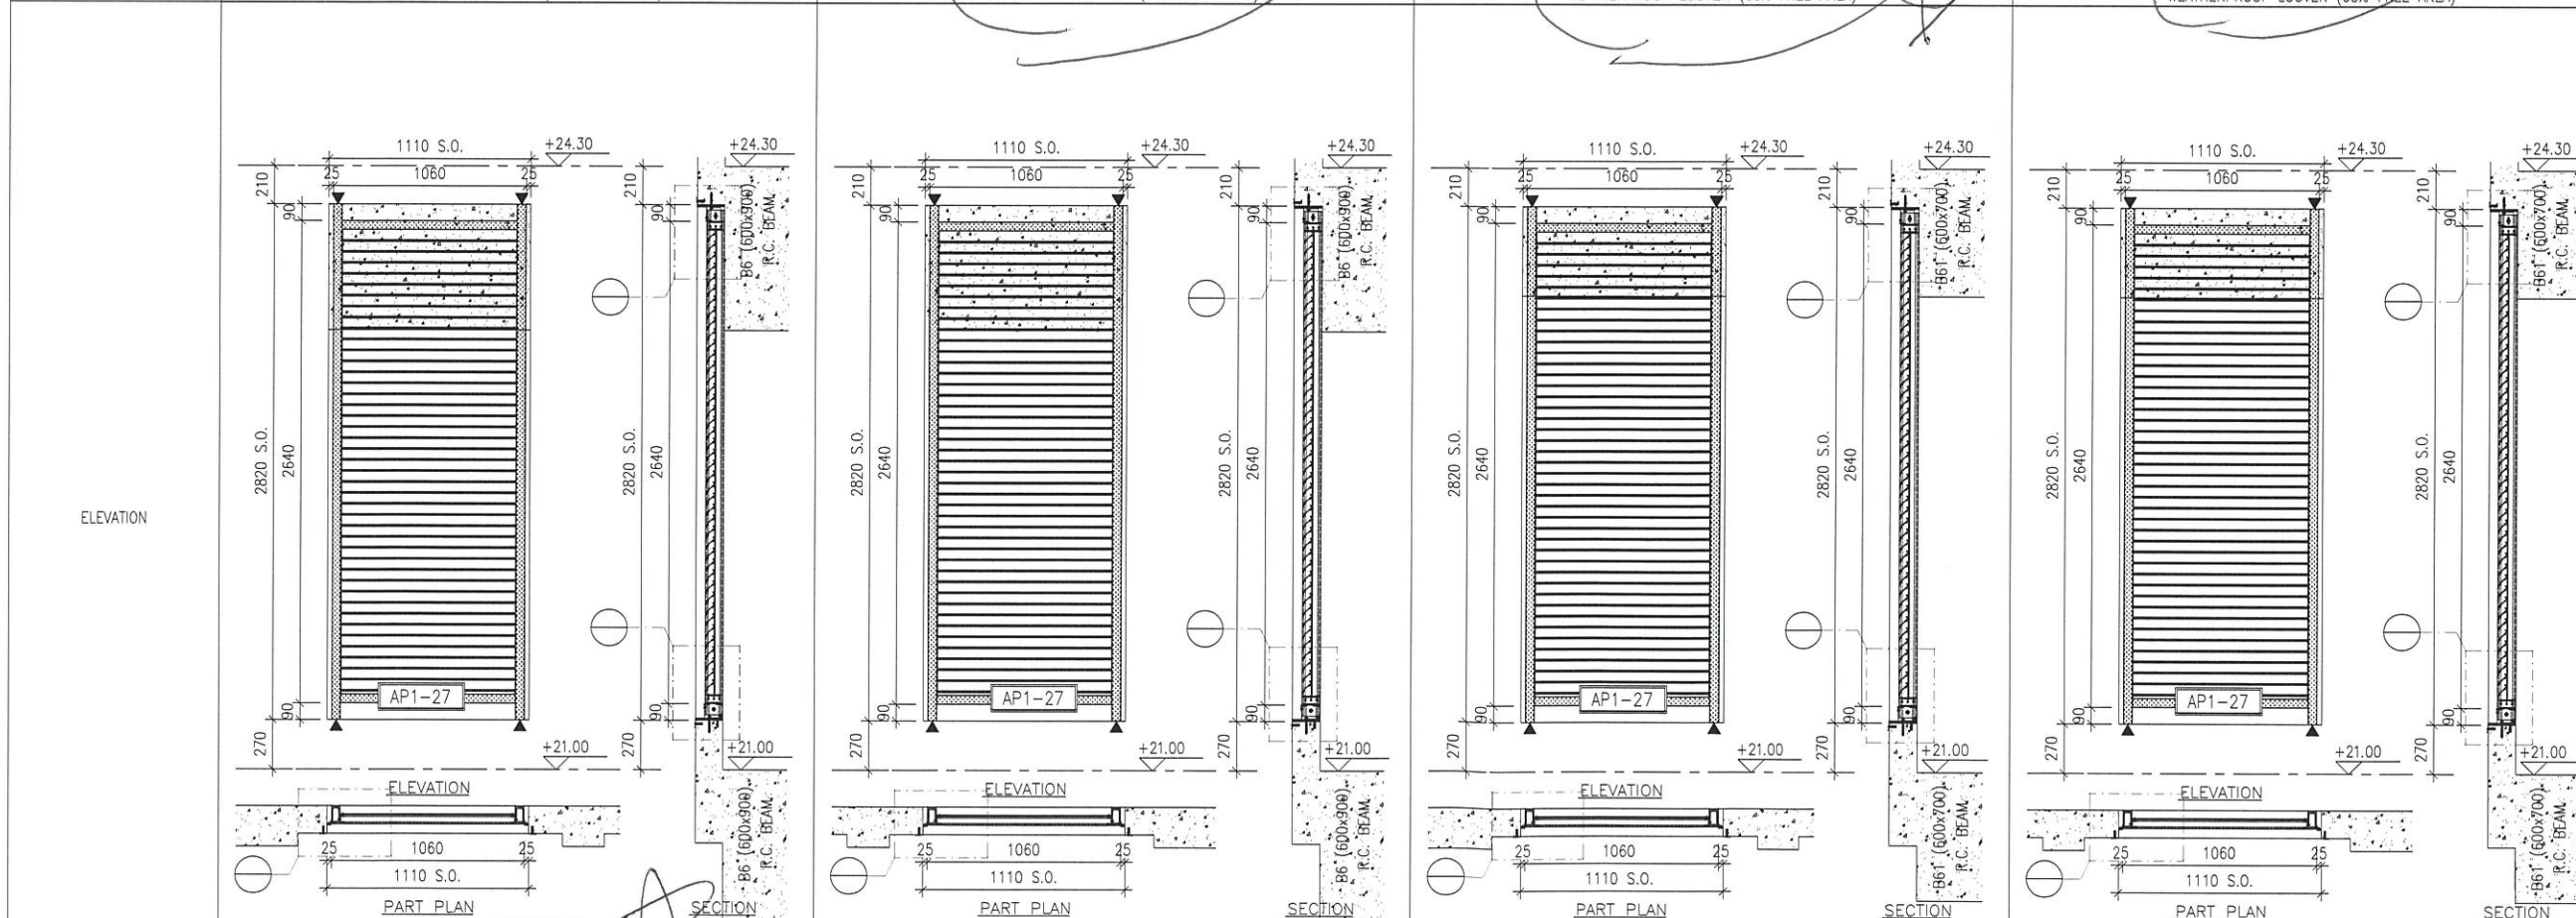

LOUVER MARK	AL-601d
FLOOR	LG3/F
ROOM	A/C PLANT ROOM 1
QUANTITY	1
REMARKS	WEATHERPROOF LOUVER (60% FREE AREA)

LOUVER MARK	AL-601e
FLOOR	LG3/F
ROOM	A/C PLANT ROOM 1
QUANTITY	1
REMARKS	WEATHERPROOF LOUVER (60% FREE AREA)

LOUVER MARK	AL-601f
FLOOR	LG3/F
ROOM	CARPARK FAN ROOM 3
QUANTITY	1
REMARKS	WEATHERPROOF LOUVER (60% FREE AREA)

LOUVER MARK	AL-601g
FLOOR	LG3/F
ROOM	UPPER PART OF EMERGENCY GENSET ROOM
QUANTITY	1
REMARKS	WEATHERPROOF LOUVER (60% FREE AREA)

B.D. REF :

CLIENT :

ARCHITECT :
AGC DESIGN LTD

MAIN CONTRACTOR :
Gammon

STRUCTURAL ENGINEER :
ARUP

FACADE CONSULTANT :
MEINHARDT

NOTE:
 1. ALL DIMENSIONS ARE IN mm.
 2. ALL ELEVATIONS ARE VIEWED FROM OUTSIDE.
 3. ALL DIMENSIONS TO BE VERIFIED ON SITE BEFORE FABRICATION.

LEGEND:
 X1 --- DETAIL MARK NO.
 X001 --- REFER SHEET NO.
 1. F.F.L. --- FINISHED FLOOR LEVEL
 2. S.F.L. --- STRUCTURAL FLOOR LEVEL
 3. S.O. --- STRUCTURAL OPENING
 4. ▲ --- FIXING LOCATION
 5. ▽ --- STRUCTURAL FLOOR LEVEL MARK

C	05-06-2020	REVISION SUBJECT TO COMMENTS	MN
B	27-04-2020	REVISION SUBJECT TO COMMENTS	MN
A	19-02-2020	REVISION SUBJECT TO COMMENTS	MN
NO.	DATE	REVISED	BY

JOB NO. : J-852
 PROJECT : PROPOSED RESIDENTIAL DEVELOPMENT AT 139 - 147 ARGYLE STREET, NKIL 6005, 6035 R.P., 6036 R.P., 6037 R.P. & 6038 R.P.

TITLE : LOUVER SCHEDULE FOR ALUM. LOUVER




DATE : 12-Feb-2020 SCALE : 1:40

DRAWN BY : LHR CHECKED BY : DW

美特铝质有限公司
MIDI ALUMINIUM FABRICATOR LTD.
 Units 6-8, Sunray Industrial Centre, 1/F
 610 Cha Kwo Ling Road, Kowloon
 Tel:23489211-4 Fax:(852)27727666

DWG NO. : J852-SD-LVA-4004 REV. : C

ELEVATION

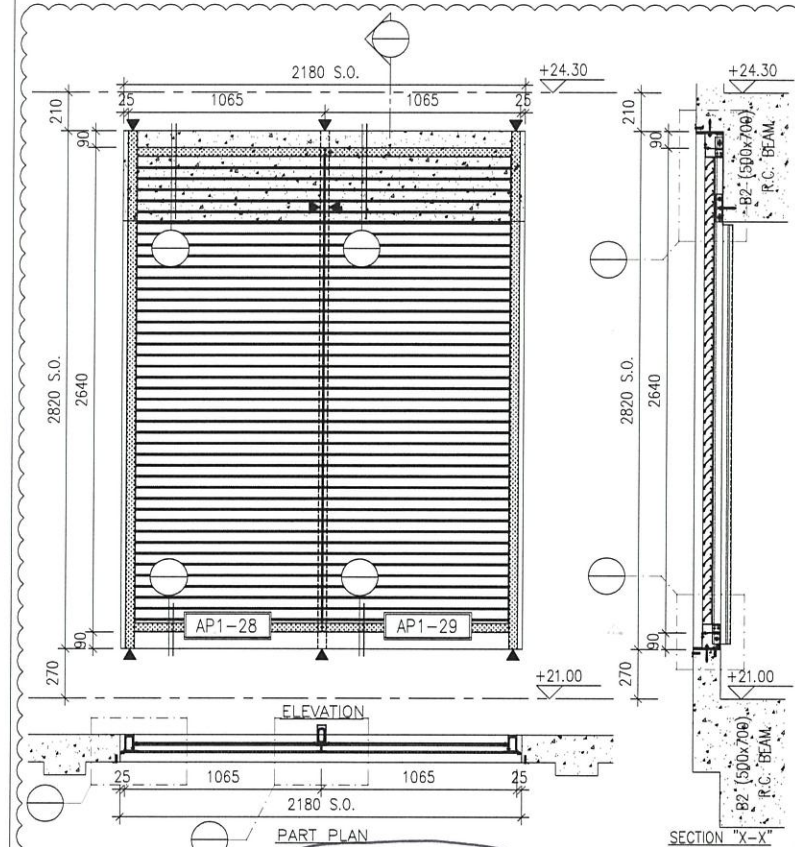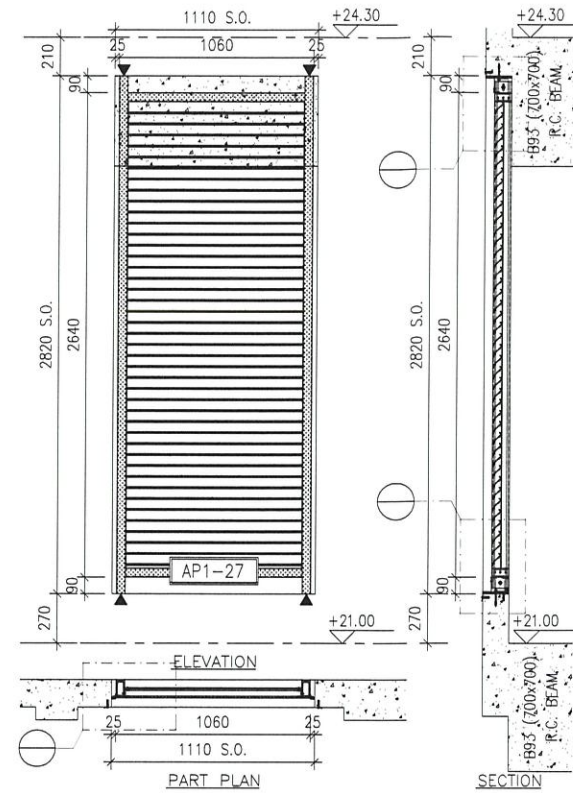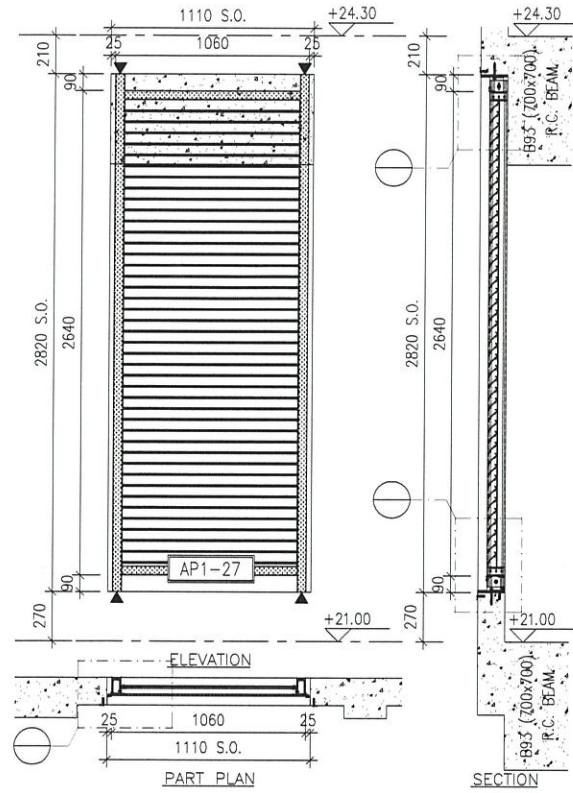

LOUVER MARK	AL-601h
LOCATION	LG3/F
FLOOR	CARPARK
ROOM	
QUANTITY	1
REMARKS	WEATHERPROOF LOUVER (60% FREE AREA)

LOUVER MARK	AL-601j
LOCATION	LG3/F
FLOOR	CARPARK
ROOM	
QUANTITY	1
REMARKS	WEATHERPROOF LOUVER (60% FREE AREA)

LOUVER MARK	AL-602
LOCATION	LG3/F
FLOOR	UPPER PART OF EMERGENCY GENSET ROOM
ROOM	
QUANTITY	1
REMARKS	WEATHERPROOF LOUVER (60% FREE AREA)

B.D. REF :

CLIENT :

ARCHITECT :



MAIN CONTRACTOR :



STRUCTURAL ENGINEER :



FAÇADE CONSULTANT :



NOTE :

1. ALL DIMENSIONS ARE IN mm.
2. ALL ELEVATIONS ARE VIEWED FROM OUTSIDE.
3. ALL DIMENSIONS TO BE VERIFIED ON SITE BEFORE FABRICATION.

LEGEND :

- X1 --- DETAIL MARK NO.
- X001 --- REFER SHEET NO.

1. F.F.L. --- FINISHED FLOOR LEVEL
2. S.F.L. --- STRUCTURAL FLOOR LEVEL
3. S.O. --- STRUCTURAL OPENING
4. ▲ --- FIXING LOCATION
5. ▽ --- STRUCTURAL FLOOR LEVEL MARK

NO.	DATE	REVISION	BY
D	29-10-2020	REVISION SUBJECT TO COMMENTS	MN
C	05-06-2020	REVISION SUBJECT TO COMMENTS	MN
B	27-04-2020	REVISION SUBJECT TO COMMENTS	MN
A	19-02-2020	REVISION SUBJECT TO COMMENTS	MN

JOB NO. : J-852

PROJECT :
PROPOSED RESIDENTIAL DEVELOPMENT
AT 139 - 147 ARGYLE STREET,
NKIL 6005, 6035 R.P., 6036 R.P.,
6037 R.P. & 6038 R.P.

TITLE :
LOUVER SCHEDULE FOR
ALUM. LOUVER




DATE : 12-Feb-2020 SCALE : 1:40

DRAWN BY : LHR CHECKED BY : DW



DWG NO. : J852-SD-LVA-4005 REV. : D

ELEVATION

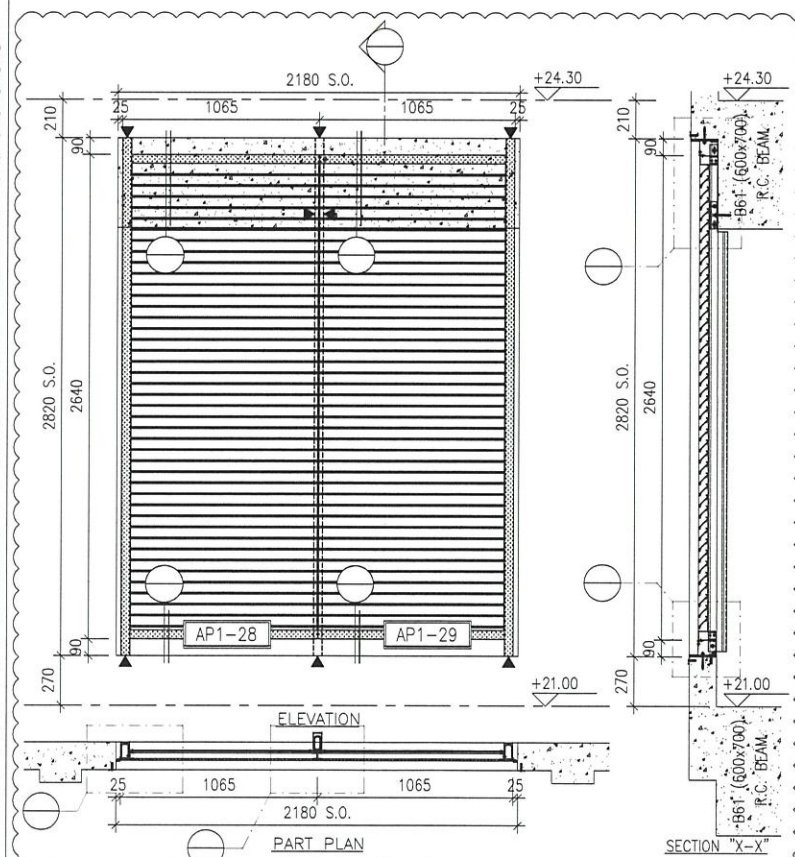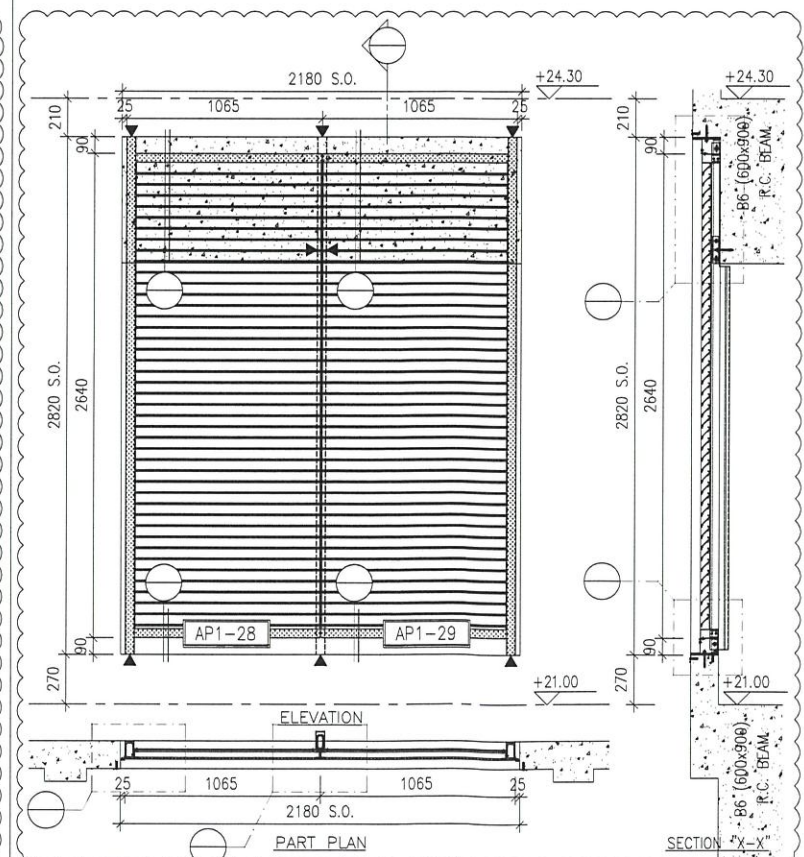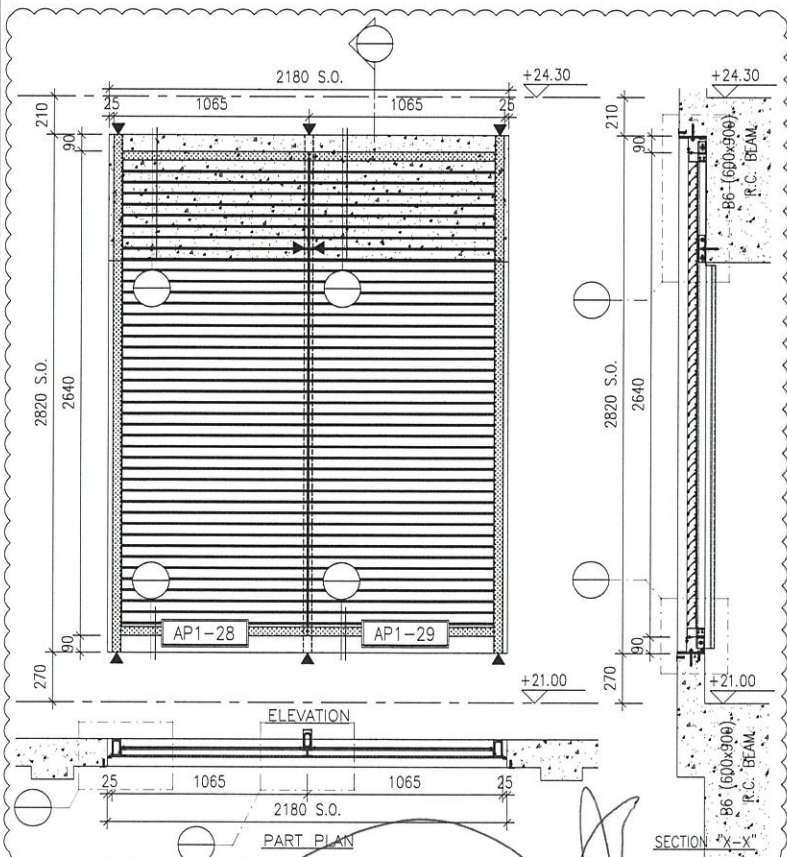


LOUVER MARK	AL-602a
LOCATION	LG3/F
FLOOR	UPPER PART OF EMERGENCY GENSET ROOM
ROOM	
QUANTITY	1
REMARKS	WEATHERPROOF LOUVER (60% FREE AREA)

LOUVER MARK	AL-602b
LOCATION	LG3/F
FLOOR	A/C PLANT ROOM 1
ROOM	
QUANTITY	1
REMARKS	WEATHERPROOF LOUVER (60% FREE AREA)


LOUVER MARK	AL-602c
LOCATION	LG3/F
FLOOR	CARPARK FAN ROOM 2
ROOM	
QUANTITY	1
REMARKS	WEATHERPROOF LOUVER (60% FREE AREA)

ELEVATION

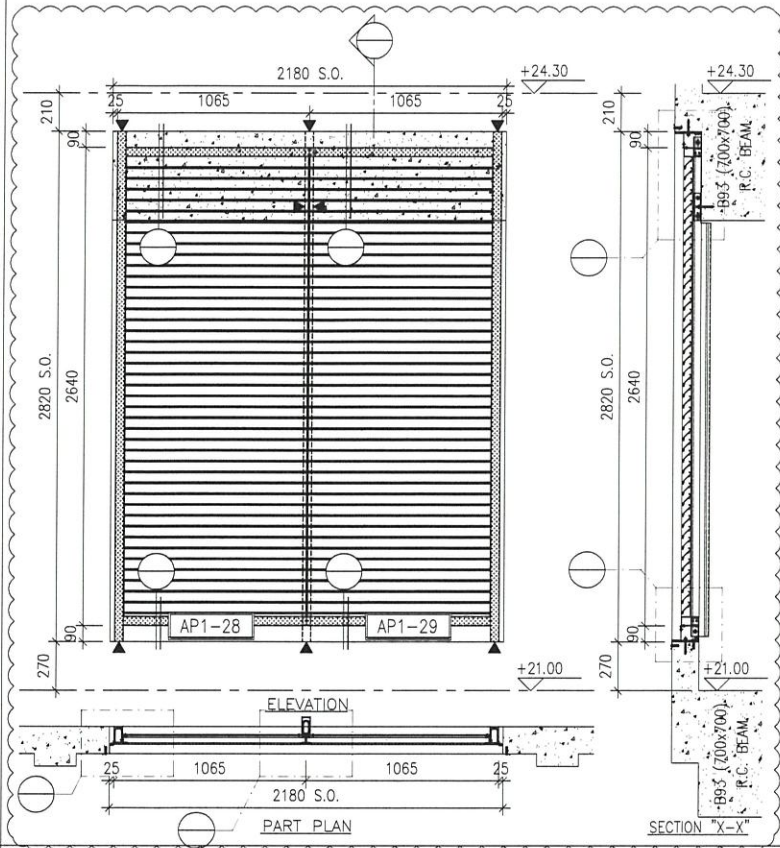


LOUVER MARK	AL-602d
LOCATION	LG3/F
FLOOR ROOM	CARPARK
QUANTITY	1
REMARKS	WEATHERPROOF LOUVER (60% FREE AREA)

ELEVATION

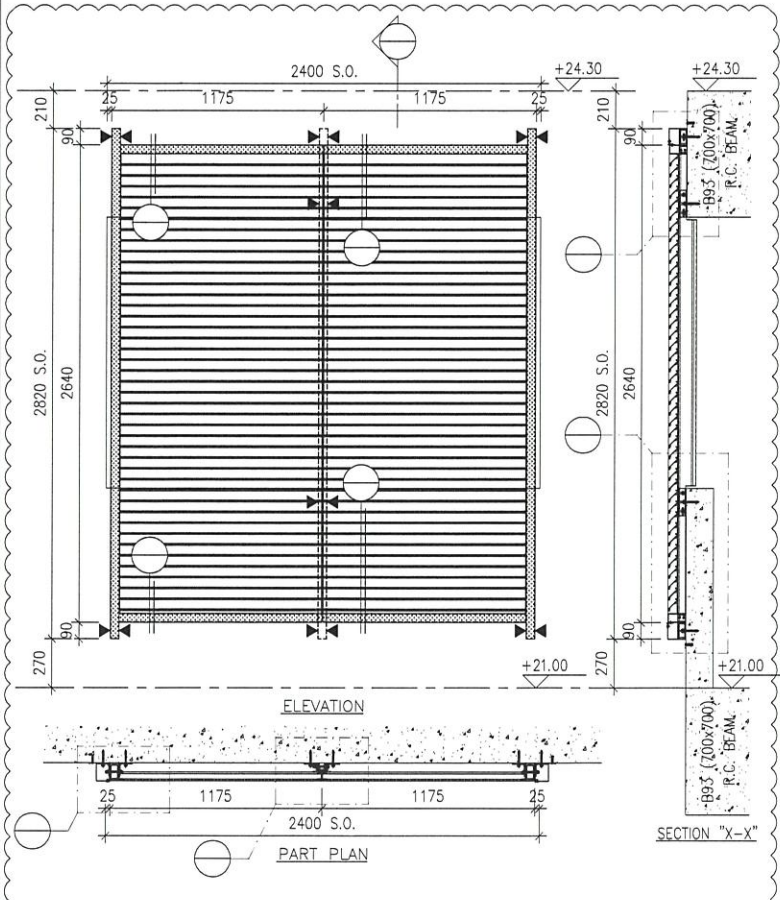


LOUVER MARK	AL-604
LOCATION	LG3/F
FLOOR ROOM	CAR RAMP
QUANTITY	1
REMARKS	WEATHERPROOF LOUVER (60% FREE AREA)

ELEVATION

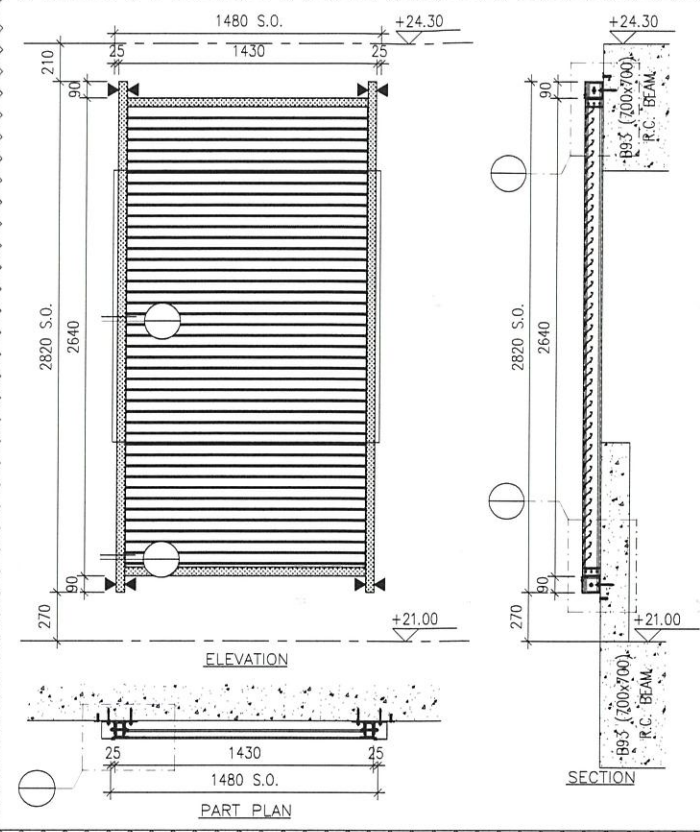

LOUVER MARK	AL-603
LOCATION	LG3/F
FLOOR ROOM	CAR RAMP
QUANTITY	1
REMARKS	WEATHERPROOF LOUVER (60% FREE AREA)

ELEVATION

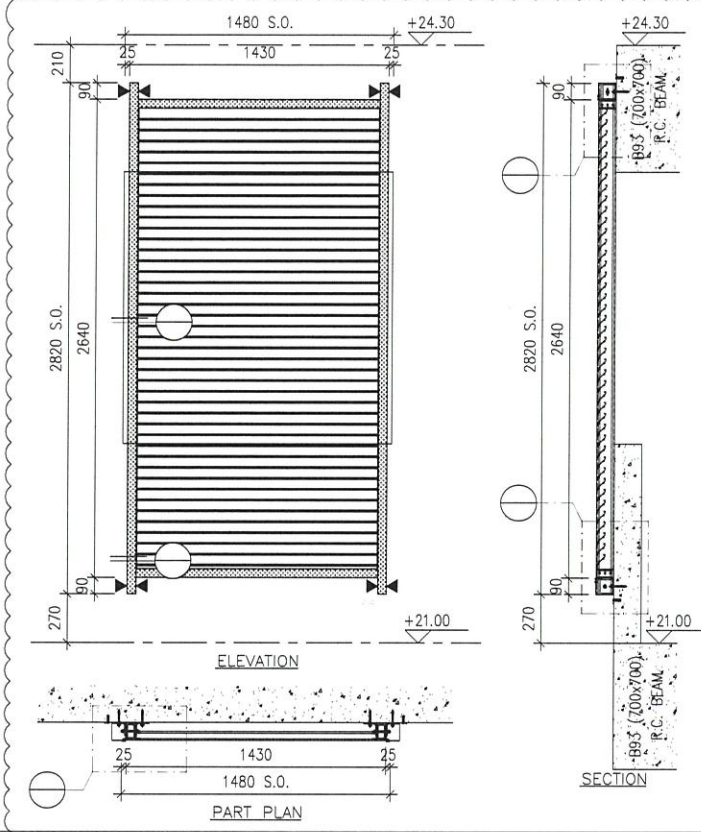

LOUVER MARK	AL-603g
LOCATION	LG3/F
FLOOR ROOM	CAR RAMP
QUANTITY	1
REMARKS	WEATHERPROOF LOUVER (60% FREE AREA)

B.D. REF :

CLIENT :

ARCHITECT :
AGC DESIGN LTD
 12/F, 127, George Street, 222, 224, 226, 998, 1000

MAIN CONTRACTOR :
Gammon

STRUCTURAL ENGINEER :
ARUP

FAÇADE CONSULTANT :
MEINHARDT

NOTE :
 1. ALL DIMENSIONS ARE IN mm.
 2. ALL ELEVATIONS ARE VIEWED FROM OUTSIDE.
 3. ALL DIMENSIONS TO BE VERIFIED ON SITE BEFORE FABRICATION.

LEGEND :
 X1 --- DETAIL MARK NO.
 X001 --- REFER SHEET NO.
 1. F.F.L. --- FINISHED FLOOR LEVEL
 2. S.F.L. --- STRUCTURAL FLOOR LEVEL
 3. S.O. --- STRUCTURAL OPENING
 4. ▲ --- FIXING LOCATION
 5. ▽ --- STRUCTURAL FLOOR LEVEL MARK


D	28-10-2020	REVISION SUBJECT TO COMMENTS	MN
C	05-08-2020	REVISION SUBJECT TO COMMENTS	MN
B	27-04-2020	REVISION SUBJECT TO COMMENTS	MN
A	19-02-2020	REVISION SUBJECT TO COMMENTS	MN
NO.	DATE	REVISED	BY

JOB NO. : J-852
 PROJECT :
 PROPOSED RESIDENTIAL DEVELOPMENT
 AT 139 - 147 ARGYLE STREET,
 NKIL 6005, 6035 R.P., 6036 R.P.,
 6037 R.P. & 6038 R.P.


TITLE :
 LOUVER SCHEDULE FOR
 ALUM. LOUVER

DATE : 12-Feb-2020 SCALE : 1:40
 DRAWN BY : LHR CHECKED BY : DW

美特鋁質有限公司
MIDI ALUMINIUM FABRICATOR LTD.
 Units 6-B, Sunray Industrial Centre, 1/F
 610 Cha Kwo Ling Road, Kowloon
 Tel:23489211-4 Fax:(852)2727666
 DWG NO. : J852-SD-LVA-4006 REV. : D

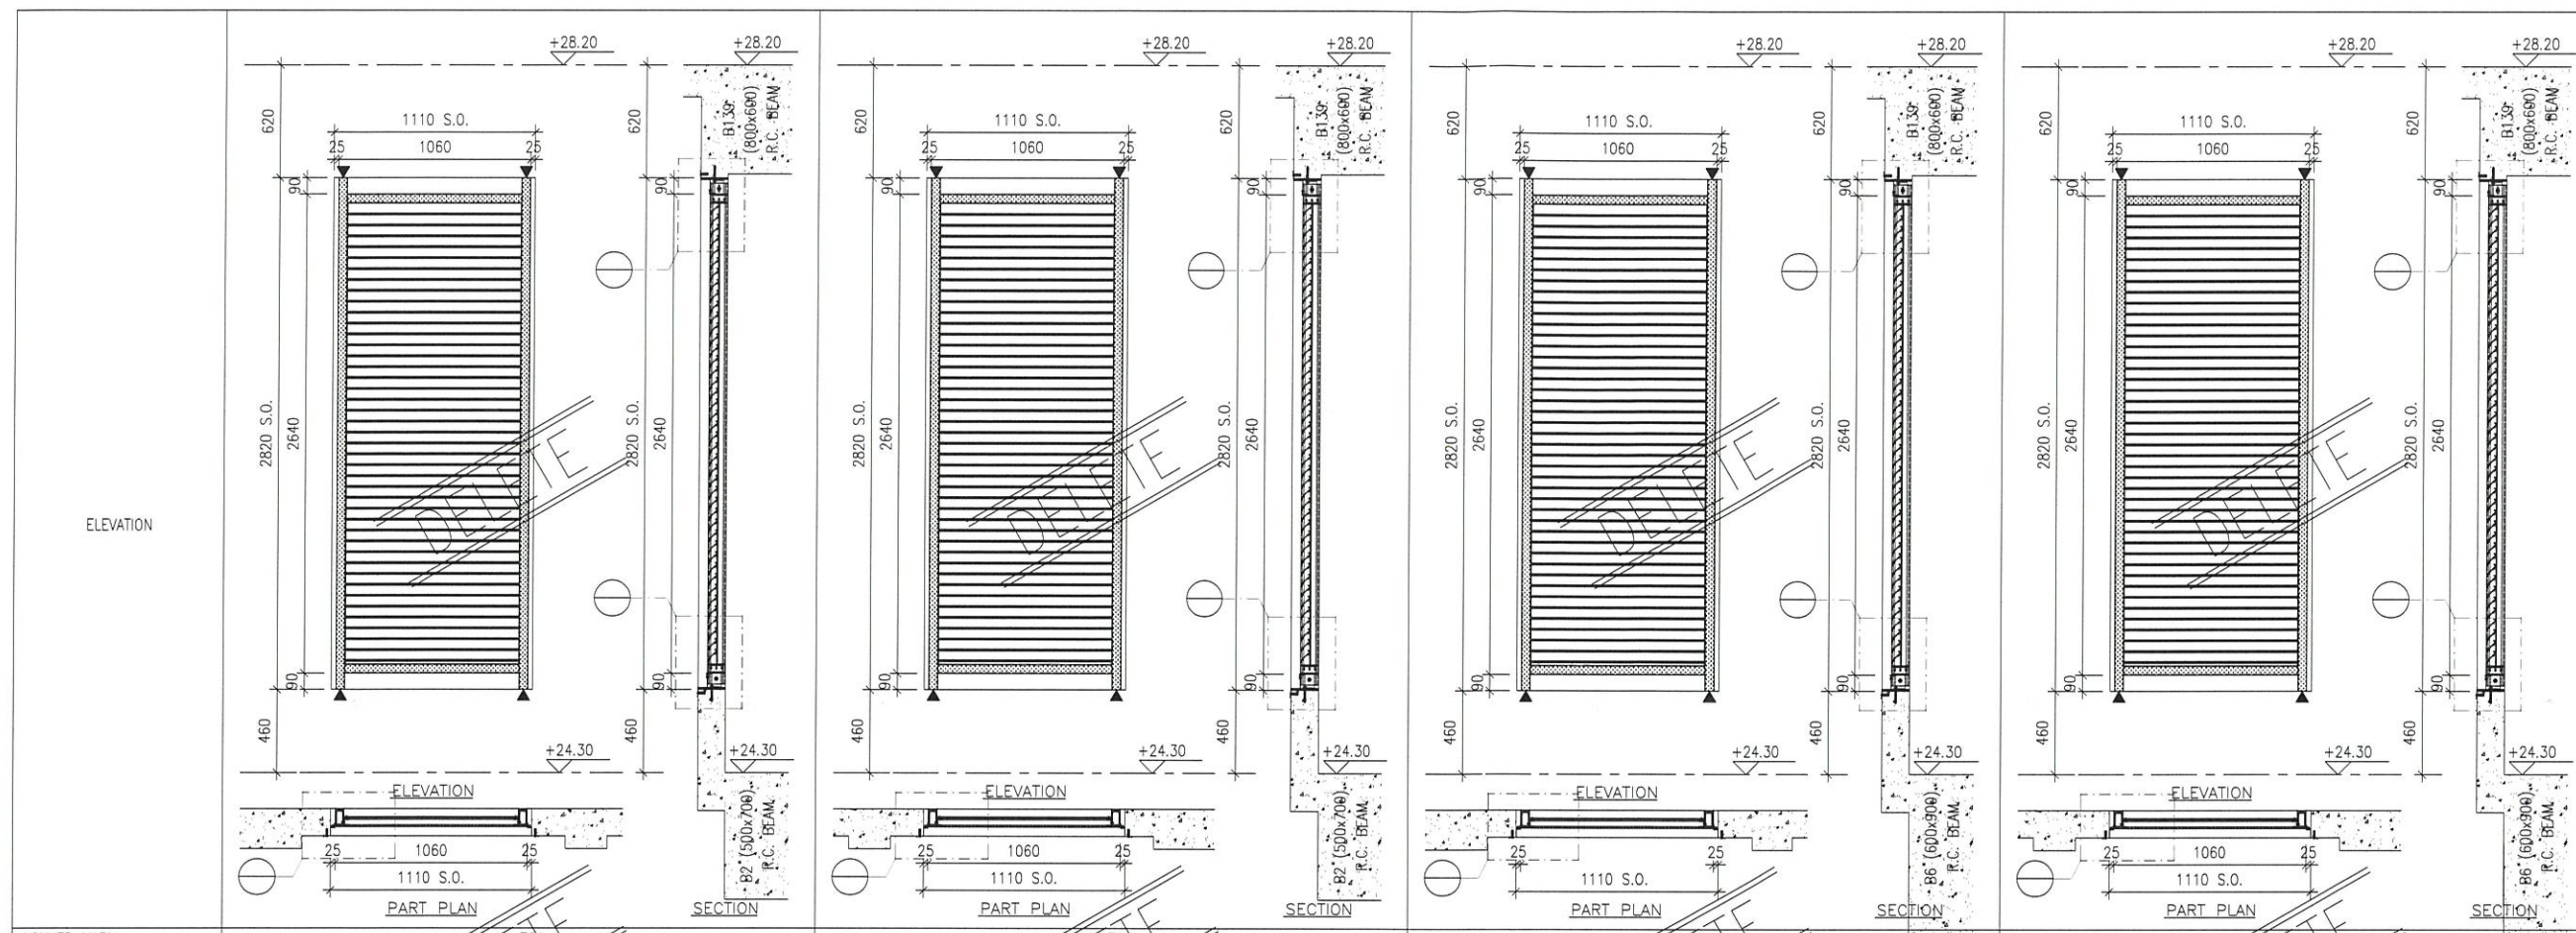

LOUVER MARK	AL-701a	AL-701b	AL-701c	AL-701d
FLOOR ROOM	LG4/F	LG4/F	LG4/F	LG4/F
LOCATION	GYM & YOGA AREA			
QUANTITY	1			
REMARKS	WEATHERPROOF LOUVER (60% FREE AREA)			

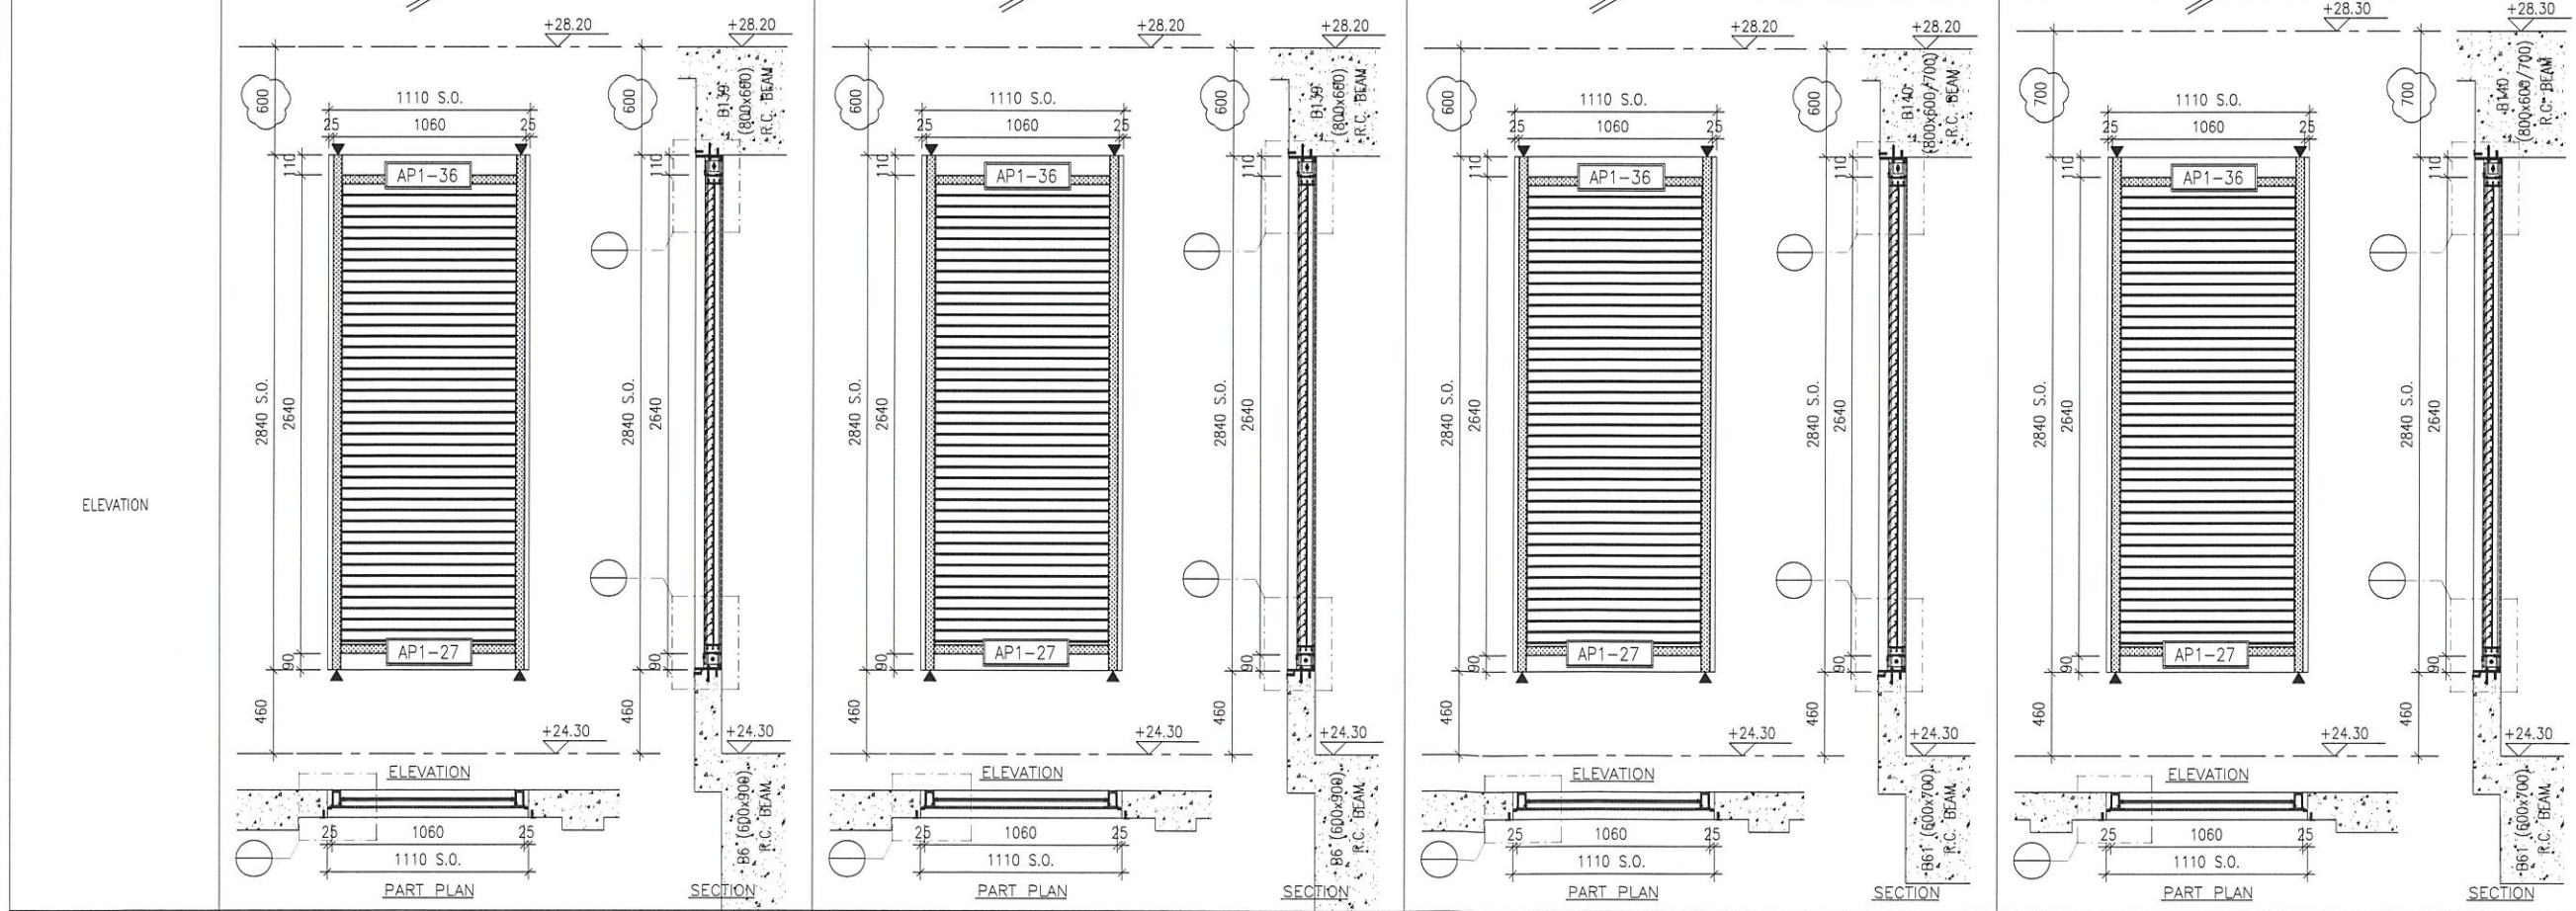

LOUVER MARK	AL-701e	AL-701f	AL-701g	AL-701h
FLOOR ROOM	LG4/F	LG4/F	LG4/F	LG4/F
LOCATION	M. CHANGING ROOM	CAR PARK FAN ROOM 2	CAR PARK FAN ROOM 2	CAR PARK FAN ROOM 2
QUANTITY	1			
REMARKS	WEATHERPROOF LOUVER (60% FREE AREA)			

B.D. REF :

CLIENT :

ARCHITECT : **AGC DESIGN LTD**

MAIN CONTRACTOR : **Gammon**

STRUCTURAL ENGINEER : **ARUP**

FAÇADE CONSULTANT : **MEINHARDT**

- NOTE :
1. ALL DIMENSIONS ARE IN mm.
 2. ALL ELEVATIONS ARE VIEWED FROM OUTSIDE.
 3. ALL DIMENSIONS TO BE VERIFIED ON SITE BEFORE FABRICATION.

- LEGEND :
- X1 --- DETAIL MARK NO.
 - X001 --- REFER SHEET NO.
1. F.F.L. --- FINISHED FLOOR LEVEL
 2. S.F.L. --- STRUCTURAL FLOOR LEVEL
 3. S.O. --- STRUCTURAL OPENING
 4. ▲ --- FIXING LOCATION
 5. ▽ --- STRUCTURAL FLOOR LEVEL MARK

D	29-10-2020	REVISION SUBJECT TO COMMENTS	MN
C	05-06-2020	REVISION SUBJECT TO COMMENTS	MN
B	27-04-2020	REVISION SUBJECT TO COMMENTS	MN
A	18-02-2020	REVISION SUBJECT TO COMMENTS	MN
NO.	DATE	REVISED	BY

JOB NO. : J-852

PROJECT : PROPOSED RESIDENTIAL DEVELOPMENT AT 139 - 147 ARGYLE STREET, NKIL 6005, 6035 R.P., 6036 R.P., 6037 R.P. & 6038 R.P.


TITLE : LOUVER SCHEDULE FOR ALUM. LOUVER

DATE : 12-Feb-2020 SCALE : 1:40


DRAWN BY : LHR CHECKED BY : DW

美特鋁質有限公司
MIDI ALUMINIUM FABRICATOR LTD.
 Units 6-8, Sunray Industrial Centre, 1/F
 610 Cha Kwo Ling Road, Kowloon
 Tel:23489211-4 Fax:(852)27727666


DWG NO. : J852-SD-LVA-4007 REV. : D

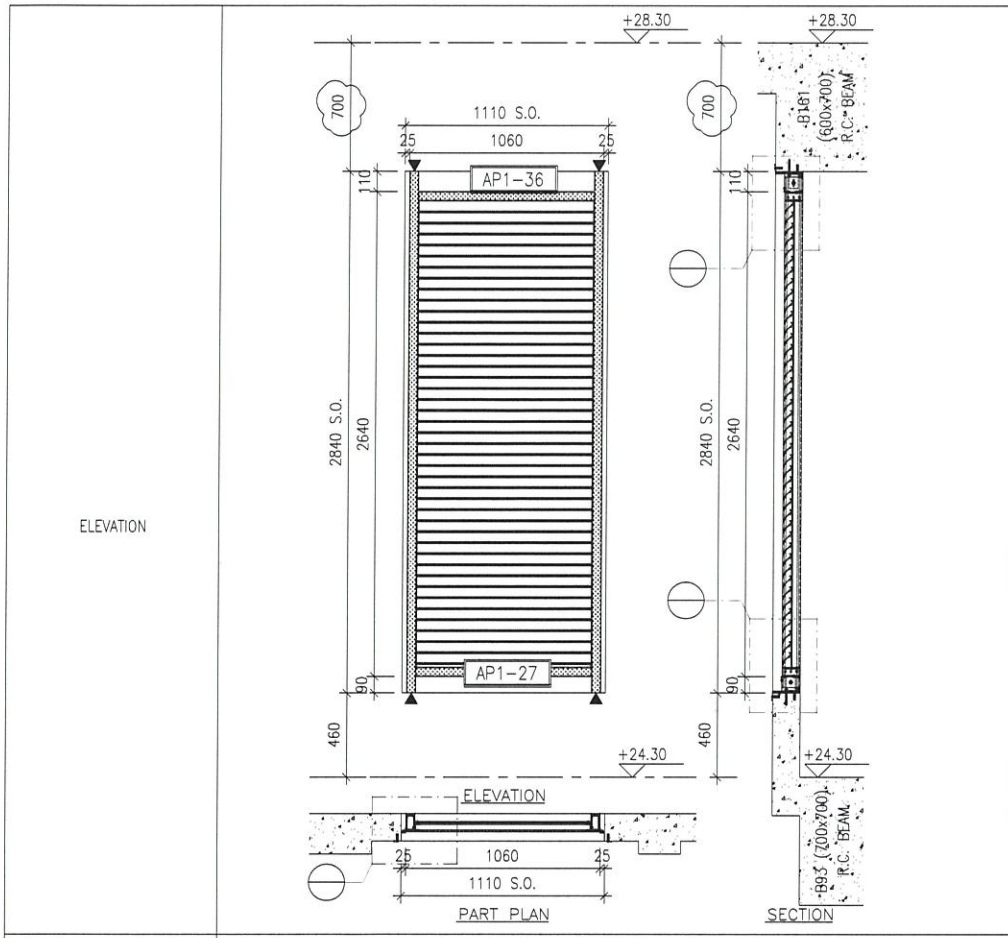


LOUVER MARK	AL-701h
LOCATION	LG4/F
FLOOR ROOM	CAR RAMP
QUANTITY	1
REMARKS	WEATHERPROOF LOUVER (60% FREE AREA)

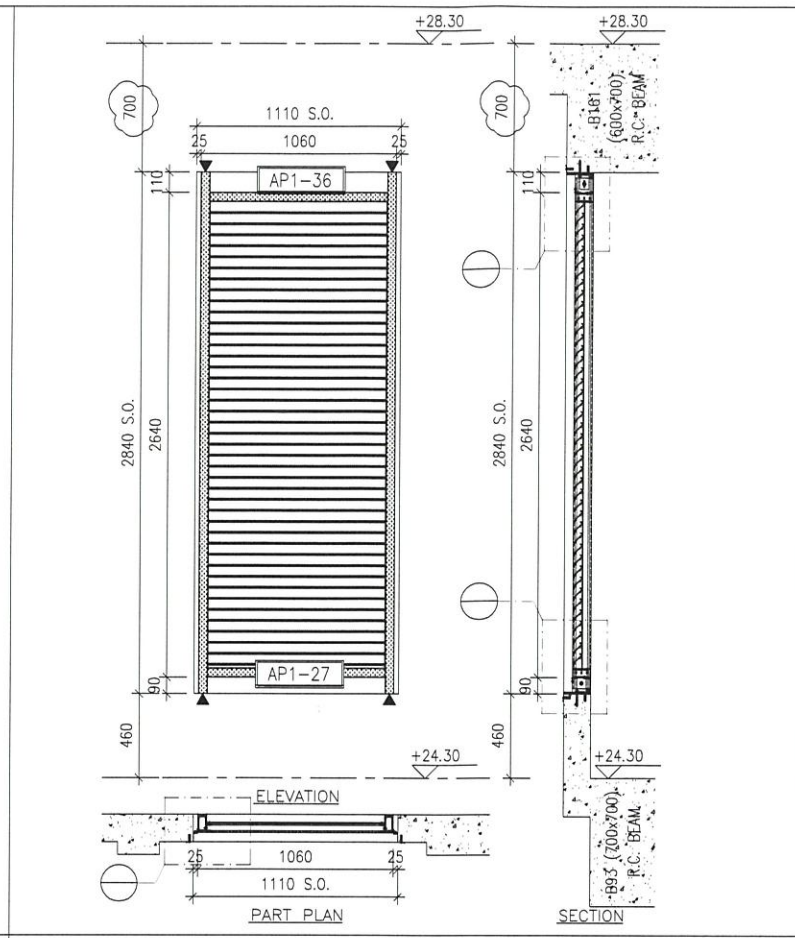


LOUVER MARK	AL-701j
LOCATION	LG4/F
FLOOR ROOM	CAR RAMP
QUANTITY	1
REMARKS	WEATHERPROOF LOUVER (60% FREE AREA)

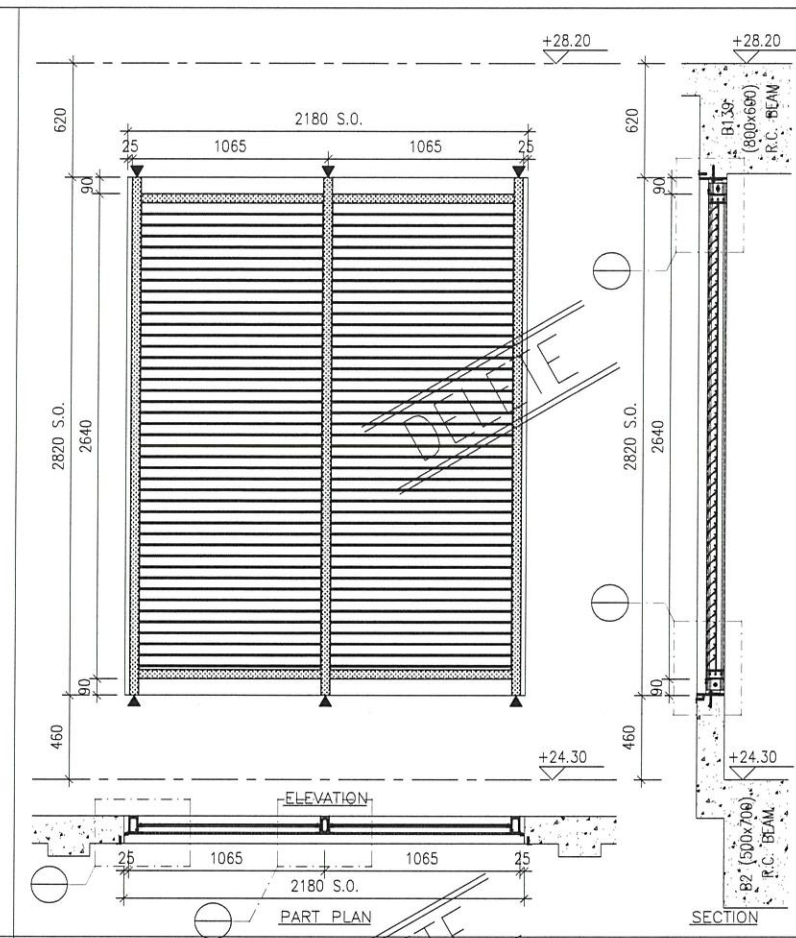


LOUVER MARK	AL-702
LOCATION	LG4/F
FLOOR ROOM	GYM & YOGA AREA
QUANTITY	1
REMARKS	WEATHERPROOF LOUVER (60% FREE AREA)

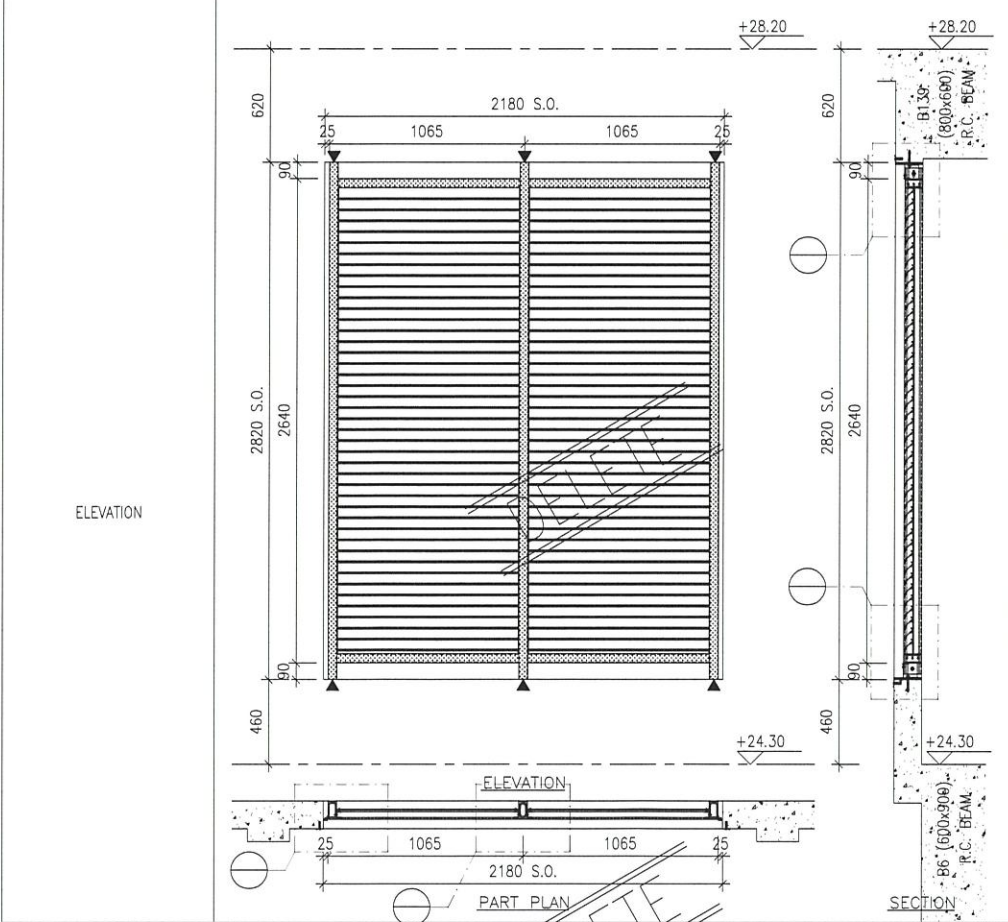

LOUVER MARK	AL-702a
LOCATION	LG4/F
FLOOR ROOM	GYM & YOGA AREA
QUANTITY	1
REMARKS	WEATHERPROOF LOUVER (60% FREE AREA)

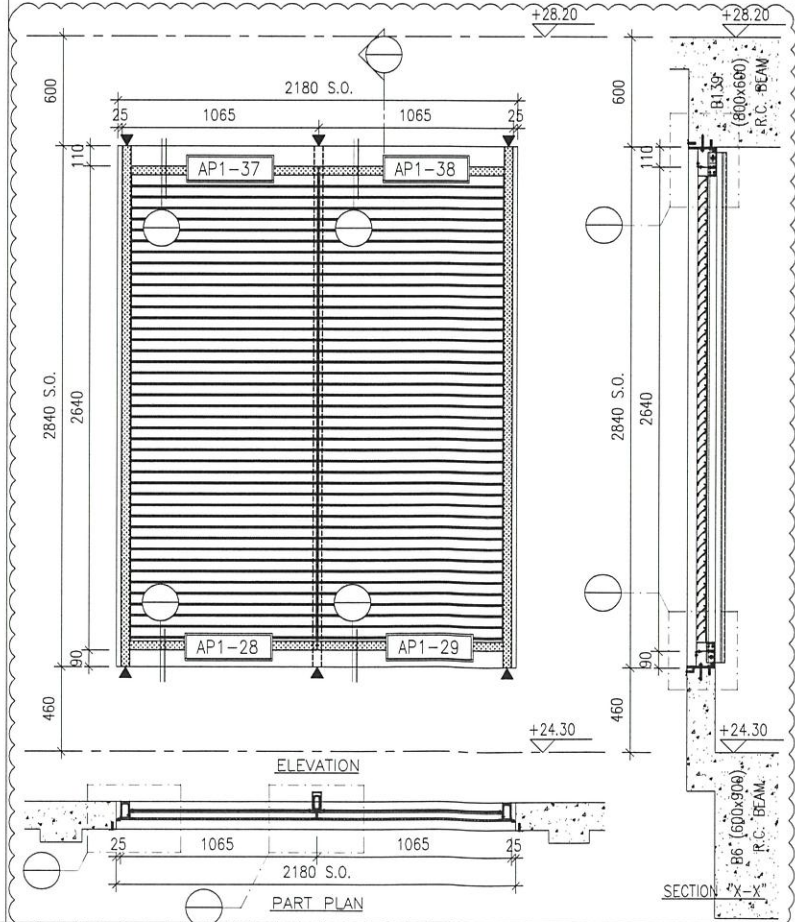

LOUVER MARK	AL-702b
LOCATION	LG4/F
FLOOR ROOM	F. CHANGING ROOM
QUANTITY	1
REMARKS	WEATHERPROOF LOUVER (60% FREE AREA)

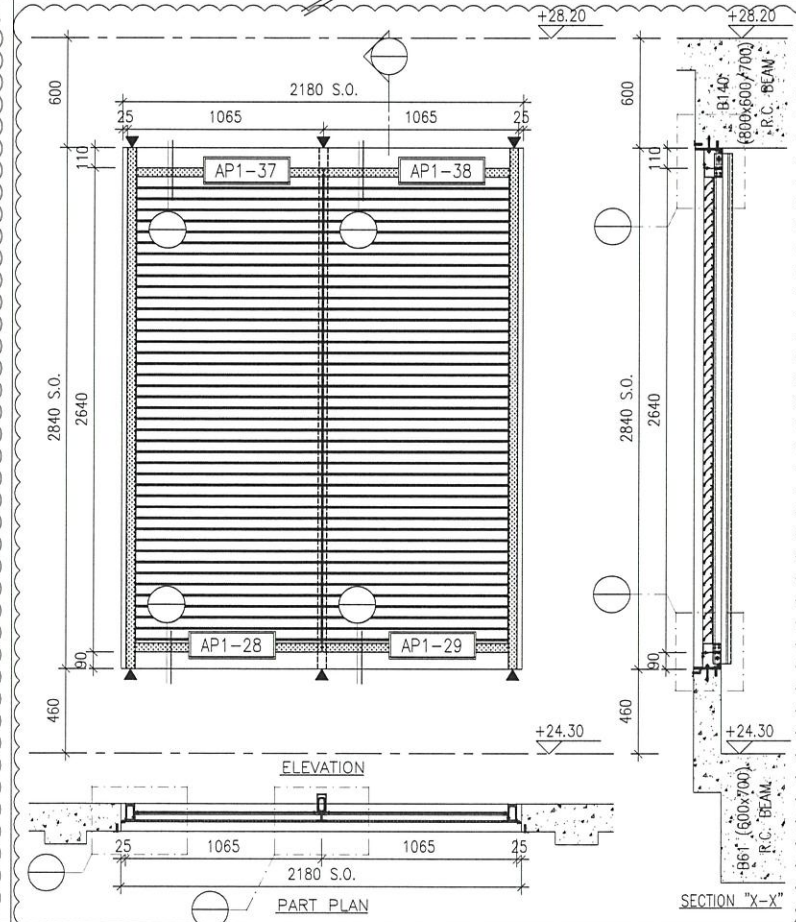

LOUVER MARK	AL-702c
LOCATION	LG4/F
FLOOR ROOM	CAR PARK FAN ROOM 2
QUANTITY	1
REMARKS	WEATHERPROOF LOUVER (60% FREE AREA)

B.D. REF :

CLIENT :

ARCHITECT :
AGC DESIGN LTD

MAIN CONTRACTOR :
Gammon

STRUCTURAL ENGINEER :
ARUP

FAÇADE CONSULTANT :
MEINHARDT

NOTE :
 1. ALL DIMENSIONS ARE IN mm.
 2. ALL ELEVATIONS ARE VIEWED FROM OUTSIDE.
 3. ALL DIMENSIONS TO BE VERIFIED ON SITE BEFORE FABRICATION.

LEGEND :
 X1 --- DETAIL MARK NO.
 X001 --- REFER SHEET NO.
 1. F.F.L. --- FINISHED FLOOR LEVEL
 2. S.F.L. --- STRUCTURAL FLOOR LEVEL
 3. S.O. --- STRUCTURAL OPENING
 4. ▲ --- FIXING LOCATION
 5. ▽ --- STRUCTURAL FLOOR LEVEL MARK

NO.	DATE	REVISION	BY
D	29-10-2020	REVISION SUBJECT TO COMMENTS	MN
C	05-06-2020	REVISION SUBJECT TO COMMENTS	MN
B	27-04-2020	REVISION SUBJECT TO COMMENTS	MN
A	19-02-2020	REVISION SUBJECT TO COMMENTS	MN

JOB NO. : J-852
 PROJECT : PROPOSED RESIDENTIAL DEVELOPMENT
 AT 139 - 147 ARGYLE STREET,
 NKIL 6005, 6035 R.P., 6036 R.P.,
 6037 R.P. & 6038 R.P.


TITLE : LOUVER SCHEDULE FOR ALUM. LOUVER

DATE : 12-Feb-2020 SCALE : 1:40


DRAWN BY : LHR CHECKED BY : DW

美特鋁質有限公司
MIDI ALUMINIUM FABRICATOR LTD.
 Units 6-8, Sunray Industrial Centre, 1/F
 610 Cha Kwo Ling Road, Kowloon
 Tel:23489211-4 Fax:(852)2727666


DWG NO. : J852-SD-LVA-4008 REV. : D

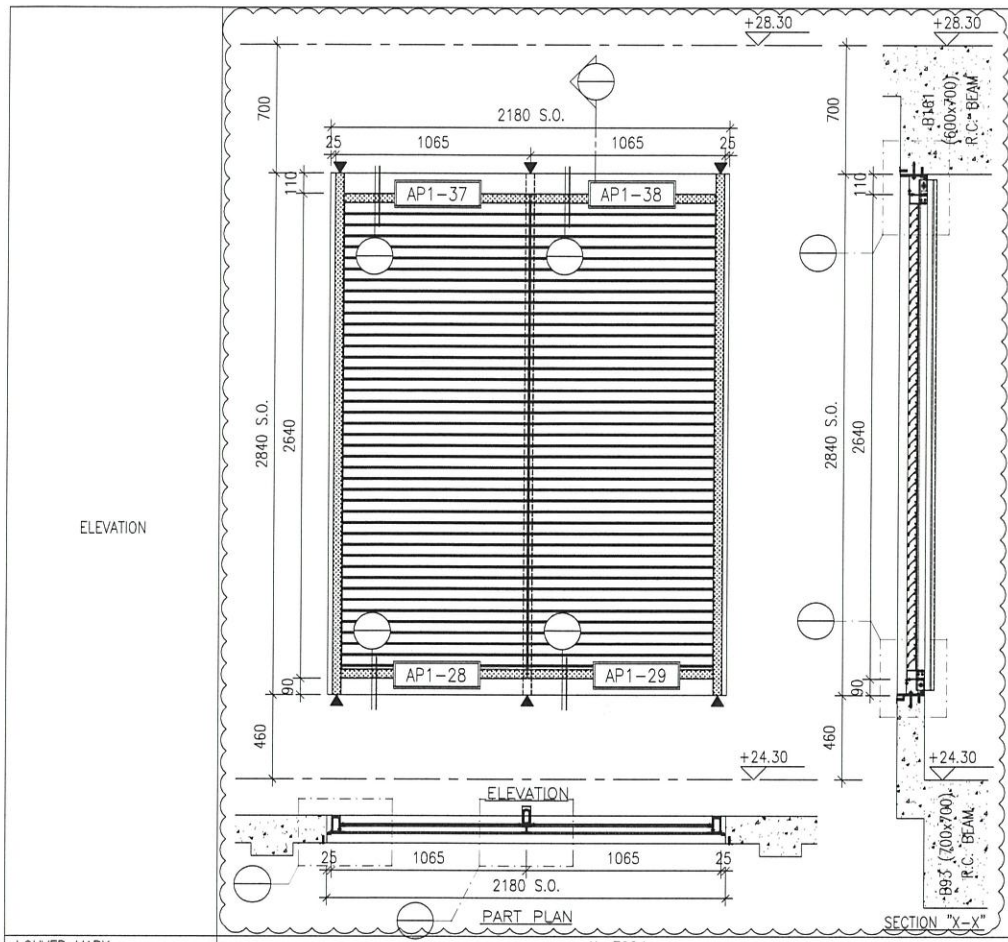


LOUVER MARK	AL-702d
LOCATION	LG4/F
FLOOR ROOM	CAR RAMP
QUANTITY	1
REMARKS	WEATHERPROOF LOUVER (60% FREE AREA)

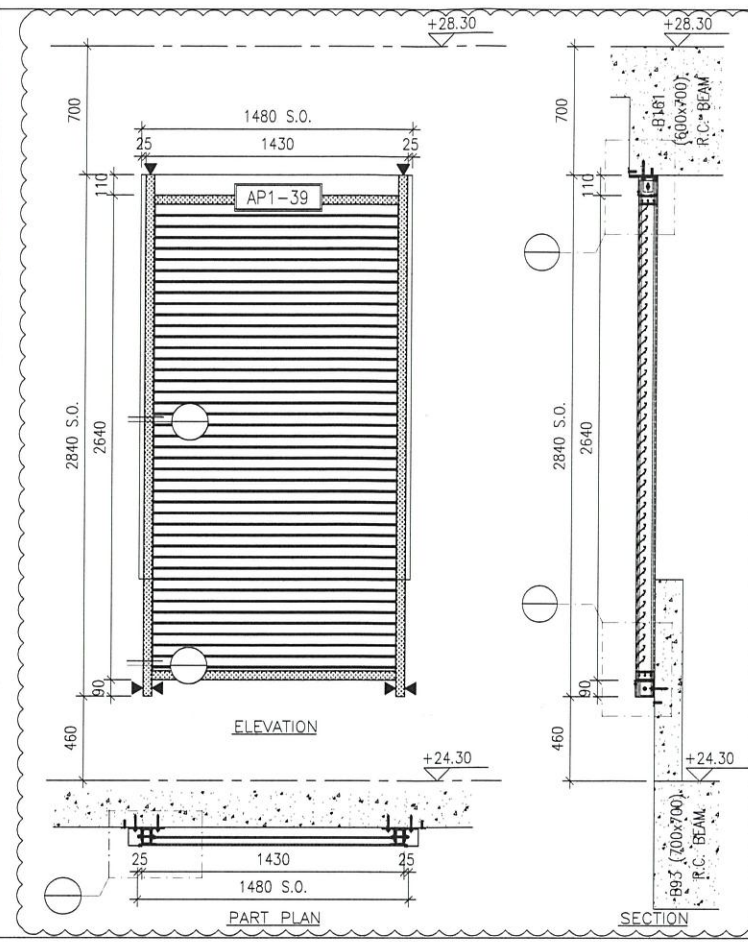


LOUVER MARK	AL-703
LOCATION	LG4/F
FLOOR ROOM	CAR RAMP
QUANTITY	1
REMARKS	WEATHERPROOF LOUVER (60% FREE AREA)

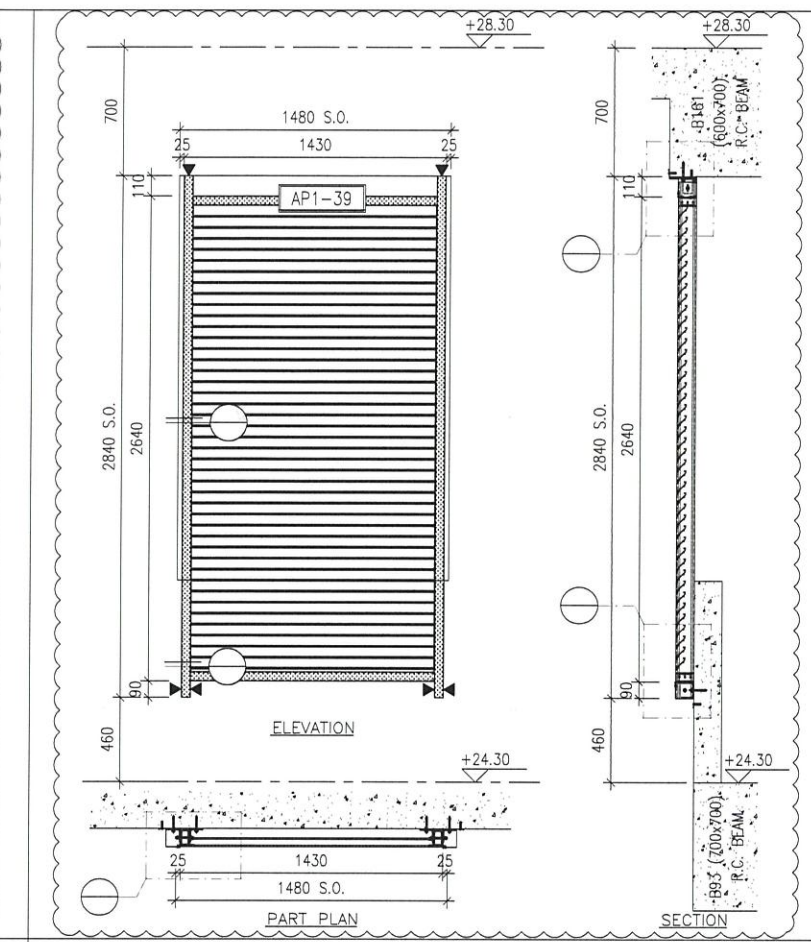

LOUVER MARK	AL-703a
LOCATION	LG4/F
FLOOR ROOM	CAR RAMP
QUANTITY	1
REMARKS	WEATHERPROOF LOUVER (60% FREE AREA)

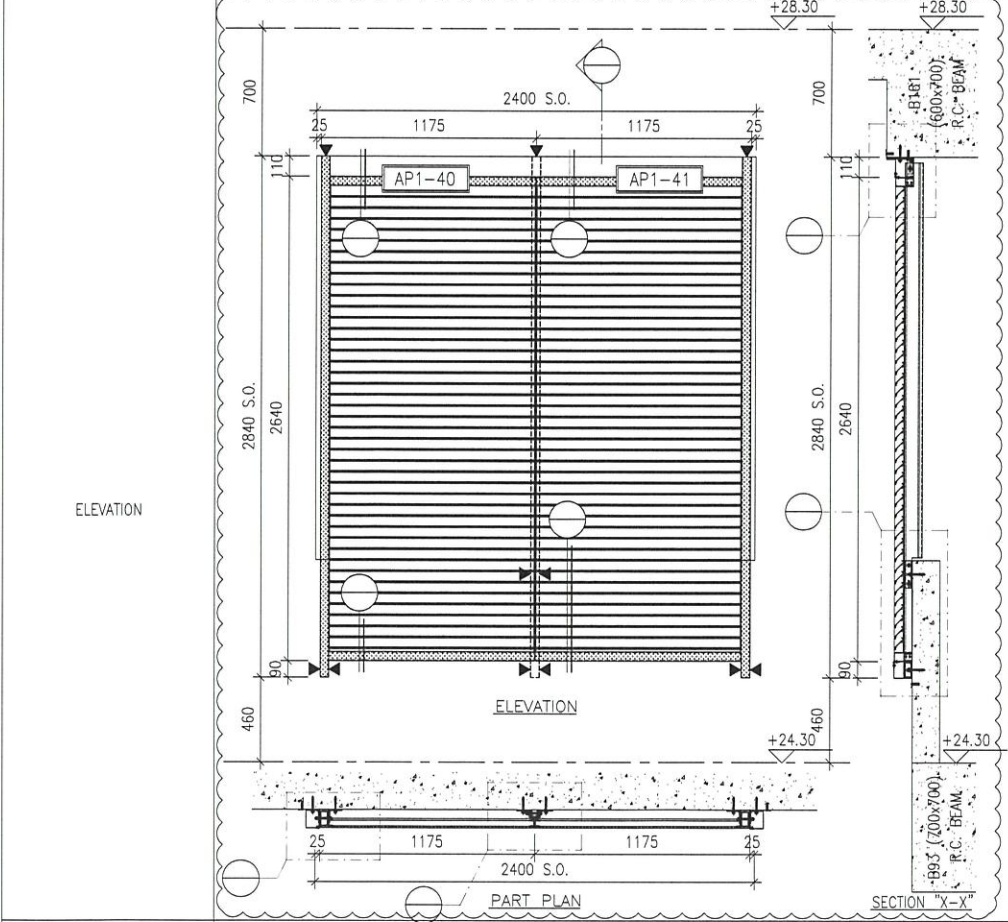

LOUVER MARK	AL-704
LOCATION	LG4/F
FLOOR ROOM	CAR RAMP
QUANTITY	1
REMARKS	WEATHERPROOF LOUVER (60% FREE AREA)

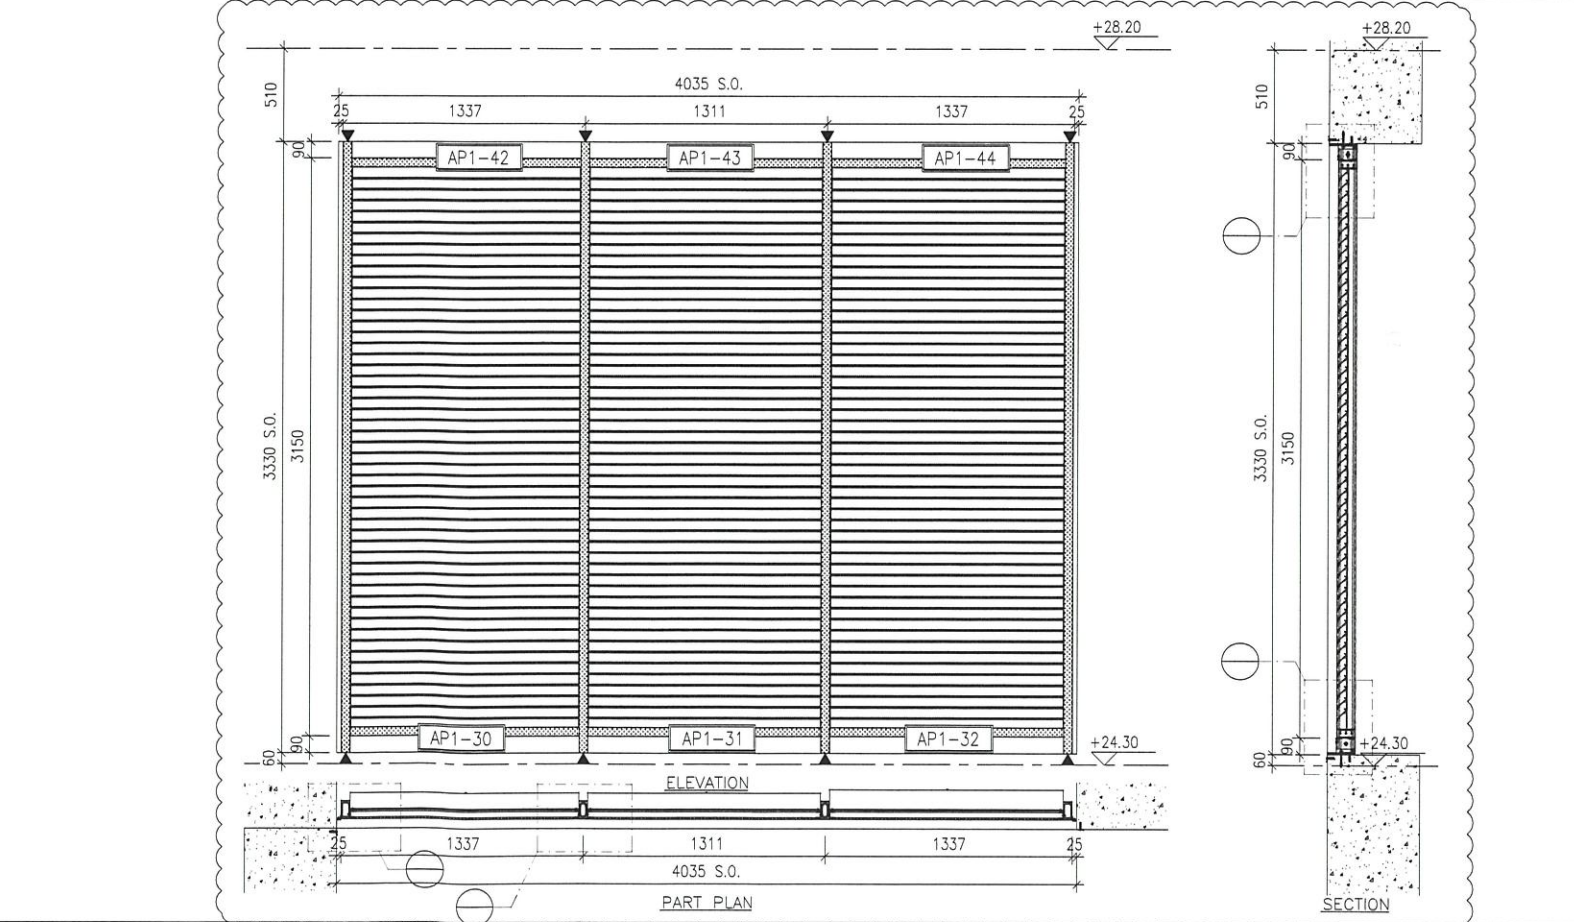

LOUVER MARK	AL-705
LOCATION	LG4/F
FLOOR ROOM	A/C PLANT ROOM
QUANTITY	1
REMARKS	WEATHERPROOF LOUVER (60% FREE AREA)

B.D. REF :

CLIENT :

ARCHITECT :

AGC DESIGN LTD

MAIN CONTRACTOR :

Gammon

STRUCTURAL ENGINEER :

ARUP

FAÇADE CONSULTANT :

MEINHARDT

NOTE :

- ALL DIMENSIONS ARE IN mm.
- ALL ELEVATIONS ARE VIEWED FROM OUTSIDE.
- ALL DIMENSIONS TO BE VERIFIED ON SITE BEFORE FABRICATION.

LEGEND :

(X1) --- DETAIL MARK NO.
 (X001) --- REFER SHEET NO.

- F.F.L. --- FINISHED FLOOR LEVEL
- S.F.L. --- STRUCTURAL FLOOR LEVEL
- S.O. --- STRUCTURAL OPENING
- ▲ --- FIXING LOCATION
- ▽ --- STRUCTURAL FLOOR LEVEL MARK

NO.	DATE	REVISION	BY
D	29-10-2020	REVISION SUBJECT TO COMMENTS	MN
C	05-06-2020	REVISION SUBJECT TO COMMENTS	MN
B	27-04-2020	REVISION SUBJECT TO COMMENTS	MN
A	19-02-2020	REVISION SUBJECT TO COMMENTS	MN

JOB NO. : J-852

PROJECT :

PROPOSED RESIDENTIAL DEVELOPMENT
 AT 139 - 147 ARGYLE STREET,
 NKIL 6005, 6035 R.P., 6036 R.P.,
 6037 R.P. & 6038 R.P.

TITLE : LOUVER SCHEDULE FOR ALUM. LOUVER

DATE : 12-Feb-2020 SCALE : 1:40

DRAWN BY : LHR CHECKED BY : DW



美特鋁質有限公司
MIDI ALUMINIUM FABRICATOR LTD.
 Units 6-8, Sunray Industrial Centre, 1/F
 610 Cha Kwo Ling Road, Kowloon
 Tel:23489211-4 Fax:(852)2772666

DWG NO. : J852-SD-LVA-4009 REV. : D

B5 (2)
R.C.

B5
SECTION
1


ELEVATION

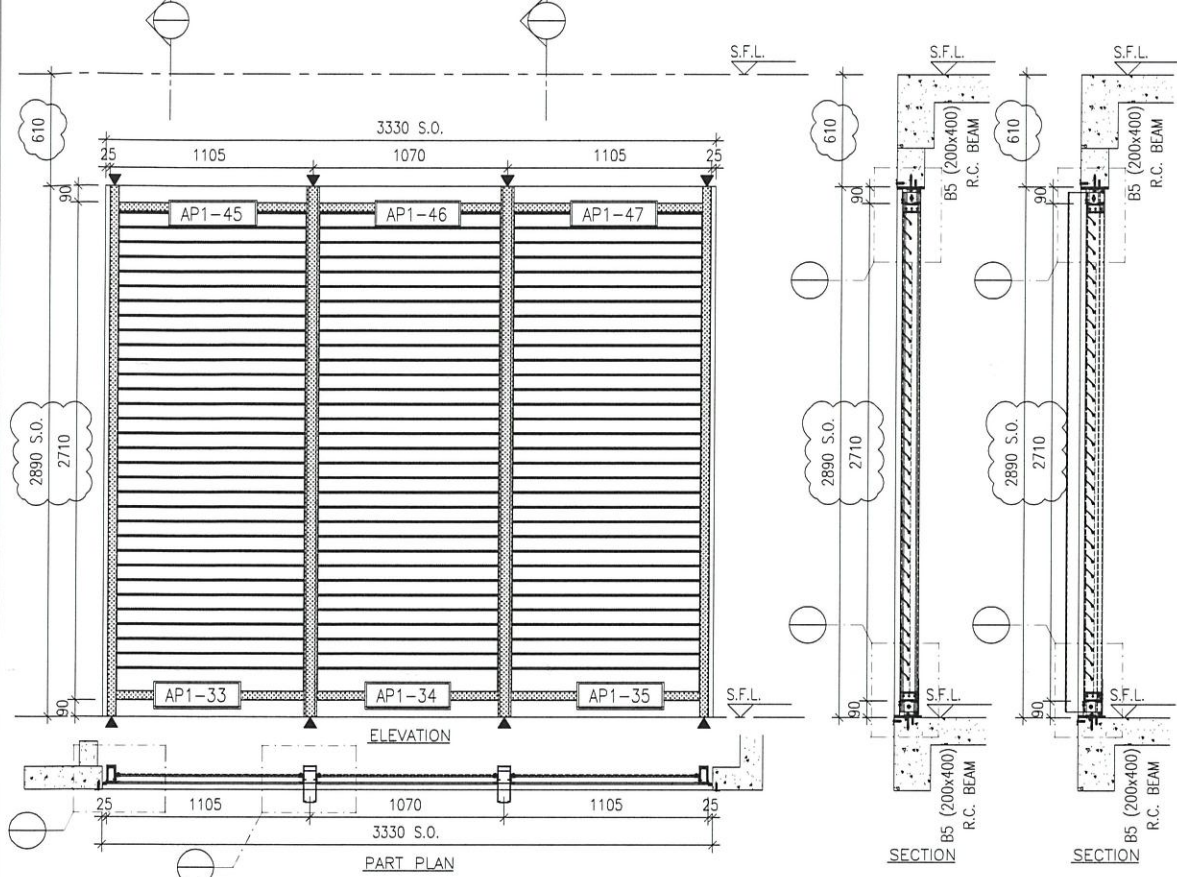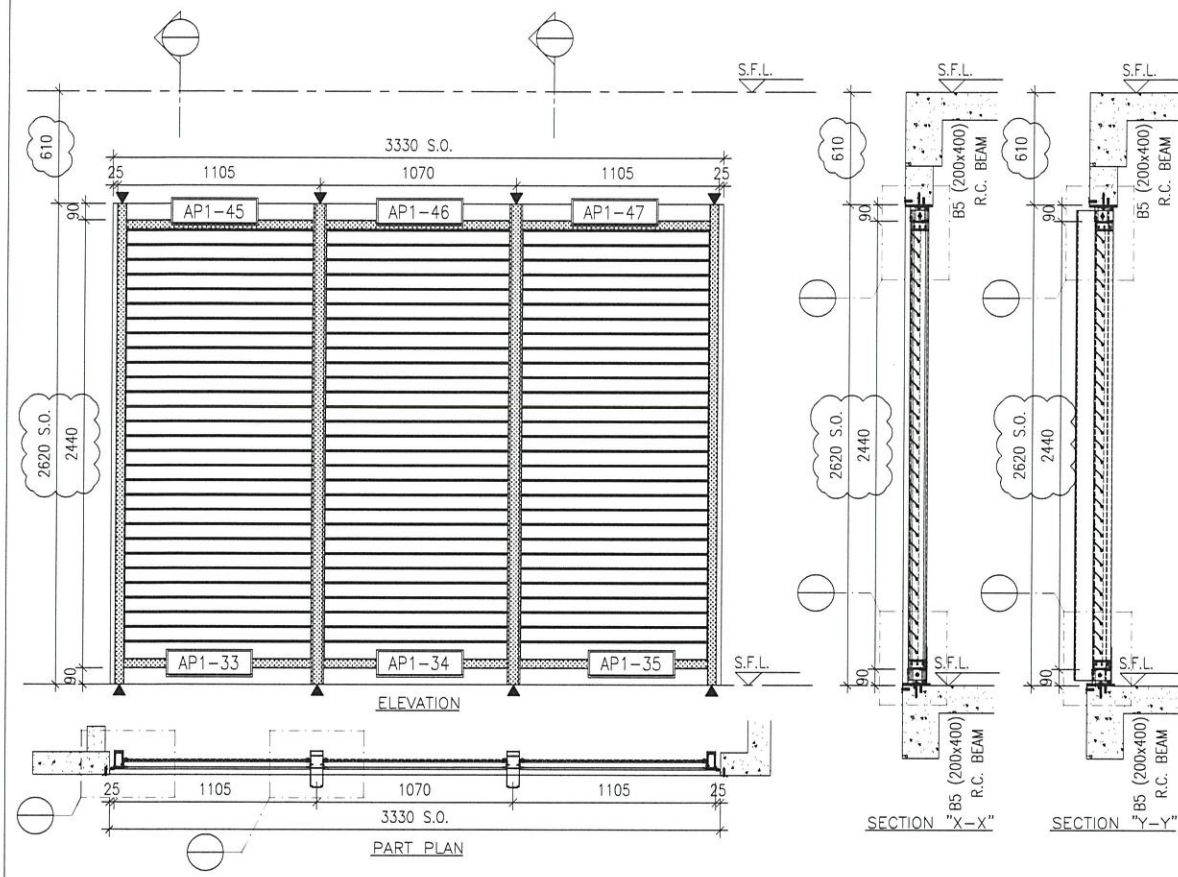

LOUVER MARK	LLC
LOCATION	FLOOR ROOM 2/F ~ 21/F (4, 13, 14 OMITTED) (TOWER 1 & 2 & 3) A/C PLANT ROOM
QUANTITY	51
REMARKS	WEATHERPROOF LOUVER (70% FREE AREA)

LOUVER MARK	LLC _a
LOCATION	FLOOR ROOM 22/F ~ 23/F (TOWER 1 & 2 & 3) A/C PLANT ROOM
QUANTITY	6
REMARKS	WEATHERPROOF LOUVER (70% FREE AREA)

ELEVATION

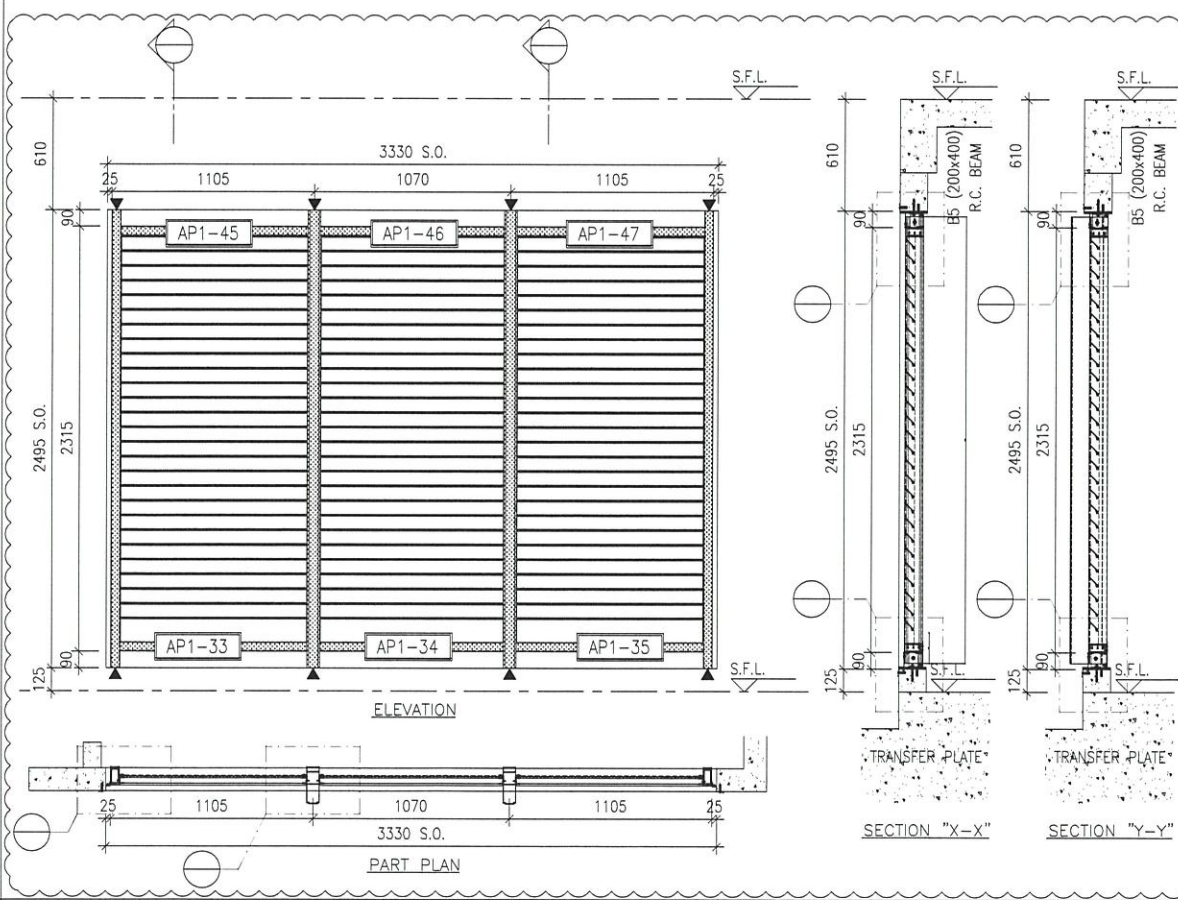

LOUVER MARK	LLC _b
LOCATION	FLOOR ROOM 1/F (TOWER 1 & 2 & 3) A/C PLANT ROOM
QUANTITY	3
REMARKS	WEATHERPROOF LOUVER (70% FREE AREA)

B.D. REF :

CLIENT :

ARCHITECT :
AGC DESIGN LTD

MAIN CONTRACTOR :
Gammon

STRUCTURAL ENGINEER :
ARUP

FAÇADE CONSULTANT :
MEINHARDT

NOTE :
1. ALL DIMENSIONS ARE IN mm.
2. ALL ELEVATIONS ARE VIEWED FROM OUTSIDE.
3. ALL DIMENSIONS TO BE VERIFIED ON SITE BEFORE FABRICATION.

LEGEND :
X1 --- DETAIL MARK NO.
X001 --- REFER SHEET NO.
1. F.F.L. --- FINISHED FLOOR LEVEL
2. S.F.L. --- STRUCTURAL FLOOR LEVEL
3. S.O. --- STRUCTURAL OPENING
4. ▲ --- FIXING LOCATION
5. ▽ --- STRUCTURAL FLOOR LEVEL MARK

D	29-10-2020	REVISION SUBJECT TO COMMENTS	MN
C	05-06-2020	REVISION SUBJECT TO COMMENTS	MN
B	27-04-2020	REVISION SUBJECT TO COMMENTS	MN
NO.	DATE	REVISED	BY

JOB NO. : J-852
PROJECT : PROPOSED RESIDENTIAL DEVELOPMENT AT 139 - 147 ARGYLE STREET, NKIL 6005, 6035 R.P., 6036 R.P., 6037 R.P. & 6038 R.P.

TITLE : LOUVER SCHEDULE FOR ALUM. LOUVER

DATE : 27-Apr-2020 SCALE : 1:40

DRAWN BY : LHR CHECKED BY : DW

美特鋁質有限公司
MIDI ALUMINIUM FABRICATOR LTD.
Units 6-8, Sunray Industrial Centre, 1/F
610 Cha Kwo Ling Road, Kowloon
Tel:23489211-4 Fax:(852)27727666

DWG NO. : J852-SD-LVA-4010 REV. : D