

工程指示 / 要求簡箋(E.I.)

工程指示編號：EI / 2809 / 20

修改版次：B

工程編號：J - 852

工程名稱：亞皆老街中電

工程項目：大樓 偏林箱 圖紙

收件人：生統 / 胡冬雲

發件人：Ant Yeung

日期：27/04/2021

要求提供 / 確認 事項：

- | | | |
|------------------------------------|-------------------------------------|-------------------------------|
| <input type="checkbox"/> 初步鋁料 B.M. | <input type="checkbox"/> 加工拆圖，然後生產 | <input type="checkbox"/> 尺寸表 |
| <input type="checkbox"/> 正式鋁料 B.M. | <input type="checkbox"/> 技術上資料 / 指示 | <input type="checkbox"/> 報價 |
| <input type="checkbox"/> 配件 B.M. | <input type="checkbox"/> 樣辦或貨品說明書 | <input type="checkbox"/> 分判合約 |
| <input type="checkbox"/> 其他：_____ | | |

內容：

B 版：已修改 W9/T1C, 附上修改圖+ CAD

A 版：附上最新大圖，請覆核加工圖

請按附上大樓偏林箱圖紙，為生產分判 樣板層: T1,T2,T3, 5/F. 請先報價 (要包拆圖)

T1 = 138 個

T2 = 137 個

T3 = 153 個 合共 428 個偏林箱 (厚度: 3mm)

優先生產 T3, 5/F 數量交現場樣板層安裝

大貨 10 層一批，第一批預 2 月頭至中，實際日期到貨由地盤安排

分判：請先交樣板。 謝謝

請在 2021.04. 28 前完成上列要求。

附：1 頁+ CAD

以上項目為：

- 原合約工程包 原合約工程加 / 減賬 新工程報價

原因：-

分發東莞各部門：

- | | | | |
|---|---|--|-------------------------------------|
| <input type="checkbox"/> 生產技術總監口連附件 | <input type="checkbox"/> 技術部 <input type="checkbox"/> 連附件 | <input type="checkbox"/> 生產部 <input type="checkbox"/> 連附件 | <input type="checkbox"/> 機械設計部口連附件 |
| <input type="checkbox"/> 採購部 <input type="checkbox"/> 連附件 | <input checked="" type="checkbox"/> 生產統籌部 <input checked="" type="checkbox"/> 連附件 | <input type="checkbox"/> 清&小羅 <input type="checkbox"/> 連附件 | |
| <input type="checkbox"/> 質檢部 <input type="checkbox"/> 連附件 | <input type="checkbox"/> 會計部 <input type="checkbox"/> 連附件 | <input type="checkbox"/> 報關組 <input type="checkbox"/> 連附件 | <input type="checkbox"/> 其他 楊榮輝口連附件 |

分發其他分判：

- 水洪 連附件

分發香港各部門：

- | | | | |
|----------------------------------|--|----------------------------------|---------------------------------------|
| <input type="checkbox"/> 行政部口連附件 | <input type="checkbox"/> 會計部口連附件 | <input type="checkbox"/> 統籌部口連附件 | <input type="checkbox"/> 工程部地盤科文口連附件 |
| <input type="checkbox"/> 採購部口連附件 | <input type="checkbox"/> QS 部 <input type="checkbox"/> 連附件 | <input type="checkbox"/> 維修部口連附件 | <input type="checkbox"/> 其他 _____口連附件 |


傳遞編號：

HK 891 / 21

發件人簽署：

項目經理簽署：

ELEVATION

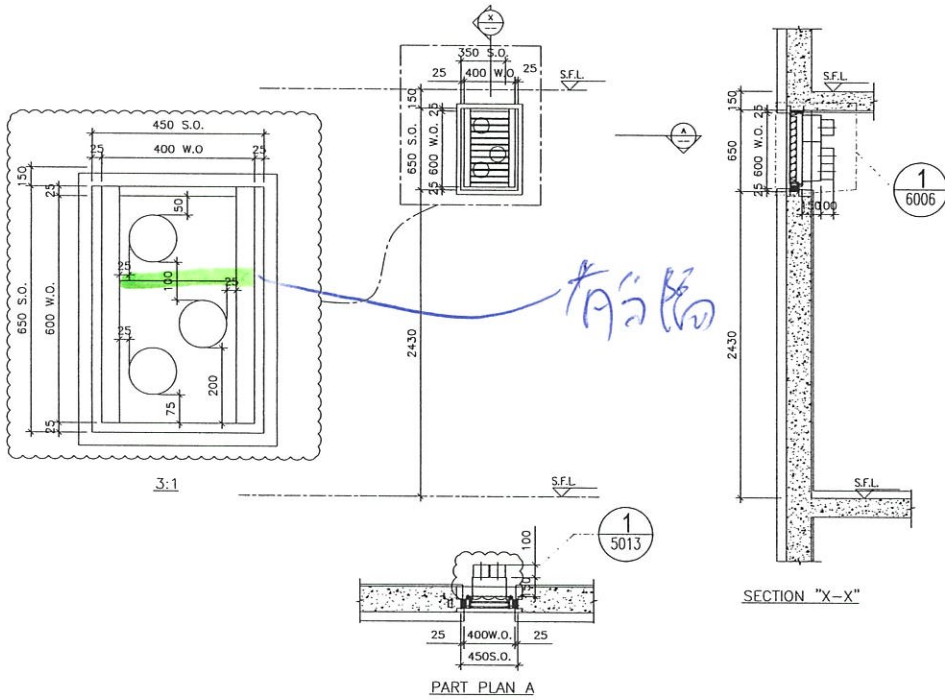

Handwritten notes: 有分格, 1 6006, 1 5013, 2021.4.26

B.D. REF :

CLIENT :

ARCHITECT :
AGC DESIGN LTD

MAIN CONTRACTOR :
Gammon

STRUCTURAL ENGINEER :
ARUP

FACADE CONSULTANT:
MEINHARDT

NOTE:
1. ALL DIMENSIONS ARE IN mm.
2. ALL ELEVATIONS ARE VIEWED FROM OUTSIDE.
3. ALL DIMENSIONS TO BE VERIFIED ON SITE BEFORE FABRICATION.

LEGEND:
X1 --- DETAIL MARK NO.
X0001 --- REFER SHEET NO.

1. F.F.L. --- FINISHED FLOOR LEVEL
2. S.F.L. --- STRUCTURAL FLOOR LEVEL
3. (2) --- REVERSED DETAIL
4. ▲ --- FIXING LOCATION
5. △ --- FIXING LUG LOCATION
6. GLASS LEGEND
GL01 --- 8mm+12mm AIR GAP+10mm THK. I.G.U.
GL01a --- 8mm+9mm AIR GAP+12mm THK. I.G.U.
GL03 --- 6mm+12mm AIR GAP+6mm THK. I.G.U.
GL04 --- 10mm THK. TEMPERED GLASS (PROTECTIVE BARREX)
GL05 --- 6mm+12mm AIR GAP+8mm THK. I.G.U.

B	26/04/2021	REVISION SUBJECT TO ARCH.COMMENT	WPH
A	06/01/2021	REVISION SUBJECT TO ARCH.COMMENT	WPH
MC	DATE	REVISED	BY

JOB NO. : J-852
PROJECT : PROPOSED RESIDENTIAL DEVELOPMENT AT 139 - 147 ARGYLE STREET, NKIL 6005, 6035 R.P., 6036 R.P., 6037 R.P. & 6038 R.P.
TITLE : SCHEDULE FOR Plenum Box AT TOWER 1 (1-21F)

DATE : 05-Dec-19 SCALE : 1:40
DRAWN BY : MN CHECKED BY : DW

MIDI ALUMINUM FABRICATOR LTD.
Units 6-8, Sunray Industrial Centre, 1/F
610 Cho Kwo Ling Road, Kowloon
Tel: 23489211-4 Fax: (852) 2727666
DWG NO. : J852-SD-PB-4106 REV. : B

WINDOW MARK	W9 TIC
LOCATION	1/F-21/F Corridor AT TOWER 1 FLAT C
SECTION	70mm ALUM. SECTION
GLAZING	
QUANTITY	18
REMARKS	