

## 工程指示 / 要求簡箋(E.I.)

工程指示編號：EI / 3066 / 21

修改版次：- A

工程編號：J - 852

工程名稱：亞皆老街中電

工程項目：天花 地盤用 鐵件 大貨 (T1-T3) (1-23/F) \*(減去 T1-T3: 3-6/F)\*

收件人：Maggie

發件人：Ant Yeung

日期：05/03/2021

□要求提供 / □確認 事項：

- |                                    |                                     |                               |
|------------------------------------|-------------------------------------|-------------------------------|
| <input type="checkbox"/> 初步鋁料 B.M. | <input type="checkbox"/> 加工拆圖，然後生產  | <input type="checkbox"/> 尺寸表  |
| <input type="checkbox"/> 正式鋁料 B.M. | <input type="checkbox"/> 技術上資料 / 指示 | <input type="checkbox"/> 報價   |
| <input type="checkbox"/> 配件 B.M.   | <input type="checkbox"/> 樣辦或貨品說明書   | <input type="checkbox"/> 分判合約 |

內容：

A 版：改寫材料 150x100x10mm 厚。

1. 請安排鐵廠加工和公正行驗焊事宜

2. 驗焊: Butt Weld: 100% UT 超聲波, 100% MPI 磁粉, 100% Visual 目測。(For 天花)

3. 包扎: 1 個露台 1 扎. 出貨請寫樓層和單位。

請在 2021.03.12 前完成上列要求。

附：2 頁

以上項目為：

 原合約工程包                       原合約工程加 / 減賬                       新工程報價

原因：-

分發東莞各部門：

- |                                     |                               |                                    |                               |                               |                                    |
|-------------------------------------|-------------------------------|------------------------------------|-------------------------------|-------------------------------|------------------------------------|
| <input type="checkbox"/> 生產技術總監口連附件 | <input type="checkbox"/> 技術部  | <input type="checkbox"/> 口連附件      | <input type="checkbox"/> 生產部  | <input type="checkbox"/> 口連附件 | <input type="checkbox"/> 機械設計部口連附件 |
| <input type="checkbox"/> 採購部        | <input type="checkbox"/> 口連附件 | <input type="checkbox"/> 生產統籌部口連附件 | <input type="checkbox"/> 小羅&清 | <input type="checkbox"/> 口連附件 |                                    |
| <input type="checkbox"/> 質檢部        | <input type="checkbox"/> 口連附件 | <input type="checkbox"/> 會計部       | <input type="checkbox"/> 口連附件 | <input type="checkbox"/> 報關組  | <input type="checkbox"/> 口連附件      |
|                                     |                               |                                    |                               | <input type="checkbox"/> 其他   | _____口連附件                          |

分發其他分判：

(v) 水洪       口連附件

分發香港各部門：

- |   |                                  |                                  |   |                                       |
|---|----------------------------------|----------------------------------|---|---------------------------------------|
| <input type="checkbox"/> 行政部口連附件            | <input type="checkbox"/> 會計部口連附件 | <input type="checkbox"/> 統籌部口連附件 | <input checked="" type="checkbox"/> 工程部地盤科文口連附件 | 祥哥                                    |
| <input checked="" type="checkbox"/> 採購部口連附件 | <input type="checkbox"/> QS 部    | <input type="checkbox"/> 口連附件    | <input type="checkbox"/> 維修部口連附件                | <input type="checkbox"/> 其他 _____口連附件 |

傳遞編號：

發件人簽署：

HK / / 21

項目經理簽署：  





美特鋁質有限公司  
MIDI Aluminium Fabricator Ltd.

工程號 J-852 地盤 亞答老街/天花

紅 3066

4-ø7mm 過孔

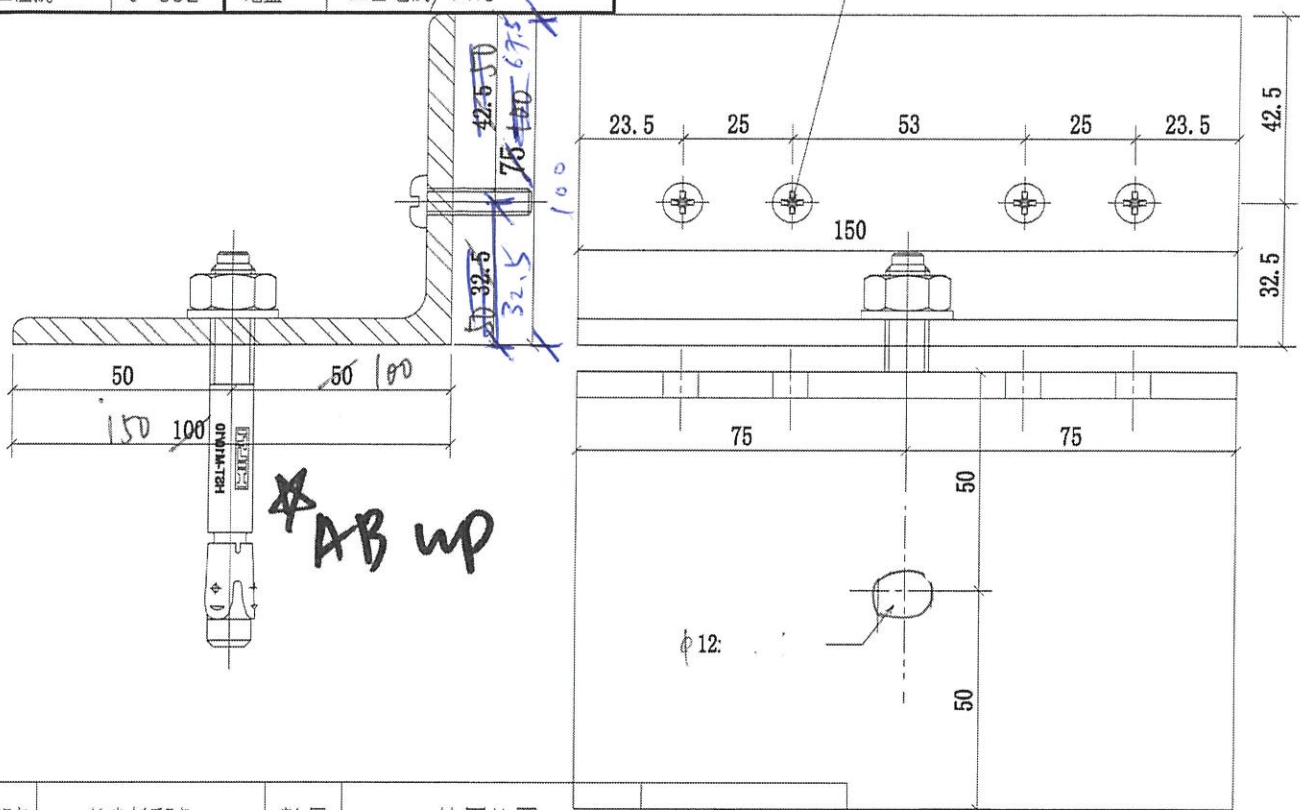

序號	物料編號	數量	使用位置	樓層
01	4103-MS01-Y9	45	J852-SD-ALC-4103	T1/(1~21F)
02	4104-MS01-Y9	45	J852-SD-ALC-4104	T1/(1~21F)
03	4105-MS01-Y9	<del>102</del>	J852-SD-ALC-4105	T1/(1~23F)
04	4106-MS01-Y9	<del>90</del>	J852-SD-ALC-4106	T1/(1~21F)
05	4107-MS01-Y9	<del>12</del>	J852-SD-ALC-4107	T1/(22,23F)
06	4203-MS01-Y9	48	J852-SD-ALC-4203	T2/(1~22F)
07	4204-MS01-Y9	48	J852-SD-ALC-4204	T2/(1~22F)
08	4205-MS01-Y9	<del>102</del>	J852-SD-ALC-4205	T2/(1~23F)
09	4206-MS01-Y9	<del>90</del>	J852-SD-ALC-4206	T2/(1~21F)
10	4207-MS01-Y9	<del>12</del>	J852-SD-ALC-4207	T2/(22,23F)
11	4304-MS01-Y9	45	J852-SD-ALC-4304	T3/(1F~21F)
12	4305-MS01-Y9	45	J852-SD-ALC-4305	T3/(1F~21F)
13	4306-MS01-Y9	<del>102</del>	J852-SD-ALC-4306	T3/(1~23F)
14	4307-MS01-Y9	<del>8</del>	J852-SD-ALC-4307	T3/(1F)
15	4307A-MS01-Y9	<del>96</del>	J852-SD-ALC-4307A	T3/(2~23F)
		888	276	


B up  
A up

A up  
B up


UP

A up  
B up

本品  
4103

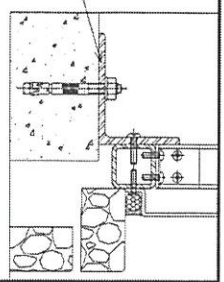

名稱	天花鋁架角碼	制圖	CJM	2021.01.29	修改	
材料	100x75x6mm 鍍鋅角鋼(材質: SJ275)	復核	SHUI	2021.01.30	日期	
顏色	熱浸鋅 150x100x100	批準			圖號	4103-MS01-Y9-100

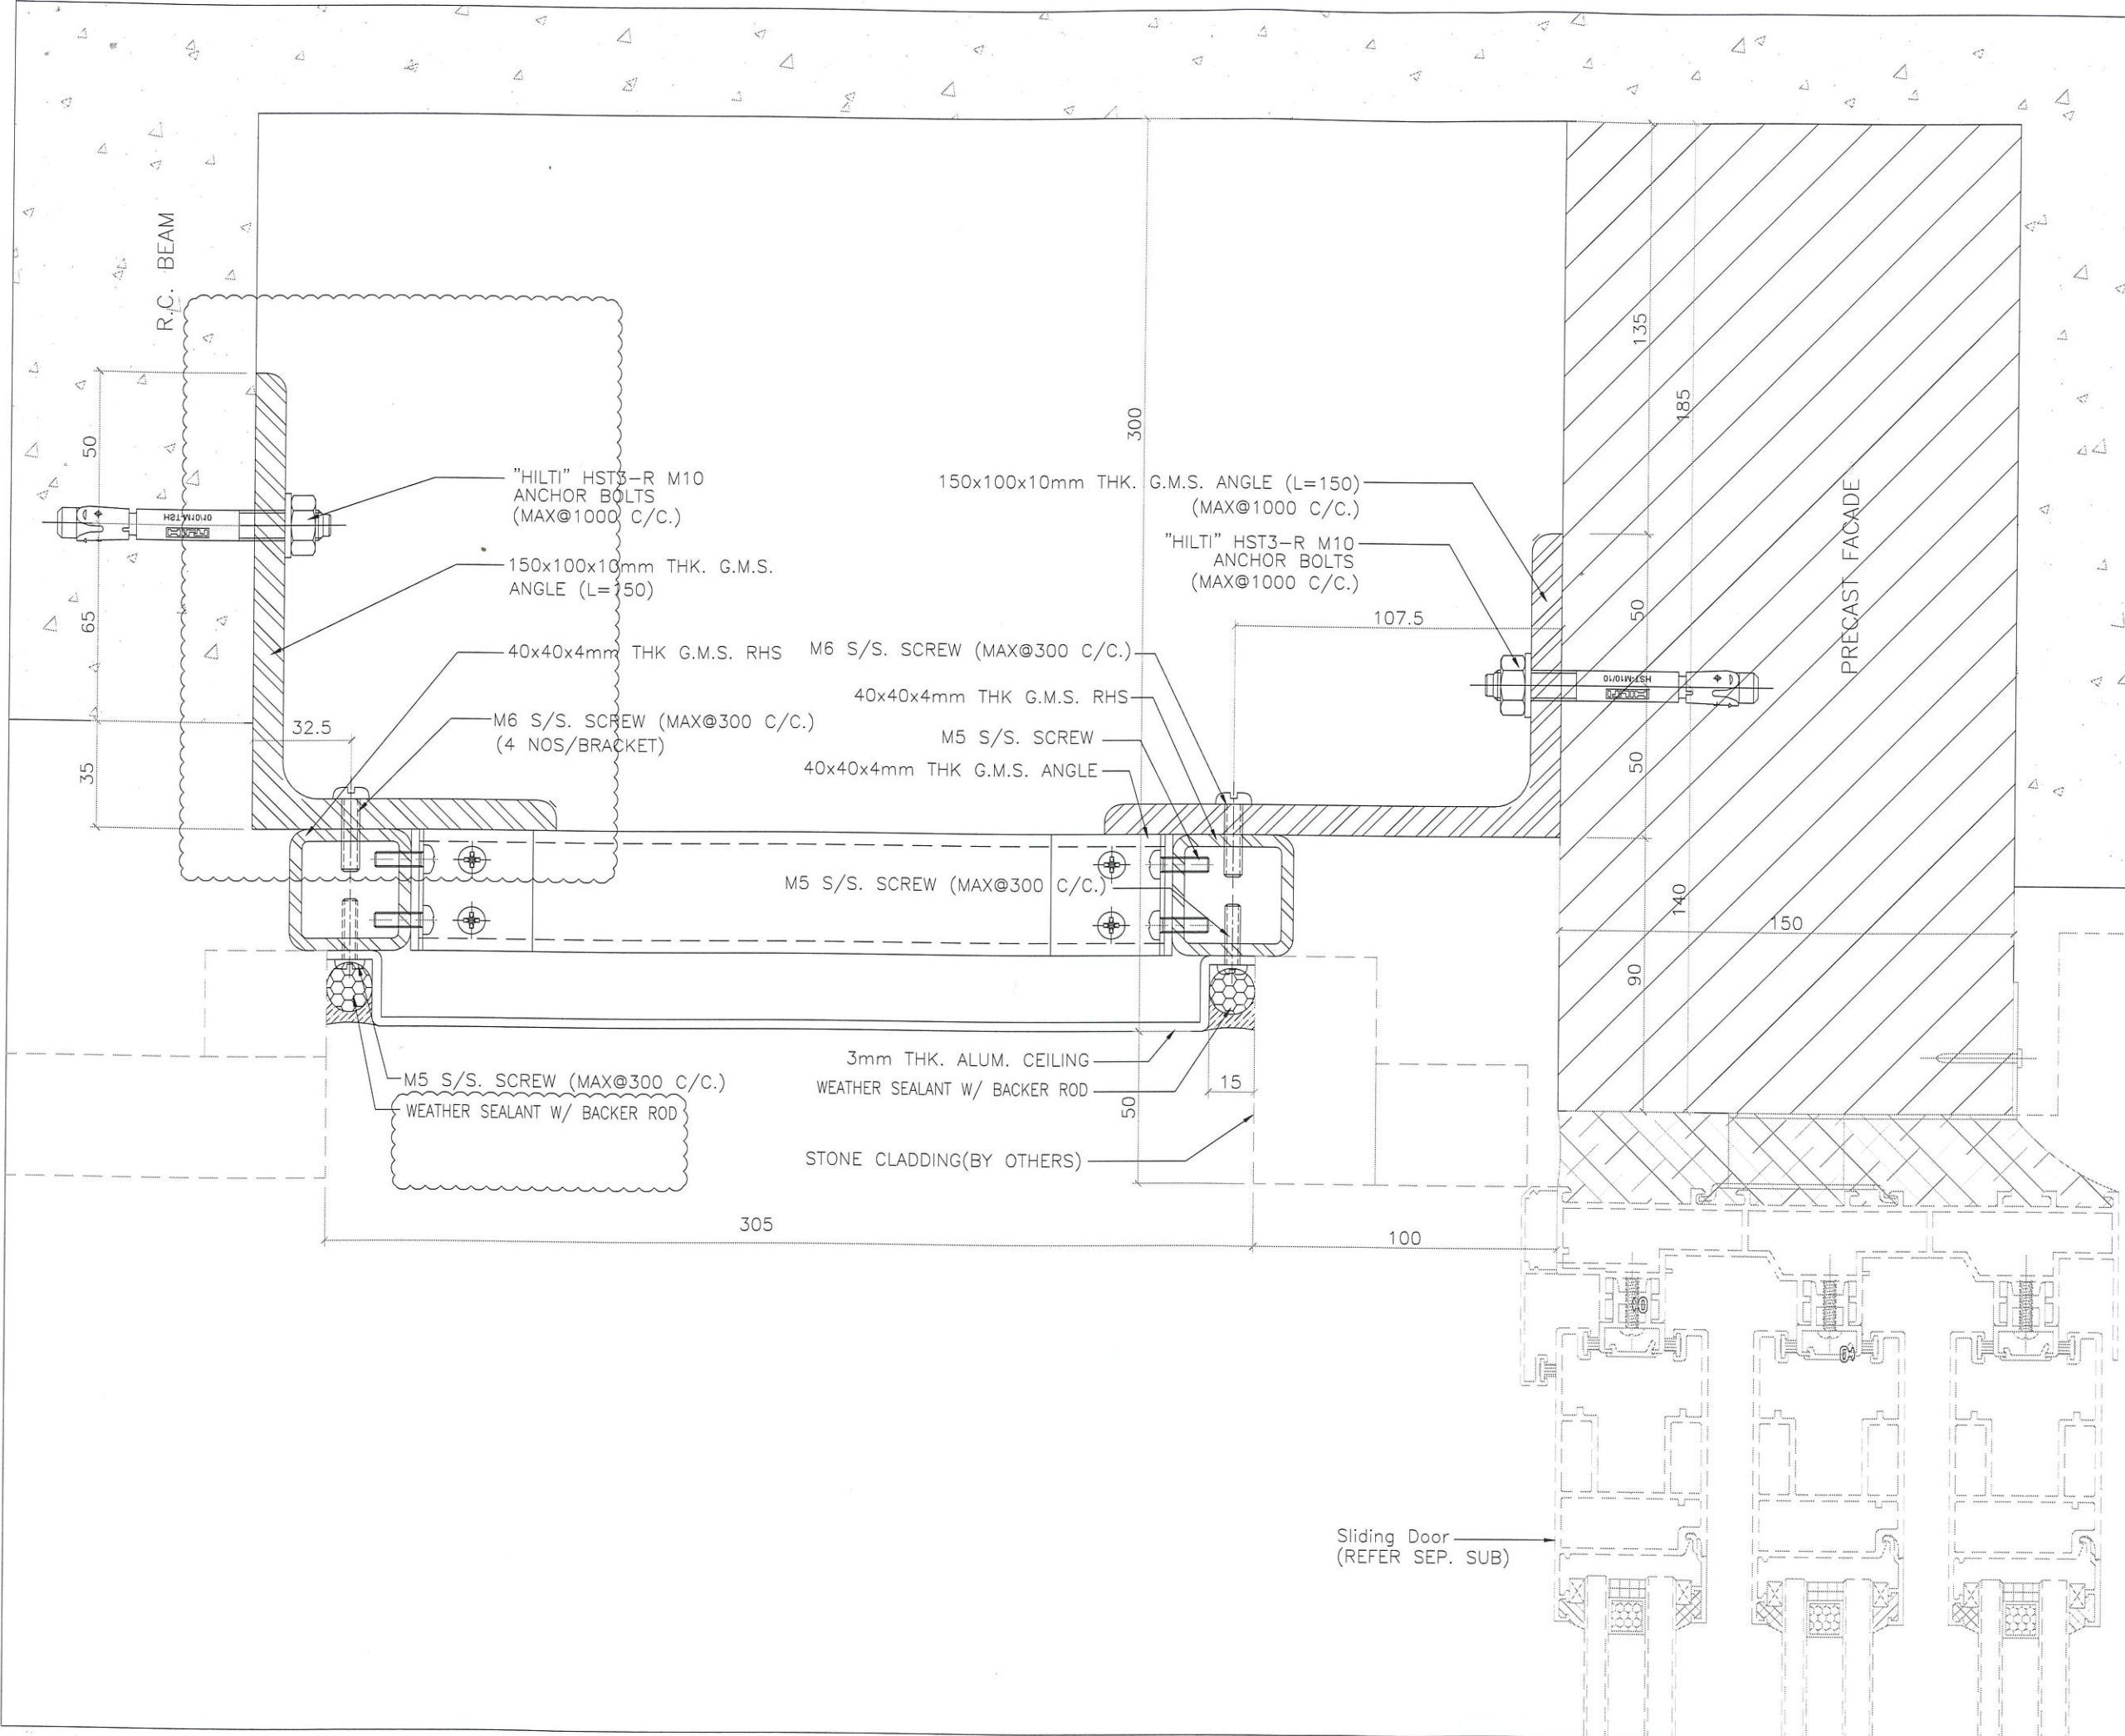

B.D. REF :

CLIENT :

ARCHITECT :  
**AGC DESIGN LTD**

MAIN CONTRACTOR :  
**Gammon**

STRUCTURAL ENGINEER :  
**ARUP**

FACADE CONSULTANT:  
**MEINHARDT**

NOTE :  
 1. ALL DIMENSIONS ARE IN mm.  
 2. ALL ELEVATIONS ARE VIEWED FROM OUTSIDE.  
 3. ALL DIMENSIONS TO BE VERIFIED ON SITE BEFORE FABRICATION.

LEGEND :  
 X1 --- DETAIL MARK NO.  
 X001 --- REFER SHEET NO.  
 1. F.F.L. --- FINISHED FLOOR LEVEL  
 2. S.F.L. --- STRUCTURAL FLOOR LEVEL  
 3. (R) --- REVERSED DETAIL

NO.	DATE	REVISED	BY
D	04/03/2021	REVISION SUBJECT TO ARCH. COMMENT	LWC
C	04/03/2021	REVISION SUBJECT TO ARCH. COMMENT	LWC
B	10/12/2020	REVISION SUBJECT TO ARCH. COMMENT	LWC
A	18/11/2020	REVISION SUBJECT TO ARCH. COMMENT	LWC

JOB NO. : J-852  
 PROJECT :  
 PROPOSED RESIDENTIAL DEVELOPMENT  
 AT 139 - 147 ARGYLE STREET,  
 NKIL 6005, 6035 R.P., 6036 R.P.,  
 6037 R.P. & 6038 R.P.

TITLE :  
 VERTICAL DETAIL FOR  
 NORMAL ALUM. CEILING  
 (FLAT A&B UP)

DATE : 02-Mar-20 SCALE : 1:2  
 DRAWN BY : LHR CHECKED BY : DW

**美特鋁質有限公司**  
**MIDI ALUMINIUM FABRICATOR LTD.**  
 Units 6-8, Sunray Industrial Centre, 1/F  
 610 Cho Kwo Ling Road, Kowloon  
 Tel:23489211-4 Fax:(852)2727666

DWG NO. : J852-SD-ALC-6011 REV. : D