

工程指示 / 要求簡箋(E.I.)

工程指示編號：EI / 3114 / 21

修改版次：A

工程編號：J - 852

工程名稱：亞皆老街中電

工程項目：外牆鋁板項目 層間鋁板 地盤用鐵件(T1-T3)(大貨)

收件人：Maggie

發件人：Ant Yeung

日期：09/03/2021

以此為準

☐要求提供 / ☐確認 事項：

- | | | |
|------------------------------------|-------------------------------------|-------------------------------|
| ☐ 初步鋁料 B.M. | ☐ 加工拆圖，然後生產 | ☐ 尺寸表 |
| ☐ 正式鋁料 B.M. | ☐ 技術上資料 / 指示 | ☐ 報價 |
| ☐ 配件 B.M. | ☐ 樣辦或貨品說明書 | ☐ 分判合約 |

內容：

A 版：請按加工圖訂購鐵介子送地盤安裝用 補回鐵件位置圖

1) 請安排分判訂購鐵介子，恆豐另報價

2) 優先生產及出貨 T3 數量，優先安裝，其餘出貨次序按附件 MO 排序

謝謝

請在 2021.03.12 前完成上列要求。

附：1 頁加工圖 +39 頁派位圖

以上項目為：

☐ 原合約工程包 ☐ 原合約工程加 / 減賬 ☐ 新工程報價

原因：-

分發東莞各部門：

- | | | | |
|-------------------------------------|------------------------------------|------------------------------------|--|
| ☐ 生產技術總監口連附件 | ☐ 技術部 口連附件 | ☐ 生產部 口連附件 | ☐ 機械設計部口連附件 |
| ☐ 採購部 口連附件 | ☐ 生產統籌部口連附件 | ☐ 小羅&清 口連附件 | |
| ☐ 質檢部 口連附件 | ☐ 會計部 口連附件 | ☐ 報關組 口連附件 | ☐ 其他 _____ 口連附件 |

分發其他分判：

(v) 水洪 ☒ 連附件

分發香港各部門：

- | | | | |
|---|------------------------------------|----------------------------------|--|
| ☐ 行政部口連附件 | ☐ 會計部口連附件 | ☐ 統籌部口連附件 | ☒ 工程部地盤科文口連附件 (祥哥) |
| ☒ 採購部口連附件 | ☐ QS 部 口連附件 | ☐ 維修部口連附件 | ☐ 其他 _____ 口連附件 |

傳遞編號：

發件人簽署：

HK / 21

項目經理簽署：



美特鋁質 有限公司
MIDI Aluminium Fabricator Ltd.

工程號


J852

地盤

亞答老街

用于鋁板鐵架兩邊位置

交地盤

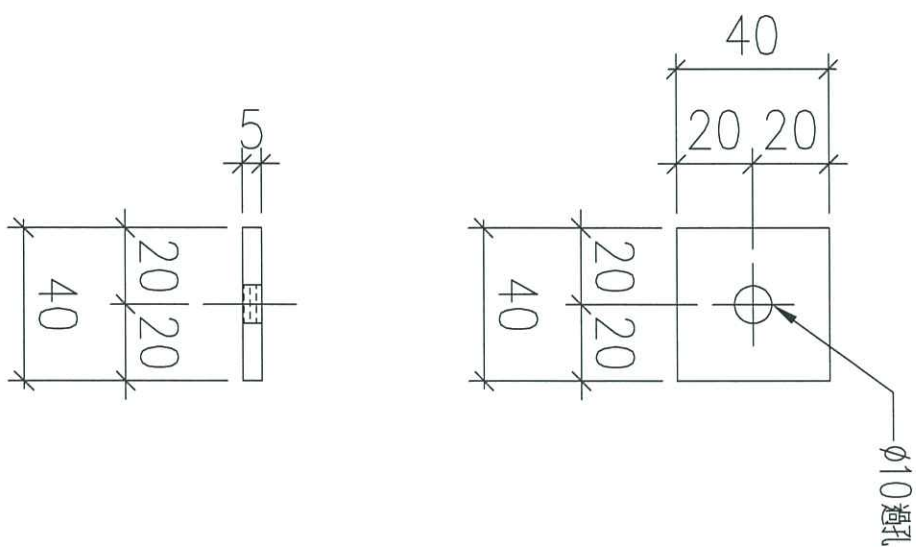

序號	物料編號	數量	使用位置	樓層
01	BK-B102	1000	UN-B101~B111	

新增圖


名稱	鐵碼加工圖	制圖	LHR	2021.03.03	修改			
材料	40x40x5mm厚鐵巴(S275)	復核	-	-	日期			
顏色	熱浸鋅	批准			圖號	J852-ACA-BK-B102		

DRAWING REGISTER

			接收日期 Receiving Date (適用於客戶圖則)								
工程名稱 Project Title:	亞畢老街	年									
	大樓鋁柵格地盤用鐵料加工圖	月									
工程編號 Project No:	J-852	日									
分發予 Distributed To			發出日期 Issued Date								
		年	20	21							
		月	12	07							
		日	22	23							
圖則編號 Drg. No.	圖則名稱 Drawing Title		修訂編號 Revision No.								
J852-ACA-MSA-B002	鐵角加工圖	27	-	A							
J852-ACA-MSA-B003	鐵角加工圖	28	-	A							
J852-ACA-MSA-B004	鐵角加工圖	29	-	A							
J852-ACA-MSA-B011	鐵角加工圖	30	-								
J852-ACA-MSA-B012	鐵角加工圖	31	-								
J852-ACA-MSA-B013	鐵角加工圖	32	-								
J852-ACA-MSA-B014	鐵角加工圖	33	-								
J852-ACA-MSA-B021	鐵角加工圖	34	-	A							
J852-ACA-MSA-B022	鐵角加工圖	35	-	A							
J852-ACA-MSA-B023	鐵角加工圖	36	-	A							
J852-ACA-MSA-B024	鐵角加工圖	37	-	A							
J852-ACA-MSA-B031	鐵角加工圖	38	-								
J852-ACA-MSA-B032	鐵角加工圖	39	-								
J852-ACA-MSA-B085	鐵角加工圖	40	-								
J852-ACA-MSA-B086	鐵角加工圖	41	-								
J852-ACA-MSB-B001	鐵板加工圖	42	-								
J852-ACA-UN-B101	鐵件組裝圖	43	-								
J852-ACA-UN-B102	鐵件組裝圖	44	-								
J852-ACA-UN-B103	鐵件組裝圖	45	-	A							
J852-ACA-UN-B104	鐵件組裝圖	46	-								
J852-ACA-UN-B105	鐵件組裝圖	47	-								
J852-ACA-UN-B106	鐵件組裝圖	48	-								
J852-ACA-UN-B107	鐵件組裝圖	49	-								
J852-ACA-UN-B108	鐵件組裝圖	50	-								
J852-ACA-UN-B109	鐵件組裝圖	51	-								
J852-ACA-UN-B110	鐵件組裝圖	52	-								

DRAWING REGISTER

[illegible]

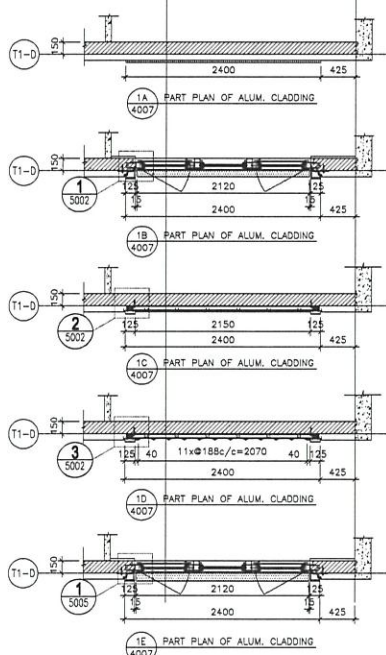

DWG NO. : JB52--SD--ACA--4007	REV.
-------------------------------	------

RD. REF :

CLIENT :

ARCHITECT :

MAIN CONTRACTOR :

STRUCTURAL ENGINEER :

FAÇADE CONSULTANT :

ARUP
MEYERHART

NOTE :
1. DIMENSIONS ARE IN mm.
2. ALL ELEVATIONS ARE VIEWED FROM OUTSIDE.
3. ALL DIMENSIONS TO BE CARRIED ON SITE BEFORE FABRICATION.

LEGEND :

- 1. DETAIL MARK NO.
- 2. DETAIL SHEET NO.
- 3. F.F.L. - FINISHED FLOOR LEVEL
- 4. S.F.L. - STRUCTURE FLOOR LEVEL
- 5. S.F.L. - STRUCTURE DETAIL
- 6. 3.0mm THK. ALUM. CLADDING
- 7. 3.0mm THK. SINTERED ALUM. FIBROBOARD PANEL

JOB NO. : J-852	
PROJECT : PROPOSED RESIDENTIAL DEVELOPMENT	
SITE : 147 MOON STREET, NKL 6005, 6035 R.P., 6036 R.P., 6037 R.P. & 6038 R.P.	
TITLE : PART ELEVATION, PLAN & SECTION OF ALUM. CLADDING FOR W7/T2A (2/F-18/F)	
DATE : 12-MAY-20	SCALE : 1:60
DRAWN BY : JHR	CHECKED BY : JHW
DATE : 24-SEP-2020	REVISION SUBJECT TO MCH. CHANGE
NO.	REV.

17/F +78.85
16/F +73.62
15/F +70.39
12/F +67.16
11/F +63.93
10/F +60.70
9/F +57.47
8/F +54.24
7/F +51.01
6/F +47.78
5/F +44.55
3/F +41.32

19/F +83.31
18/F +80.06

2/F +38.09

2 STEEL MEMBER CONNECTION OF ALUM. CLADDING FOR W7/T2A (2/F-18/F)

1 PARTIAL ELEVATION OF ALUM. CLADDING FOR W7/T2A (2/F-18/F)

X SECTION

Y SECTION

1A PART PLAN OF ALUM. CLADDING

1B PART PLAN OF ALUM. CLADDING

1C PART PLAN OF ALUM. CLADDING

1D PART PLAN OF ALUM. CLADDING

1A PART PLAN OF ALUM. CLADDING

2 STEEL MEMBER CONNECTION OF ALUM. CLADDING FOR W7/T2A (2/F-18/F)

1 PARTIAL ELEVATION OF ALUM. CLADDING FOR W7/T2A (2/F-18/F)

X SECTION

Y SECTION

1A PART PLAN OF ALUM. CLADDING

1B PART PLAN OF ALUM. CLADDING

1C PART PLAN OF ALUM. CLADDING

1D PART PLAN OF ALUM. CLADDING

1A PART PLAN OF ALUM. CLADDING

B.O. REF :

CLIENT :

ARCHITECT :
AEC
REGISTERED
STRUCTURAL ENGINEER
MAIN CONTRACTOR :

STRUCTURAL ENGINEER :
Gammone
REGISTERED
STRUCTURAL ENGINEER
FACILE CONSULTANT:
ARUP
MEYERHARDT


NOTE :
1. DIMENSIONS ARE IN mm.
2. ALL DIMENSIONS ARE GIVEN FROM OUTSIDE.
3. ALL DIMENSIONS TO BE VERIFIED ON SITE BEFORE FABRICATION.

LEGEND :
21 DETAIL MARK NO.
1000 DETAIL SHEET NO.
1. F.F.L. - FINISHED FLOOR LEVEL
2. S.F.L. - STRUCTURAL FLOOR LEVEL
3. (R) - REINFORCED DETAIL
4. 3.0mm THK. ALUM. CLADDING
5. 6.25mm THK. STRENGTHENED ALUM. REINFORCED PANEL

PROJECT :
PROPOSED RESIDENTIAL DEVELOPMENT
MIL 6005 6035 R.P. 6036 R.P.
MIL 6037 R.P. & 6038 R.P.
TITLE :
PART ELEVATION, PLAN & SECTION OF
ALUM. CLADDING
FOR W7/73B (2/F-18/F)

DATE : 12-MAY-20
SCALE : 1:50
DRAWN BY : LHR
CHECKED BY : DW

DESIGNED BY : LHR
DRAWN BY : LHR
CHECKED BY : DW
DATE : 12-MAY-20
SCALE : 1:50
PROJECT :
PROPOSED RESIDENTIAL DEVELOPMENT
MIL 6005 6035 R.P. 6036 R.P.
MIL 6037 R.P. & 6038 R.P.
TITLE :
PART ELEVATION, PLAN & SECTION OF
ALUM. CLADDING
FOR W7/73B (2/F-18/F)

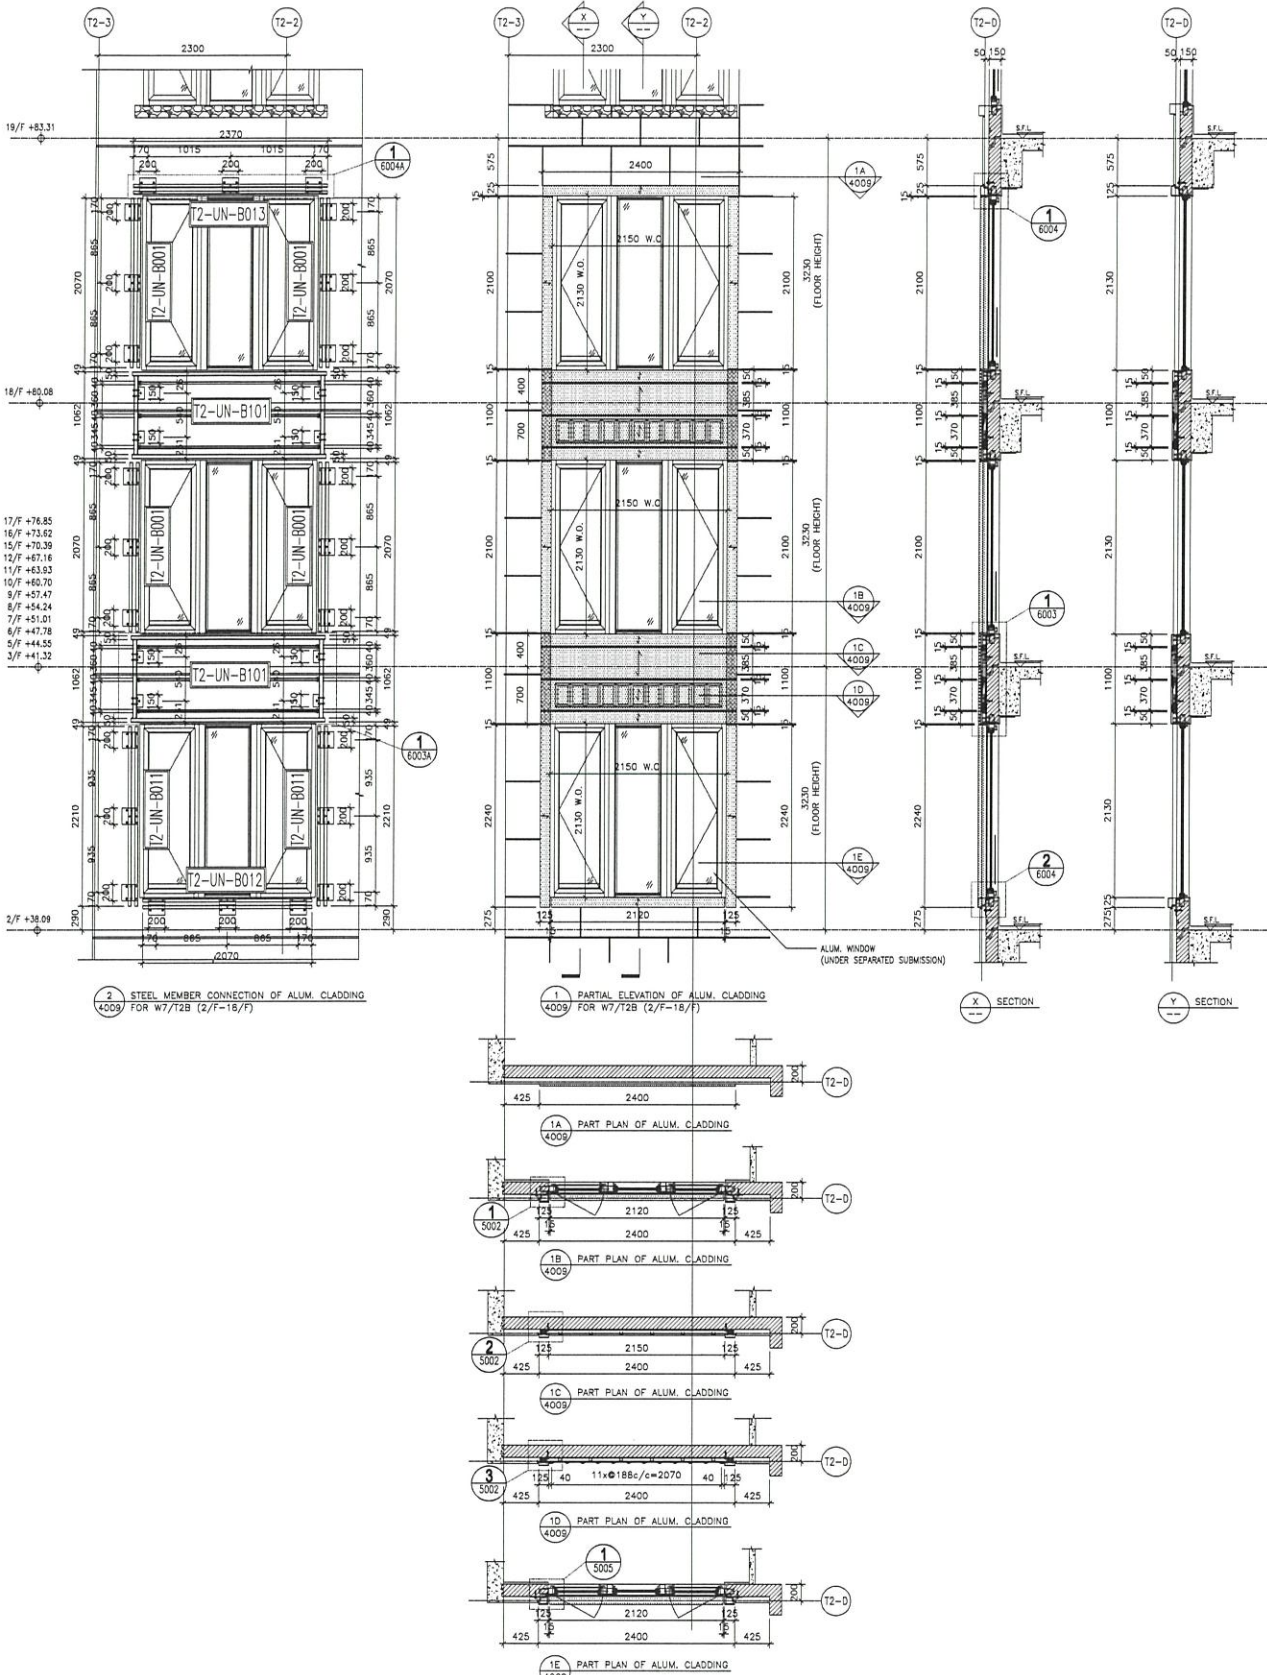

B.O. REF. :

CLIENT :

ARCHITECT :

MAIN CONSULTANT :

STRUCTURAL ENGINEER :

FAÇADE CONSULTANT :

ARUP
MENHARDT

NOTE :

1. ALL DIMENSIONS ARE IN mm.
2. ALL ELEVATIONS ARE VIEWED FROM OUTSIDE.
3. ALL DIMENSIONS TO BE VERIFIED ON SITE BEFORE FABRICATION.

LEGEND :

1. F.F.L. — FINISHED FLOOR LEVEL
2. S.F.L. — STRUCTURAL FLOOR LEVEL
3. — REVERSED DETAIL
4. 3.0mm THK. ALUM. CLADDING
5. 6037 R.P. & 6038 R.P. PERFORATED PANEL

DATE :

12-MAY-20

SCALE :

1:60

TITLE :

PART ELEVATION, PLAN & SECTION OF
ALUM. CLADDING
FOR W9/T1A (2/F-18/F)

DATE :

12-MAY-20

CHECKED BY :

TW

DOWN BY :


LHR


CHECKED BY :

TW


UNIT 6-8, SINOY INDUSTRIAL CENTRE, 1/F
610 CHIA HOE LING ROAD, KODEN
TEL: 63492211-4 FAX: 6352727665

DATE NO. : JBS2-SO-ACA-4011 REV. : C

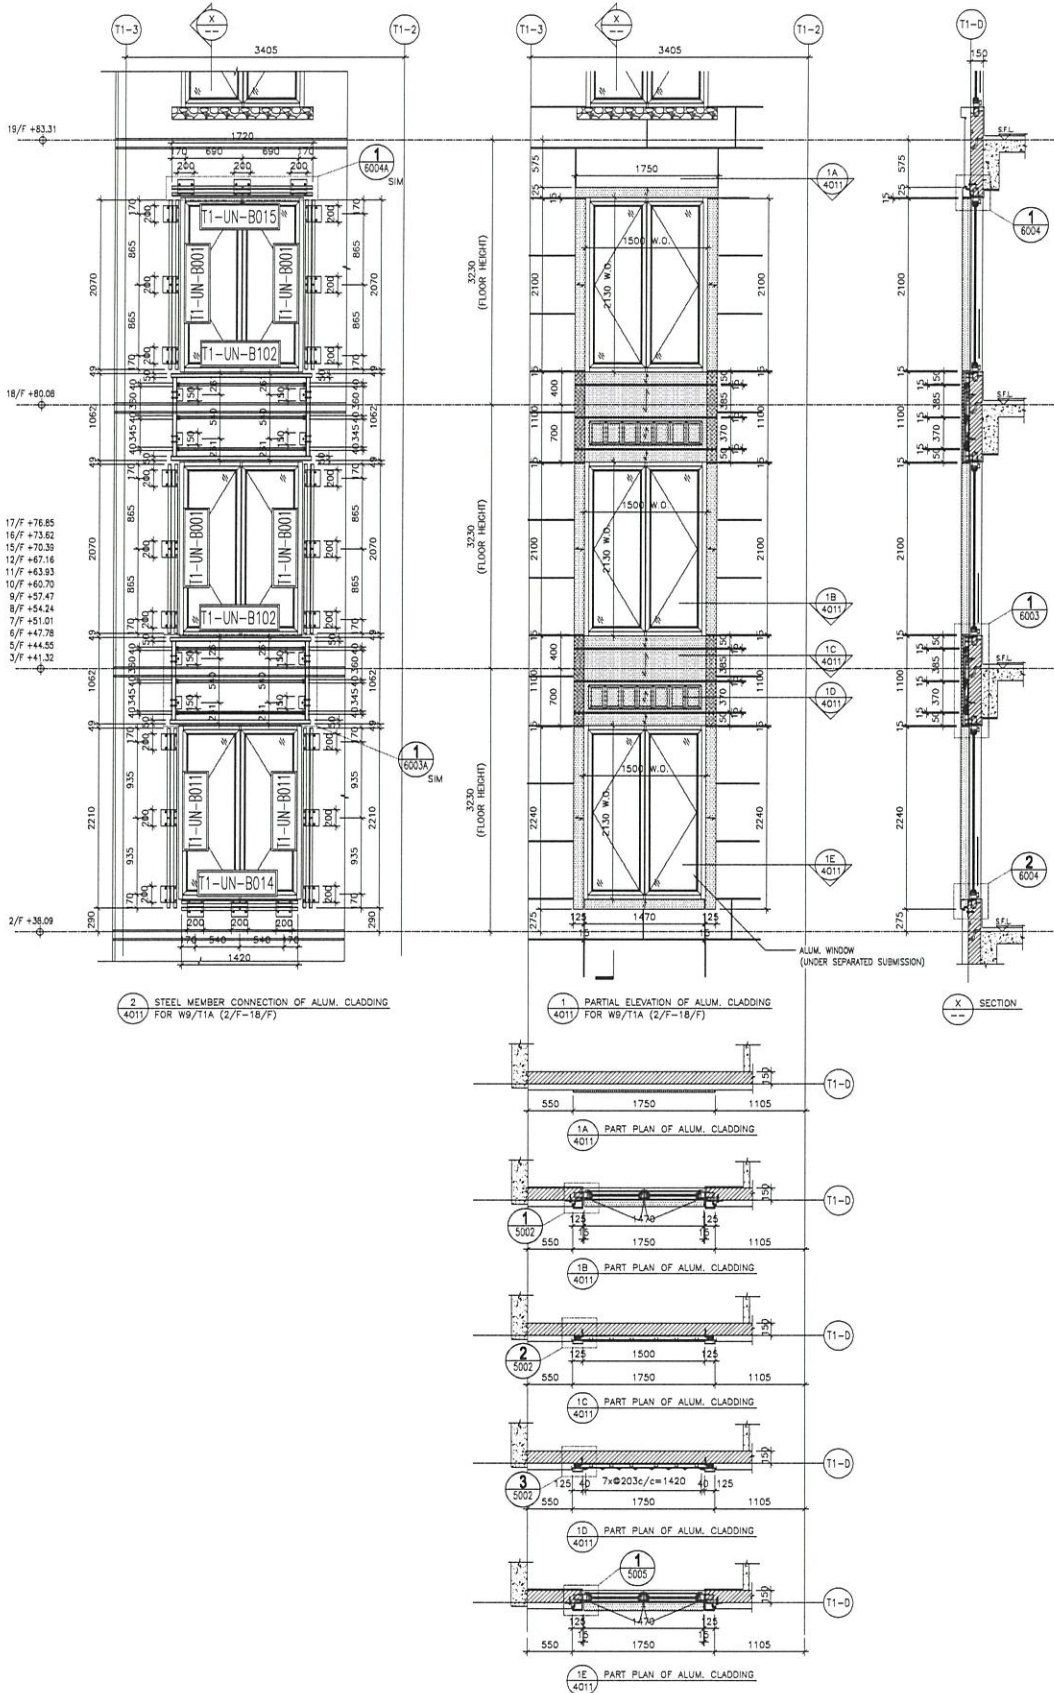

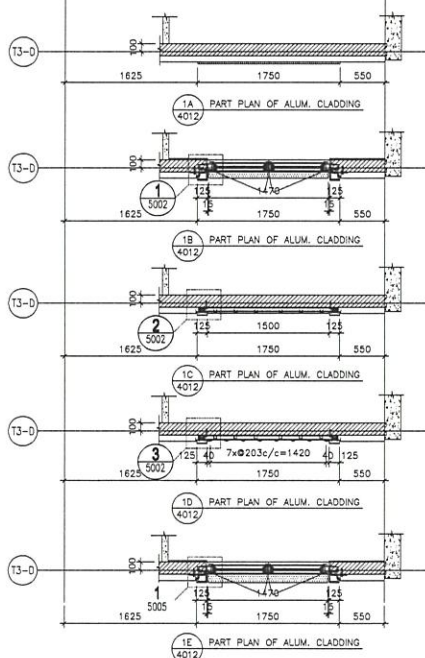


DWG NO. : JB52-SD-ACA-4012	REV. : C
----------------------------	----------

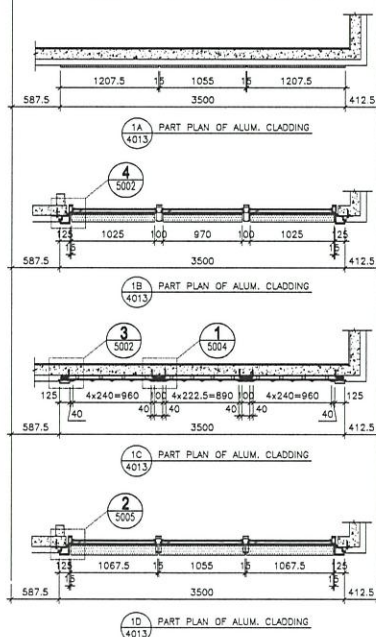

C	A	E
1-12-2000	1-12-2000	1-12-2000
REVIEW SCHEDULED IN REEL CLOSING	REVIEW SCHEDULED IN REEL CLOSING	REVIEW SCHEDULED IN REEL CLOSING
DATE	DATE	DATE
J-852	J-852	J-852
PROJECT :	PROPOSED RESIDENTIAL DEVELOPMENT AT 139 - 147 ARCADE STREET, NNL 6005, 6035 R.P., 6036 R.P., 6037 R.P. & 6038 R.P.	
TITLE :	PART ELEVATION, PLAN & SECTION OF ALUM. CLADDING FOR T1 A/C PLANT ROOM LLC (2/F)-18/17)	
DATE : 12-MAY-20	SCALE : 1:60	
DRAWN BY : LHM	CHECKED BY : DMV	
 M&T ENGINEERING & PLANNING LTD. Units G-8, Suway Industrial Centre, 6110 Choo Mei Ling Road, Kowloon TEL: (852) 2411-7777 FAX: (852) 2411-7766 E-MAIL: info@metplanning.com.hk		
DWG NO.: JBSJ-92-PK-A-4013		
REV.: C		

[illegible]

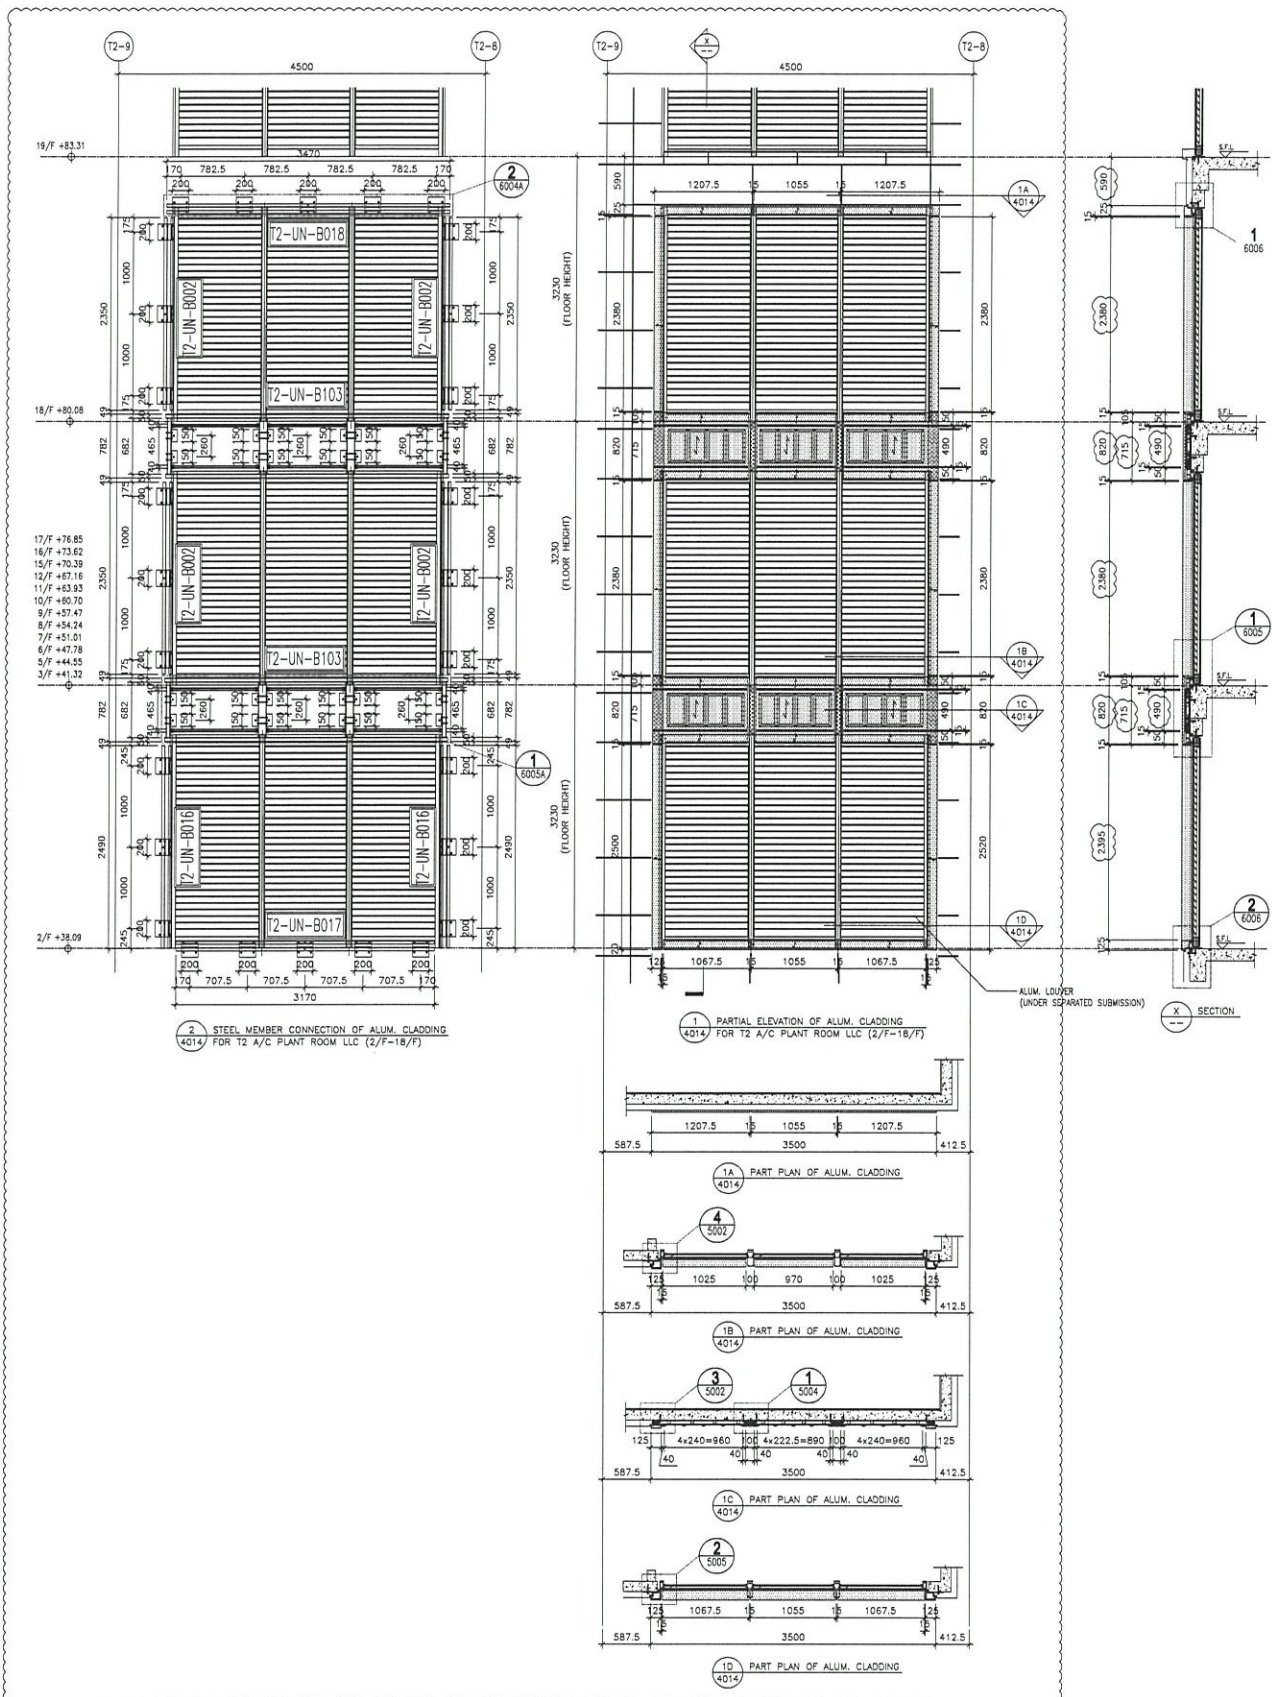

B.O. REF. :

CLIENT :

ARCHITECT :

MAIN CONTRACTOR :

STRUCTURAL ENGINEER :

FAÇADE CONSULTANT :



- NOTE :
1. ALL DIMENSIONS ARE IN mm.
 2. ALL DIMENSIONS ARE TO BE VERIFIED ON SITE BEFORE FABRICATION.
 3. ALL DIMENSIONS TO BE VERIFIED ON SITE BEFORE FABRICATION.

LEGEND :

1. F.F.L. --- FINISHED FLOOR LEVEL.
2. S.F.L. --- STRUCTURAL FLOOR LEVEL.
3. --- REINFORCED CONCRETE.
4. --- 3.0mm THK. ALUM. CLADDING.
5. --- 5.0mm THK. STITCHED ALUM. REINFORCED PANEL.

NO.	DATE	REVISION
1	1-11-2020	REVISION SUBMITTED TO MAIN CONTRACTOR
2	21-09-2020	REVISION SUBMITTED TO MAIN CONTRACTOR
3		REVISION

PROJECT :
 PROPOSED RESIDENTIAL DEVELOPMENT
 AT 138 - 147 ARBOTE STREET
 HKL 6005, 6035 R.P., 6036 R.P.,
 6037 R.P. & 6038 R.P.

TITLE :
 ALUM. CLADDING
 FOR T2 A/C PLANT ROOM LLC
 (2/F-18/F)


DATE : 12-MAY-20
 SCALE : 1:60

DRAWN BY : LHR
 CHECKED BY : DW

UNITED STATES OF AMERICA
 610 Cheong Cheong Road, #04-01
 Tel: 65072711-4 Fax: 65072711-6


UNITED STATES OF AMERICA
 610 Cheong Cheong Road, #04-01
 Tel: 65072711-4 Fax: 65072711-6

UNITED STATES OF AMERICA
 610 Cheong Cheong Road, #04-01
 Tel: 65072711-4 Fax: 65072711-6

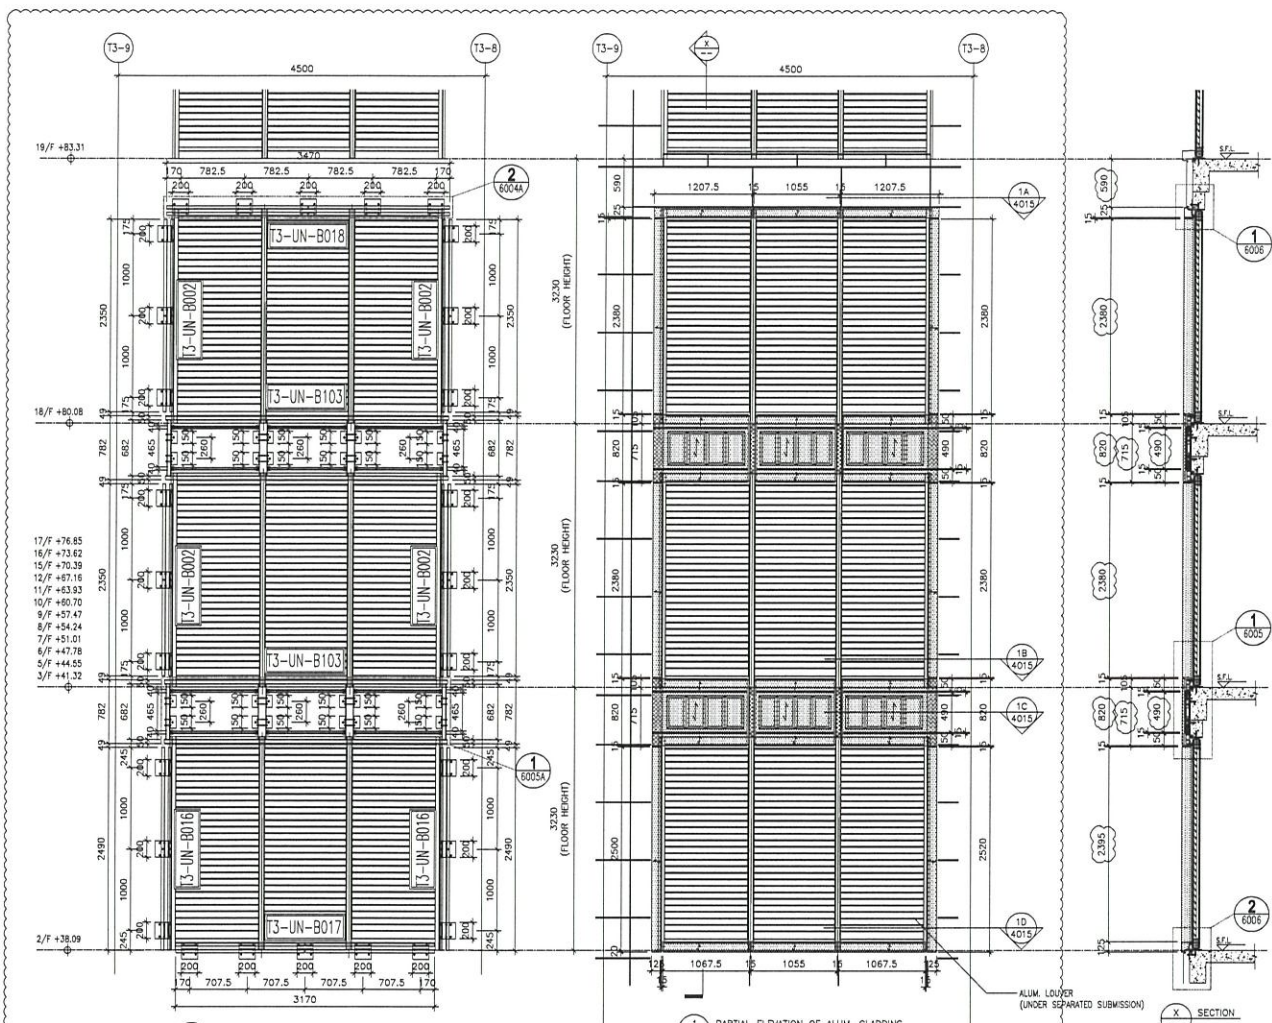

2 STEEL MEMBER CONNECTION OF ALUM. CLADDING 4015 FOR T3 A/C PLANT ROOM LLC (2/F-18/F)

1 PARTIAL ELEVATION OF ALUM. CLADDING 4015 FOR T3 A/C PLANT ROOM LLC (2/F-18/F)

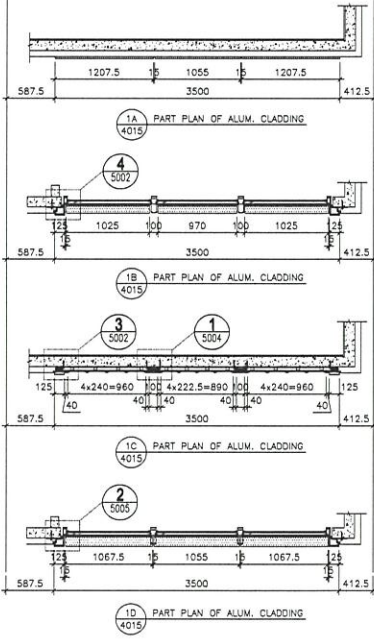

NOTE:
1. ALL DIMENSIONS ARE IN MM.
2. ALL ELEVATIONS ARE VIEWED FROM OUTSIDE.
3. ALL DIMENSIONS TO BE VERIFIED ON SITE BEFORE FABRICATION.

LEGEND:
1. DETAIL MARK NO.
2. DETAIL SHEET NO.

1. F.F.L. — FINISHED FLOOR LEVEL.
2. S.F.L. — STRUCTURAL FLOOR LEVEL.
3. — REVERSED DETAIL.
4. 3mm THK. ALUM. CLADDING.
5. 6035 R.P. & 6038 R.P. PERFORATED PANEL.

PROJECT: RESIDENTIAL DEVELOPMENT
PROJECT NO.: J-852
DATE: 24-09-2020
REVISION: 1
REVISION SUBJECT: REVISION 1

DATE: 12-MAY-20
SCALE: 1:50
CHECKED BY: DW
DRAWN BY: LHR

TITLE: PART ELEVATION, PLAN & SECTION OF ALUM. CLADDING FOR T3 A/C PLANT ROOM LLC (2/F-18/F)

PROJECT: RESIDENTIAL DEVELOPMENT
PROJECT NO.: J-852
DATE: 24-09-2020
REVISION: 1
REVISION SUBJECT: REVISION 1

DATE: 12-MAY-20
SCALE: 1:50
CHECKED BY: DW
DRAWN BY: LHR

TITLE: PART ELEVATION, PLAN & SECTION OF ALUM. CLADDING FOR T3 A/C PLANT ROOM LLC (2/F-18/F)

PROJECT: RESIDENTIAL DEVELOPMENT
PROJECT NO.: J-852
DATE: 24-09-2020
REVISION: 1
REVISION SUBJECT: REVISION 1



DATE: 12-MAY-20
SCALE: 1:50
CHECKED BY: DW
DRAWN BY: LHR

TITLE: PART ELEVATION, PLAN & SECTION OF ALUM. CLADDING FOR T3 A/C PLANT ROOM LLC (2/F-18/F)

PROJECT: RESIDENTIAL DEVELOPMENT
PROJECT NO.: J-852
DATE: 24-09-2020
REVISION: 1
REVISION SUBJECT: REVISION 1

DATE: 12-MAY-20
SCALE: 1:50
CHECKED BY: DW
DRAWN BY: LHR

TITLE: PART ELEVATION, PLAN & SECTION OF ALUM. CLADDING FOR T3 A/C PLANT ROOM LLC (2/F-18/F)

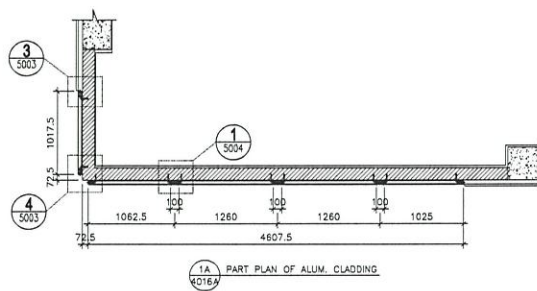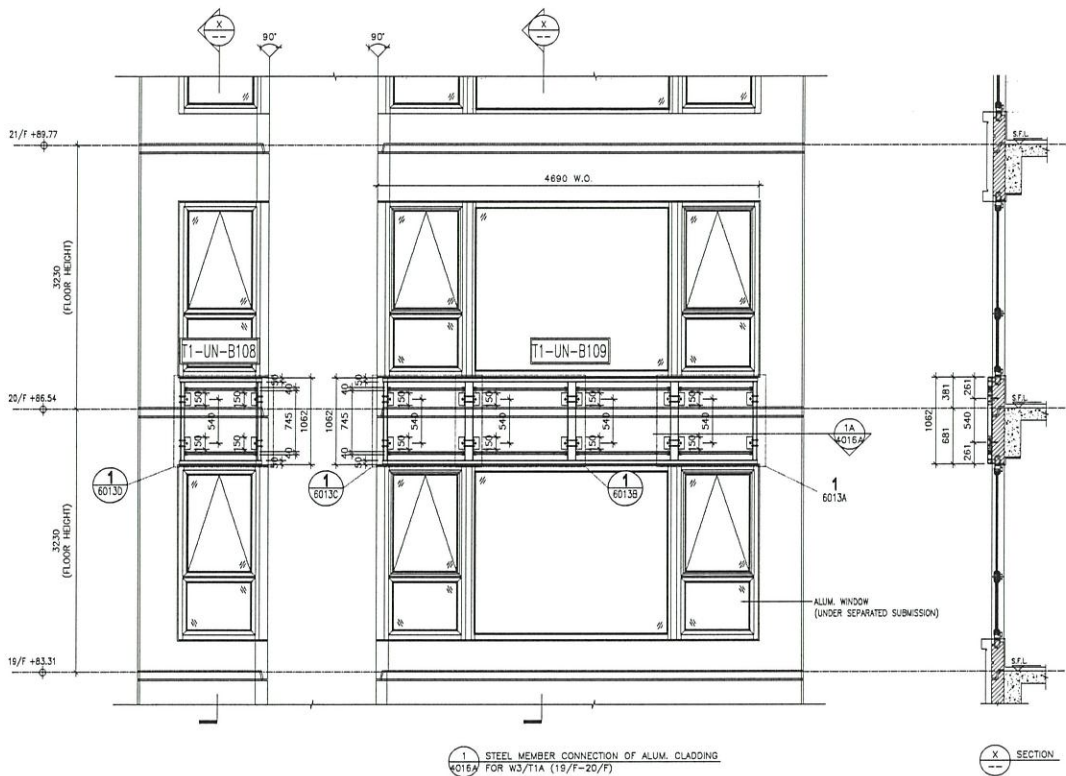

REA. REF :

CLIENT :

ARCHITECT :

MAIN CONSULTANT :

STRUCTURAL ENGINEER :

FACE CONSULTANT :

Gammon
ARUP
MEINHARDT

NOTE:
1. ALL DIMENSIONS ARE IN mm.
2. ALL ELEVATIONS ARE VIEWED FROM OUTSIDE.
3. ALL DIMENSIONS TO BE CHECKED ON SITE BEFORE FABRICATION.

LEGEND :

1. F.F.L. --- FINISHED FLOOR LEVEL
2. S.F.L. --- STRUCTURAL FLOOR LEVEL
3. --- REVERSED DETAIL

NO.	DATE	REVISION	BY
1	2020-12-01	1	JH

JOB NO. : J-852

PROJECT : PROPOSED RESIDENTIAL DEVELOPMENT
AT 139 - 147 ARCADE STREET,
NDL 6005, 6035 R.P., 6036 R.P.,
6037 R.P. & 6038 R.P.

TITLE : PART ELEVATION, PLAN & SECTION OF
STEEL MEMBER CONNECTION
FOR W3/T1A (19/F-20/F)

DATE : 1-DEC-20


SCALE : 1:60

DRAWN BY : LHS

CHECKED BY : JHW

MDI
MID-DEVELOPMENT INTERNATIONAL LTD.
Unit 6-8, Sunny Industrial Centre, 1/F
610 Cho Kwo Ling Road, Kowloon
Tel: (852) 2777-7666

DWG NO. : J852-SD-ACA-4016A REV. : C

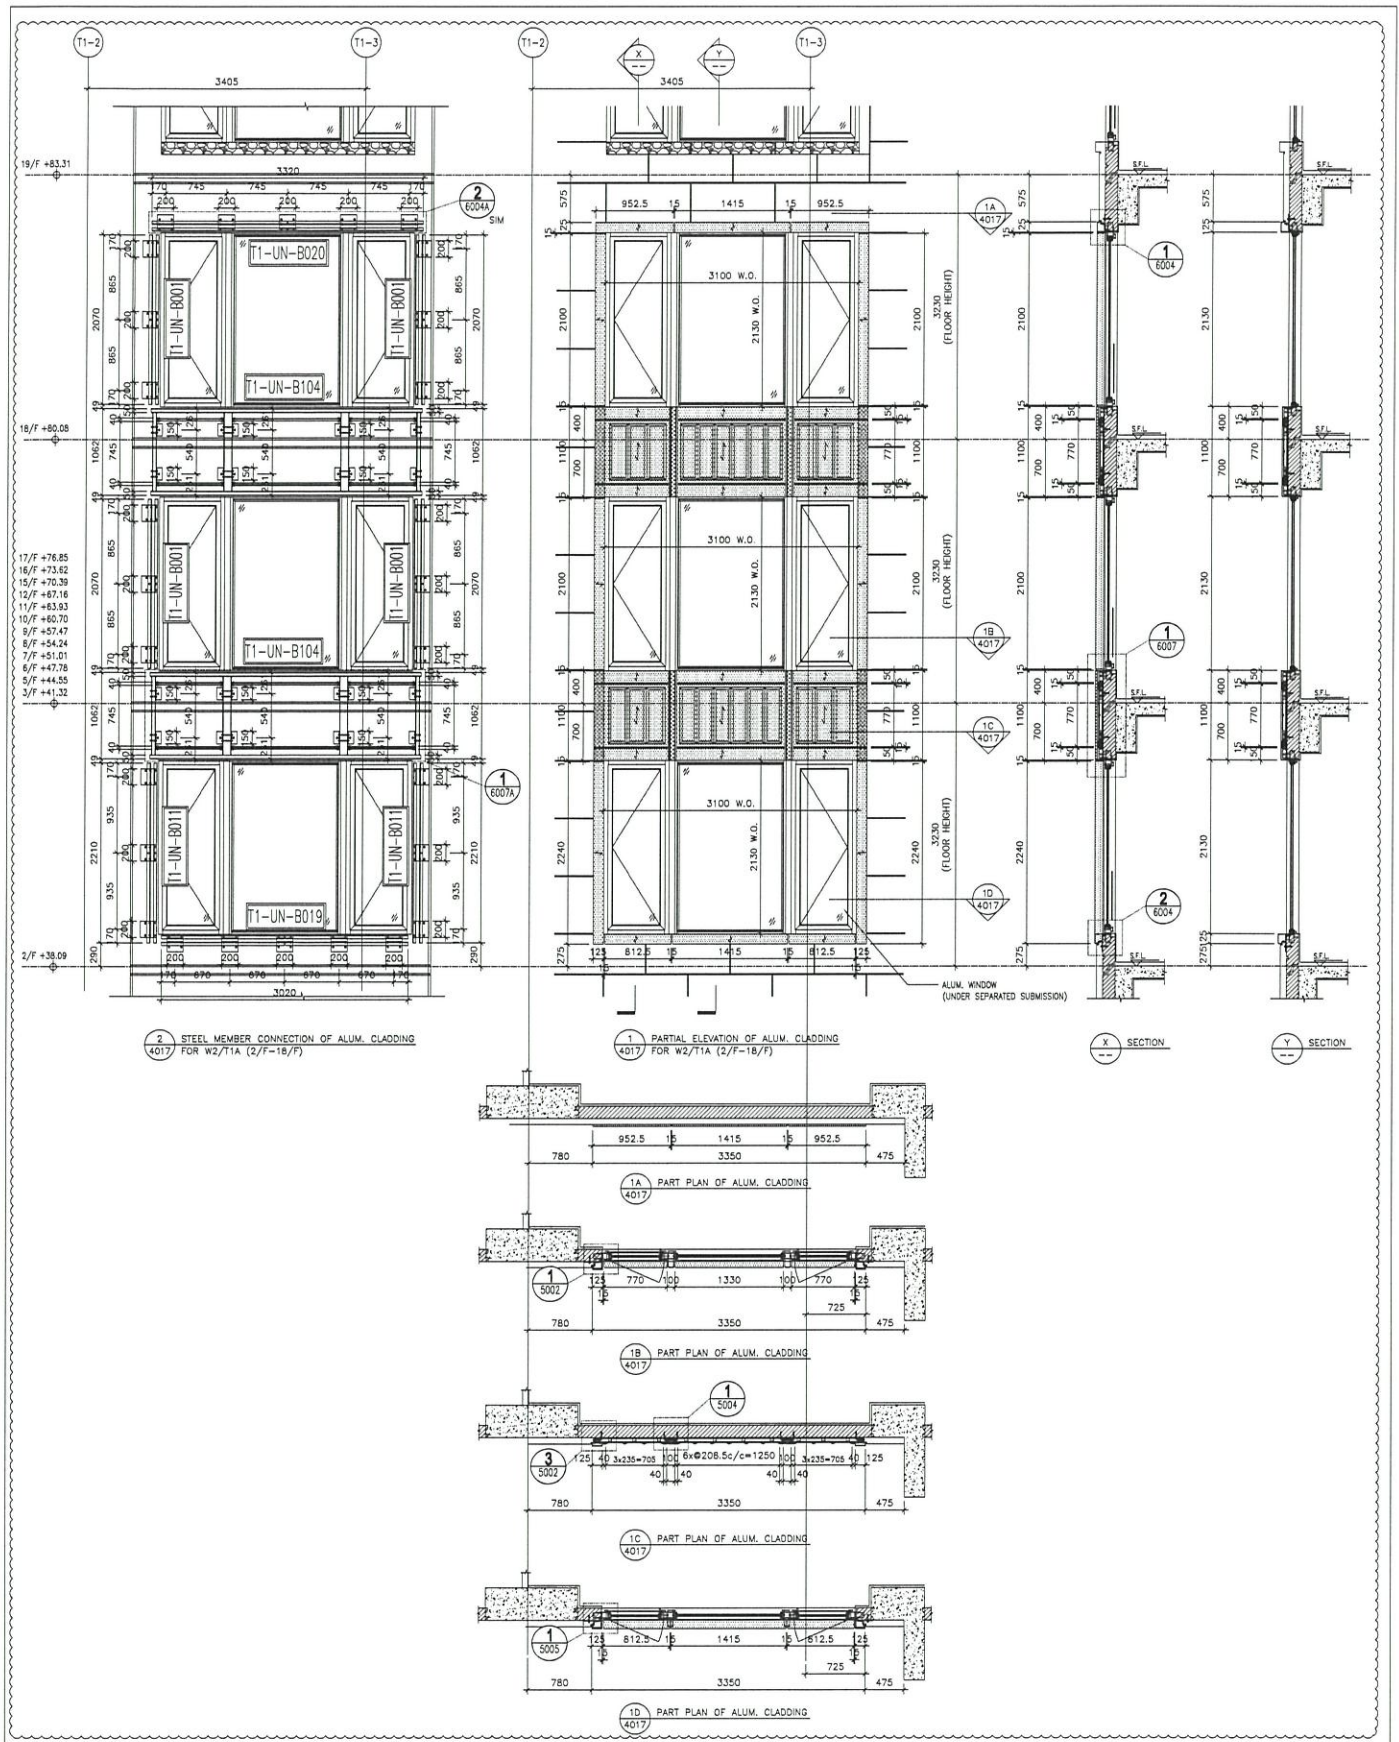

REVISIONS

NO.	DATE	REVISION	BY	CHK
1	11-11-2020	REVISION SUBMITTED TO ARCHITECT	W	
2	12-03-2020	REVISION SUBMITTED TO ARCHITECT	W	

PROJECT INFORMATION

PROJECT: PROPOSED RESIDENTIAL DEVELOPMENT
 139-141 ADELPHI STREET
 MKL 6005, 6035 R.P., 6036 R.P.,
 6037 R.P. & 6038 R.P.

TITLE:
 PART ELEVATION, PLAN & SECTION OF
 ALUM. CLADDING
 FOR W2/T1A (2/F-18/F)

DATE: 12-MAY-20 **SCALE:** 1:60

DRAWN BY: JHR **CHECKED BY:** JMW

DESIGNER: 美特铝业有限公司
 11013 美特铝业有限公司
 11013 美特铝业有限公司
 610 Ono Yee Road, Kowloon
 Tel: (852) 27777866

DMC NO.: J-852

NOTES:

1. DIMENSIONS ARE IN MM.
2. ALL ELEVATIONS ARE VIEWED FROM OUTSIDE.
3. ALL DIMENSIONS ARE TO BE VERIFIED ON SITE BEFORE FABRICATION.

LEGEND:

- 1. F.F.L. --- FINISHED FLOOR LEVEL
- 2. S.F.L. --- STRUCTURAL FLOOR LEVEL
- 3. 2. --- EXPOSED BEAM
- 4. 3. --- 3.0mm THK ALUM. CLADDING
- 5. 5. --- 5.0mm THK STITCHED ALUM. REINFORCED PANEL


ARCHITECT:
 AEC
 11013 美特铝业有限公司

STRUCTURAL ENGINEER:
 Gammon

FAÇADE CONSULTANT:
 ARUP
 MEINWART

CLIENT:

B.O. REF.:

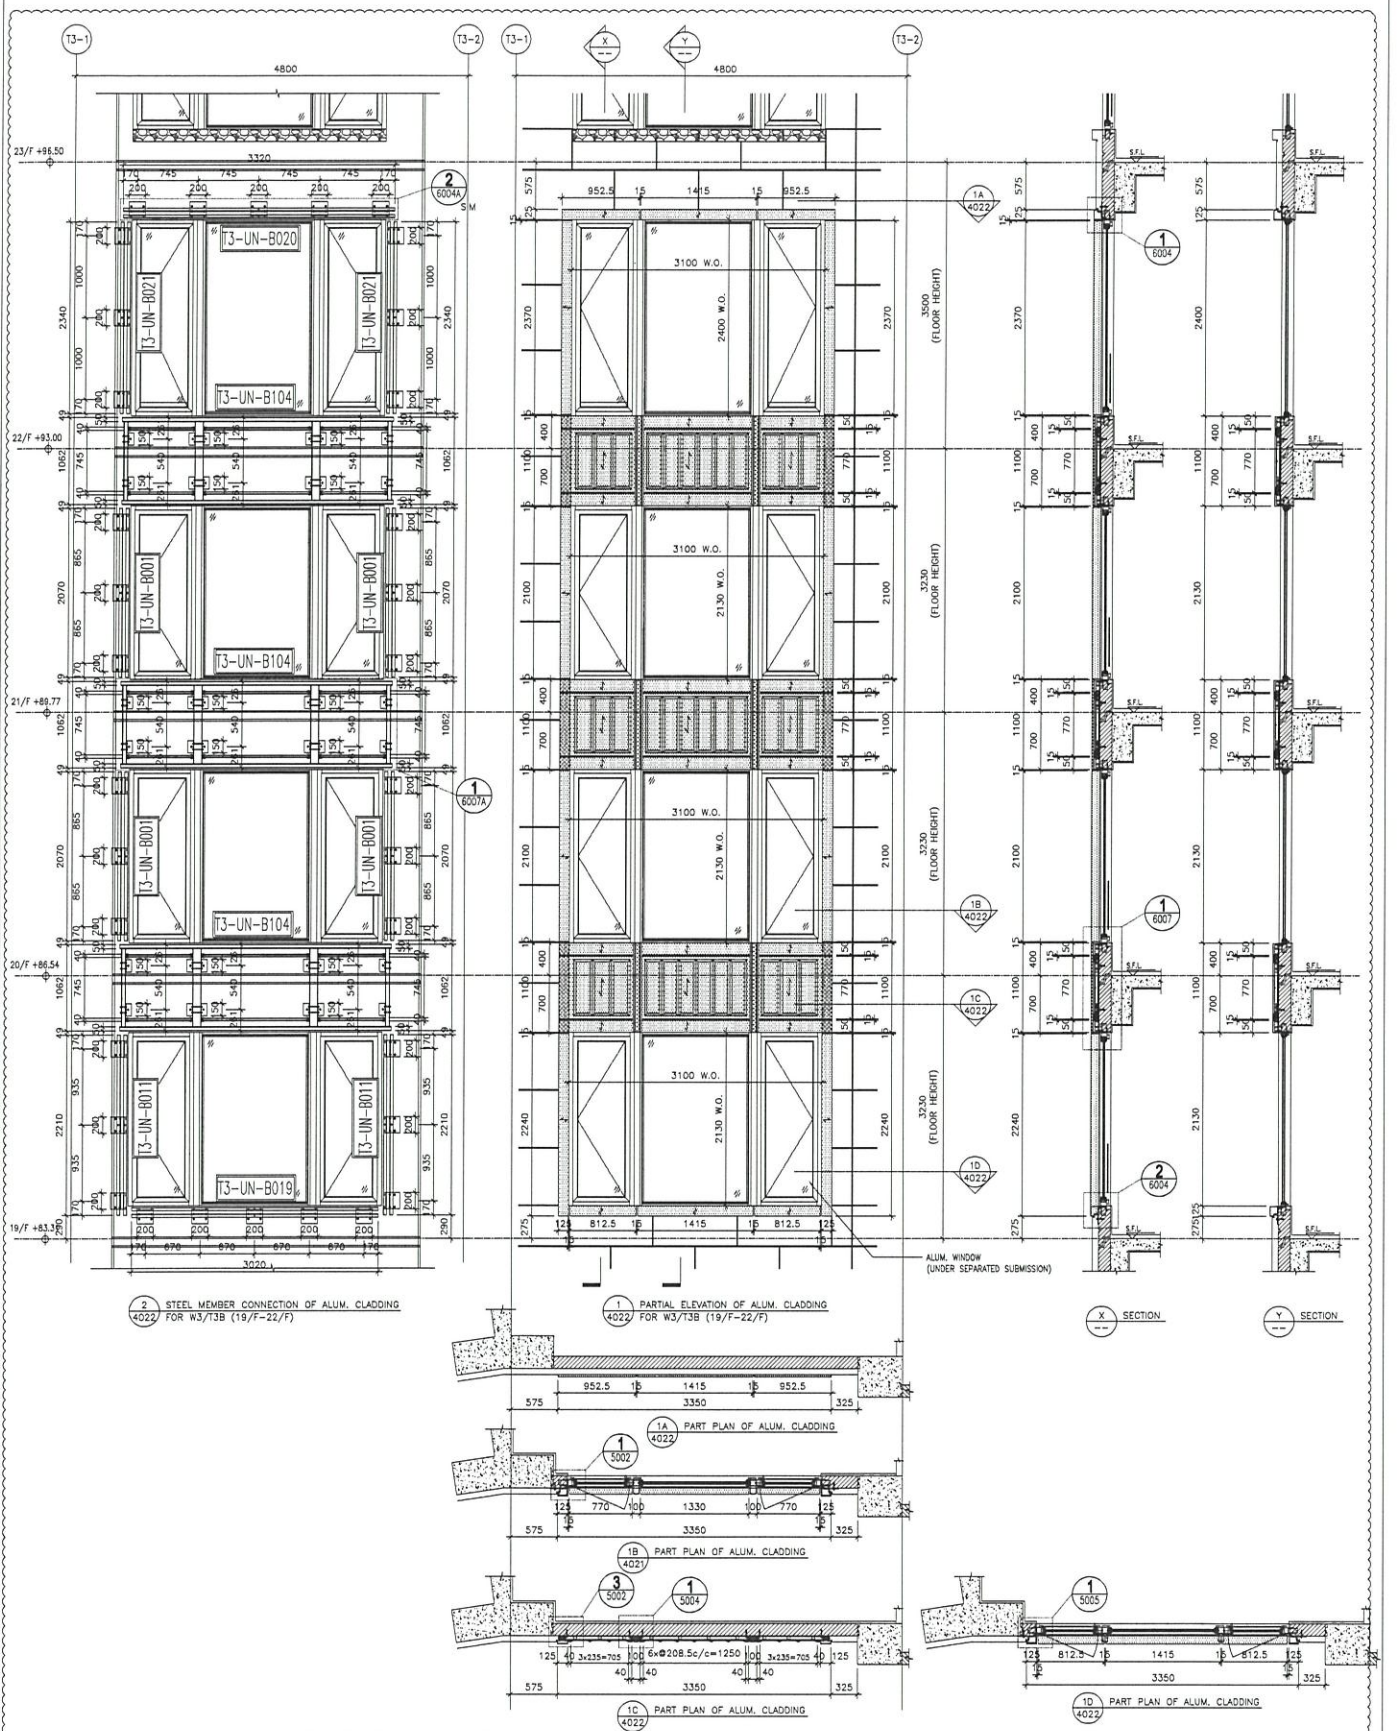

CLIENT :

ARCHITECT :

MAIN CONTRACTOR :

STRUCTURAL ENGINEER :

FAÇADE CONSULTANT :

MEINHARDT

NOTE :

- ALL DIMENSIONS ARE IN mm.
- ALL ELEVATIONS ARE VIEWED FROM OUTSIDE.
- ALL DIMENSIONS TO BE CHECKED ON SITE BEFORE FABRICATION.

LEGEND :

- 1. F.F.L. - FINISHED FLOOR LEVEL
- 2. S.F.L. - STRUCTURAL FLOOR LEVEL
- 3. S.F.L. - FINISHED FLOOR LEVEL
- 4. 3.0mm THK. ALUM. CLADDING
- 5. 3.0mm THK. STITCHED ALUM. PERFORATED PANEL

REVISIONS :

NO.	DATE	REVISION
1	12-2020	REVISION SUBMITTED TO ARCHITECT
2	24-02-2020	REVISION SUBMITTED TO ARCHITECT

DATE : 12-MAY-20

SCALE : 1:60

PROJECT : PROPOSED RESIDENTIAL DEVELOPMENT AT 139 - 147 MOULE STREET, 6037 R.P. & 6038 R.P.

TITLE : PART ELEVATION, PLAN & SECTION OF ALUM. CLADDING FOR W3/T3B (19/F-22/F)

DESIGNER : J-B52

CHECKED BY : JOW

DATE : 12-MAY-20

SCALE : 1:60

PROJECT : PROPOSED RESIDENTIAL DEVELOPMENT AT 139 - 147 MOULE STREET, 6037 R.P. & 6038 R.P.

TITLE : PART ELEVATION, PLAN & SECTION OF ALUM. CLADDING FOR W3/T3B (19/F-22/F)

DESIGNER : J-B52

CHECKED BY : JOW

DATE : 12-MAY-20

SCALE : 1:60

UNIT : mm

DATE : 12-MAY-20

SCALE : 1:60

PROJECT : PROPOSED RESIDENTIAL DEVELOPMENT AT 139 - 147 MOULE STREET, 6037 R.P. & 6038 R.P.

 
TITLE : PART ELEVATION, PLAN & SECTION OF ALUM. CLADDING FOR W3/T3B (19/F-22/F)

DESIGNER : J-B52


CHECKED BY : JOW

DATE : 12-MAY-20

SCALE : 1:60



	10. Ref :
--	-----------


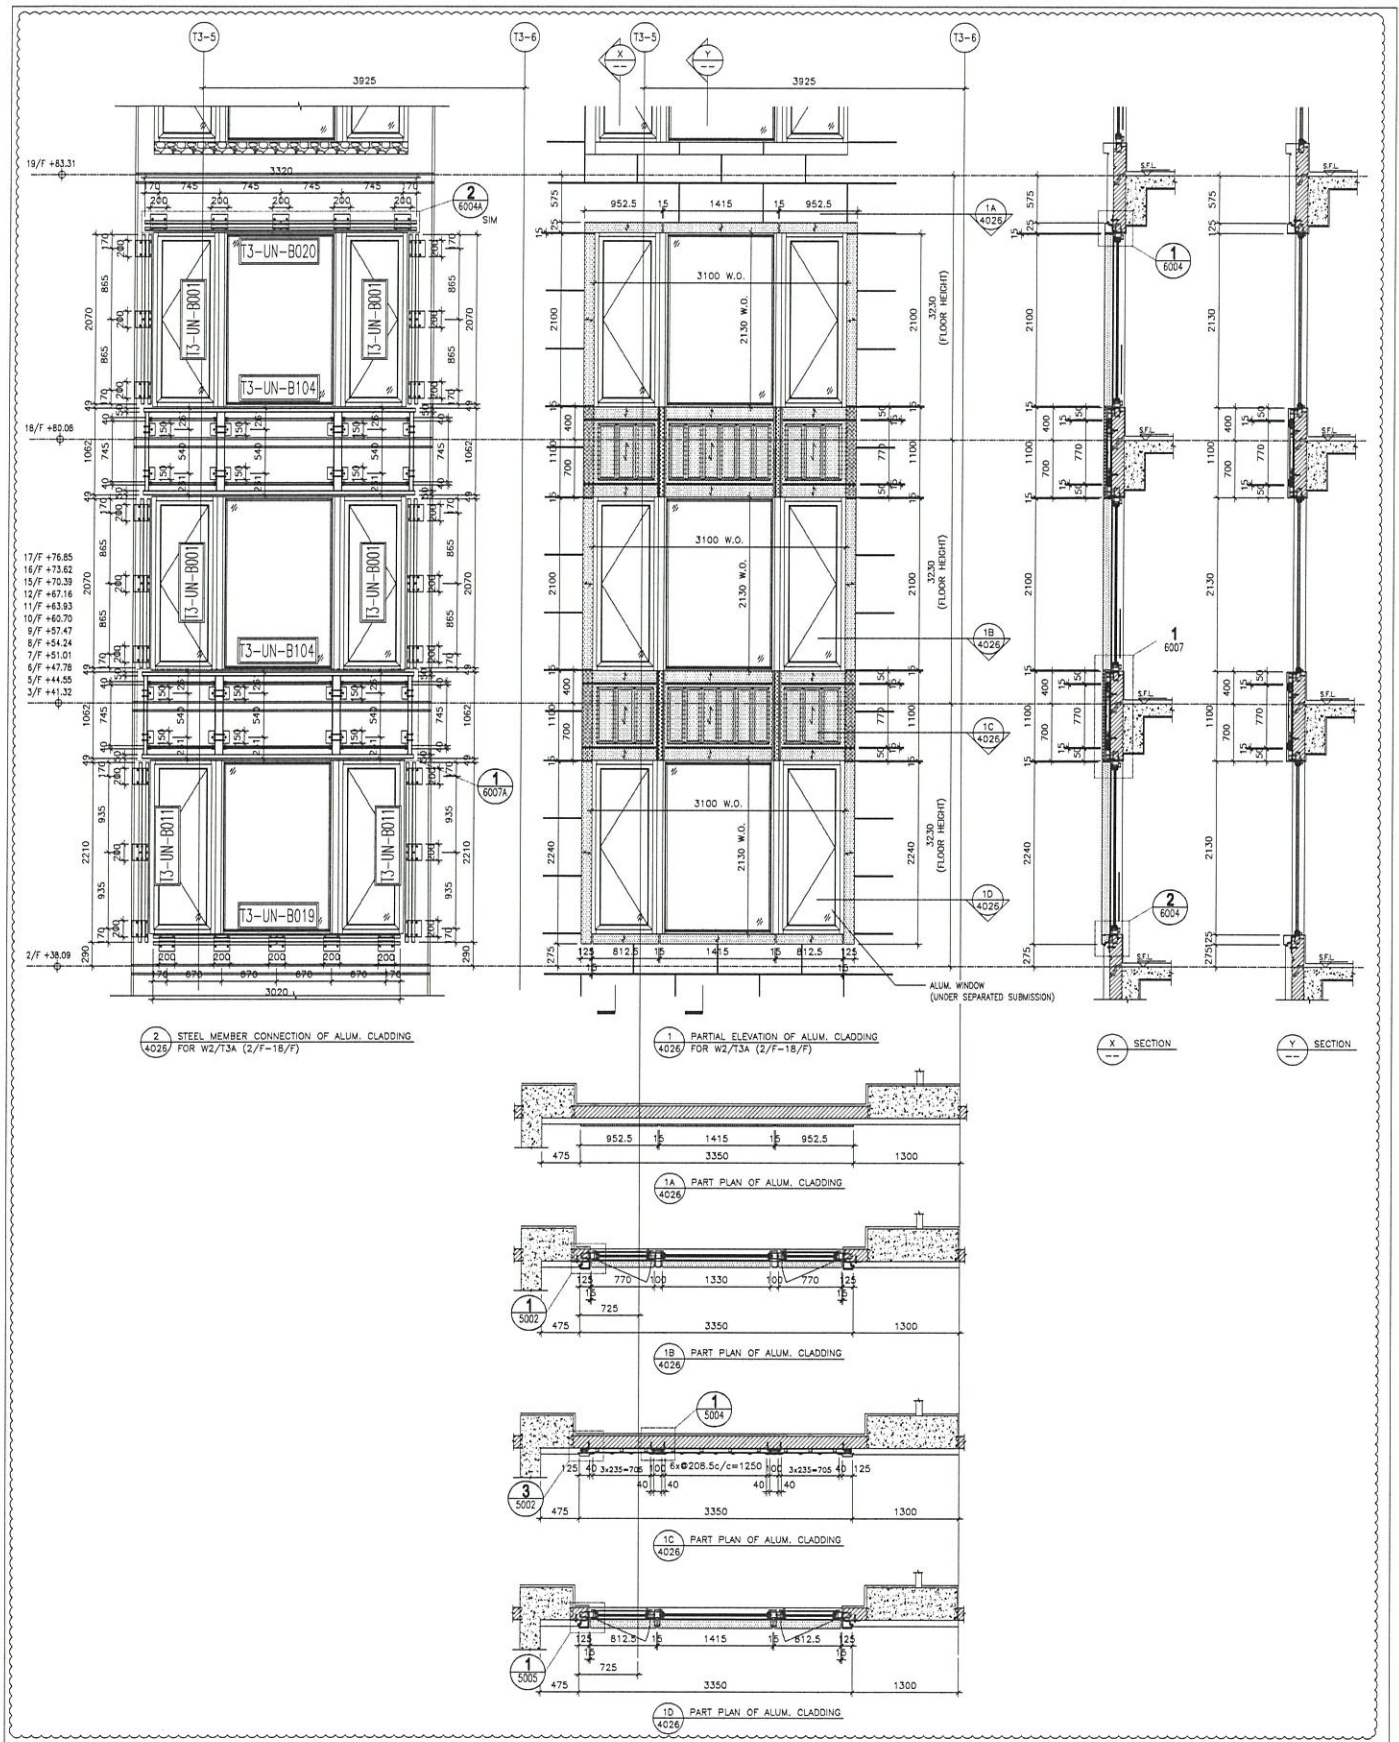


REVISIONS:

NO.	DATE	DESCRIPTION	BY	CHK
1	1-12-2020	REVISION SUBJECT TO ARCH. CHANGE		
2	24-05-2021	REVISION SUBJECT TO ARCH. CHANGE		

DATE: 12-MAY-20
SCALE: 1:60
DRAWN BY: LHR
CHECKED BY: JMW

PROJECT:
PROPOSED RESIDENTIAL DEVELOPMENT
119-121, 123, 125, 127, 4189, 419

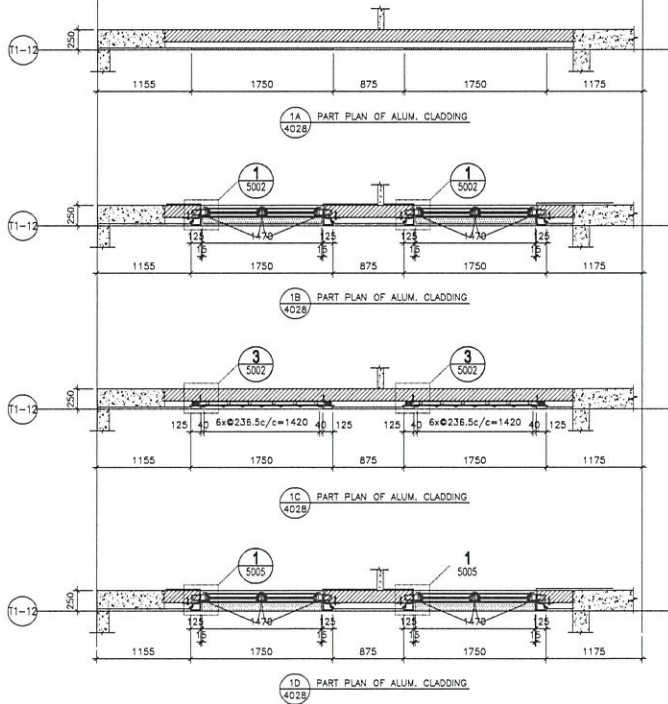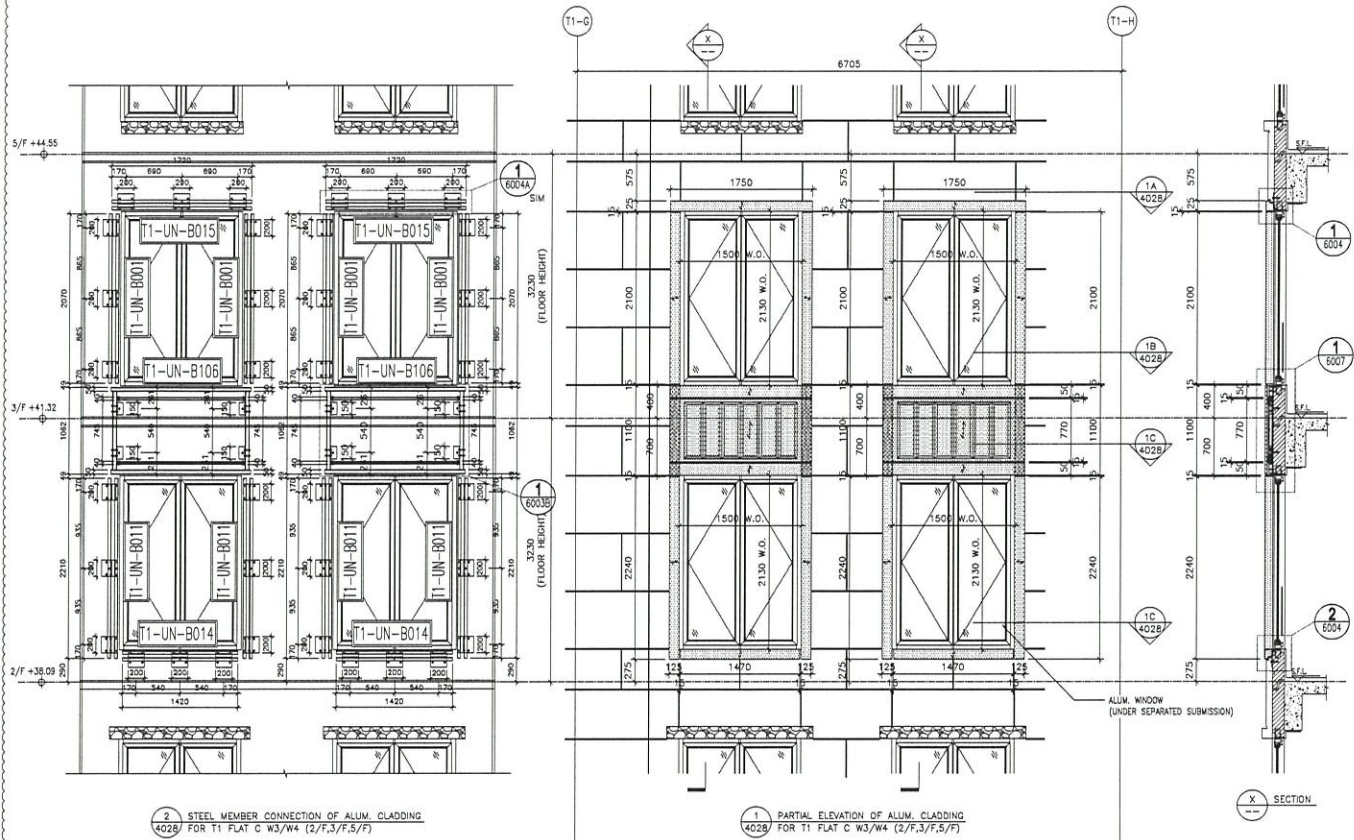

B/L REF :

CLIENT :

ARCHITECT :
AEC
DESIGN LTD
11/F, 118, NANTAN STREET, KOWLOON
HONG KONG

STRUCTURAL ENGINEER :
Gammion
11/F, 118, NANTAN STREET, KOWLOON
HONG KONG

MECHANICAL CONSULTANT :
ARUP
11/F, 118, NANTAN STREET, KOWLOON
HONG KONG

NOTE :
1. DIMENSIONS ARE IN mm.
2. ALL ELEVATIONS ARE VIEWED FROM OUTSIDE.
3. ALL DIMENSIONS TO BE VERIFIED ON SITE.
BEFORE FABRICATION.

LEGEND :
1. DETAIL MARK NO.
2. REFER SHEET NO.
3. F.F.L. -- FINISHED FLOOR LEVEL
4. S.F.L. -- STRUCTURAL FLOOR LEVEL
5. 2. -- REINFORCED BEAM
6. 3. -- 30mm THK ALUM. CLADDING
7. 4. 50mm THK STEEPED ALUM. REINFORCED PANEL

NO.	DATE	REVISION	BY	CHK
1	1-12-2020	ISSUED FOR TOWER 1 FLAT C W3/W4		
2	24-05-2020	REVISION SUBMITTED TO ARCH. CONSULTANT		
3	24-05-2020	REVISION SUBMITTED TO ARCH. CONSULTANT		


PROJECT :
PROPOSED RESIDENTIAL DEVELOPMENT
AT 139 - 147 ABOVITE STREET,
NHL 6005, 6035 R.P., 6036 R.P.,
6037 R.P. & 6038 R.P.

TITLE :
PART ELEVATION, PLAN & SECTION OF
ALUM. CLADDING
FOR TOWER 1 FLAT C W3/W4
(2/F,3/F,5/F)

DATE : 12-MAY-20
SCALE : 1:60

DESIGN BY : LHR
CHECKED BY : DW
DRAWN BY : LHR
MIDT 鋁質有限公司
Unit 6-8, Sunny Industrial Centre, 1/F
610 Che Kwo Ling Road, Kowloon
Tel: (852) 27777666 Fax: (852) 27777666


DWG NO. : 052-SD-ACA-4028 REV. : C

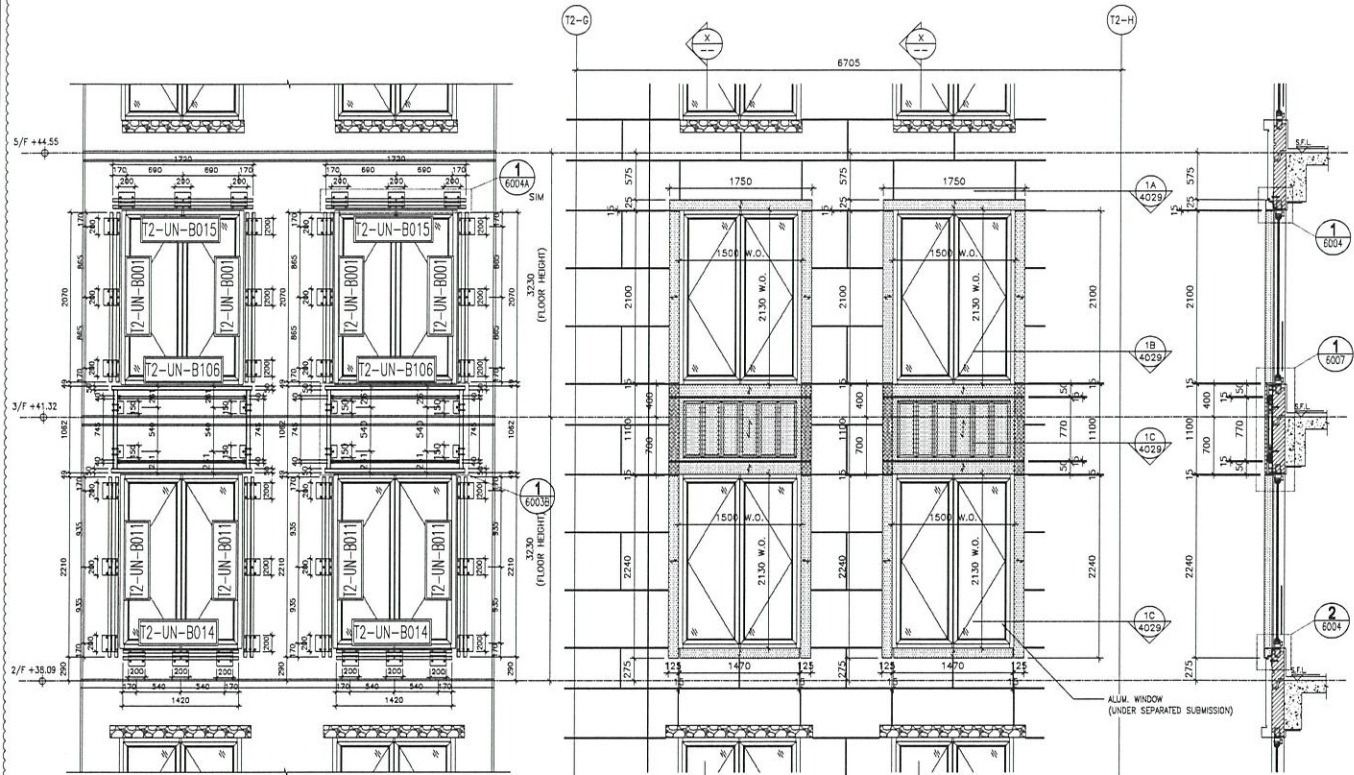

2 STEEL MEMBER CONNECTION OF ALUM. CLADDING
4029 FOR T2 FLAT C W3/W4 (2/F,3/F,5/F)

1 PARTIAL ELEVATION OF ALUM. CLADDING
4029 FOR T2 FLAT C W3/W4 (2/F,3/F,5/F)

X SECTION

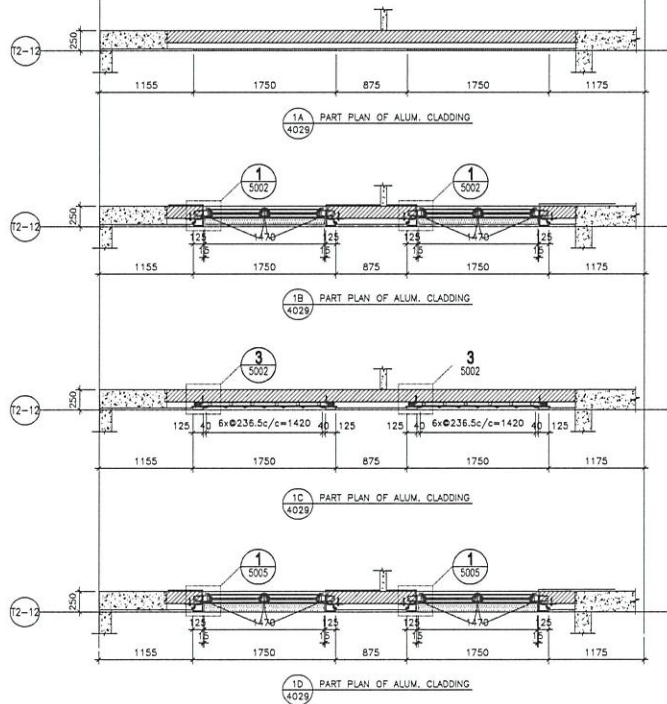


1A PART PLAN OF ALUM. CLADDING
4029

1B PART PLAN OF ALUM. CLADDING
4029

1C PART PLAN OF ALUM. CLADDING
4029

1D PART PLAN OF ALUM. CLADDING
4029

ARCHITECT : AEC MAIN CONSULTANT : ARUP STRUCTURAL ENGINEER : Gammone CLIENT :		REMARKS : 1. DIMENSIONS ARE IN mm. 2. ALL DIMENSIONS ARE TO FACE UNLESS OTHERWISE SPECIFIED. 3. ALL DIMENSIONS ARE TO BE CHECKED ON SITE BEFORE CONSTRUCTION.													
DATE : 12-MAY-20 SCALE : 1:60 PROJECT : PROPOSED RESIDENTIAL DEVELOPMENT AT 139 - 147 ARGENT STREET, NTL 6005, 6035 R.P., 6036 R.P., 6037 R.P. & 6038 R.P. TITLE : PART ELEVATION, PLAN & SECTION OF ALUM. CLADDING FOR TOWER 2 FLAT C W3/W4 (2/F,3/F,5/F) DESIGNED BY : LHR CHECKED BY : JMW DATE : 12-MAY-20 SCALE : 1:60		REVISIONS : <table border="1"> <thead> <tr> <th>NO.</th> <th>DATE</th> <th>REVISION</th> </tr> </thead> <tbody> <tr> <td>1</td> <td>12-05-2020</td> <td>ISSUED FOR TENDER</td> </tr> <tr> <td>2</td> <td>24-05-2020</td> <td>REVISION SUBMIT TO ARCH. CONSULTANT</td> </tr> <tr> <td>3</td> <td>24-05-2020</td> <td>REVISION SUBMIT TO ARCH. CONSULTANT</td> </tr> </tbody> </table>		NO.	DATE	REVISION	1	12-05-2020	ISSUED FOR TENDER	2	24-05-2020	REVISION SUBMIT TO ARCH. CONSULTANT	3	24-05-2020	REVISION SUBMIT TO ARCH. CONSULTANT
NO.	DATE	REVISION													
1	12-05-2020	ISSUED FOR TENDER													
2	24-05-2020	REVISION SUBMIT TO ARCH. CONSULTANT													
3	24-05-2020	REVISION SUBMIT TO ARCH. CONSULTANT													

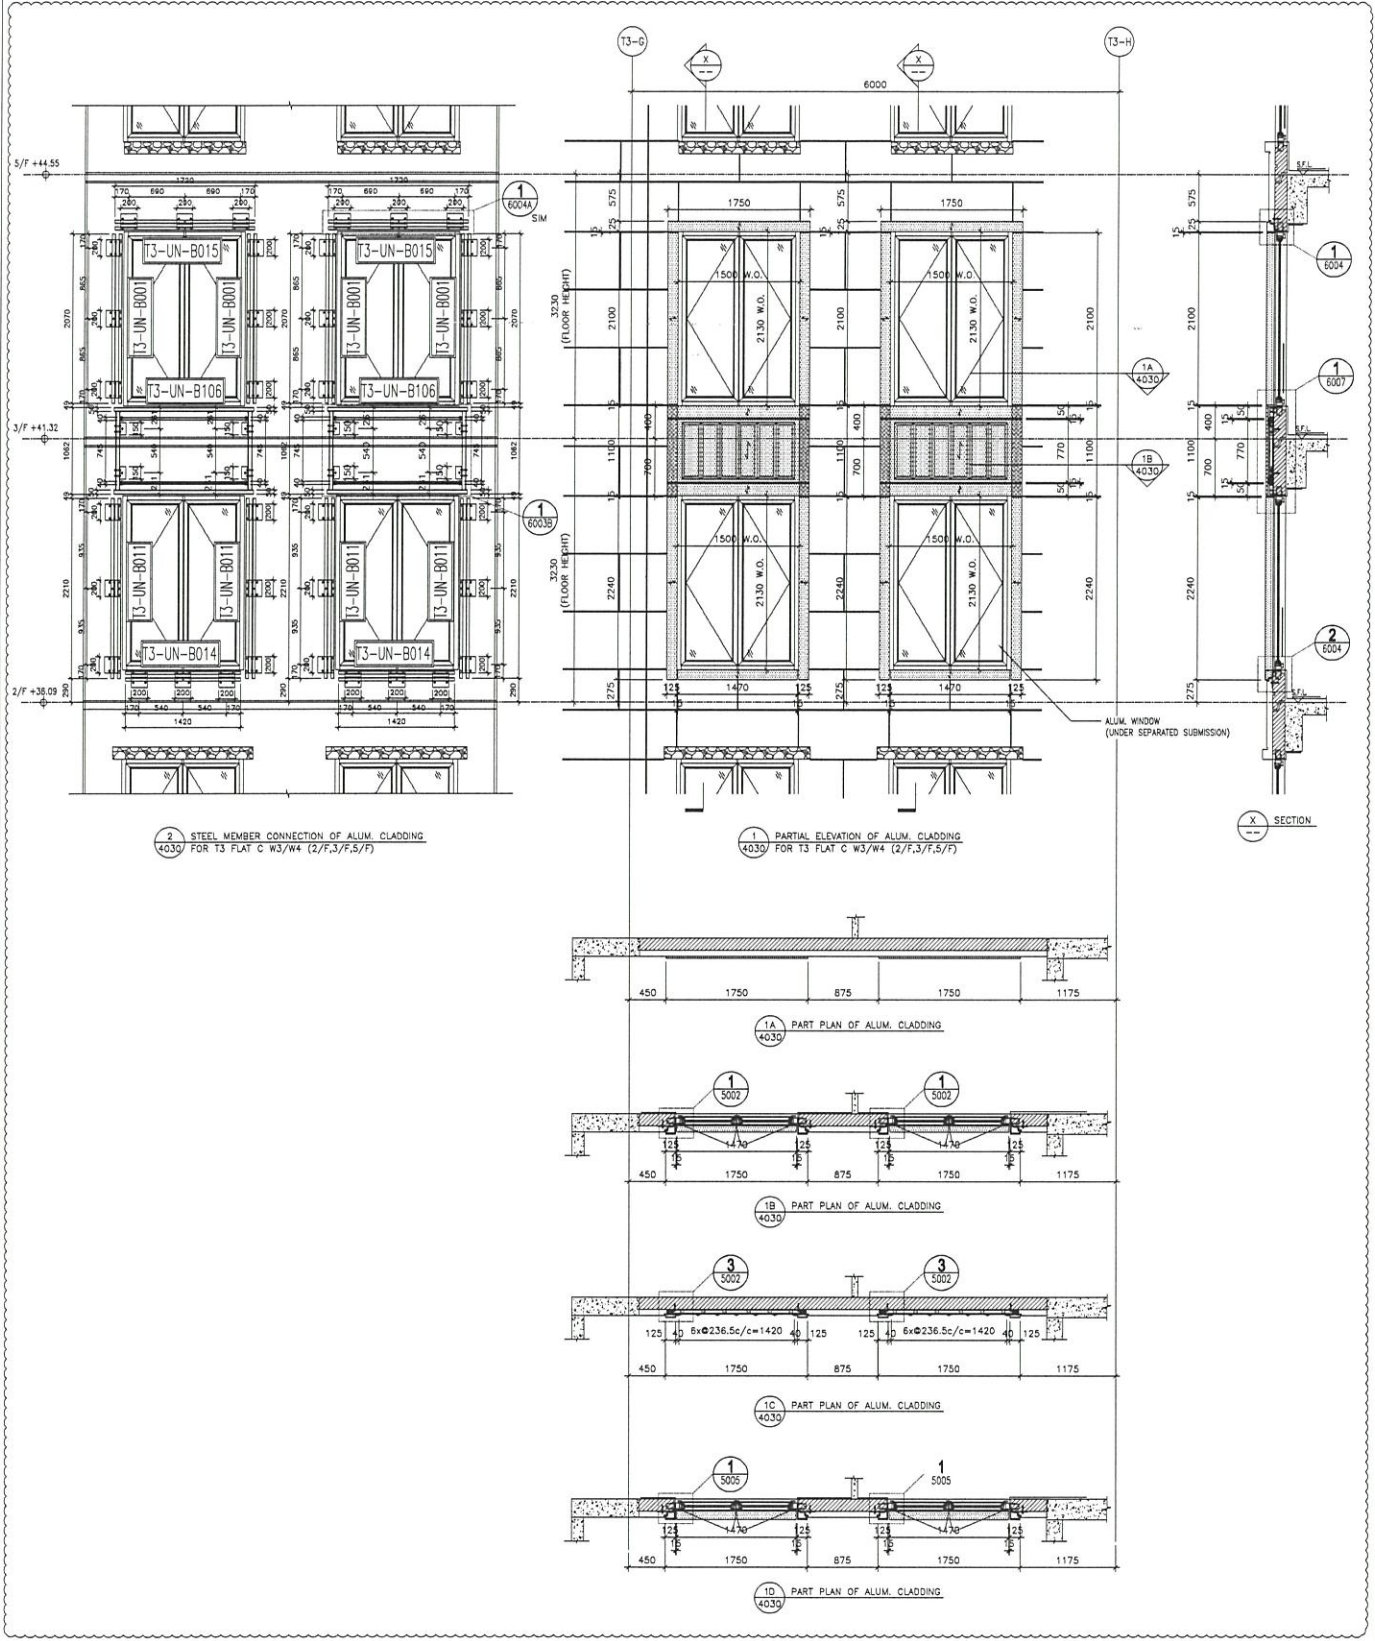

CLIENT :

ARCHITECT : AEC

STRUCTURAL ENGINEER : Gammon

PACKAGE CONSULTANT : ARUP

MEINHARDT

DATE : 12-MAY-20

SCALE : 1:60

PROJECT : PROPOSED RESIDENTIAL DEVELOPMENT

TITLE : PART ELEVATION, PLAN & SECTION OF ALUM. CLADDING FOR TOWER 3 FLAT C W3/W4 (2/F, 3/F, 5/F)

DESIGNER : J-852

CHECKED BY : J-852

DATE : 12-MAY-20

SCALE : 1:60

PROJECT : PROPOSED RESIDENTIAL DEVELOPMENT

TITLE : PART ELEVATION, PLAN & SECTION OF ALUM. CLADDING FOR TOWER 3 FLAT C W3/W4 (2/F, 3/F, 5/F)

REVISIONS :


NO.	DATE	REVISION
1	12-05-2020	ISSUED FOR TENDER
2	12-05-2020	REVISION SUBMIT TO ARCH. CONSULTANT
3	12-05-2020	REVISION SUBMIT TO ARCH. CONSULTANT

NOTES :

- ALL DIMENSIONS ARE IN mm.
- ALL DIMENSIONS ARE TO FACE UNLESS OTHERWISE SPECIFIED.
- ALL DIMENSIONS TO BE CHECKED ON SITE BEFORE FABRICATION.

LEGEND :


- 1. F.F.L. --- FINISHED FLOOR LEVEL
- 2. S.F.L. --- STRUCTURAL FLOOR LEVEL
- 3. (X) --- REINFORCED DETAIL
- 4. (X) --- 3mm THK. ALUM. CLADDING
- 5. (X) --- 3mm THK. STITCHED ALUM. PERFORATED PANEL

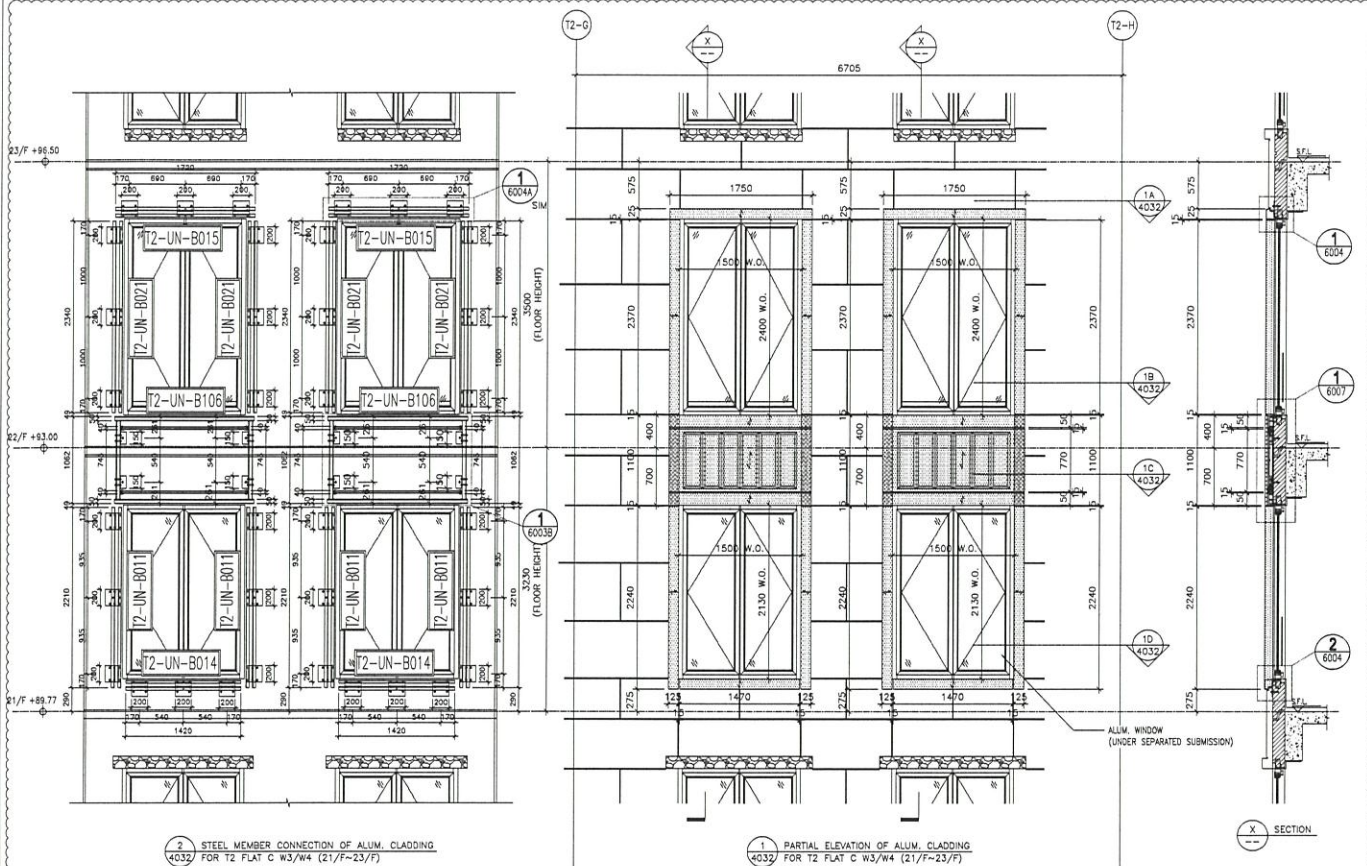

2 STEEL MEMBER CONNECTION OF ALUM. CLADDING
FOR T2 FLAT C W3/W4 (21/F-23/F)

1 PARTIAL ELEVATION OF ALUM. CLADDING
FOR T2 FLAT C W3/W4 (21/F-23/F)

SECTION

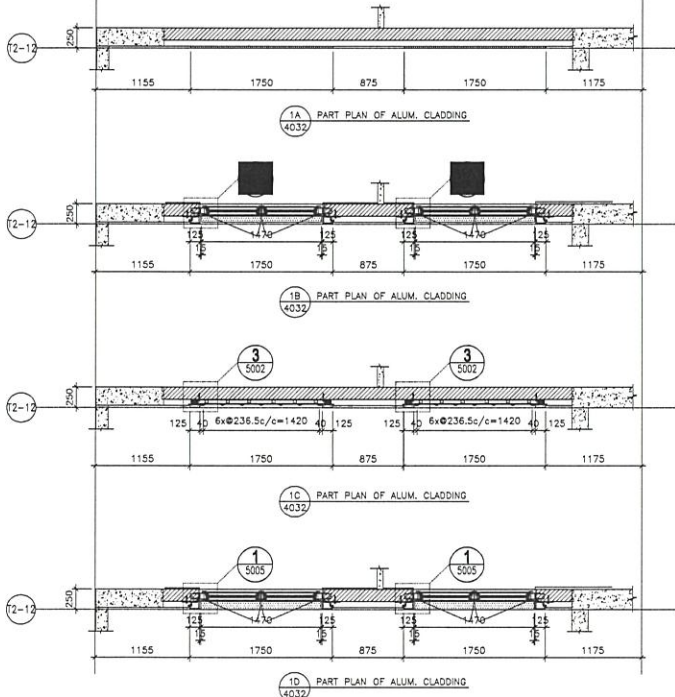

1A PART PLAN OF ALUM. CLADDING

1B PART PLAN OF ALUM. CLADDING

1C PART PLAN OF ALUM. CLADDING

1D PART PLAN OF ALUM. CLADDING

CLIENT :

ARCHITECT :

MAIN CONTRACTOR :

STRUCTURAL ENGINEER :

FAÇADE CONSULTANT :

ARUP

MEYERHARDT

PROJECT :

PROPOSED RESIDENTIAL DEVELOPMENT

PHASE 1: 139 - 147 ARGENT STREET

NKIL 6005, 6035 R.P., 6036 R.P.,

6037 R.P. & 6038 R.P.

TITLE :

ALUM. CLADDING

FOR TOWER 2 FLAT C W3/W4

(21/F-23/F)

DATE : 12-MAY-20

SCALE : 1:50

DRAWN BY : LHR

CHECKED BY : DW

REVISIONS :

NO.	DATE	DESCRIPTION
1	11-10-2020	ISSUED FOR TENDER
2	24-08-2020	REVISIONS TO BE VERIFIED ON SITE BEFORE FABRICATION.

LEGEND :

1. F.F.L. - FINISHED FLOOR LEVEL

2. S.F.L. - STRUCTURAL FLOOR LEVEL

3. (R) - REVERSED DETAIL

4. 3.0mm THK. ALUM. CLADDING

5. 5.0mm THK. STIFFENED ALUM. REINFORCED PANEL

NOTE :

1. ALL DIMENSIONS ARE IN MM.

2. ALL DIMENSIONS ARE MEASURED FROM OUTSIDE.

3. ALL DIMENSIONS TO BE VERIFIED ON SITE BEFORE FABRICATION.

OWNER : J-852

PROJECT : PROPOSED RESIDENTIAL DEVELOPMENT

PHASE 1: 139 - 147 ARGENT STREET

NKIL 6005, 6035 R.P., 6036 R.P.,

6037 R.P. & 6038 R.P.

TITLE :

ALUM. CLADDING

FOR TOWER 2 FLAT C W3/W4

(21/F-23/F)

DATE : 12-MAY-20

SCALE : 1:50

DRAWN BY : LHR

CHECKED BY : DW

OWNER : J-852

PROJECT : PROPOSED RESIDENTIAL DEVELOPMENT

PHASE 1: 139 - 147 ARGENT STREET

NKIL 6005, 6035 R.P., 6036 R.P.,

6037 R.P. & 6038 R.P.

TITLE :

ALUM. CLADDING

FOR TOWER 2 FLAT C W3/W4

(21/F-23/F)

DATE : 12-MAY-20

SCALE : 1:50

 
DRAWN BY : LHR

CHECKED BY : DW

B.L. REF :





1 PARTIAL ELEVATION OF ALUM. CLADDING
4034 FOR 22W14/T1A, 23W14/T1A(22/F-23/F)



1B PART PLAN OF ALUM. CLADDING
4034

DWG NO. : JB52-SD-ACA-4034	REV. : C
----------------------------	----------

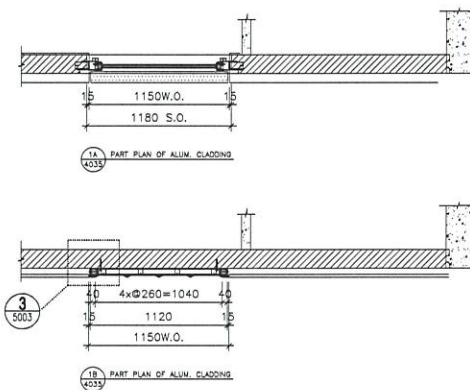


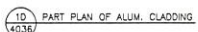

Y SECTION

Y SECTION

00. REF :	

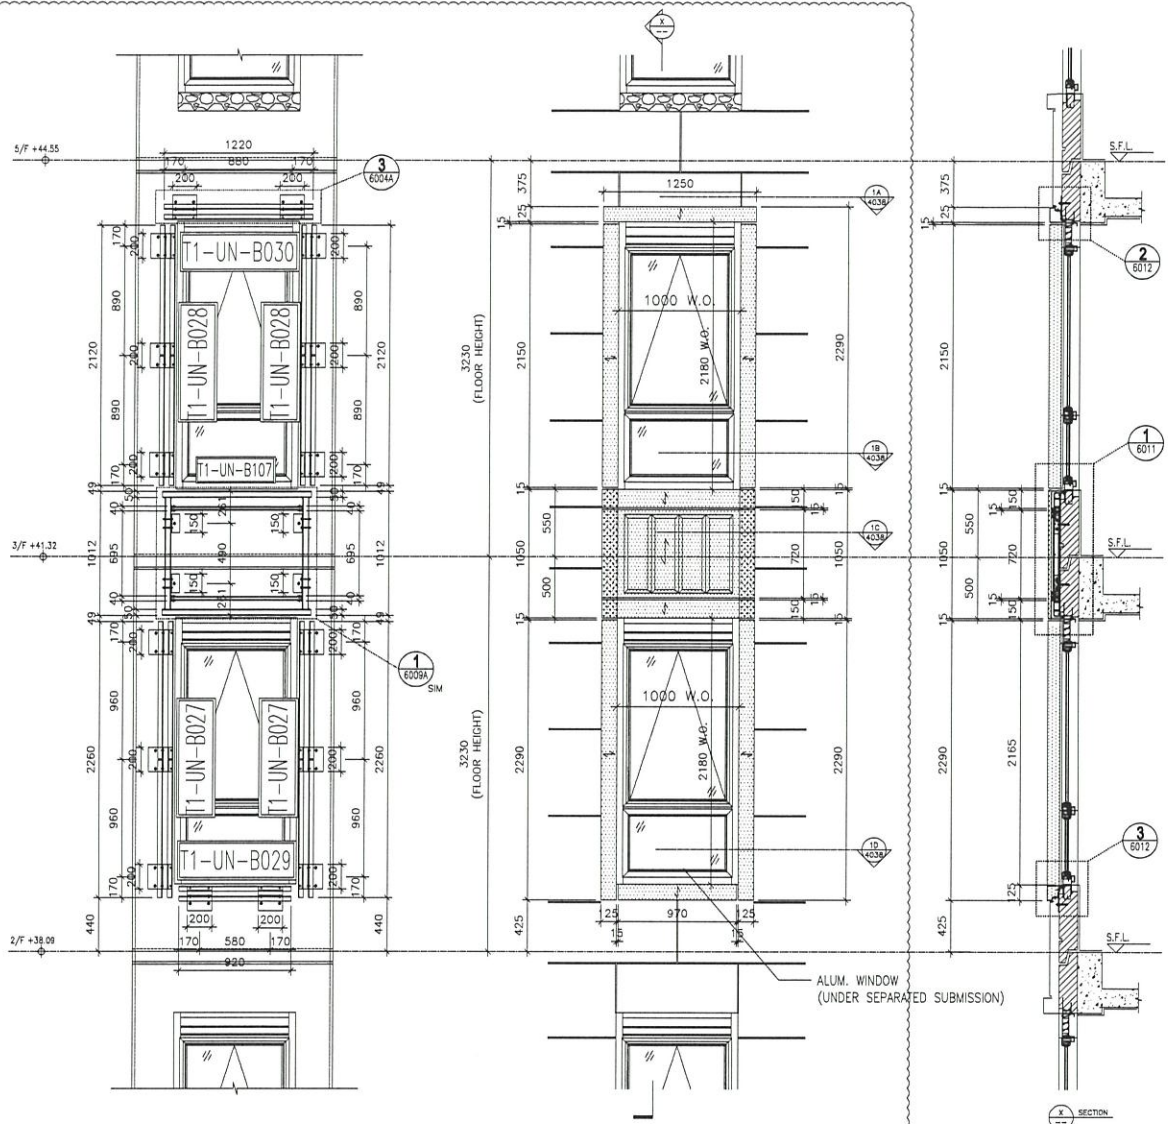

2 STEEL MEMBER CONNECTION OF ALUM. CLADDING FOR W5/T1A (2/F, 3/F, 5/F)

1 PARTIAL ELEVATION OF ALUM. CLADDING FOR W5/T1A (2/F, 3/F, 5/F)


1A PART PLAN OF ALUM. CLADDING

1 PART PLAN OF ALUM. CLADDING


1B PART PLAN OF ALUM. CLADDING

3 PART PLAN OF ALUM. CLADDING

1C PART PLAN OF ALUM. CLADDING

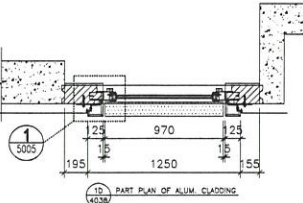

1 PART PLAN OF ALUM. CLADDING

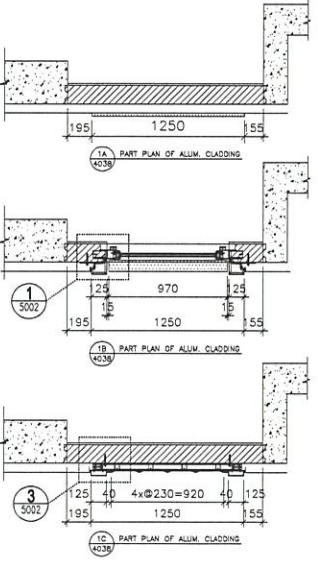

1A PART PLAN OF ALUM. CLADDING

1 PART PLAN OF ALUM. CLADDING

1B PART PLAN OF ALUM. CLADDING

3 PART PLAN OF ALUM. CLADDING

1C PART PLAN OF ALUM. CLADDING

CLIENT :

ARCHITECT :

MAIN CONSULTANT :

STRUCTURAL ENGINEER :

TRUCK CONSULTANT :

MEYERDT

ARUP

GAMMON

NOTE :

1. ALL DIMENSIONS ARE IN MM UNLESS OTHERWISE SPECIFIED.

2. ALL DIMENSIONS ARE TO FACE UNLESS OTHERWISE SPECIFIED.

3. ALL DIMENSIONS TO BE CHECKED ON SITE BEFORE FABRICATION.

LEGEND :

1. F.F.L. — FINISHED FLOOR LEVEL

2. S.F.L. — STRUCTURAL FLOOR LEVEL

3. () — REVERSED DETAIL

4. 3.0mm THK. ALUM. CLADDING

5. 5.0mm THK. SINTERED ALUM. PERFORATED PANEL

DATE : 12-MAY-20

SCALE : 1:40

DRAWN BY : LHR

CHECKED BY : JHW

PROJECT : PROPOSED RESIDENTIAL DEVELOPMENT AT 139-147 MOORE STREET, NKL 6005 6035 R.P., 6036 R.P., 6037 R.P. & 6038 R.P.

TITLE : PART ELEVATION, PLAN & SECTION OF ALUM. CLADDING FOR W5/T1A (2/F, 3/F, 5/F)

DATE NO. : J-852

REVISION :

NO.	DATE	DESCRIPTION
1	12-05-2020	ISSUED SUBJECT TO MAIN CONSULTANT
2	24-05-2020	REVISION SUBJECT TO MAIN CONSULTANT
3		
4		
5		
6		
7		
8		
9		
10		

DATE NO. : J-852


REVISION :

 
DATE NO. : J-852

REVISION :


DATE NO. : J-852

REVISION :

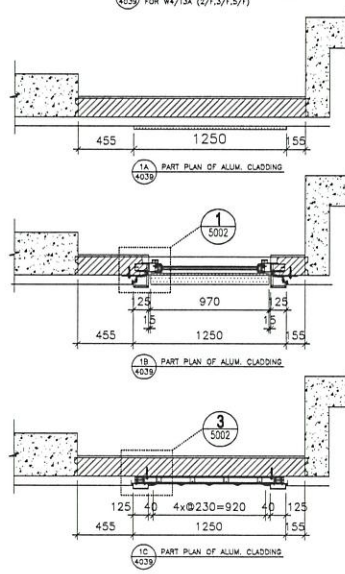



DWG NO. : JB52-SD-ACA-4041	REV. : C
----------------------------	----------

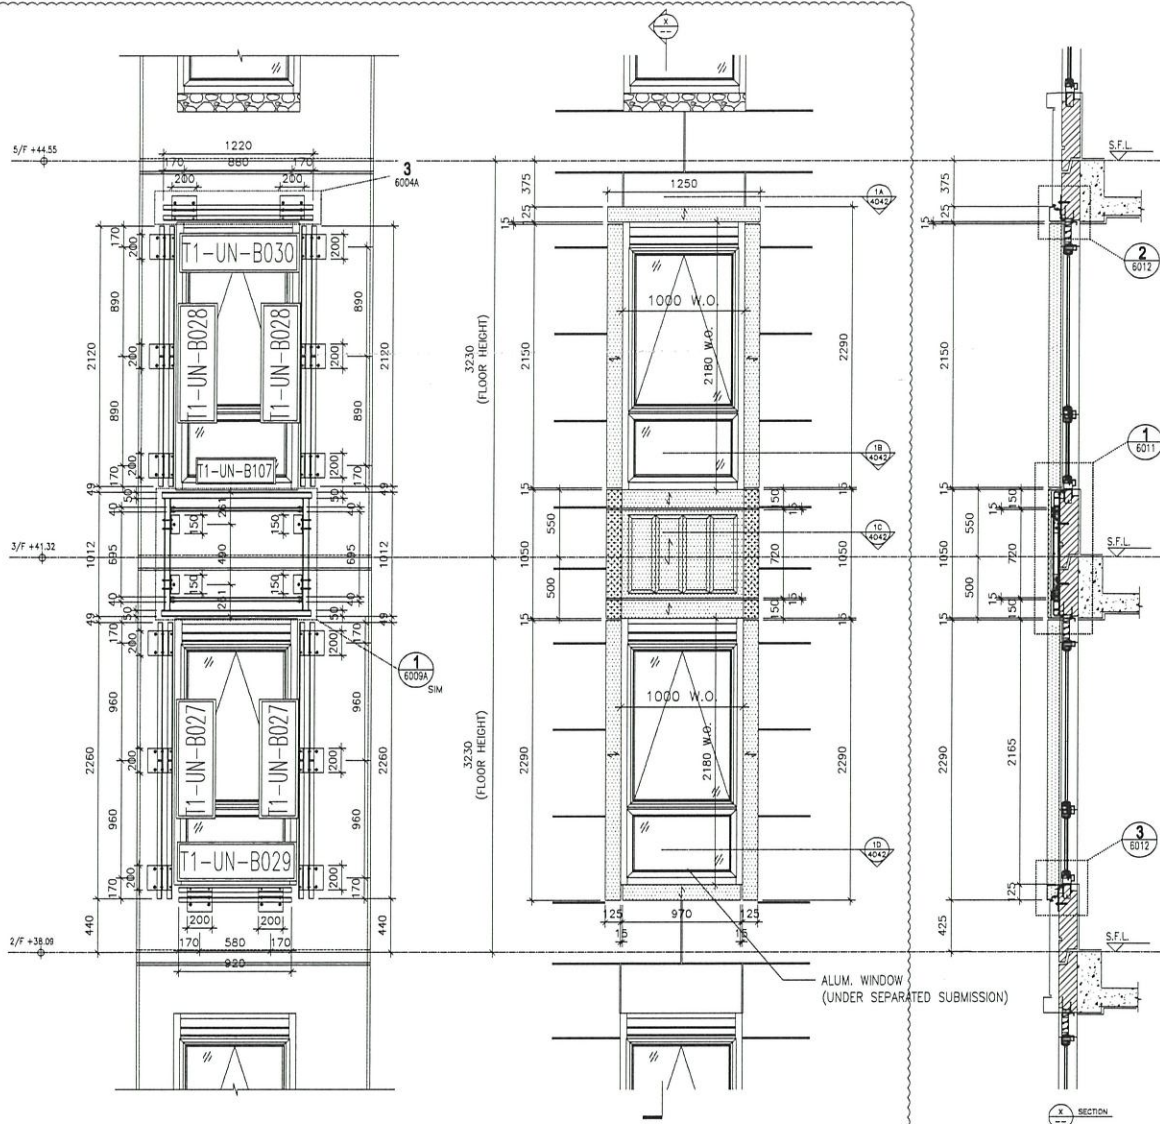


1 STEEL MEMBER CONNECTION OF ALUM. CLADDING FOR W4/T1A (2/F, 3/F, 5/F)

1 PARTIAL ELEVATION OF ALUM. CLADDING FOR W4/T1A (2/F, 3/F, 5/F)


1A PART PLAN OF ALUM. CLADDING

1B PART PLAN OF ALUM. CLADDING

1C PART PLAN OF ALUM. CLADDING

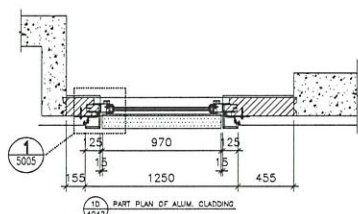

1D PART PLAN OF ALUM. CLADDING

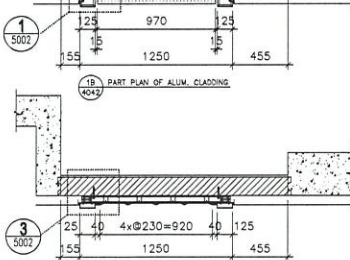

NOTE:
1. DIMENSIONS ARE IN mm.
2. ALL ELEVATIONS ARE VIEWED FROM OUTSIDE.
3. ALL DIMENSIONS TO BE CARRIED ON SITE BEFORE FABRICATION.

LEGEND:

- 1. F.F.L. --- FINISHED FLOOR LEVEL
- 2. S.F.L. --- STRUCTURE FLOOR LEVEL
- 3. --- REVERSED DETAIL
- 4. --- 30mm THK. ALUM. CLADDING
- 5. --- 30mm THK. SINTERED ALUM. PERFORATED PANEL

ARCHITECT : **AEC DESIGN LTD.**


STRUCTURAL ENGINEER : **Gammone**

MECHANICAL CONSULTANT : **ARUP**

ELECTRICAL CONSULTANT : **MEINHARDT**

PROJECT : PROPOSED RESIDENTIAL DEVELOPMENT AT 139 - 147 ANTOLE STREET, NTL 6005, 6035 R.P., 6036 R.P., 6037 R.P. & 6038 R.P.	
TITLE : PART ELEVATION, PLAN & SECTION OF ALUM. CLADDING FOR W4/T1A (2/F, 3/F, 5/F)	
DATE : 12-MAY-20	SCALE : 1:40
DRAWN BY : LHR	CHECKED BY : JHW
DOWNTOWN : 11-12-2009 24-02-2009 REVISION SUBJECT TO HOLO CONSULTANT REVISION NO. 1 SHEET	
JOB NO. : J-852 PROJECT : PROPOSED RESIDENTIAL DEVELOPMENT AT 139 - 147 ANTOLE STREET, NTL 6005, 6035 R.P., 6036 R.P., 6037 R.P. & 6038 R.P. TITLE : PART ELEVATION, PLAN & SECTION OF ALUM. CLADDING FOR W4/T1A (2/F, 3/F, 5/F)	

UNITED OVERSEAS CHINESE BANK LTD.
 610 Cheong Cheong Road, Kowloon
 Tel: 23488711-4 Fax: (852) 7777666
 DMC NO. : J852-SO-ACA-4042 REV : C

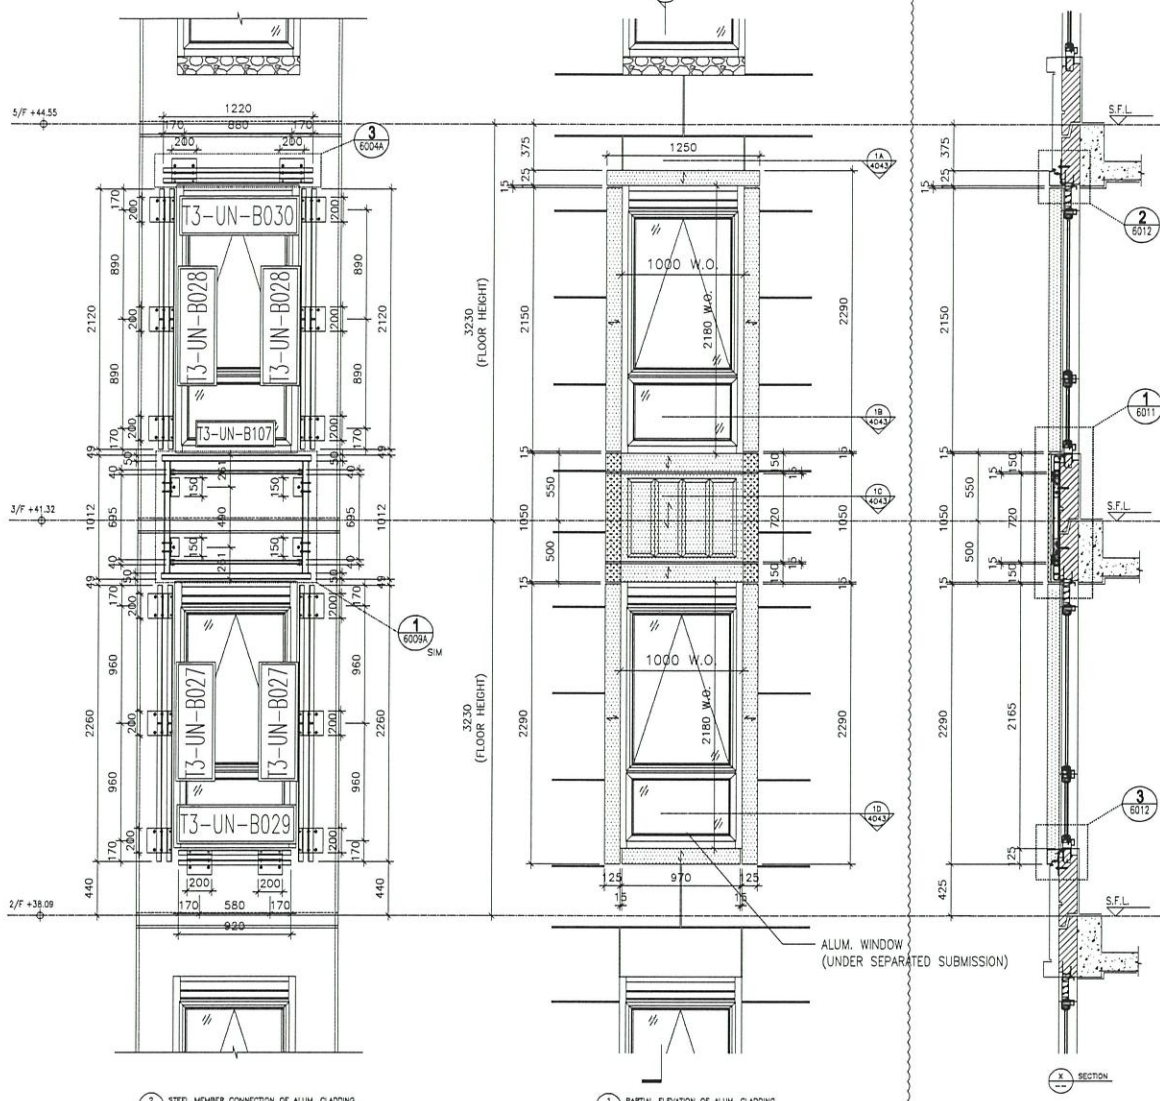


1 STEEL MEMBER CONNECTION OF ALUM. CLADDING FOR W5/T3A (2/F,3/F,5/F)

1 PARTIAL ELEVATION OF ALUM. CLADDING FOR W5/T3A (2/F,3/F,5/F)


1A PART PLAN OF ALUM. CLADDING

1B PART PLAN OF ALUM. CLADDING

1C PART PLAN OF ALUM. CLADDING

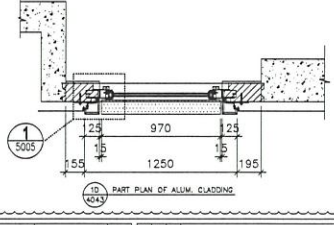

1 6009A

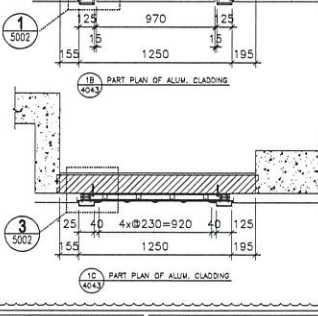


1 6009A

DATE: 12-MAY-20
DRAWN BY: LHR
CHECKED BY: DW


SCALE: 1:40

TITLE: PART ELEVATION, PLAN & SECTION OF ALUM. CLADDING FOR W5/T3A (2/F,3/F,5/F)


PROJECT: PROPOSED RESIDENTIAL DEVELOPMENT
NO. 133, 135, 137, 4125,

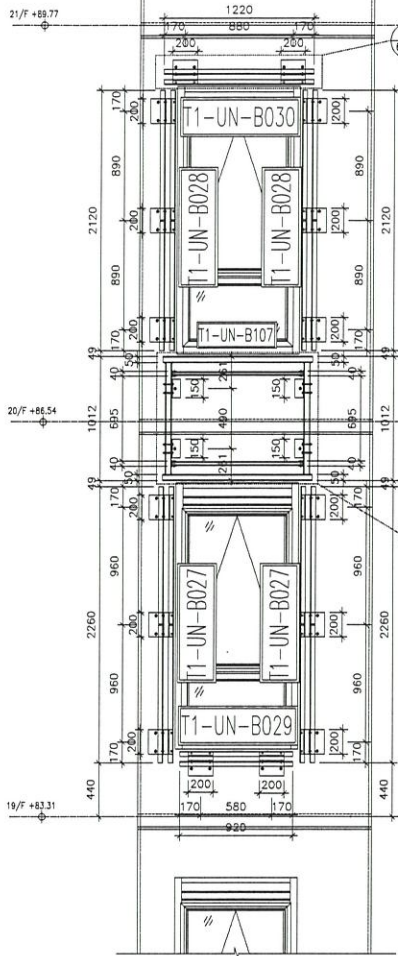

1 STEEL MEMBER CONNECTION OF ALUM. CLADDING FOR W4/71A (19/F-20/F)

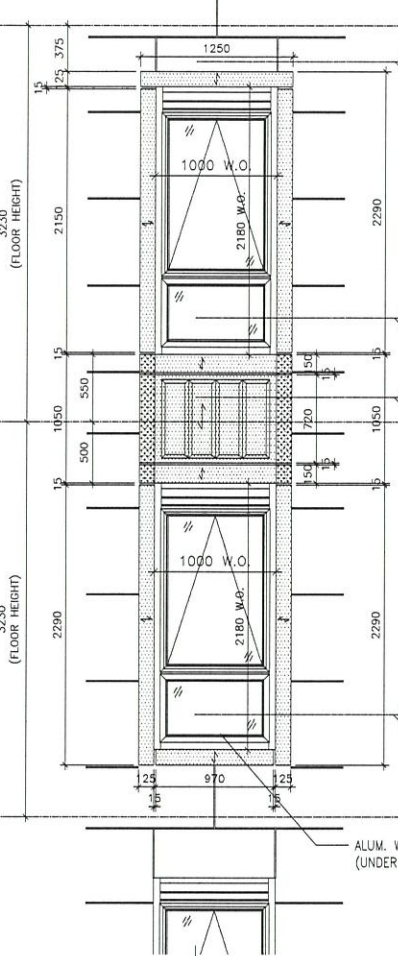


ALUM. WINDOW (UNDER SEPARATED SUBMISSION)

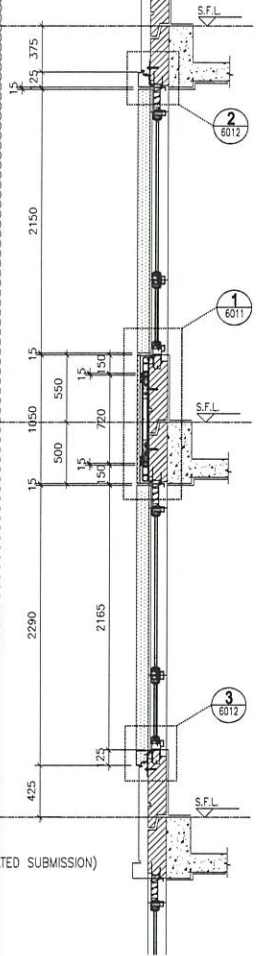


SECTION


1 PARTIAL ELEVATION OF ALUM. CLADDING FOR W4/71A (19/F-20/F)

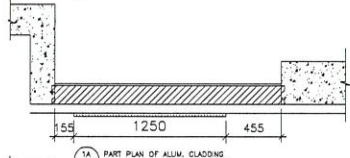


1A PART PLAN OF ALUM. CLADDING

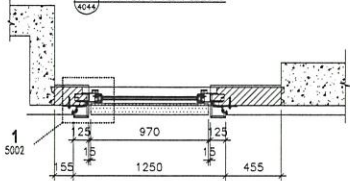

1B PART PLAN OF ALUM. CLADDING

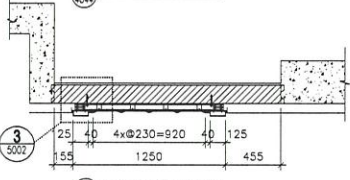

1C PART PLAN OF ALUM. CLADDING

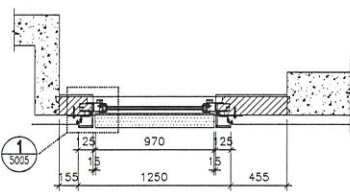

1D PART PLAN OF ALUM. CLADDING

ARCHITECT : **AEC**

STRUCTURAL ENGINEER : **Gammmon**


MECHANICAL CONSULTANT : **ARUP**

FAÇADE CONSULTANT : **WEINYARDT**

- NOTE:
1. ALL DIMENSIONS ARE IN MM.
 2. ALL ELEVATIONS ARE VIEWED FROM OUTSIDE.
 3. ALL DIMENSIONS TO BE VERIFIED ON SITE BEFORE FABRICATION.
- LEGEND:
1. F.F.L. — FINISHED FLOOR LEVEL
 2. S.F.L. — STRUCTURAL FLOOR LEVEL
 3. (Ø) — REINFORCED CONCRETE
 4. 3.0mm THK. ALUM. CLADDING
 5. 5.0mm THK. STIFFENED ALUM. PERFORATED PANEL

PROJECT : PROPOSED RESIDENTIAL DEVELOPMENT

NO. 132, 147, 149, 151, 3957, 3959

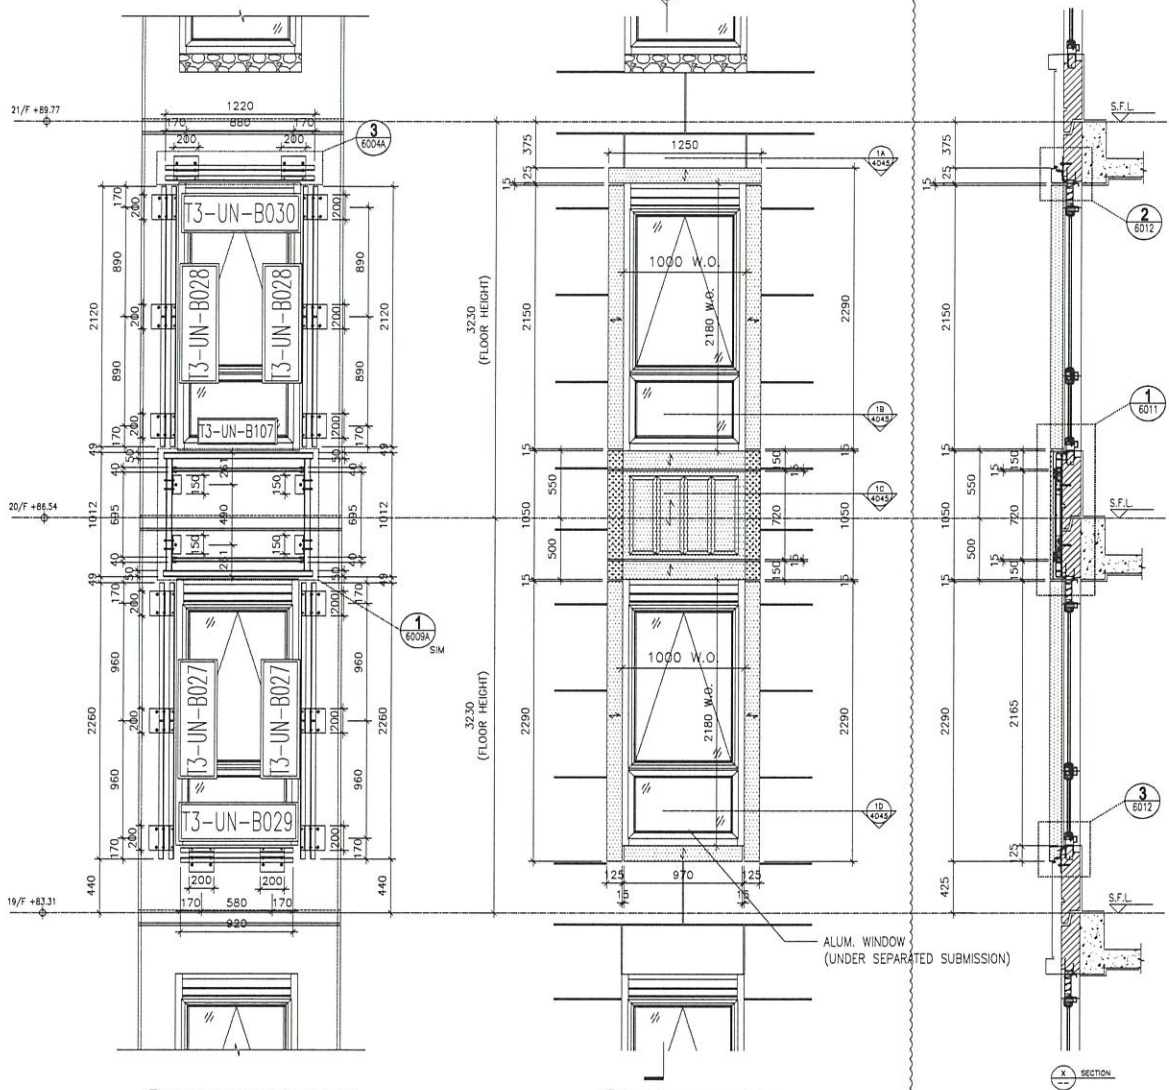



1 STEEL MEMBER CONNECTION OF ALUM. CLADDING
FOR W5/13A (19/F-20/F)

1 PARTIAL ELEVATION OF ALUM. CLADDING
FOR W5/13A (19/F-20/F)

1A PART PLAN OF ALUM. CLADDING

1B PART PLAN OF ALUM. CLADDING

1C PART PLAN OF ALUM. CLADDING

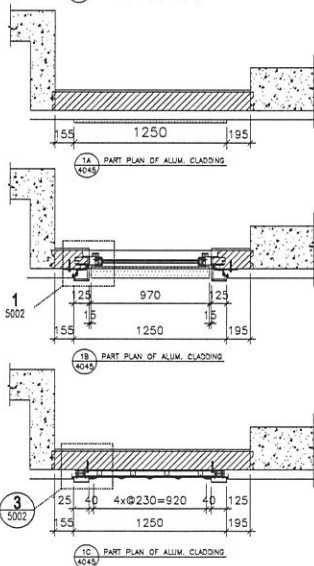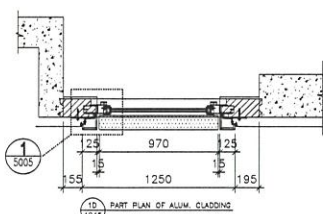

DATE: 12-MAY-20
SCALE: 1:40
DRAWN BY: LHR
CHECKED BY: JOW
PROJECT: PROPOSED RESIDENTIAL DEVELOPMENT
AT 139 - 147 ARGOTE STREET
MKL 6005 6035 R.P., 6036 R.P.,
6037 R.P. & 6038 R.P.
TITLE: PART ELEVATION, PLAN & SECTION OF
ALUM. CLADDING
FOR W5/13A (19/F-20/F)

NO.	DATE	REVISION	REVISION SUBJECT TO ARCH. COMMENT
1	12-05-2020	REVISION	REVISION SUBJECT TO ARCH. COMMENT
2	24-06-2020	REVISION	REVISION SUBJECT TO ARCH. COMMENT

LEGEND:
1. F.F.L. --- FINISHED FLOOR LEVEL
2. S.F.L. --- STRUCTURAL FLOOR LEVEL
3. (S) --- REVERSED DETAIL
4. 3.0mm THK. ALUM. CLADDING
5. 8259 5.0mm THK. STIFFENED ALUM. PERFORATED PANEL

NOTE:
1. DIMENSIONS ARE IN mm.
2. ALL ELEVATIONS ARE VIEWED FROM OUTSIDE.
3. ALL DIMENSIONS TO BE CHECKED ON SITE BEFORE FABRICATION.

STRUCTURAL ENGINEER:
ARUP
ARCHITECT:
MEYERHARDT

MAN CONSULTANT:
Gammone
ARCHITECT:
AEC
DESIGNER LTD.

CLIENT:
DATE: 12-MAY-20
SCALE: 1:40
DRAWN BY: LHR
CHECKED BY: JOW

PROJECT: PROPOSED RESIDENTIAL DEVELOPMENT
AT 139 - 147 ARGOTE STREET
MKL 6005 6035 R.P., 6036 R.P.,
6037 R.P. & 6038 R.P.
TITLE: PART ELEVATION, PLAN & SECTION OF
ALUM. CLADDING
FOR W5/13A (19/F-20/F)

MEYERHARDT
139-147 ARGOTE STREET
MKL 6005 6035 R.P., 6036 R.P.,
6037 R.P. & 6038 R.P.
TEL: 23489211-4 Fax: (852) 7727666
DWC NO.: JBS2-SID-A04-4045
REV: C