

工程指示 / 要求簡箋(E.I.)

工程指示編號：EI / 3157 / 21

修改版次：B

工程編號：J - 852

有聲後

工程名稱：亞皆老街中電

工程項目：Acoustic Fins(C UP) 大貨地盤用鋁板優先出貨 (T3 3,6/F)

收件人：生統

發件人：Ant Yeung

日期：30/03/2021

要求提供 / 確認 事項：

- | | | |
|------------------------------------|-------------------------------------|-------------------------------|
| <input type="checkbox"/> 初步鋁料 B.M. | <input type="checkbox"/> 加工拆圖，然後生產 | <input type="checkbox"/> 尺寸表 |
| <input type="checkbox"/> 正式鋁料 B.M. | <input type="checkbox"/> 技術上資料 / 指示 | <input type="checkbox"/> 報價 |
| <input type="checkbox"/> 配件 B.M. | <input type="checkbox"/> 樣辦或貨品說明書 | <input type="checkbox"/> 分判合約 |

內容：

B版：優先出貨 (T3 3,6/F) 共 20 件

A版：1) 所有長孔要改為梗孔。顧問只接受梗孔。 2) 稍後提供裝棉指引。

A版：3) 請與 EI 3219 的鋁料於廠一起組裝，送地盤用。取消 50X50X3 鋁角，以免重複生產。

請按加工圖生產 T1-T3: 1-23/F Acoustic Fins (C UP)有孔鋁板 送地盤用。 T3 優先 軒仔收貨

EI2977 已生產 T3: 5/F 的數量

(10層一批生產)

T1/2/3-ACD-A65-67 拆圖尚有修改，先暫停生產。

請在 2021.04.06 前完成上列要求。

附：9 頁

以上項目為：

- 原合約工程包 原合約工程加 / 減賬 新工程報價

原因：-

分發東莞各部門：

- | | | | |
|--|---|--|--|
| <input type="checkbox"/> 生產技術總監 <input type="checkbox"/> 連附件 | <input type="checkbox"/> 技術部 <input type="checkbox"/> 連附件 | <input type="checkbox"/> 生產部 <input type="checkbox"/> 連附件 | <input type="checkbox"/> 機械設計部 <input type="checkbox"/> 連附件 |
| <input type="checkbox"/> 採購部 <input type="checkbox"/> 連附件 | <input checked="" type="checkbox"/> 生產統籌部 <input checked="" type="checkbox"/> 連附件 | <input checked="" type="checkbox"/> 小羅 & 清 <input checked="" type="checkbox"/> 連附件 | |
| <input type="checkbox"/> 質檢部 <input type="checkbox"/> 連附件 | <input type="checkbox"/> 會計部 <input type="checkbox"/> 連附件 | <input type="checkbox"/> 報關組 <input type="checkbox"/> 連附件 | <input type="checkbox"/> 其他 楊榮輝 <input type="checkbox"/> 連附件 |

分發其他分判：

- 水洪 連附件

分發香港各部門：

- | | | | |
|---|--|--|--|
| <input type="checkbox"/> 行政部 <input type="checkbox"/> 連附件 | <input type="checkbox"/> 會計部 <input type="checkbox"/> 連附件 | <input type="checkbox"/> 統籌部 <input type="checkbox"/> 連附件 林哥 | <input type="checkbox"/> 工程部地盤科文 <input type="checkbox"/> 連附件 祥哥 |
| <input type="checkbox"/> 採購部 <input type="checkbox"/> 連附件 | <input type="checkbox"/> QS 部 <input type="checkbox"/> 連附件 | <input type="checkbox"/> 維修部 <input type="checkbox"/> 連附件 | <input type="checkbox"/> 其他 _____ <input type="checkbox"/> 連附件 |

傳遞編號：

HK 666 / 21






發件人簽署：

項目經理簽署：


(Signature)

Handwritten blue notes: 2, 3, 4, 5, 6, 7, 8, 9, 10, 11, 12, 13, 14

Handwritten black notes: 暫停 (Stop), T3

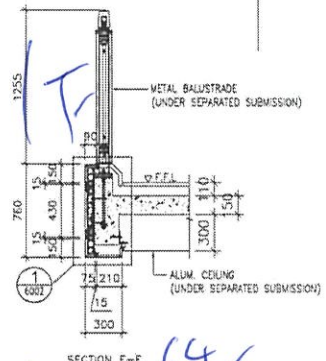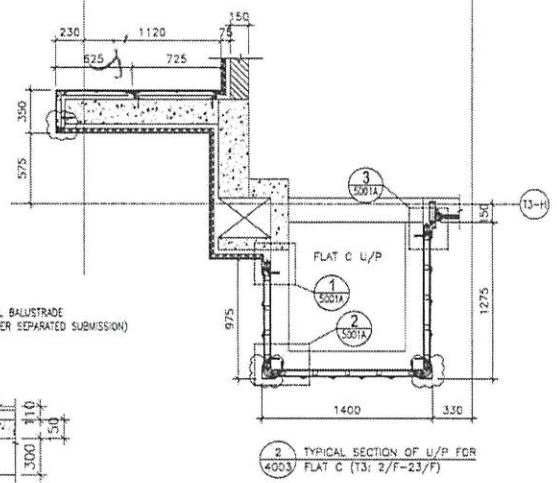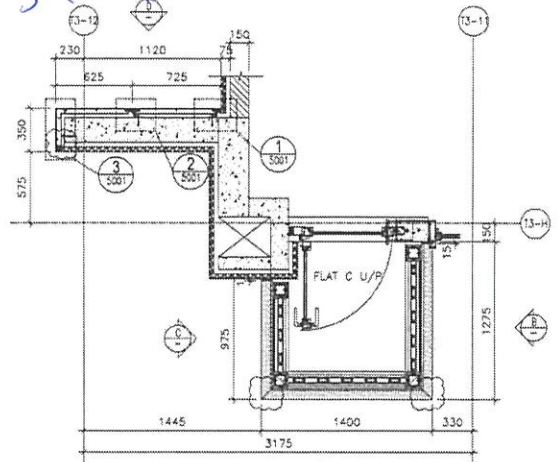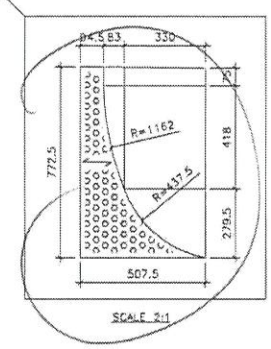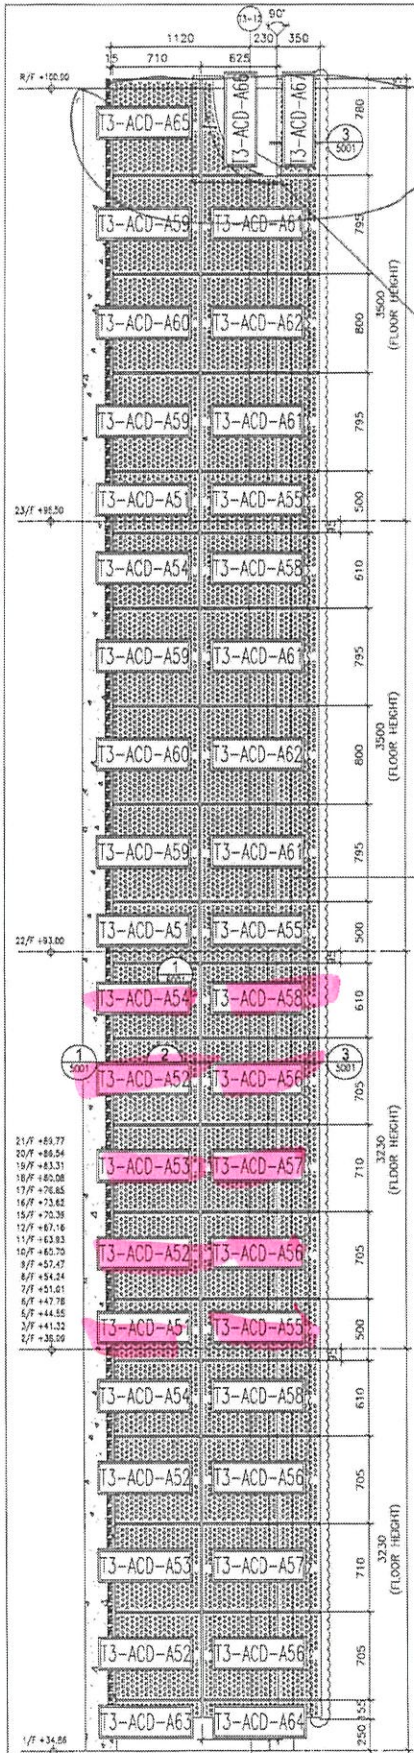

Handwritten blue notes: 3, 0, 12, H, 20, 14


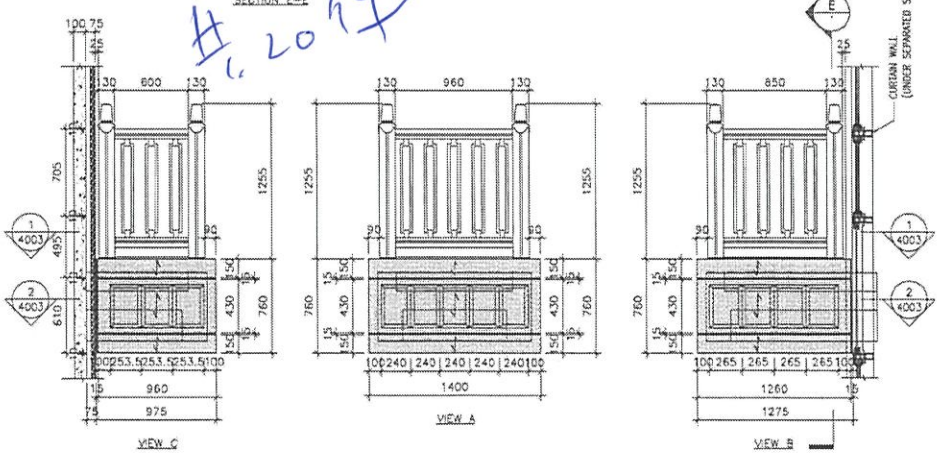


<p>DATE: 12-JAN-20 DRAWN BY: JHR CHECKED BY: JHW SCALE: 1:40</p>	<p>PROJECT: PROPOSED RESIDENTIAL DEVELOPMENT AT T33 - 147 ARGENT STREET, HNL 6025, 6026, 6027, 6028, 6029, 6030, 6031, 6032, 6033, 6034, 6035, 6036, 6037, 6038, 6039, 6040.</p> <p>TITLE: FACIT ELEVATION PLAN & SECTION OF ALUM. & ACOSTIC CLADDING FOR TOWER 3 FLAT C U/P</p>	<p>JOB NO.: J-452</p> <table border="1"> <tr> <th>NO.</th> <th>REV.</th> <th>DESCRIPTION</th> </tr> <tr> <td>1</td> <td>1</td> <td>ISSUE FOR PERMIT</td> </tr> <tr> <td>2</td> <td>2</td> <td>ISSUE FOR PERMIT</td> </tr> <tr> <td>3</td> <td>3</td> <td>ISSUE FOR PERMIT</td> </tr> <tr> <td>4</td> <td>4</td> <td>ISSUE FOR PERMIT</td> </tr> <tr> <td>5</td> <td>5</td> <td>ISSUE FOR PERMIT</td> </tr> <tr> <td>6</td> <td>6</td> <td>ISSUE FOR PERMIT</td> </tr> <tr> <td>7</td> <td>7</td> <td>ISSUE FOR PERMIT</td> </tr> <tr> <td>8</td> <td>8</td> <td>ISSUE FOR PERMIT</td> </tr> <tr> <td>9</td> <td>9</td> <td>ISSUE FOR PERMIT</td> </tr> <tr> <td>10</td> <td>10</td> <td>ISSUE FOR PERMIT</td> </tr> <tr> <td>11</td> <td>11</td> <td>ISSUE FOR PERMIT</td> </tr> <tr> <td>12</td> <td>12</td> <td>ISSUE FOR PERMIT</td> </tr> <tr> <td>13</td> <td>13</td> <td>ISSUE FOR PERMIT</td> </tr> <tr> <td>14</td> <td>14</td> <td>ISSUE FOR PERMIT</td> </tr> <tr> <td>15</td> <td>15</td> <td>ISSUE FOR PERMIT</td> </tr> <tr> <td>16</td> <td>16</td> <td>ISSUE FOR PERMIT</td> </tr> <tr> <td>17</td> <td>17</td> <td>ISSUE FOR PERMIT</td> </tr> <tr> <td>18</td> <td>18</td> <td>ISSUE FOR PERMIT</td> </tr> <tr> <td>19</td> <td>19</td> <td>ISSUE FOR <td>46</td> <td>46</td> <td>ISSUE FOR PERMIT</td> </tr> <tr> <td>47</td> <td>47</td> <td>ISSUE FOR PERMIT</td> </tr> <tr> <td>48</td> <td>48</td> <td>ISSUE FOR PERMIT</td> </tr> <tr> <td>49</td> <td>49</td> <td>ISSUE FOR PERMIT</td> </tr> <tr> <td>50</td> <td>50</td> <td>ISSUE FOR PERMIT</td> </tr> </table>	NO.	REV.	DESCRIPTION	1	1	ISSUE FOR PERMIT	2	2	ISSUE FOR PERMIT	3	50	ISSUE FOR PERMIT	<p>MEMBER: ARUP PROJECT: T33</p> <p>MEMBER: Gammou PROJECT: T33</p> <p>MEMBER: ARUP PROJECT: T33</p>	<p>MEMBER: ARUP PROJECT: T33</p> <p>MEMBER: Gammou PROJECT: T33</p> <p>MEMBER: ARUP PROJECT: T33</p>	<p>MEMBER: ARUP PROJECT: T33</p> <p>MEMBER: Gammou PROJECT: T33</p> <p>MEMBER: ARUP PROJECT: T33</p>
NO.	REV.	DESCRIPTION																																																																																																																																																												
1	1	ISSUE FOR PERMIT																																																																																																																																																												
2	2	ISSUE FOR PERMIT																																																																																																																																																												
3	3	ISSUE FOR PERMIT																																																																																																																																																												
50	50	ISSUE FOR PERMIT																																																																																																																																																												





美特鋁質 有限公司
MIDI Aluminium Fabricator Ltd.

工程號 J852 地盤 亞答老街

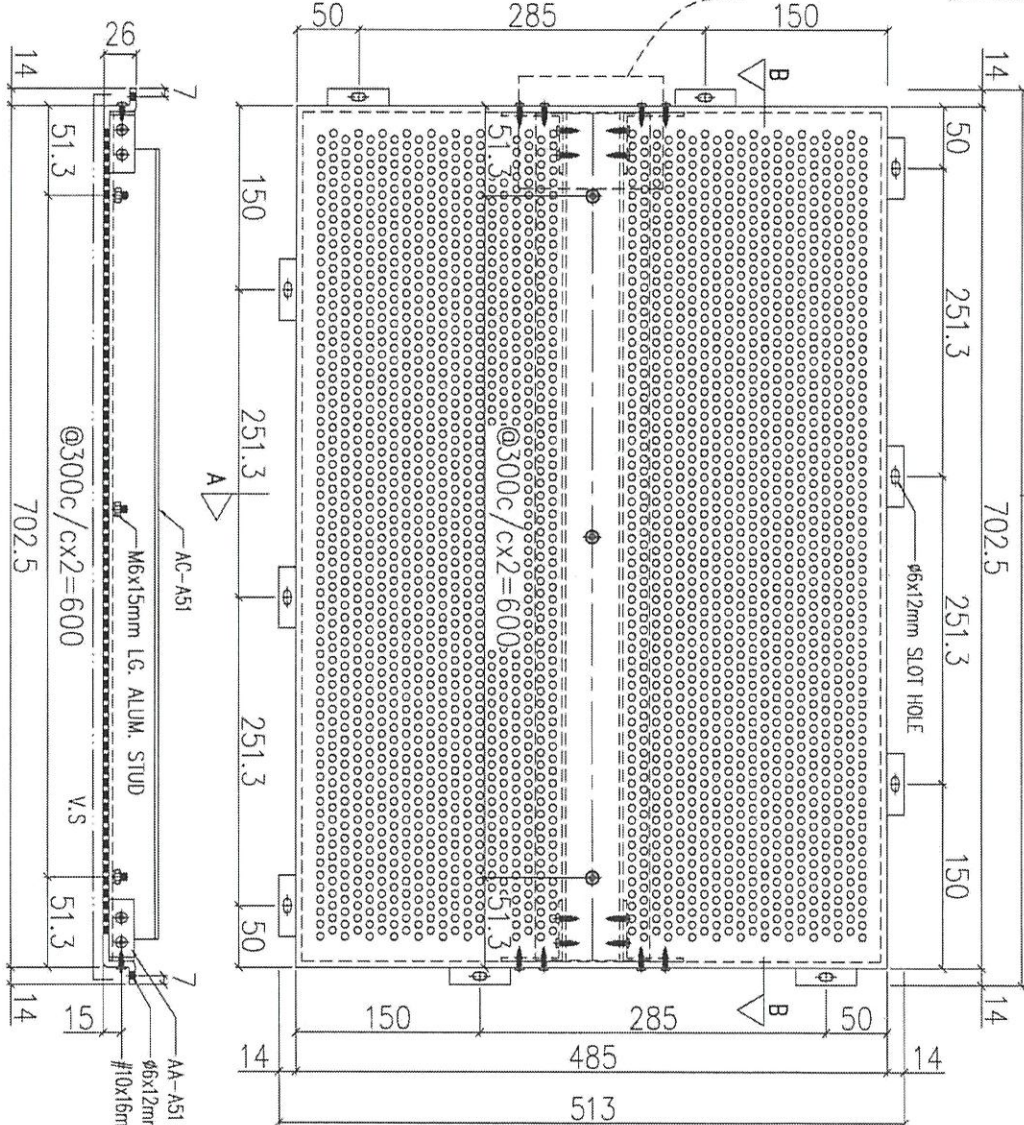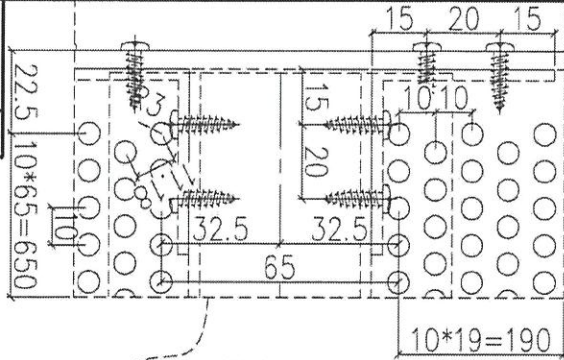

A
730.5
TOP

Handwritten notes:
299
ACD-A51

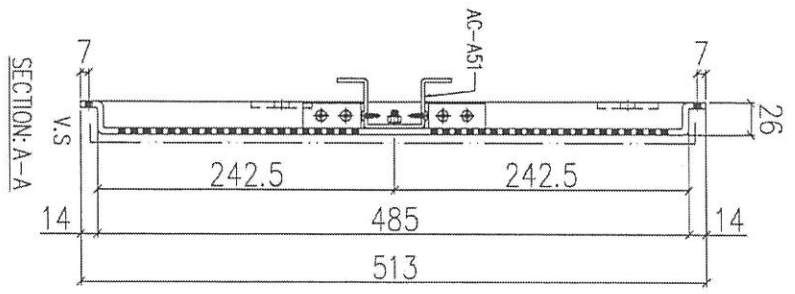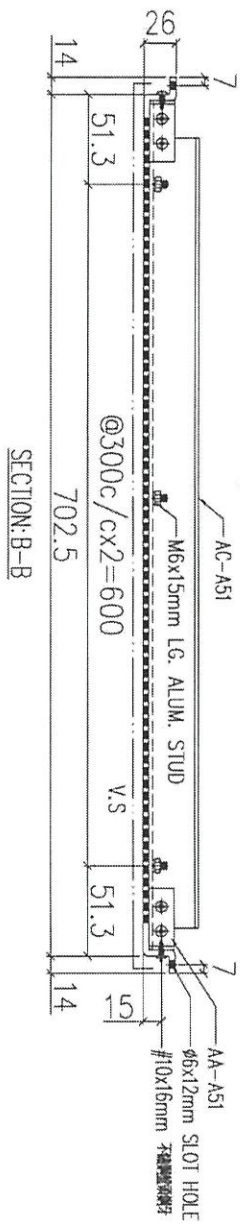

序號	物料編號	數量	使用位置	樓層
01	T1-ACD-A51	19	見派位圖	2F~23F
02	T2-ACD-A51	19	見派位圖	2F~23F
03	T3-ACD-A51	19	見派位圖	2F~23F



名稱	鋁板加工圖	制圖	LHR	2021.03.08	修改
材料	5mm THK. ALUM. CLADDING	復核	-	-	日期
顏色	FN090M	批准			圖號 J852-ACA-ACD-A51



美特鋁質 有限公司
MIDI Aluminium Fabricator Ltd.

工程號 J852 地盤 亞答老街

送地盤

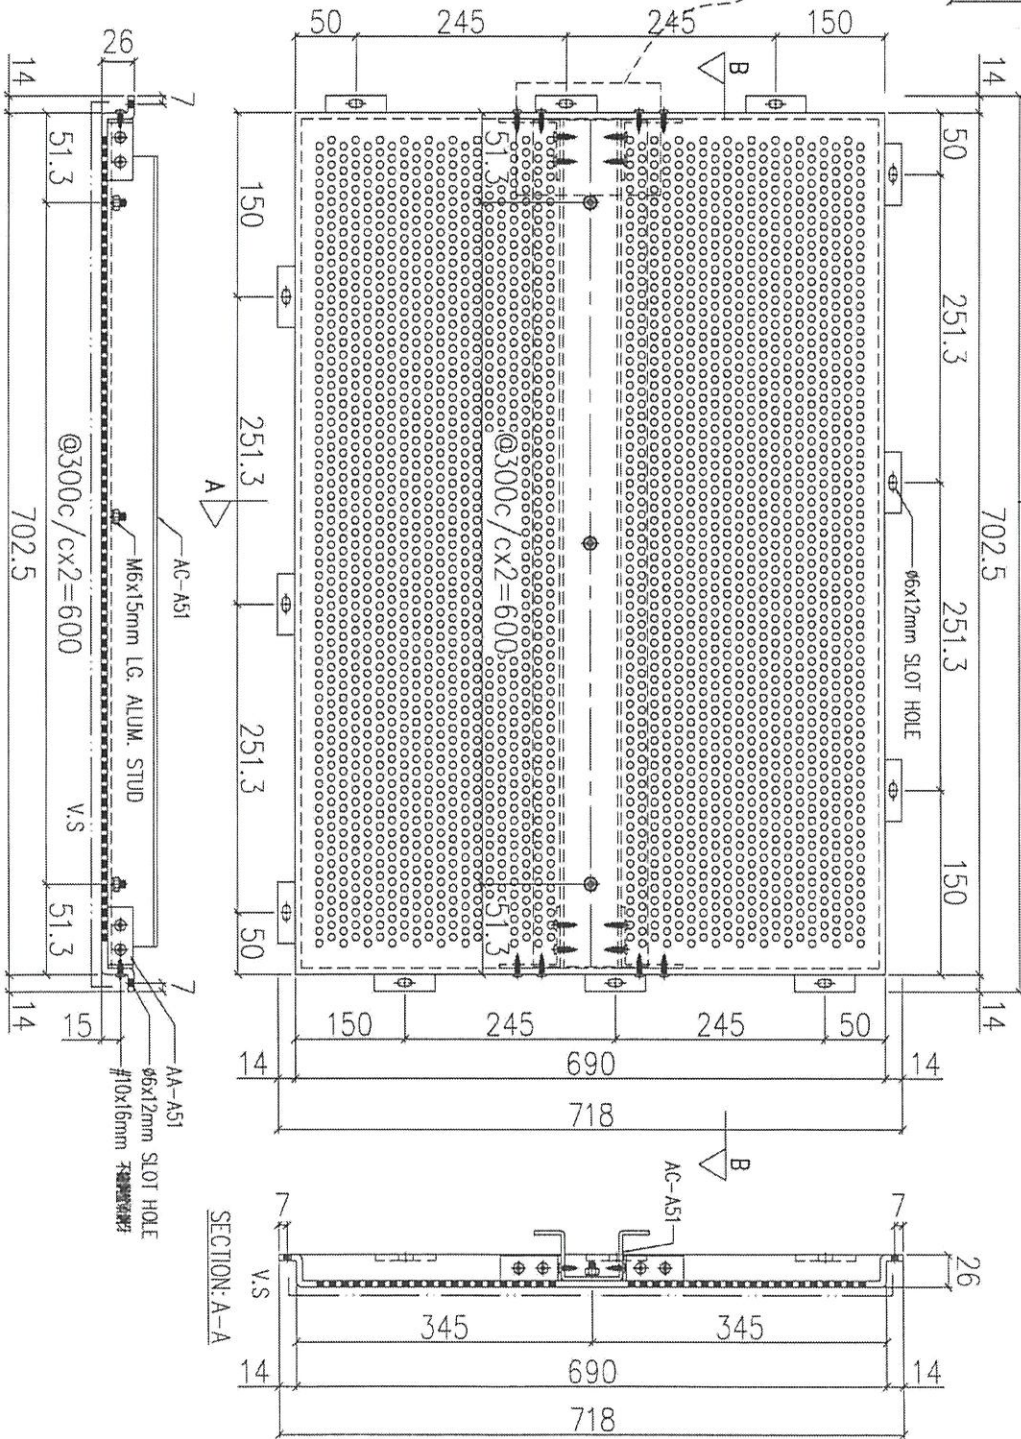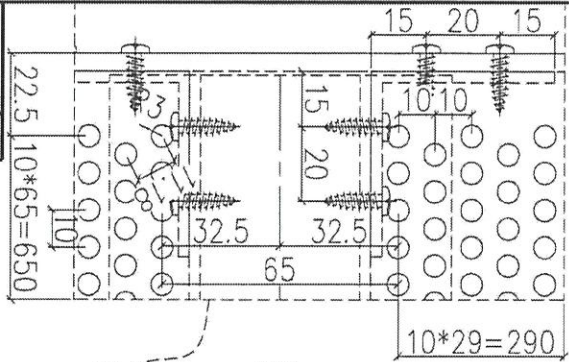

Handwritten notes in blue ink: "3/24" and "4/24".

序號	物料編號	數量	使用位置	樓層
01	T1-ACD-A52	36	見派位圖	1F~21F
02	T2-ACD-A52	36	見派位圖	1F~21F
03	T3-ACD-A52	36	見派位圖	1F~21F


名稱	鋁板加工圖	制圖	LHR	2021.03.08	修改
材料	5mm THK. ALUM. CLADDING	復核	-	-	日期
顏色	FN090M	批准			圖號
					J852-ACA-ACD-A52



美特鋁質 有限公司
MIDI Aluminium Fabricator Ltd.


工程號 J852 地盤 亞答老街

送地盤

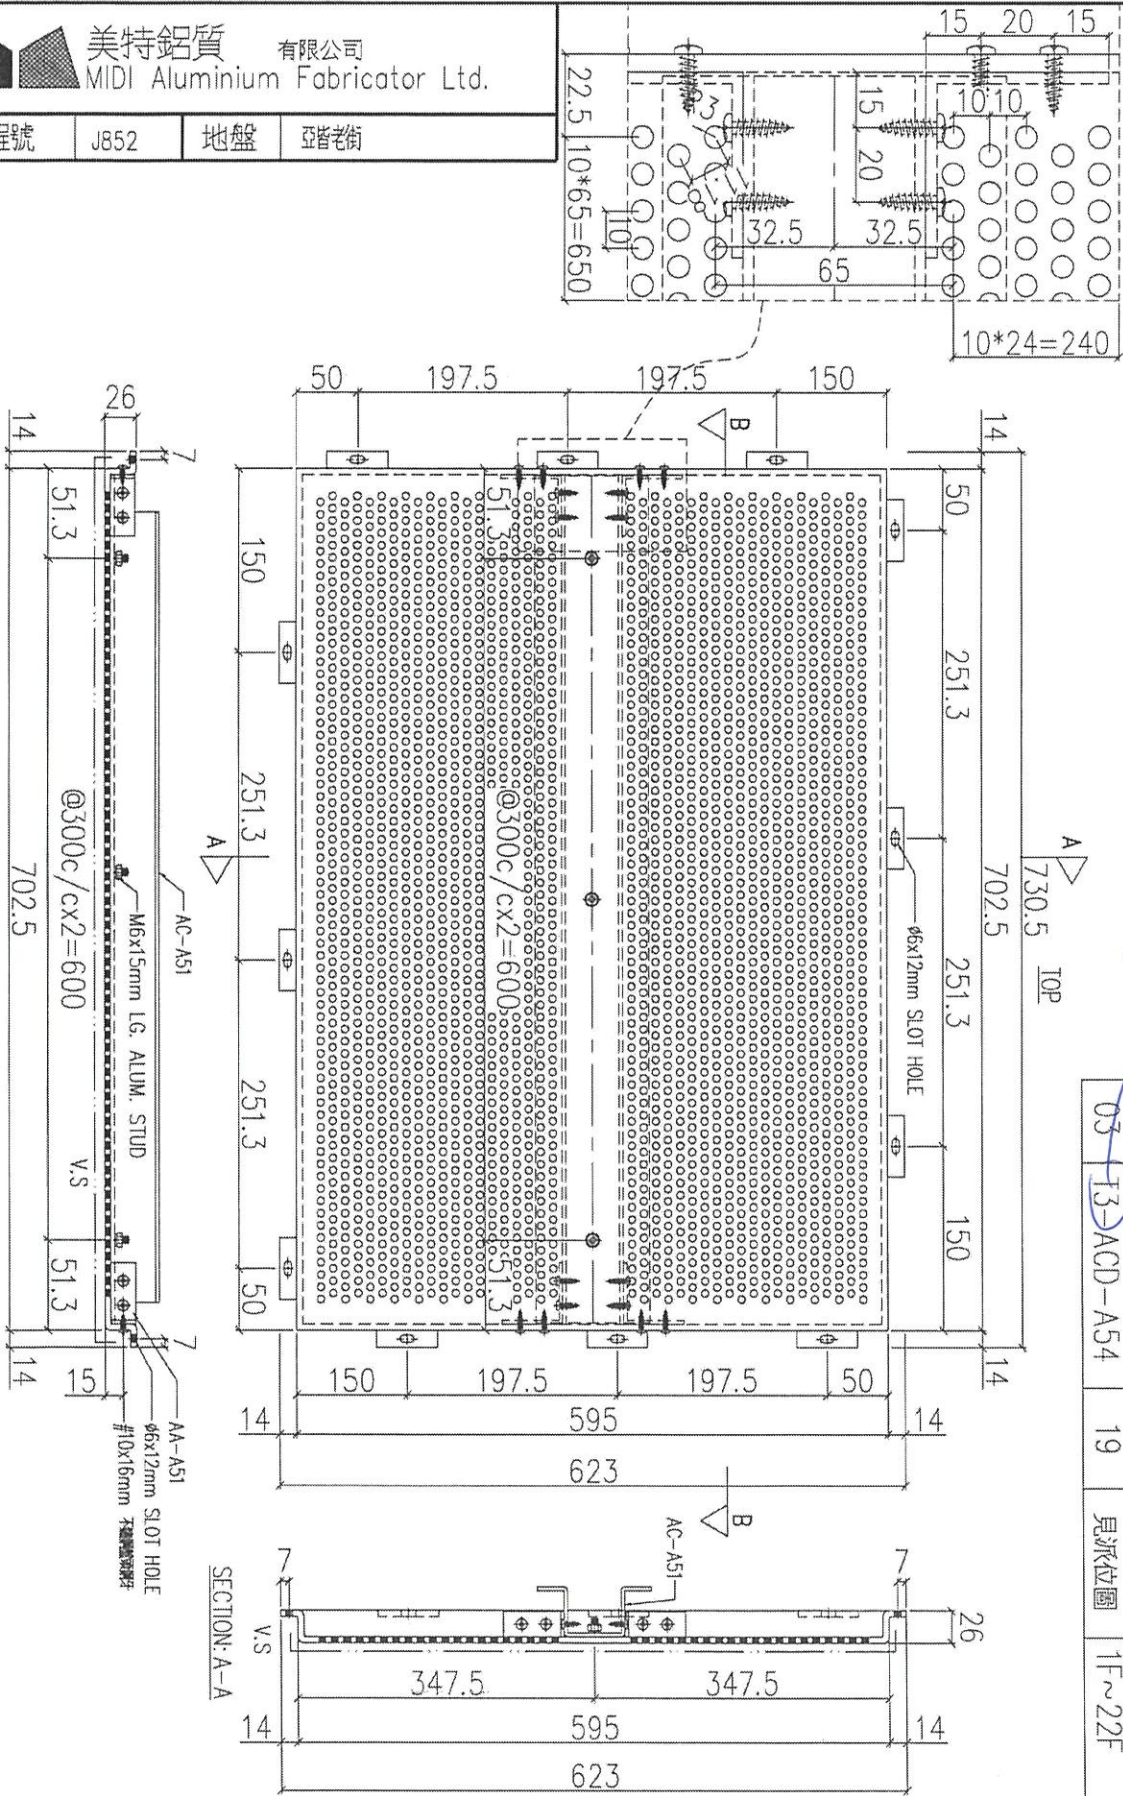

序號	物料編號	數量	使用位置	樓層
01	T1-ACD-A54	19	見派位圖	1F~22F
02	T2-ACD-A54	19	見派位圖	1F~22F
03	T3-ACD-A54	19	見派位圖	1F~22F


名稱	鋁板加工圖	制圖	LHR	2021.03.08	修改
材料	5mm THK. ALUM. CLADDING	復核	-	-	日期
顏色	FN090M	批准			圖號
					J852-ACA-ACD-A54

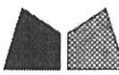

美特鋁質 有限公司
MIDI Aluminium Fabricator Ltd.

工程號 J852 地盤 亞答老街


送地盤

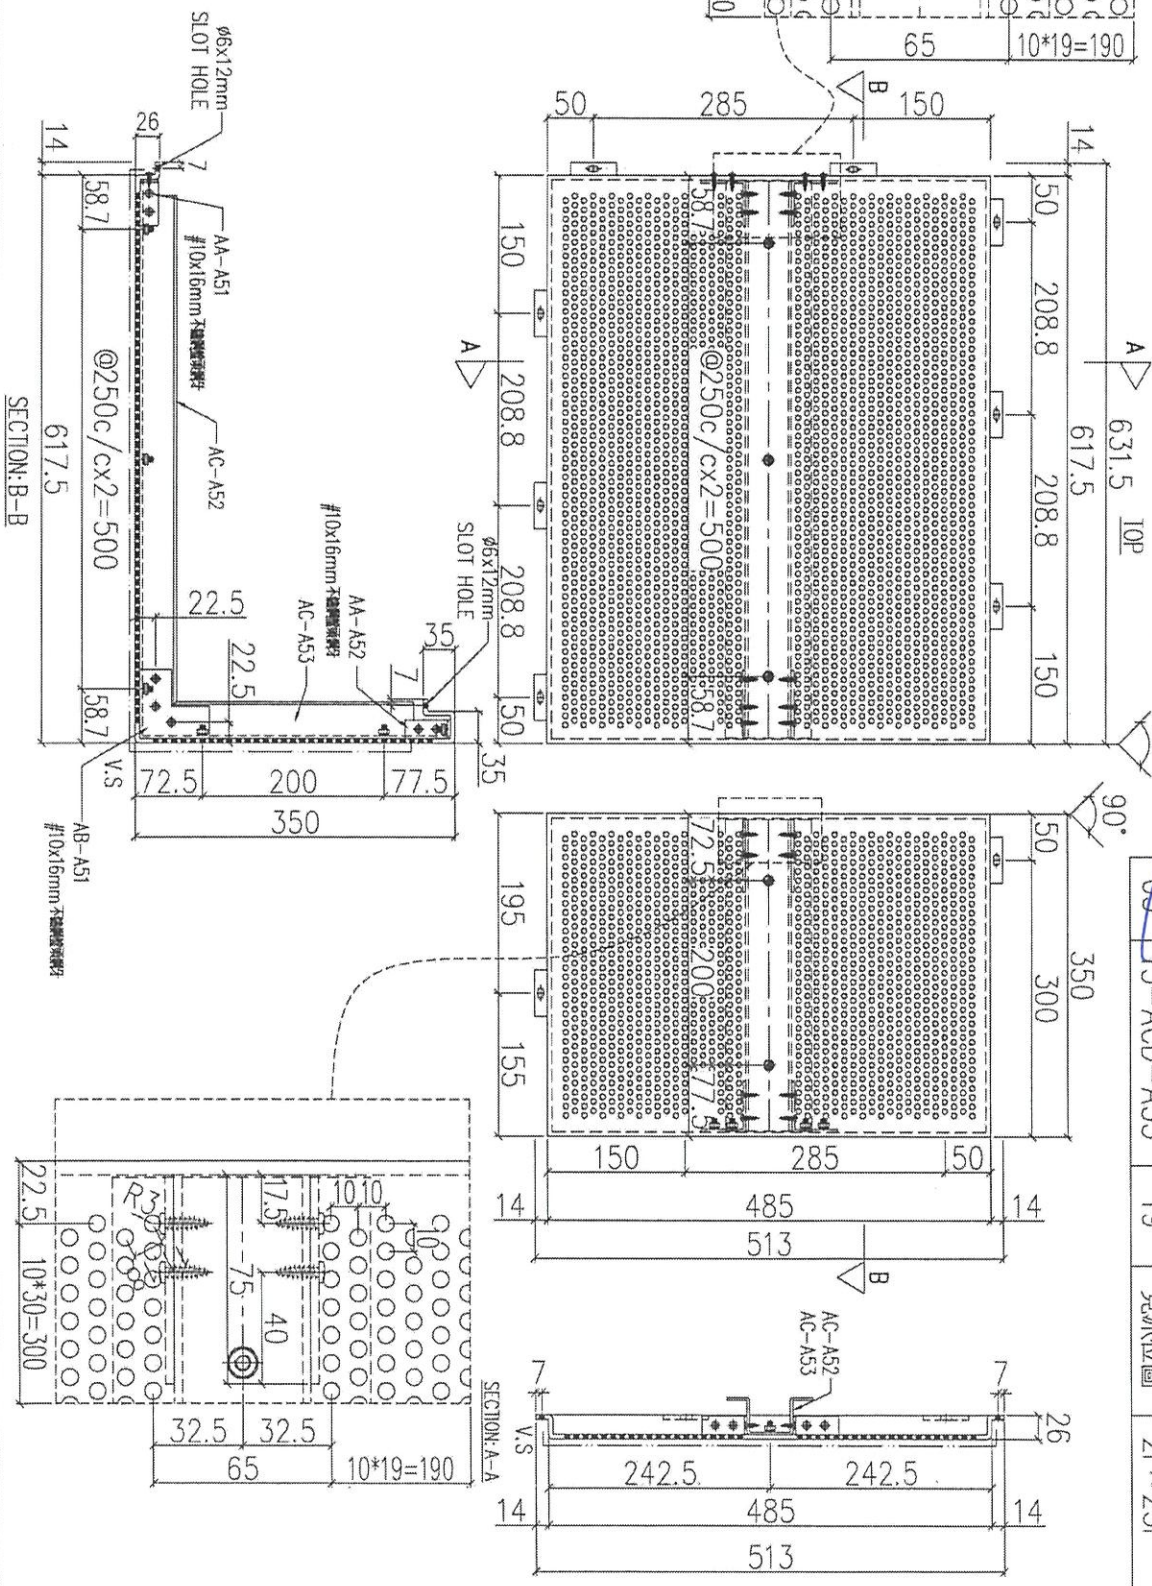

Handwritten notes in blue ink: "214" and a signature.

序號	物料編號	數量	使用位置	樓層
01	T1-ACD-A55	19	見派位圖	2F~23F
02	T2-ACD-A55	19	見派位圖	2F~23F
03	J3-ACD-A55	19	見派位圖	2F~23F


名稱	鋁板加工圖	制圖	LHR	2021.03.08	修改
材料	5mm THK. ALUM. CLADDING	復核	-	-	日期
顏色	FN090M	批准			圖號 J852-ACA-ACD-A55

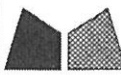

美特鋁質 有限公司
MIDI Aluminium Fabricator Ltd.

工程號 J852 地盤 亞答老街


送地盤

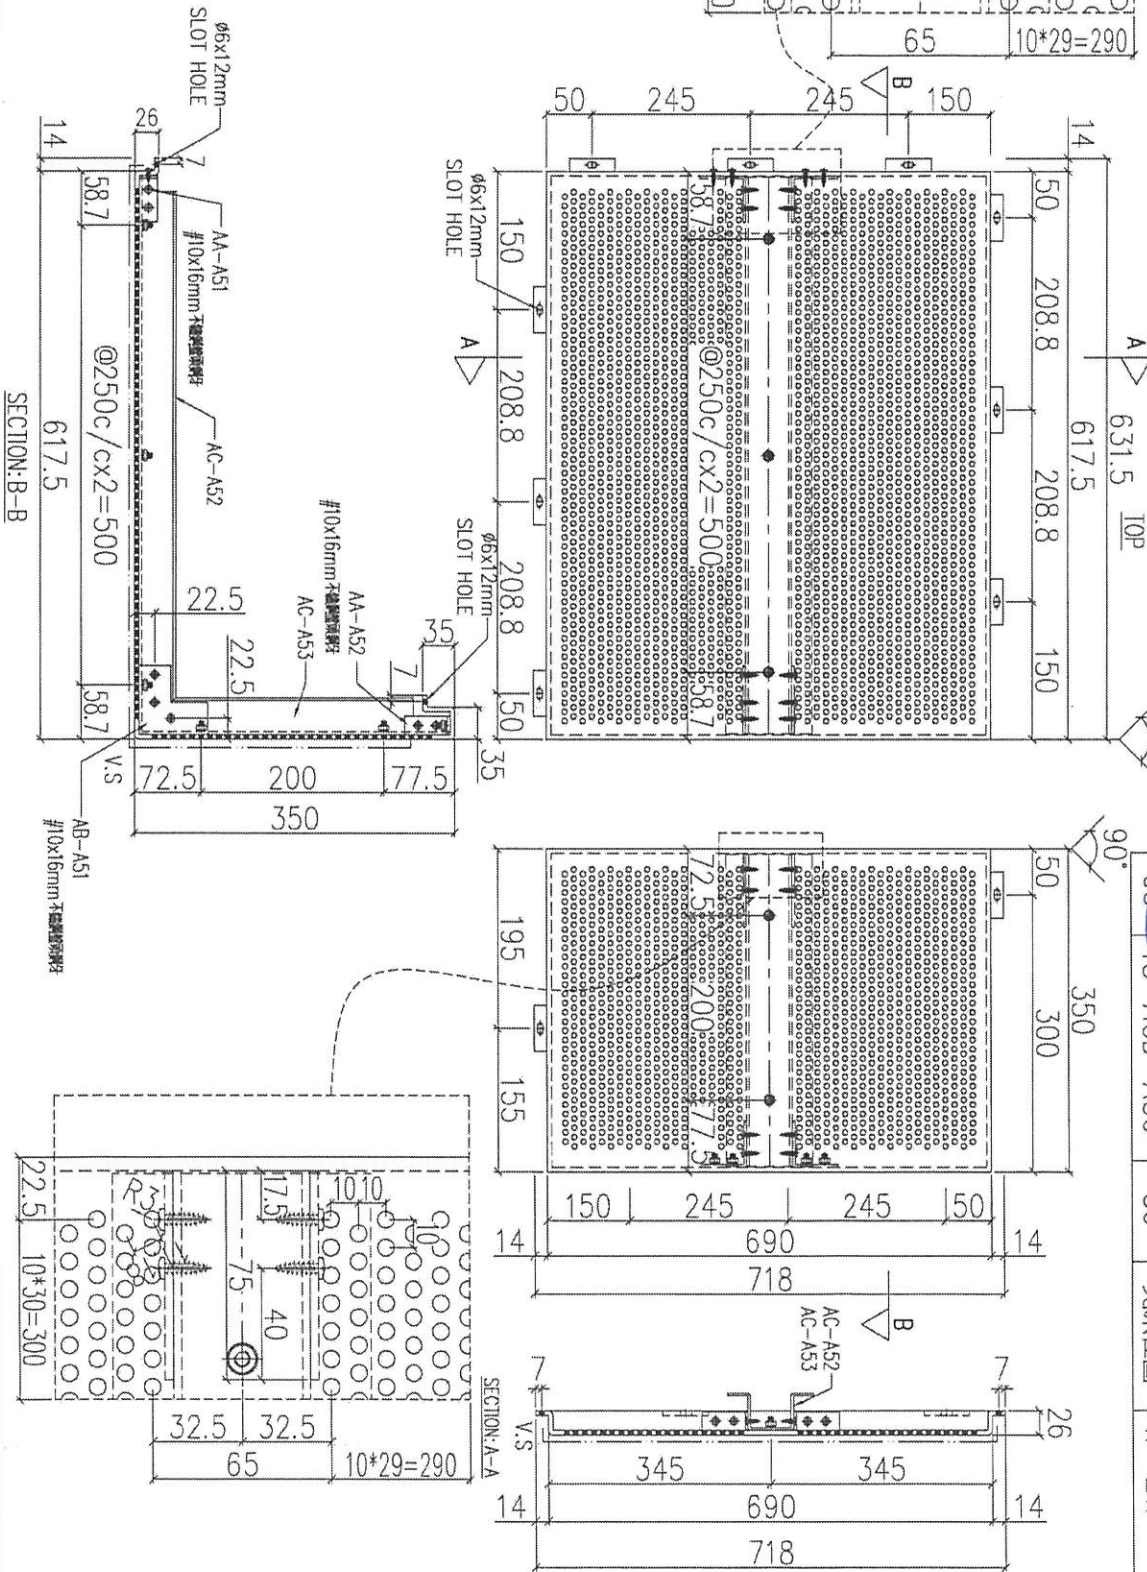

序號	物料編號	數量	使用位置	樓層
01	T1-ACD-A56	36	見派位圖	1F~21F
02	T2-ACD-A56	36	見派位圖	1F~21F
03	T3-ACD-A56	36	見派位圖	1F~21F

Handwritten notes in blue ink:
K 2/2
4/4


名稱	鋁板加工圖	制圖	LHR	2021.03.08	修改
材料	5mm THK. ALUM. CLADDING	復核	-	-	日期
顏色	FN090M	批准			圖號 J852-ACA-ACD-A56

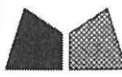

美特鋁質 有限公司
MIDI Aluminium Fabricator Ltd.

工程號 J852 地盤 亞答老街

送地盤

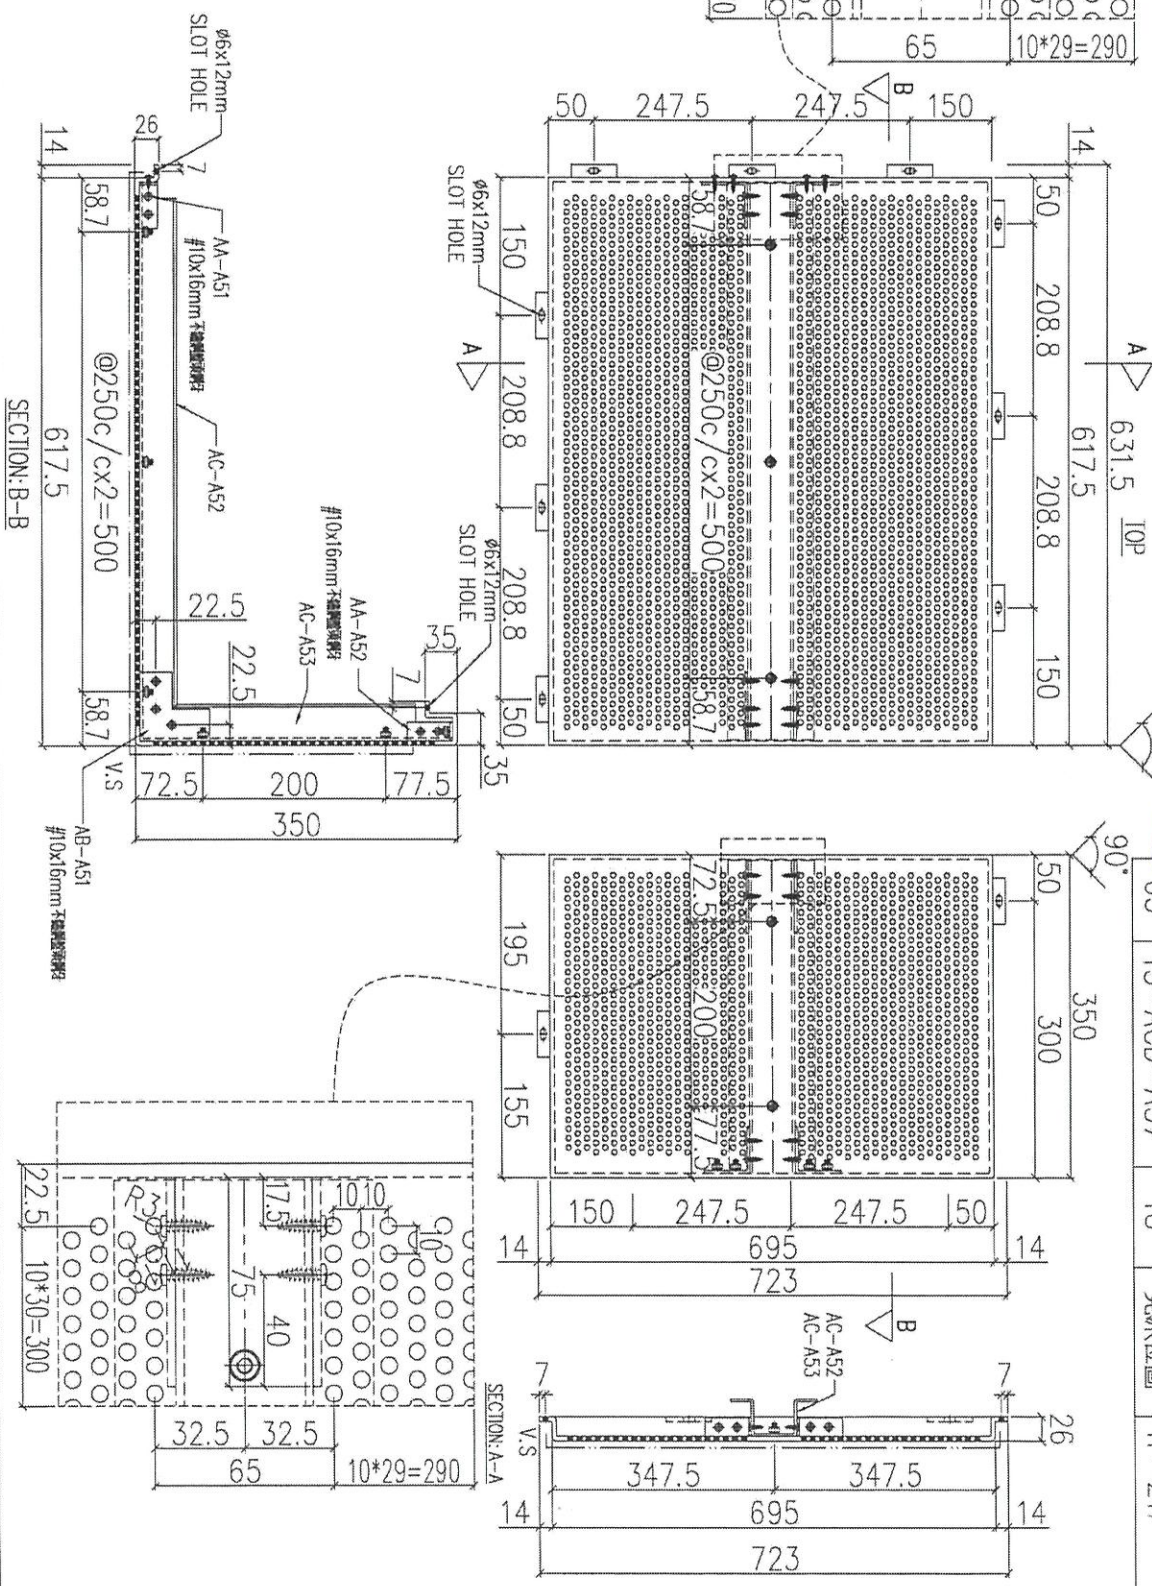


序號	物料編號	數量	使用位置	樓層
01	T1-ACD-A57	18	見派位圖	1F~21F
02	T2-ACD-A57	18	見派位圖	1F~21F
03	T3-ACD-A57	18	見派位圖	1F~21F

名稱	鋁板加工圖	制圖	LHR	2021.03.08	修改
材料	5mm THK. ALUM. CLADDING	復核	-	-	日期
顏色	FN090M	批准			圖號
					J852-ACA-ACD-A57



美特鋁質 有限公司
MIDI Aluminium Fabricator Ltd.

工程號	J852	地盤	亞皆老街
-----	------	----	------

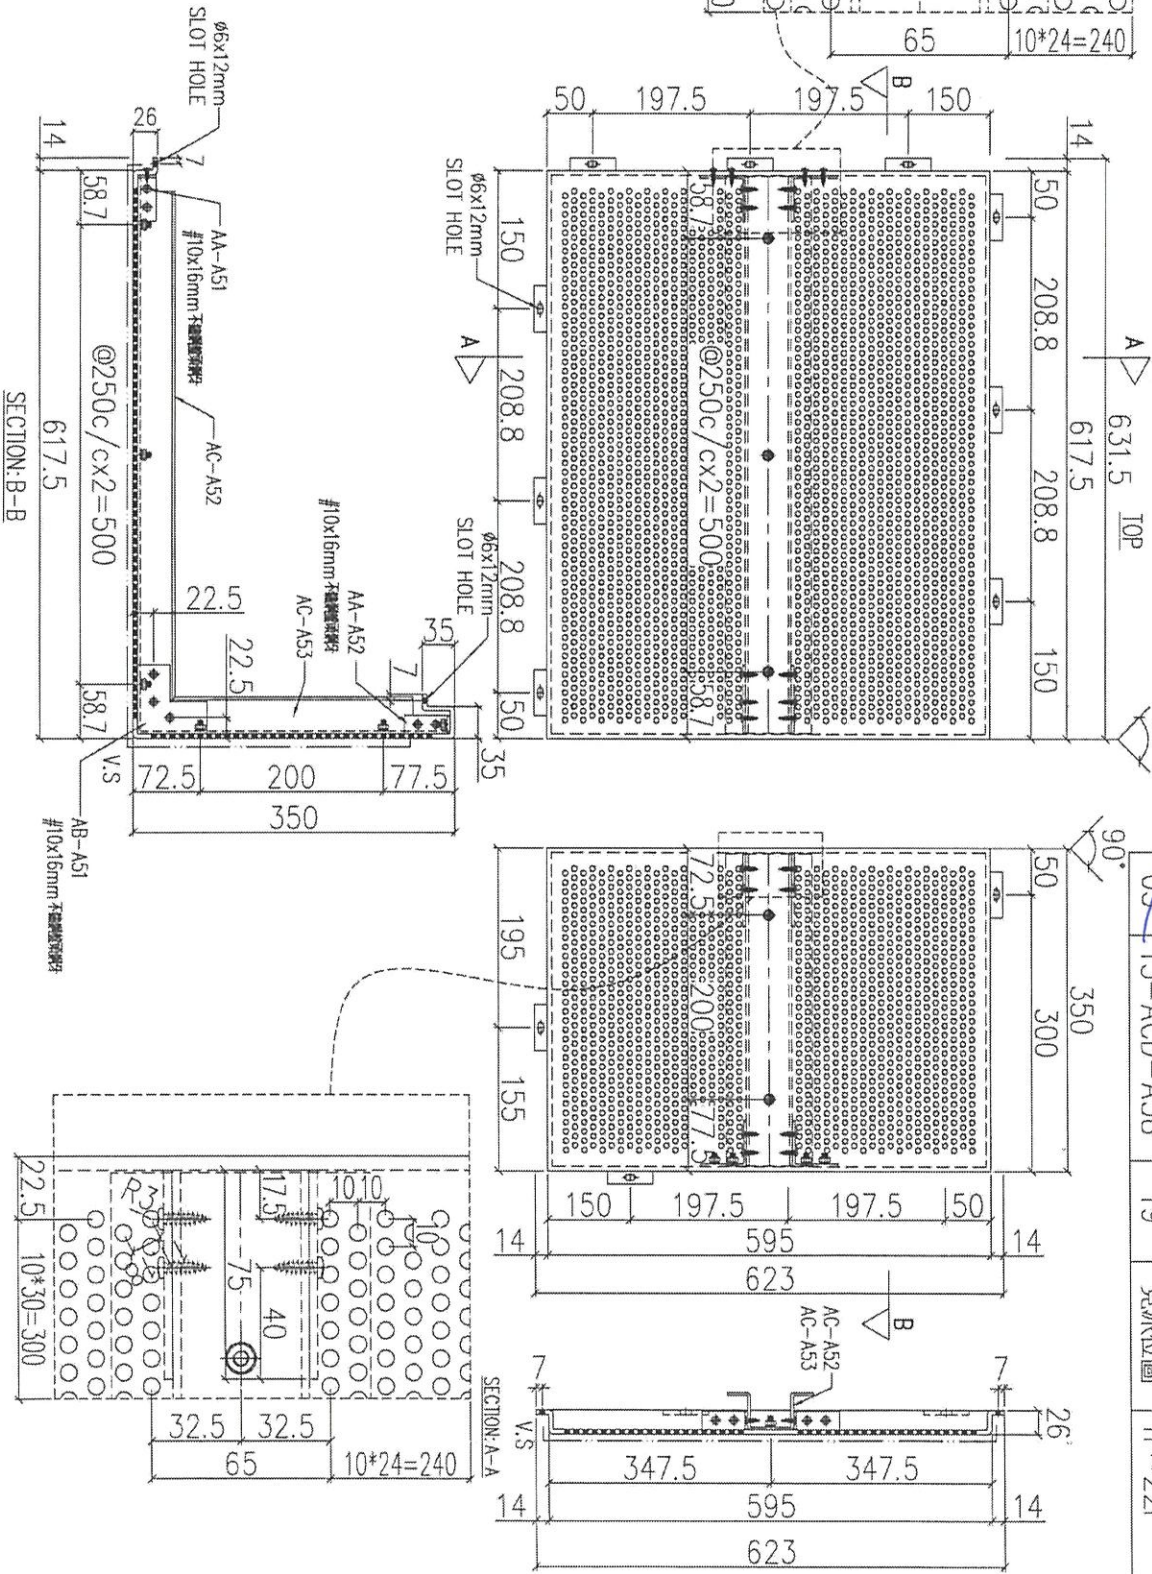

Handwritten notes in blue ink: 2/4

序號	物料編號	數量	使用位置	樓層
01	T1-ACD-A58	19	見派位圖	1F~22F
02	T2-ACD-A58	19	見派位圖	1F~22F
03	T3-ACD-A58	19	見派位圖	1F~22F

名稱	鋁板加工圖	制圖	LHR	2021.03.08	修改
材料	5mm THK. ALUM. CLADDING	復核	-	-	日期
顏色	FNO90M	批准			圖號
					J852-ACA-ACD-A58