



工程指示 / 要求簡箋(E.I.)

工程指示編號：EI / 3181 / 21

修改版次：B

工程編號：J - 852

工程名稱：亞皆老街中電

工程項目：幕牆 地盤用玻璃 B.M. 大貨 (T1-T3) (1-23/F) (468 件)

收件人：Maggie

發件人：Ant Yeung

日期：06/05/2021

要求提供 / 確認 事項：

- () 初步鋁料 B.M.
- () 加工拆圖，然後生產
- () 尺寸表
- () 正式鋁料 B.M.
- () 技術上資料 / 指示
- () 報價
- () 配件 B.M.
- () 樣辦或貨品說明書
- () 分判合約

內容：

(GL02)

B 版：放行死牆玻璃訂購，玻璃已批 D21010042 款(見附相)

A 版：本司和判頭也已同意確認包箱方法，無位置暫存，必須是分座分層。

A 版：GL02 死牆玻璃和 GL04 安全玻璃是暫停的。

A 版：所有保護按 EI3234 。

請按 BM 訂購 T1-T3 (1-23/F)幕牆用玻璃 (共 468 件) (T1: 158 件. T2: 158 件. T3: 152 件)直送地盤。

包裝要分座分層.* T3 優先出貨

IGU 膠用 DC983 結構膠

玻璃要做熱浸。 Low-E: SEE0-83T.

請留意玻璃加工時不要固定的鋼化及熱浸標籤。玻璃出貨時需加上"可移除" 標籤。

單片：標籤在室外面 (注明半鋼化/ 鋼化); IGU：標籤在室內外面 (注明半鋼化/ 鋼化)

請在 2021.05.24 前完成上列要求。

附：3 頁 BM+3 頁參考 BM+2 頁派位圖+4 頁加工圖

以上項目為：

- 原合約工程包
- 原合約工程加 / 減賬
- 新工程報價

原因：-

分發東莞各部門：

- () 生產技術總監口連附件
- () 技術部 口連附件
- () 生產部 口連附件
- () 機械設計部口連附件
- () 採購部 口連附件
- () 生產統籌部口連附件
- () 小羅&清 口連附件
- () 質檢部 口連附件
- () 會計部 口連附件
- () 報關組 口連附件
- () 其他 楊榮輝 口連附件

分發其他分判：


- (v) 水洪 口連附件


分發香港各部門：


- () 行政部口連附件
- () 會計部口連附件
- () 統籌部口連附件
- () 工程部地盤科文口連附件
- () 採購部口連附件
- () QS 部 口連附件
- () 維修部口連附件
- () 其他 祥哥 口連附件

傳遞編號：


發件人簽署：



 美特鋁質 有限公司 MIDI Aluminium Fabricator Ltd.		工程號:	J852	計算:	LHR	日期:	2021.02.22	送呈:		
		地盤名稱:		核對:	wsh	日期:	2021.02.23	副本:		
地盤用玻璃B.M.表		項目類別:	幕牆 (T1-1~23F)	批准:		日期:		A/C Code:		
BM編號:		修改版次:	A(2021.03.12)	總計玻璃面積 (平方米):		124.69				
序號	修改內容	玻璃編號	顏色與類型	厚度 (mm)	玻璃尺寸		數量 (塊)	總面積 (平方米)	使用位置	加工圖參考
					寬度 (W mm)	高度 (H mm)				
01	A-搭位18mm	GL01-T1-T01	8mm+12mm AIR GAP+10mm THK. I.G.U.	30.0	713.0	1123.0	18	14.41	生窗位(1~21/F)	GL01-01
02	A-搭位18mm	GL01-T1-T02			713.0	1393.0	2	1.99	生窗位(22,23/F)	
						合計:	20	16.40		
03	A-搭位18mm	GL01-T1-F01	8mm+12mm AIR GAP+10mm THK. I.G.U.	30.0	916.0	1246.0	18	20.54	大梗窗位(1~21/F)	GL01-01
04	A-搭位18mm	GL01-T1-F04			916.0	1516.0	2	2.78	大梗窗位(22,23/F)	
05	A-搭位18mm	GL01-T1-F02			916.0	656.0	19	11.42	梗窗位(2/F,7~23/F)	
06	A-搭位18mm	GL01-T1-F03			836.0	656.0	19	10.42	梗窗位(2/F,7~23/F)	
07	A-搭位18mm	GL01-T1-F05			916.0	806.0	1	0.74	梗窗位(1/F)	
08	A-搭位18mm	GL01-T1-F06			836.0	806.0	1	0.67	梗窗位(1/F)	
						合計:	60	46.57		
09	B放行,修改尺寸	GL02-T1-F01	10mm THK. HEAT STRENGTHENED GLASS	10.0	906.0	976.0	19	16.80	上格間牆位(2~23/F)	GL02-01
10	B放行,修改尺寸	GL02-T1-F02			826.0	976.0	19	15.32	上格間牆位(2~23/F)	
						合計:	38	32.12		
11	A暫停	GL04-T1-T01	10mm THK. TEMPERED GLASS (PROTECTIVE BARRIER)	10.0	766.0	163.0	20	2.50	生窗欄河位(1~23/F)	GL04-01
						合計:	20	2.50		
12	A-搭位14mm	GL05-T1-FD01	6mm THK. HEAT STRENGTHENED GLASS+12mm AIR GAP+8mm THK. TEMPERED GLASS I.G.U	26.0	588.0	2278.0	18	24.11	FD門位(1~21/F)	GL05-01
13	A-搭位14mm	GL05-T1-FD02			588.0	2548.0	2	3.00	FD門位(22,23/F)	
						合計:	20	27.11		
						總合計:	158	124.7		
加工注意事項:		1).本表中之所有玻璃顏色待定。								
		2).本表中所有玻璃對角線尺寸偏差要求不超過負2mm。								
		3).本表中玻璃要求粗磨邊處理並倒棱角，而所有玻璃之入爐方向需保持一致。								
		4).本表中所有玻璃成品均需做雙面保護，用透明靜電膠紙加四周一寸FK白膠紙做雙面加固保護處理。								
		5).本表中所有玻璃成品均需注明室內外及其玻璃編號，以便識別。								

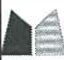 美特鋁質 有限公司 MIDI Aluminium Fabricator Ltd.		工程號:	J852	計算:	LHR	日期:	2021.02.22	送呈:		
		地盤名稱:		核對:	wsh	日期:	2021.02.23	副本:		
地盤用玻璃B.M.表		項目類別:	幕牆 (T2-1~23F)	批准:		日期:		A/C Code:		
BM編號:		修改版次:	A(2021.03.12)	總計玻璃面積 (平方米):		124.69				
序號	修改內容	玻璃編號	顏色與類型	厚度 (mm)	玻璃尺寸		數量 (塊)	總面積 (平方米)	使用位置	加工圖參考
					寬度 (W mm)	高度 (H mm)				
01	A-搭位18mm	GL01-T2-T01	8mm+12mm AIR GAP+10mm THK. I.G.U.	30.0	713.0	1123.0	18	14.41	生窗位(1~21/F)	GL01-01
02	A-搭位18mm	GL01-T2-T02			713.0	1393.0	2	1.99	生窗位(22,23/F)	
						合計:	20	16.40		
03	A-搭位18mm	GL01-T2-F01	8mm+12mm AIR GAP+10mm THK. I.G.U.	30.0	916.0	1246.0	18	20.54	大梗窗位(1~21/F)	GL01-01
04	A-搭位18mm	GL01-T2-F04			916.0	1516.0	2	2.78	大梗窗位(22,23/F)	
05	A-搭位18mm	GL01-T2-F02			916.0	656.0	19	11.42	梗窗位(2~23/F)	
06	A-搭位18mm	GL01-T2-F03			836.0	656.0	19	10.42	梗窗位(2~23/F)	
07	A-搭位18mm	GL01-T2-F05			916.0	806.0	1	0.74	梗窗位(1/F)	
08	A-搭位18mm	GL01-T2-F06			836.0	806.0	1	0.67	梗窗位(1/F)	
						合計:	60	46.57		
09	B放行.修改尺寸	GL02-T2-F01	10mm THK. HEAT STRENGTHENED GLASS	10.0	906.0	976.0	19	16.80	上格間牆位(2~23/F)	GL02-01
10	B放行.修改尺寸	GL02-T2-F02			826.0	976.0	19	15.32	上格間牆位(2~23/F)	
						合計:	38	32.12		
11	A暫停	GL04-T2-T01	10mm THK. TEMPERED GLASS (PROTECTIVE BARRIER)	10.0	766.0	163.0	20	2.50	生窗欄河位(1~23/F)	GL04-01
						合計:	20	2.50		
12	A-搭位14mm	GL05-T2-FD01	6mm THK. HEAT STRENGTHENED GLASS+12mm AIR GAP+8mm THK. TEMPERED GLASS I.G.U	26.0	588.0	2278.0	18	24.11	FD門位(1~21/F)	GL05-01
13	A-搭位14mm	GL05-T2-FD02			588.0	2548.0	2	3.00	FD門位(22,23/F)	
						合計:	20	27.11		
						總合計:	158	124.7		
加工注意事項:		1).本表中之所有玻璃顏色待定。								
		2).本表中所有玻璃對角線尺寸偏差要求不超過負2mm。								
		3).本表中玻璃要求粗磨邊處理並倒棱角，而所有玻璃之入爐方向需保持一致。								
		4).本表中所有玻璃成品均需做雙面保護，用透明靜電膠紙加四周一寸FK白膠紙做雙面加固保護處理。								
		5).本表中所有玻璃成品均需注明室內外及其玻璃編號，以便識別。								

 美特鋁質 有限公司 MIDI Aluminium Fabricator Ltd.		工程號:	J852	計算:	LHR	日期:	2021.02.22	送呈:		
		地盤名稱:		核對:	wsh	日期:	2021.02.23	副本:		
地盤用玻璃B.M.表		項目類別:	幕牆 (T3-1~3F, 6~23F)	批准:		日期:		A/C Code:		
BM編號:		修改版次:	A(2021.03.12)	總計玻璃面積 (平方米):		118.52				
序號	修改內容	玻璃編號	顏色與類型	厚度 (mm)	玻璃尺寸		數量 (塊)	總面積 (平方米)	使用位置	加工圖參考
					寬度 (W mm)	高度 (H mm)				
01	A-搭位18mm	GL01-T3-T01	8mm+12mm AIR GAP+10mm THK. I.G.U.	30.0	713.0	1123.0	17	13.61	生窗位(1~3/F,6~21/F)	GL01-01
02	A-搭位18mm	GL01-T3-T02			713.0	1393.0	2	1.99	生窗位(22,23/F)	
					合計:		19	15.60		
03	A-搭位18mm	GL01-T3-F01	8mm+12mm AIR GAP+10mm THK. I.G.U.	30.0	916.0	1246.0	17	19.40	大梗窗位(1~3/F,6~21/F)	GL01-01
04	A-搭位18mm	GL01-T3-F04			916.0	1516.0	2	2.78	大梗窗位(22,23/F)	
05	A-搭位18mm	GL01-T3-F02			916.0	656.0	19	11.42	梗窗位(1~3/F,6~23/F)	
06	A-搭位18mm	GL01-T3-F03			836.0	656.0	19	10.42	梗窗位(1~3/F,6~23/F)	
					合計:		57	44.02		
07	B放行,修改尺寸	GL02-T3-F01	10mm THK. HEAT STRENGTHENED GLASS	10.0	906.0	976.0	18	15.92	上格間牆位(2~3/F,6~23/F)	GL02-01
08	B放行,修改尺寸	GL02-T3-F02			826.0	976.0	18	14.51	上格間牆位(2~3/F,6~23/F)	
09	B放行,修改尺寸	GL02-T3-F03			906.0	195.0	1	0.18	起底(1/F)	
10	B放行,修改尺寸	GL02-T3-F04			826.0	195.0	1	0.16	起底(1/F)	
					合計:		38	30.77		
11	A暫停	GL04-T3-T01	10mm THK. TEMPERED GLASS (PROTECTIVE BARRIER)	10.0	766.0	163.0	19	2.37	生窗欄河位(1~3/F,6~23/F)	GL04-01
					合計:		19	2.37		
12	A-搭位14mm	GL05-T3-FD01	6mm THK. HEAT STRENGTHENED GLASS+12mm AIR GAP+8mm THK. TEMPERED GLASS I.G.U	26.0	588.0	2278.0	17	22.77	FD門位(1~3/F,6~21/F)	GL05-01
13	A-搭位14mm	GL05-T3-FD02			588.0	2548.0	2	3.00	FD門位(22,23/F)	
					合計:		19	25.77		
					總合計:		152	118.5		
加工注意事項:		1).本表中之所有玻璃顏色待定。								
		2).本表中所有玻璃對角線尺寸偏差要求不超過負2mm。								
		3).本表中玻璃要求粗磨邊處理並倒棱角，而所有玻璃之入爐方向需保持一致。								
		4).本表中所有玻璃成品均需做雙面保護，用透明靜電膠紙加四周一寸FK白膠紙做雙面加固保護處理。								
		5).本表中所有玻璃成品均需注明室內外及其玻璃編號，以便識別。								

EG-DWG4

 藝 杻 跣 斲 鋸 登 鼠 伺 MIDI Aluminium Fabricator Ltd.	??		易 踢?	
	梁?	CJM	2020.09.12	?? ?? GLOZ
党 蛭				?? 講 ?BOM桶
??				奔 离

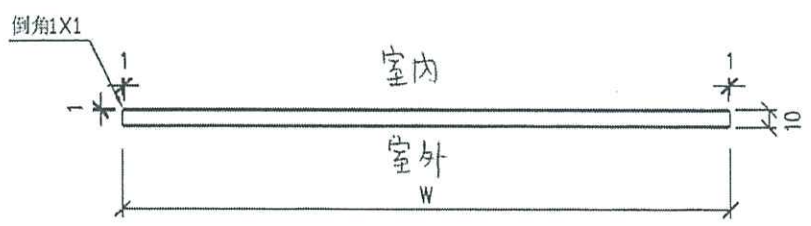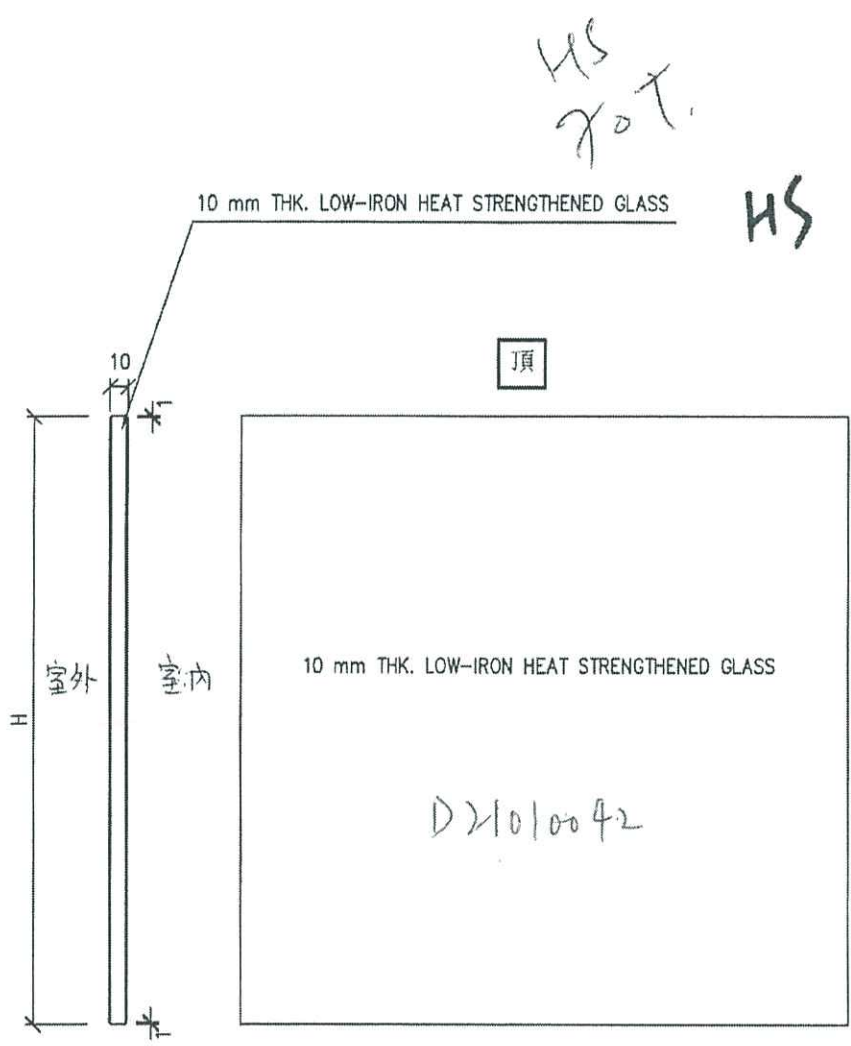

J-852	?? 铝 棧 窗 / GLASS CLADDING	哲 璃	①
10mm 厚 LOW-IRON H.S 玻璃			



美特鋁質有限公司
MIDI ALUMINIUM FABRICATOR LTD.

Our ref. MC/40067/852

1st April 2021

Gammon Engineering & Construction Company Limited
139 - 147 Argyle Street,
Kowloon, Hong Kong

By Email & Hand

Attn.: Mr. Dick Yuen / Ms. Penny Chau

Dear Sir,

Re : Design, Supply & Installation of Aluminium Window & Cladding, Curtain Wall, Glass Wall, Louvers and Glass Balustrade Nominated Sub-Contract at K.I.L. 6038RP, K.I.L.6037RP, K.I.L. 6036RP, K.I.L. 6035RP & K.I.L. 6005, Nos. 139-147 Argyle Street, Kowloon.
Resubmission of Glass Sample Board for Bulk Order - Spandrel Glass of Curtain Wall & Glass Cladding (MS072)

Further to the captioned project, we would like to re-submit Spandrel Glass & Glass Cladding Sample Board for your review and comment.

Glass Sample: 10mm Low-iron Heat Strengthened Glass ^{D21019042} ~~D20070686~~ (10CB)
Back Plate Color: Metallic Bronze UCT201498XL(A)-3
Location: Spandrel Glass of Curtain Wall & Glass Cladding

For details, please refer to the attached photos and glass data.

Thank you for your kind attention.

Yours faithfully,
MIDI ALUMINIUM FABRICATOR LTD.

Marco Tam
Director

Encl

cc. Gammon	- Mr. Chris Kwok / Ms. Myra Li / - Ms. Esther Chung / Ms. Angel Man / - Mr. Jackson Mok / Mr. Sam Tang	(w/e)
Sino	- Mr. Billy Tang / Mr. Jimmy Cheung / - Mr. Terry Wan / Mr. Jaja Wong	(w/e) (Email Only)
AGC	- Mr. Raymond Ho / Mr. Eliot Chan	(w/e) (Email Only)
MFT	- Mr. Brian Leung / Mr. Nigel Lo - Ms. Yoanna Chan / Ms. Cosimo Wong - Mr. Neo Wong	(w/e)

FM/MT/DW/AY/BL/yl



Sample Board for Bulk
Order - Spandrel Glass
of Curtain Wall &
Glass Cladding
(MS072)

Submission Date

01/04/2021

Name:

R. [unclear]

Approval Date

23.4.2021

Signature:

[Signature]

Comments:

Approved and Approved only

Signature Date:

23.4.2021

IAGC
 ARUP
 WOY

AXXA

Jammon

J3860 - Proposed Residential Development, At 139 - 147 Argyle Street, Kowloon

Submission Ref. no.:	MC/ <u>40067</u> /852	Authorized Representative:	<input type="checkbox"/> Pacific Shine	<input type="checkbox"/> MFT
Material Description:	Resubmission of Glass Sample Board for Bulk Order - Spandrel Glass of Curtain Wall & Glass Cladding (MS072)		<input checked="" type="checkbox"/> AGC	<input type="checkbox"/> AXXA
			<input type="checkbox"/> ARUP	<input type="checkbox"/>
			<input type="checkbox"/> WOY	<input type="checkbox"/>
Submission Date:	01/04/2021	Name:		
Approval Date:	24.4.2021	Signature:		
Comment:	Approval on Attendance only.	Signature/Date:		