

工程指示 / 要求簡箋(E.I.)

工程指示編號：EI / 3338 / 21

修改版次：-

工程編號：J - 852

工程名稱：亞皆老街中電

工程項目：百葉 石紋色報價(後樓梯、機房)

收件人：生統

發件人：Ant Yeung

日期：28/04/2021

要求提供 / 確認 事項：

- | | | |
|------------------------------------|-------------------------------------|-------------------------------|
| <input type="checkbox"/> 初步鋁料 B.M. | <input type="checkbox"/> 加工拆圖，然後生產 | <input type="checkbox"/> 尺寸表 |
| <input type="checkbox"/> 正式鋁料 B.M. | <input type="checkbox"/> 技術上資料 / 指示 | <input type="checkbox"/> 報價 |
| <input type="checkbox"/> 配件 B.M. | <input type="checkbox"/> 樣辦或貨品說明書 | <input type="checkbox"/> 分判合約 |
| <input type="checkbox"/> 其他：_____ | | |

內容：

請按附件提供資料報價，後樓梯、機房百葉需改用石紋色

影響 EI: EI3071, EI3248, EI3259

謝謝 E23260, E23235, E23072 (合計)

請在 2021.05.08 前完成上列要求。

附：5 頁

以上項目為：

- 原合約工程包 原合約工程加 / 減賬 新工程報價

原因：-

分發東莞各部門：

- () 生產技術總監 連附件 () 技術部 連附件 () 生產部 連附件 () 機械設計部 連附件
 () 採購部 連附件 () 生產統籌部 連附件 () 小羅 & 清 連附件
 () 質檢部 連附件 () 會計部 連附件 () 報關組 連附件 () 其他 楊榮輝 連附件

分發其他分判：

- (v) 水洪 連附件

分發香港各部門：

- () 行政部 連附件 () 會計部 連附件 () 統籌部 連附件 () 工程部地盤科文 連附件 祥哥
 () 採購部 連附件 () QS 部 連附件 () 維修部 連附件 () 其他 _____ 連附件

傳遞編號：

HK 0912 / 21

發件人簽署：

項目經理簽署：

2021-4-28

石紋色百葉		no. Floor sub total				Remarks	
	G/F	GF-1	1	1	1	EI3248	
		GF-2	1	1	1	EI3248	
		GF-6	1	1	1	EI3248	
		GF-7	1	1	1	EI3248	
T1	1/F	L01-T1	1	1	1	EI3248	
T2		L01-T2	1	1	1	EI3248	
T3		L01-T3	1	1	1	EI3248	
						7	
T1	1-21/F	L02-T1	1	18	18	EI3071	加工中
T3	1-21/F	L02-T3	1	18	18	EI3071	已到地盆已裝
						36	
	Upper Roof	L03-T1	1	1	1	EI3259	
	Upper Roof	L03-T2	1	1	1	EI3259	
	Upper Roof	L03-T3	1	1	1	EI3259	
						3	
	Upper Roof	L04-T1	2	1	2	EI3259	
	Upper Roof	L04-T2	2	1	2	EI3259	
	Upper Roof	L04-T3	2	1	2	EI3259	
						6	
	23/F	23-L01-T1	1	1	1	EI3248	
	23/F	23-L01-T2	1	1	1	EI3248	
	23/F	23-L01-T3	1	1	1	EI3248	
						3	
					Total	55	

B.D. REF

CLIENT

ARCHITECT :
AGC DESIGN LTD

MAIN CONTRACTOR

Gammon

STRUCTURAL ENGINEER :

ARUP

FACADE CONSULTANT:

MEINHARDT

NOTES:
1. ALL DIMENSIONS ARE IN mm.
2. ALL ELEVATIONS ARE VIEWED FROM OUTSIDE.
3. ALL DIMENSIONS TO BE VERIFIED ON SITE BEFORE FABRICATION.

LEGEND:
① - DETAIL MARK NO.
REF - REFER SHEET NO.
1. F.F.L. --- FINISHED FLOOR LEVEL
2. S.F.L. --- STRUCTURAL FLOOR LEVEL
3. --- REVERSED DETAIL

NO.	DATE	REVISED	BY

JOB NO : J-852

PROJECT :
PROPOSED RESIDENTIAL DEVELOPMENT
AT 139 - 147 ARDYLE STREET,
MK11 6DGS, 6035 R.P., 6036 R.P.,
6037 R.P. & 6038 R.P.


TITLE :
G/F FLOOR PLAN

DATE : 05-FEB-20 SCALE : 1:300

DRAWN BY : MN CHECKED BY : EW

美特铝质有限公司
MIDI ALUMINIUM FABRICATOR LTD.
Units E-B, Surrey Industrial Centre, 1/F
610 Chea Kwo Ling Road, Aokman
Tel: 3489211-4 Fax: (852) 2727866

DWG NO. : J852-SD-W-3000 REV. : -

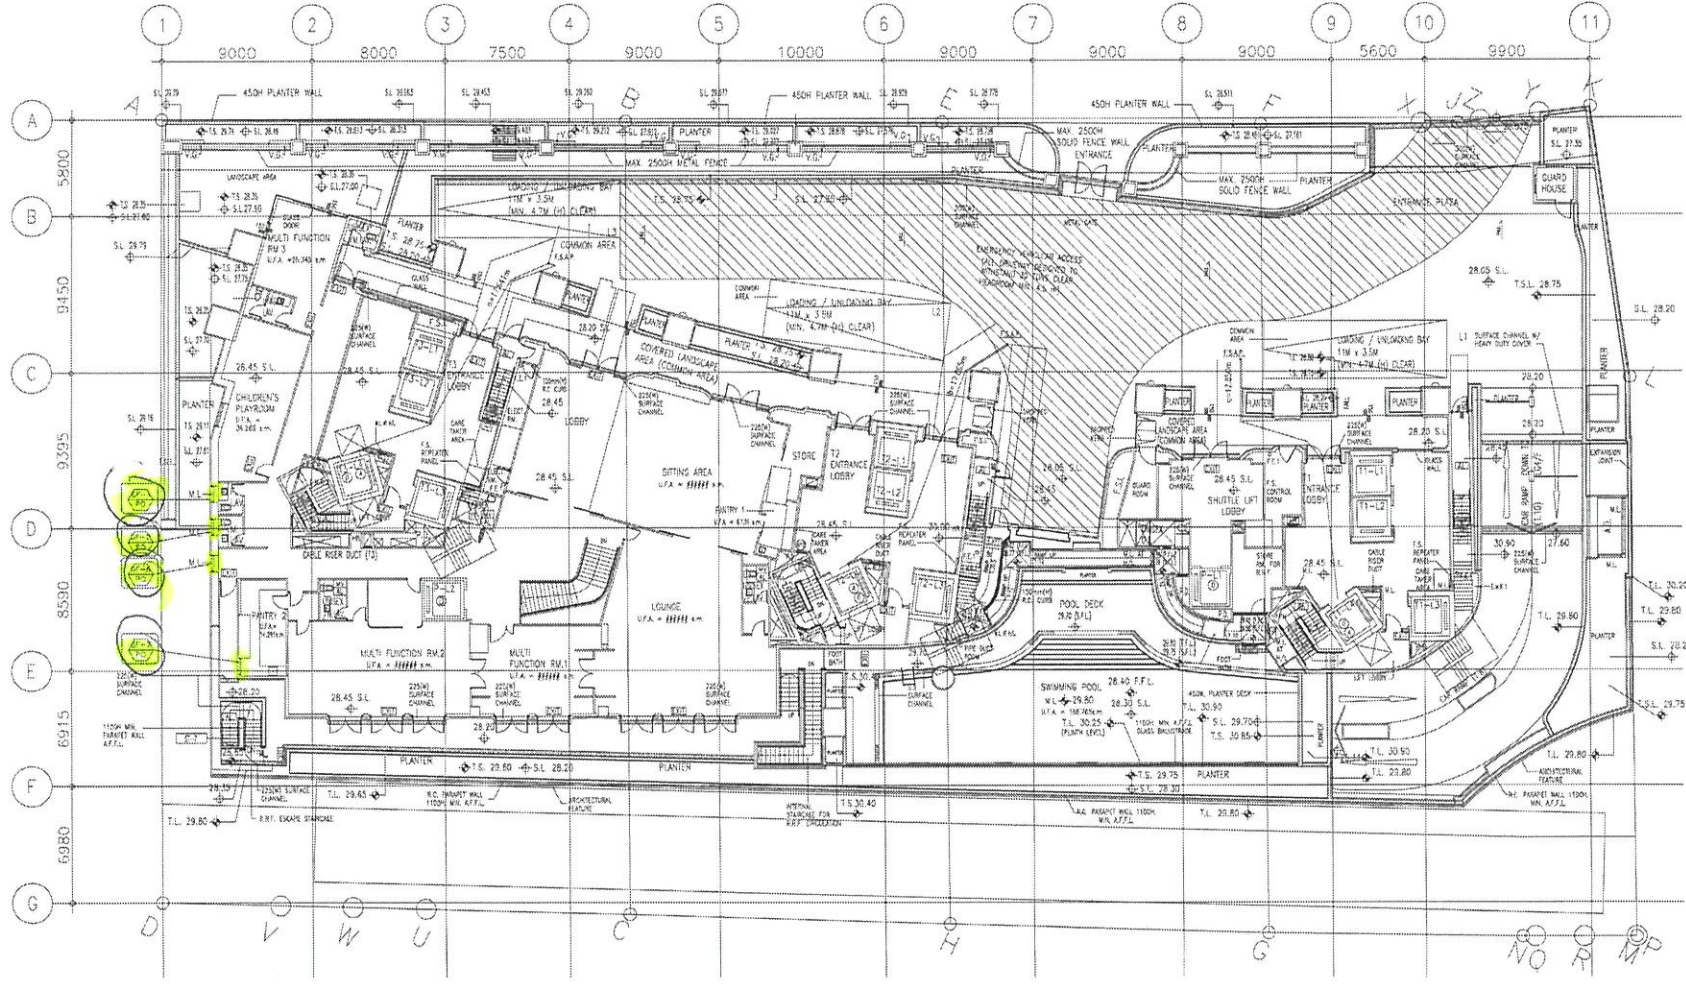

GROUND FLOOR PLAN

SUPERIMPOSED LOAD : 5kPa
NO. OF LOADING/ UNLOADING BAY = 3
(2) x (1) = 3.5M x 15.0M; MINIMUM HEADROOM 4.7M
AUTOMATIC SPRINKLER SYSTEM TO BE PROVIDED
ALL DIMENSIONS REFER TO U4 PLAN UNLESS NOTED OTHERWISE



FIRST FLOOR PLAN

SUPERIMPOSED LOAD : 2.5kPa
 ALL DIMENSIONS SAME AS TYPICAL FLOOR (2/17 TO 21/17) UNLESS OTHERWISE STATED.

B.O. REF :

CLIENT :

ARCHITECT :

AGC DESIGN LTD

MAIN CONTRACTOR :

Gammon

STRUCTURAL ENGINEER :

ARUP

FAÇADE CONSULTANT :

MEINHARDT

NOTE :

1. ALL DIMENSIONS ARE IN MM.
2. ALL ELEVATIONS ARE VIEWED FROM OUTSIDE.
3. ALL DIMENSIONS TO BE VERIFIED ON SITE BEFORE FABRICATION.

LEGEND :

⊗ --- DETAIL MARK NO. --- REFER SHEET NO.

1. F.F.L. --- FINISHED FLOOR LEVEL
2. S.F.L. --- STRUCTURAL FLOOR LEVEL
3. Ⓢ --- REVERSED DETAIL

D	11/03/2021	REVISION SUBJECT TO ARCH COMMENT	Rev
C	22/01/2021	REVISION SUBJECT TO ARCH COMMENT	Rev
B	28/07/2020	REVISION SUBJECT TO ARCH COMMENT	Rev
A	21/04/2020	REVISION SUBJECT TO ARCH COMMENT	Rev
NO.	DATE	REVISED	BY

JOB NO. : J-852

PROJECT :

PROPOSED RESIDENTIAL DEVELOPMENT
 AT 139 - 147 ARGYLE STREET,
 NK11 6QJ, 6QJ5 R.P., 6QJ6 R.P.,
 6QJ7 R.P. & 6QJ8 R.P.

TITLE :

1/F FLOOR PLAN

DATE : 05-FEB-20

SCALE : 1:300

DRAWN BY : MN

CHECKED BY : DW

MIDI ALUMINIUM FABRICATOR LTD.
 Units 6-8, Surrey Industrial Centre, 1/F
 810 Dia Two Ling Road, Kowloon
 Tel: 2348511-4 Fax: (852) 2772858

DWG NO. : JB52-50-IW-3001

REV. D



TOWER 3

TOWER 2

TOWER 1

23/F FLOOR PLAN

B.D. REF :

CLIENT :

ARCHITECT :
AGC DESIGN LTD
ARCHITECTS

MAIN CONTRACTOR :
Gammon

STRUCTURAL ENGINEER :
ARUP

FACADE CONSULTANT :
MEINHARDT

NOTE :
 1. ALL DIMENSIONS ARE IN mm.
 2. ALL ELEVATIONS ARE VIEWED FROM OUTSIDE.
 3. ALL DIMENSIONS TO BE VERIFIED ON SITE BEFORE FABRICATION.


LEGEND :
 X1 — DETAIL MARK NO.
 X001 — REFER SHEET NO.
 1. F.F.L. — FINISHED FLOOR LEVEL
 2. S.F.L. — STRUCTURAL FLOOR LEVEL
 3. (⊖) — REVERSED DETAIL

C	11/02/2021	REVISION SUBJECT TO ARCH/COMMENT	MAN
B	22/02/2021	REVISION SUBJECT TO ARCH/COMMENT	MAN
A	25/08/2020	REVISION SUBJECT TO ARCH/COMMENT	MAN
NO.	DATE	REVISION	BY

JOB NO : J-852
 PROJECT : PROPOSED RESIDENTIAL DEVELOPMENT AT 139 - 147 ARGYLE STREET, NKIL 6005, 6035 R.P., 6036 R.P., 6037 R.P. & 6038 R.P.
 TITLE : 23/F FLOOR PLAN

DATE : 05-FEB-20 SCALE : 1:300
 DRAWN BY : MN CHECKED BY : DW

MIDI ALUMINIUM FABRICATOR LTD.
 英特鋁質有限公司
 Units 6-B, Sunray Industrial Centre, 1/F
 810 Cha Kwo Ling Road, Kowloon
 Tel: 23465211-4 Fax: (852) 27727668
 DWG NO. : J852-S0-W-3004 REV. : C

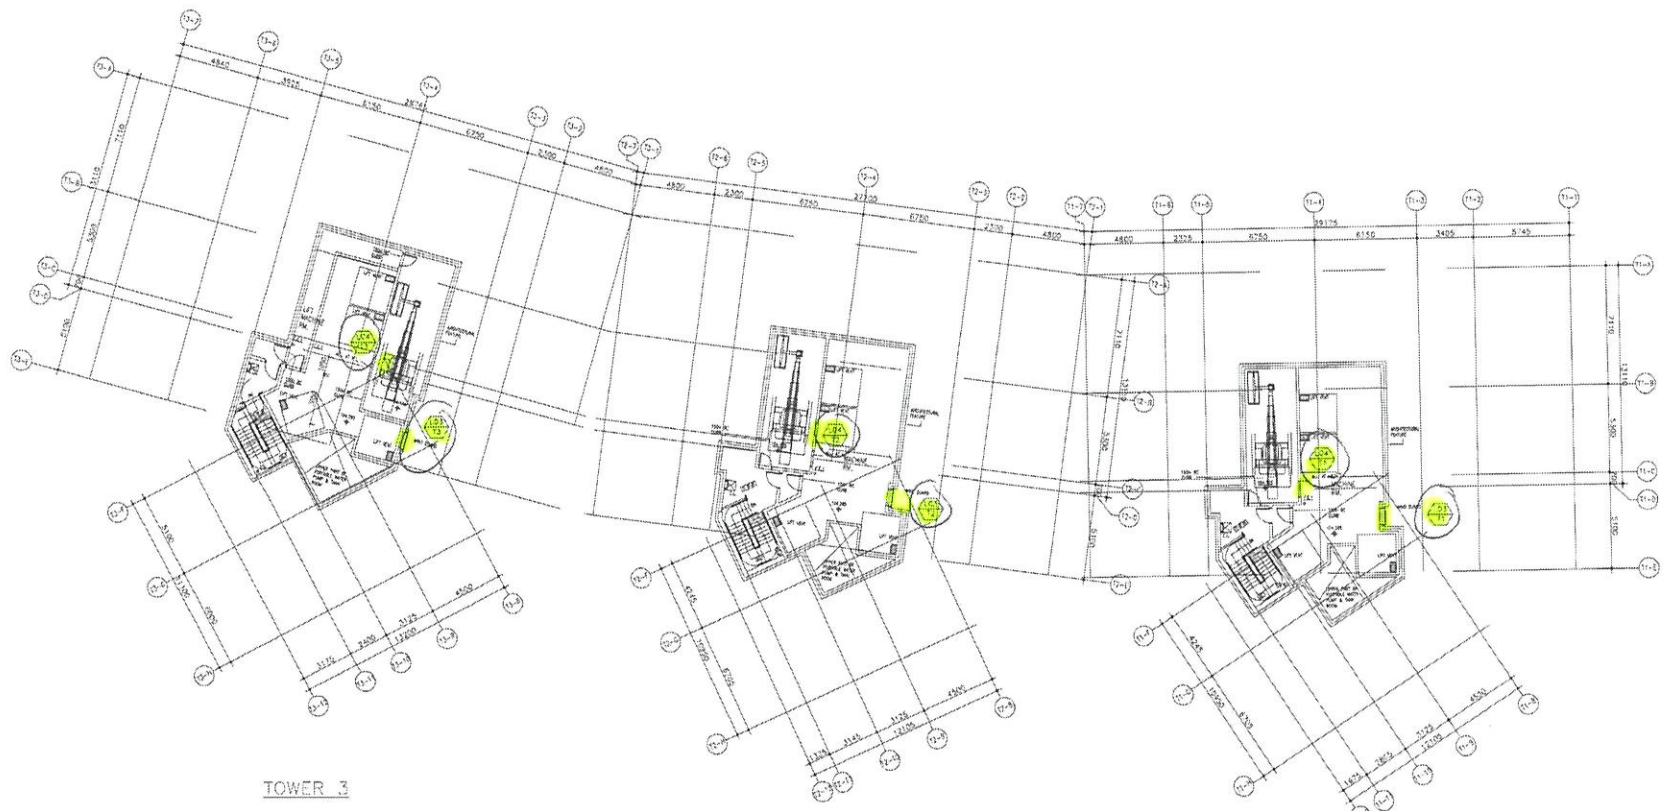

TOWER 3

TOWER 2

TOWER 1

UPPER ROOF FLOOR PLAN

UPERIMPOSED LOAD : 2.5kPa

B.D. REF :

CLIENT :

ARCHITECT :
AGC DESIGN LTD

MAIN CONTRACTOR :
Gammon

STRUCTURAL ENGINEER :
ARUP

FACADE CONSULTANT :
MEINHARDT

NOTE:
 1. ALL DIMENSIONS ARE IN mm.
 2. ALL ELEVATIONS ARE VIEWED FROM OUTSIDE.
 3. ALL DIMENSIONS TO BE VERIFIED ON SITE BEFORE FABRICATION.

LEGEND:
 (X1) --- DETAIL MARK NO.
 (X001) --- REFER SHEET NO.
 1. F.F.L --- FINISHED FLOOR LEVEL
 2. S.F.L --- STRUCTURAL FLOOR LEVEL
 3. (Z) --- REVERSED DETAIL

NO.	DATE	REVISED	BY

JOB NO. : J-852
 PROJECT :
 PROPOSED RESIDENTIAL DEVELOPMENT
 AT 139 - 147 ARGYLE STREET,
 NKHL 6005, 6035 R.P., 6036 R.P.,
 6037 R.P. & 6038 R.P.

TITLE :
 UPPER ROOF FLOOR PLAN

DATE : 05-FEB-20 SCALE : 1:300

DRAWN BY : MN CHECKED BY : DW

MIDI 英特鋁質有限公司
 ALUMINIUM FABRICATOR LTD.
 Units 5-6, Surrey Industrial Centre, 1/7
 610 Chee Koo Ling Road, Kowloon
 Tel: 23488211-4 Fax: 232272666

DWG NO : J552-SD-W-3005 REV. : -