

工程指示 / 要求簡箋(E.I.)

工程指示編號：EI/3397/21

修改版次：

工程編號：J - 852

工程名稱：亞皆老街中電

工程項目：後裝窗 用背板 (W10/T3A) (T3: 21/F)

收件人：生統

發件人：Ant Yeung

日期：12/05/2021

要求提供 / 確認 事項：

- | | | |
|------------------------------------|-------------------------------------|-------------------------------|
| <input type="checkbox"/> 初步鋁料 B.M. | <input type="checkbox"/> 加工拆圖，然後生產 | <input type="checkbox"/> 尺寸表 |
| <input type="checkbox"/> 正式鋁料 B.M. | <input type="checkbox"/> 技術上資料 / 指示 | <input type="checkbox"/> 報價 |
| <input type="checkbox"/> 配件 B.M. | <input type="checkbox"/> 樣辦或貨品說明書 | <input type="checkbox"/> 分判合約 |
| <input type="checkbox"/> 其他：_____ | | |

內容：

因窗號 W10/ T3A 於 21/F 沒有偏林箱，需在百頁安裝鋁背板。

請在 2021.05.15 前完成上列要求。

附：1 頁 BM+ 1 頁加工圖

以上項目為：

- 原合約工程包 原合約工程加 / 減賬 新工程報價

原因：-

分發東莞各部門：

- | | | | |
|--|--|--|---|
| <input type="checkbox"/> 生產技術總監 <input type="checkbox"/> 連附件 | <input type="checkbox"/> 技術部 <input type="checkbox"/> 連附件 | <input type="checkbox"/> 生產部 <input type="checkbox"/> 連附件 | <input type="checkbox"/> 機械設計部 <input type="checkbox"/> 連附件 |
| <input type="checkbox"/> 採購部 <input type="checkbox"/> 連附件 | <input checked="" type="checkbox"/> 生產統籌部 <input type="checkbox"/> 連附件 | <input type="checkbox"/> 小羅&清 <input type="checkbox"/> 連附件 | |
| <input type="checkbox"/> 質檢部 <input type="checkbox"/> 連附件 | <input type="checkbox"/> 會計部 <input type="checkbox"/> 連附件 | <input type="checkbox"/> 報關組 <input type="checkbox"/> 連附件 | <input type="checkbox"/> 其他 <u>楊榮輝</u> <input type="checkbox"/> 連附件 |

分發其他分判：

- 水洪 連附件

分發香港各部門：


- | | | | |
|---|--|---|--|
| <input type="checkbox"/> 行政部 <input type="checkbox"/> 連附件 | <input type="checkbox"/> 會計部 <input type="checkbox"/> 連附件 | <input type="checkbox"/> 統籌部 <input type="checkbox"/> 連附件 | <input checked="" type="checkbox"/> 工程部地盤科文 <input type="checkbox"/> 連附件 <u>祥哥</u> |
| <input type="checkbox"/> 採購部 <input type="checkbox"/> 連附件 | <input type="checkbox"/> QS 部 <input type="checkbox"/> 連附件 | <input type="checkbox"/> 維修部 <input type="checkbox"/> 連附件 | <input type="checkbox"/> 其他 _____ <input type="checkbox"/> 連附件 |

傳遞編號：

HK 1057/21

發件人簽署：

項目經理簽署：


 美特鋁質 有限公司 MIDI Aluminium Fabricator Ltd.		工程號:	J852		計算:	lvan		日期:	2021.05.10		送呈:			
		地盤名稱:	亞皆老街		核對:			日期:			副本:			
廠用鋁板B.M.表		項目類別:	后裝窗(標準層)百頁鋁板-依最新大圖要求增加					日期:						
BM編號:		修改版次:		A/C Code:		總V.F.:	11.75	總重量:	23.88		此BM依據**拆圖資料計算			
序號	修改內容	鋁板圖號	鋁板名稱	顏色	實用	後備	總數	總重量	單件展開面積	總展開面積	單件V.F.	總V.F.	備註	位置
									平方米		平方米			
5		AL15-05	3.0mm厚鋁板	UCT201498XL(A)-3	18		18	23.877	0.326	5.874	0.653	11.747		用于W10/T3A
6														
7														
8														
9														
10														
11														
12														
					總計:		18	23.88	5.87		11.75			



美特鋁質 有限公司
MIDI Aluminium Fabricator Ltd.


工程號 J852 地盤 亞皆老街

窗號	W (MM)	H (MM)	數量 (支)	A	B	C	D	背板编号
W8/T1B#1	1237.5	243.5	18	93.75	3*350	75.5	100	AL15-01
W8/T2B#2	1237.5	243.5	18	93.75	3*350	75.5	100	AL15-02
W8/T2A#1	1237.5	243.5	18	93.75	3*350	75.5	100	AL15-03
W8/T3B#2	1212.5	243.5	18	81.25	3*350	75.5	100	AL15-04
W10/T3A	1197.5	243.5	18 (1)	73.75	3*350	75.5	100	AL15-05

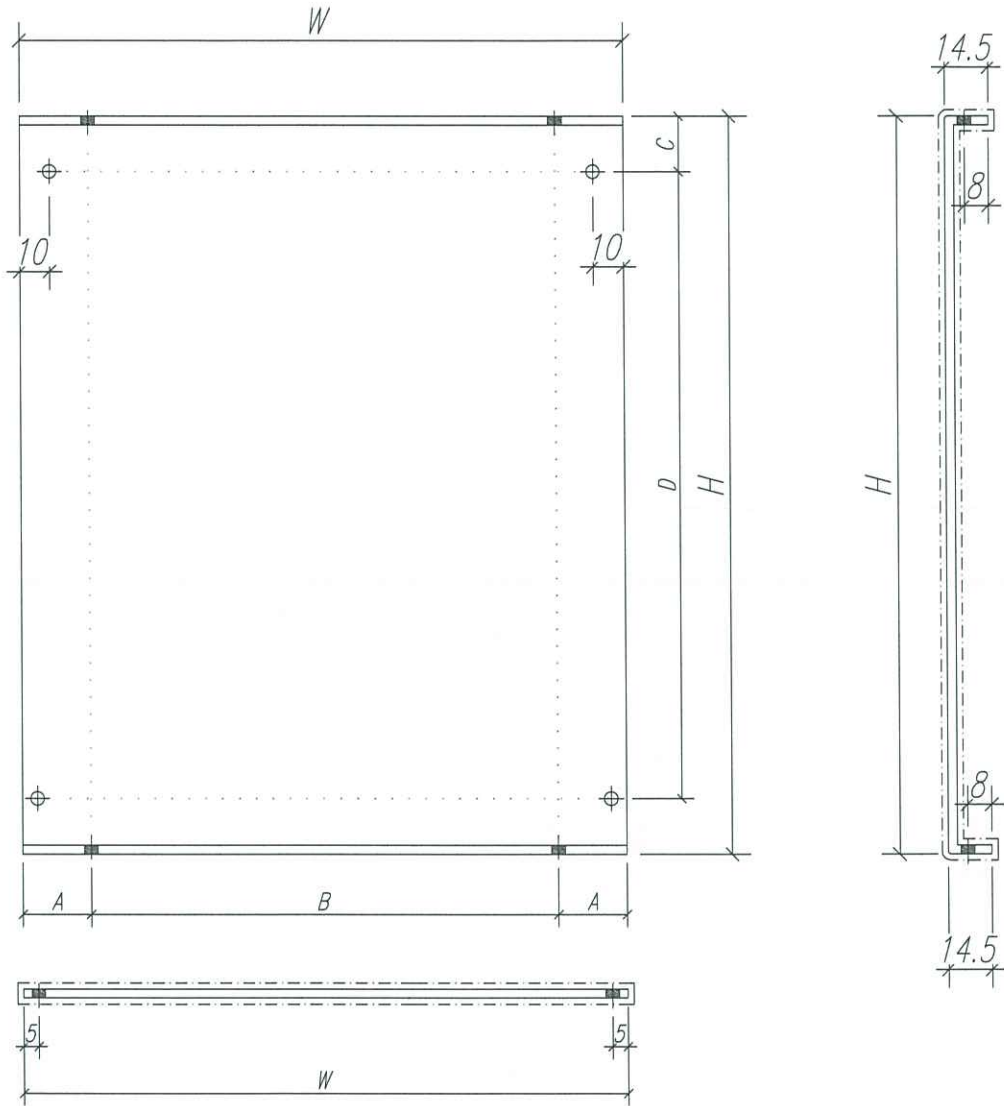

新增圖

名稱	鋁背板	制圖	Ivan	2021.05.10	修改		
材料	3mm 鋁板	復核	WHS		日期		
顏色	Uct201498xL(A)-3	批准			圖號	IW01-AL15	

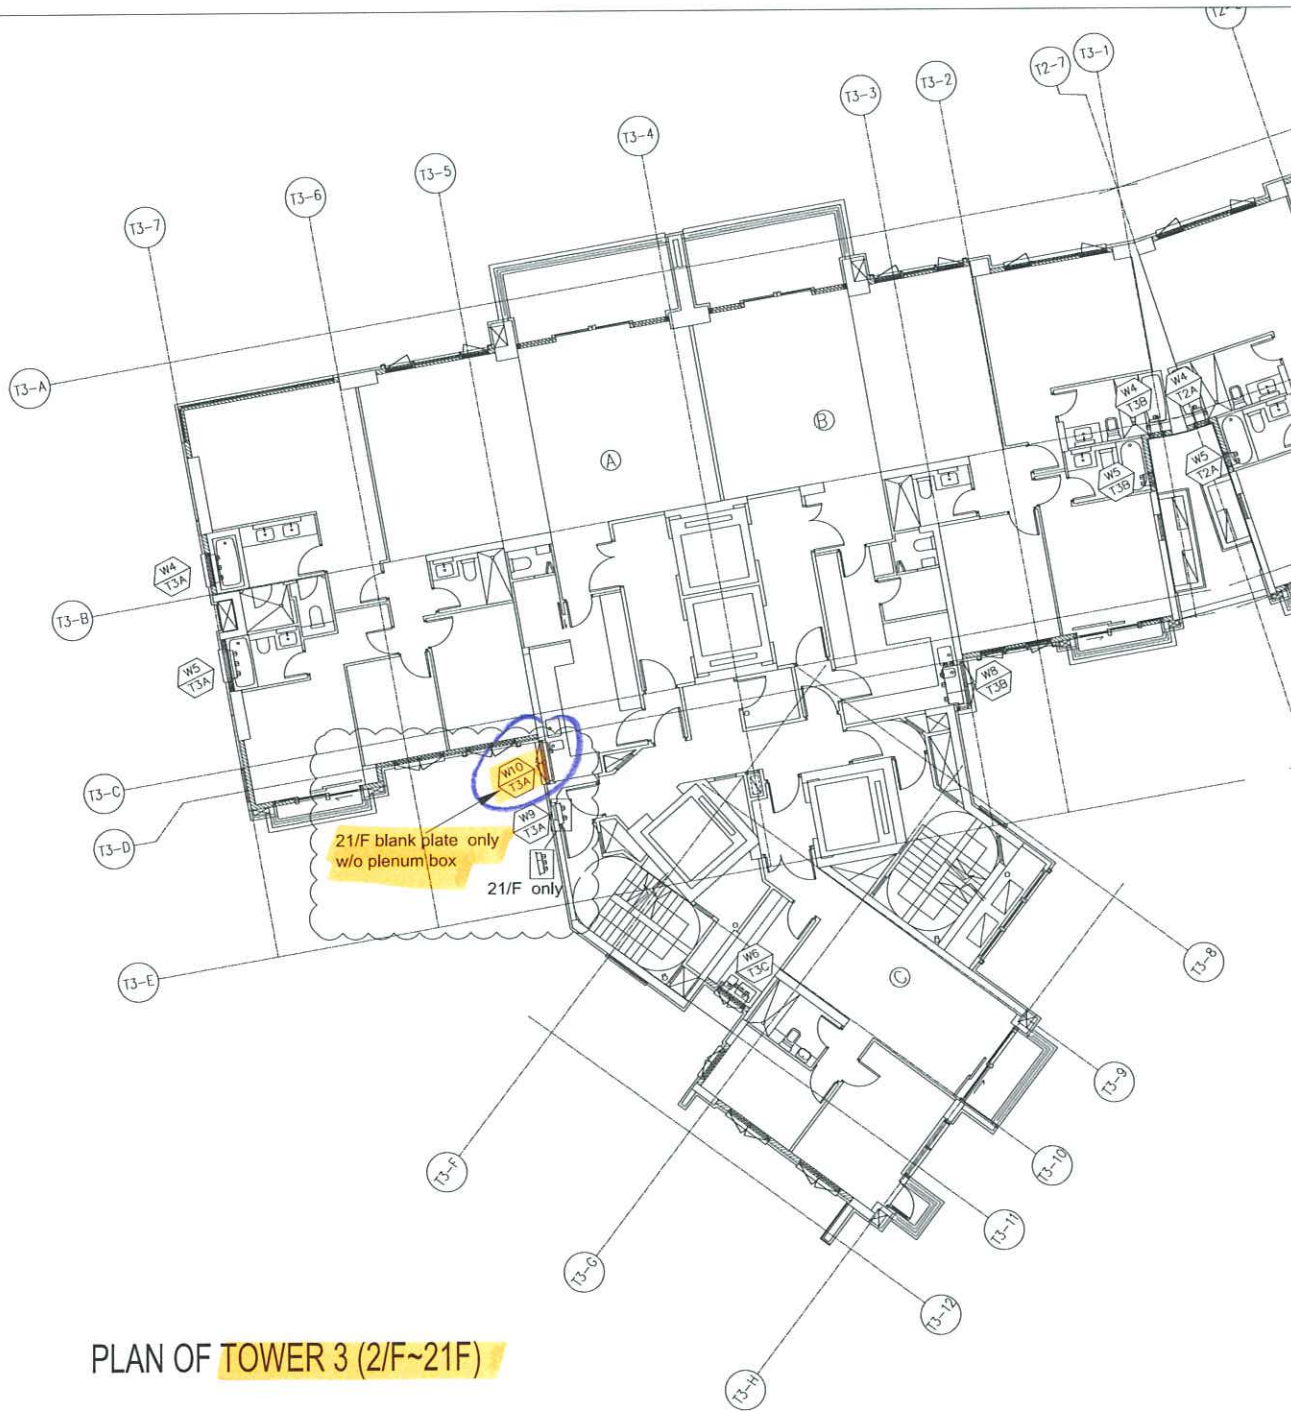

PLAN OF TOWER 3 (2/F~21/F)

B.D. REF :

CLIENT :

ARCHITECT :
AGC DESIGN LTD

MAIN CONTRACTOR :
Gammon

STRUCTURAL ENGINEER :
ARUP

FACADE CONSULTANT:
MEINHARDT

NOTE :
 1. ALL DIMENSIONS ARE IN mm.
 2. ALL ELEVATIONS ARE VIEWED FROM OUTSIDE.
 3. ALL DIMENSIONS TO BE VERIFIED ON SITE BEFORE FABRICATION.

LEGEND :
 (X1) — DETAIL MARK NO.
 (2005) — REFER SHEET NO.

1. F.F.L. — FINISHED FLOOR LEVEL
 2. S.F.L. — STRUCTURAL FLOOR LEVEL
 3. (↔) — REVERSED DETAIL.

B	06/07/2021	REVISION SUBJECT TO ARCH/COMMITMENT	REV
A	07/11/2020	REVISION SUBJECT TO ARCH/COMMITMENT	REV
NO.	DATE	REVISION	REV

JOB NO. : J-852

PROJECT :
 PROPOSED RESIDENTIAL DEVELOPMENT
 AT 139 — 147 ARGYLE STREET,
 NKIL 6005, 6035 R.P., 6036 R.P.,
 6037 R.P. & 6038 R.P.

TITLE :
 PART PLAN OF
 TOWER 3 (2-21/F)

DATE : 12-Dec-2019 SCALE : 1:150

DRAWN BY : MN CHECKED BY : DW

美特鋁質有限公司
MIDI ALUMINIUM FABRICATOR LTD.
 Units 6-8, Sunray Industrial Centre, 1/F
 810 Che Kwo Ling Road, Kowloon
 Tel: 23489211-4, Fax: (852) 7727656

DWG NO. : J852-S0-PB-3010 REV. : B