

工程指示 / 要求簡箋(E.I.)

工程指示編號：EI / 3580 / 21

修改版次：B

工程編號：J - 852

工程名稱：亞皆老街中電

工程項目：後裝窗 地盤用玻璃 B.M. (T1-T3: 1-21/F) (90 件) 玻璃 放行

收件人：Maggie

發件人：Ant Yeung

日期：30/08/2021

要求提供 / 確認 事項：

- | | | |
|------------------------------------|-------------------------------------|-------------------------------|
| <input type="checkbox"/> 初步鋁料 B.M. | <input type="checkbox"/> 加工拆圖，然後生產 | <input type="checkbox"/> 尺寸表 |
| <input type="checkbox"/> 正式鋁料 B.M. | <input type="checkbox"/> 技術上資料 / 指示 | <input type="checkbox"/> 報價 |
| <input type="checkbox"/> 配件 B.M. | <input type="checkbox"/> 樣辦或貨品說明書 | <input type="checkbox"/> 分判合約 |
| <input type="checkbox"/> 其他：_____ | | |

內容：

B 版：顧問已批核 fritted pattern 玻璃。現放行生產所有玻璃 (共 90 件)。

A 版：因顧問拒絕批核 acid etched 磨砂玻璃。現暫停生產所有磨砂玻璃。此單暫停。

因則師要求部分後裝窗改為磨砂玻璃 (原 EI3182)，請按 B.M. 訂購 T1-T3: 1-21/F 磨砂玻璃 (共 90 件) (T1/T3: 各 36 件。T2: 18 件) 直送地盤。 T3 優先生產。 分判包箱。

IGU 膠用 DC983 結構膠 玻璃要熱浸 Low-E: SEE0-83T

請留意玻璃加工時不要固定的鋼化及熱浸標籤。玻璃出貨時需加上"可移除" 標籤。

IGU: 標籤在室內外面 (注明半鋼化/ 鋼化)

請在 2021.09.30 前完成上列要求。

附：3 頁 BM+ 2 頁加工圖+ 2 頁顧問簽批玻璃

以上項目為：

- 原合約工程包 原合約工程加 / 減賬 新工程報價

原因：-

分發東莞各部門：

- | | | | |
|-------------------------------------|------------------------------------|------------------------------------|---|
| <input type="checkbox"/> 生產技術總監口連附件 | <input type="checkbox"/> 技術部 口連附件 | <input type="checkbox"/> 生產部 口連附件 | <input type="checkbox"/> 機械設計部口連附件 |
| <input type="checkbox"/> 採購部 口連附件 | <input type="checkbox"/> 生產統籌部口連附件 | <input type="checkbox"/> 小羅&清 口連附件 | |
| <input type="checkbox"/> 質檢部 口連附件 | <input type="checkbox"/> 會計部 口連附件 | <input type="checkbox"/> 報關組 口連附件 | <input type="checkbox"/> 其他 <u>楊榮輝</u> 口連附件 |

分發其他分判：

- 水洪 口連附件

分發香港各部門：

- | | | | | |
|---|------------------------------------|----------------------------------|---|-----------|
| <input type="checkbox"/> 行政部口連附件 | <input type="checkbox"/> 會計部口連附件 | <input type="checkbox"/> 統籌部口連附件 | <input checked="" type="checkbox"/> 工程部地盤科文口連附件 | <u>祥哥</u> |
| <input checked="" type="checkbox"/> 採購部口連附件 | <input type="checkbox"/> QS 部 口連附件 | <input type="checkbox"/> 維修部口連附件 | <input type="checkbox"/> 其他 _____ 口連附件 | |

傳遞編號：

HK / 21

發件人簽署：



項目經理簽署：

美特鋁質有限公司 MIDI Aluminium Fabricator Ltd.		工程號: J852	計算: Ivan	日期: 24/02/2021	送呈:	計算參考數值/所屬位置分格											玻璃派窗表																					
地盤名稱:		核對:	日期:	副本:																																		
項目類別: T1后裝窗及趟門玻璃 (1F~21F)		日期:	A/C Code:																																			
BM編號:		修改版次: B-2021.08.30	總計玻璃面積 (平方米): 20.87																																			
序號	修改內容	玻璃圖號	顏色與類型	厚度 (mm)	玻璃尺寸		數量 (塊)	總面積 (平方米)	使用位置	座號	單位	分屬類型	樓層	分格闊度	玻璃見光 (闊)	玻璃訂貨尺寸 (闊)	分格高度	玻璃見光 (高)	玻璃訂貨尺寸 (高)	1F	2F	3F	5F	6F	7F	8F	9F	10F	11F	12F	15F	16F	17F	18F	19F	20F	21F	合計
					寬度 (W mm)	高度 (H mm)																																
	B-改fritted pattern	GL03-T1-004	6mm Low Iron Low E #2 HS+12A+6mm Low Iron fritted pattern #3 tempered (D21070874) Low-E: SEE0-83T	24.0	571.0	1201.0	18	12.34	W9/T1B	T1	B	生窗	1~21F	750.00	547.00	571.00	1380.00	1177.00	1201.00	1	1	1	1	1	1	1	1	1	1	1	1	1	1	1	1	1	1	18
						合計:	18	12.34																													0	
	B-改fritted pattern	GL01-T1-001	8mm Low Iron Low E #2 HS+12A+10mm Low Iron fritted pattern #3 tempered (D21070875) Low-E: SEE0-83T	30.0	1133.0	418.0	18	8.52	W10/T1A	T1	A	梗窗	1~21F	1300.00	1097.00	1133.00	550.00	382.00	418.00	1	1	1	1	1	1	1	1	1	1	1	1	1	1	1	1	1	18	
						合計:	18	8.52																													0	
						总合计:	36	20.87																													0	
加工注意事項:		<p>1).本表中之所有玻璃顏色待定。</p> <p>2).本表中所有玻璃對角線尺寸偏差要求不超過負2mm。</p> <p>3).本表中玻璃要求粗磨邊處理並倒棱角，而所有玻璃之入爐方向需保持一致。</p> <p>4).本表中所有玻璃成品均需做雙面保護，用透明靜電膠紙加四周一寸FK白膠紙做雙面加固保護處理。</p> <p>5).本表中所有玻璃成品均需注明室內外及其玻璃編號，以便識別。</p>																																				

<T1> 訂購用 + 派窗表


EG-DWG4


 美特鋁質 有限公司 MIDI Aluminium Fabricator Ltd.	類別		物料號	
	制圖	Ivan	2020-09-04	圖號 GL03-01~04
修改			復核	數量 一
日期			批准	位置 后裝鋁窗及鋁門用

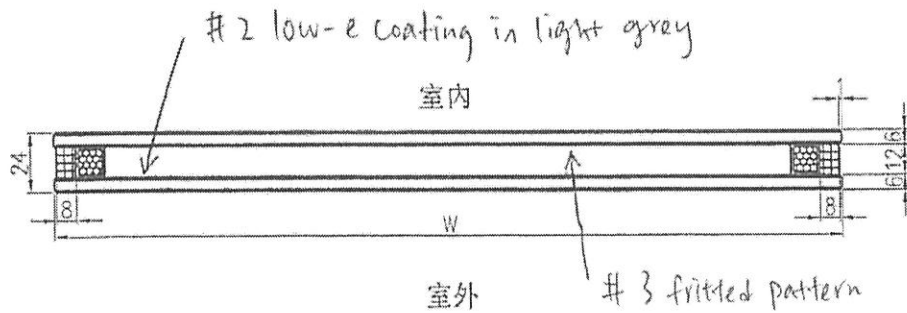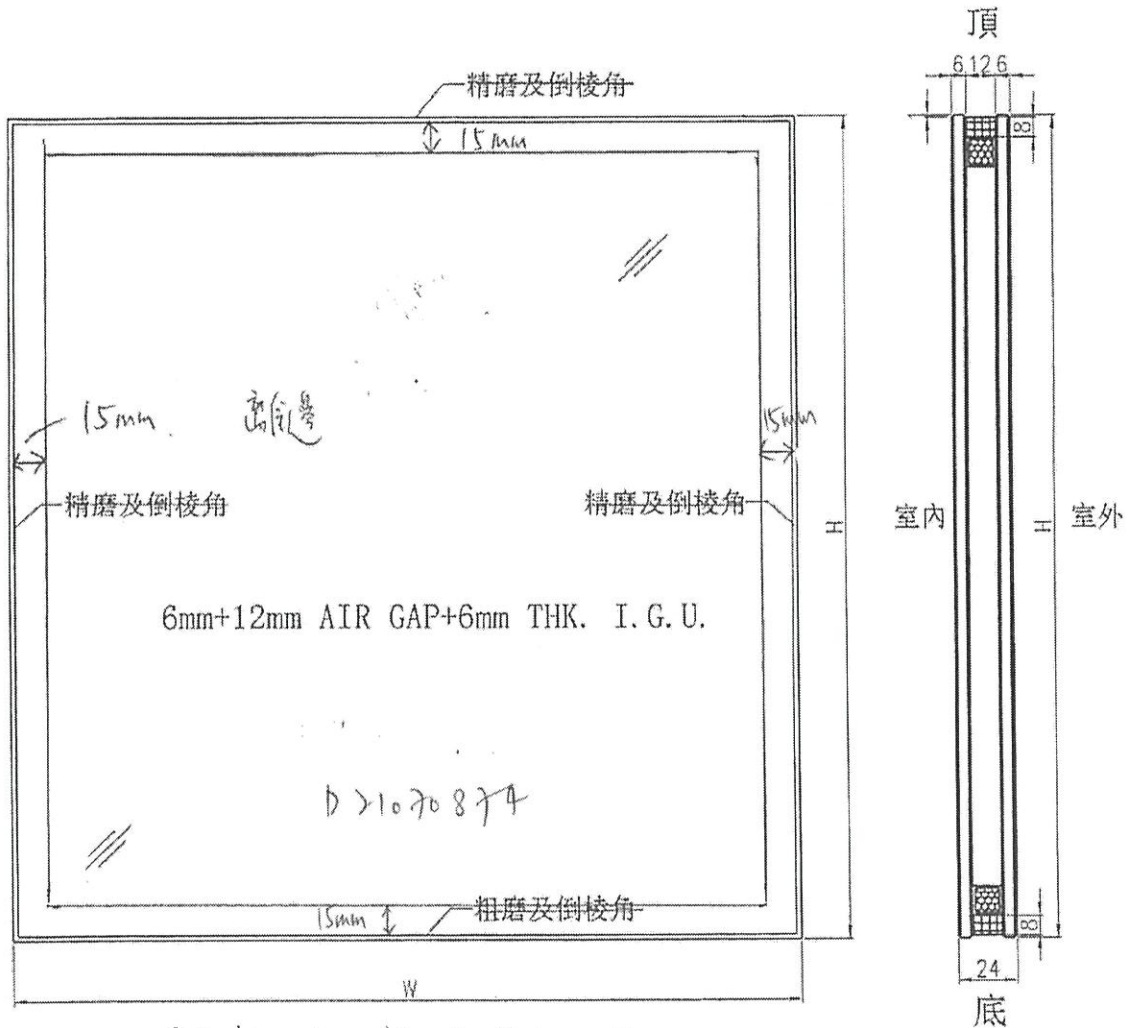

工程號	J-852	地盤	-	附 件
名稱	玻璃加工圖		採用	
材料	6mm+12mm AIR GAP+6mm THK. I.G.U.		地盤	
顏色	-		工廠 <input checked="" type="checkbox"/>	

EG-DWG4


 美特鋁質 有限公司 MIDI Aluminium Fabricator Ltd.	類別	物料號			
	制圖	Ivan	2020-09-04	圖號	GL01-04~05, 11
修改		復核		數量	—
日期		批准		位置	后裝鋁窗及鋁門用

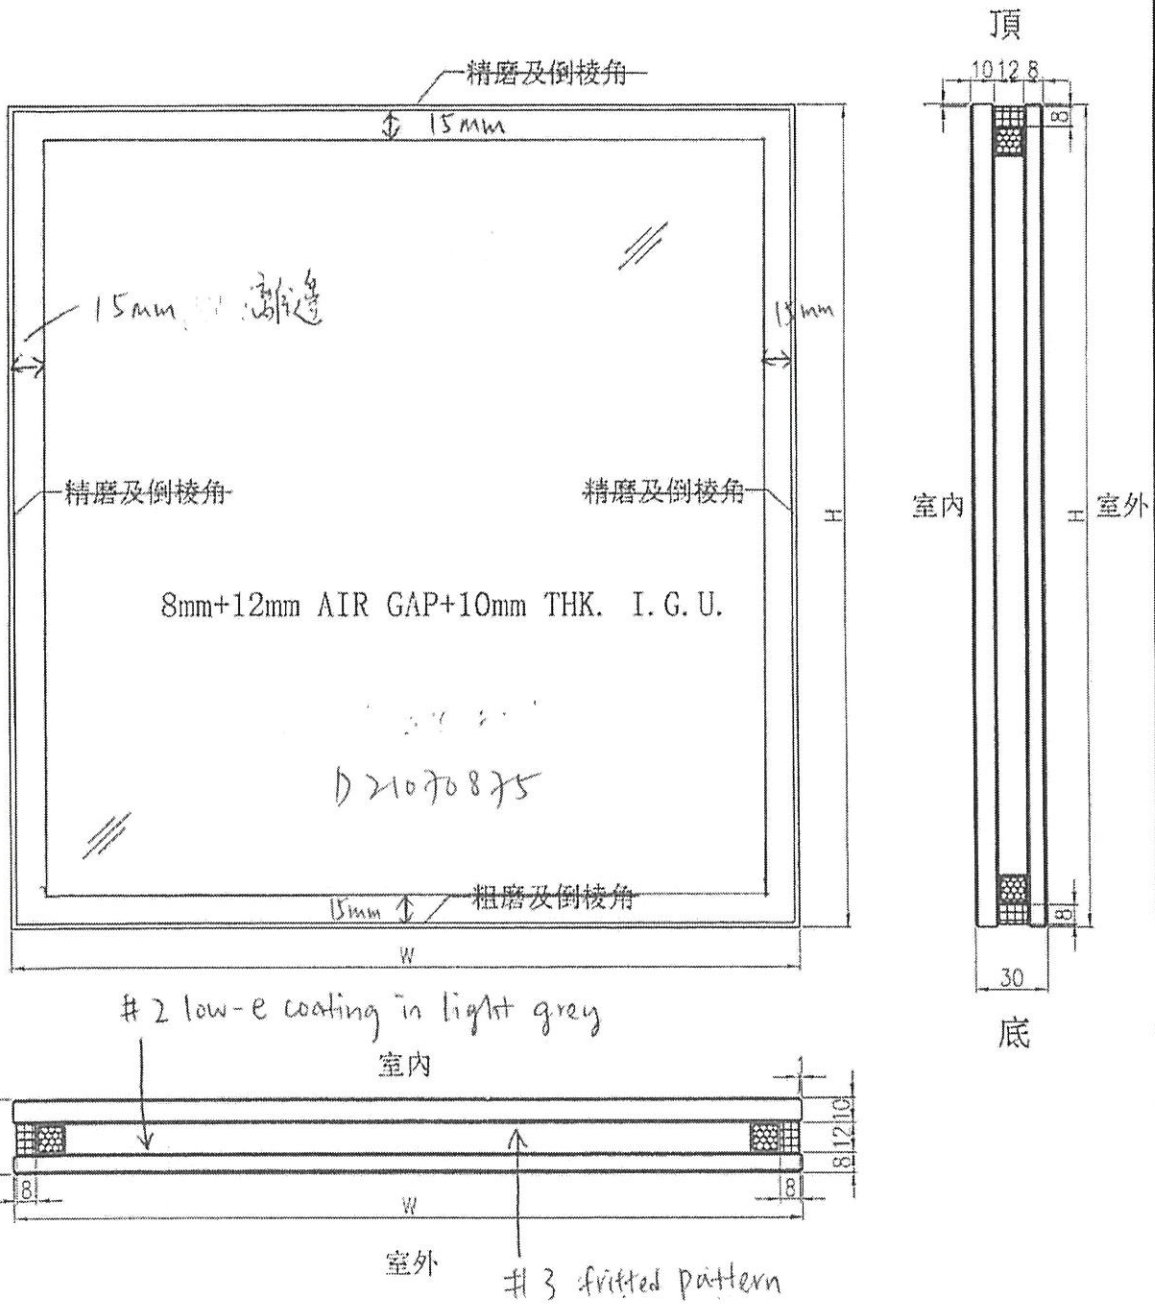


工程號	J-852	地盤	—	附 件
名稱	玻璃加工圖		採用	
材料	8mm+12mm AIR GAP+10mm THK. I.G.U.		地盤	
顏色	—		工廠	

MIDI ALUMINIUM FABRICATOR LTD.
 Unit 7, 8 Sunny Industrial Centre, Cha Kwo Ling Road Kowloon.

Project: Nos. 139-147 Argyle Street, Kowloon.
 Subject: Submission of Glass Sample for Bulk Order -
 Transparency Fritted Pattern Glass for Tower (MS092)
 6mm Low Iron Low-E(SEE0-871) FS + 12A + 6mm Low Iron
 Size: 600x1200x6mm
 Sample Code: D210708
 I.D. ref.: MC/40383/852
 Date: 19 August 2021

 13866 - Proposed Residential Development Nos. 139-147 Argyle Street, Kowloon		<input type="checkbox"/> Pacific Shine <input type="checkbox"/> IAGC <input type="checkbox"/> DARUP <input type="checkbox"/> WCY	<input type="checkbox"/> DMF <input type="checkbox"/> AXXA <input type="checkbox"/>
Submission Ref. No.:	MC/ 40383 / 852	Authorized Representative:	
Material Description:	Submission of Glass Sample for Bulk Order - Transparency Fritted Pattern Glass for Tower (MS092)	Name:	
Submission Date:	19/08/2021	Signature:	
Approval Date:		Signature Date:	
Comment:			

APPROVED BY: *[Signature]*
 DATE: 19/08/2021
 APPROVED BY: *[Signature]*
 DATE: 19/08/2021

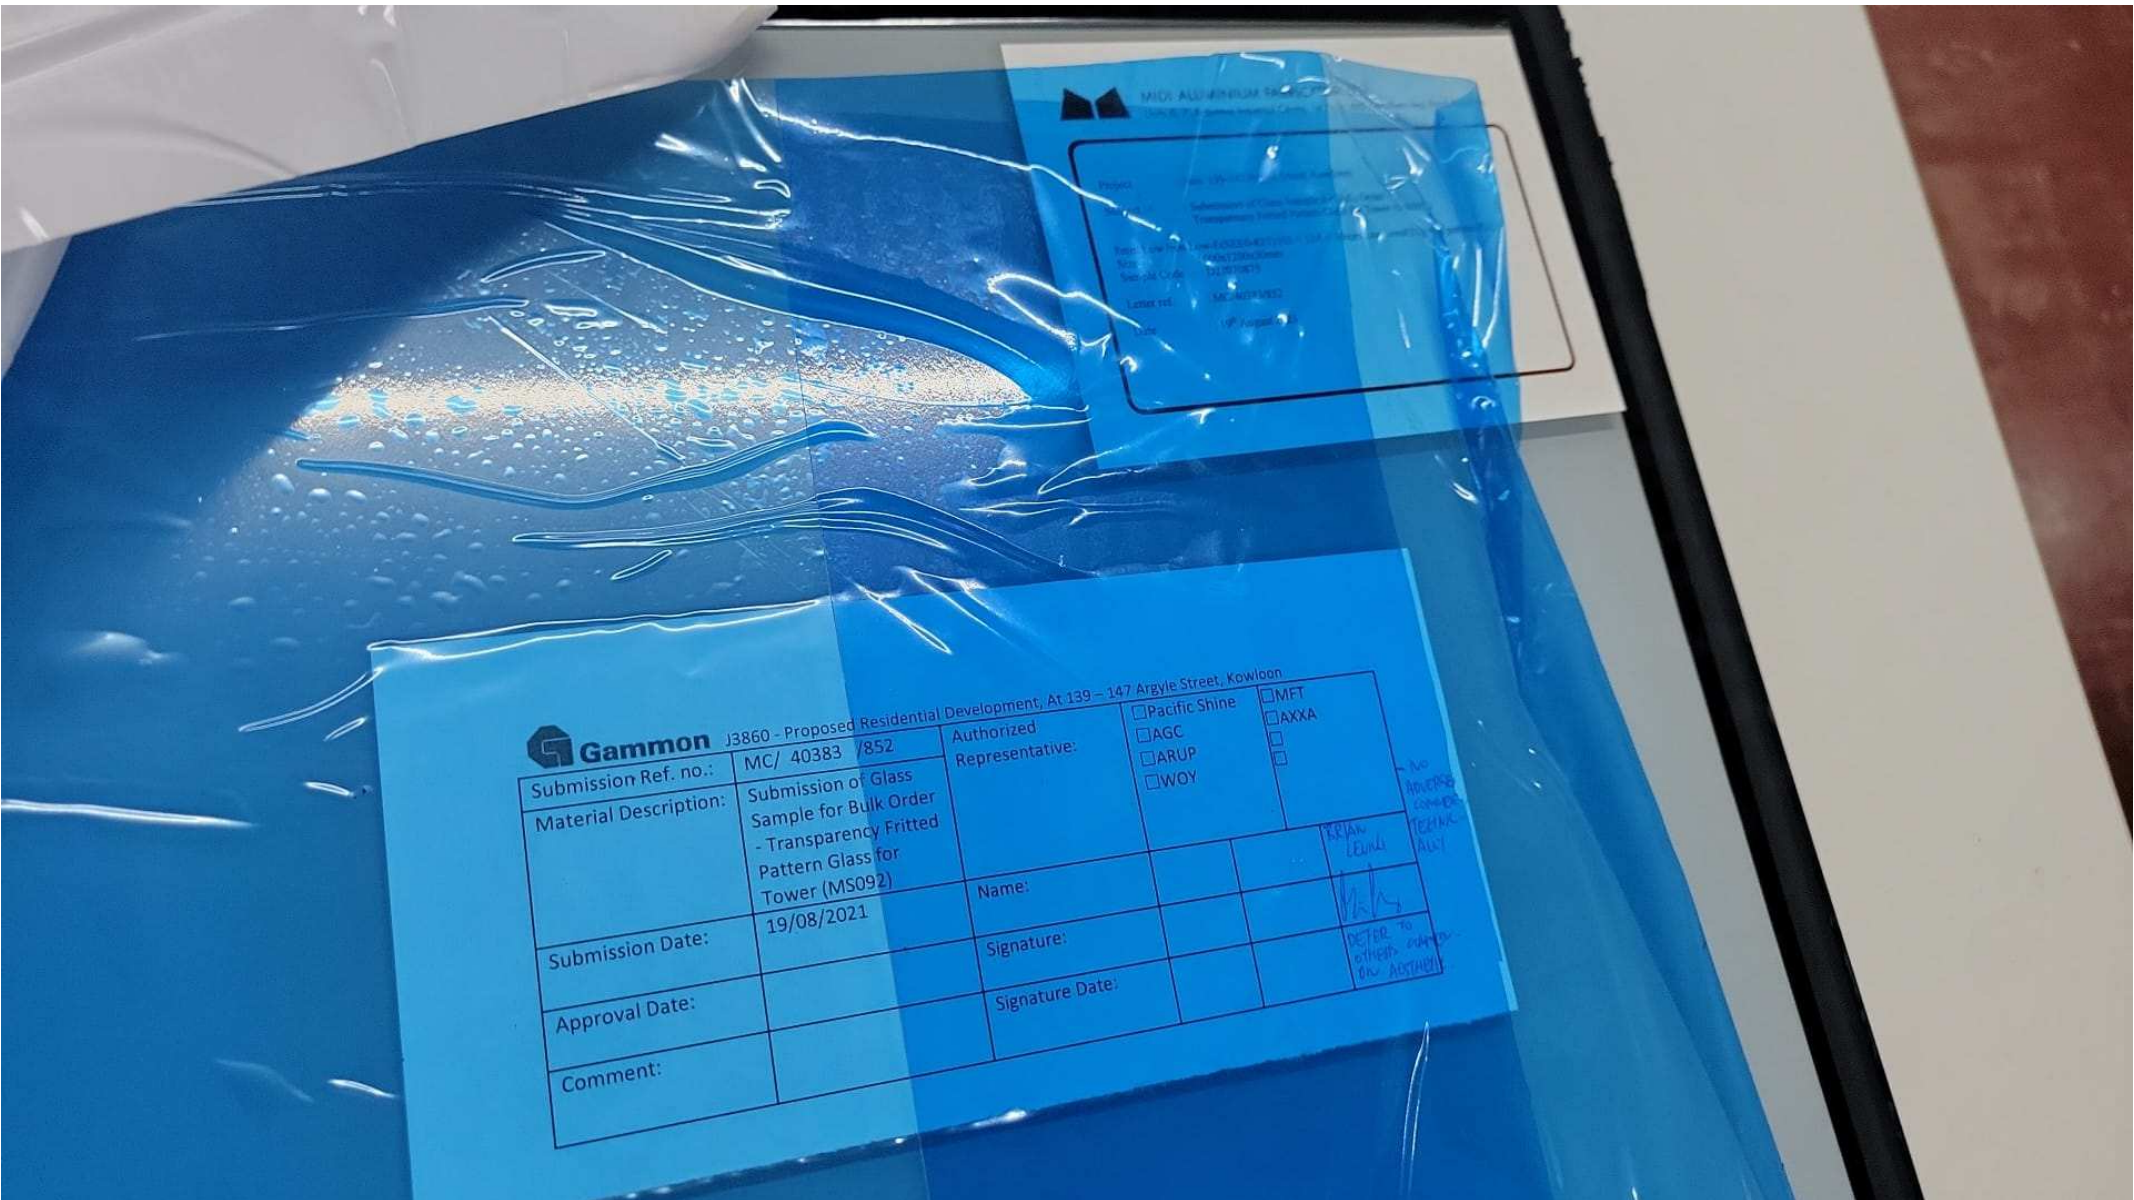

MIGR ALUMINIUM SAMPLE
 Project: 139-147 Argyle Street, Kowloon
 Submission of Glass Sample for Bulk Order - Transparency Fritted Pattern Glass for Tower (MS092)
 Form: MS092 (Rev 1.0) (19/08/2021)
 Spec. Call Code: 1400000000
 1400000000
 Form Ref: MS092 (Rev 1.0)
 Date: 19/08/2021

Gammon J3860 - Proposed Residential Development, At 139 - 147 Argyle Street, Kowloon

Submission Ref. no.:	MC/ 40383 /852	Authorized Representative:	<input type="checkbox"/> Pacific Shine <input type="checkbox"/> JAGC <input type="checkbox"/> JARUP <input type="checkbox"/> WOY	<input type="checkbox"/> MFT <input type="checkbox"/> JAXXA <input type="checkbox"/> <input type="checkbox"/>
Material Description:	Submission of Glass Sample for Bulk Order - Transparency Fritted Pattern Glass for Tower (MS092)	Name:		
Submission Date:	19/08/2021	Signature:		
Approval Date:		Signature Date:		
Comment:				

Handwritten notes:
 - No ARUP/MS092 FORM
 - BRYAN LEUNG
 - DETER TO OTHER COMPANY ON ACTIVITY