



## 工程指示 / 要求簡箋(E.I.)

工程指示編號：EI / 3749 / 21

修改版次：B

工程編號：J - 852

工程名稱：亞皆老街中電

工程項目：平台 Glass Wall 廠用配件 BM 地鎖 G/F 用

收件人：生統 / 楊榮輝

發件人：Ant Yeung

日期：13/12/2021

要求提供 / 確認 事項：

- |                                    |                                     |                               |
|------------------------------------|-------------------------------------|-------------------------------|
| <input type="checkbox"/> 初步鋁料 B.M. | <input type="checkbox"/> 加工拆圖，然後生產  | <input type="checkbox"/> 尺寸表  |
| <input type="checkbox"/> 正式鋁料 B.M. | <input type="checkbox"/> 技術上資料 / 指示 | <input type="checkbox"/> 報價   |
| <input type="checkbox"/> 配件 B.M.   | <input type="checkbox"/> 樣辦或貨品說明書   | <input type="checkbox"/> 分判合約 |
| <input type="checkbox"/> 其他：_____  |                                     |                               |

內容：

B 版：增加地鎖 GCC 55128 用在平台的 G/F 門

請按配件 BM 訂購送廠

請在 2021.12.17 前完成上列要求。

附：1 頁 BM+ 2 頁

- |                                 |                                      |                                |
|---------------------------------|--------------------------------------|--------------------------------|
| <input type="checkbox"/> 原合約工程包 | <input type="checkbox"/> 原合約工程加 / 減賬 | <input type="checkbox"/> 新工程報價 |
|---------------------------------|--------------------------------------|--------------------------------|

原因：-\_\_\_\_\_

分發東莞各部門：

- |  |  |  |  |
|--|--|--|--|
| <input type="checkbox"/> 生產技術總監 <input type="checkbox"/> 連附件 | <input type="checkbox"/> 技術部 <input type="checkbox"/> 連附件              | <input type="checkbox"/> 生產部 <input type="checkbox"/> 連附件    | <input type="checkbox"/> 機械設計部 <input type="checkbox"/> 連附件                    |
| <input type="checkbox"/> 採購部 <input type="checkbox"/> 連附件    | <input checked="" type="checkbox"/> 生產統籌部 <input type="checkbox"/> 連附件 | <input type="checkbox"/> 小羅 & 清 <input type="checkbox"/> 連附件 |  |
| <input type="checkbox"/> 質檢部 <input type="checkbox"/> 連附件    | <input type="checkbox"/> 會計部 <input type="checkbox"/> 連附件              | <input type="checkbox"/> 報關組 <input type="checkbox"/> 連附件    | <input checked="" type="checkbox"/> 其他 <u>楊榮輝</u> <input type="checkbox"/> 連附件 |

分發其他分判：

- |   |
|---|
| <input checked="" type="checkbox"/> 水洪 <input type="checkbox"/> 連附件 |
|---|

分發香港各部門：


- |   |  |  |                                   |   |           |
|---|--|--|-----------------------------------|---|-----------|
| <input type="checkbox"/> 行政部 <input type="checkbox"/> 連附件 | <input type="checkbox"/> 會計部 <input type="checkbox"/> 連附件  | <input checked="" type="checkbox"/> 統籌部 <input type="checkbox"/> 連附件 | 林哥                                | <input type="checkbox"/> 工程部地盤科文 <input type="checkbox"/> 連附件 | <u>祥哥</u> |
| <input type="checkbox"/> 採購部 <input type="checkbox"/> 連附件 | <input type="checkbox"/> QS 部 <input type="checkbox"/> 連附件 | <input type="checkbox"/> 維修部 <input type="checkbox"/> 連附件            | <input type="checkbox"/> 其他 _____ | <input type="checkbox"/> 連附件                                  |           |

傳遞編號：

發件人簽署：

HK 271 / 21

項目經理簽署：


 <b>美特鋁質有限公司</b> MIDI Aluminium Fabricator Ltd.		工程號: J-852 地盤名稱: 亞皆老街 項目類別: 平台GLASS WALL A/C Code: 3249	計算: 黃漢卿 核對: 日期: 批准: 日期:	日期: 2021/08/09 送呈: 副本:	胡哥
工廠用配件B.M.表 此BM依據 2021-7-31 收Wong009拆图资料 計算					
BM編號:					

序號	修改標示	配件圖號	物料編號	配件名稱	顏色	實用	後備	總數	單位	備注
1	<del>A</del>	多玛 8066 (見附件)		門玉頂漂域巴		58	4	62	個	← 左 - 右
2	<del>A</del>	多玛 7421 (見附件)		門玉底地較漂域巴		58	4	62	個	← 左 - 右
3				M5x100mm平頭機絲	S.S#316 A4-70	800	50	850	套	20x20x3鋁通組裝用螺絲
4				M5x10mm平頭機絲	S.S#316 A4-70	4000	200	4200	套	X85924 三角形鋁通固定鋁板上用
5				D.C.791,防水膠 300ml/支	古銅色	35	5	40	支	
6				9cc/55128 地鎖		16	2	18	個	(一左 - 右)
7										
8										
CLUBHOUSE AND LOBBY  
 AUTO DOOR LOCATION PLAN  
 REV. 3  
 DATE: 17 AUG 2021

*Handwritten signature and initials in blue ink.*

- R RELEASE BUTTON
- IL INDICATOR LOCK
- M DOOR CONTACT
- BG BREAK GLASS
- K MANUAL KEY LOCK
- D DETEX LOCK
- IR INFRARED SENSOR
- QR QR CODE READER
- CR CARD READER
- A AUTO DOOR
- H HAND SENSOR
- E ELECTRICAL LOCK

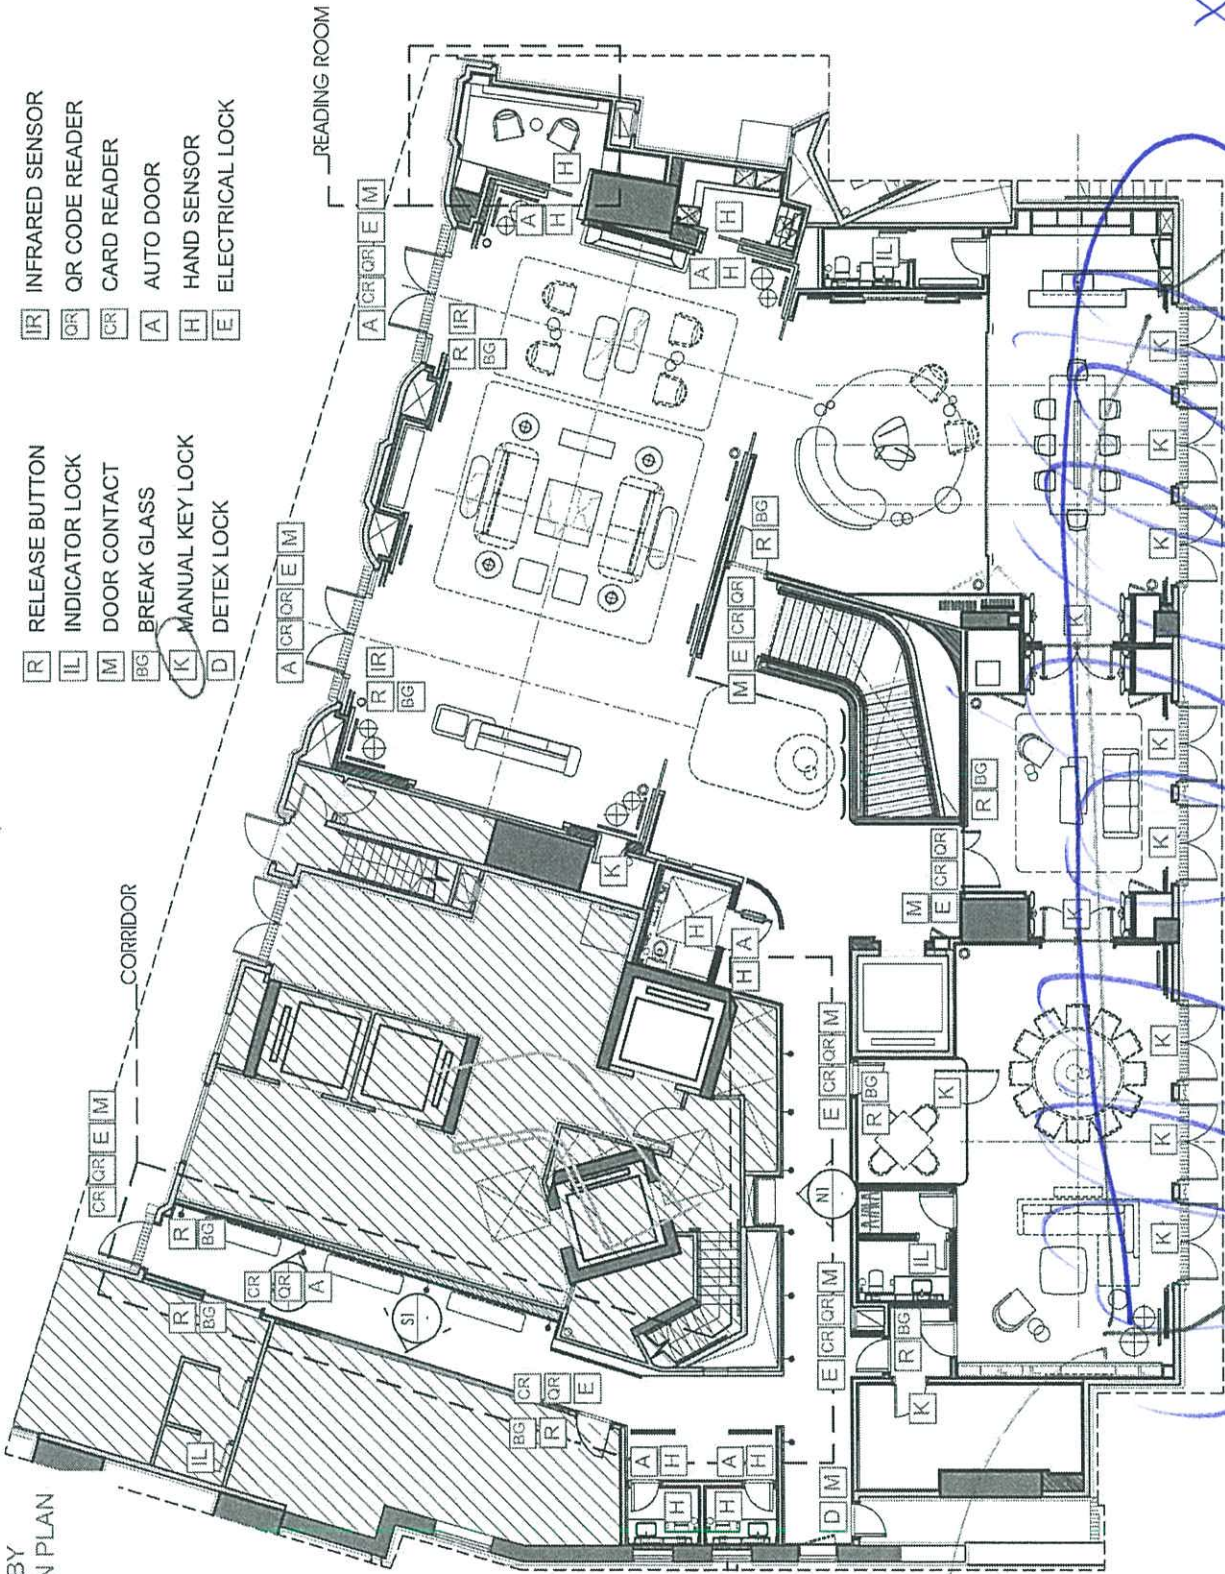

DWG. NO.: SK01

Revision  
 A. 05 MAY. 2020 GENERAL REVISION  
 B. 27 MAY. 2020 GENERAL REVISION  
 C. 30 OCT. 2020 GENERAL REVISION  
 D. 24 JUN. 2021 GENERAL REVISION

Project  
 PROPOSED  
 RESIDENTIAL DEVELOPMENT  
 AT 24A KADOOORE AVENUE

Project Title  
 KEY PLAN  
 OF CLUBHOUSE  
 G/F


Scale  
 1:125  
 Date 09 APR. 2020

General Notes  
 This drawing and design is the property of the author and shall remain confidential. No part of this drawing shall be reproduced, stored in a retrieval system, or transmitted in any form or by any means, electronic, mechanical, photocopying, recording, or by any information storage and retrieval system, without the prior written permission of the author. Measurements to existing works to be used in conjunction with specification and condition of contract.

MOTY'S DESIGN  
 1 (952) 8802 0056  
 mohydesign.com.hk  
 17/F The Phoenix, 23 Luand Road  
 Wan Chai, Hong Kong

Wong 049A  
 地舖五金

55128L DEADLOCK "LONG THROW" ★

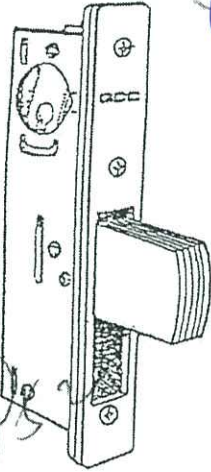


- Cylinder backset available: 31/32", 7/8", 1-1/8", and 1-1/2".
- Bolt 1-3/8" throw, made of 5 ply laminated steel with hardened roller pin in center to resist hacksaw attacks.
- Lock accepts standard 1-5/32" mortise key or thumbturn cylinders.
- 1" x 6-7/8" faceplates.

Faceplate Type	
55128L/1	
Flat faceplate	
55128L/2	
Radius faceplate	
55128L/3	
Radius weather-stripped faceplate	
55128L/4	
Left Hand beveled faceplate	
55128L/5	
Right Hand beveled faceplate	

Faceplate finishes;  
 AL - Anodized Satin Aluminum  
 DU - Anodized Bronze  
 BK - Anodized Black

55128S DEADLOCK "SHORT THROW"  
 55128H DEADLOCK "HOOK BOLT"

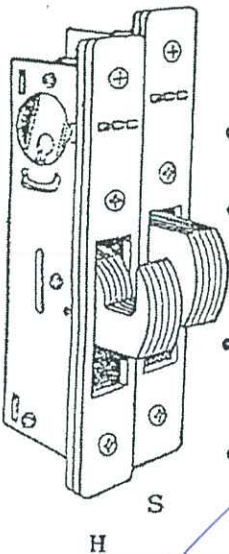


- Cylinder backset available: 31/32", 1-1/8", 7/8" and 1-1/2".
- Bolt 13/16" throw, made of 5 ply laminated steel with hardened roller pin in center to resist hacksaw attacks.
- Lock accepts standard 1-5/32" mortise key or thumbturn cylinders.
- 1" X 6-7/8" faceplates.

Faceplate Type	
55128(S or H)/1	
Flat faceplate	
55128(S or H)/2	
Radius faceplate	
55128(S or H)/3	
Radius weather-stripped faceplate	
55128(S or H)/4	
Left Hand beveled faceplate	
55128(S or H)/5	
Right Hand beveled faceplate	

Faceplate finishes;  
 AL - Anodized Satin Aluminum  
 DU - Anodized Bronze  
 BK - Anodized Black

55129 DEADLATCH LOCK

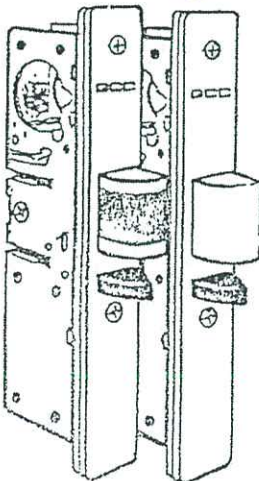

- Cylinder backset 1-1/8".
- Field reversible for opposite hand.
- Key controlled dogging.
- Latchbolt 1/2" throw with Delrin insert for smooth, quiet latching(A) or w/o Delrin insert(B).
- Lock accepts standard 1-5/32" mortise key or thumbturn cylinders.
- Strike included, US 26D.
- 1" X 6-7/8" faceplates.

Faceplate Type	
55129/1	
Flat faceplate	
55129/2	
Radius faceplate	
55129/3	
Radius weather-stripped faceplate	
55129/4	
Left Hand beveled faceplate	
55129/5	
Right Hand beveled faceplate	


Faceplate finishes;  
 AL - Anodized Satin Aluminum  
 DU - Anodized Bronze  
 BK - Anodized Black

(A) (B)

3/8

# GCC<sup>®</sup> Door Hardware


## LH-560 LEVER HANDLE

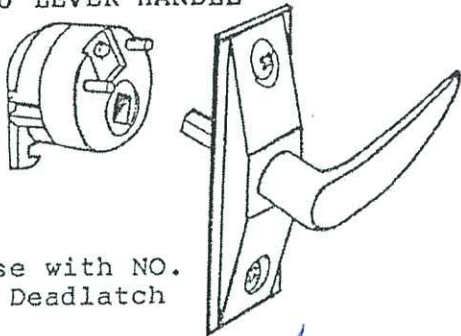

- \*For use with NO. 55129 Deadlatch Lock.
- \*Cam plug non-handed reversible in the field.
- \*Finishes available:
  - AL - Baked Satin Aluminum Paint
  - DU - Baked Storefront Bronze Paint
  - BK - Baked Black Paint


## MORTISE KEY CYLINDER

ZC-101 (ZINC)  
BS-102 (SOLID BRASS)

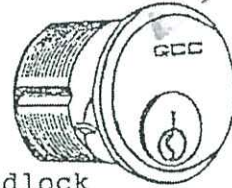

- \*1-5/32" 5 pin cylinder.
- \*For use with Deadlock or Deadlatch Lock.
- \*Core face and Key US 26D.
- \*Cylinder ring 3/16" standard, 5/32" and 7/32" optional.
- \*Keyway available: Schlage "C", Yale "8".
- \*Finishes available:
  - AL - Anodized Satin Aluminum
  - DU - Anodized Bronze
  - BK - Anodized Black
  - PC - Polish Chrome (for BS-102 only)


## PH-520 LATCH PADDLE HANDLE

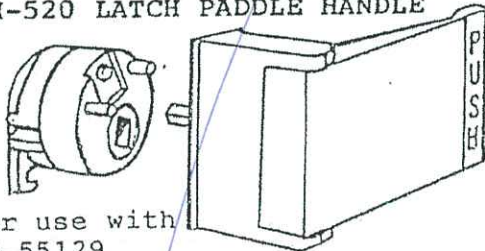



- \*For use with NO. 55129 Deadlatch Lock.
- \*Cam on cam plug is handed and can be reversed.
- \*Operation: PSL-Push To Left  
PSR-Push To Right  
PLL-Pull To Left  
PLR-Pull To Right
- \*Finish available:
  - AL - Anodized Satin Aluminum
  - DU - Anodized Bronze
  - BK - Anodized Black

## MORTISE THUMBTURN CYLINDER


ZC-101T (ZINC)  
BS-102T (SOLID BRASS)

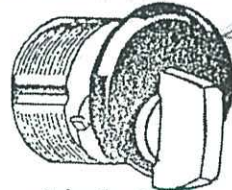


- \*1-5/32" mortise cylinder.
- \*For use with Deadlock or Deadlatch Lock.
- \*Thumbturn US 26D.
- \*Cylinder ring 3/16" standard, 5/32" and 7/32" optional.
- \*Finishes available:
  - AL - Anodized Satin Aluminum
  - DU - Anodized Bronze
  - BK - Anodized Black
  - PC - Polish Chrome (for BS-102T only)

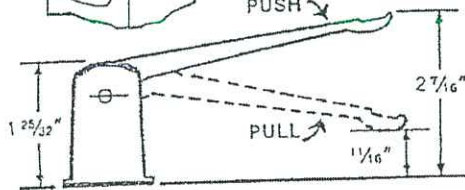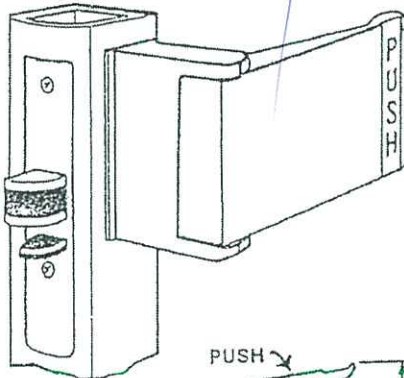

## 9125 DOUBLE ENDED EUROPROFILE MORTICE CYLINDER (CD-88)

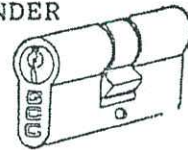

- \*Length 2-15/32" (62mm) standard.
- \*For use with Patch Lock NO. GL-50, GL-34 or use with Deadlock NO. 55128L, 55128S, 55128H backset 1" (25mm) or 1-3/16" (30mm).
- \*Keyway available: Schlage "C" or Yale "8".
- \*Finish available:
  - PC - Polish Chrome
  - PB - Polish Brass
  - SC - Satin Chrome

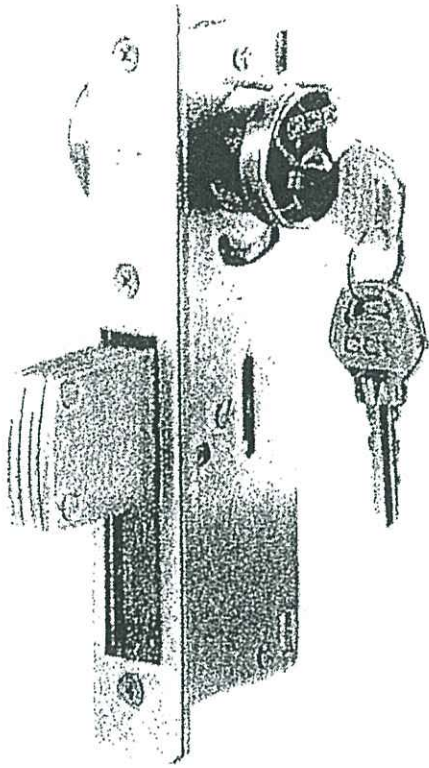

55128

