

工程指示 / 要求簡箋(E.I.)

工程指示編號：EI / 3912 / 21

修改版次：-

工程編號：J - 852

工程名稱：亞皆老街中電

工程項目：鐘樓 欄河玻璃 19+19 Lam 玻璃 (20件) 地盤

收件人：Maggie

發件人：Ant Yeung

日期：11/10/2021

要求提供 / 確認 事項：

- | | | |
|------------------------------------|-------------------------------------|-------------------------------|
| <input type="checkbox"/> 初步鋁料 B.M. | <input type="checkbox"/> 加工拆圖，然後生產 | <input type="checkbox"/> 尺寸表 |
| <input type="checkbox"/> 正式鋁料 B.M. | <input type="checkbox"/> 技術上資料 / 指示 | <input type="checkbox"/> 報價 |
| <input type="checkbox"/> 配件 B.M. | <input type="checkbox"/> 樣辦或貨品說明書 | <input type="checkbox"/> 分判合約 |
| <input type="checkbox"/> 其他：_____ | | |

內容：

請按 BM 訂購欄河玻璃 19+19 Lam 玻璃 (20件) (Low - Iron) 送地盤安裝

鐘樓 欄河玻璃 1/F and 2/F

謝謝

請在 2021 / 11 / 01 前完成上列要求。

附：頁

以上項目為：

- 原合約工程包 原合約工程加 / 減賬 新工程報價

原因：-

分發東莞各部門：

- () 生產技術總監 連附件 () 技術部 連附件 () 生產部 連附件 () 機械設計部 連附件
 () 採購部 連附件 () 生產統籌部 連附件 () 小羅 & 清 連附件
 () 質檢部 連附件 () 會計部 連附件 () 報關組 連附件 () 其他 _____ 連附件

分發其他分判：

- (v) 水洪 連附件

分發香港各部門：


- () 行政部 連附件 () 會計部 連附件 () 統籌部 連附件 () 工程部地盤科文 連附件
 () 採購部 連附件 () QS 部 連附件 () 維修部 連附件 () 其他 _____ 連附件

傳遞編號：

HK / 21

發件人簽署：

項目經理簽署：


 美特鋁質 有限公司 MIDI Aluminium Fabricator Ltd.		工程號:	J-852	計算:	WYY	日期:	05/06/2021	送呈:	Jason
		地盤名稱:	亞皆老街	核對:		日期:		副本:	
地盤用玻璃B.M.表		項目類別:		批准:		日期:		A/C Code:	
BM編號:		修改版次:		總計玻璃面積 (平方米):		20.000		此BM依據	
序號	修改內容	玻璃圖號	顏色與類型	厚度 (mm)	玻璃尺寸		數量 (塊)	總面積 (平方米)	備注
					寬度 (mm)	高度 (mm)			
1		852-SX-G01	19mm Low Iron Tempered+ 2.28 PVB+ 19mm Low Iron Tempered Laminated Glass (R20210628001)	40.28	1060.0	1025.0	4	4.346	夾膠玻璃(見附圖J852-SX-A01)
2		852-SX-G02		40.28	1060.0	1025.0	4	4.346	夾膠玻璃(見附圖J852-SX-A01)
3		852-SX-G03		40.28	1106.0	1025.0	2	2.267	夾膠玻璃(見附圖J852-SX-A01)
1		852-SX-G01	19mm Low Iron Tempered+ 2.28 PVB+ 19mm Low Iron Tempered Laminated Glass (R20210628001)	40.28	1022	1025.0	4	4.346	1/F 夾膠玻璃(見附圖J852-SX-A01)
2		852-SX-G02		40.28	1060.0	1025.0	4	4.346	夾膠玻璃(見附圖J852-SX-A01)
3		852-SX-G03		40.28	1106.0	1025.0	2	2.267	夾膠玻璃(見附圖J852-SX-A01)
3					小計:		20	20.000	
14					總計:		20	20.000	
加工注意事項:		1).本表中所採用之玻璃為信義玻璃廠出品之 玻璃原片 2).本表中所有玻璃對角線尺寸偏差要求不超過正負2mm。 3).本表中所有玻璃要求粗磨邊處理並倒棱角。 4).本表中不同種類玻璃參照玻璃加工圖加工。 5).本表中所有強化玻璃均需HEAT SOAK TEST。 6).本表中所有強化玻璃之入爐方向均以寬度方向進入。 7).本表中所有玻璃成品送交東莞美而特廠，每次交貨時須齊層、齊款、齊數量，每次來貨之具體數量由美而特廠生產統籌部提供。 8).本表中所有玻璃成品均需注明室內外面及其玻璃編號，以便識別。							



美特鋁質 有限公司
MIDI Aluminium Fabricator Ltd.


工程號	J-852	地盤	亞答街
-----	-------	----	-----

玻璃編號	寬度W	數量
852-SX-G01	1060.0	8
852-SX-G02	1106.0	2

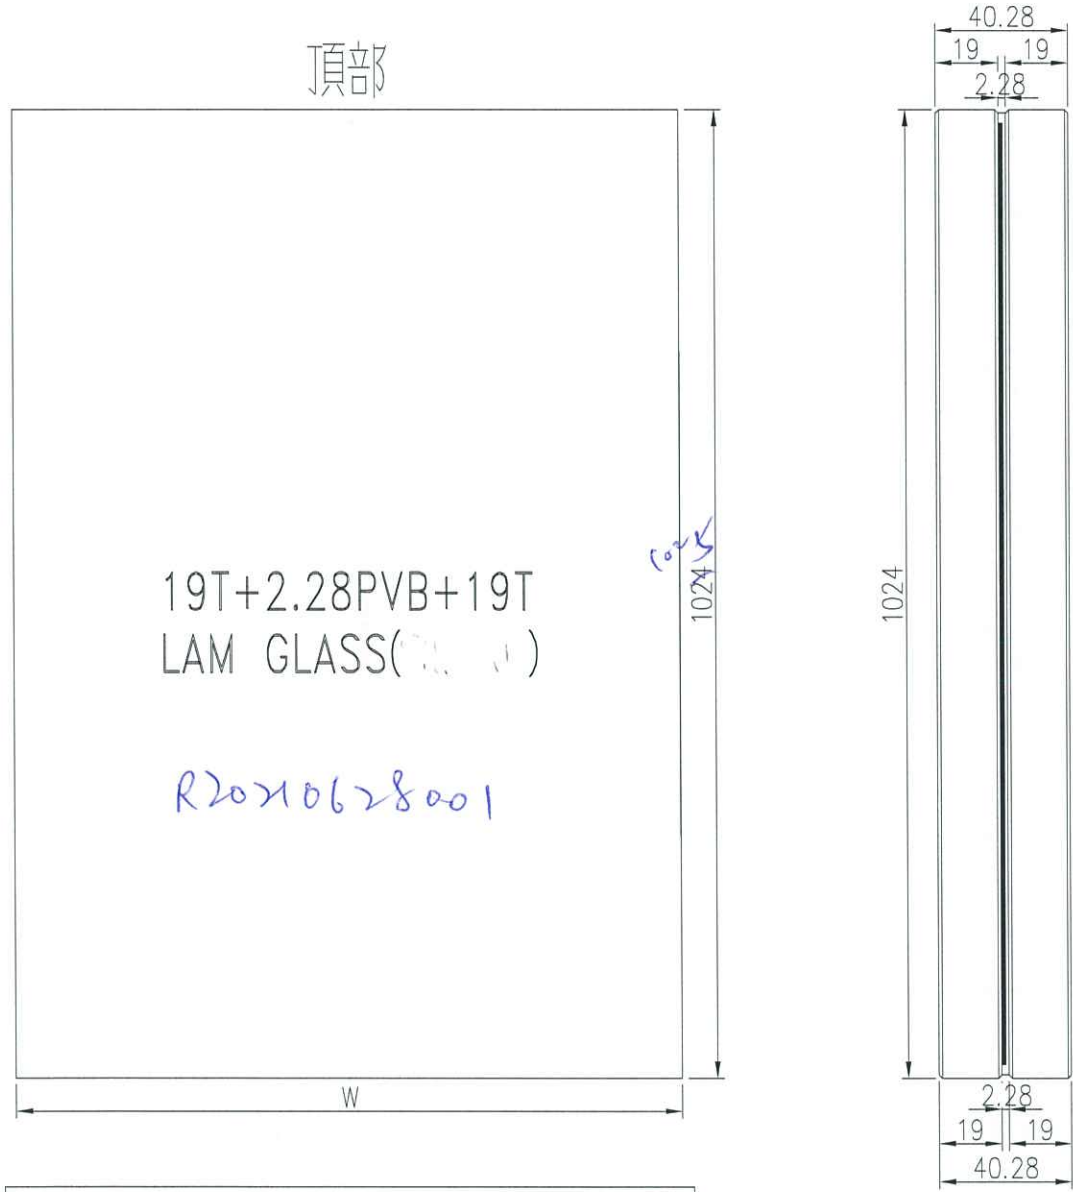

室外面

*左右两边需倒棱角及精磨邊

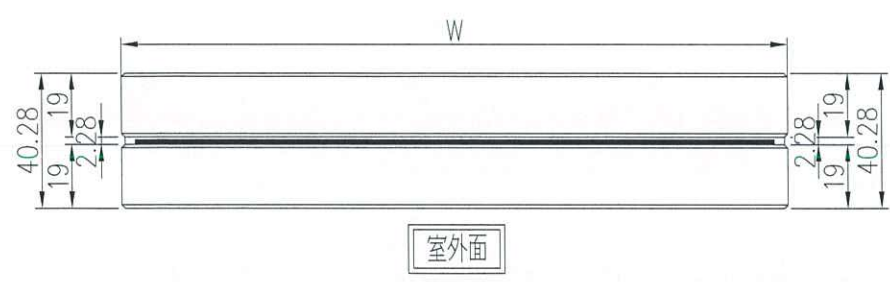


名稱	玻璃加工圖	制圖	吳禕瑜	2019.4.19	修改		
材料		復核			日期		
顏色		批准			圖號	J852-SX-A01	



美特鋁質 有限公司
MIDI Aluminium Fabricator Ltd.

工程號 J-852 地盤 亞皆老街

Handwritten notes:
4.28
3.85
4.270
1.55
4.270

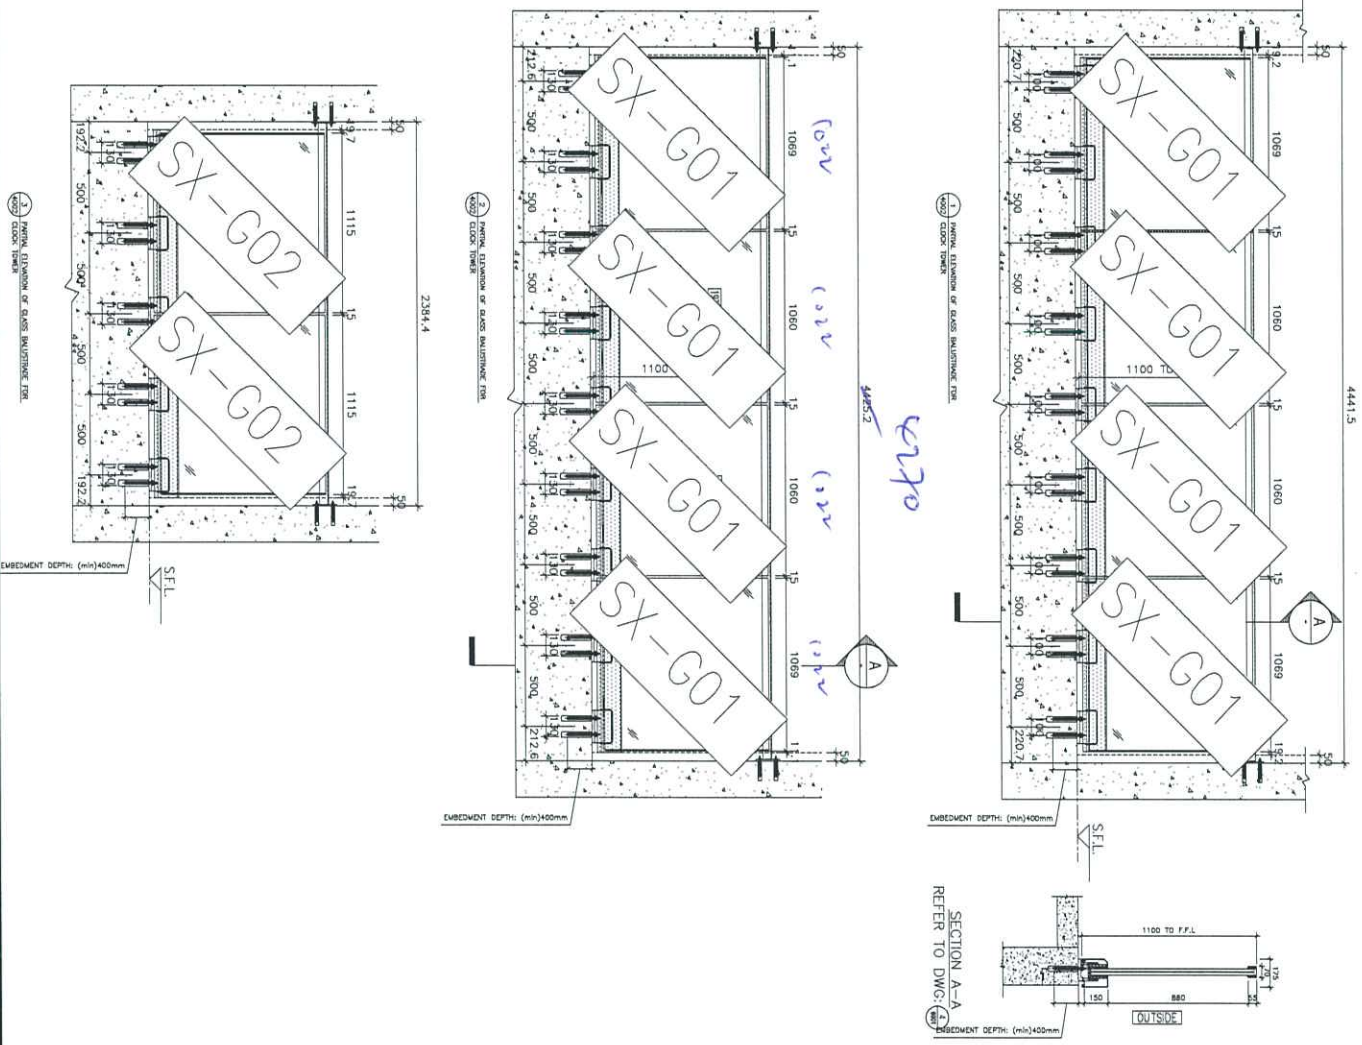

名稱	玻璃安裝位置圖	制圖	WYY	2021.6.05	修改	
材料		復核			日期	
顏色		批准			圖號	852-SX-BLW1

Handwritten signature: YF




工程號

J-852

地盤


亞皆老街

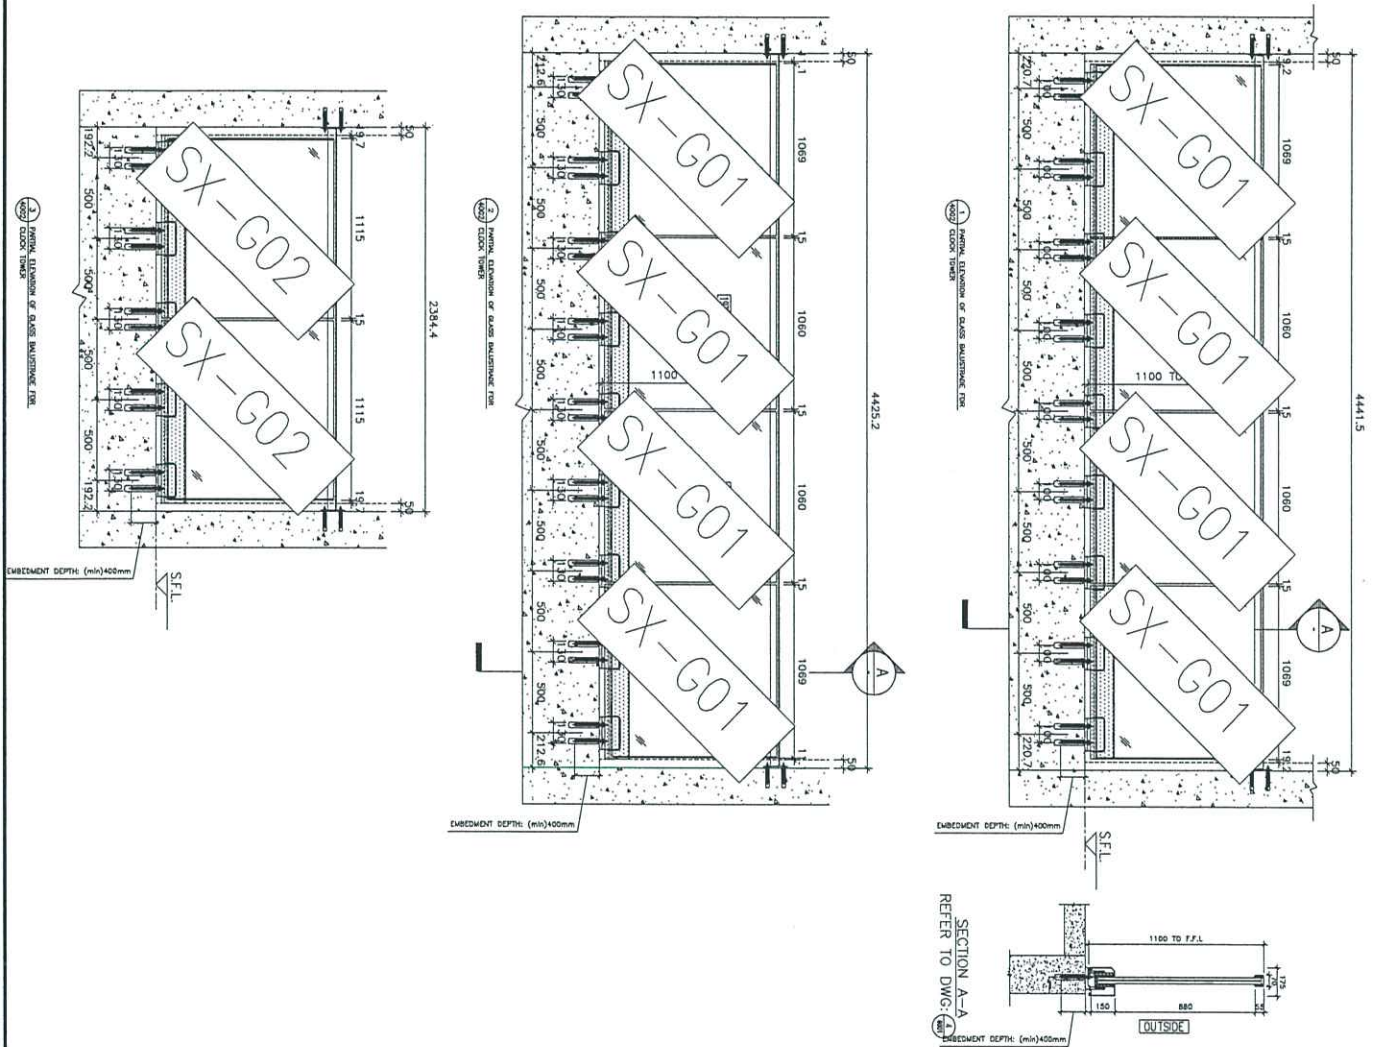

名稱	玻璃安裝位置圖	制圖	WYY	2021.6.05	修改		
材料		復核			日期		
顏色		批准			圖號	852-SX-BLW1	

2/2

✓

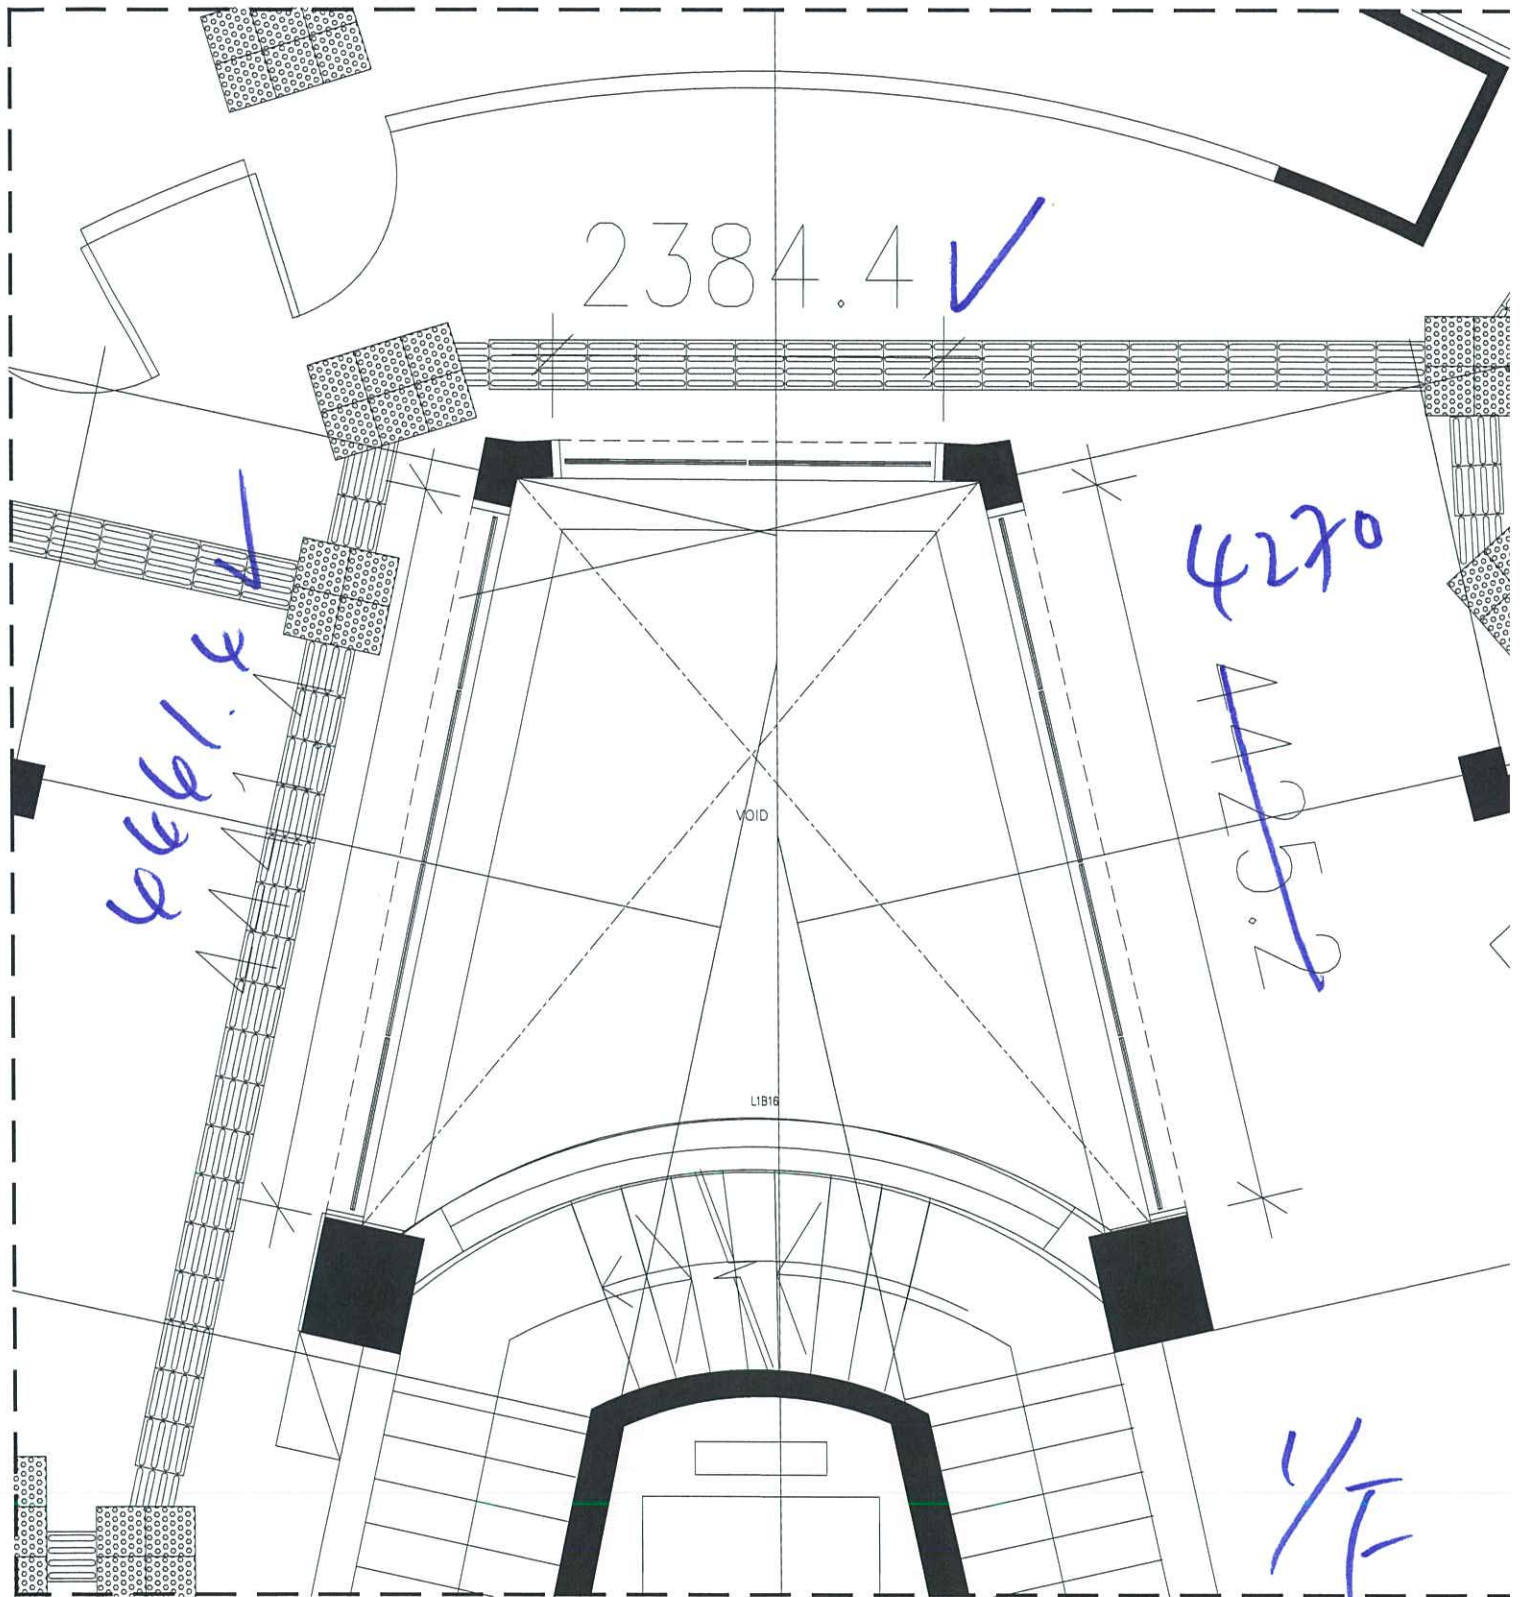

2384.4 ✓

4661.4


4270

4250.2

VOID

LIB16

1/2

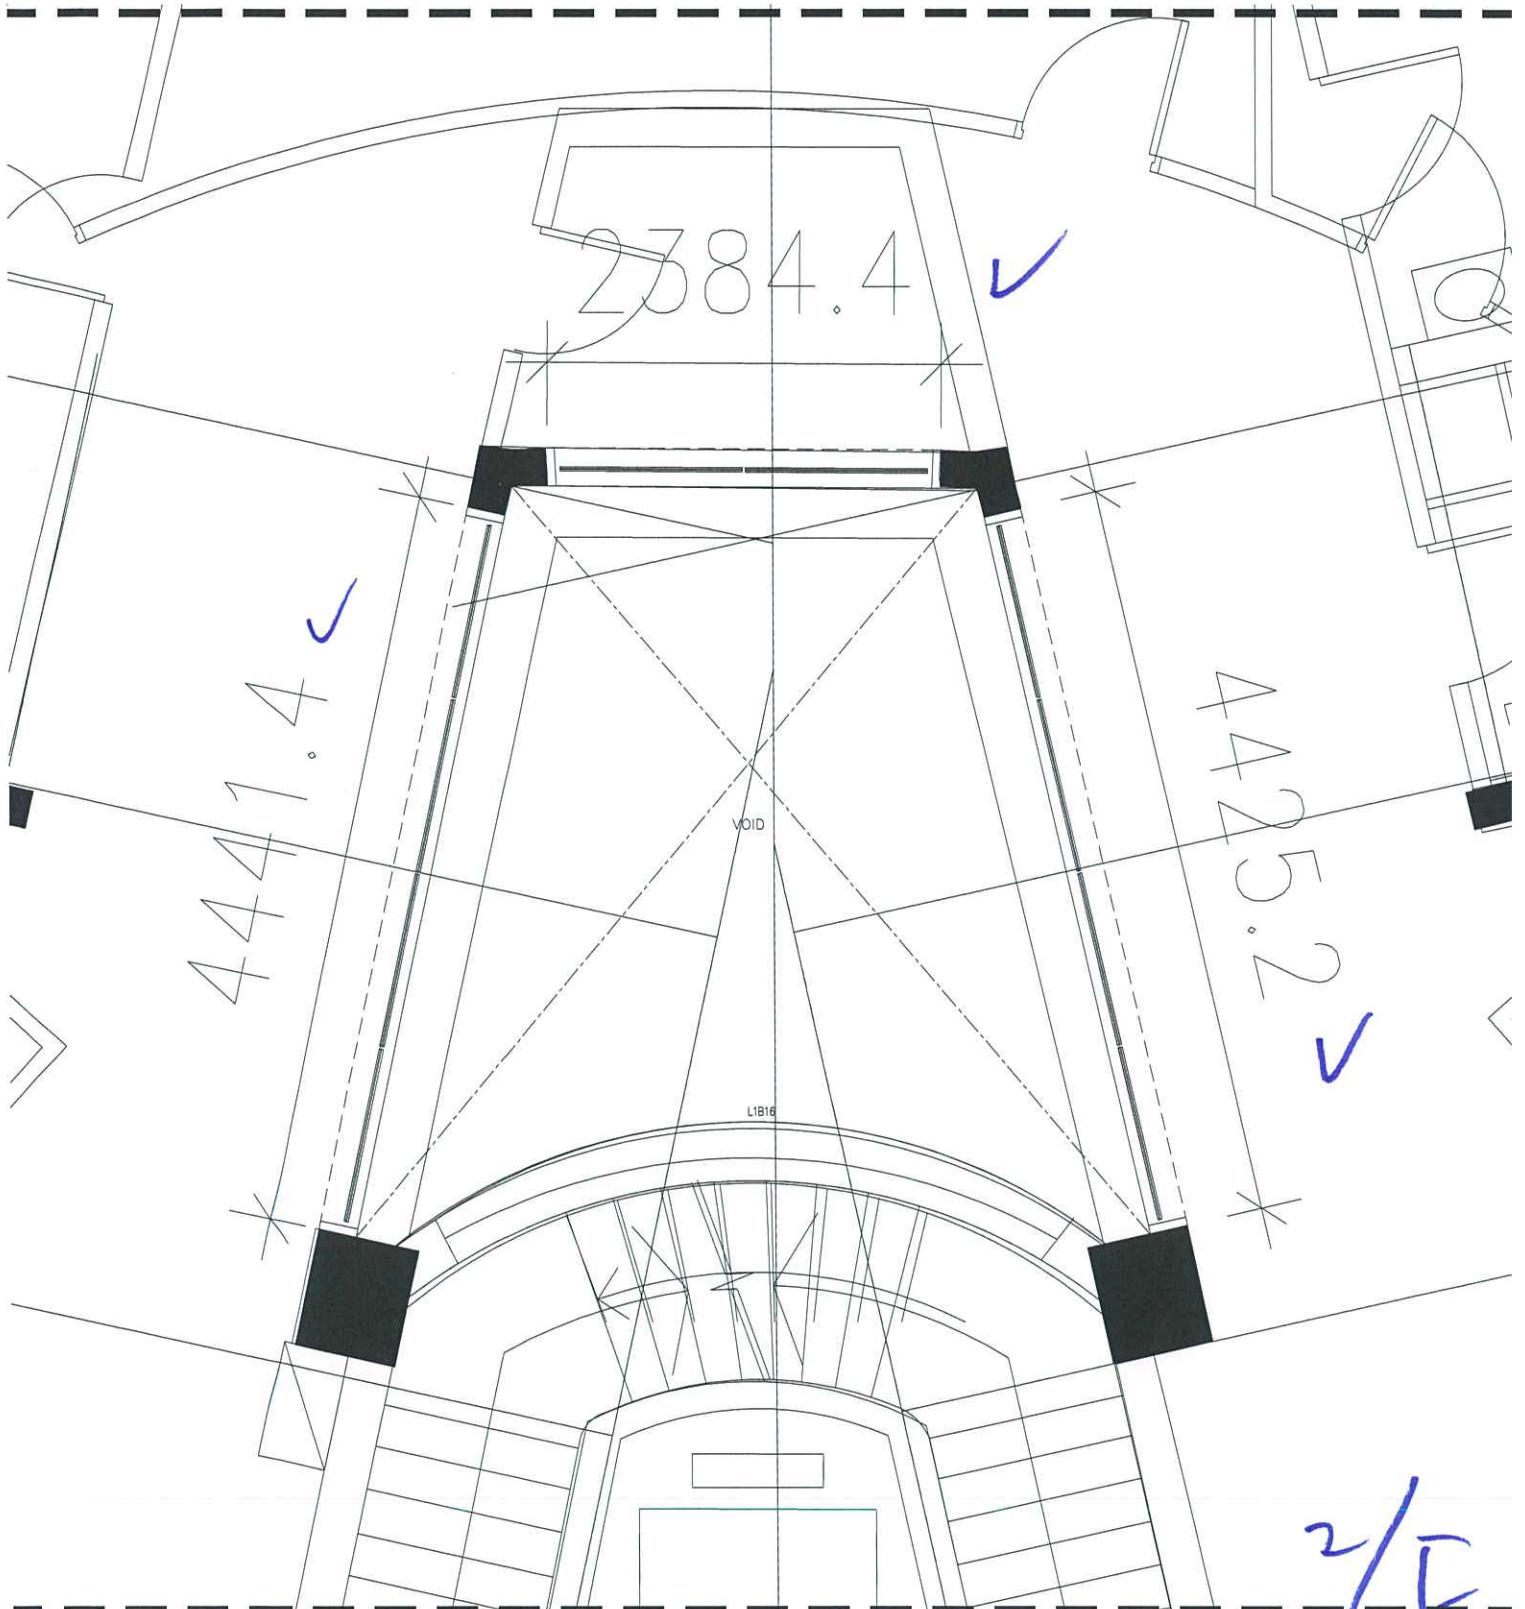

Project: CLP Development Project (KIL6038)

Site Instructions

S.I. No.: APM, PS, J.C. 12021 8 13 17:00
(Parties / Company / Issued Person / Year / Month / Date / Time)

To
(Contractor): GECCL, Midi

Location : CTB

Instructions:

To adopt low iron glass for
CTB glass balustrade.


For your immediate action on site
Drawing No. / Sketches No. Email record from
Graham dated 12 Aug 2021

Reasons for this Instruction:

As per request from CTB interior designer
Sugar-

Issued By:

Acknowledge Receipt:


Name, Title & Signature


Name, Title & Signature

Total Pages: 1/10

Contractor's Copy



MATERIAL / SAMPLE SUBMISSION FORM

To : **Mr Brian Leung / Mr Nigel Lo / Eunice Yan**
Meinhardt Façade Technology (HK) Ltd
22/F Great Smart Tower,
230 Wanchai Road,
Wan Chai, Hong Kong

No. MS/A/326 (Rev. 1)

Date: 31 August 2021

REQUIRED APPROVAL DATE: Immediately

Ref. J3860/304.6/D11764

We submit the following material for your comment / approval by the date indicated above.

Sub-Contractor / Trade: Midi Aluminium Fabrication Ltd. / Curtain Wall, Aluminium Windows and Louvres, Aluminium Cladding and Glass Balustrade

Material Description: Submission of Glass Samples for Bulk Order - Glass Balustrade at Clock Tower (Midi's Ref.: MS093)

Comply fully w/ Specification
N.A.

Not comply fully with Specification (Deviation Listed herein)
N.A.

Equipment Originally Offered

Type : Glass
Manufacturer : Avic Sanxin
Origin : China
Model No : D21031633 (19C+2.28T+19C)

Equipment Offer

Type : Glass
Manufacturer : Avic Sanxin
Origin : China
Model No : R20210628001
(19mm low iron + 2.28 pvb + 19mm low iron)

Reason for change if any : Site Instruction (Ref. No.: SI/APM/PS/JC/2021/08/13/1700)

Location for use: Clock Tower (Glass Balustrade)

Enclosures: Catalogue Data / Specification Certificate / Approval
 Test Report Material Sample Installation Drawing
 Job Reference Schedule Other (specify): Demarcation of glass

Remarks: The glass sample boards are kept on site for review and approval.

cc Pacific Shine - Mr Billy Tang / Mr Kocher Wong / Mr Edwin Chow / Mr Simon Chung / Mr Ross Pau / Mr Ken Ng / Mr Wyman Fong / Mr Jimmy Cheung / Mr C F Lee / Mr Peter Chong
 AGC - Ms Grace Cheng / Mr Tony Lam / Mr Raymond Ho
 ARUP (Stru) - Mr Johnson Po / Mr Keith Ng / Mr Wayne Ke
 W&O - Mr Nier Chan / Mr Anson Lau
 Arcadis - Ms Brenda Mok / Ms Emily Chu
 AXXA - Mr Bernard Chung / Mr Jason Teo
 ARUP (Traffic) - Ms Carmen Chu / Mr Eddy Cheung
 WSP - Ms Anthea Ng / Mr Dennis Tse
 RE - Mr Edwin Lui / Ms Jini Lai / Mr Jayden Wong
 MFT (RE) - Ms Cosimo Wong / Mr Neo Wong
 AECOM - Mr Tony Ng / Ms Lee Ka Wing
 Sugar - Mr Fred / Mr William Lau
 OSR - Mr H T Tseung / Mr Poon Tsz Kit / Mr Jaja Wong / Mr Elvis Lam
 BSI (Sino) - Mr Kelvin Tam
 RBSE (W&O) - Mr Kevin Lee
 S/C - Midi (By Email)

Dick Yuen
Senior Project Manager
Gammon Engineering &
Construction Company Limited
DY/RW/CK/ML/wym
Encl

Architect's / Consultant's Reply

Approved (A) Approved with comment (B) Approved with comment & resubmit (C) Rejected (D)

Comments : Subject to client's and project architect's comment on aesthetic.
And also subject to BD approval drawings.

Signed : PP = Bruce Designation : MFT Date : 8 Oct 2021
Remarks : w/encl. w/o encl



美特鋁質有限公司
MIDI ALUMINIUM FABRICATOR LTD.

Our ref. MC/40413/852

26th August 2021

Gammon Engineering & Construction Company Limited
139 - 147 Argyle Street,
Kowloon, Hong Kong

By Email & Hand

Attn.: Mr. Dick Yuen / Ms. Penny Chau

Dear Sir,

Re : Design, Supply & Installation of Aluminium Window & Cladding, Curtain Wall, Glass Wall, Lourves and Glass Balustrade Nominated Sub-Contract at K.I.L. 6038RP, K.I.L.6037RP, K.I.L. 6036RP, K.I.L. 6035RP & K.I.L. 6005, Nos. 139-147 Argyle Street, Kowloon.
Submission of Glass Sample for Bulk Order - Glass Balustrade at Clock Tower (MS093)

Regarding the captioned project, we would like to submit the glass sample for bulk order for your review and comment.

1) 19mm Low Iron Tempered+ 2.28PVB + 19mm Low Iron Tempered Laminated Glass
Sample Code: R20210628001
Location: Glass Balustrade at Clock Tower

Remarks:

The glass sample will be delivered to site office directly with 2 sets. For Details, please refer to the attached location plan, glass data and sample photos.

Thank you for your kind attention.

Yours faithfully,
MIDI ALUMINIUM FABRICATOR LTD.

Francis Mau
Managing Director

Encl

cc. Gammon	- Mr. Chris Kwok / Ms. Myra Li / - Ms. Esther Chung / Mr. Sam Tang / - Mr. Jackson Mok / Mr. Joe Ng	(w/e)
Sino	- Mr. Billy Tang / Mr. Jimmy Cheung / - Mr. Terry Wan / Mr. Jaja Wong	(w/e) (Email Only)
AGC	- Mr. Raymond Ho / Mr. Eliot Chan	(w/e) (Email Only)
MFT	- Mr. Brian Leung / Mr. Nigel Lo - Ms. Eunice Yan / Ms. Cosimo Wong / Mr. Neo Wong	(w/e) (Email Only)

EM/MT/DW/AY/EL/KL/wk

九龍茶果嶺道610號生利工業中心1樓6-8號
Units 6-8, 1st Floor, Sunray Industrial Centre, 610 Cha Kwo Ling Road, Kln.
TEL. (電話): 2348 9211 FAX. (傳真): 2772 7666 E-mail Address (電郵): midi@miditd.com.hk.



ISO 9001 : 2015
Certificate No: CC 1795