

工程指示 / 要求簡箋(E.I.)

工程指示編號：EI / 3930 / 21

修改版次：A

工程編號：J - 853

工程名稱：延坪道住宅項目

工程項目：平台 Glass Door 用鋁飾線模圖 *x 86038*

收件人：Maggie

發件人：Ant Yeung

日期：25/10/2021

要求提供 / 確認 事項：

- () 初步鋁料 B.M. () 加工拆圖，然後生產 () 尺寸表
- () 正式鋁料 B.M. () 技術上資料 / 指示 () 報價
- () 配件 B.M. () 樣辦或貨品說明書 () 分判合約
- () 其他：_____

內容：

A 版: 標示 VF 面

請安排畫新模圖，平台 glass wall 用飾線

謝謝。

請在 2021 / 10 / 26 29 前完成上列要求。

附：(頁

以上項目為:

- 原合約工程包 原合約工程加 / 減賬 新工程報價

原因：-

分發東莞各部門：

- () 生產技術總監 連附件 () 技術部 連附件 () 生產部 連附件 () 機械設計部 連附件
- () 採購部 連附件 () 生產統籌部 連附件 () 小羅 & 清 連附件
- () 質檢部 連附件 () 會計部 連附件 () 報關組 連附件 () 其他 _____ 連附件

分發其他分判：

- () 水洪 連附件

分發香港各部門：

- () 行政部 連附件 () 會計部 連附件 () 統籌部 連附件 () 工程部地盤科文 連附件
- () 採購部 連附件 () QS 部 連附件 () 維修部 連附件 () 其他 _____ 連附件

傳遞編號：

HK *1949* / 21

發件人簽署：

項目經理簽署：

Z
hgr



MIDI ALUMINIUM FABRICATOR LTD.


DRAWING NO.

REV. **A**

TITLE

~~X86xxx~~

X86038

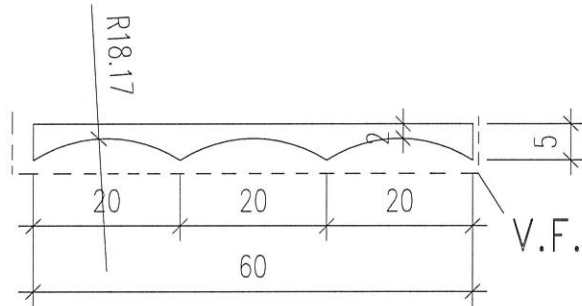

— — — V.F.

APPROVED :

6063-T5

b=R0.5

NOTE: Unspecified thickness _____ mm
Radii on unspecified corner (max. 0.3 mm)

SECTIONAL AREA	mm ²	ADDITIONAL TOLERANCE	DATE	REVISION			
				NO.	DATE	NAME	DESCRIPTION
177		Thickness ± 0.1 mm	04/01/2020				
WEIGHT	KG/M	Flatness 0.1 /25mm width	SCALE				
0.48		Straightness 0.3 /300mm	1 : 1				
PERIMETER	mm	Twist 0.5° /300 mm max	DRAWN				
133.5		Angularity ± 1.0 degree	-				
V.F.	mm		CHECK				
144.617							