

工程指示 / 要求簡箋(E.I.)

工程指示編號：EI / 4002 / 21

修改版次: G

工程編號 : J - 852

工程名稱 : 亞皆老街中電

工程項目 : 平台 Glass Wall 廠用鋁板 優先 G/F ^{LG/F}

收件人 : 生統

發件人 : Ant Yeung

日期 : 06/01/2022

要求提供 / 確認 事項 :

- | | | |
|------------------------------------|-------------------------------------|-------------------------------|
| <input type="checkbox"/> 初步鋁料 B.M. | <input type="checkbox"/> 加工拆圖, 然後生產 | <input type="checkbox"/> 尺寸表 |
| <input type="checkbox"/> 正式鋁料 B.M. | <input type="checkbox"/> 技術上資料 / 指示 | <input type="checkbox"/> 報價 |
| <input type="checkbox"/> 配件 B.M. | <input type="checkbox"/> 樣辦或貨品說明書 | <input type="checkbox"/> 分判合約 |

內容 :

→ G 版 G/F, 優先生產 G/F 的平台門 GDZK 41 和 GDZK-40 的門玉 16 對門玉 (共 32 隻)

F 版 G/F 地鎖分 ABC 3 款, A3x2 套; B2x2 套; C3x2 套, 請廠生產時留意地鎖的配套, 請地盆留意同一間房, 用同一條鎖匙。合共 3 條匙

E 版: 補回地鎖避位

D 版: 補回 pivot 和底巴避位

請按加工圖生產鋁板.

附: 2021/12/09 完成 1/1, 1/2 到 1/2 對 41. ^{GDZK.}

以上項目為:

- 原合約工程包 原合約工程加 / 減賬 新工程報價

原因 :-

分發東莞各部門 :

- | | | | |
|--|---|--|---|
| <input type="checkbox"/> 生產技術總監 <input type="checkbox"/> 連附件 | <input type="checkbox"/> 技術部 <input type="checkbox"/> 連附件 | <input type="checkbox"/> 生產部 <input type="checkbox"/> 連附件 | <input type="checkbox"/> 機械設計部 <input type="checkbox"/> 連附件 |
| <input type="checkbox"/> 採購部 <input type="checkbox"/> 連附件 | <input checked="" type="checkbox"/> 生產統籌部 <input checked="" type="checkbox"/> 連附件 | <input type="checkbox"/> 小羅 & 清 <input type="checkbox"/> 連附件 | |
| <input type="checkbox"/> 質檢部 <input type="checkbox"/> 連附件 | <input type="checkbox"/> 會計部 <input type="checkbox"/> 連附件 | <input type="checkbox"/> 報關組 <input type="checkbox"/> 連附件 | <input type="checkbox"/> 其他 <u>楊榮輝</u> <input type="checkbox"/> 連附件 |

分發其他分判 :

- 水洪 連附件 (v) 秋 連附件

分發香港各部門 :

- 行政部 連附件 會計部 連附件 統籌部 連附件 林哥 工程部地盤科文 連附件 有哥, 祥哥
 採購部 連附件 QS 部 連附件 維修部 連附件 其他 _____ 連附件

傳遞編號 :

發件人簽署 :

HK 0037 / 21

項目經理簽署 :

BL REF 1

CLIENT :

PROJECT :

WORK CONTRACT :

AGC DESIGN LTD
110, HONG KONG AVENUE
HONG KONG



ARUP
STRUCTURAL ENGINEERS

MEINHARDT
LOCAL CONSULTANT

- NOTE:
1. ALL DIMENSIONS ARE IN MM.
 2. ALL DIMENSIONS ARE FROM FINISH SURFACE.
 3. ALL DIMENSIONS TO BE SHOWN ON THE DRAWING INDICATION.

SYSTEMS:

- 1. (1) --- 200A MARK NO.
- 2. (2) --- 200B MARK NO.
- 3. (1/1) --- FINISHED FLOOR LEVEL.
- 4. (2/1) --- STRUCTURAL FLOOR LEVEL.
- 5. (3) --- REARER EDGE.
- 6. (1/2) --- Glass The IMPERVED GLASS.
- 7. (1/3) --- Glass The IMPERVED GLASS.

NO.	DESCRIPTION	STATUS
1	REVISION	REVISION MADE BY DATE
2	REVISION	REVISION MADE BY DATE
3	REVISION	REVISION MADE BY DATE
4	REVISION	REVISION MADE BY DATE
5	REVISION	REVISION MADE BY DATE
6	REVISION	REVISION MADE BY DATE

PROJ NO. : J-1827

PROJECT :

PROPOSED DEVELOPMENT
AT KOWLOON ISLAND,
LOT Nos. 6030A/F, 6030B/F, 6030C/F,
6030D/F, AND LOT No. 6005.

TITLE :


ELEVATION & PART PLAN
FOR GLASS WALL(G/F)

DATE : 25-Mar-21

SCALE : 1:10

DRAWN BY : GAN


CHECKED BY : JYW

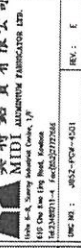

UNIT 10, Sunny Industrial Centre, 1/F
MTR COOKWATER STATION, 1/F
MTR COOKWATER STATION, 1/F
MTR COOKWATER STATION, 1/F

PHONE NO. : 852-4524-0011


FAX : E

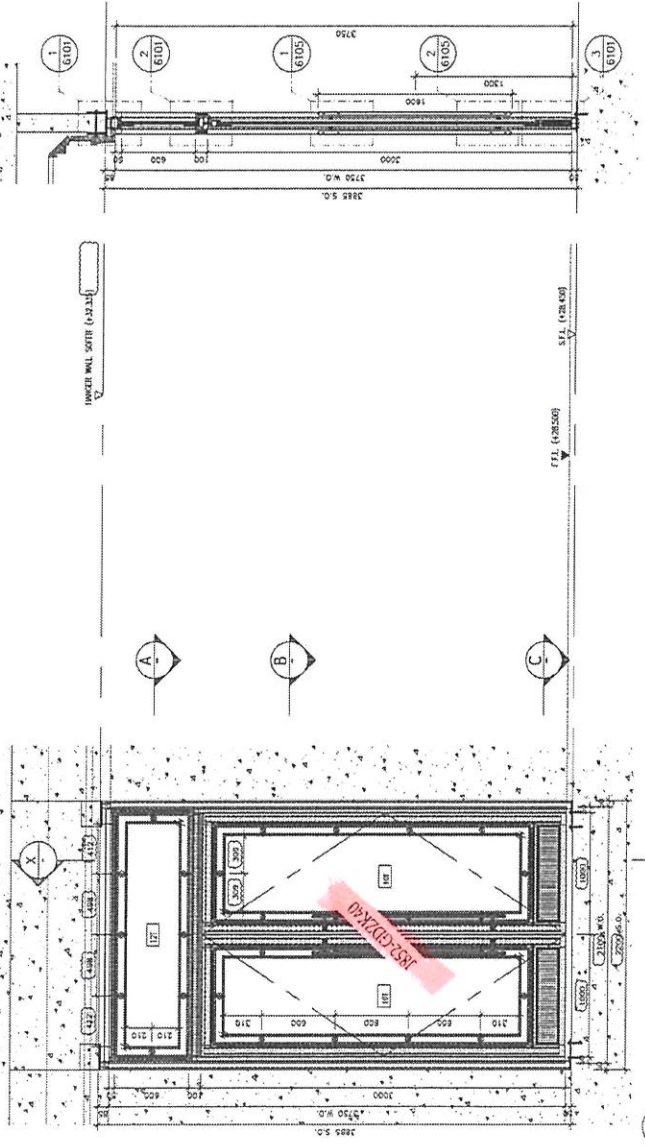


SECTION X

ELEVATION

PART PLAN A

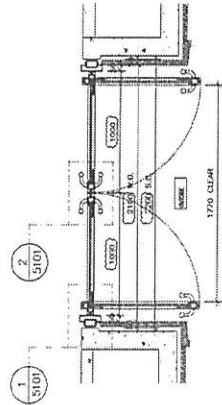

PART PLAN B

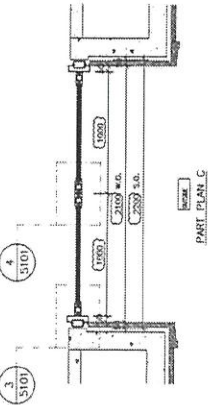

PART PLAN C

FLOOR	LOCATION	GLASS WALL MARK	CITY
G	TOWER 1 LIFT LOBBY	T101/G	1

REV. NO. :

CLIENT :

ARCHITECT :
AGC DESIGN LTD
100, WING LOK STREET, HONG KONG

STRUCTURAL ENGINEER :
GAMMON
ARUP
MEINHARDT


NOTE:
1. ALL DIMENSIONS ARE IN mm.
2. ALL DIMENSIONS ARE MEASD FROM OUTSIDE.
3. ALL DIMENSIONS TO BE CHECKED ON SITE.
BEFORE IMPLEMENTATION.

LEGEND:
① TOTAL MARK NO.
② FINISHED FLOOR LEVEL
③ STRUCTURE INSIDE DIMS
④ FINISHED CEILING
⑤ DOWN THE THUMBING GUIDES
⑥ DOWN THE THUMBING GUIDES

1	GLASS PANEL	WORKS MADE TO PANEL NUMBER
2	GLASS PANEL	WORKS MADE TO PANEL NUMBER
3	GLASS PANEL	WORKS MADE TO PANEL NUMBER
4	GLASS PANEL	WORKS MADE TO PANEL NUMBER
5	GLASS PANEL	WORKS MADE TO PANEL NUMBER
6	GLASS PANEL	WORKS MADE TO PANEL NUMBER
7	GLASS PANEL	WORKS MADE TO PANEL NUMBER
8	GLASS PANEL	WORKS MADE TO PANEL NUMBER
9	GLASS PANEL	WORKS MADE TO PANEL NUMBER
10	GLASS PANEL	WORKS MADE TO PANEL NUMBER


JOB NO. : J-822
 PROJECT :
 PROPOSED DEVELOPMENT
 AT KOWLOON PLAZA,
 LOT Nos. 603B/1P, 603B/2P, 603B/3P,
 603B/4P, AND LOT No. 6005
 TITLE :
 ELEVATION & PART PLAN
 FOR GLASS WALL (C/F)

DATE : 25-10-21 SCALE : 1:45
 DRAWN BY : CM CHECKED BY : DW
 MIDT ARCHITECTURE FABRICATOR LTD.
 100 Cheong Cheong Street, Tsim Sha Tsui,
 Kowloon, HONG KONG
 REGISTRATION NO. : 6022-FCM-1022
 REV. : E

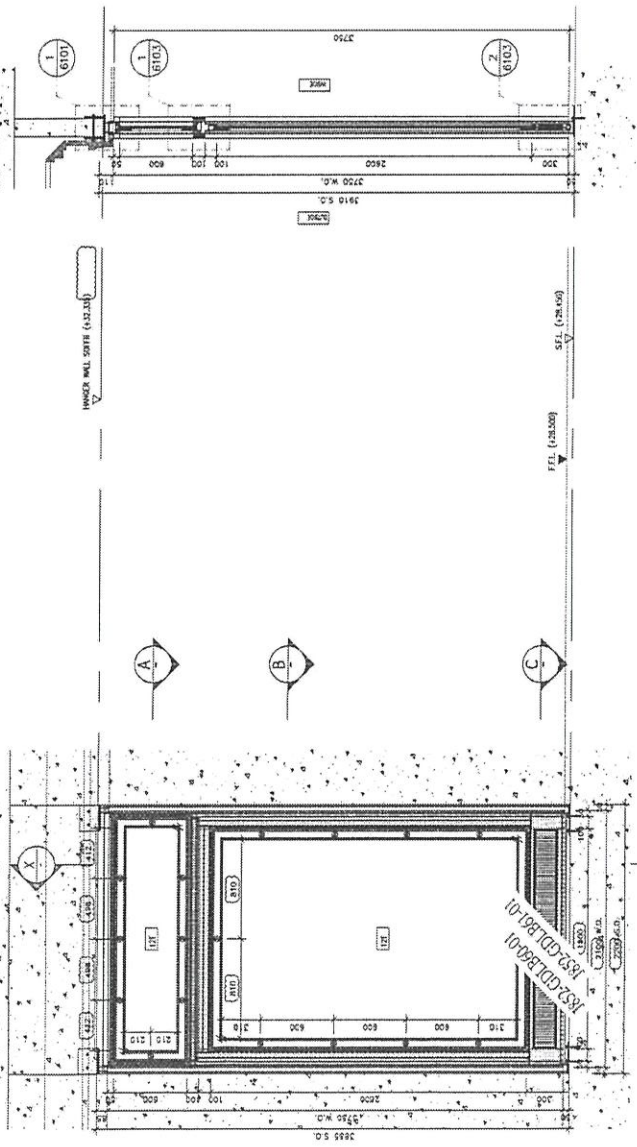


SECTION X


ELEVATION

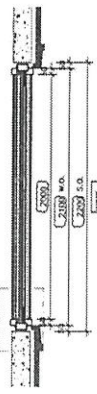

PART PLAN A

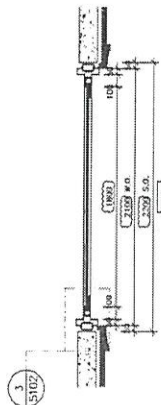

PART PLAN B

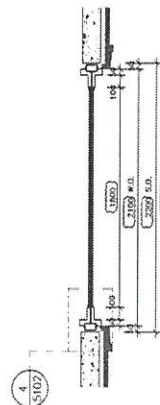

PART PLAN C

FLOOR	LOCATION	GLASS WALL MARK	QTY
C	TOWER 1 LIFT LOBBY	T102/C	1

REV. REF.

DATE:

ADDRESS:

MAIN CONTRACTOR:

AGC DESIGN LTD
2, BANGSAKULAN
100, BANGSAKULAN
100, BANGSAKULAN



NOTE:
1. ALL DIMENSIONS ARE IN mm.
2. ALL DIMENSIONS ARE MEASURED FROM CENTERLINE UNLESS OTHERWISE SPECIFIED.
3. ALL DIMENSIONS TO BE CHECKED ON SITE.

SYMBOLS:
1. 1/1L --- FINISHED FLOOR LEVEL
2. 5/1L --- STRUCTURAL FLOOR LEVEL
3. 1/1P --- REFERENCE LEVEL
4. 1/1E --- DIMENSION TO THE EXTERIOR SURFACE
5. 1/1S --- DIMENSION TO THE CENTERLINE

1	GLASS	GLASS WALKWAY TO G/F LOBBY
2	GLASS	GLASS WALKWAY TO G/F LOBBY
3	GLASS	GLASS WALKWAY TO G/F LOBBY
4	GLASS	GLASS WALKWAY TO G/F LOBBY
5	GLASS	GLASS WALKWAY TO G/F LOBBY
6	GLASS	GLASS WALKWAY TO G/F LOBBY
7	GLASS	GLASS WALKWAY TO G/F LOBBY
8	GLASS	GLASS WALKWAY TO G/F LOBBY
9	GLASS	GLASS WALKWAY TO G/F LOBBY
10	GLASS	GLASS WALKWAY TO G/F LOBBY


PROJECT: PROPOSED DEVELOPMENT AT HONGKONG BEACH, LOT 100, GOSWELL, GOSWELL, 603797P, GOSWELL, AND LOT No. 6045

TITLE: ELEVATION & PART PLAN FOR GLASS WALKWAY

DATE: 25-Mar-21
SCALE: 1:40
DRAWN BY: CM
CHECKED BY: CM


MEINHARDT ARCHITECTURE FABRICATOR LTD.
101 Cheong Chee Road, Singapore, S'pore
Tel: 65 6337 7756
Fax: 65 6337 7756

REV: 1

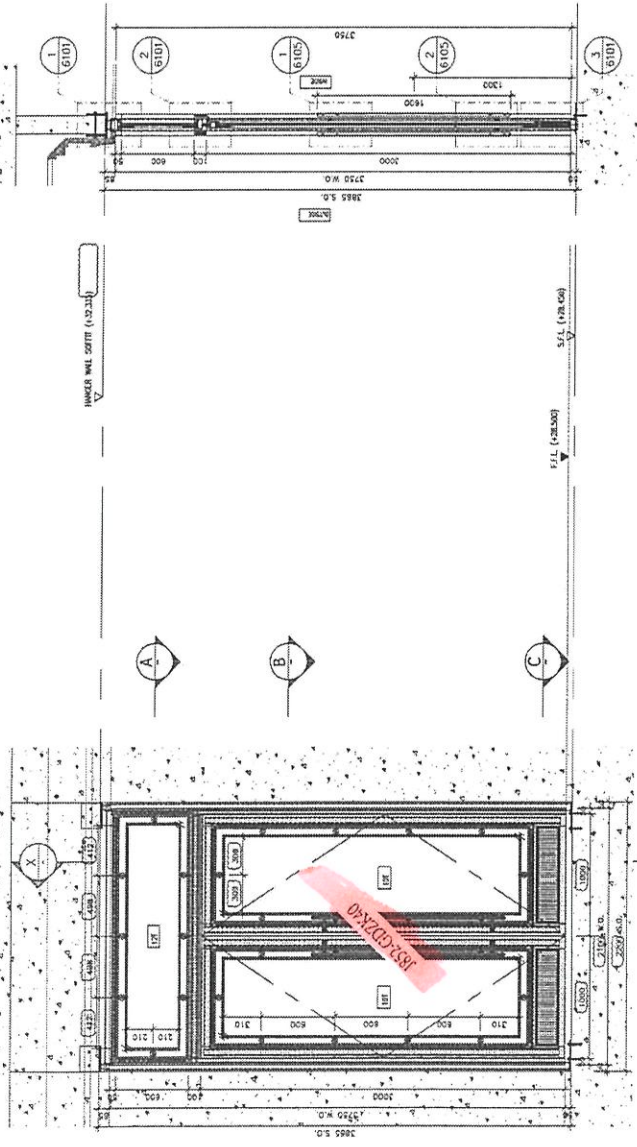


SECTION X


ELEVATION

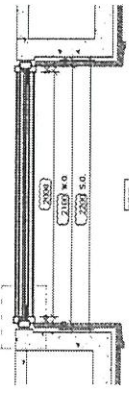

PART PLAN A

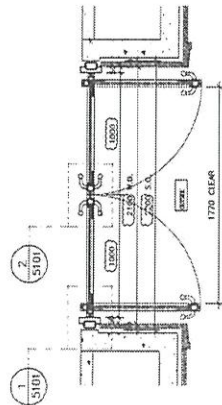

PART PLAN B

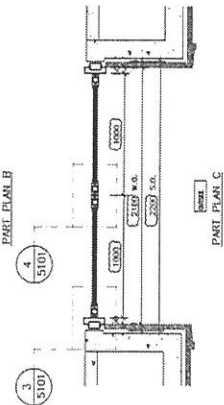

PART PLAN C

FLOOR	LOCATION	GLASS WALL MARK	QTY
G	TOWER 2 LIFT LOBBY	T201/G	1

REV. REF.

CLASS.

AGC REGISTERED ARCHITECTS

Gammon ARUP MEINHARDT

NOTES: 1. ALL DIMENSIONS ARE IN MM. 2. ALL DIMENSIONS ARE GIVEN FROM INTERSECTING FACE UNLESS OTHERWISE SPECIFIED. 3. ALL DIMENSIONS TO BE VERIFIED ON SITE BEFORE CONSTRUCTION.


LEGEND: 1. F.F.L. --- FINISHED FLOOR LEVEL. 2. G.F.L. --- GRASSING FLOOR LEVEL. 3. R.F.L. --- ROOF FLOOR LEVEL. 4. T.F.L. --- TOP OF FINISHED FLOOR LEVEL. 5. T.C.L. --- TOP OF CONCRETE LEVEL.

Table with 4 columns: No., Description, Quantity, Unit. Includes items for window frames and glass panels.

PROPOSED DEVELOPMENT AT NON-LOCAL PLANS, LOT Nos. 6035EP, 6036EP, 6037EP, 6038EP, AND LOT No. 6005. ELEVATION & PART PLAN FOR CLASS WALL(S) (S7)

DATE: 20-11-21 SCALE: 1:10 DRAWN BY: CM CHECKED BY: DW

美特铝业有限公司 MTDI ALUMINIUM FABRICATOR LTD.

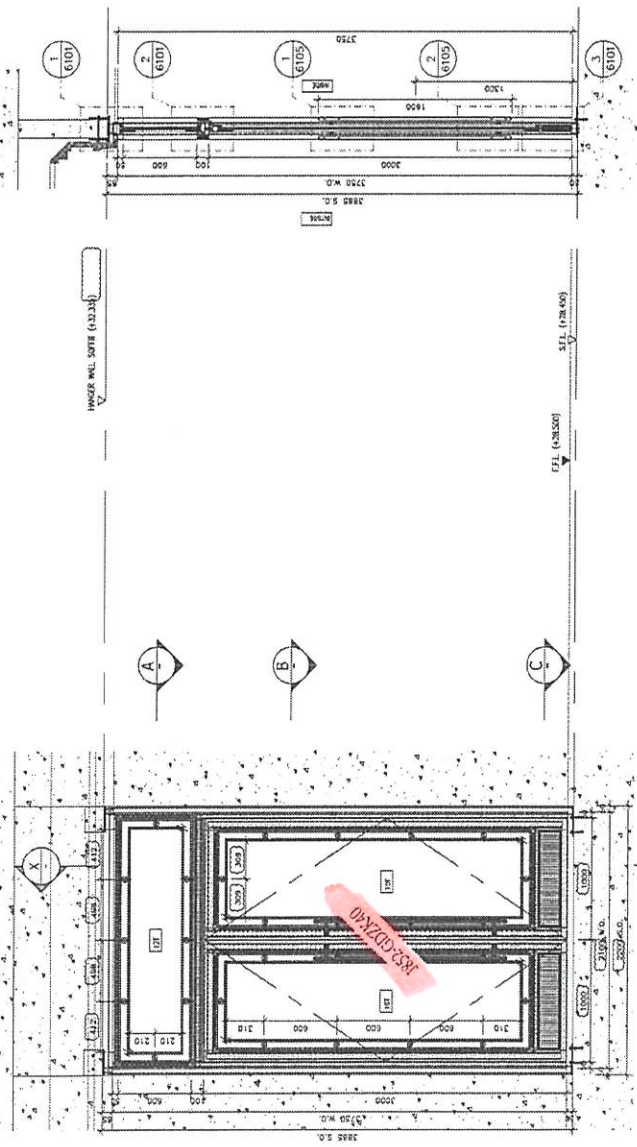

SECTION X

ELEVATION


PART PLAN A

PART PLAN B

PART PLAN C

Table with 4 columns: FLOOR, LOCATION, CLASS WALL, MARK, QTY. Row 1: G, TOWER 2 LIFT LOBBY, 1202/G, 1.

AGC DESIGN LTD 110, BANGKOK ROAD, SUKHUMVIT 11, BANGKOK 10110, THAILAND TEL: 02-2546 1111 FAX: 02-2546 1112 WWW.AGCDESIGN.COM		Gammon CONSULTING ENGINEERS 110, BANGKOK ROAD, SUKHUMVIT 11, BANGKOK 10110, THAILAND TEL: 02-2546 1111 FAX: 02-2546 1112 WWW.GAMMON.COM		ARUP FACULTY CONSULTING 110, BANGKOK ROAD, SUKHUMVIT 11, BANGKOK 10110, THAILAND TEL: 02-2546 1111 FAX: 02-2546 1112 WWW.ARUP.COM		MEINHARDT 110, BANGKOK ROAD, SUKHUMVIT 11, BANGKOK 10110, THAILAND TEL: 02-2546 1111 FAX: 02-2546 1112 WWW.MEINHARDT.COM	
PROJECT: PROPOSED DEVELOPMENT AT NONGKOOK BEACH, LOT No. 6028A-P, 6028B-P, 6028C-P, 6028D-P, AND LOT No. 6025		DATE: 21-Mar-20		SCALE: 1:48		DESIGN BY: JDF	
TITLE: ELEVATION & PART PLAN FOR GLASS WALL(G/T)		DATE: 21-Mar-20		SCALE: 1:48		DESIGN BY: JDF	
NO.: 2-827		DATE: 21-Mar-20		SCALE: 1:48		DESIGN BY: JDF	

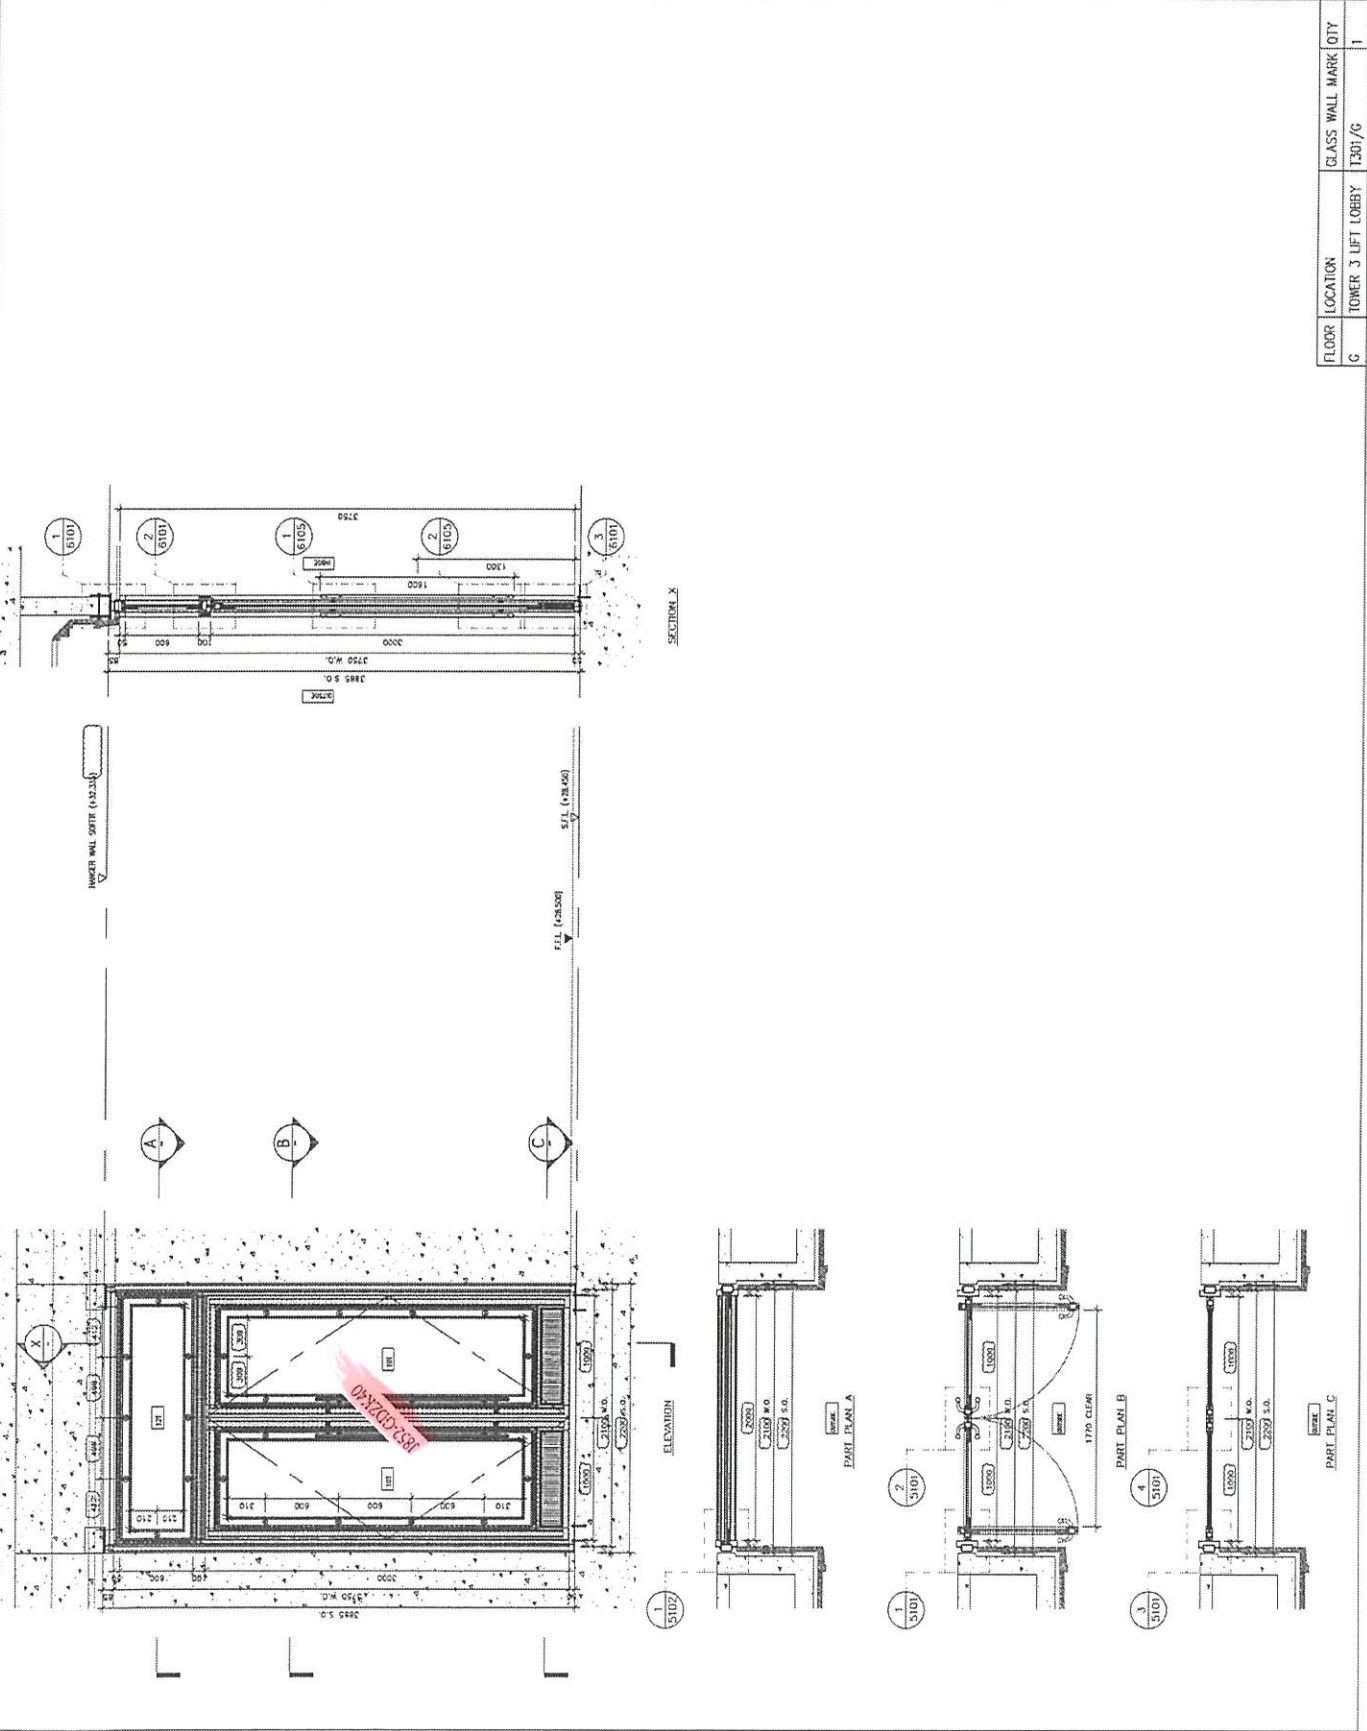

FLOOR	LOCATION	GLASS WALL MARK	QTY
C	TOWER 3 LIFT LOBBY	1301/G	1

REV. NO. 1

CLIENT:

AGC BISTREET LTD
AGC BISTREET LTD
AGC BISTREET LTD

Gammon
STRUCTURAL ENGINEER:
ARUP
FACE CONSULTANT:
WEINHARDT

SCALE:
1. 1/2" = 1'-0" (1:24)
2. ALL DIMENSIONS ARE IN METERS UNLESS OTHERWISE SPECIFIED
3. ALL DIMENSIONS TO BE VERIFIED ON SITE
REF: BME / 1000000

REVISIONS:

- 1. FEEL --- FINISHED FLOOR LEVEL
- 2. STL --- STRUCTURAL FLOOR LEVEL
- 3. --- UNFINISHED LEVEL
- 4. --- DOWN THE TEMPERED GLASS
- 5. --- DOWN THE TAMPING CLAYS

NO.	DESCRIPTION	DATE
1	ISSUED FOR PERMIT	10/10/2014
2	ISSUED FOR PERMIT	10/10/2014
3	ISSUED FOR PERMIT	10/10/2014
4	ISSUED FOR PERMIT	10/10/2014
5	ISSUED FOR PERMIT	10/10/2014

APP. NO.: J-832

PROJECT:
PROPOSED DEVELOPMENT
AT KOWLOON RIFARD,
LOT Nos. 6038EP, 6039EP, 6037EP,
6036EP, AND LOT No. 6035


TITLE:
ELEVATION & PART PLAN
FOR GLASS WALL(G)

DATE: 20-10-2014 SCALE: 1:140

DRAWN BY: GJM CHECKED BY: JON

美特鋁業有限公司
MIDI ALUMINIUM FABRICATOR LTD.
Unit 5-6, Sunny Shading Centre, 1/F
MAGNETIC LANE, KOWLOON, HONG KONG

REV. C

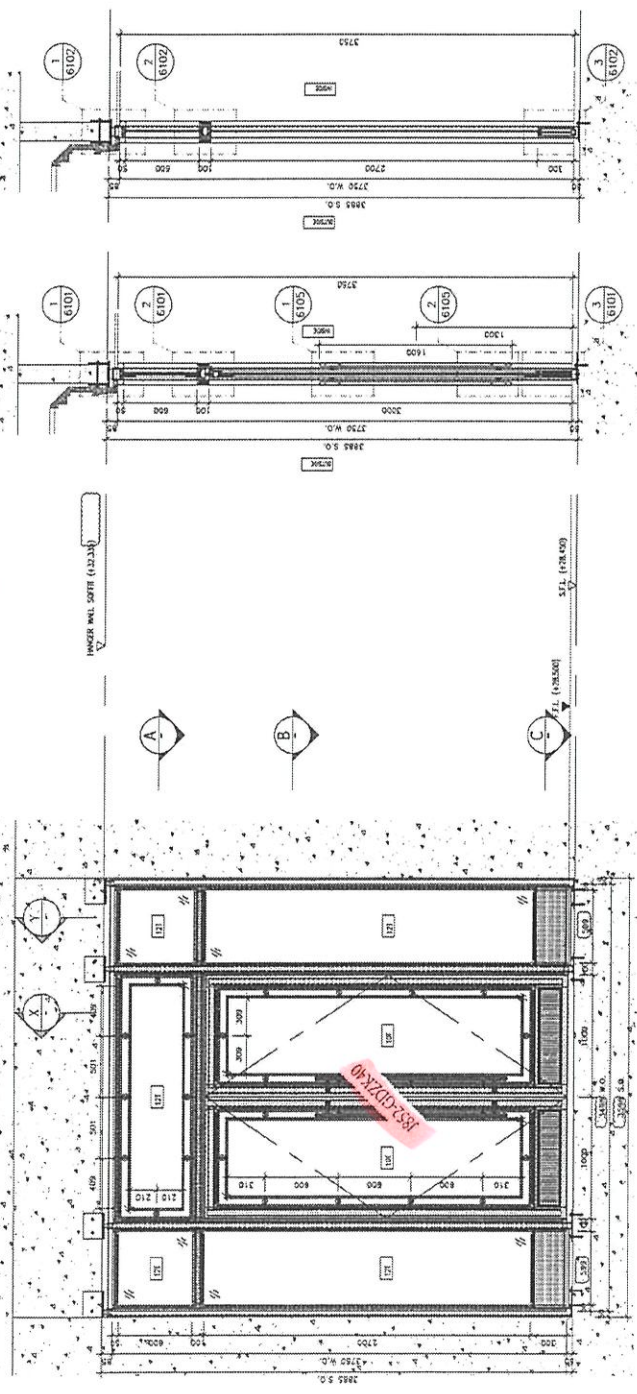

SECTION X

SECTION Y

ELEVATION

PART PLAN A

PART PLAN B

PART PLAN C

FLOOR	LOCATION	GLASS WALL MARK	QTY
C	CLUBHOUSE LOBBY	CH01/G	1

REV. REF. :

CLIENT :

PROJECT :

ARCHITECT :

STRUCTURAL ENGINEER :

MECHANICAL ENGINEER :

CONTRACTOR :

DATE :

Gammon

ARUP

WEINHARDT

STRUCTURAL ENGINEER

MECHANICAL ENGINEER

CONTRACTOR

REVISIONS

NO.	DESCRIPTION	DATE
1	ISSUED FOR PERMIT	20-MAR-21
2	ISSUED FOR PERMIT	20-MAR-21
3	ISSUED FOR PERMIT	20-MAR-21
4	ISSUED FOR PERMIT	20-MAR-21
5	ISSUED FOR PERMIT	20-MAR-21

PROPOSED DEVELOPMENT
AT KOWLOON ISLAND,
LOT Nos. 6028P1, 6028P2, 6028P3,
6028P4, AND LOT No. 6005

DATE : 20-MAR-21 SCALE : 1:40

DRAWN BY : CHW CHECKED BY : CHW

PROJECT NO. : J-822

PROJECT :



LOT Nos. 6028P1, 6028P2, 6028P3, 6028P4, AND LOT No. 6005

EDUCATION & PART PLAN
FOR CLASS WALL (G/F)

UNIT 4-B, Tower Insurance Centre, 1/F
420 Cheong Chee Road, Singapore
Tel: (65) 6337 2222

MEI MEDICAL ASSOCIATES PTE. LTD.
UNIT 4-B, Tower Insurance Centre, 1/F
420 Cheong Chee Road, Singapore
Tel: (65) 6337 2222

REV. : C

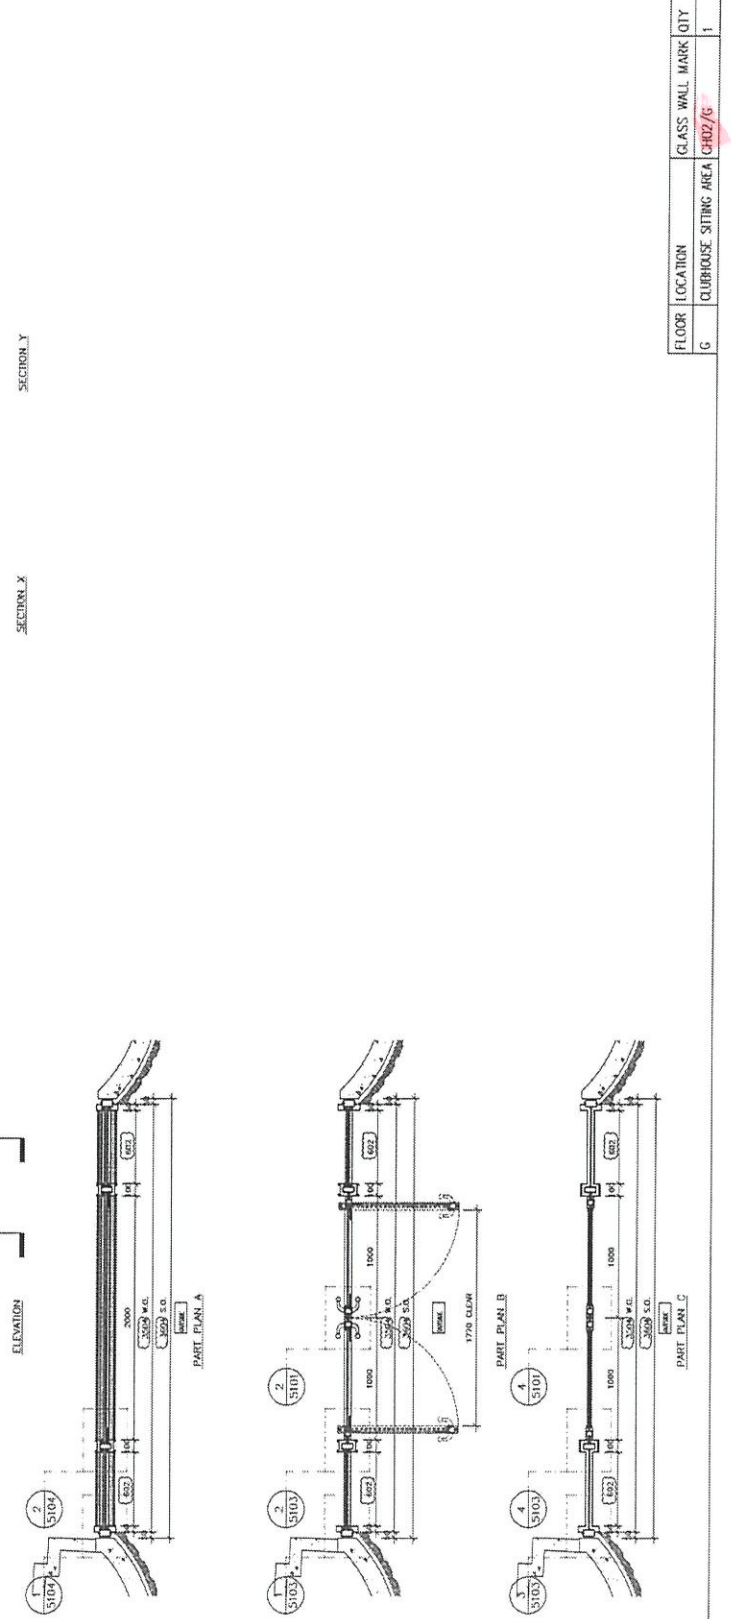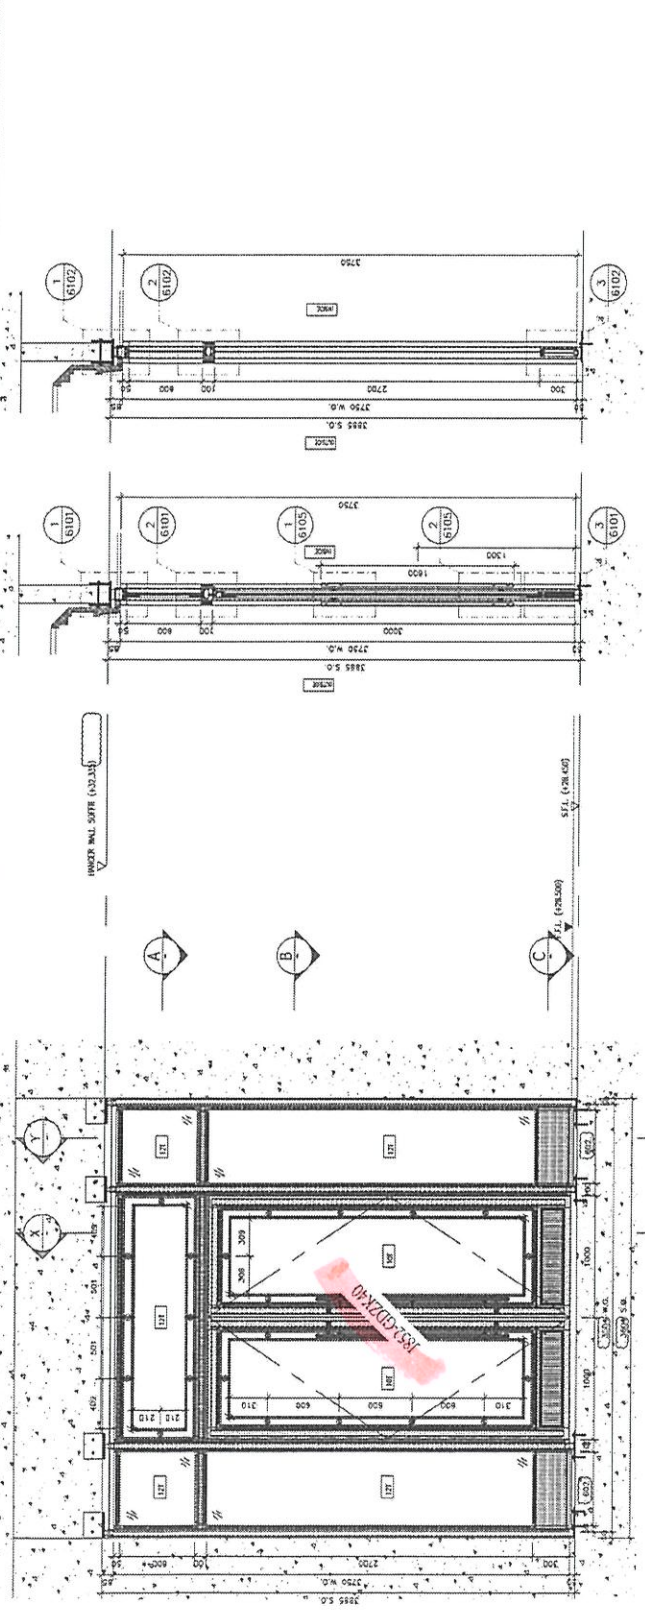

FLOOR	LOCATION	CLASS WALL MARK	QTY
G	CLUBHOUSE SITTING AREA	CH02/G-	1

REV. REF.:

DATE:

AGC
BESTIER LTD
AGC BUILDING SYSTEMS
AGC BUILDING SYSTEMS (HONG KONG) LTD



NOTE:
1. ALL DIMENSIONS ARE IN MM.
2. DIMENSIONS ARE TO FACE UNLESS SPECIFIED OTHERWISE.
3. ALL DIMENSIONS ARE TO BE CHECKED ON SITE BEFORE FIXING.

LEGEND:
1. F.F.L. --- FINISHED FLOOR LEVEL
2. S.F.L. --- STRUCTURAL FLOOR LEVEL
3. R.F.L. --- RAISED FLOOR
4. I.F.L. --- DOWN SIDE RAMPING FLOOR
5. I.F.L. --- DOWN SIDE RAMPING FLOOR

NO.	DESCRIPTION	DATE
1	ISSUED FOR PERMIT	14/03/2023
2	ISSUED FOR PERMIT	14/03/2023
3	ISSUED FOR PERMIT	14/03/2023
4	ISSUED FOR PERMIT	14/03/2023
5	ISSUED FOR PERMIT	14/03/2023

PROJECT: PROPOSED DEVELOPMENT AT HONGKONG ISLAND, LOT Nos. 60326/P, 60326/P, 60326/P, 60326/P, AND LOT No. 60326.

SCALE: 1:40

DATE: 25-Mar-20


DRAWN BY: CAM

CHECKED BY: JPM

MEIDI 美特 銘實有限公司
MEIDI ARCHITECTURE FABRICATOR LTD.
Unit 6-A, Sunny Industrial Centre, 1/F
142-143, Hoi Yee Street, Tsim Sha Tsui, Kowloon, Hong Kong

PROJECT NO.: 2002-204-1100

REV.: C

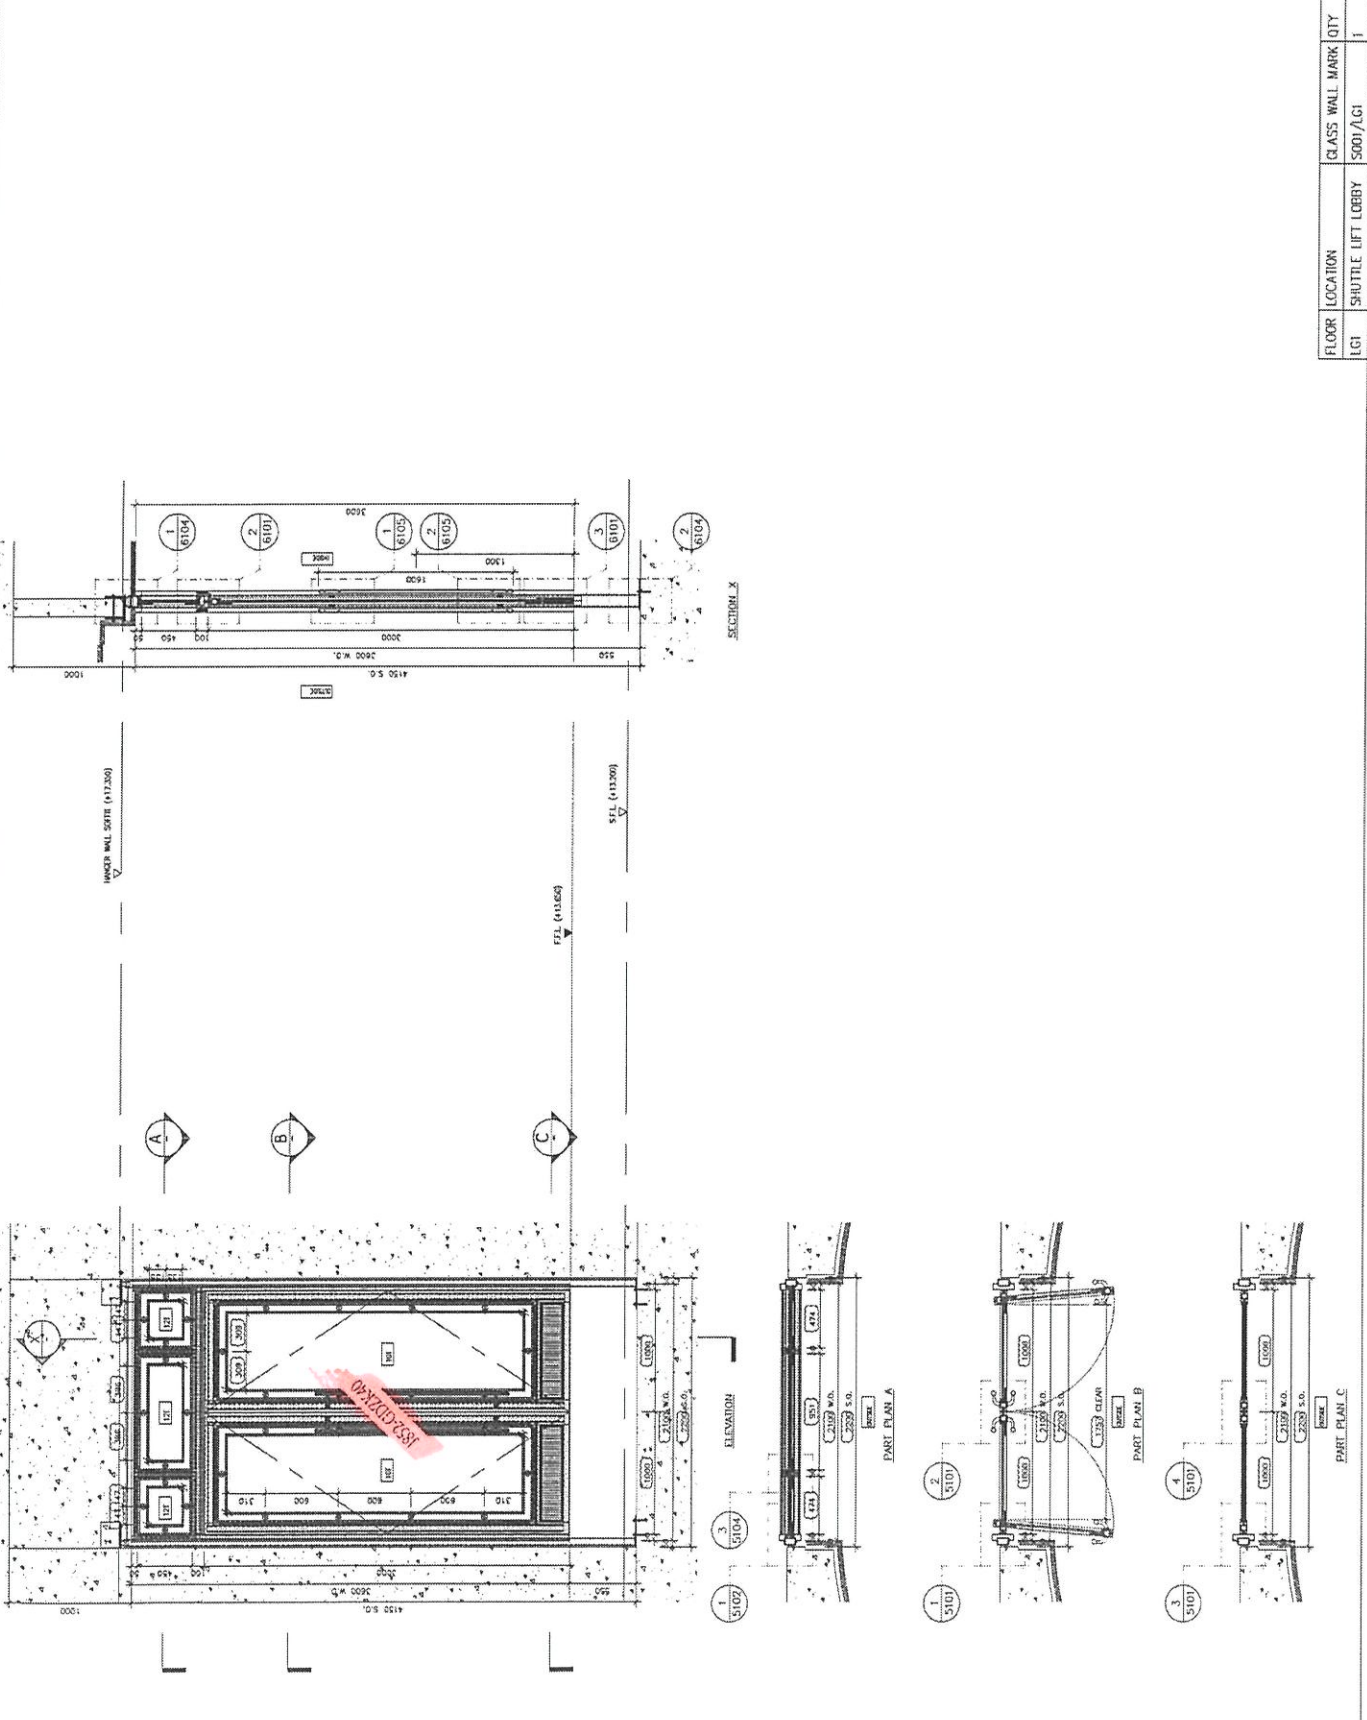

FLOOR	LOCATION	CLASS	WALL MARK	QTY
LC1	SHUTTLE LIFT LOBBY	5000/LC1		1

B.D. REF. :

CLIENT :

ARCHITECT : **AGC DESIGN LTD**
AGC DESIGN LTD
100, WING LOK STREET, HONG KONG

MAIN CONTRACTOR :



STRUCTURAL ENGINEER :

ARUP

FAÇADE CONSULTANT :



NOTE :
1. ALL DIMENSIONS ARE IN mm.
2. ALL ELEVATIONS ARE VIEWED FROM OUTSIDE.
3. ALL DIMENSIONS TO BE VERIFIED ON SITE BEFORE FABRICATION.

LEGEND :

- ① DETAIL MARK NO.
- ② REFER SHEET NO.
- 1. FFL. --- FINISHED FLOOR LEVEL
- 2. SFL. --- STRUCTURAL FLOOR LEVEL
- 3. --- REVERSED DETAIL

B	25/01/2021	REVISION SUBJECT TO ARCH. COMMENT	MC
A	07/01/2021	REVISION SUBJECT TO ARCH. COMMENT	MC
NO	DATE	REVISION	BY

JOB NO. : J-852

PROJECT :
PROPOSED DEVELOPMENT
AT VOORLOON BUILDING,
LOT Nos. 60338P., 60339P., 60337P.,
60338P., AND LOT No. 6005

TITLE :
LOCATION PLAN FOR
GLASS WALL
(G/F)

DATE : 25-Mar-20

SCALE : 1:300

DRAWN BY : GJM

CHECKED BY : DW




Units 6-8, Sunny Industrial Centre, 1/F
100 Cheong Yee Ling Road, Hong Kong
Tel: 2485211-4 Fax: 2482727666

DWG NO. : J852-PGW-3005

REV. : B

LOCATION	GLASS WALL MARK	DRAWING No.
CLUBHOUSE M.F. RM.3	CH06/G	J852-PGW-4512
CLUBHOUSE M.E. RM.2	CH05/G	J852-PGW-4511
CLUBHOUSE M.F. RM.1	CH04/G	J852-PGW-4510
CLUBHOUSE LOUNGE	CH03/G	J852-PGW-4509
CLUBHOUSE SITTING AREA	CH02/G	J852-PGW-4508
CLUBHOUSE LOBBY	CH01/G	J852-PGW-4507
TOWER 3 LIFT LOBBY	T301/G	J852-PGW-4505
TOWER 2 LIFT LOBBY	T202/G	J852-PGW-4504
TOWER 1 LIFT LOBBY	T102/G	J852-PGW-4503
TOWER 1 LIFT LOBBY	T101/G	J852-PGW-4501
SHUTTLE LIFT LOBBY	S001/G	J852-PGW-4500

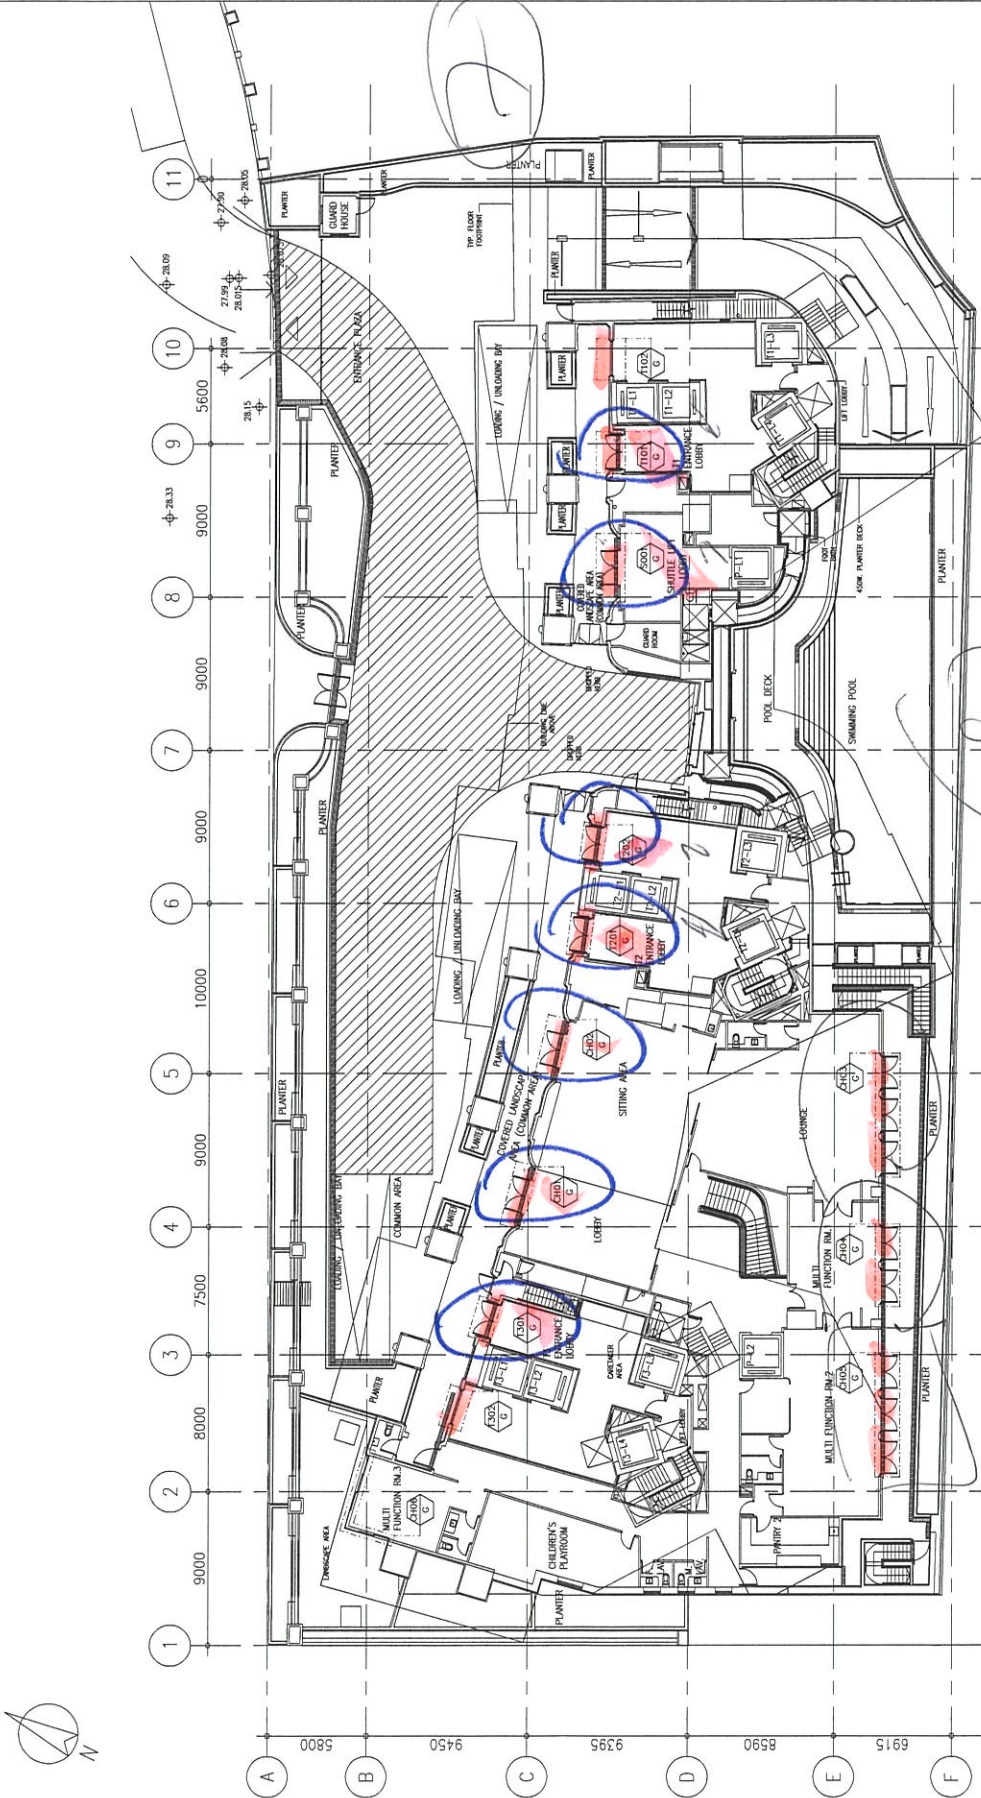

LOCATION PLAN FOR GLASS WALL (G/F)

