

工程指示 / 要求簡箋(E.I.)

工程指示編號：EI / 4037 / 21 修改版次：-  
 工程編號：J - 852 工程名稱：亞皆老街中電  
 工程項目：平台 Glass Door 地盤用鋁板 波浪飾面  
 收件人：生統 發件人：Ant Yeung 日期：18/11/2021

要求提供 /  確認 事項：

- |                                    |                                     |                               |
|------------------------------------|-------------------------------------|-------------------------------|
| <input type="checkbox"/> 初步鋁料 B.M. | <input type="checkbox"/> 加工拆圖，然後生產  | <input type="checkbox"/> 尺寸表  |
| <input type="checkbox"/> 正式鋁料 B.M. | <input type="checkbox"/> 技術上資料 / 指示 | <input type="checkbox"/> 報價   |
| <input type="checkbox"/> 配件 B.M.   | <input type="checkbox"/> 樣辦或貨品說明書   | <input type="checkbox"/> 分判合約 |
| <input type="checkbox"/> 其他：_____  |                                     |                               |

內容：

請按加工圖生產波浪飾面鋁板送地盤安裝 波浪為鋁料  
 謝謝。

**恆豐  
收貨**

請在 2021 / 12 / 10 前完成上列要求。

附： 頁

以上項目為：

- 原合約工程包                       原合約工程加 / 減賬                       新工程報價

原因：-

分發東莞各部門：

- ( ) 生產技術總監  連附件    ( ) 技術部     連附件    ( ) 生產部     連附件    ( ) 機械設計部  連附件  
 ( ) 採購部     連附件    ( ) 生產統籌部  連附件    ( ) 小羅&清     連附件  
 ( ) 質檢部     連附件    ( ) 會計部     連附件    ( ) 報關組     連附件    ( ) 其他 \_\_\_\_\_  連附件

分發其他分判：

- (v) 水洪     連附件

分發香港各部門：

- ( ) 行政部  連附件    ( ) 會計部  連附件    ( ) 統籌部  連附件    ( ) 工程地盤科文  連附件  
 ( ) 採購部  連附件    ( ) QS 部  連附件    ( ) 維修部  連附件    ( ) 其他 \_\_\_\_\_  連附件

**有哥，  
祥哥**

傳遞編號：

HK 2098 / 21

發件人簽署：


項目經理簽署：

**圖則登記表**  
DRAWING REGISTER


接收日期 Receiving Date (適用於客戶圖則)	
工程名稱 Project Title: <b>亞皆老街</b> <b>GLASS DOOR 工廠用鋁板加工圖</b>	年 <input type="text"/> <input type="text"/> <input type="text"/> <input type="text"/> <input type="text"/> <input type="text"/> <input type="text"/> <input type="text"/>
工程編號 Project No: <b>J-852</b>	月 <input type="text"/> <input type="text"/> <input type="text"/> <input type="text"/> <input type="text"/> <input type="text"/> <input type="text"/> <input type="text"/>
分發予 Distributed To	發出日期 Issued Date
年 <input type="text"/> <input type="text"/> <input type="text"/> <input type="text"/> <input type="text"/> <input type="text"/> <input type="text"/> <input type="text"/>	21 <input type="text"/> <input type="text"/> <input type="text"/> <input type="text"/> <input type="text"/> <input type="text"/> <input type="text"/> <input type="text"/>
月 <input type="text"/> <input type="text"/> <input type="text"/> <input type="text"/> <input type="text"/> <input type="text"/> <input type="text"/> <input type="text"/>	11 <input type="text"/> <input type="text"/> <input type="text"/> <input type="text"/> <input type="text"/> <input type="text"/> <input type="text"/> <input type="text"/>
日 <input type="text"/> <input type="text"/> <input type="text"/> <input type="text"/> <input type="text"/> <input type="text"/> <input type="text"/> <input type="text"/>	17 <input type="text"/> <input type="text"/> <input type="text"/> <input type="text"/> <input type="text"/> <input type="text"/> <input type="text"/> <input type="text"/>
圖則編號 Drg. No.	圖則名稱 Drawing Title
修訂編號 Revision No.	
J852-GDZK80	鋁型材組框圖
J852-GDZK81	鋁型材組框圖
J852-GDZK82	鋁型材組框圖
J852-GDZK83	鋁型材組框圖
J852-GDZK84	鋁型材組框圖
J852-GDZK85	鋁型材組框圖
J852-GDZK86	鋁型材組框圖
J852-GDZK87	鋁型材組框圖
J852-GDZK88	鋁型材組框圖
J852-GDZK89	鋁型材組框圖
J852-GDZK90	鋁型材組框圖
J852-GDZK91	鋁型材組框圖
J852-GDZK92	鋁型材組框圖
J852-GDZK93	鋁型材組框圖
J852-GDZK94	鋁型材組框圖
J852-GDZK95	鋁型材組框圖
J852-GDZK96	鋁型材組框圖
J852-GDAL30	型材加工圖
J852-GDAL31	型材加工圖
J852-PGW-4500	鋁板位置圖
J852-PGW-4501	鋁板位置圖
J852-PGW-4502	鋁板位置圖
J852-PGW-4503	鋁板位置圖
J852-PGW-4504	鋁板位置圖
J852-PGW-4505	鋁板位置圖
J852-PGW-4506	鋁板位置圖
J852-PGW-4507	鋁板位置圖
J852-PGW-4508	鋁板位置圖
1	-
2	-
**圖則登記表**  
DRAWING REGISTER

工程名稱 Project Title: <b>亞皆老街</b> <b>GLASS DOOR 工廠用鋁板加工圖</b>		接收日期 Receiving Date (適用於客戶圖則)	年	月	日	日	日	日	日	日	日
工程編號 Project No: <b>J-852</b>											
分發予 Distributed To		發出日期 Issued Date									
		年	21								
		月	11								
		日	17								
圖則編號 Drg. No.	圖則名稱 Drawing Title		修訂編號 Revision No.								
J852-PGW-4509	鋁板位置圖	29	-								
J852-PGW-4510	鋁板位置圖	30	-								
J852-PGW-4511	鋁板位置圖	31	-								
J852-PGW-4400	鋁板位置圖	32	-								
J852-PGW-4401	鋁板位置圖	33	-								
J852-PGW-4402	鋁板位置圖	34	-								
J852-PGW-4403	鋁板位置圖	35	-								
J852-PGW-4404	鋁板位置圖	36	-								
J852-PGW-4300	鋁板位置圖	37	-								
J852-PGW-4301	鋁板位置圖	38	-								
J852-PGW-4302	鋁板位置圖	39	-								
J852-PGW-4303	鋁板位置圖	40	-								
J852-PGW-4304	鋁板位置圖	41	-								
J852-PGW-4200	鋁板位置圖	42	-								
J852-PGW-4201	鋁板位置圖	43	-								
J852-PGW-4202	鋁板位置圖	44	-								
J852-PGW-4203	鋁板位置圖	45	-								
J852-PGW-4204	鋁板位置圖	46	-								
J852-PGW-4100	鋁板位置圖	47	-								

 美特鋁質有限公司 MIDI Aluminium Fabricator Ltd.	工程號: J852	計算: ZJP	日期: 2021-11-17	送呈: 胡哥
	地 盤: 亞皆老街	核對:	日期:	副本:
工廠用鋁板B.M.表	項目類別: GLASS DOOR	批准:	日期:	
BM編號:			總展開面積: 18.85 總V.F.: 0.00	此BM依據



序號	修改標示	鋁板編號	鋁板名稱	噴塗顏色	實用	後備	總數	單位	單件V.F. (M2)	總V.F. (M2)	單件展開 面積(M2)	總展開面積 (M2)
1		J852-GDZK80	1mm 厚鋁板	鉻化	32	0	32	件	0.00	0.00	0.12	3.82
2		J852-GDZK81			4	0	4	件	0.00	0.00	0.28	1.11
3		J852-GDZK82			32	0	32	件	0.00	0.00	0.11	3.57
4		J852-GDZK83			20	0	20	件	0.00	0.00	0.13	2.67
5		J852-GDZK84			4	0	4	件	0.00	0.00	0.04	0.16
6		J852-GDZK85			4	0	4	件	0.00	0.00	0.04	0.15
7		J852-GDZK86			4	0	4	件	0.00	0.00	0.04	0.15
8		J852-GDZK87			16	0	16	件	0.00	0.00	0.03	0.54
9		J852-GDZK88			12	0	12	件	0.00	0.00	0.08	0.90
10		J852-GDZK89			12	0	12	件	0.00	0.00	0.07	0.82
11		J852-GDZK90			4	0	4	件	0.00	0.00	0.23	0.91
12		J852-GDZK91			2	0	2	件	0.00	0.00	0.25	0.50
13		J852-GDZK92			24	0	24	件	0.00	0.00	0.07	1.57
14		J852-GDZK93			12	0	12	件	0.00	0.00	0.12	1.49
15		J852-GDZK94			8	0	8	件	0.00	0.00	0.02	0.20
16		J852-GDZK95			4	0	4	件	0.00	0.00	0.03	0.12
17		J852-GDZK96			2	0	2	件	0.00	0.00	0.07	0.15
18									196	件		0.00

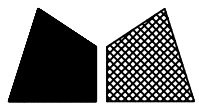


美特鋁質 有限公司  
MIDI Aluminium Fabricator Ltd.

产品编号	L(mm)	数量	N	M	A	B	N1	M1	备注
		4							

工程號 J852 地盤 亞皆老街

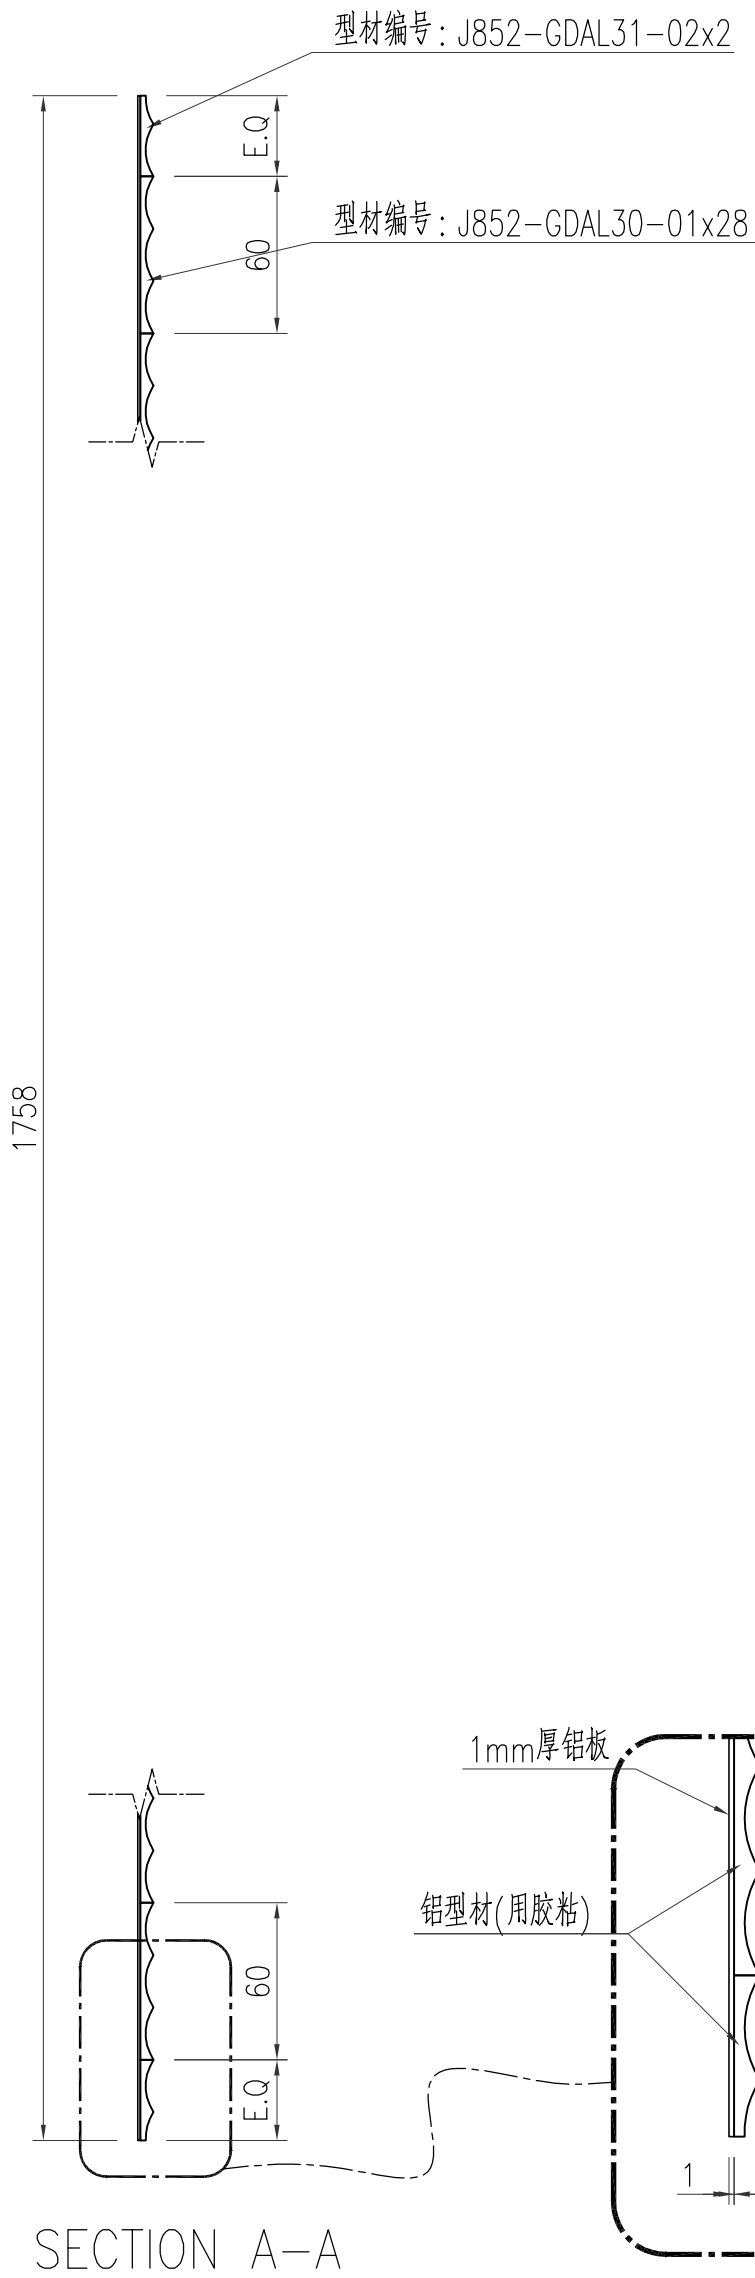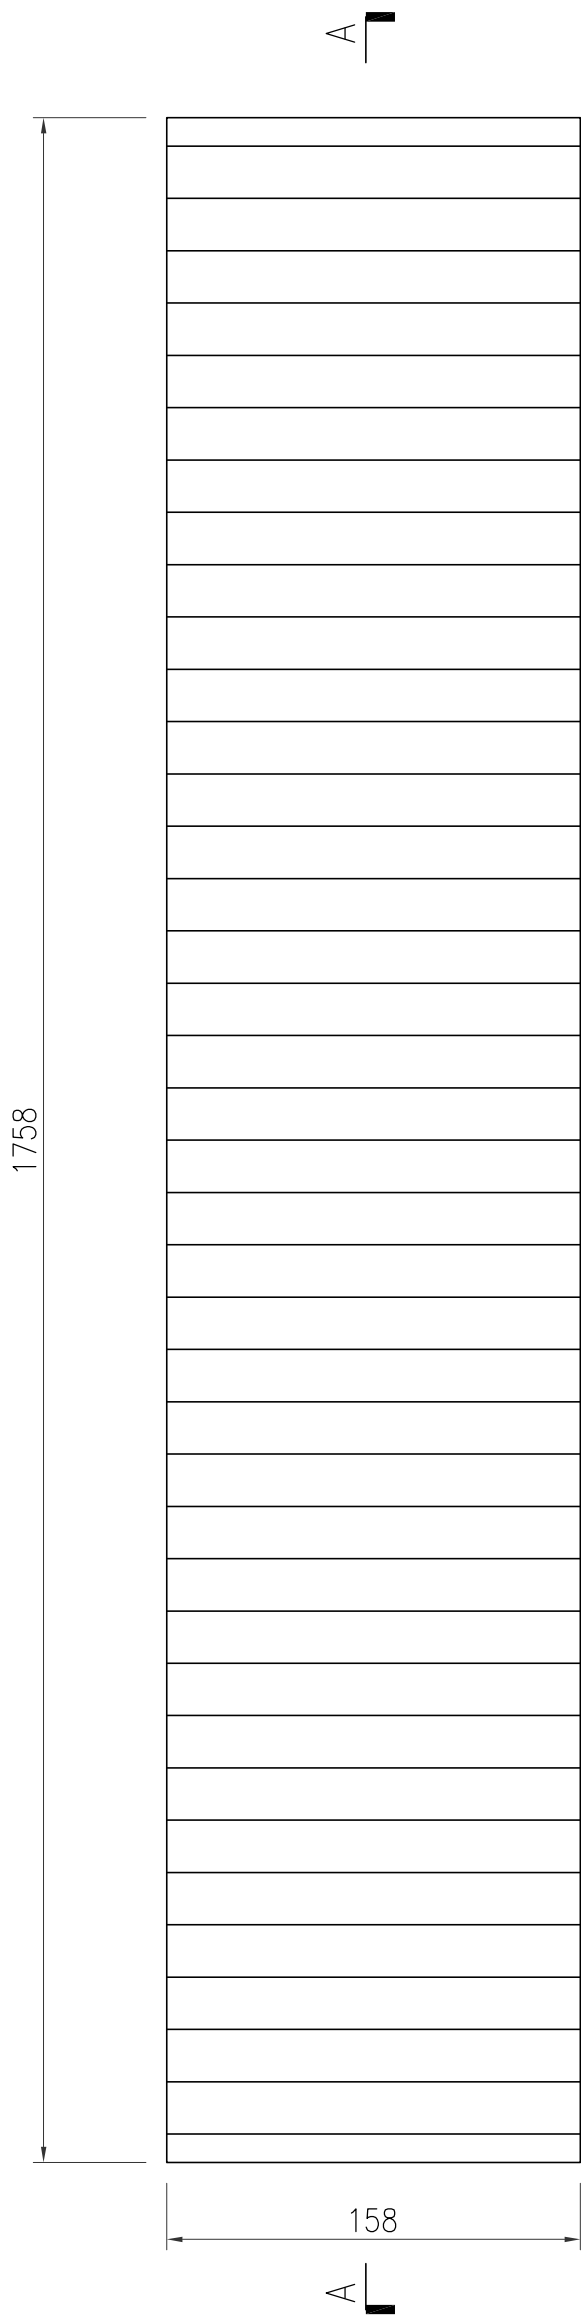



名稱	鋁型材組框圖	制圖	ZJP	2021-11-04	修改			
材料	1mm厚鋁板+X86038	復核			日期			
顏色	-	批准			圖號	J852-GDZK81		

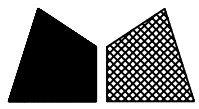

美特鋁質 有限公司  
MIDI Aluminium Fabricator Ltd.

产品编号	L(mm)	数量	N	M	A	B	N1	M1	备注
		32							



工程號 J852 地盤 亞皆老街

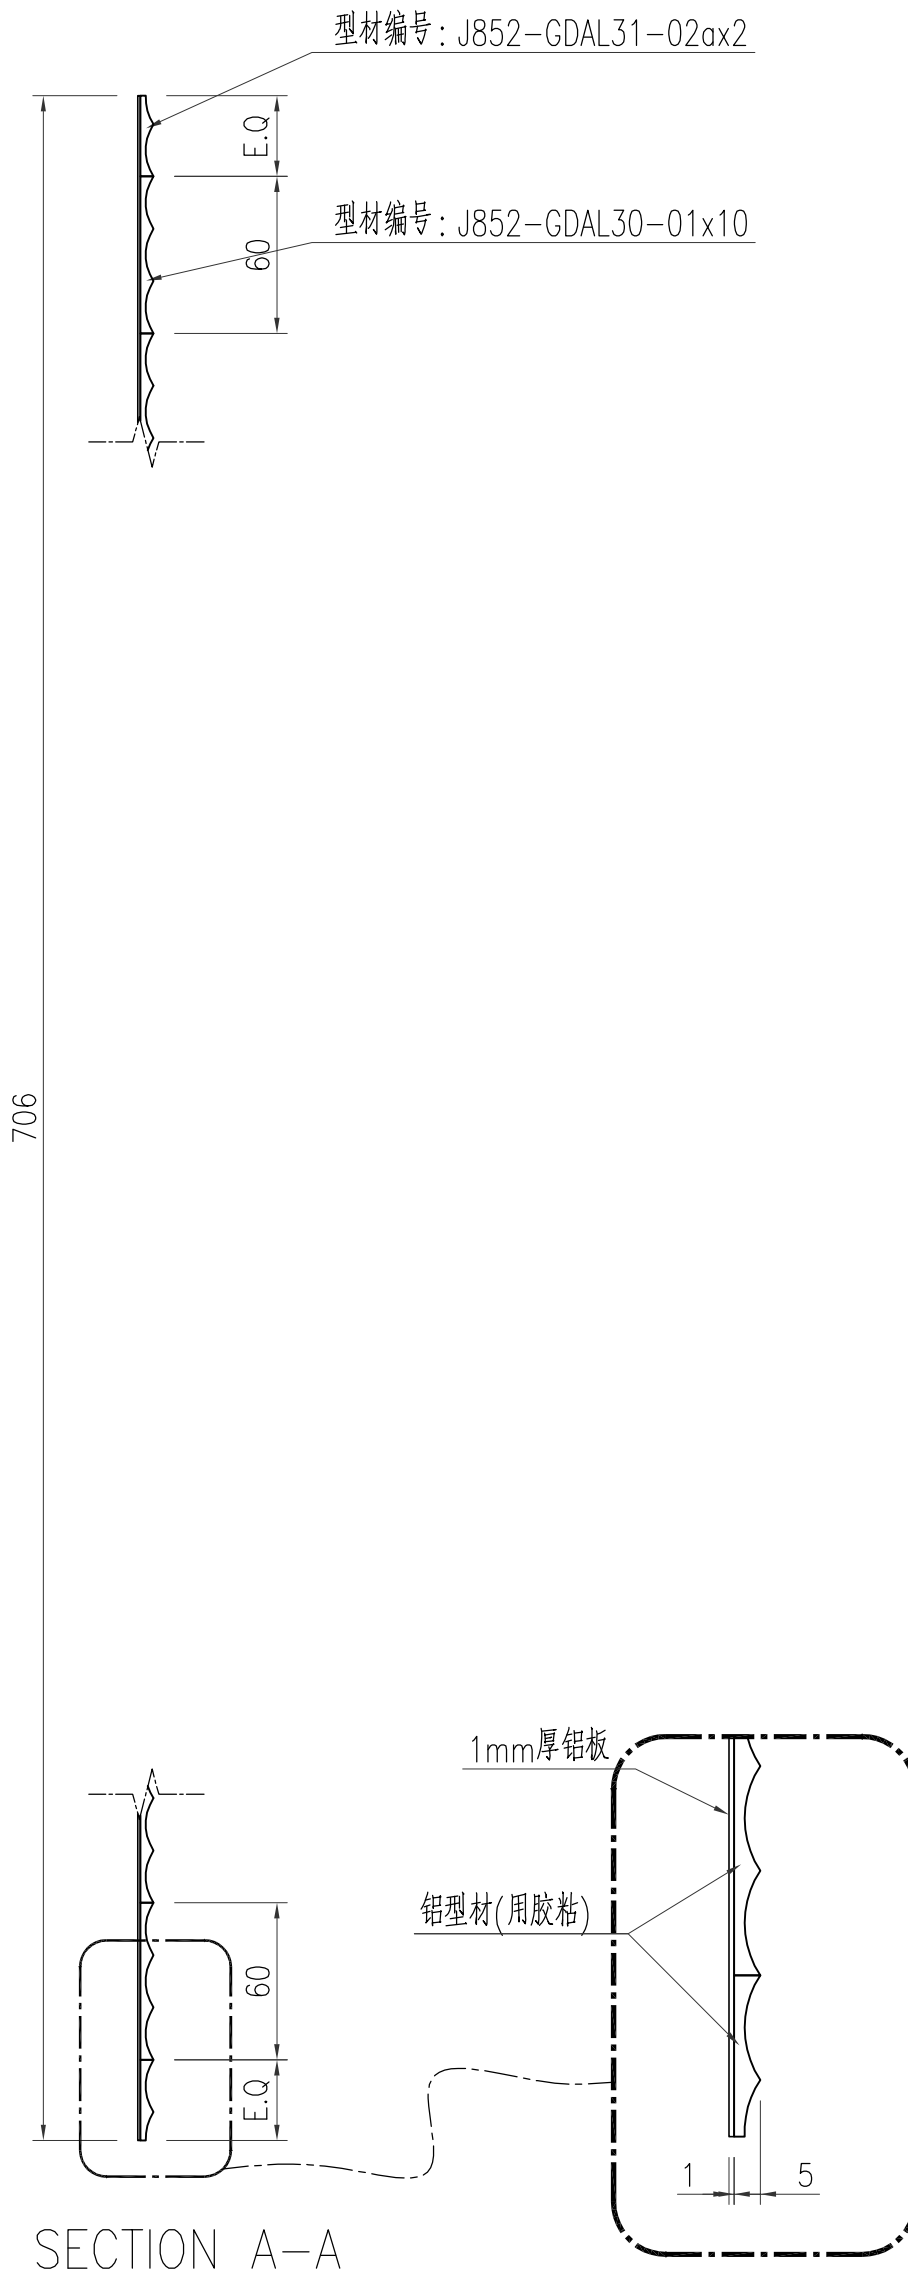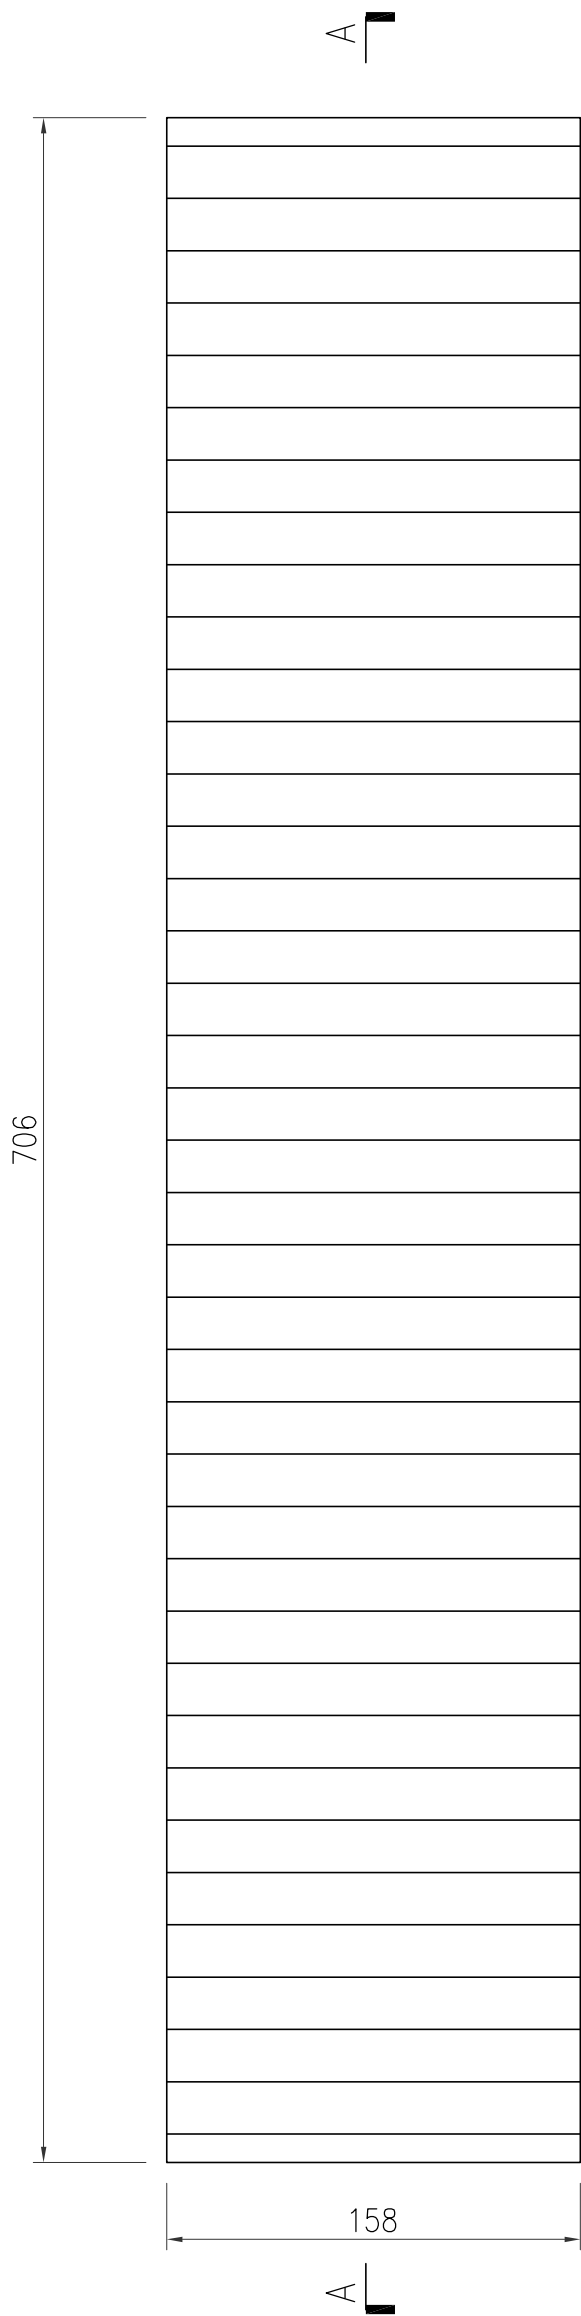


名稱	鋁型材組框圖	制圖	ZJP	2021-11-04	修改			
材料	1mm厚鋁板+X86038	復核			日期			
顏色	-	批准			圖號	J852-GDZK82		

 <b>美特鋁質</b> 有限公司 MIDI Aluminium Fabricator Ltd.			
工程號	J852	地盤	亞皆老街

产品编号	L(mm)	数量	N	M	A	B	N1	M1	备注
		32							

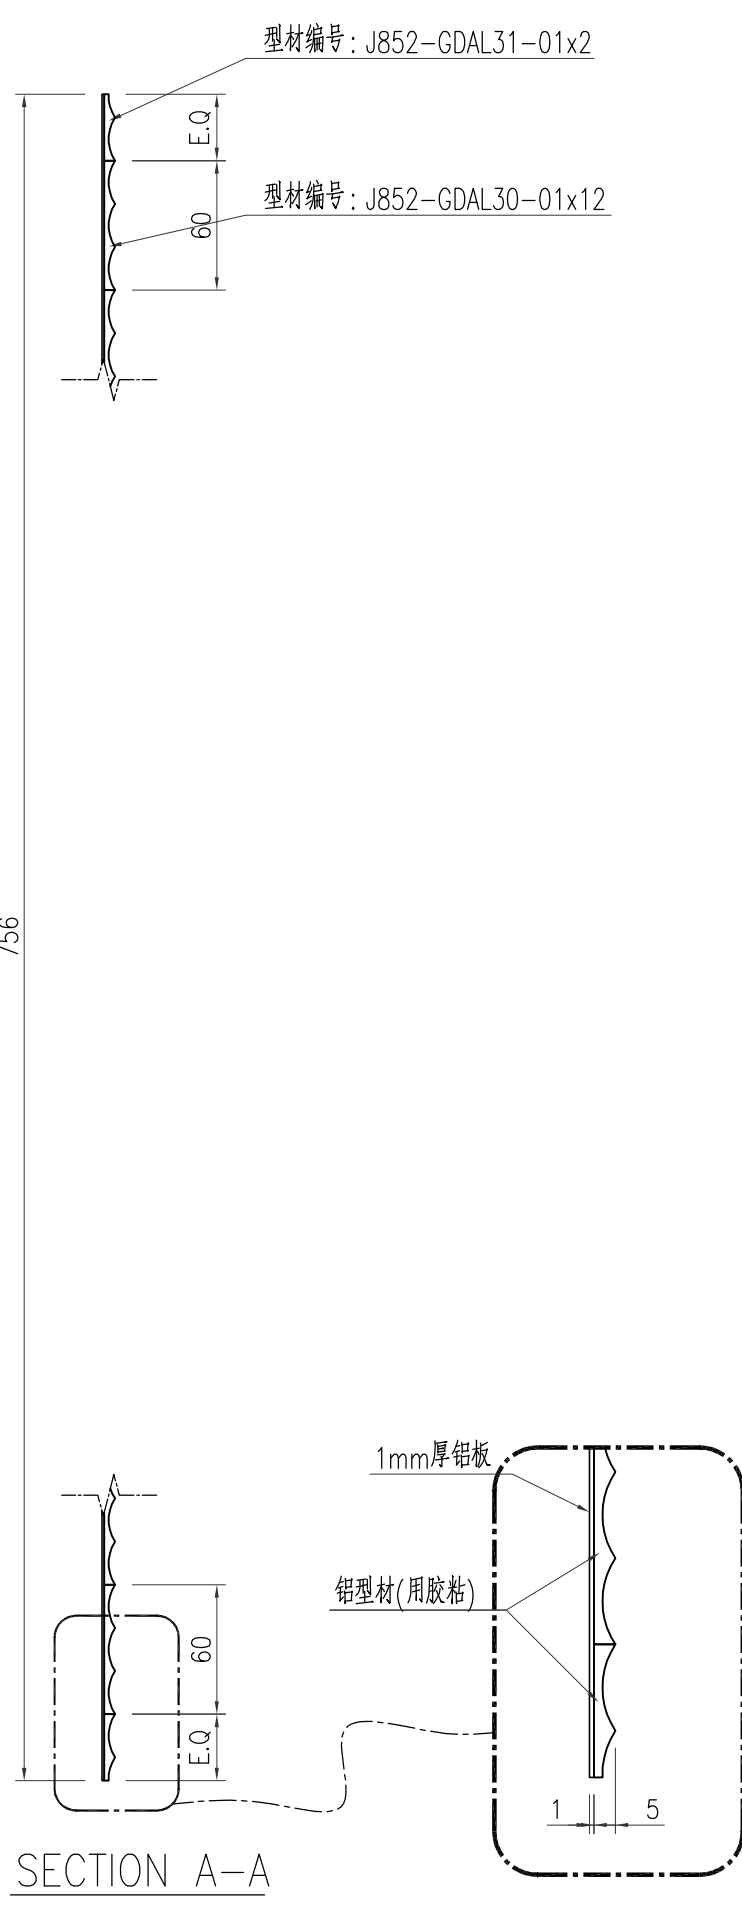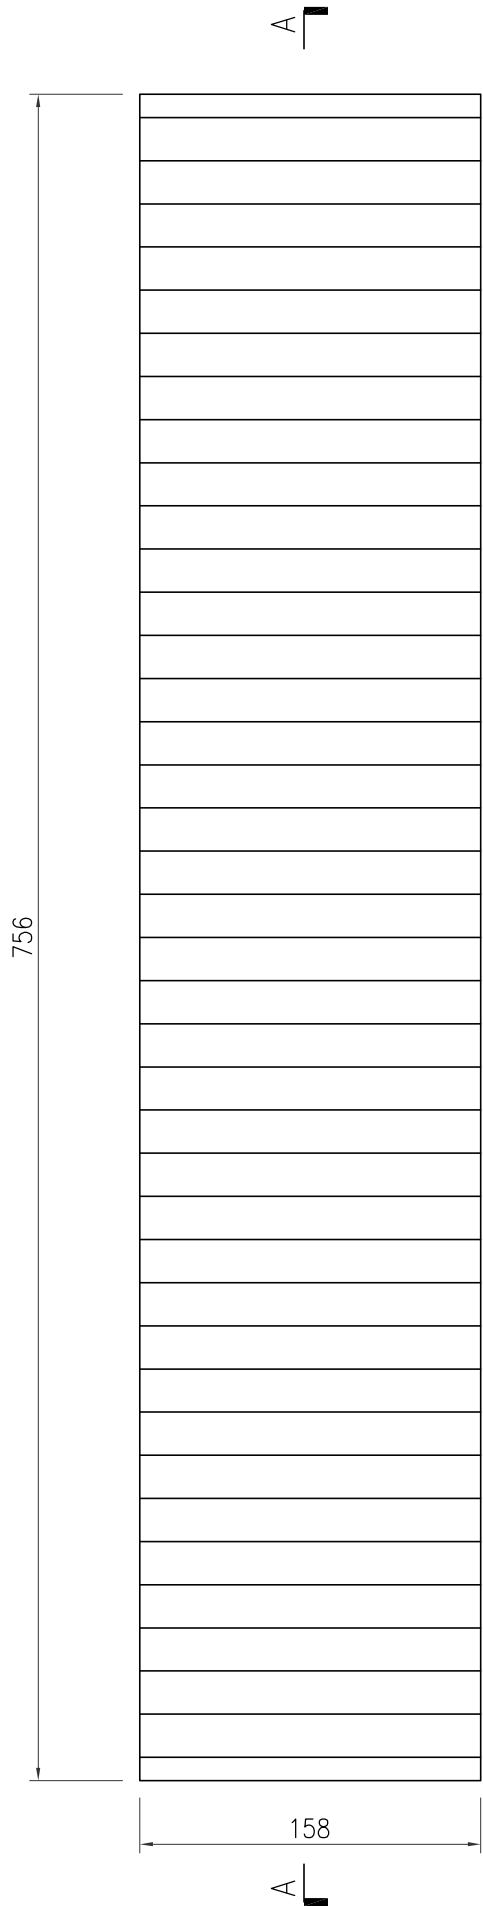



名稱	鋁型材組框圖	制圖	ZJP	2021-11-04	修改			
材料	1mm厚鋁板+X86038	復核			日期			
顏色	-	批准			圖號	J852-GDZK80		

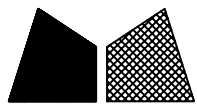


美特鋁質 有限公司  
MIDI Aluminium Fabricator Ltd.

产品编号	L(mm)	数量	N	M	A	B	N1	M1	备注
		20							

工程號	J852	地盤	亞皆老街
-----	------	----	------

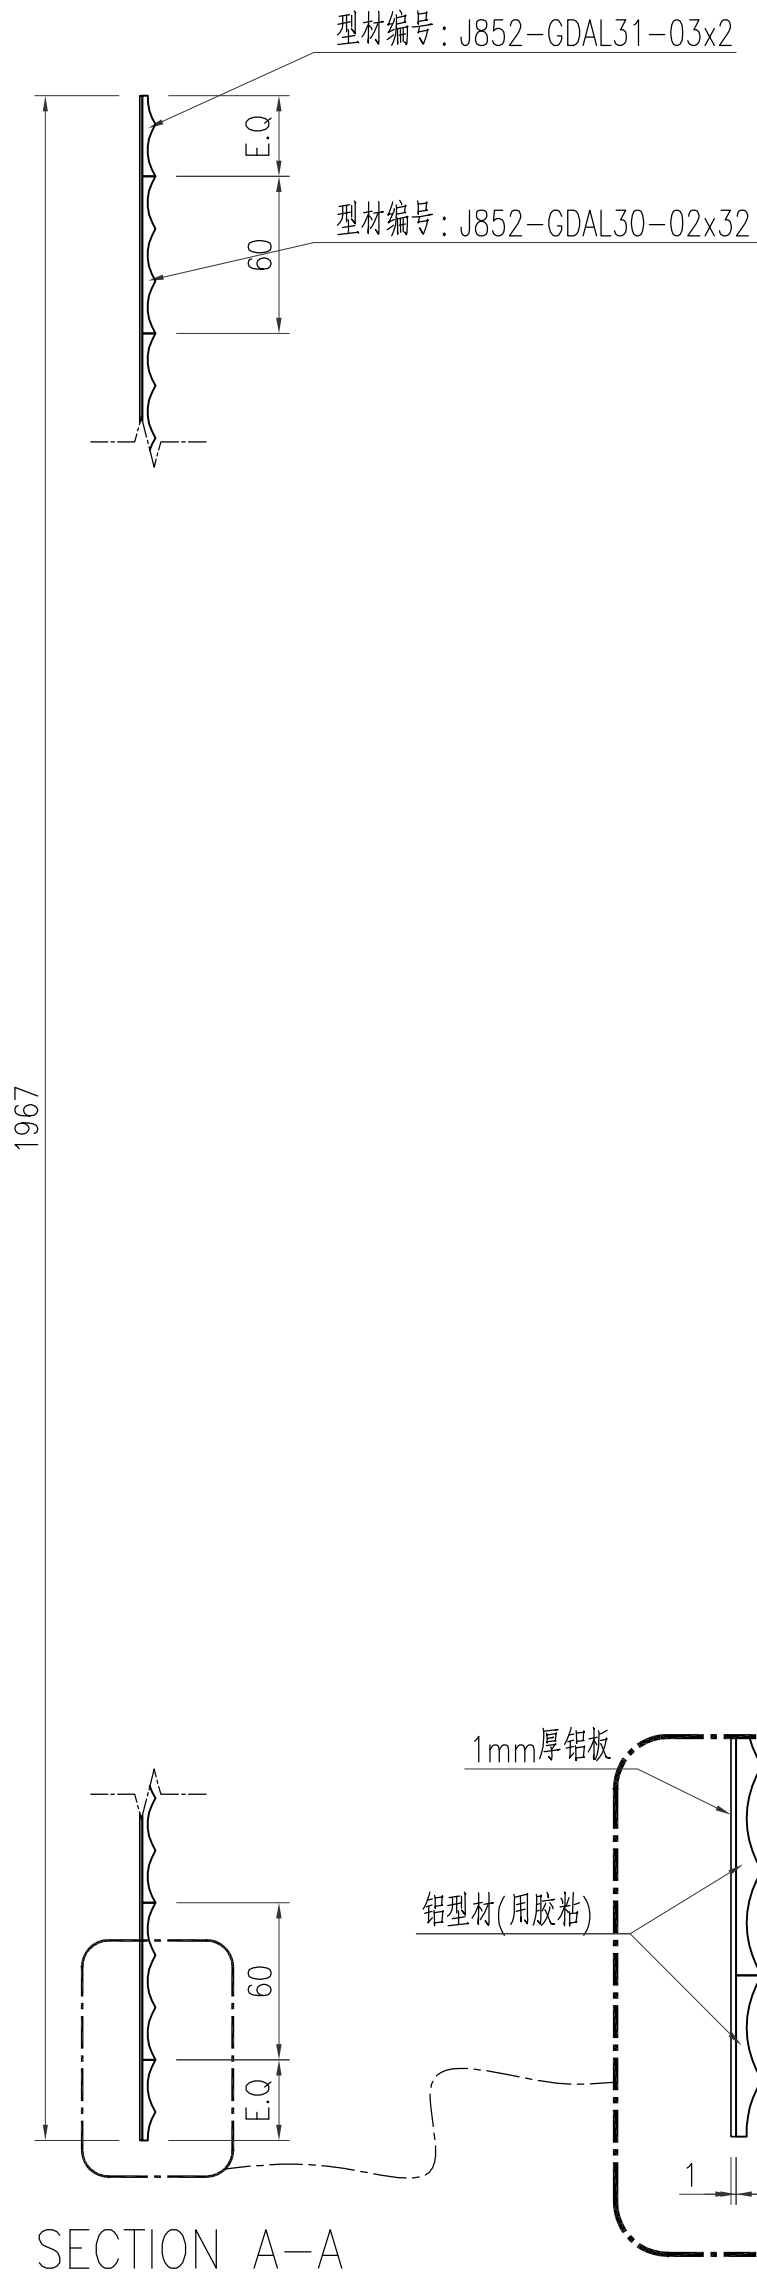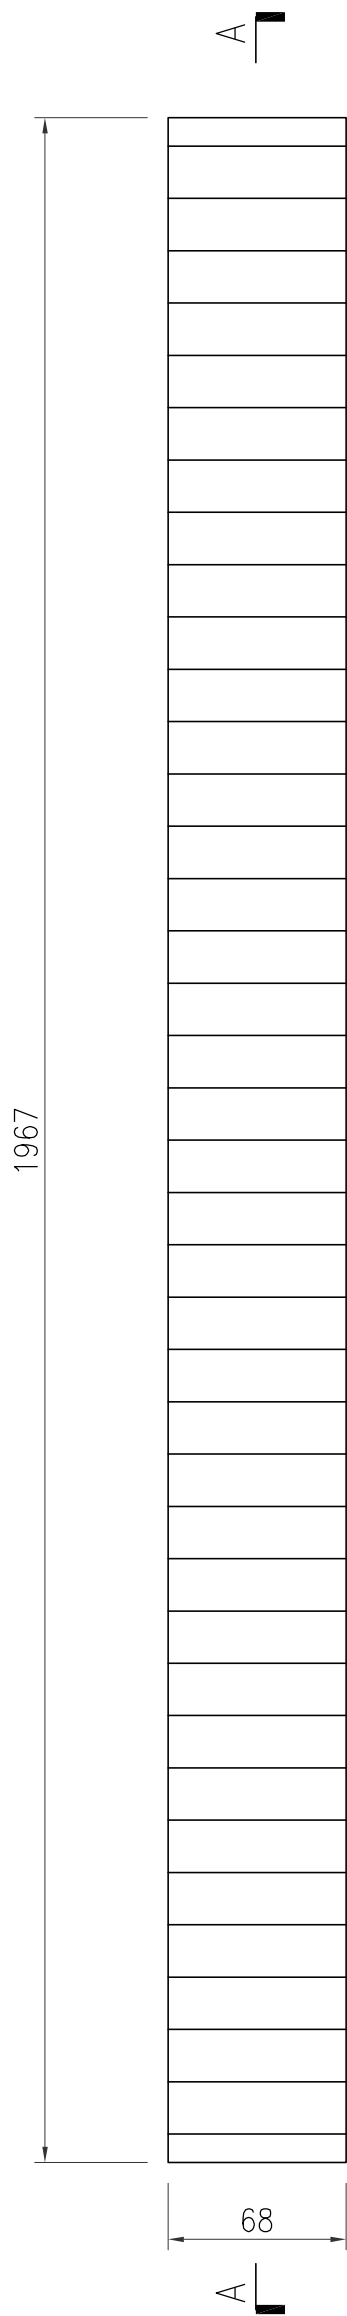



名稱	鋁型材組框圖	制圖	ZJP	2021-11-04	修改			
材料	1mm厚鋁板+X86038	復核			日期			
顏色	-	批准			圖號	J852-GDZK83		

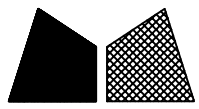


美特鋁質 有限公司  
MIDI Aluminium Fabricator Ltd.

产品编号	L(mm)	数量	N	M	A	B	N1	M1	备注
		4							

工程號	J852	地盤	亞皆老街
-----	------	----	------

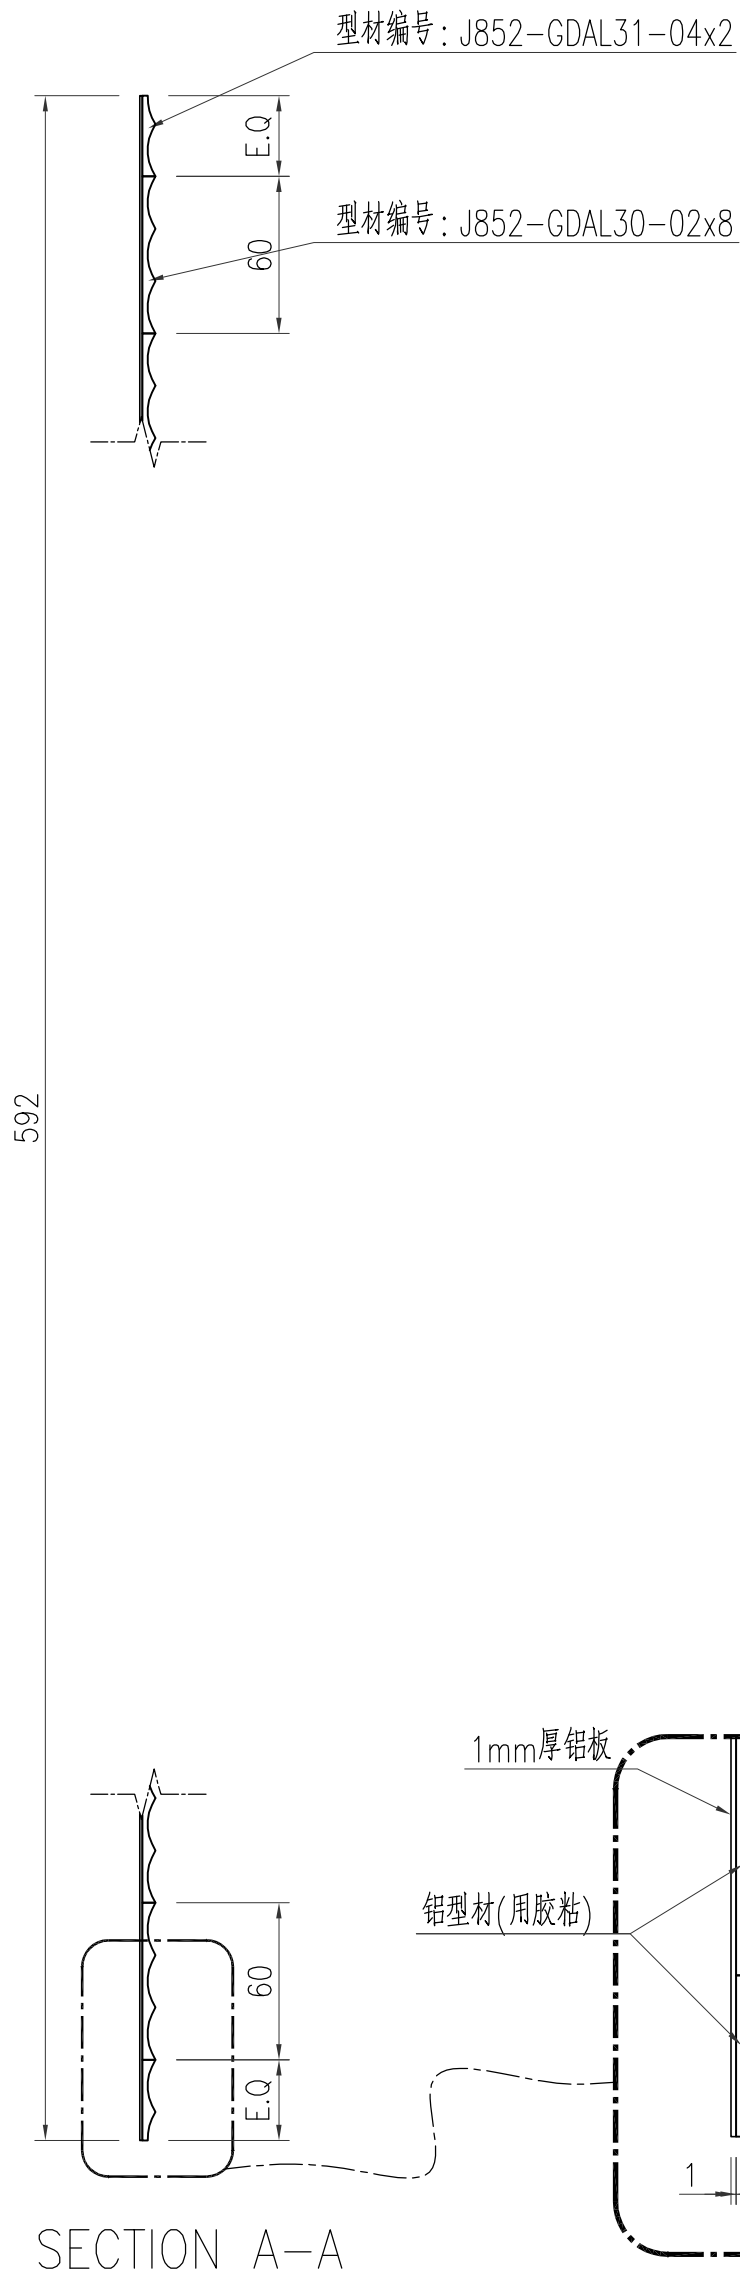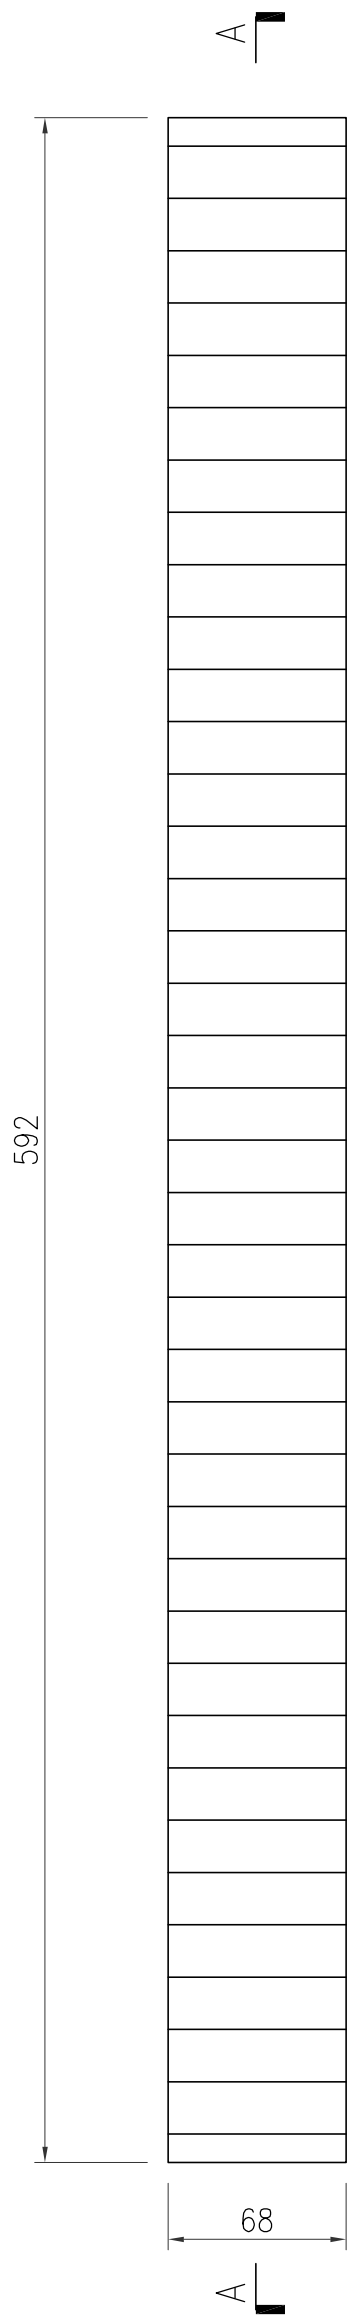



名稱	鋁型材組框圖	制圖	ZJP	2021-11-04	修改			
材料	1mm厚鋁板+X86038	復核			日期			
顏色	-	批准			圖號	J852-GDZK84		

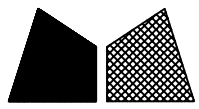


美特鋁質 有限公司  
MIDI Aluminium Fabricator Ltd.

产品编号	L(mm)	数量	N	M	A	B	N1	M1	备注
		4							

工程號	J852	地盤	亞皆老街
-----	------	----	------

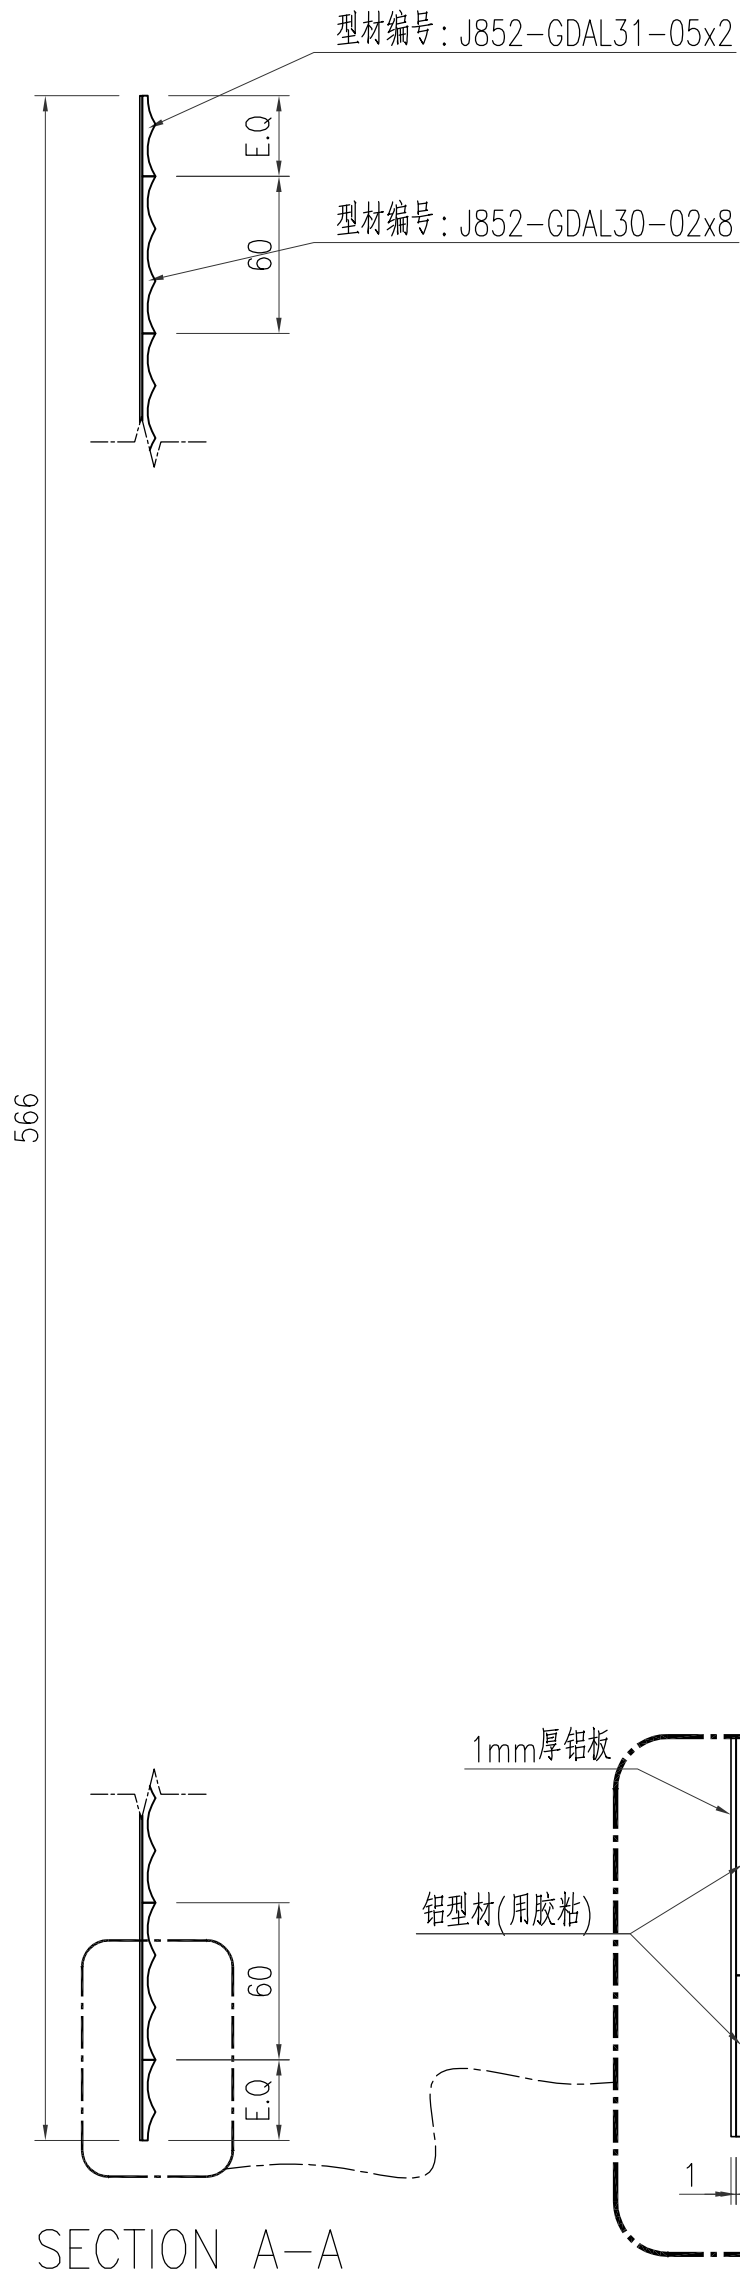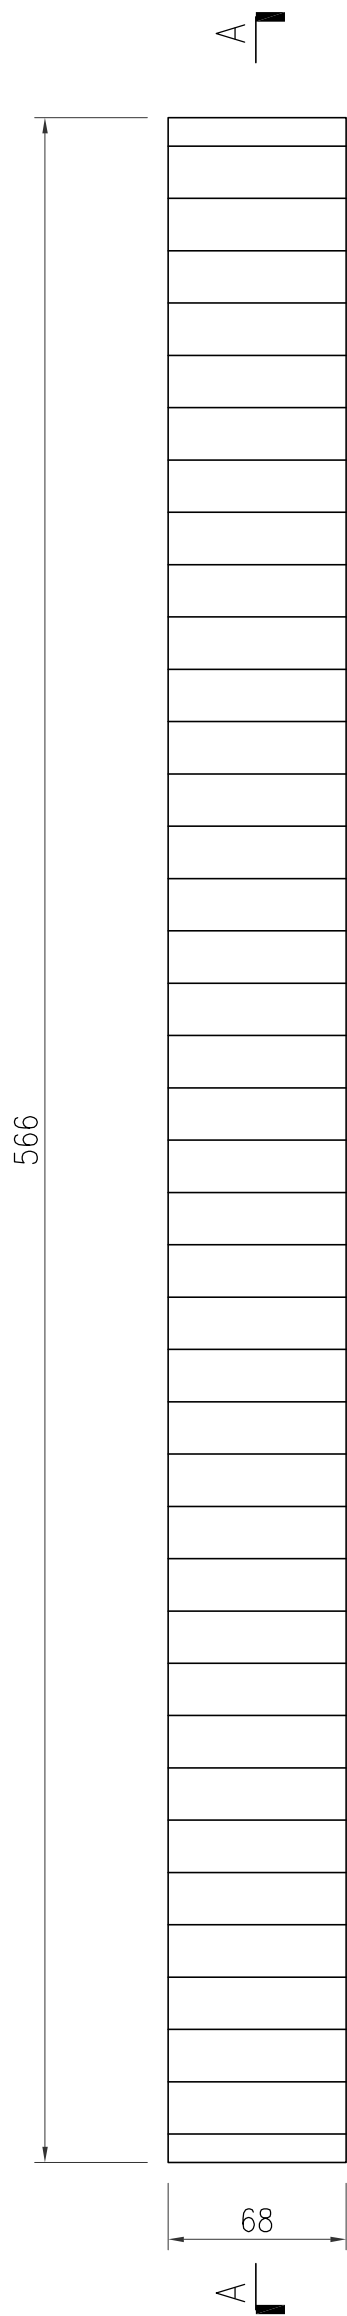



名稱	鋁型材組框圖	制圖	ZJP	2021-11-04	修改			
材料	1mm厚鋁板+X86038	復核			日期			
顏色	-	批准			圖號	J852-GDZK85		

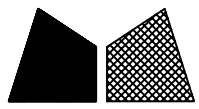


美特鋁質 有限公司  
MIDI Aluminium Fabricator Ltd.

产品编号	L(mm)	数量	N	M	A	B	N1	M1	备注
		4							

工程號	J852	地盤	亞皆老街
-----	------	----	------

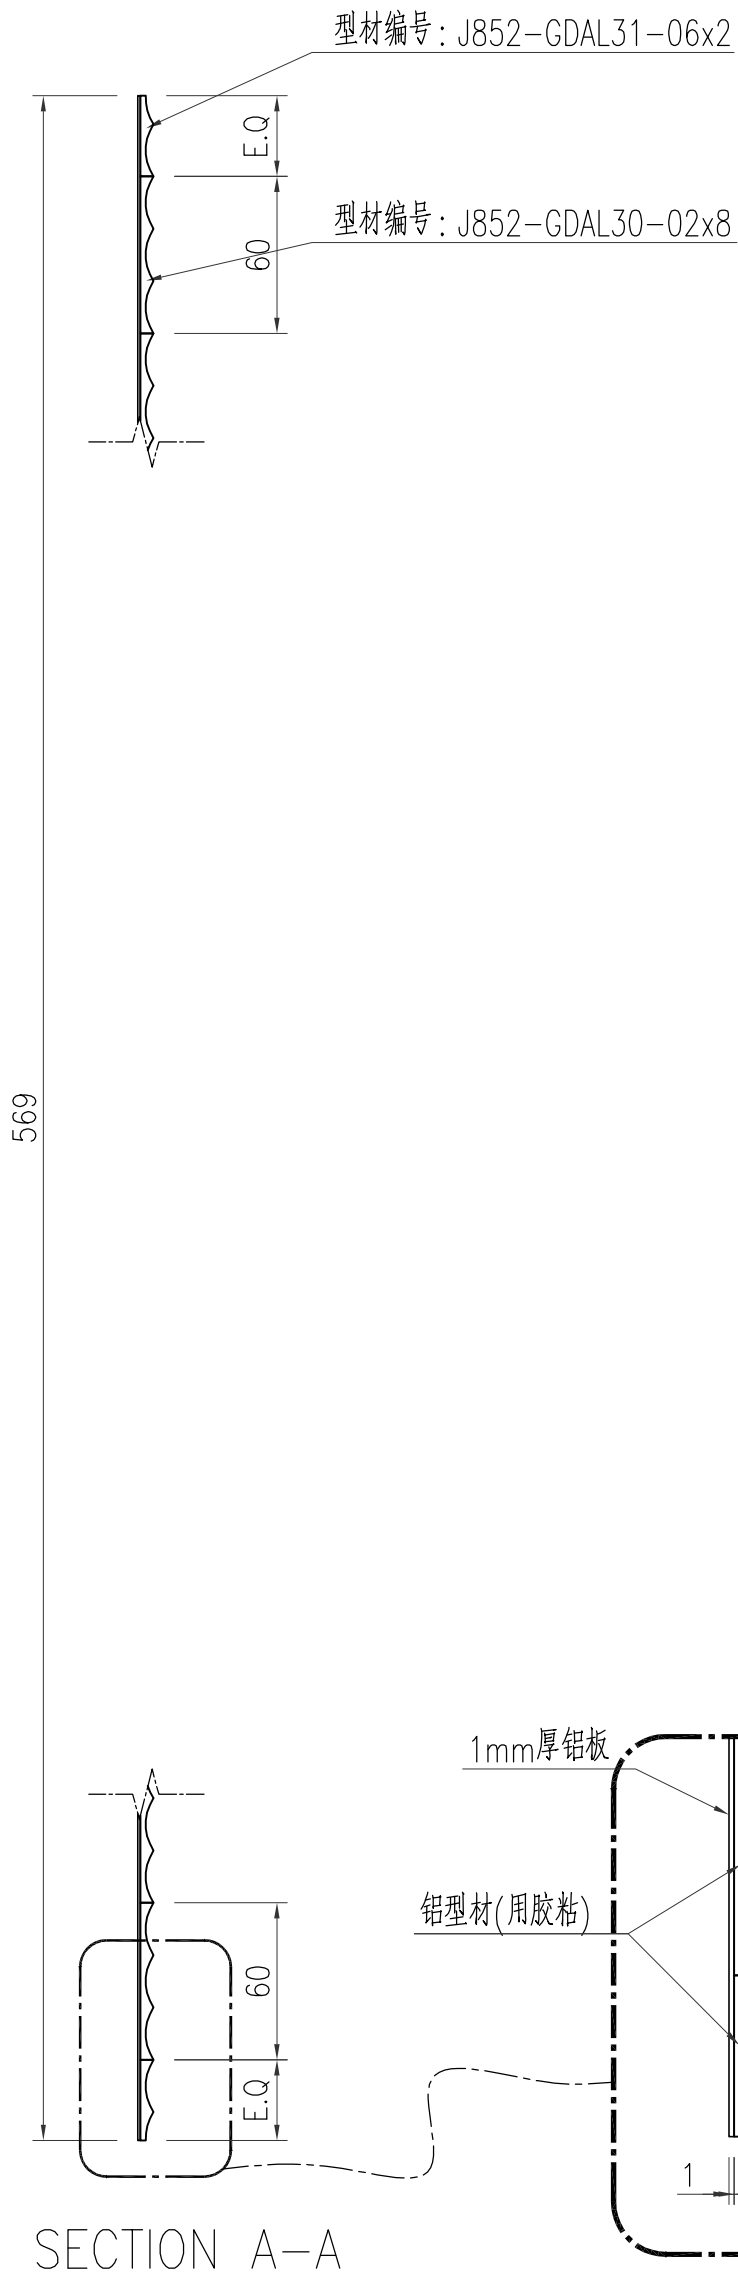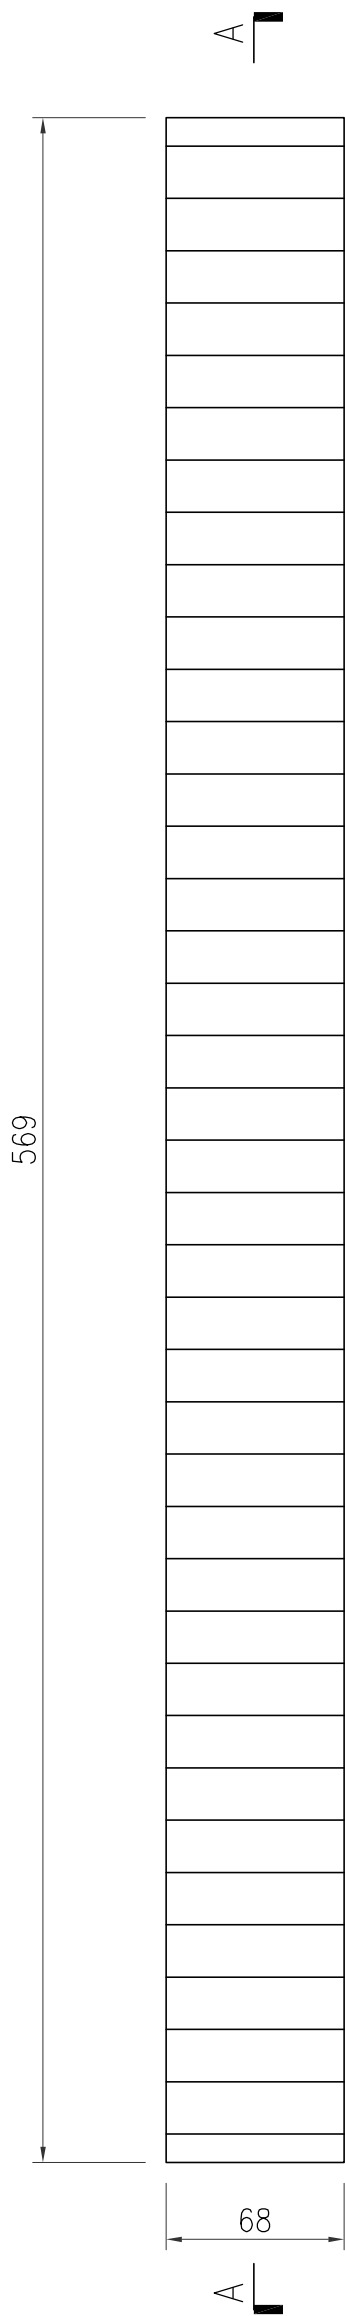



名稱	鋁型材組框圖	制圖	ZJP	2021-11-04	修改			
材料	1mm厚鋁板+X86038	復核			日期			
顏色	-	批准			圖號	J852-GDZK86		

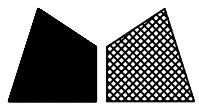


美特鋁質 有限公司  
MIDI Aluminium Fabricator Ltd.

产品编号	L(mm)	数量	N	M	A	B	N1	M1	备注
		16							

工程號 J852 地盤 亞皆老街

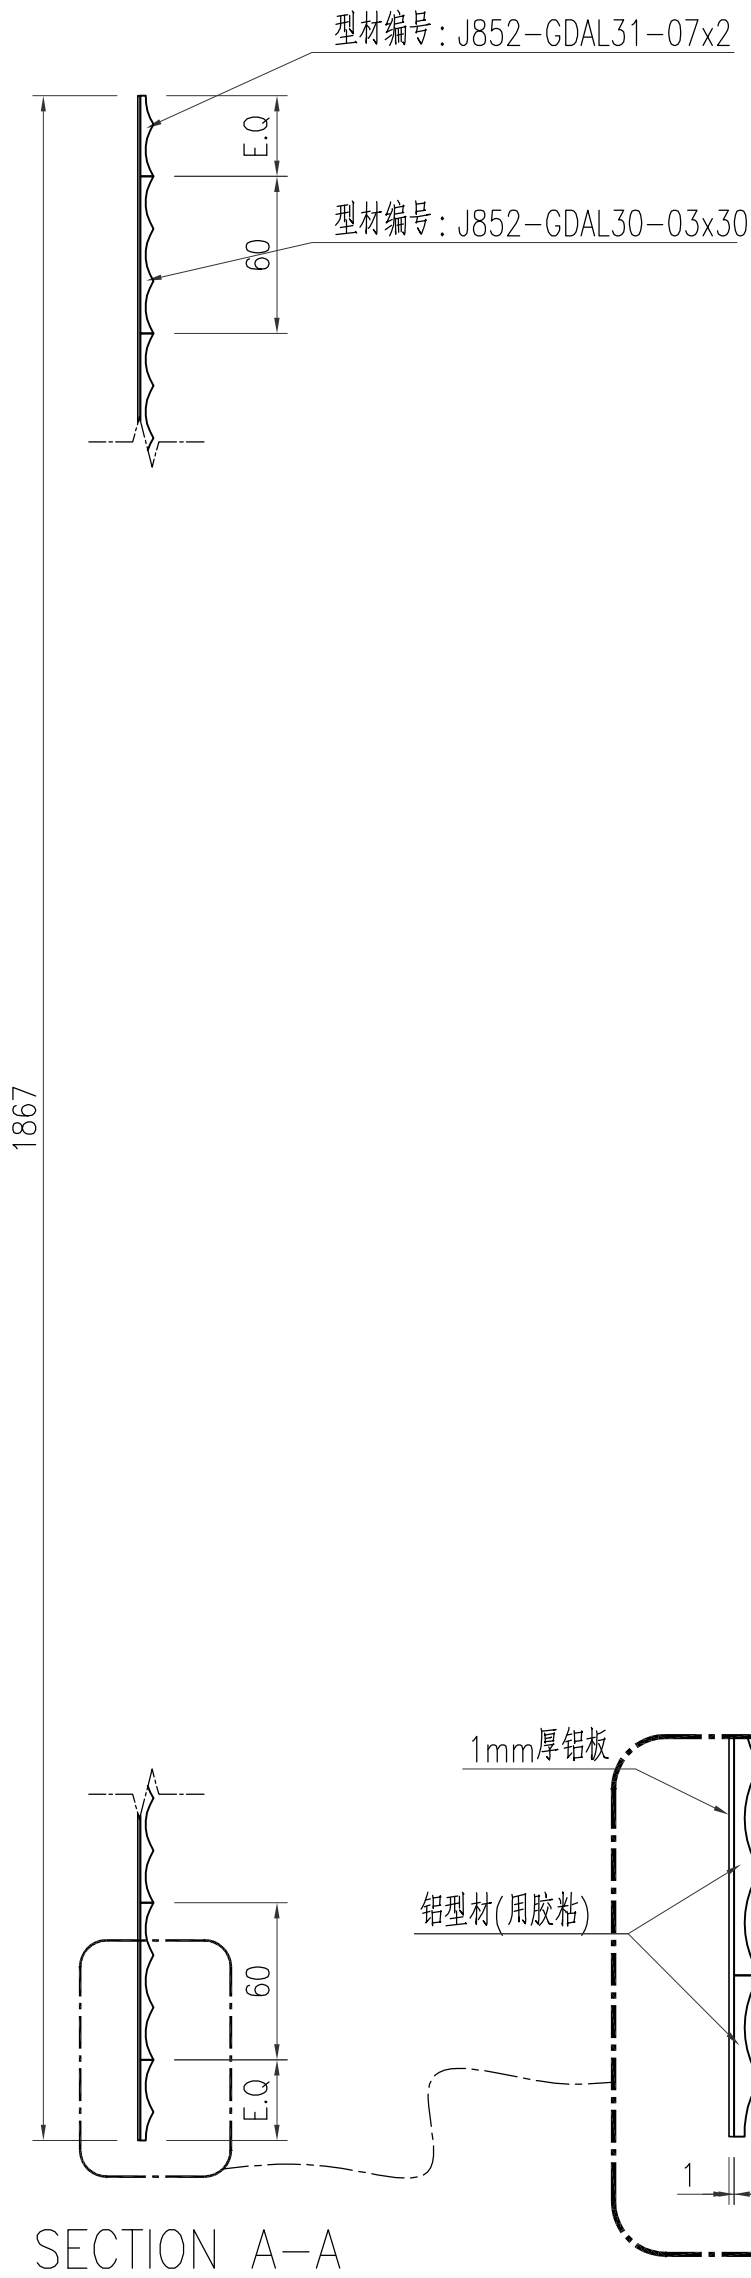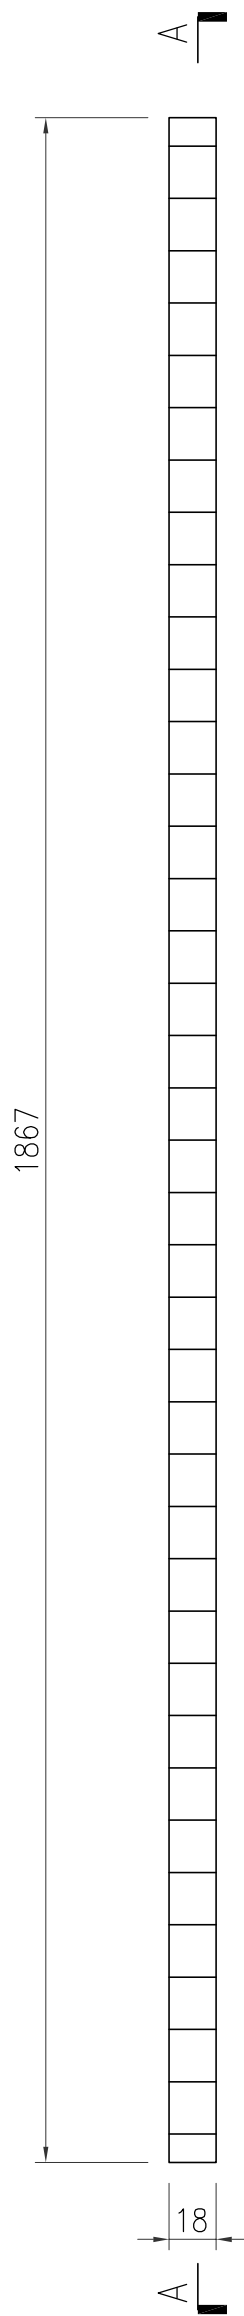



名稱	鋁型材組框圖	制圖	ZJP	2021-11-04	修改			
材料	1mm厚鋁板+X86038	復核			日期			
顏色	-	批准			圖號	J852-GDZK87		

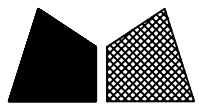


美特鋁質 有限公司  
MIDI Aluminium Fabricator Ltd.

产品编号	L(mm)	数量	N	M	A	B	N1	M1	备注
		12							

工程號	J852	地盤	亞皆老街
-----	------	----	------

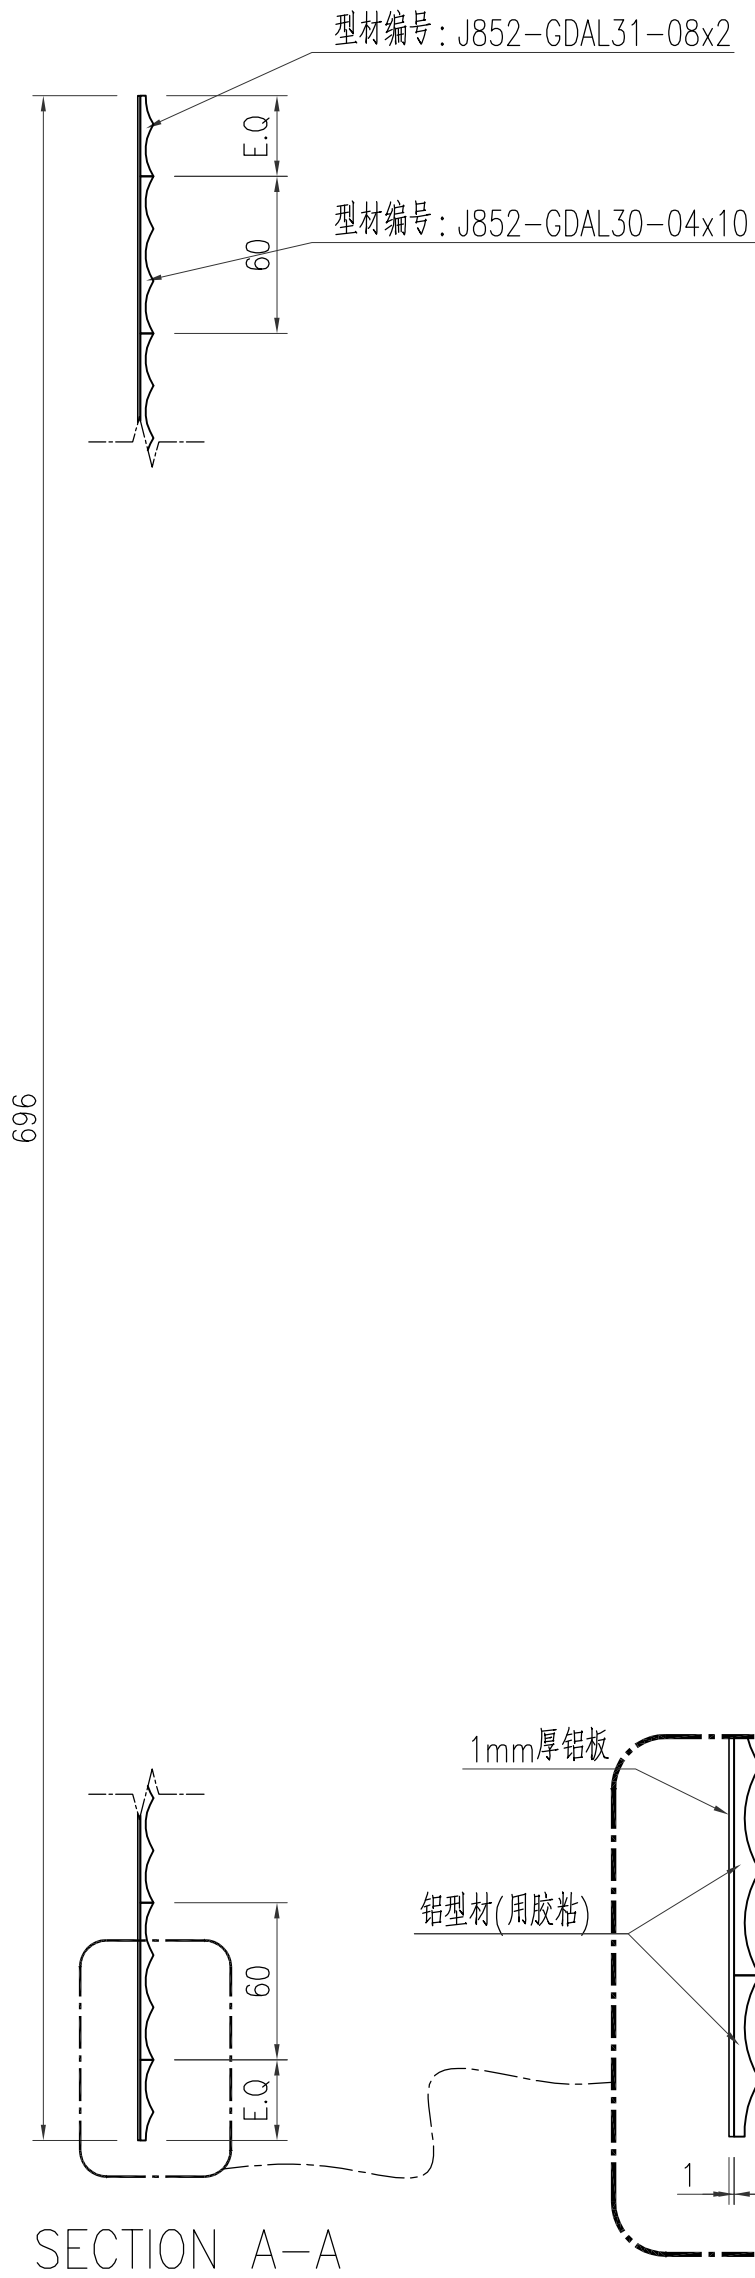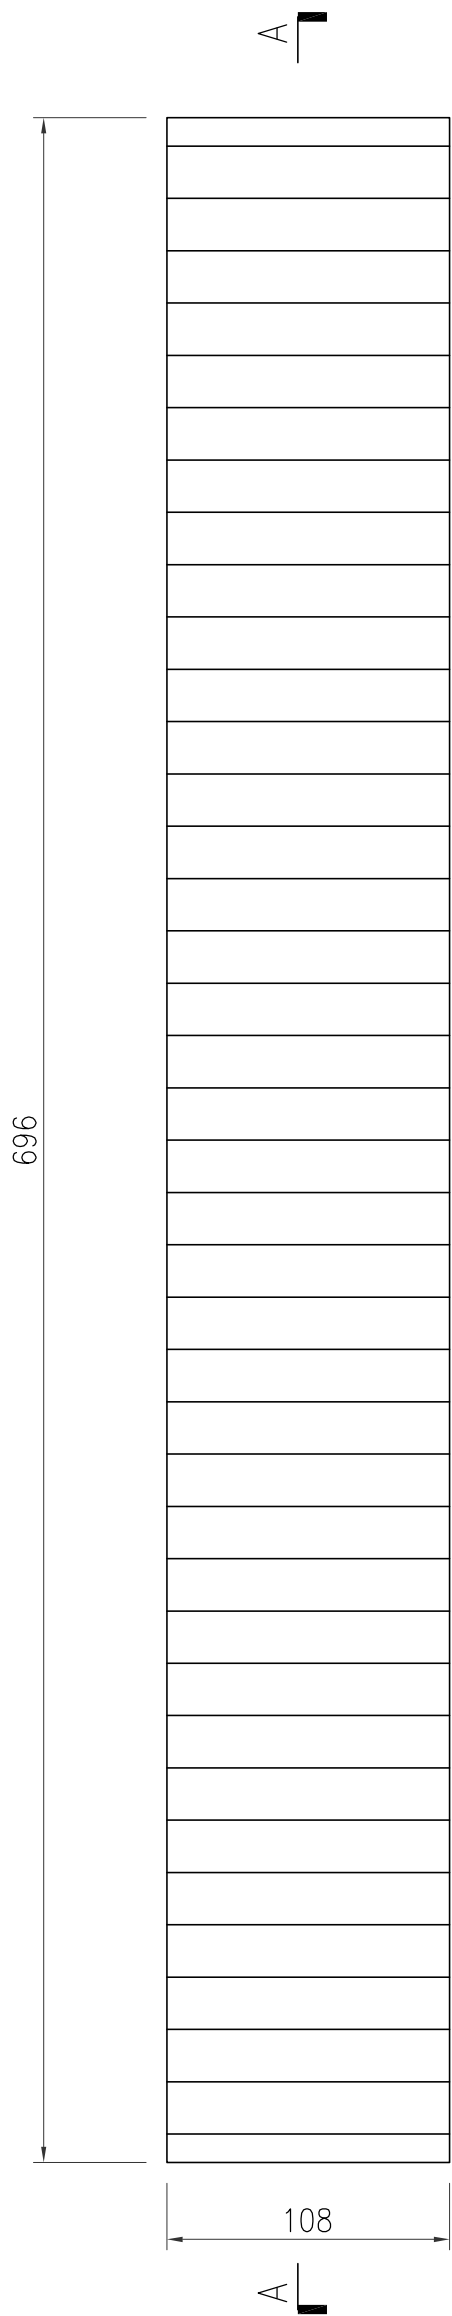



名稱	鋁型材組框圖	制圖	ZJP	2021-11-04	修改			
材料	1mm厚鋁板+X86038	復核			日期			
顏色	-	批准			圖號	J852-GDZK88		

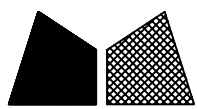


美特鋁質 有限公司  
MIDI Aluminium Fabricator Ltd.

产品编号	L(mm)	数量	N	M	A	B	N1	M1	备注
		12							

工程號 J852 地盤 亞皆老街

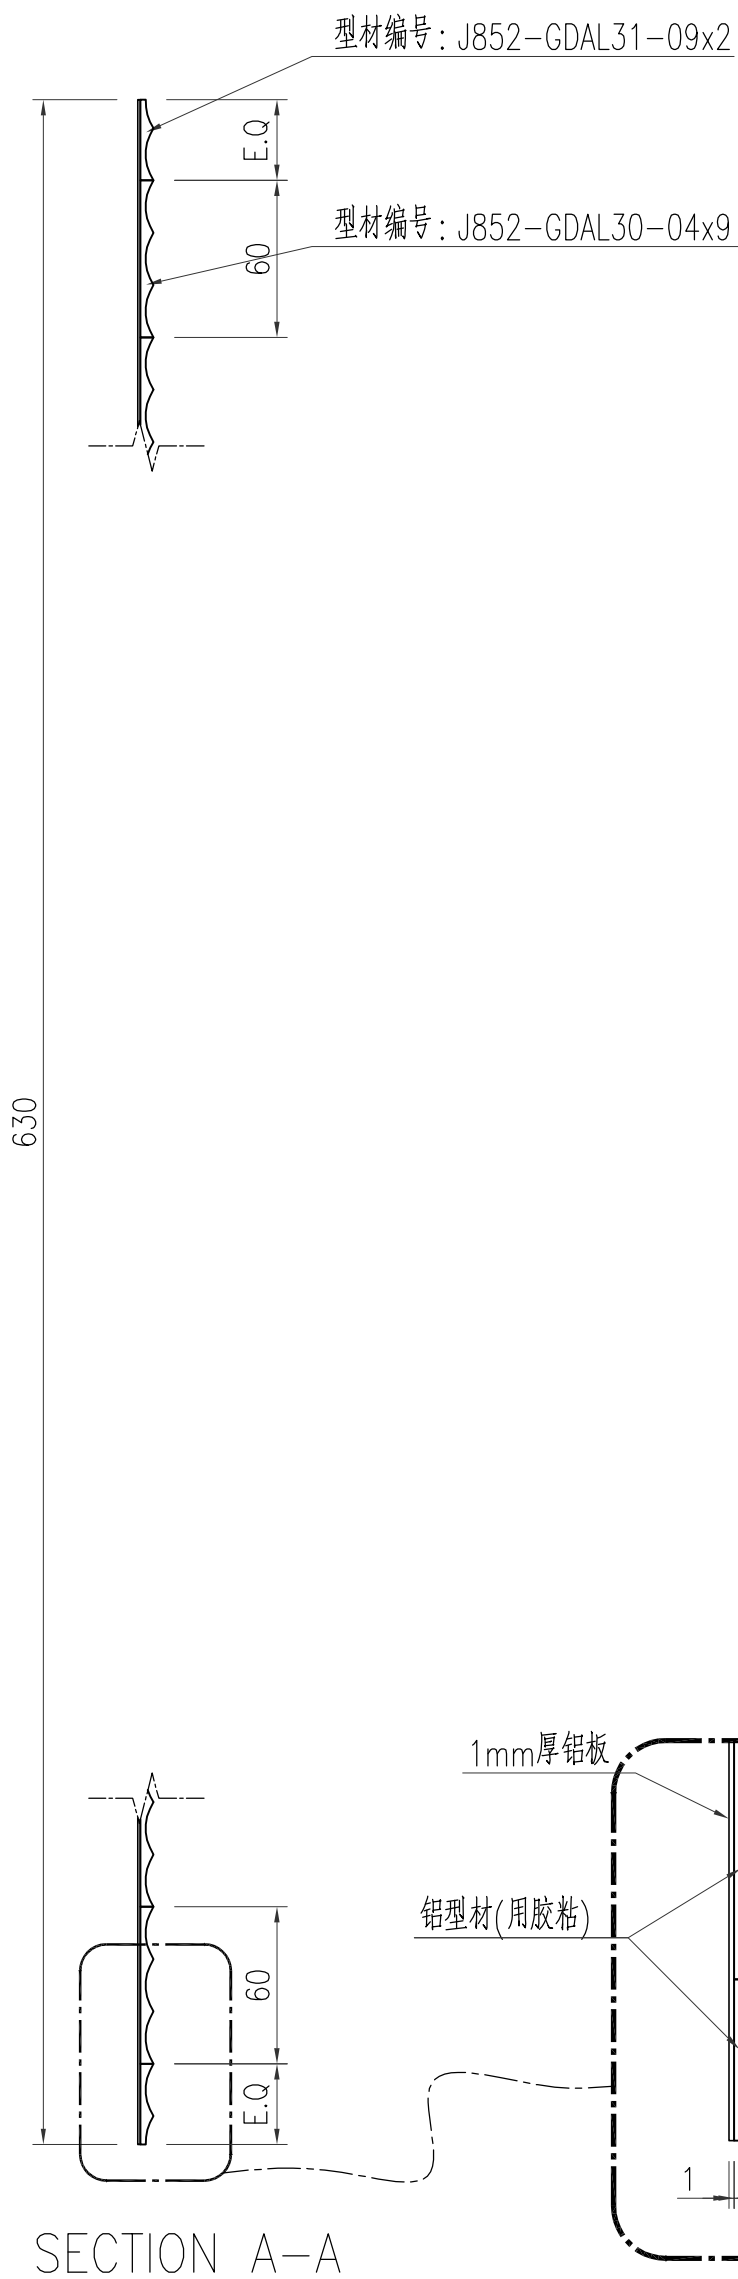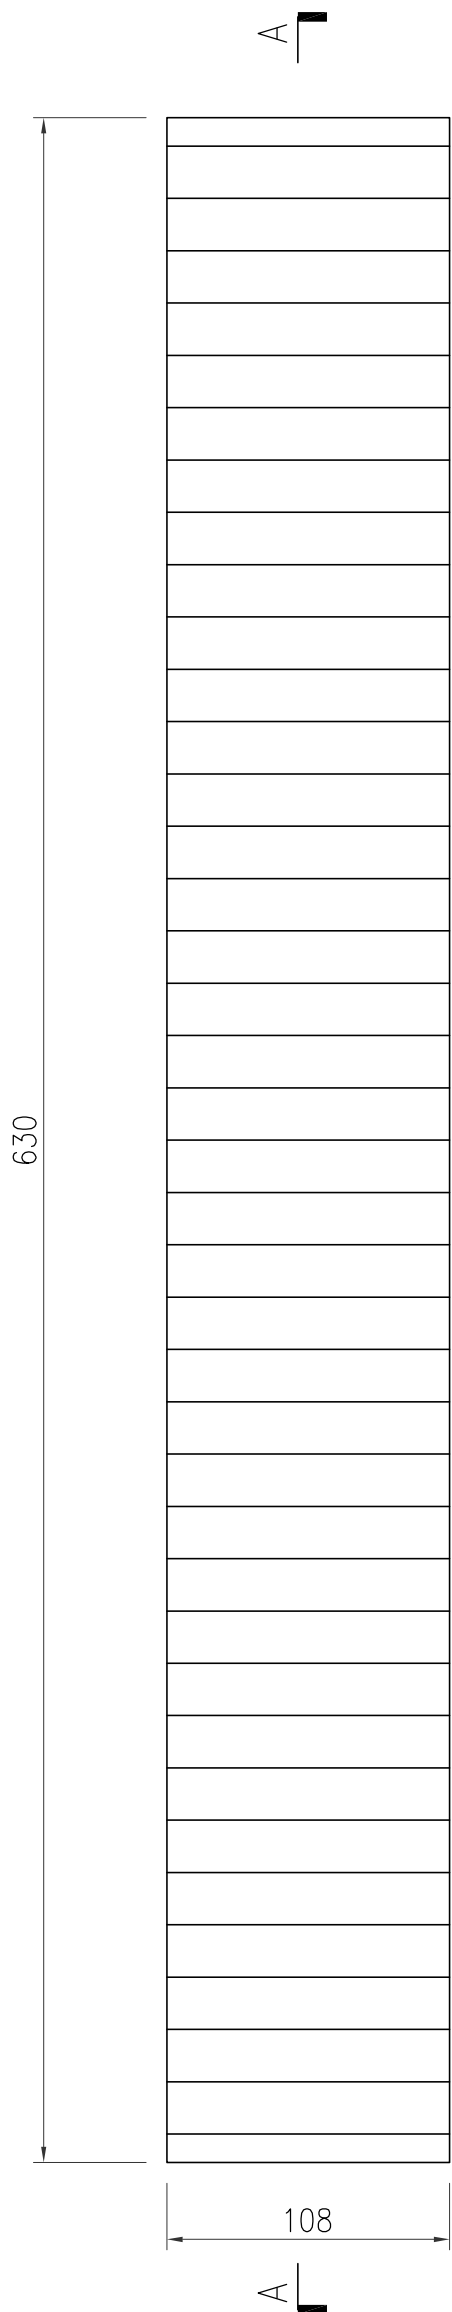



名稱	鋁型材組框圖	制圖	ZJP	2021-11-04	修改			
材料	1mm厚鋁板+X86038	復核			日期			
顏色	-	批准			圖號	J852-GDZK89		

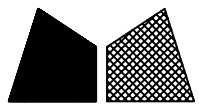


美特鋁質 有限公司  
MIDI Aluminium Fabricator Ltd.

产品编号	L(mm)	数量	N	M	A	B	N1	M1	备注
		4							

工程號 J852 地盤 亞皆老街

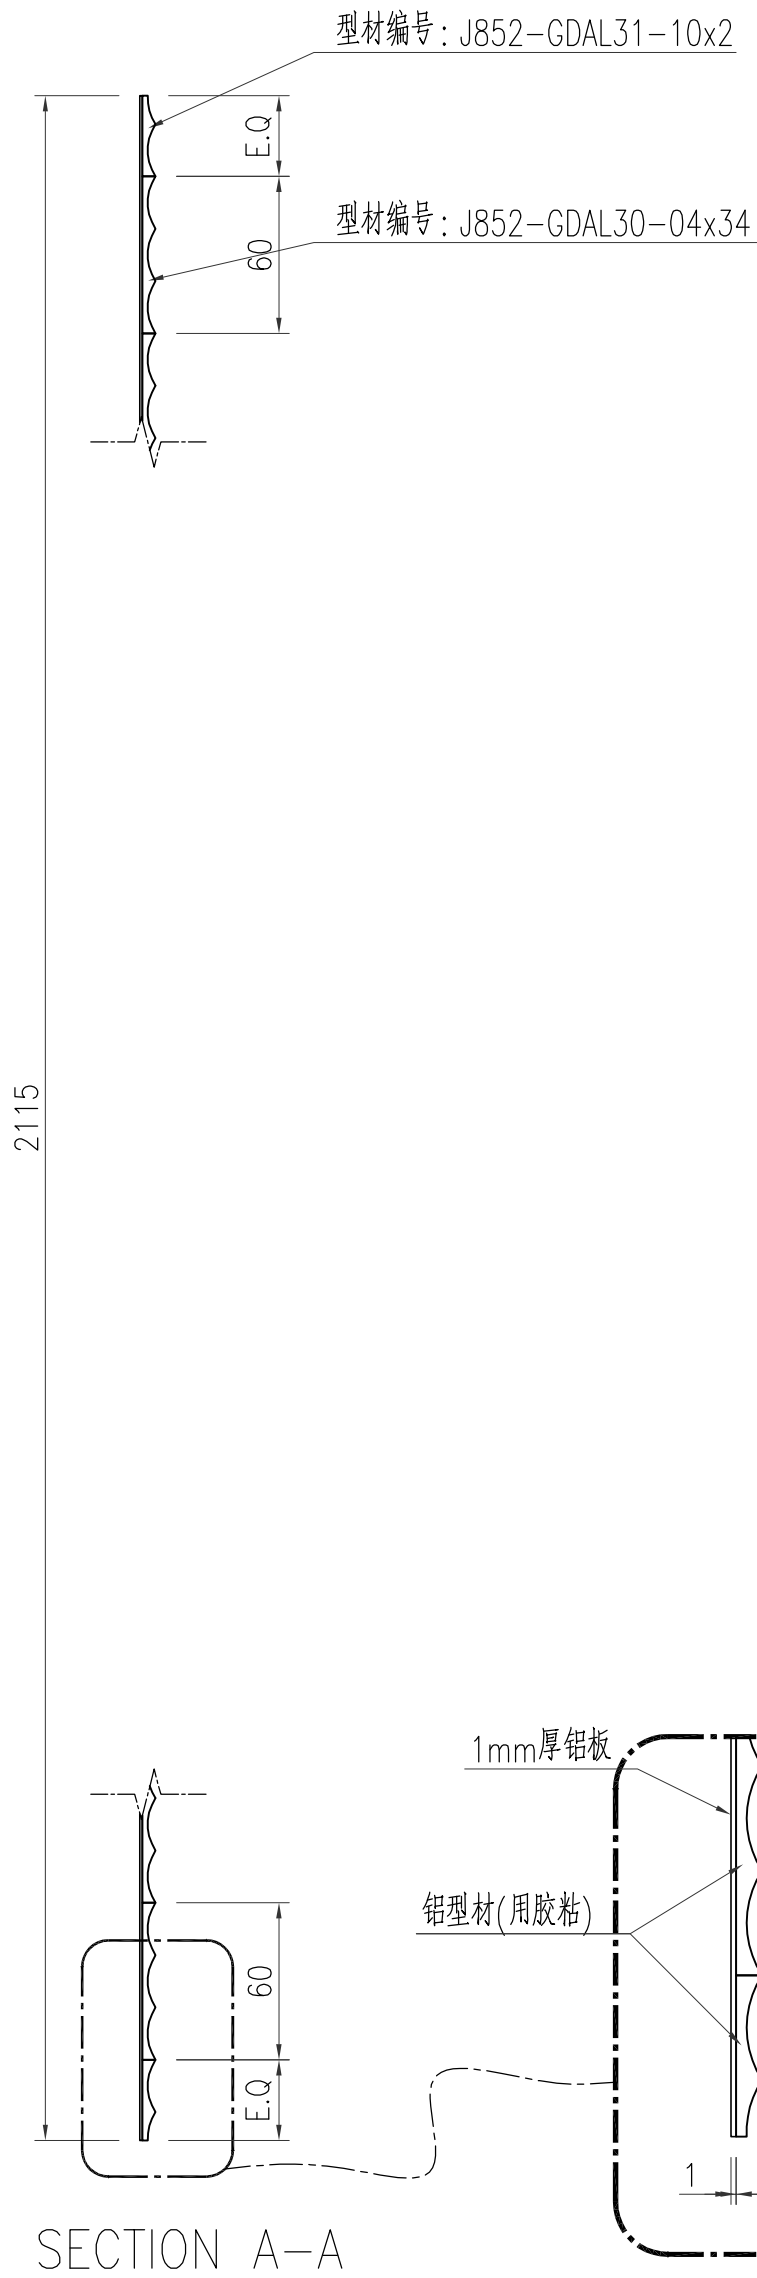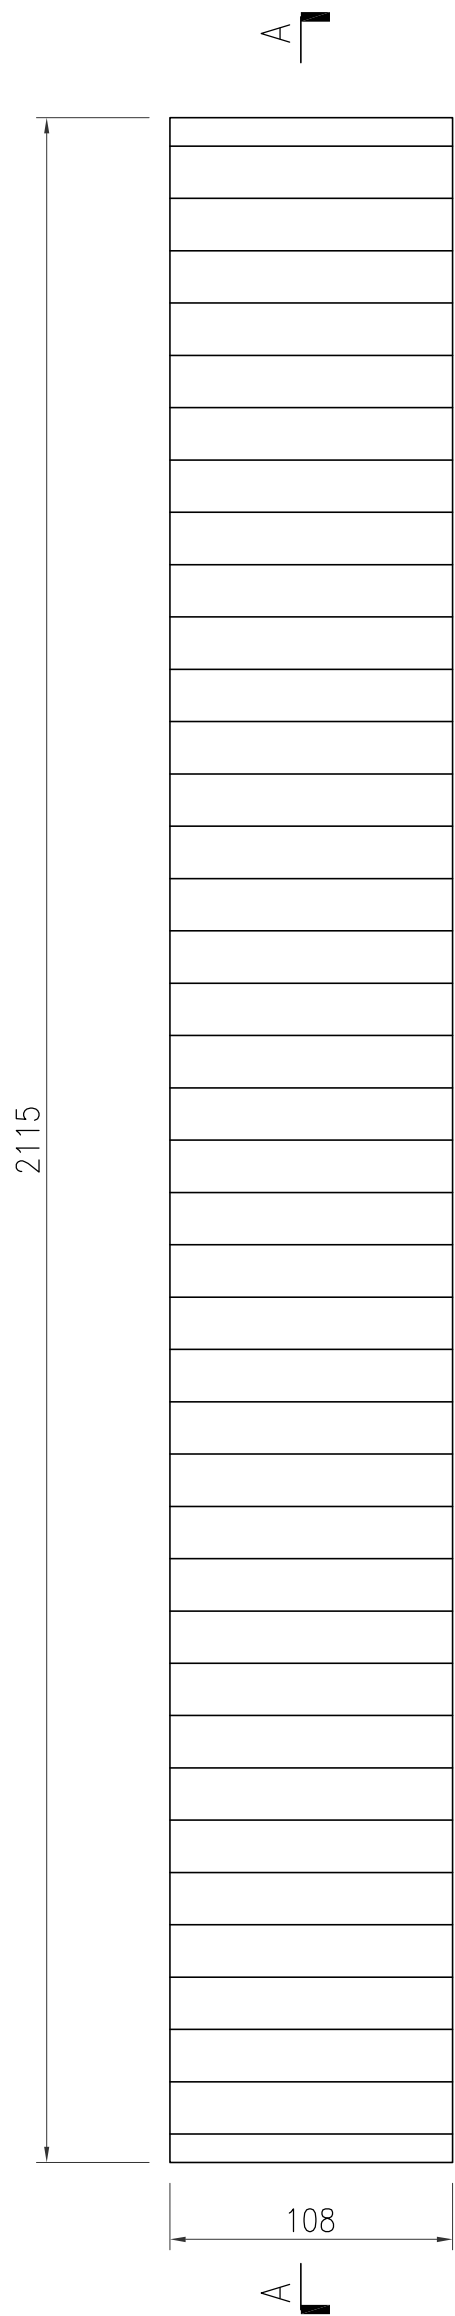



名稱	鋁型材組框圖	制圖	ZJP	2021-11-04	修改			
材料	1mm厚鋁板+X86038	復核			日期			
顏色	-	批准			圖號	J852-GDZK90		

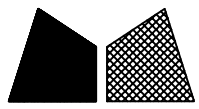


美特鋁質 有限公司  
MIDI Aluminium Fabricator Ltd.

产品编号	L(mm)	数量	N	M	A	B	N1	M1	备注
		2							

工程號	J852	地盤	亞皆老街
-----	------	----	------

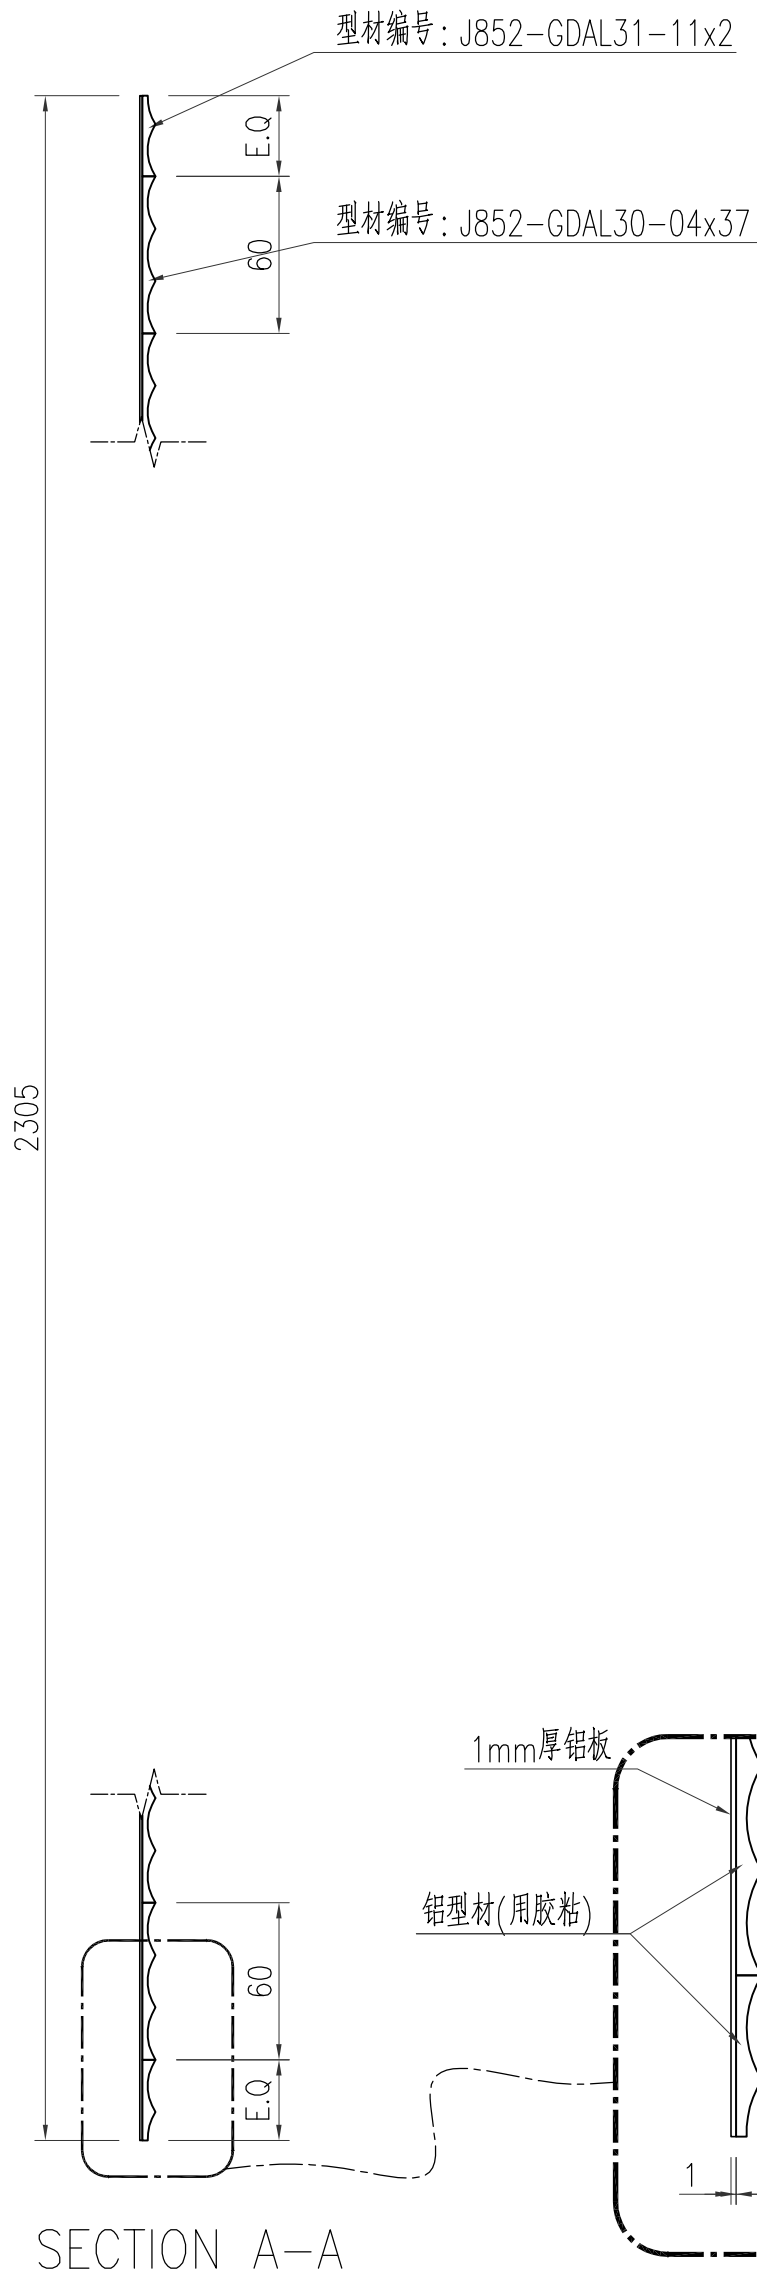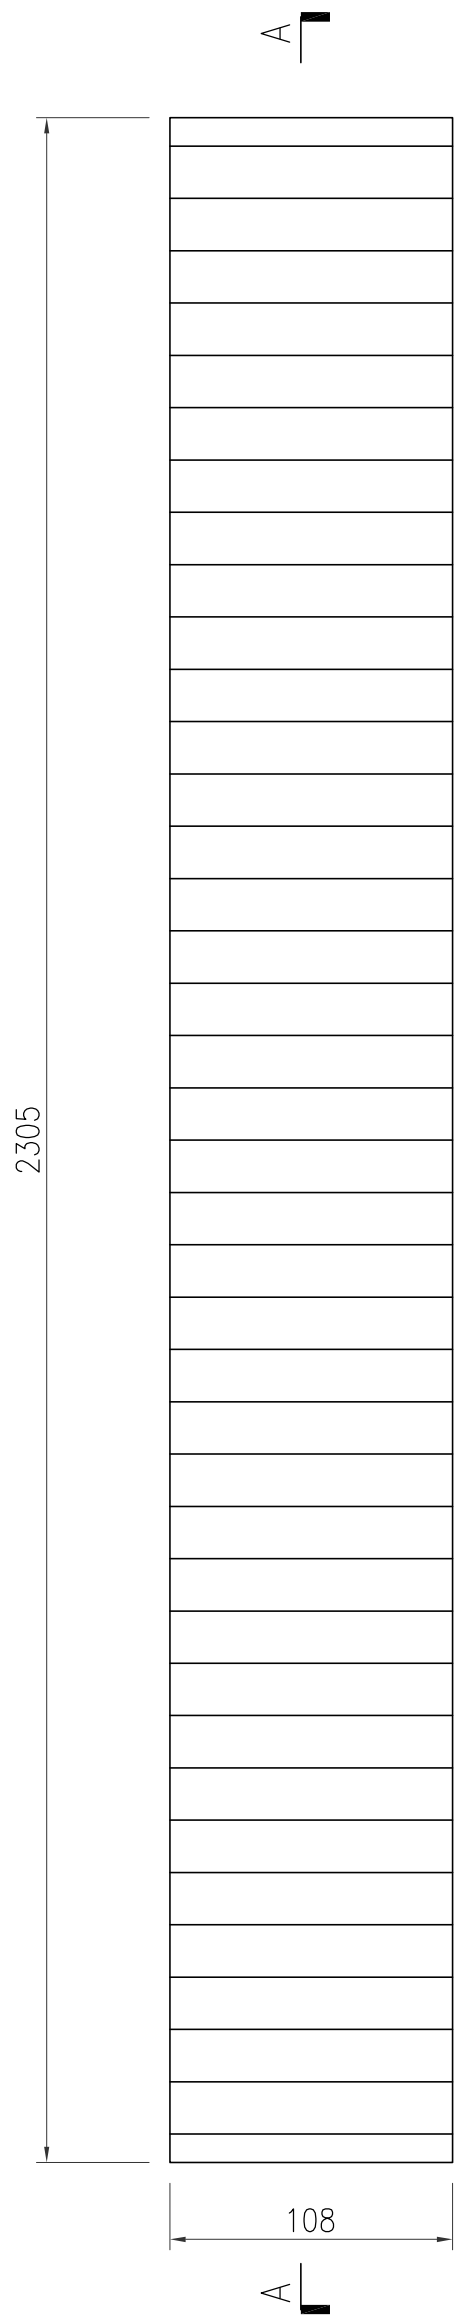



名稱	鋁型材組框圖	制圖	ZJP	2021-11-04	修改			
材料	1mm厚鋁板+X86038	復核			日期			
顏色	-	批准			圖號	J852-GDZK91		

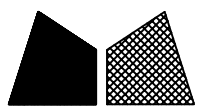


美特鋁質 有限公司  
MIDI Aluminium Fabricator Ltd.

产品编号	L(mm)	数量	N	M	A	B	N1	M1	备注
		24							

工程號 J852 地盤 亞皆老街

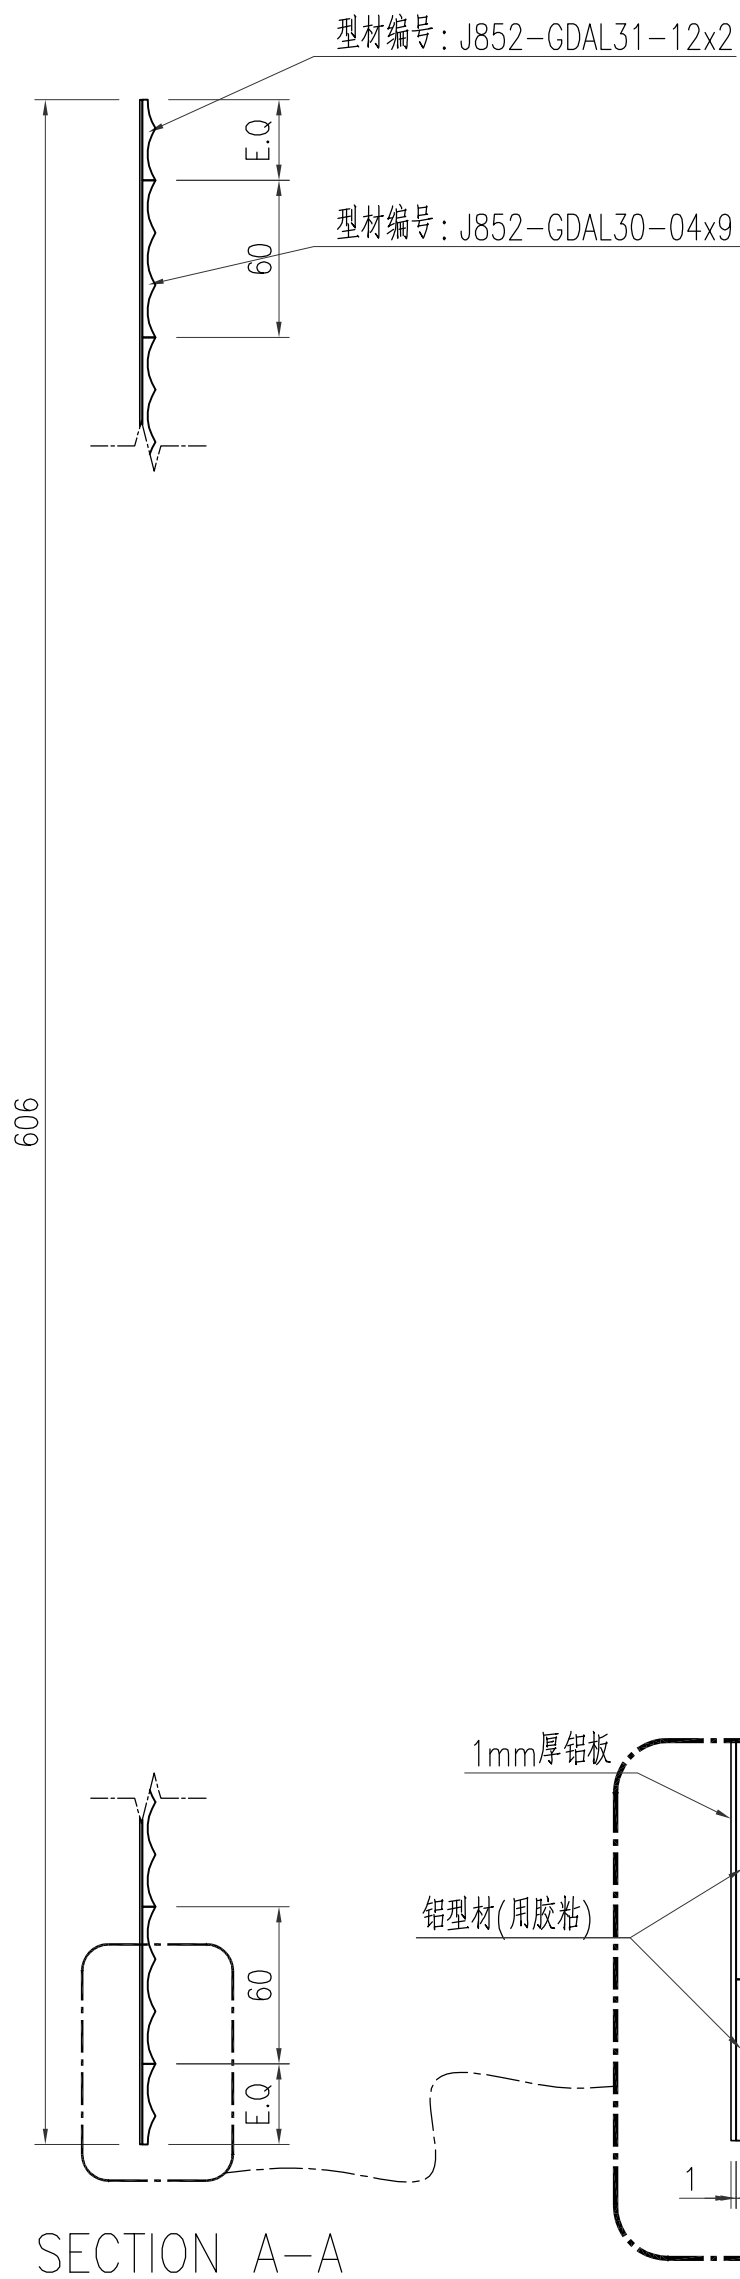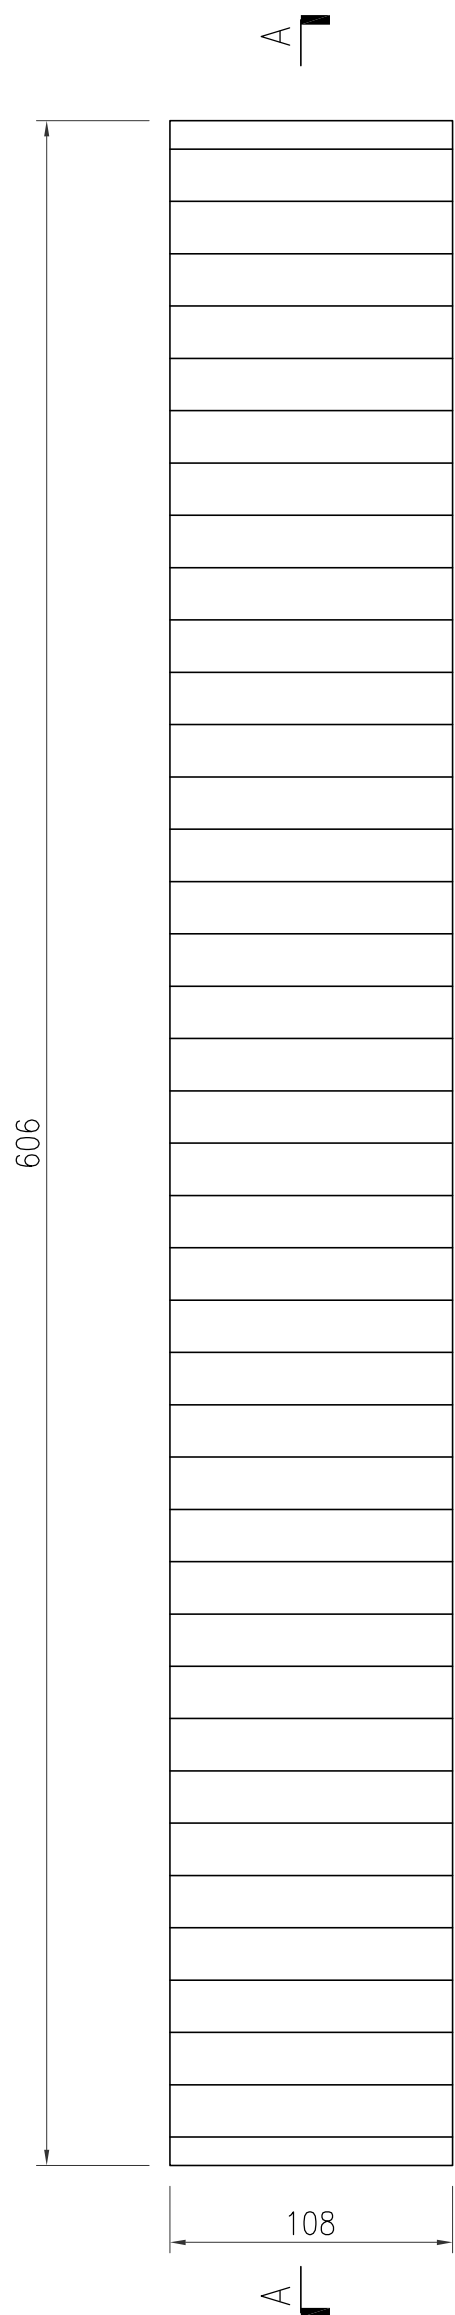



名稱	鋁型材組框圖	制圖	ZJP	2021-11-04	修改			
材料	1mm厚鋁板+X86038	復核			日期			
顏色	-	批准			圖號	J852-GDZK92		

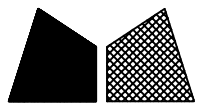


美特鋁質 有限公司  
MIDI Aluminium Fabricator Ltd.

产品编号	L(mm)	数量	N	M	A	B	N1	M1	备注
		12							

工程號 J852 地盤 亞皆老街

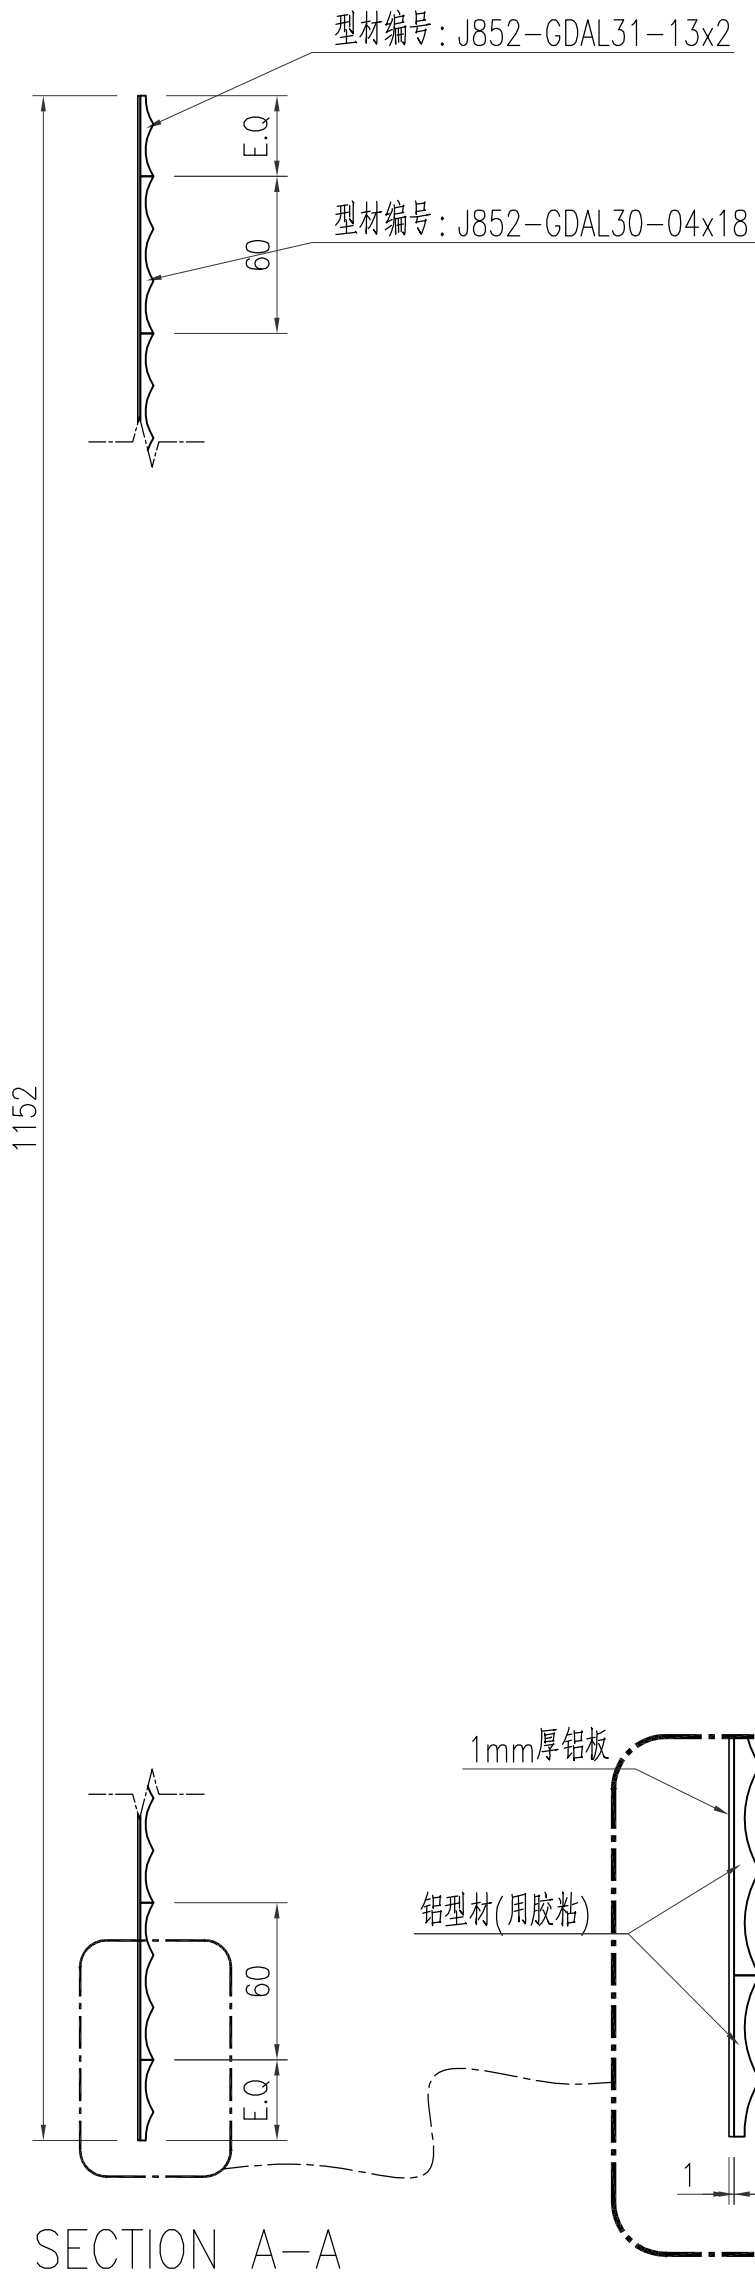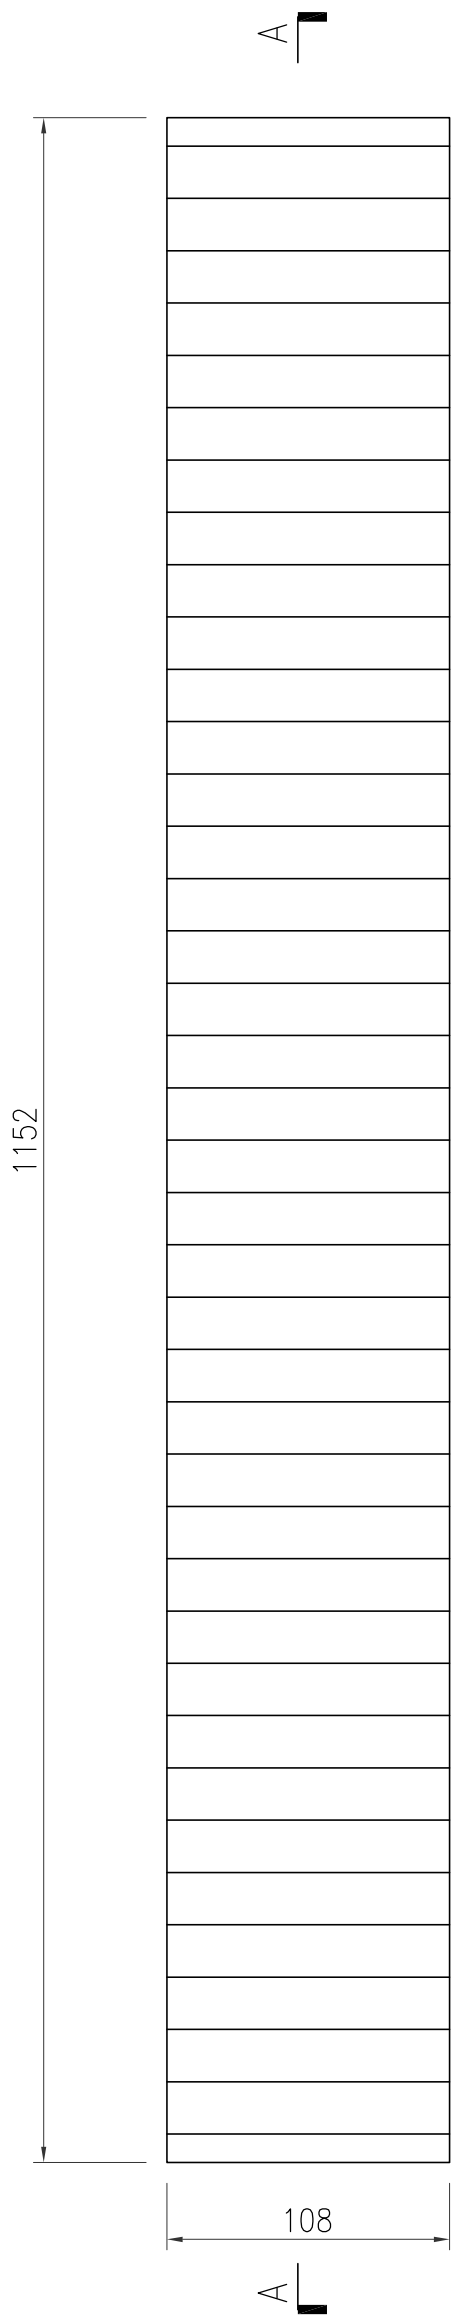


名稱	鋁型材組框圖	制圖	ZJP	2021-11-04	修改			
材料	1mm厚鋁板+X86038	復核			日期			
顏色	-	批准			圖號	J852-GDZK93		

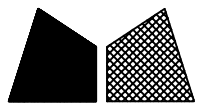


美特鋁質 有限公司  
MIDI Aluminium Fabricator Ltd.

产品编号	L(mm)	数量	N	M	A	B	N1	M1	备注
		8							

工程號	J852	地盤	亞皆老街
-----	------	----	------

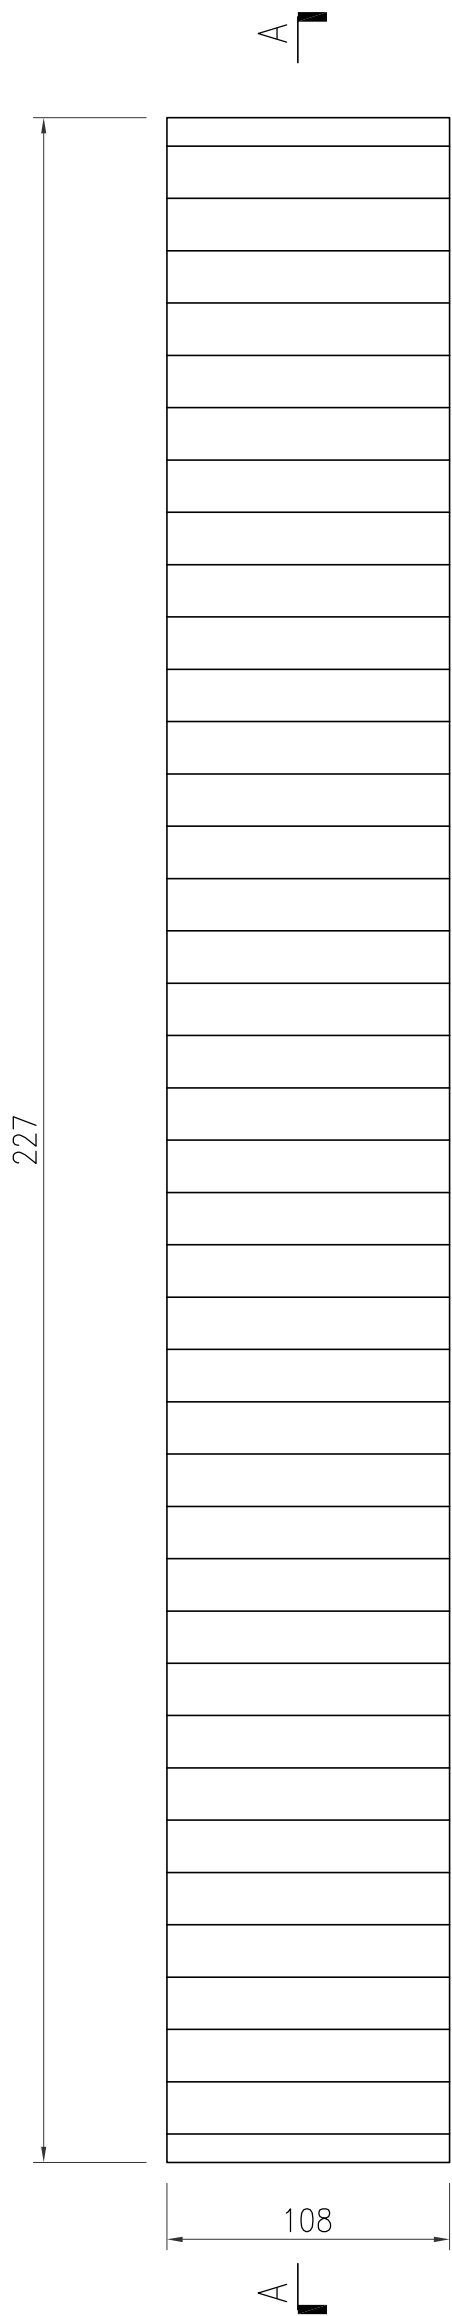



名稱	鋁型材組框圖	制圖	ZJP	2021-11-04	修改			
材料	1mm厚鋁板+X86038	復核			日期			
顏色	-	批准			圖號	J852-GDZK94		

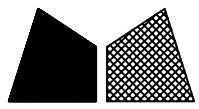


美特鋁質 有限公司  
MIDI Aluminium Fabricator Ltd.

产品编号	L(mm)	数量	N	M	A	B	N1	M1	备注
		4							

工程號	J852	地盤	亞皆老街
-----	------	----	------

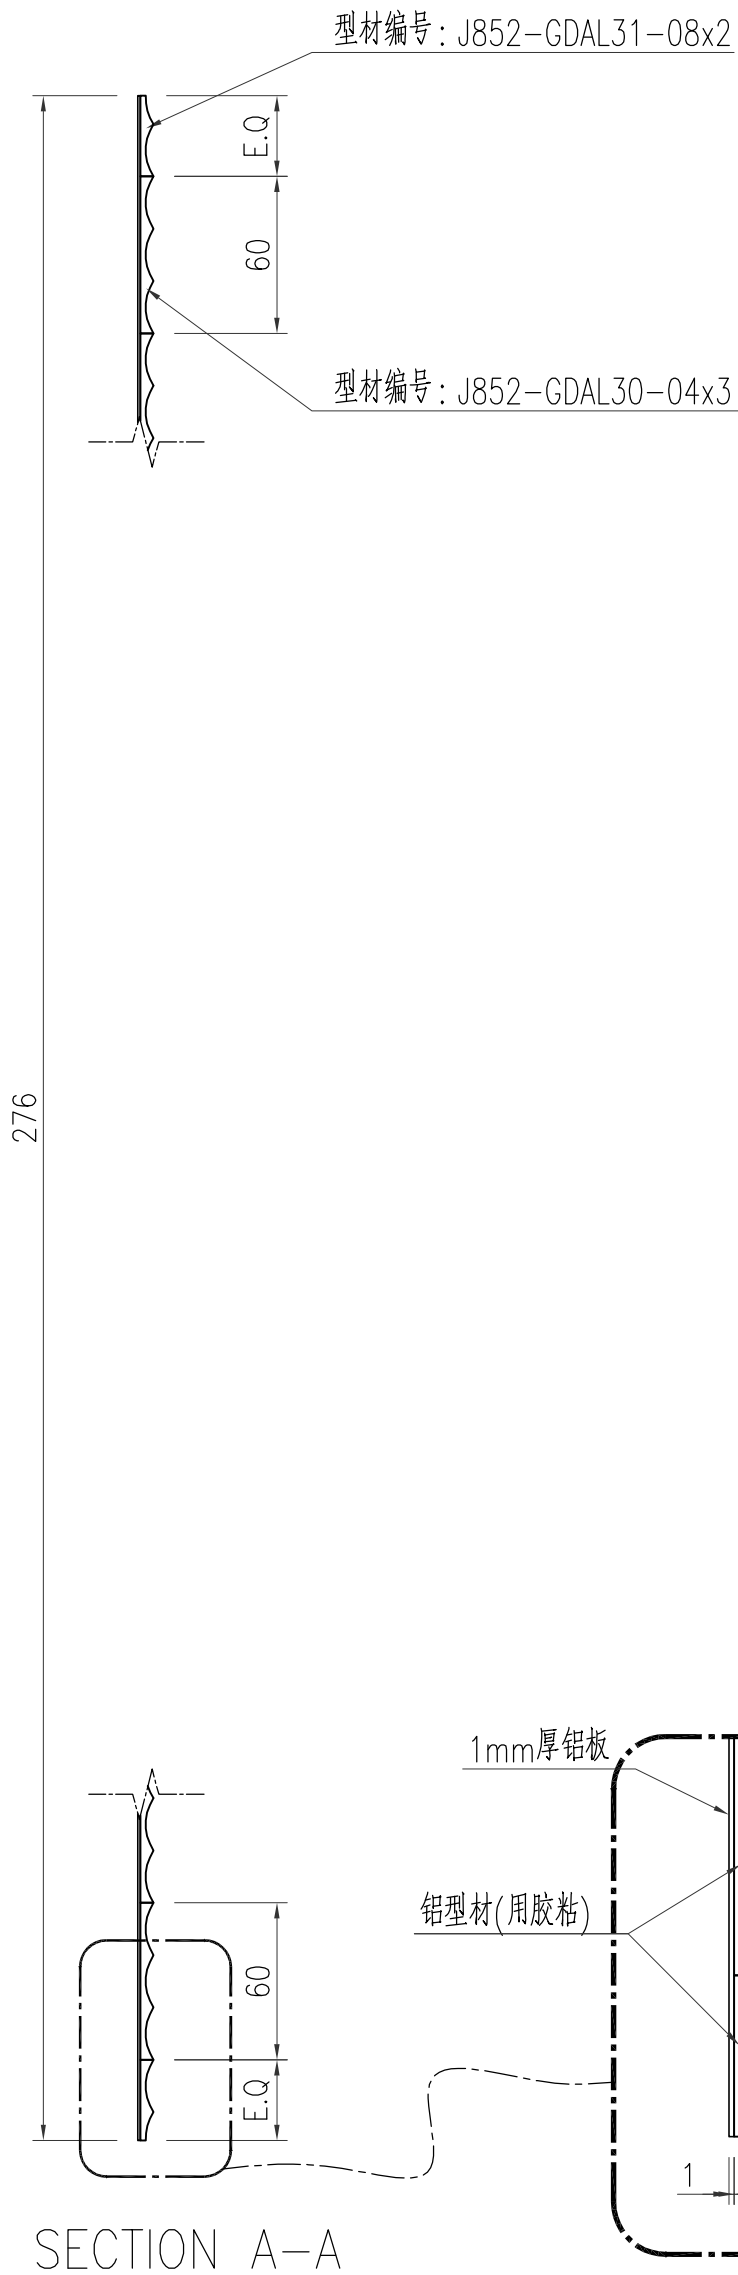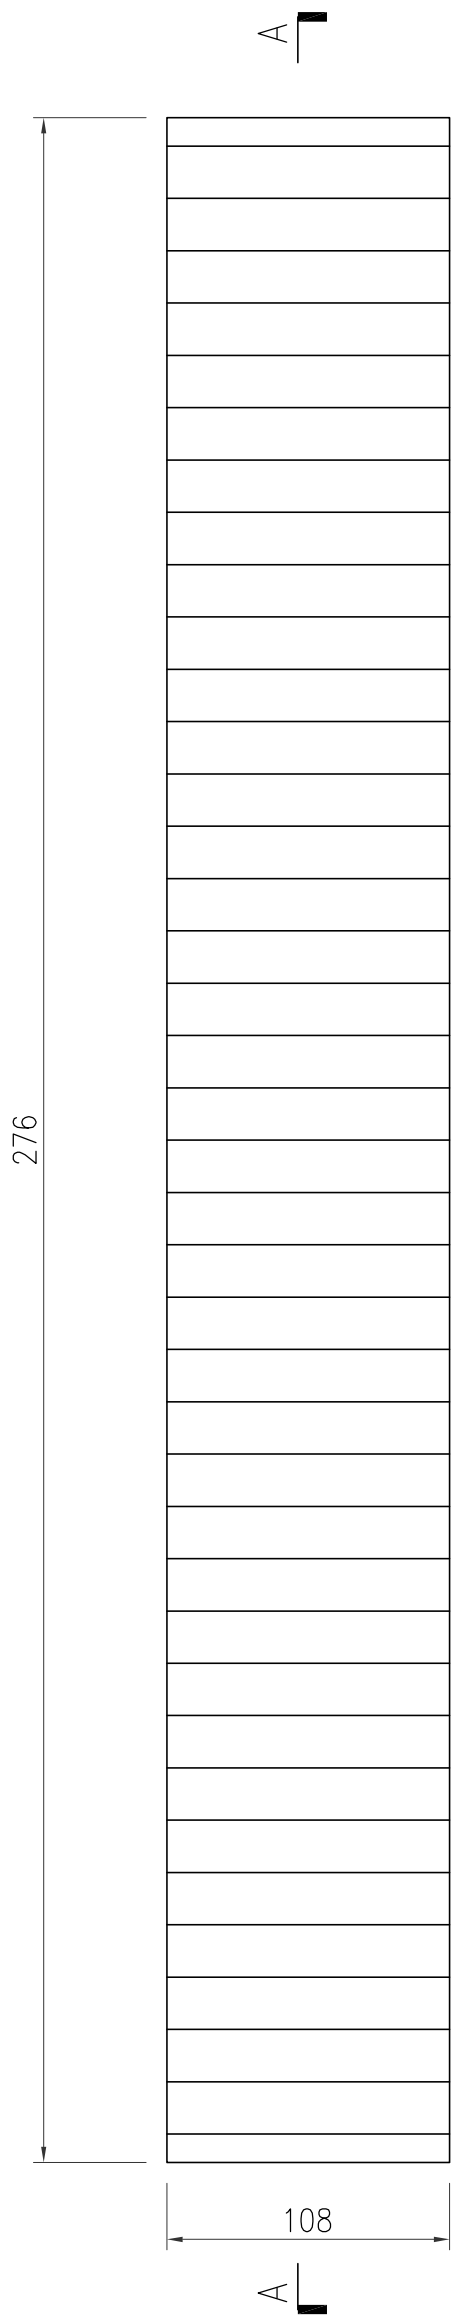



名稱	鋁型材組框圖	制圖	ZJP	2021-11-04	修改			
材料	1mm厚鋁板+X86038	復核			日期			
顏色	-	批准			圖號	J852-GDZK95		

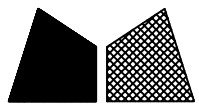


美特鋁質 有限公司  
MIDI Aluminium Fabricator Ltd.

产品编号	L(mm)	数量	N	M	A	B	N1	M1	备注
		2							

工程號	J852	地盤	亞皆老街
-----	------	----	------

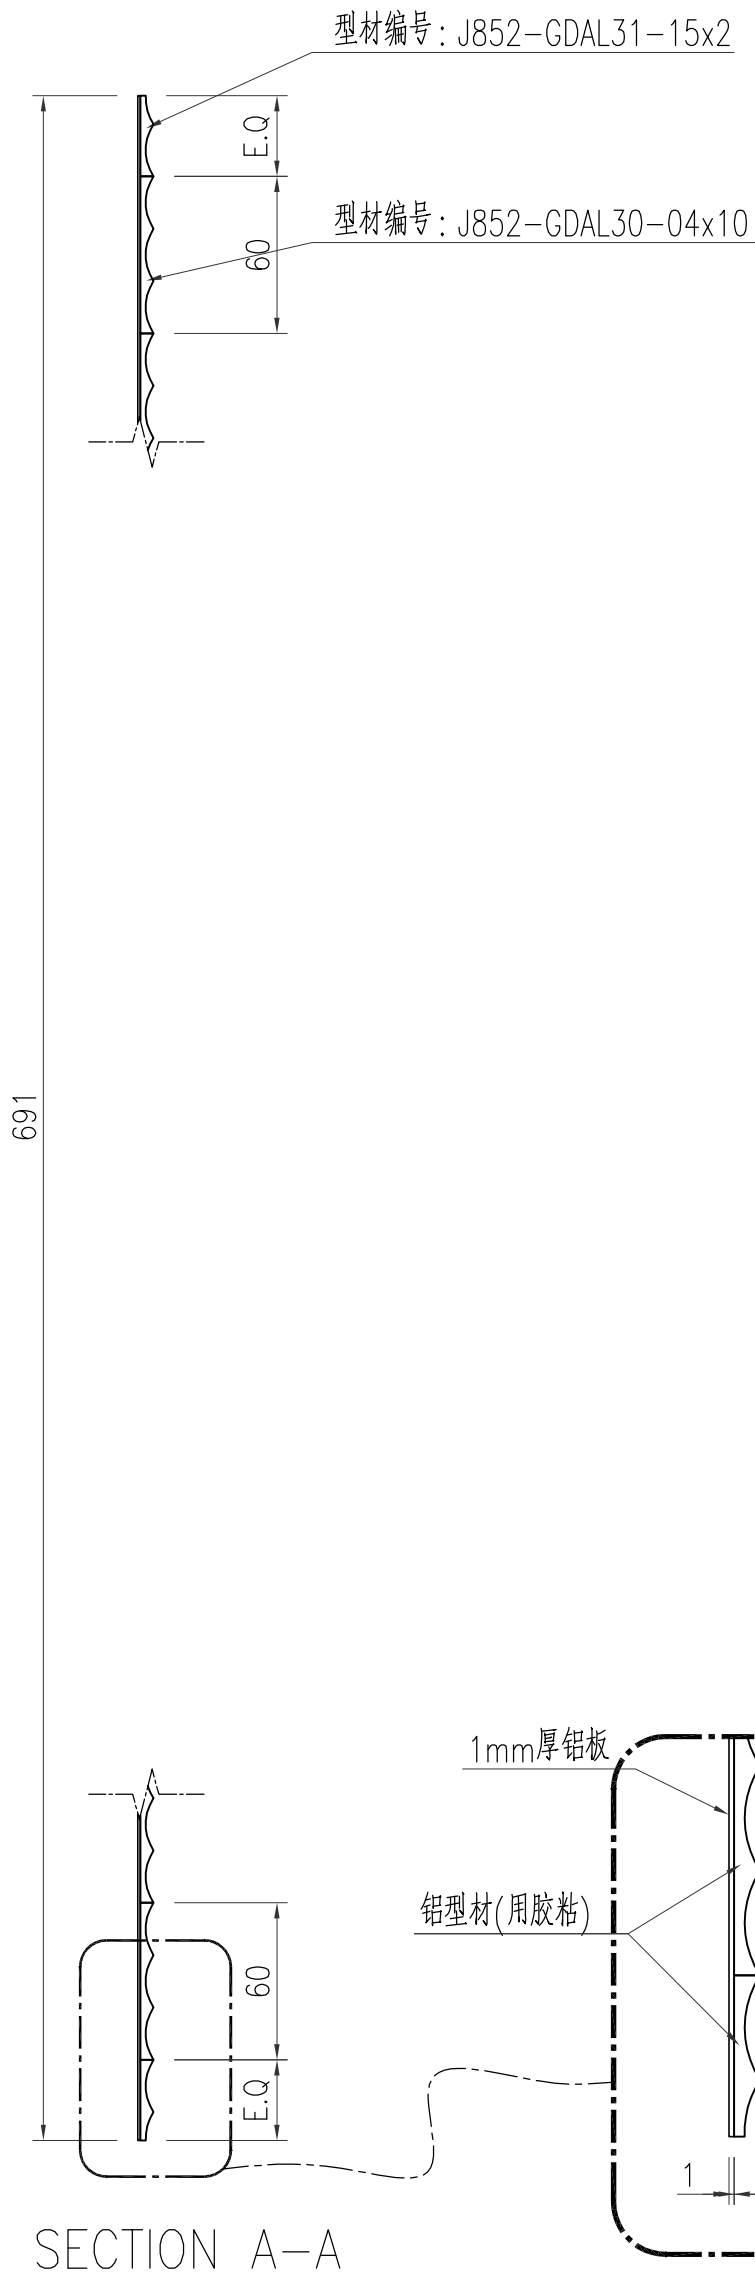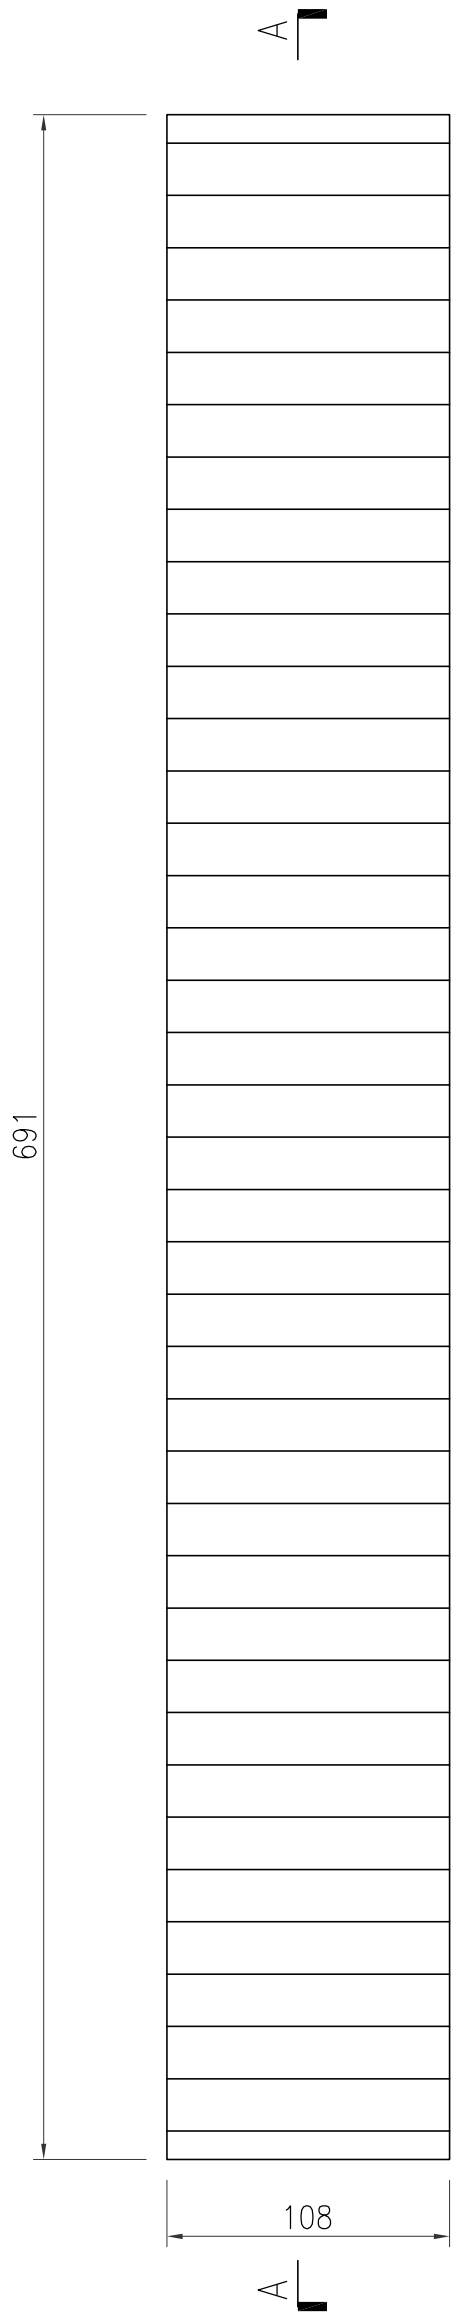



名稱	鋁型材組框圖	制圖	ZJP	2021-11-04	修改			
材料	1mm厚鋁板+X86038	復核			日期			
顏色	-	批准			圖號	J852-GDZK96		

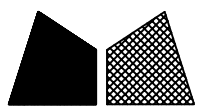

美特鋁質 有限公司  
MIDI Aluminium Fabricator Ltd.


产品编号	L(mm)	数量	N	M	A	B	N1	M1	备注
J852-GDAL30-01	158	816							
J852-GDAL30-02	68	736							
J852-GDAL30-03	18	480							
J852-GDAL30-04	108	926							

工程號	J852	地盤	亞皆老街
-----	------	----	------

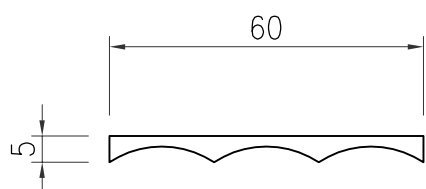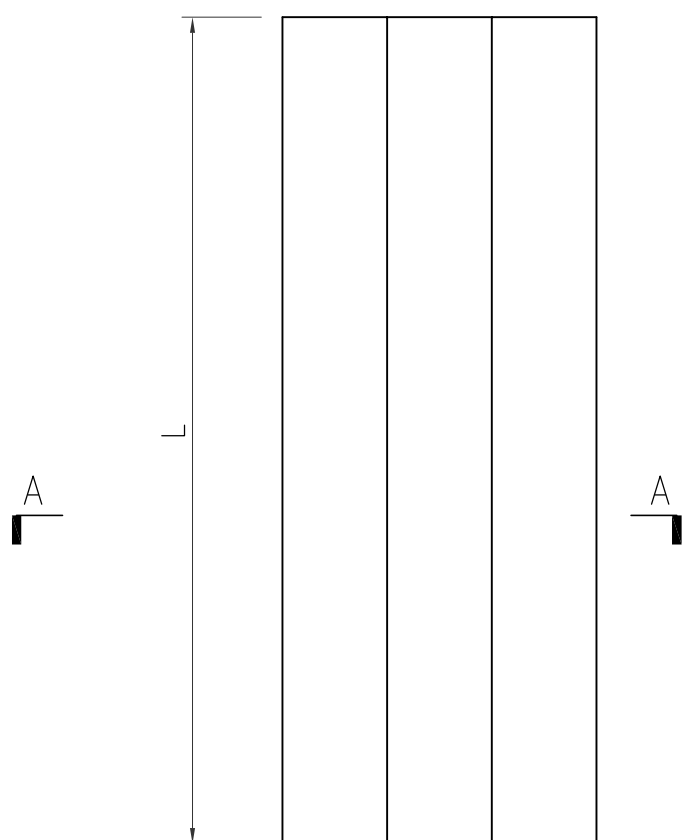

SECTION A-A



名稱	型材加工圖	制圖	ZJP	2021-11-04	修改			
材料	X86038	復核			日期			
顏色	UCT201498XL(A)-3 灰色	批准			圖號	J852-GDAL30		

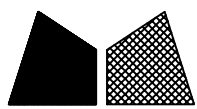

美特鋁質 有限公司  
MIDI Aluminium Fabricator Ltd.





工程號	J852	地盤	亞皆老街
-----	------	----	------

产品编号	L(mm)	数量	N	M	A	B	N1	M1	备注
J852-GDAL31-01	158	64			18				
J852-GDAL31-02	158	8			39				
J852-GDAL31-02a	158	64			53				
J852-GDAL31-03	68	40			23.5				
J852-GDAL31-04	68	8			56				
J852-GDAL31-05	68	8			43				
J852-GDAL31-06	68	8			44.5				
J852-GDAL31-07	18	64			33.5				
J852-GDAL31-08	108	32			48				
J852-GDAL31-09	108	24			45				
J852-GDAL31-10	108	8			37.5				
J852-GDAL31-11	108	4			42.5				
J852-GDAL31-12	108	48			33				
J852-GDAL31-13	108	24			36				
J852-GDAL31-14	108	16			23.5				
J852-GDAL31-15	108	4			45.5				

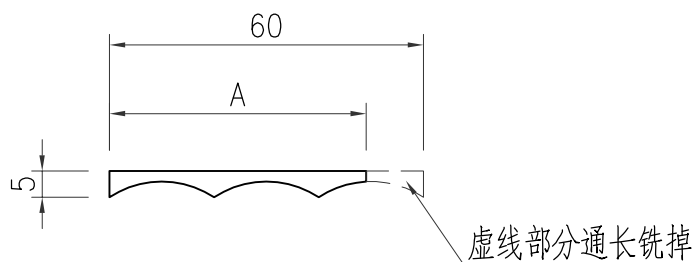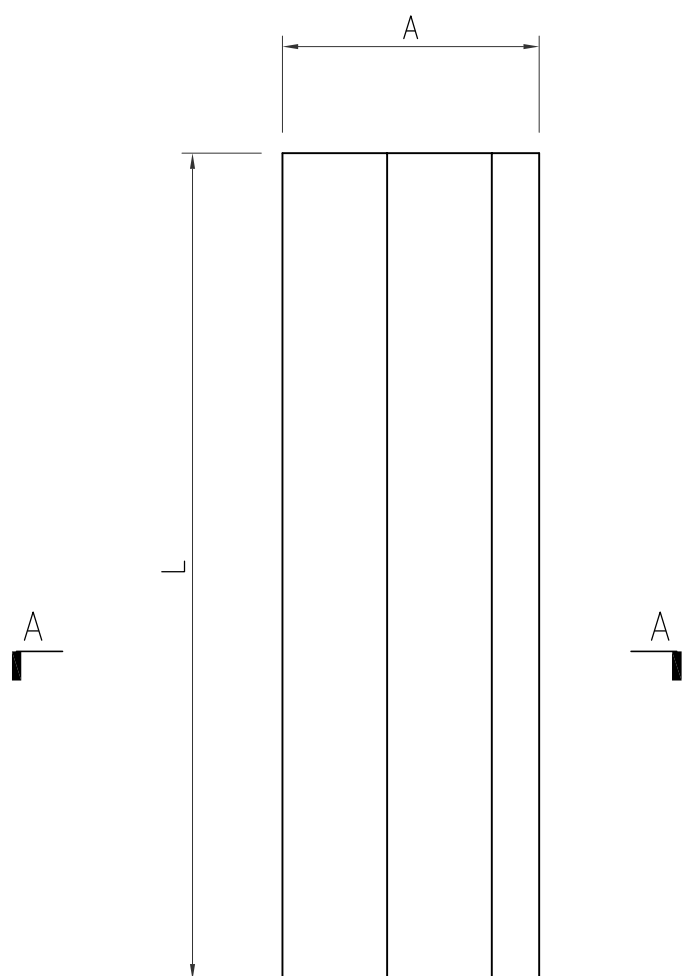

SECTION A-A


名稱	型材加工圖	制圖	ZJP	2021-11-04	修改			
材料	X86038	復核			日期			
顏色	UCT201498XL(A)-3 灰色	批准			圖號	J852-GDAL31		

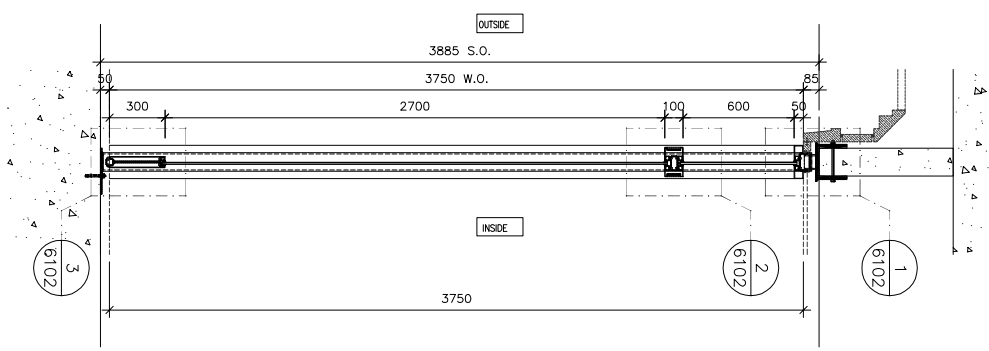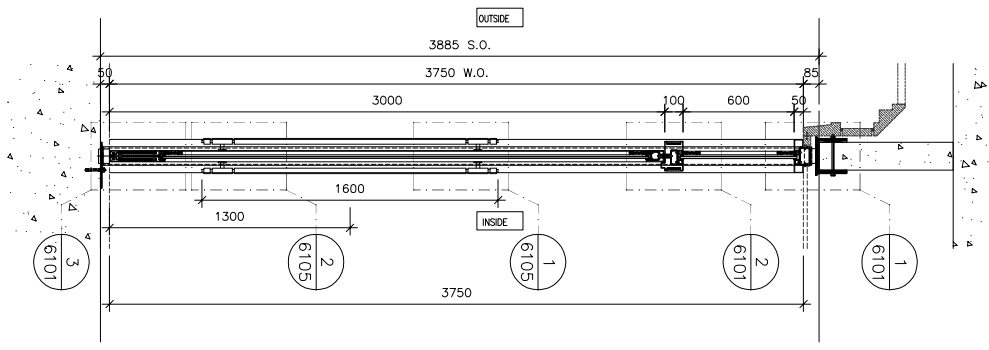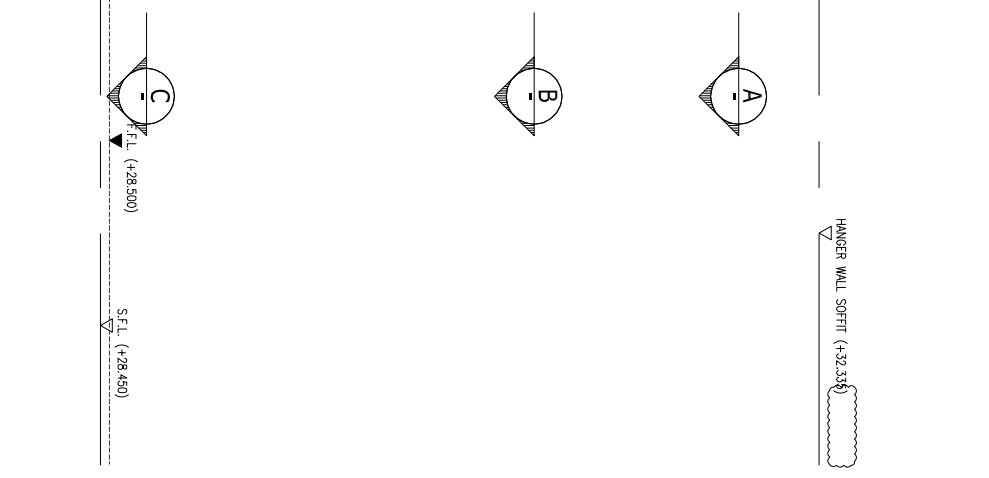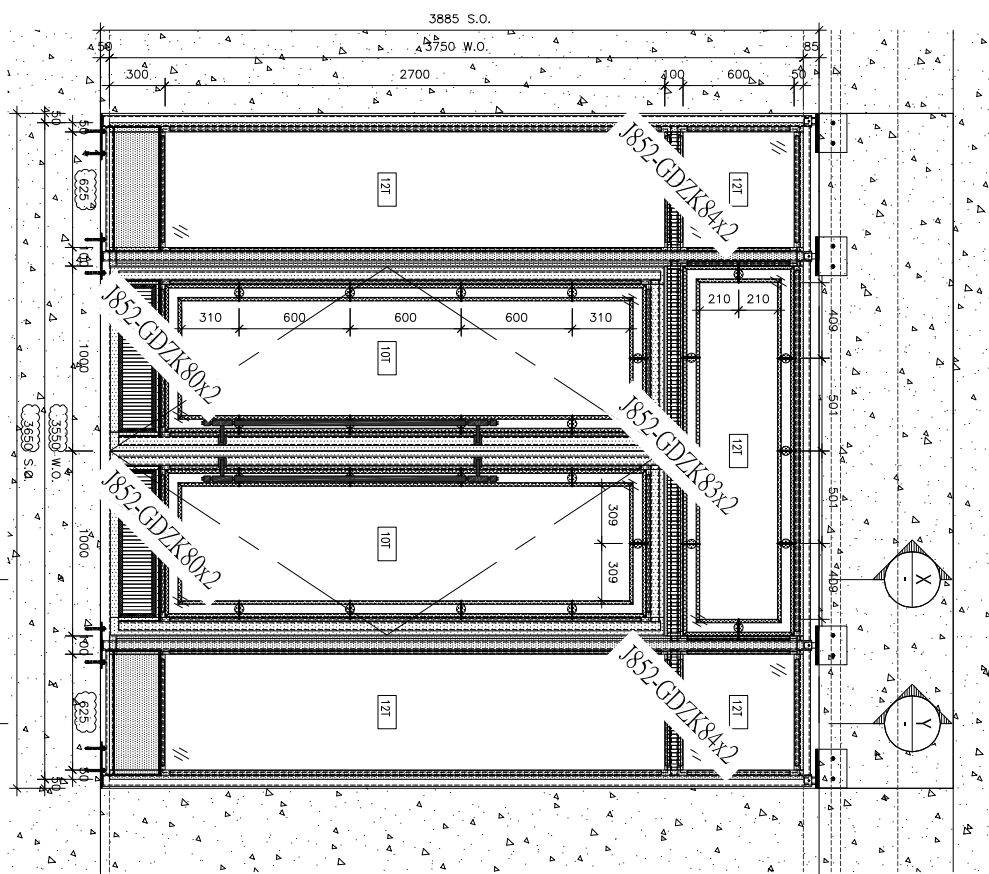


ELEVATION

SECTION X


SECTION Y

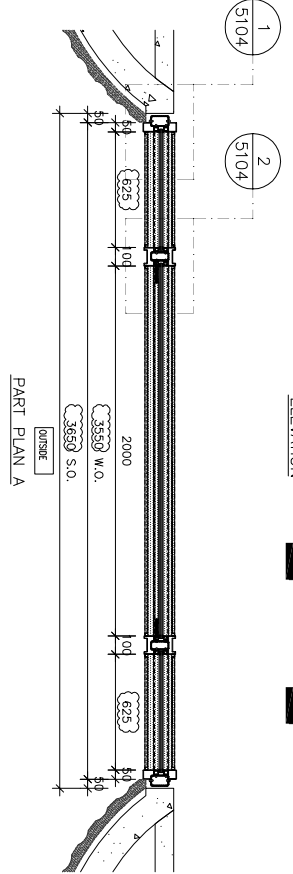

PART PLAN A

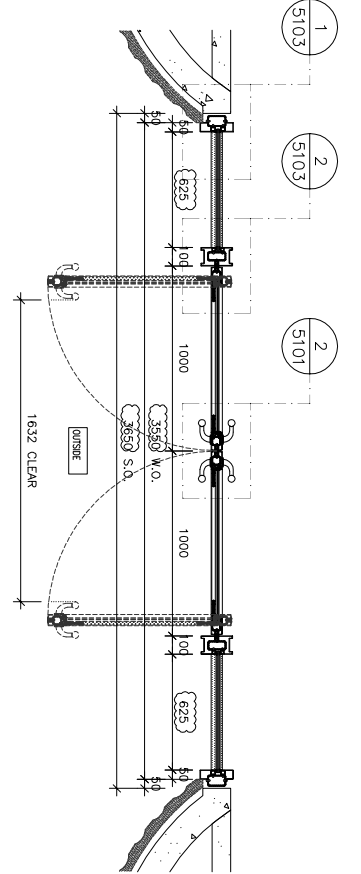

PART PLAN B

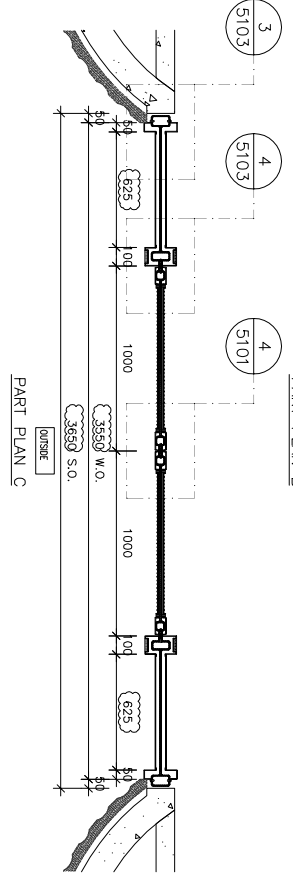

PART PLAN C

FLOOR	LOCATION	GLASS WALL MARK	QTY
G	SHUTTLE LIFT LOBBY	S001/G	1

BO. REF :  
 CLIENT :  
 ARCHITECT :  
**AGC DESIGN LTD**  
 11/F, THE HONG KONG AIRPORT AUTHORITY HEADQUARTERS, 1  
 AIRPORT AVENUE, HONG KONG  
 MAIN CONTRACTOR :  
**Gammon**  
 STRUCTURAL ENGINEER :  
**ARUP**  
 FACADE CONSULTANT :  
**MEINHARDT**






NOTE:  
 1. ALL DIMENSIONS ARE IN MM.  
 2. ALL ELEVATIONS ARE VIEWED FROM OUTSIDE.  
 3. ALL DIMENSIONS TO BE VERIFIED ON SITE BEFORE FABRICATION.  
 LEGEND:  
 X1 --- DETAIL MARK NO.  
 X001 --- REFER SHEET NO.

1. F.F.L. --- FINISHED FLOOR LEVEL  
 2. S.F.L. --- STRUCTURAL FLOOR LEVEL  
 3. R --- REVERSED DETAIL  
 4. 12T --- 12mm THK. TEMPERED GLASS  
 5. 10T --- 10mm THK. REVERSED GLASS

NO.	DATE	REVISION
1	16/10/2011	REVISION SUBJECT TO ARCH. COMMENT
2	23/09/2011	REVISION SUBJECT TO ARCH. COMMENT
3	23/09/2011	REVISION SUBJECT TO ARCH. COMMENT
4	27/11/2011	REVISION SUBJECT TO ARCH. COMMENT
5	10/11/2011	REVISION SUBJECT TO ARCH. COMMENT

JOB NO. : J-852  
 PROJECT : PROPOSED DEVELOPMENT AT KOWLOON INLAND.  
 LOT Nos. 6035R.P., 6036R.P., 6037R.P., 6038R.P., AND LOT No. 6005  
 TITLE : ELEVATION & PART PLAN FOR GLASS WALL(G/F)

DATE : 25-Mar-21 SCALE : 1:40  
 DRAWN BY : CJM CHECKED BY : DW  
**美特铝业有限公司**  
**MIDI ALUMINIUM FABRICATOR LTD.**  
 Units 6-8, Sunny Industrial Centre, 1/F  
 610 Chee Kwo Ling Road, Kowloon  
 Tel: 2498211-4 Fax: 8527272166  
 DMC NO. : JB52-PCW-4500 REV : E

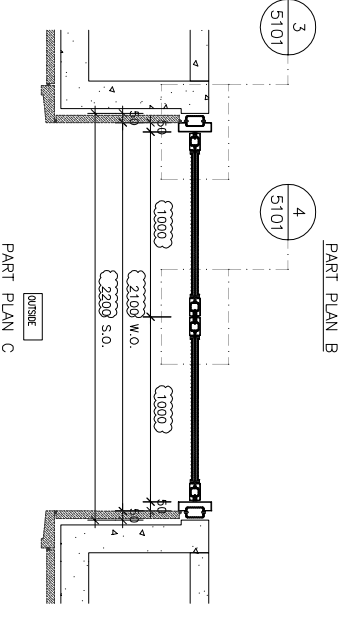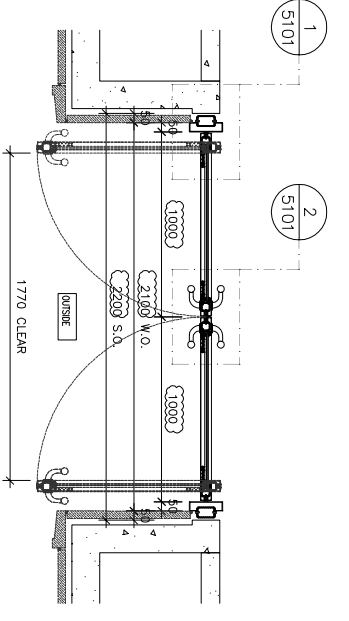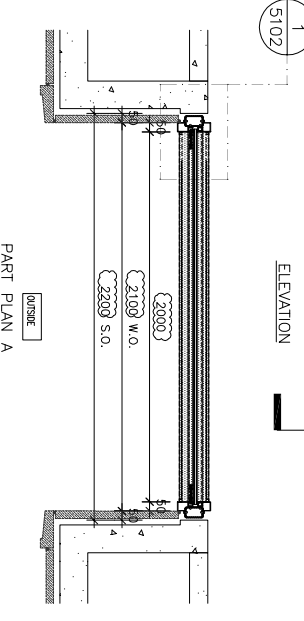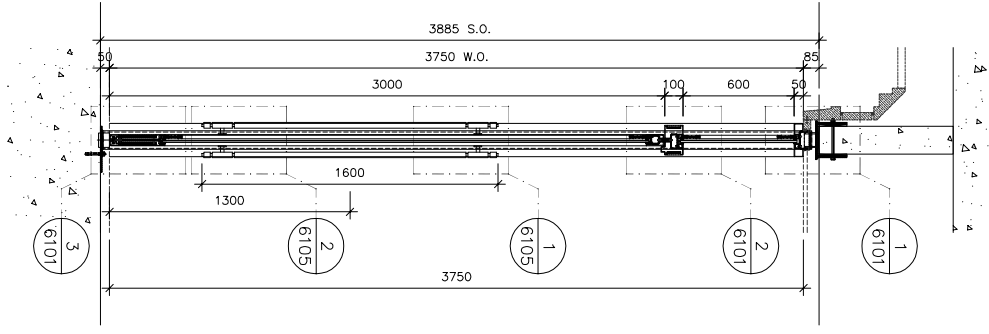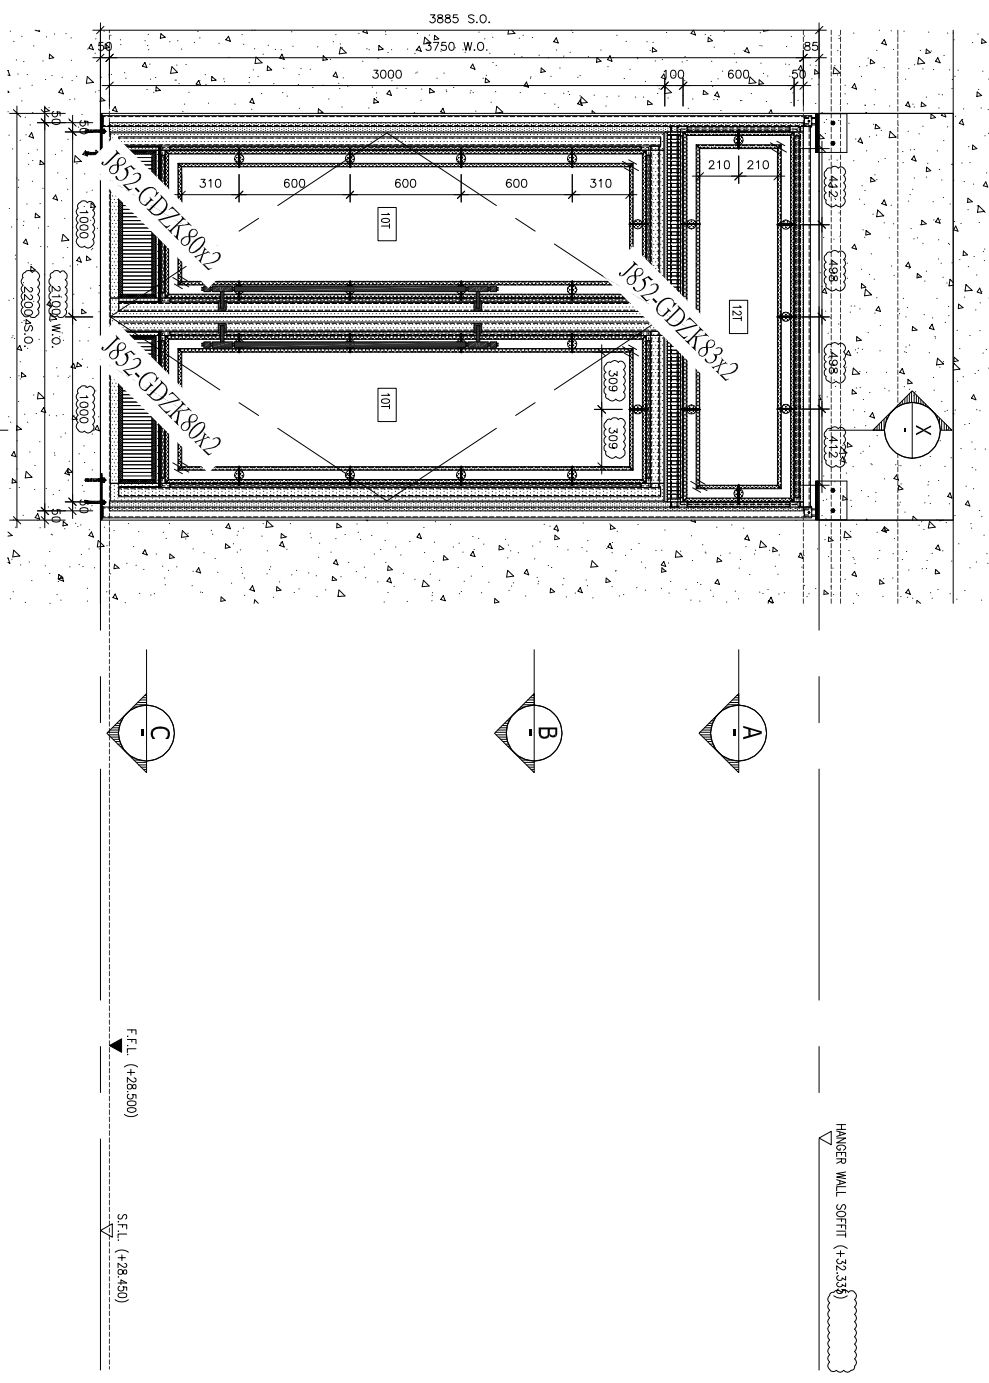



BO. REF. :	
CLIENT :	
ARCHITECT :	AGC DESIGN LTD.
MAIN CONTRACTOR :	GAMMON
STRUCTURAL ENGINEER :	ARUP
FAÇADE CONSULTANT :	MEINHARDT
NOTE :	<ol style="list-style-type: none"> <li>ALL DIMENSIONS ARE IN MM.</li> <li>ALL ELEVATIONS ARE VIEWED FROM OUTSIDE.</li> <li>ALL DIMENSIONS TO BE VERIFIED ON SITE BEFORE FABRICATION.</li> </ol>
LEGEND :	<p>X1 --- DETAIL WORK NO.</p> <p>X001 --- REFER SHEET NO.</p> <p>1. F.F.L. --- FINISHED FLOOR LEVEL</p> <p>2. S.F.L. --- STRUCTURAL FLOOR LEVEL</p> <p>3. <math>\overleftarrow{R}</math> --- REVERSED DETAIL</p> <p>4. 12T --- 12mm THK. TEMPERED GLASS</p> <p>5. 10T --- 10mm THK. REVERSED GLASS</p>
JOB NO. :	J-852
PROJECT :	PROPOSED DEVELOPMENT AT KOWLOON INLAND, LOT Nos. 6035R.P., 6036R.P., 6037R.P., 6038R.P., AND LOT No. 6005
TITLE :	ELEVATION & PART PLAN FOR GLASS WALL(G/F)
DATE :	25-Mar-21
SCALE :	1:40
DRAWN BY :	CJM
CHECKED BY :	DW
Units 6-8, Sunny Industrial Centre, 1/F	
610 Chee Kwo Ling Road, Kowloon	
Tel: 2498211-4 Fax: 8527272966	
DWG NO. :	JB52-PCW-4501
REV. :	E

NO.	DATE	REVISION
1	18/09/2021	REGION SELECT TO ARCH. COMMENT
2	23/09/2021	REGION SELECT TO ARCH. COMMENT
3	28/09/2021	REGION SELECT TO ARCH. COMMENT
4	27/11/2021	REGION SELECT TO ARCH. COMMENT
5	10/12/2021	REGION SELECT TO ARCH. COMMENT

FLOOR	LOCATION	GLASS WALL MARK	QTY
G	TOWER 1 LIFT LOBBY	T101/G	1

**美特铝质有限公司**  
 MIDI ALUMINIUM FABRICATOR LTD.  
 Units 6-8, Sunny Industrial Centre, 1/F  
 610 Chee Kwo Ling Road, Kowloon  
 Tel: 2498211-4 Fax: 8527272966  
 DWG NO. : JB52-PCW-4501



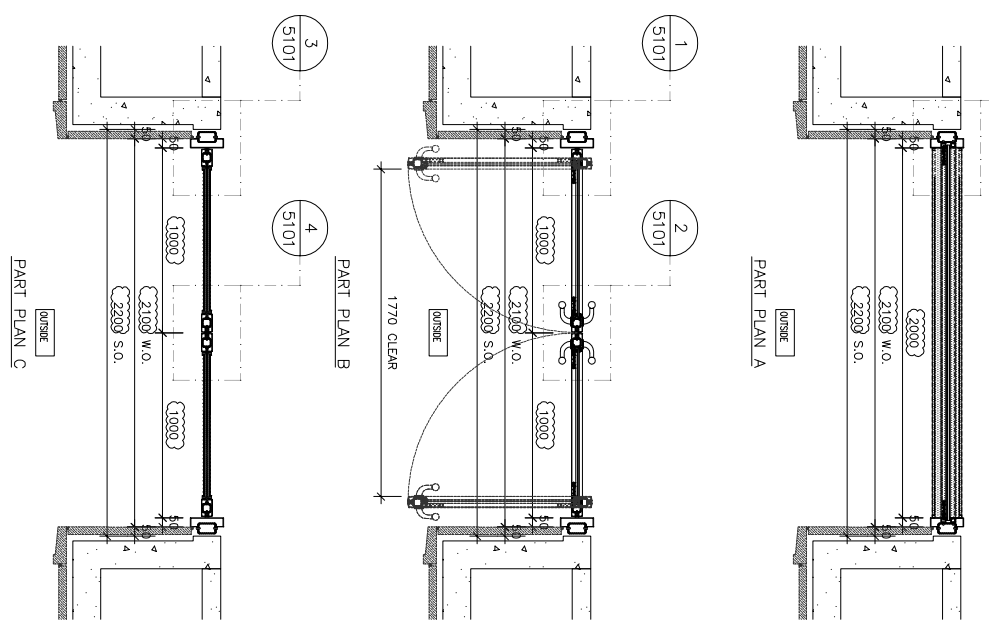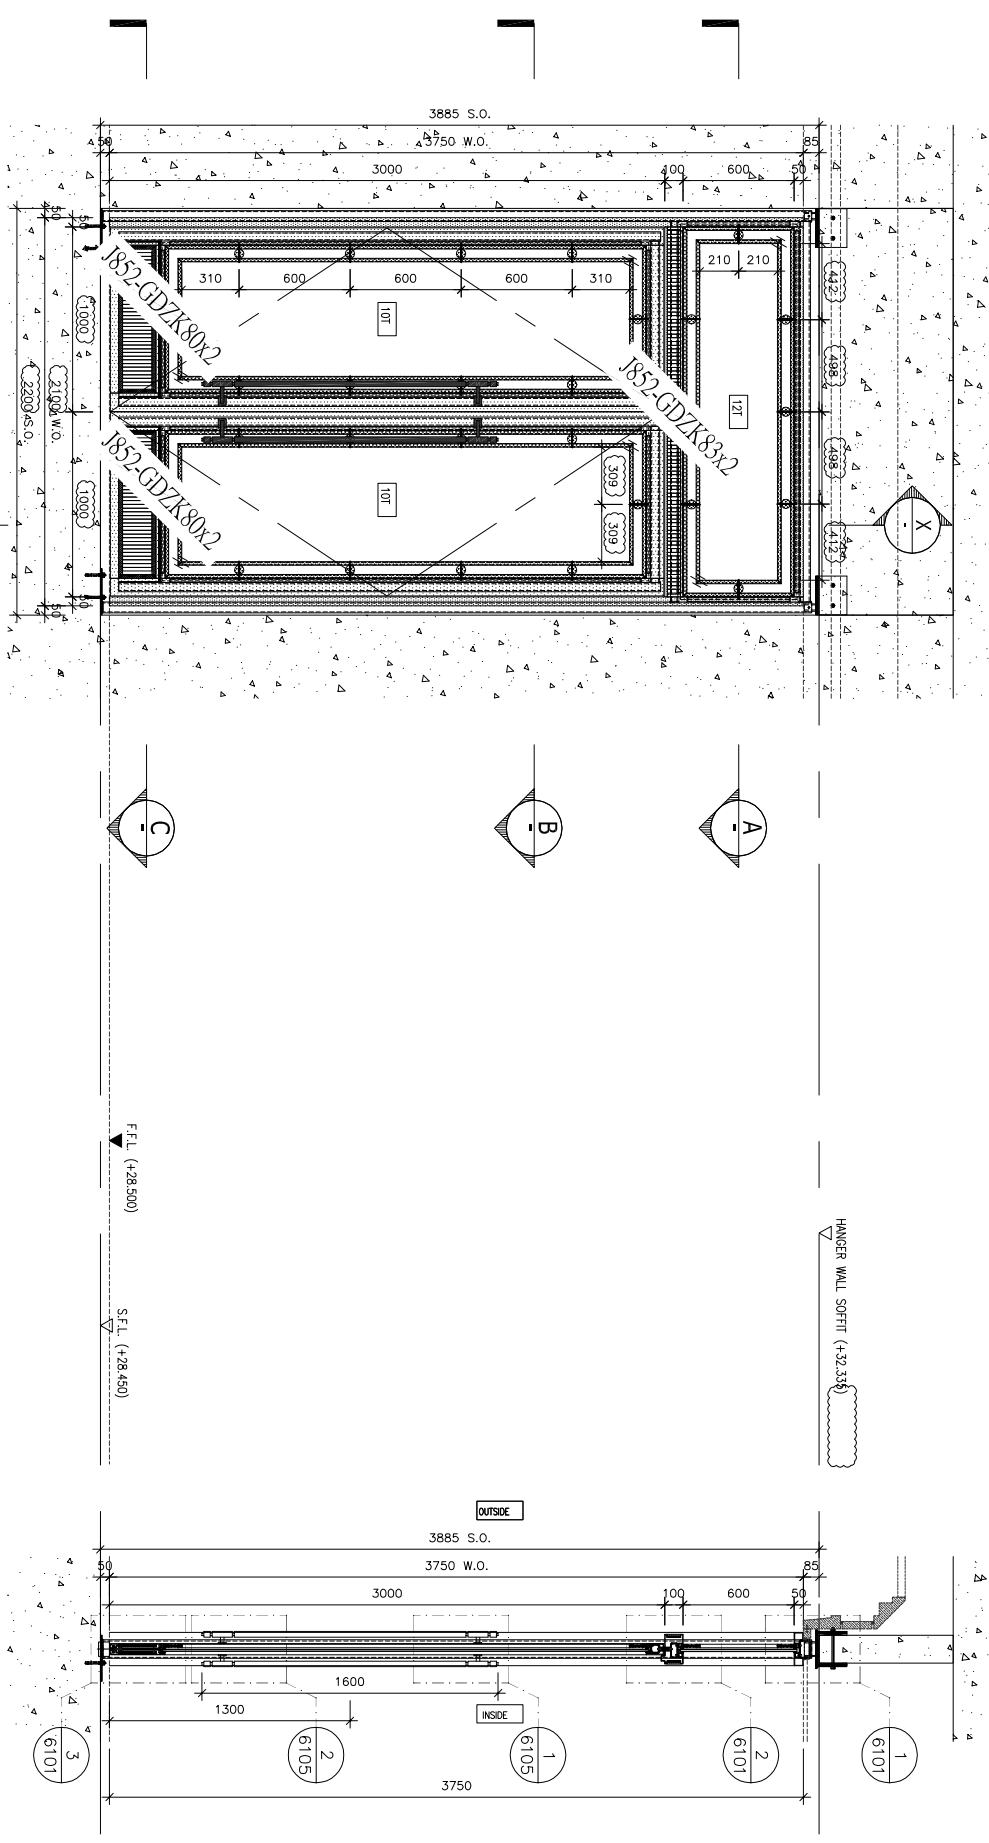

F.F.L. (+28.500)  
S.F.L. (+28.450)

SECTION X

NOTE:  
1. ALL DIMENSIONS ARE IN MM.  
2. ALL ELEVATIONS ARE VIEWED FROM OUTSIDE.  
3. ALL DIMENSIONS TO BE VERIFIED ON SITE BEFORE FABRICATION.

LEGEND:

- X1 --- DETAIL WORK NO.
- X001 --- REFER SHEET NO.
- 1. F.F.L. --- FINISHED FLOOR LEVEL
- 2. S.F.L. --- STRUCTURAL FLOOR LEVEL
- 3. --- REVERSED DETAIL
- 4. 12T --- 12mm THK. TEMPERED GLASS
- 5. 10T --- 10mm THK. TEMPERED GLASS

NO.	DATE	REVISION
1	18/10/2011	REVISION SUBJECT TO ARCH. COMMENT
2	23/09/2011	REVISION SUBJECT TO ARCH. COMMENT
3	23/09/2011	REVISION SUBJECT TO ARCH. COMMENT
4	10/11/2011	REVISION SUBJECT TO ARCH. COMMENT

JOB NO. : J-852  
PROJECT : PROPOSED DEVELOPMENT AT KOWLOON INLAND, LOT Nos. 6035R.P., 6036R.P., 6037R.P., 6038R.P., AND LOT No. 6005  
TITLE : ELEVATION & PART PLAN FOR GLASS WALL(G/F)






DATE : 25-Mar-21  
SCALE : 1:40  
DRAWN BY : CJM  
CHECKED BY : DW

Unit 6-8, Sunny Industrial Centre, 1/F  
610 Chee Kwo Ling Road, Kowloon  
Tel: 2498211-4 Fax: 8527272966  
DWC NO. : JB52-PCW-4503

**美特铝业有限公司**  
MIDI ALUMINIUM FABRICATOR LTD.

FLOOR	LOCATION	GLASS WALL MARK	QTY
G	TOWER 2 LIFT LOBBY	T201/G	1

BO. REF. :  
CLIENT :  
ARCHITECT : **AGC DESIGN LTD.**  
MAIN CONTRACTOR :  
STRUCTURAL ENGINEER : **GAMMON**  
FAÇADE CONSULTANT : **ARUP** and **MEINHARDT**

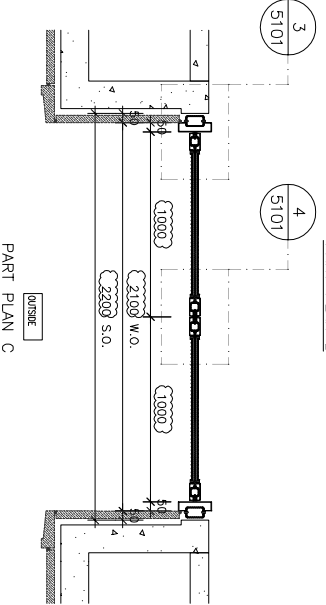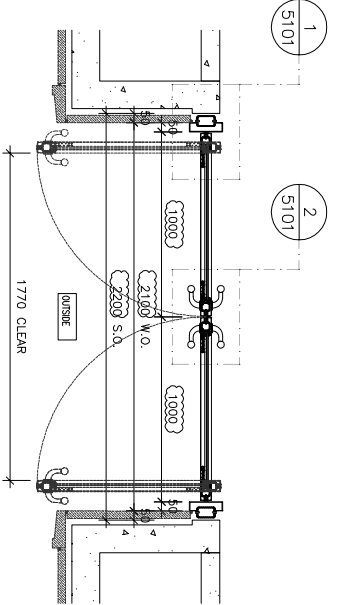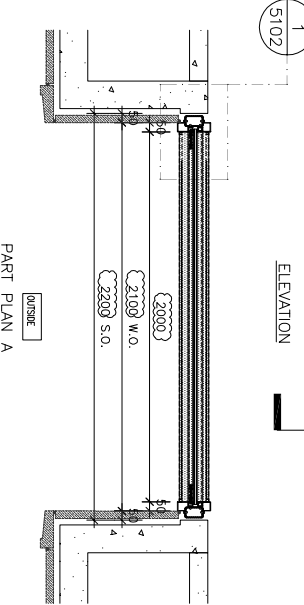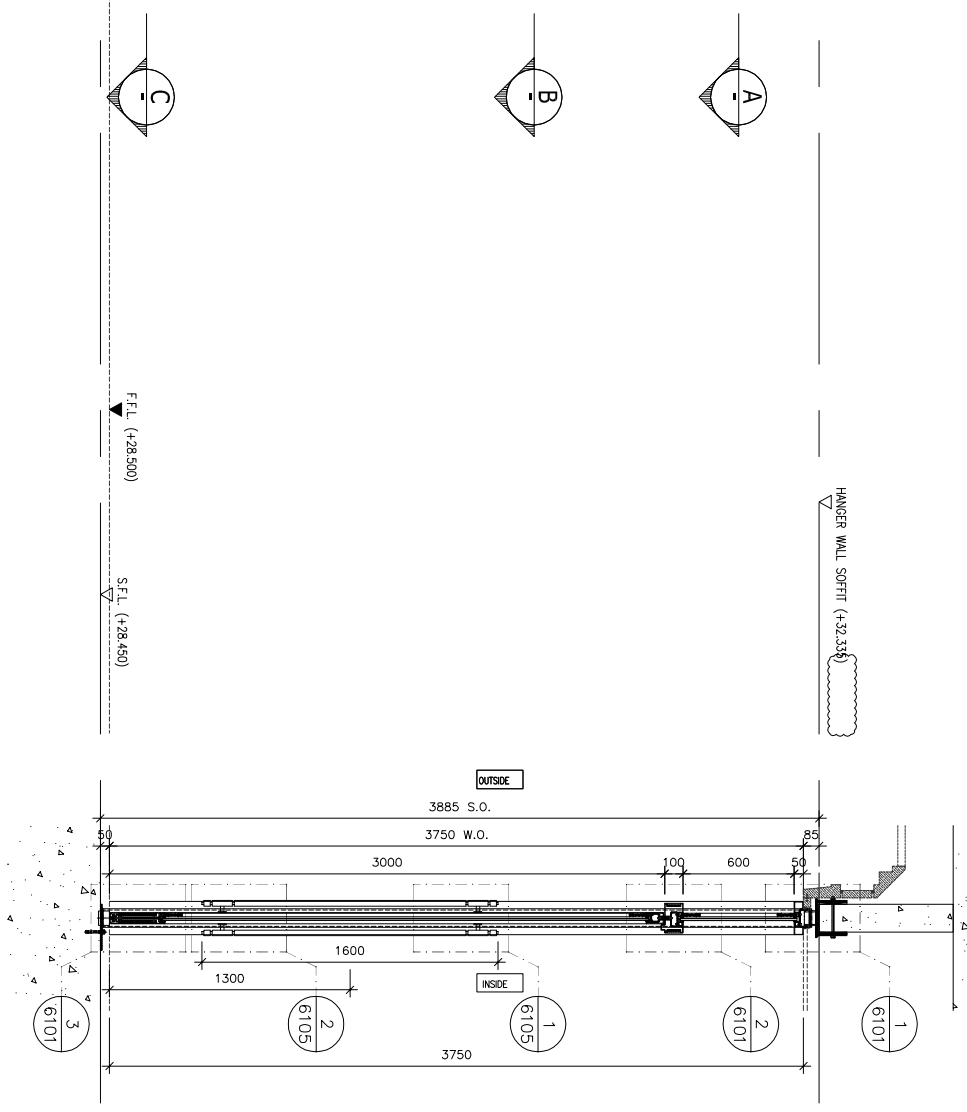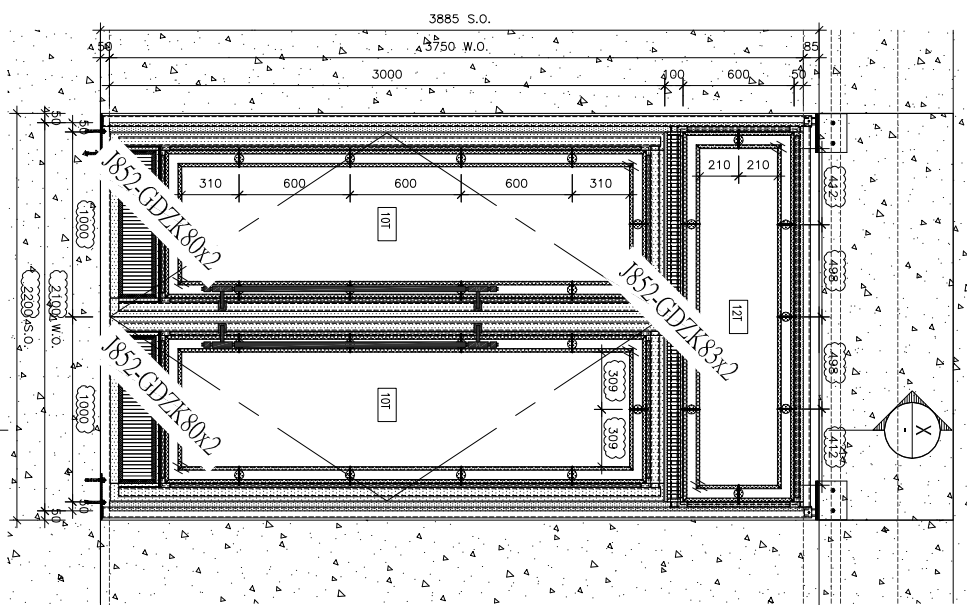

FLOOR	LOCATION	GLASS WALL MARK	QTY
G	TOWER 2 LIFT LOBBY	T202/G	1

DATE	25-Mar-21	SCALE	1:40
DRAWN BY	CJM	CHECKED BY	DW
<p><b>美特铝业有限公司</b> MIDI ALUMINIUM FABRICATOR LTD. Units 6-8, Sunny Industrial Centre, 1/F 610 Chee Kwe Ling Road, Kowloon Tel: 2498211-4 Fax: 8522727266</p>			
<p><b>AGC DESIGN LTD</b> AGC DESIGN LTD 11/F, 110 Des Voeux Road East, Hong Kong</p>			
<p><b>GAMMON</b> GAMMON 11/F, 110 Des Voeux Road East, Hong Kong</p>			
<p><b>ARUP</b> ARUP 11/F, 110 Des Voeux Road East, Hong Kong</p>			
<p><b>MEINHARDT</b> MEINHARDT 11/F, 110 Des Voeux Road East, Hong Kong</p>			

NO.	DATE	REVISION
1	18/09/2021	REVISION SUBJECT TO ARCH COMMENT
2	23/09/2021	REVISION SUBJECT TO ARCH COMMENT
3	28/09/2021	REVISION SUBJECT TO ARCH COMMENT
4	27/11/2021	REVISION SUBJECT TO ARCH COMMENT
5	10/12/2021	REVISION SUBJECT TO ARCH COMMENT

JOB NO. : J-852

PROJECT : PROPOSED DEVELOPMENT AT KOWLOON INLAND, LOT Nos. 6035R.P., 6036R.P., 6037R.P., 6038R.P., AND LOT No. 6005

TITLE : ELEVATION & PART PLAN FOR GLASS WALL(G/F)

DATE : 25-Mar-21

SCALE : 1:40

DRAWN BY : CJM

CHECKED BY : DW

DATE : 18/09/2021

REVISION SUBJECT TO ARCH COMMENT

DATE : 23/09/2021

REVISION SUBJECT TO ARCH COMMENT

DATE : 27/11/2021

REVISION SUBJECT TO ARCH COMMENT

DATE : 10/12/2021

REVISION SUBJECT TO ARCH COMMENT

CLIENT :

ARCHITECT : **AGC DESIGN LTD**

MAIN CONTRACTOR : **GAMMON**

STRUCTURAL ENGINEER : **ARUP**

FAÇADE CONSULTANT : **MEINHARDT**

NOTE :



- ALL DIMENSIONS ARE IN MM.
- ALL ELEVATIONS ARE VIEWED FROM OUTSIDE.
- ALL DIMENSIONS TO BE VERIFIED ON SITE BEFORE FABRICATION.

LEGEND :

X1 --- DETAIL MARK NO.

X001 --- REFER SHEET NO.

- F.F.L. --- FINISHED FLOOR LEVEL
- S.F.L. --- STRUCTURAL FLOOR LEVEL
- 12T --- REVERSED DETAIL
- 12T --- 12mm THK. TEMPERED GLASS
- 10T --- 10mm THK. TEMPERED GLASS

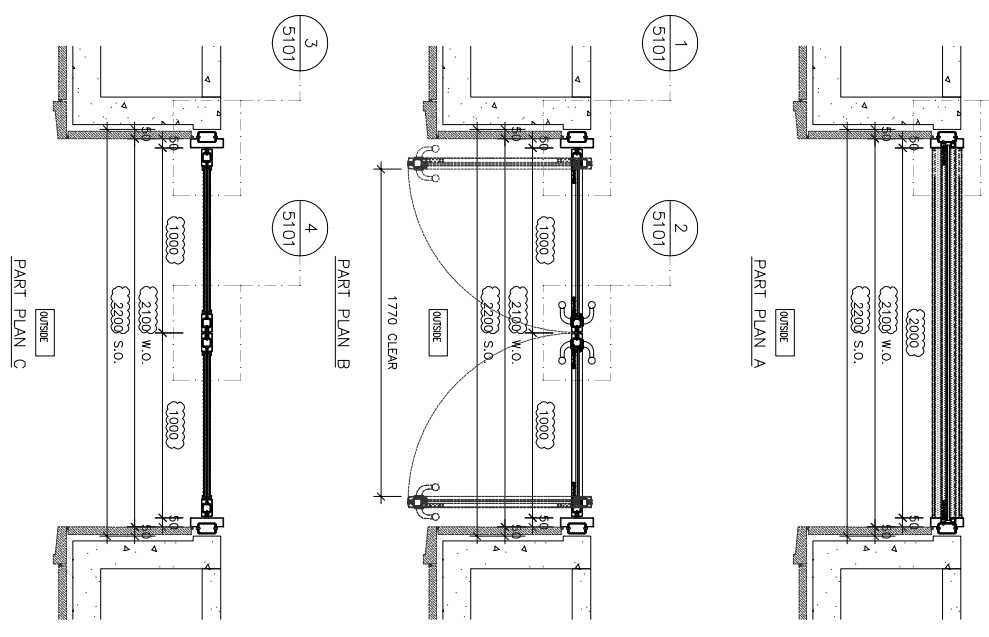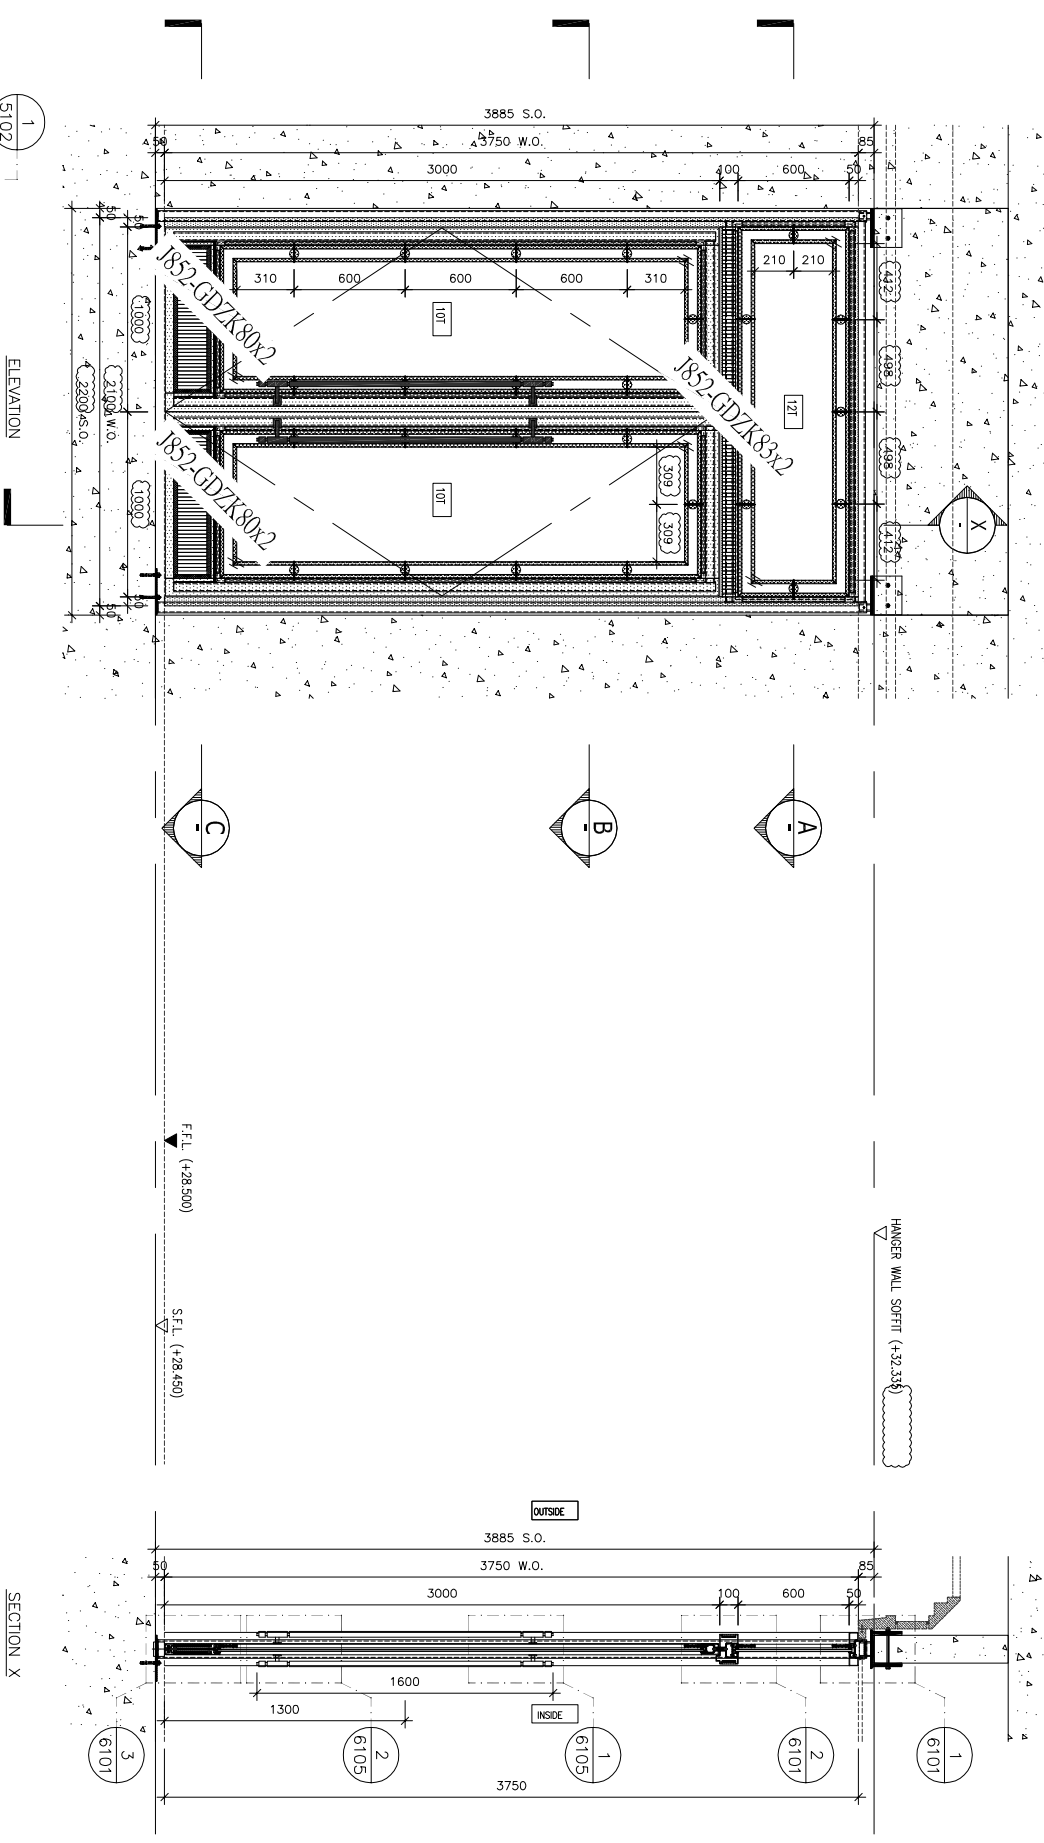

NO.	DATE	REVISION	REVISION SUBJECT TO ARCH. COMMENT	DATE	REVISION
B	16/01/2021		REVISION SUBJECT TO ARCH. COMMENT		
A	23/09/2021		REVISION SUBJECT TO ARCH. COMMENT		

BO. REF. :  
 CLIENT :  
 ARCHITECT :  
 AGC DESIGN LTD  
 MAIN CONTRACTOR :  
 STRUCTURAL ENGINEER :  
 Gammon  
 FACADE CONSULTANT :  
 ARUP  
 MEIN-HARDT

NOTE :  
 1. ALL DIMENSIONS ARE IN mm.  
 2. ALL ELEVATIONS ARE VIEWED FROM OUTSIDE.  
 3. ALL DIMENSIONS TO BE VERIFIED ON SITE BEFORE FABRICATION.

LEGEND :  
 X1 --- DETAIL MARK NO.  
 X001 --- REFER SHEET NO.



1. F.F.L. --- FINISHED FLOOR LEVEL  
 2. S.F.L. --- STRUCTURAL FLOOR LEVEL  
 3. (R) --- REVERSED DETAIL  
 4. (12T) --- 12mm THK. TEMPERED GLASS  
 5. (10T) --- 10mm THK. TEMPERED GLASS

JOB NO. : J-852  
 PROJECT : PROPOSED DEVELOPMENT AT KOWLOON INLAND, LOT Nos. 6035R.P., 6036R.P., 6037R.P., 6038R.P., AND LOT No. 6005  
 TITLE : ELEVATION & PART PLAN FOR GLASS WALL(G/F)

DATE : 25-Mar-20 SCALE : 1:40  
 DRAWN BY : CJM CHECKED BY : DW


Unit 6-8, Sunny Industrial Centre, 1/F  
 610 Chee Kwo Ling Road, Kowloon  
 Tel: 2498211-4 Fax: 8522727566  
 MIDDI ALUMINIUM FABRICATOR LTD.  
 DMC NO. : JB52-PCW-4505 REV. : B

FLOOR	LOCATION	GLASS WALL MARK	QTY
G	TOWER 3 LIFT LOBBY	T301/G	1

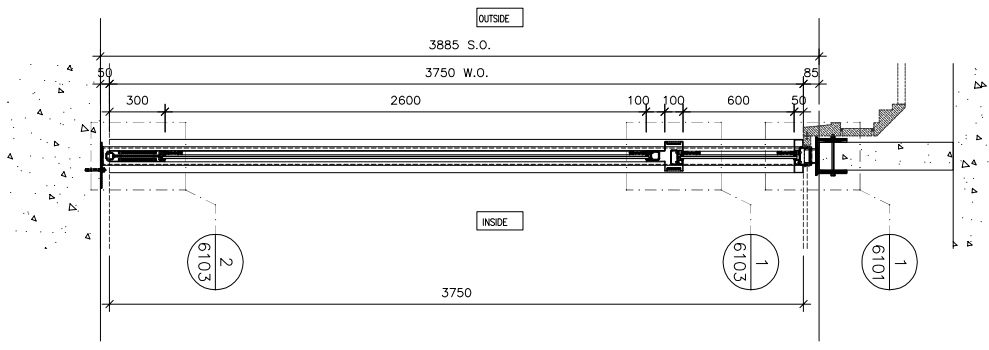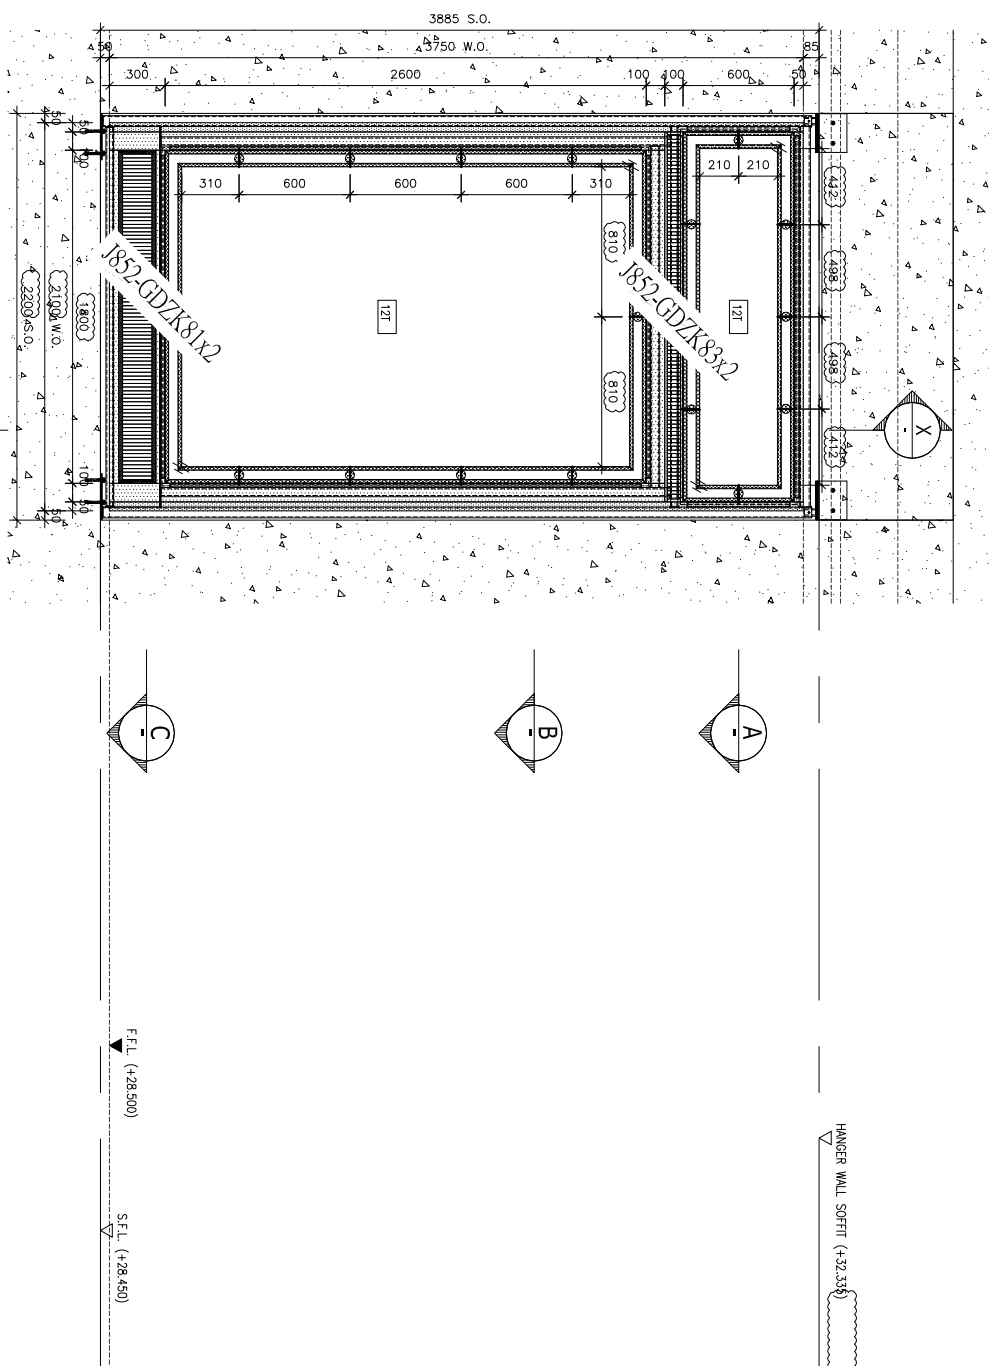


ELEVATION


SECTION X

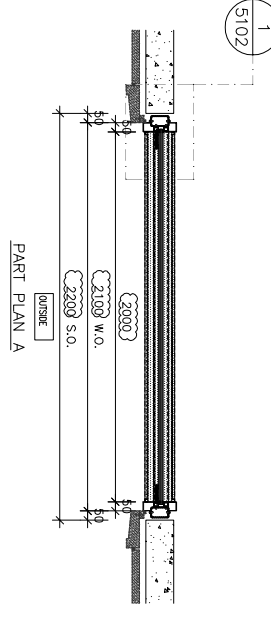

PART PLAN A

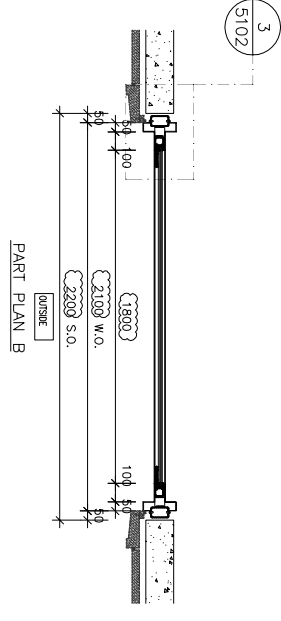

PART PLAN B

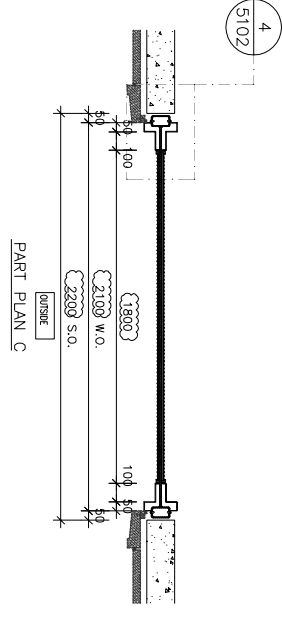

PART PLAN C

BO. REF. :

CLIENT :

ARCHITECT :

AGC DESIGN LTD

MAIN CONTRACTOR :

Gammon

STRUCTURAL ENGINEER :

ARUP

FAÇADE CONSULTANT :

MEIN-HARDT

NOTE :  
 1. ALL DIMENSIONS ARE IN mm.  
 2. ALL ELEVATIONS ARE VIEWED FROM OUTSIDE.  
 3. ALL DIMENSIONS TO BE VERIFIED ON SITE BEFORE FABRICATION.

LEGEND :

X1 --- DETAIL MARK NO.  
 X001 --- REFER SHEET NO.

1. F.F.L. --- FINISHED FLOOR LEVEL  
 2. S.F.L. --- STRUCTURAL FLOOR LEVEL  
 3. 18 --- REVERSED DETAIL  
 4. 12T --- 12mm THK. TEMPERED GLASS  
 5. 10T --- 10mm THK. REVERSED GLASS

NO.	DATE	REVISION
1	18/10/2011	REVISION SUBJECT TO ARCH. COMMENT
2	23/09/2011	REVISION SUBJECT TO ARCH. COMMENT
3	21/07/2011	REVISION SUBJECT TO ARCH. COMMENT
4	17/11/2011	REVISION SUBJECT TO ARCH. COMMENT
5		REVISION






JOB NO. : J-852  
 PROJECT : PROPOSED DEVELOPMENT AT KOWLOON INLAND, LOT Nos., 60356P., 60366P., 60376P., 60386P., AND LOT No., 6005

TITLE : ELEVATION & PART PLAN FOR GLASS WALL(G/F)

DATE : 25-Mar-21  
 SCALE : 1:40  
 DRAWN BY : CJM  
 CHECKED BY : DW

美特鋁質有限公司  
 MIDT ALUMINIUM FABRICATOR LTD.  
 Units 6-8, Sunny Industrial Centre, 1/F  
 610 Chee Kwo Ling Road, Kowloon  
 Tel: 2498211-4 Fax: 8527272166  
 DMC NO. : JB52-PCW-4506  
 REV : E

FLOOR	LOCATION	GLASS WALL MARK	QTY
G	TOWER 3 LIFT LOBBY	T302/G	1

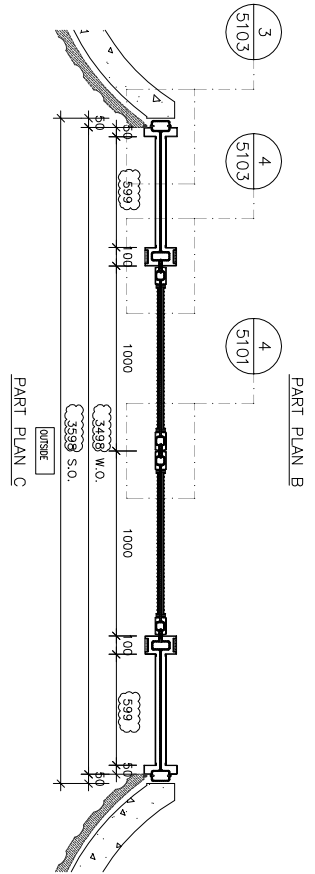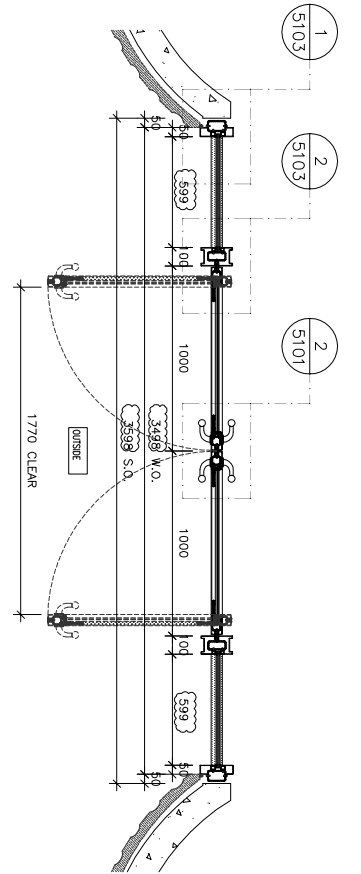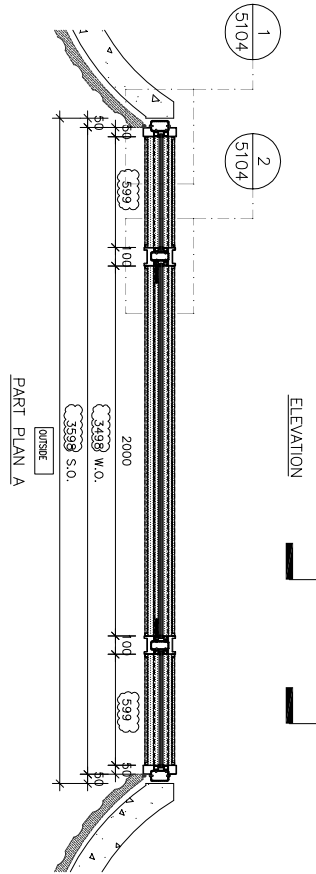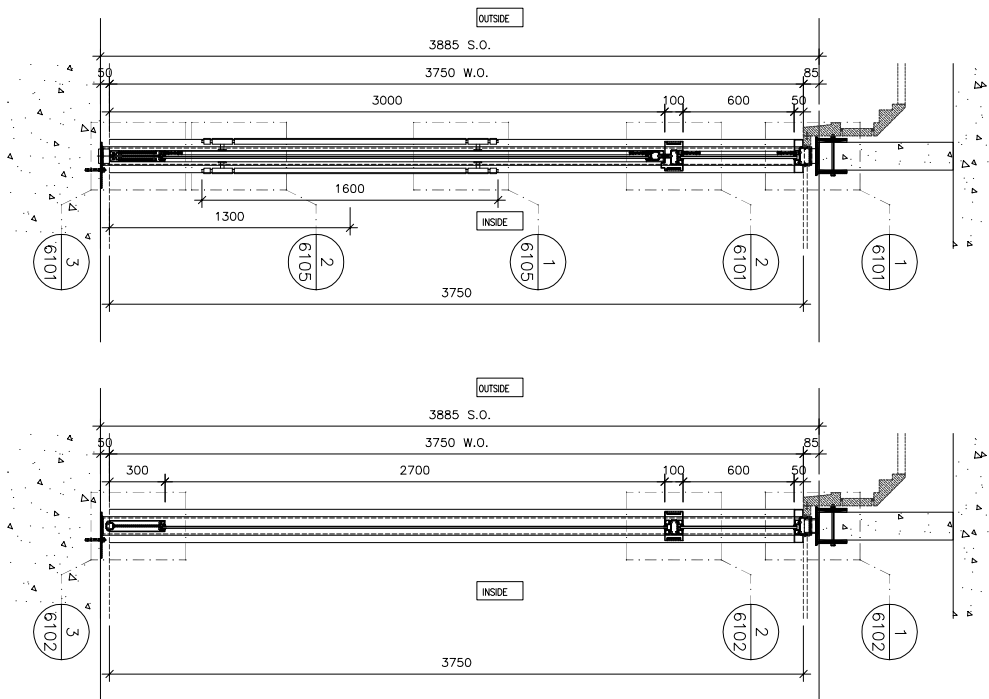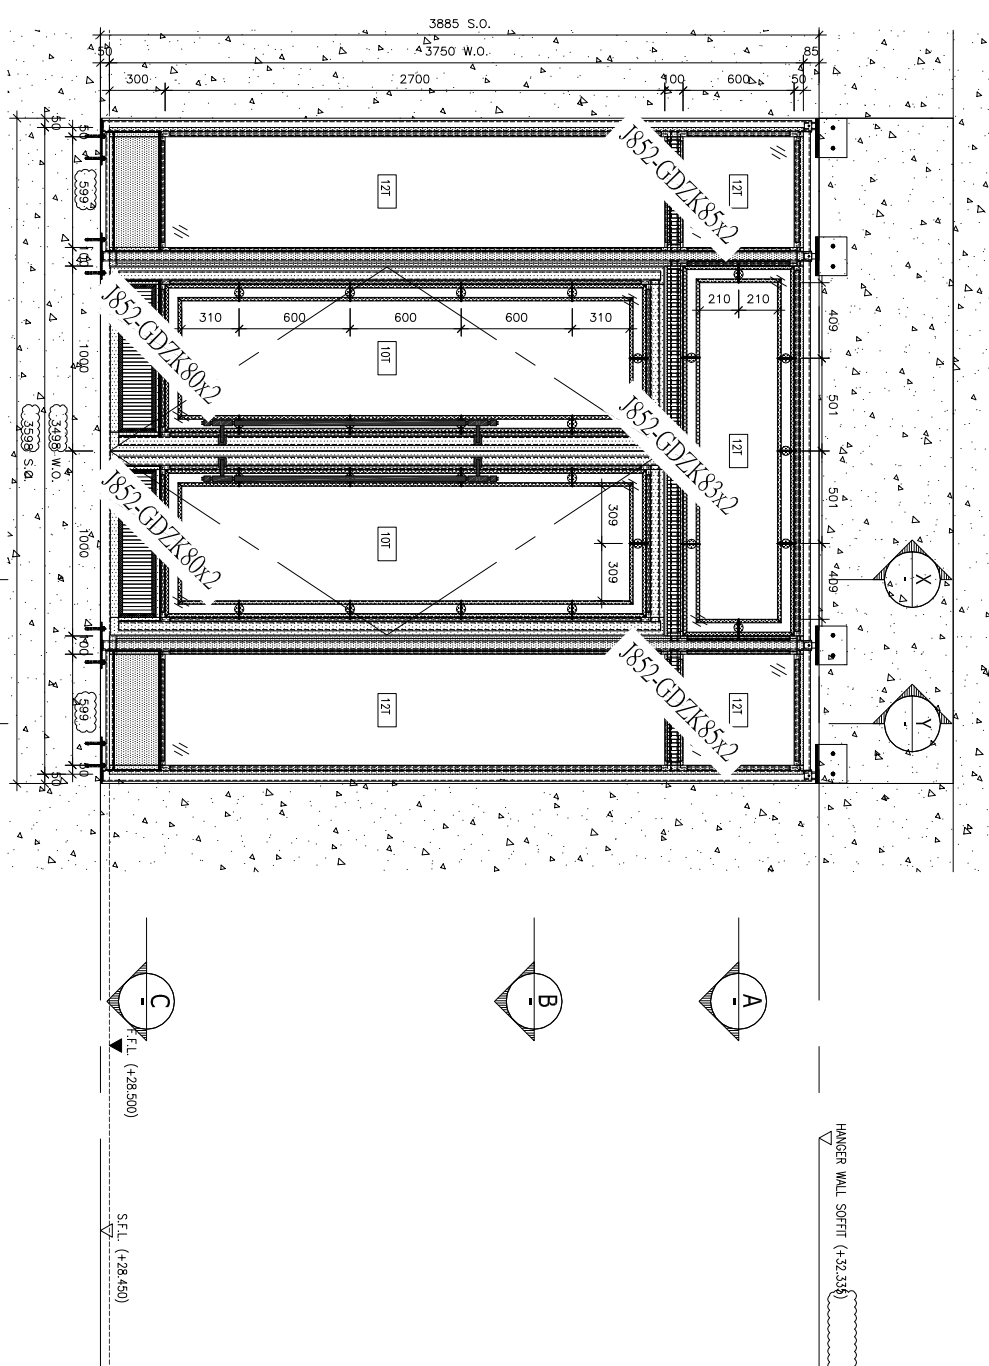

BO. REF. :  
 CLIENT :  
 ARCHITECT :  
**AGC DESIGN LTD**  
 10/F, 100, Des Voeux Road West, Hong Kong  
 MAIN CONTRACTOR :  
**Gammon**  
 STRUCTURAL ENGINEER :  
**ARUP**  
 FIGURE CONSULTANT :  
**MEINHARDT**








NOTE :  
 1. ALL DIMENSIONS ARE IN mm.  
 2. ALL ELEVATIONS ARE VIEWED FROM OUTSIDE.  
 3. ALL DIMENSIONS TO BE VERIFIED ON SITE BEFORE FABRICATION.  
 LEGEND :  
 X1 --- DETAIL MARK NO.  
 X001 --- REFER SHEET NO.

1.	16/9/2011	REVISION SUBJECT TO ARCH. COMMENT	MC
2.	23/9/2011	REVISION SUBJECT TO ARCH. COMMENT	MC
3.	23/9/2011	REVISION SUBJECT TO ARCH. COMMENT	MC
4.	10/7/2011	REVISION SUBJECT TO ARCH. COMMENT	MC
5.			

JOB NO. : J-852  
 PROJECT : PROPOSED DEVELOPMENT AT KOWLOON INLAND, LOT Nos. 6035R.P., 6036R.P., 6037R.P., 6038R.P., AND LOT No. 6005  
 TITLE : ELEVATION & PART PLAN FOR GLASS WALL(G/F)

DATE : 25-Mar-21 SCALE : 1:40  
 DRAWN BY : CJM CHECKED BY : DW  
**美特铝业有限公司**  
**MIDI ALUMINIUM FABRICATOR LTD.**  
 Units 6-8, Sunny Industrial Centre, 1/F  
 610 Chee Kwo Ling Road, Kowloon  
 Tel: 2498211-4 Fax: 8522727266  
 DWG NO. : JB52-PCW-4507 REV. : E

FLOOR	LOCATION	GLASS WALL MARK	QTY
G	CLUBHOUSE LOBBY	CH01/G	1

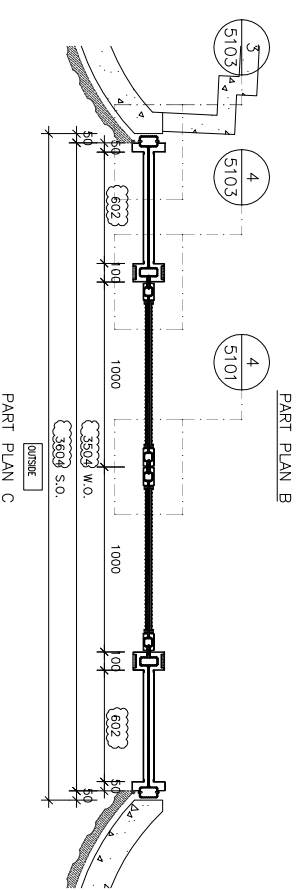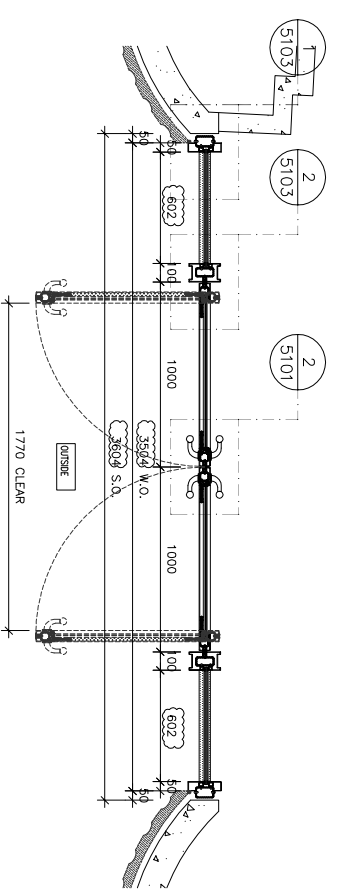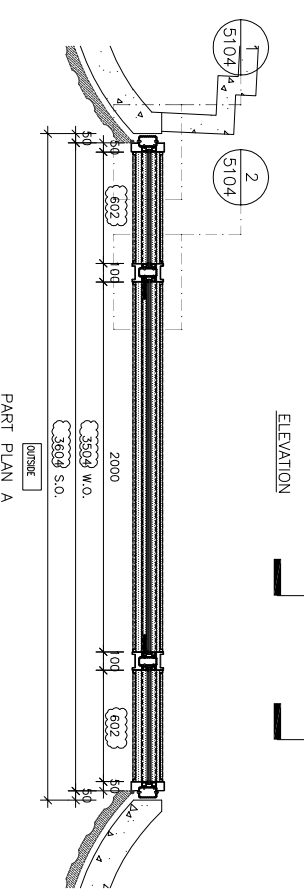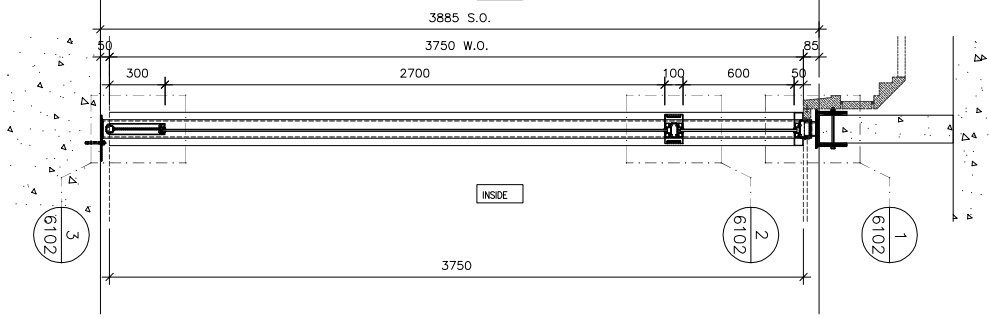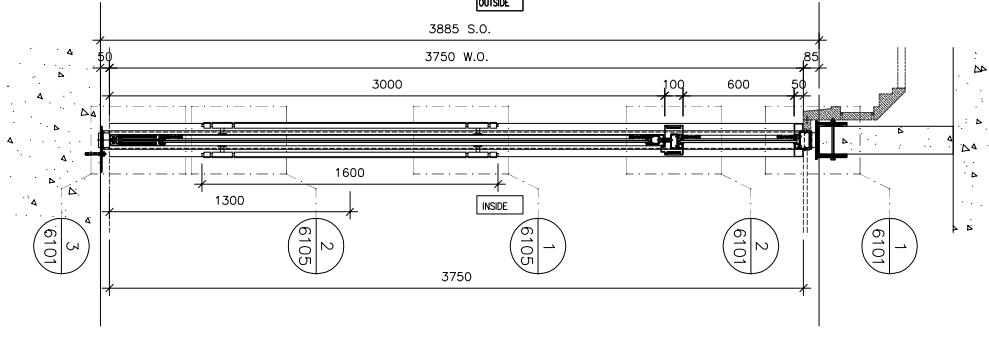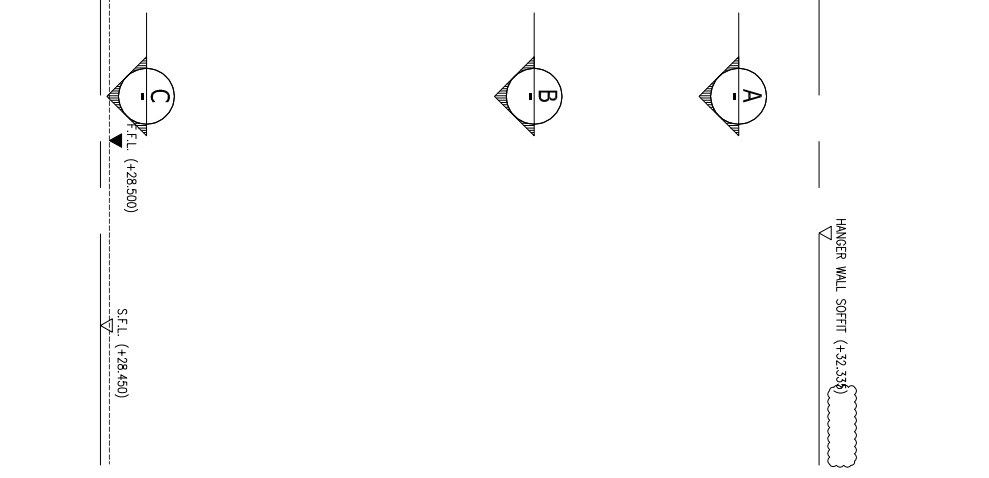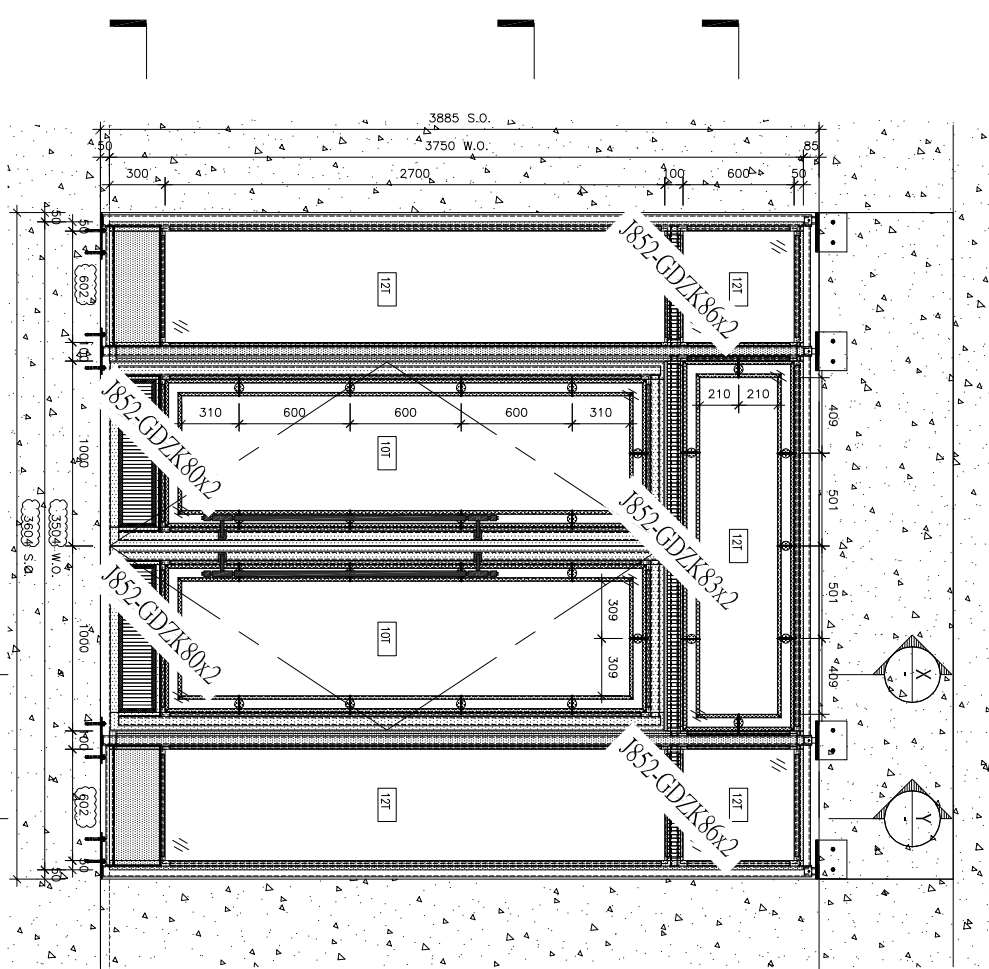

FLOOR	LOCATION	GLASS WALL MARK	QTY
G	CLUBHOUSE SITTING AREA	CH02/G	1

BO. REF. :  
 CLIENT :  
 ARCHITECT :  
 AGC DESIGN LTD  
 11/F, THE HONG KONG BANK BUILDING, 111 HONG KONG STREET, HONG KONG

MAIN CONTRACTOR :  
 STRUCTURAL ENGINEER :  
**GAMMON**

FIGURE CONSULTANT:  
**ARUP**  
**MEINHARDT**





NOTE:  
 1. ALL DIMENSIONS ARE IN MM.  
 2. ALL ELEVATIONS ARE VIEWED FROM OUTSIDE.  
 3. ALL DIMENSIONS TO BE VERIFIED ON SITE BEFORE FABRICATION.

LEGEND:  
 X1 --- DETAIL MARK NO.  
 X001 --- REFER SHEET NO.  
 1. F.F.L. --- FINISHED FLOOR LEVEL  
 2. S.F.L. --- STRUCTURAL FLOOR LEVEL  
 3. 12T --- REVERSED DETAIL  
 4. 12T --- 12mm THK. TEMPERED GLASS  
 5. 10T --- 10mm THK. REVERSED GLASS

NO.	DATE	REVISION
1	16/10/2011	REVISION SUBJECT TO ARCH. COMMENT
2	23/09/2011	REVISION SUBJECT TO ARCH. COMMENT
3	23/09/2011	REVISION SUBJECT TO ARCH. COMMENT
4	27/11/2011	REVISION SUBJECT TO ARCH. COMMENT
5	10/11/2011	REVISION SUBJECT TO ARCH. COMMENT

JOB NO. : J-852  
 PROJECT : PROPOSED DEVELOPMENT AT KOWLOON INLAND, LOT Nos. 6035R.P., 6036R.P., 6037R.P., 6038R.P., AND LOT No. 6005

DATE : 25-Mar-21  
 SCALE : 1:40  
 DRAWN BY : CJM  
 CHECKED BY : DW  
**美特铝业有限公司**  
**MIDI ALUMINIUM FABRICATOR LTD.**  
 Units 6-8, Sunny Industrial Centre, 1/F  
 610 Chee Kwo Ling Road, Kowloon  
 Tel: 2498211-4 Fax: 8522727266  
 DMC NO. : J852-PCW-4508  
 REV : E

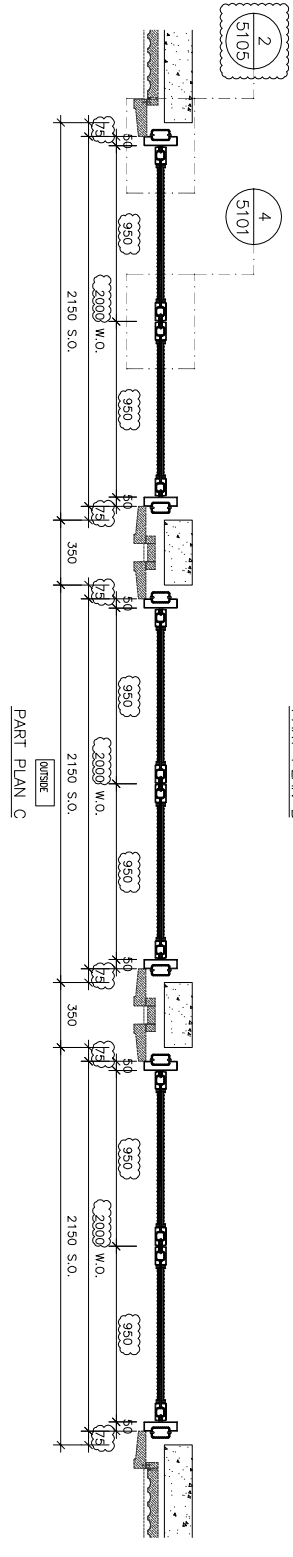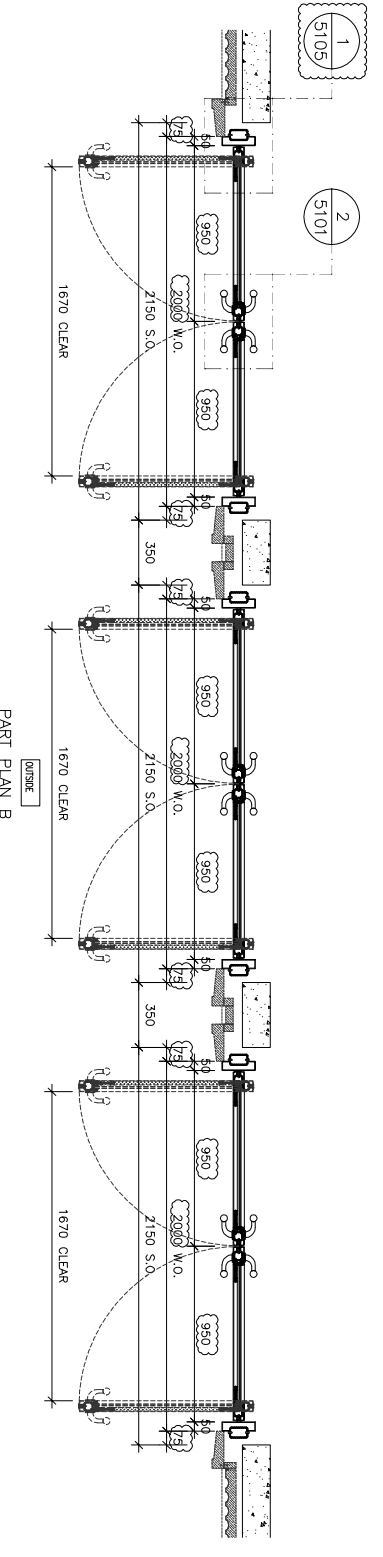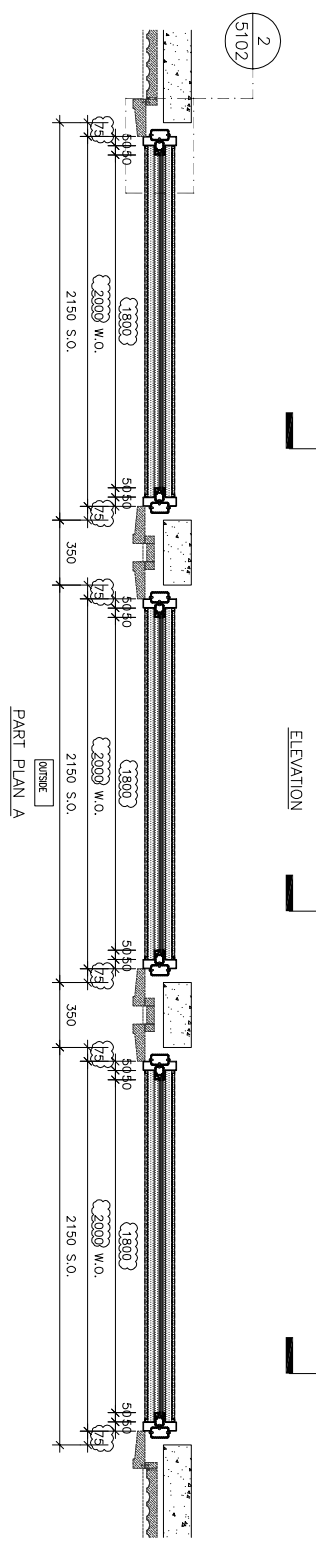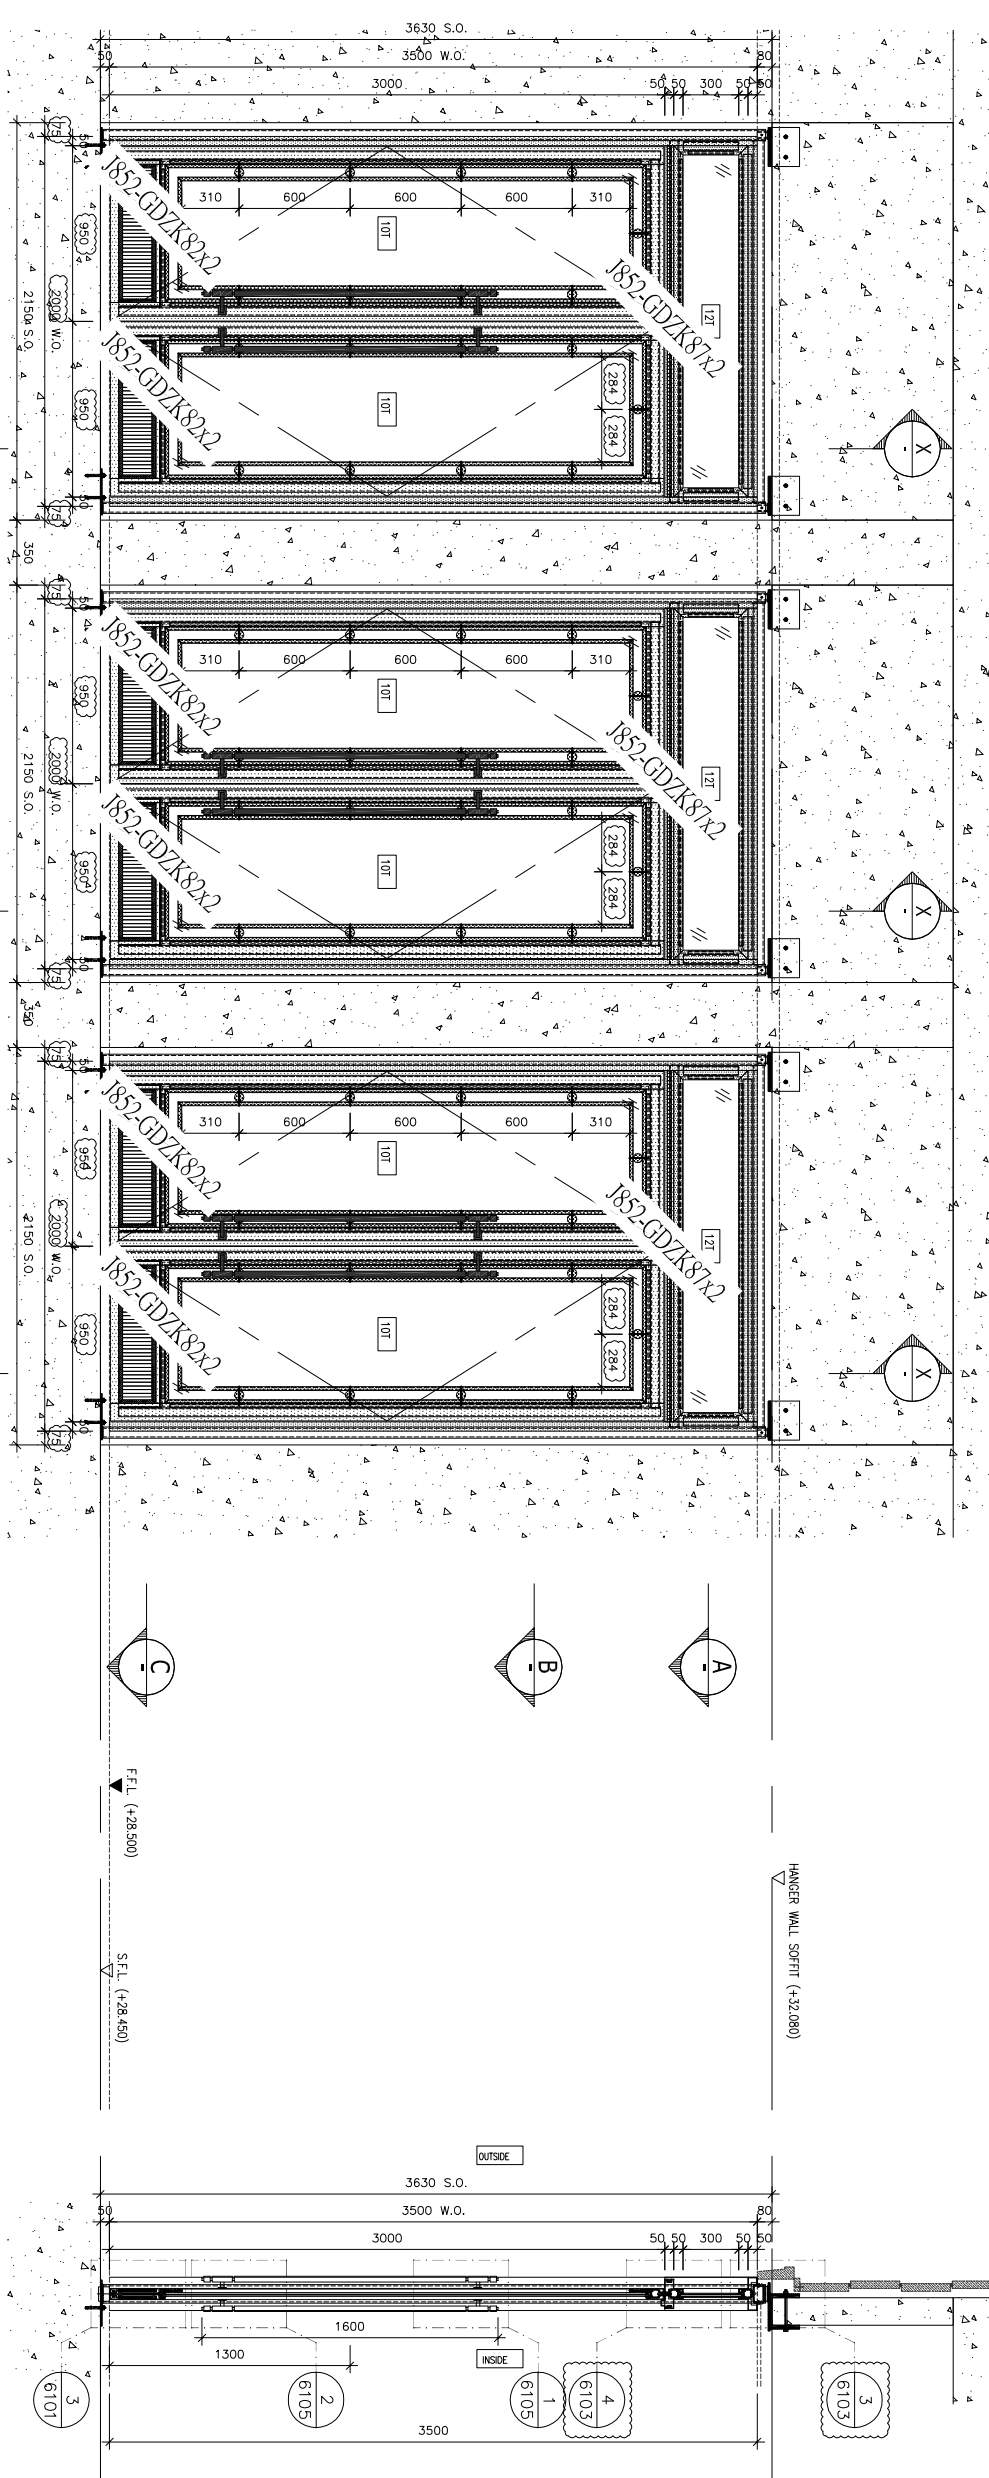

BO. REF. :

CLIENT :

ARCHITECT : **AGC DESIGN LTD**

MAIN CONTRACTOR :

STRUCTURAL ENGINEER : **GAMMON**

FAÇADE CONSULTANT : **ARUP**

MEINHARDT

NOTE :

- ALL DIMENSIONS ARE IN mm.
- ALL ELEVATIONS ARE VIEWED FROM OUTSIDE.
- ALL DIMENSIONS TO BE VERIFIED ON SITE BEFORE FABRICATION.

LEGEND :

X1 --- DETAIL MARK NO.

X001 --- REFERS SHEET NO.

- F.F.L. --- FINISHED FLOOR LEVEL.
- S.F.L. --- STRUCTURAL FLOOR LEVEL.
- ⊗ --- REVERSED DETAIL.
- 12T --- 12mm THK. TEMPERED GLASS.
- 10T --- 10mm THK. REVERSED GLASS.

NO.	DATE	REVISION
1	16/10/2011	REVISION SUBJECT TO ARCH. COMMENT
2	23/09/2011	REVISION SUBJECT TO ARCH. COMMENT
3	21/07/2011	REVISION SUBJECT TO ARCH. COMMENT
4	27/11/2011	REVISION SUBJECT TO ARCH. COMMENT
5	10/11/2011	REVISION SUBJECT TO ARCH. COMMENT

JOB NO. : J-852

PROJECT : PROPOSED DEVELOPMENT AT KOWLOON INLAND, LOT Nos. 60356P, 60366P, 60376P, 60386P, AND LOT No. 6005

TITLE : ELEVATION & PART PLAN FOR GLASS WALL(G/F)

DATE : 25-Mar-21 SCALE : 1:40

DRAWN BY : CJM CHECKED BY : DW


FLOOR	LOCATION	GLASS WALL MARK	QTY
G	CLUBHOUSE LOUNGE	CH03/G	1

Unit 6-8, Sunny Industrial Centre, 1/F  
610 Chee Kwo Ling Road, Kowloon  
Tel: 2498211-4 Fax: 8527272166




**MIDI** ALUMINIUM FABRICATOR LTD.

Unit 6-8, Sunny Industrial Centre, 1/F  
610 Chee Kwo Ling Road, Kowloon  
Tel: 2498211-4 Fax: 8527272166

DWG NO. : JB52-PCW-4509 REV. : E

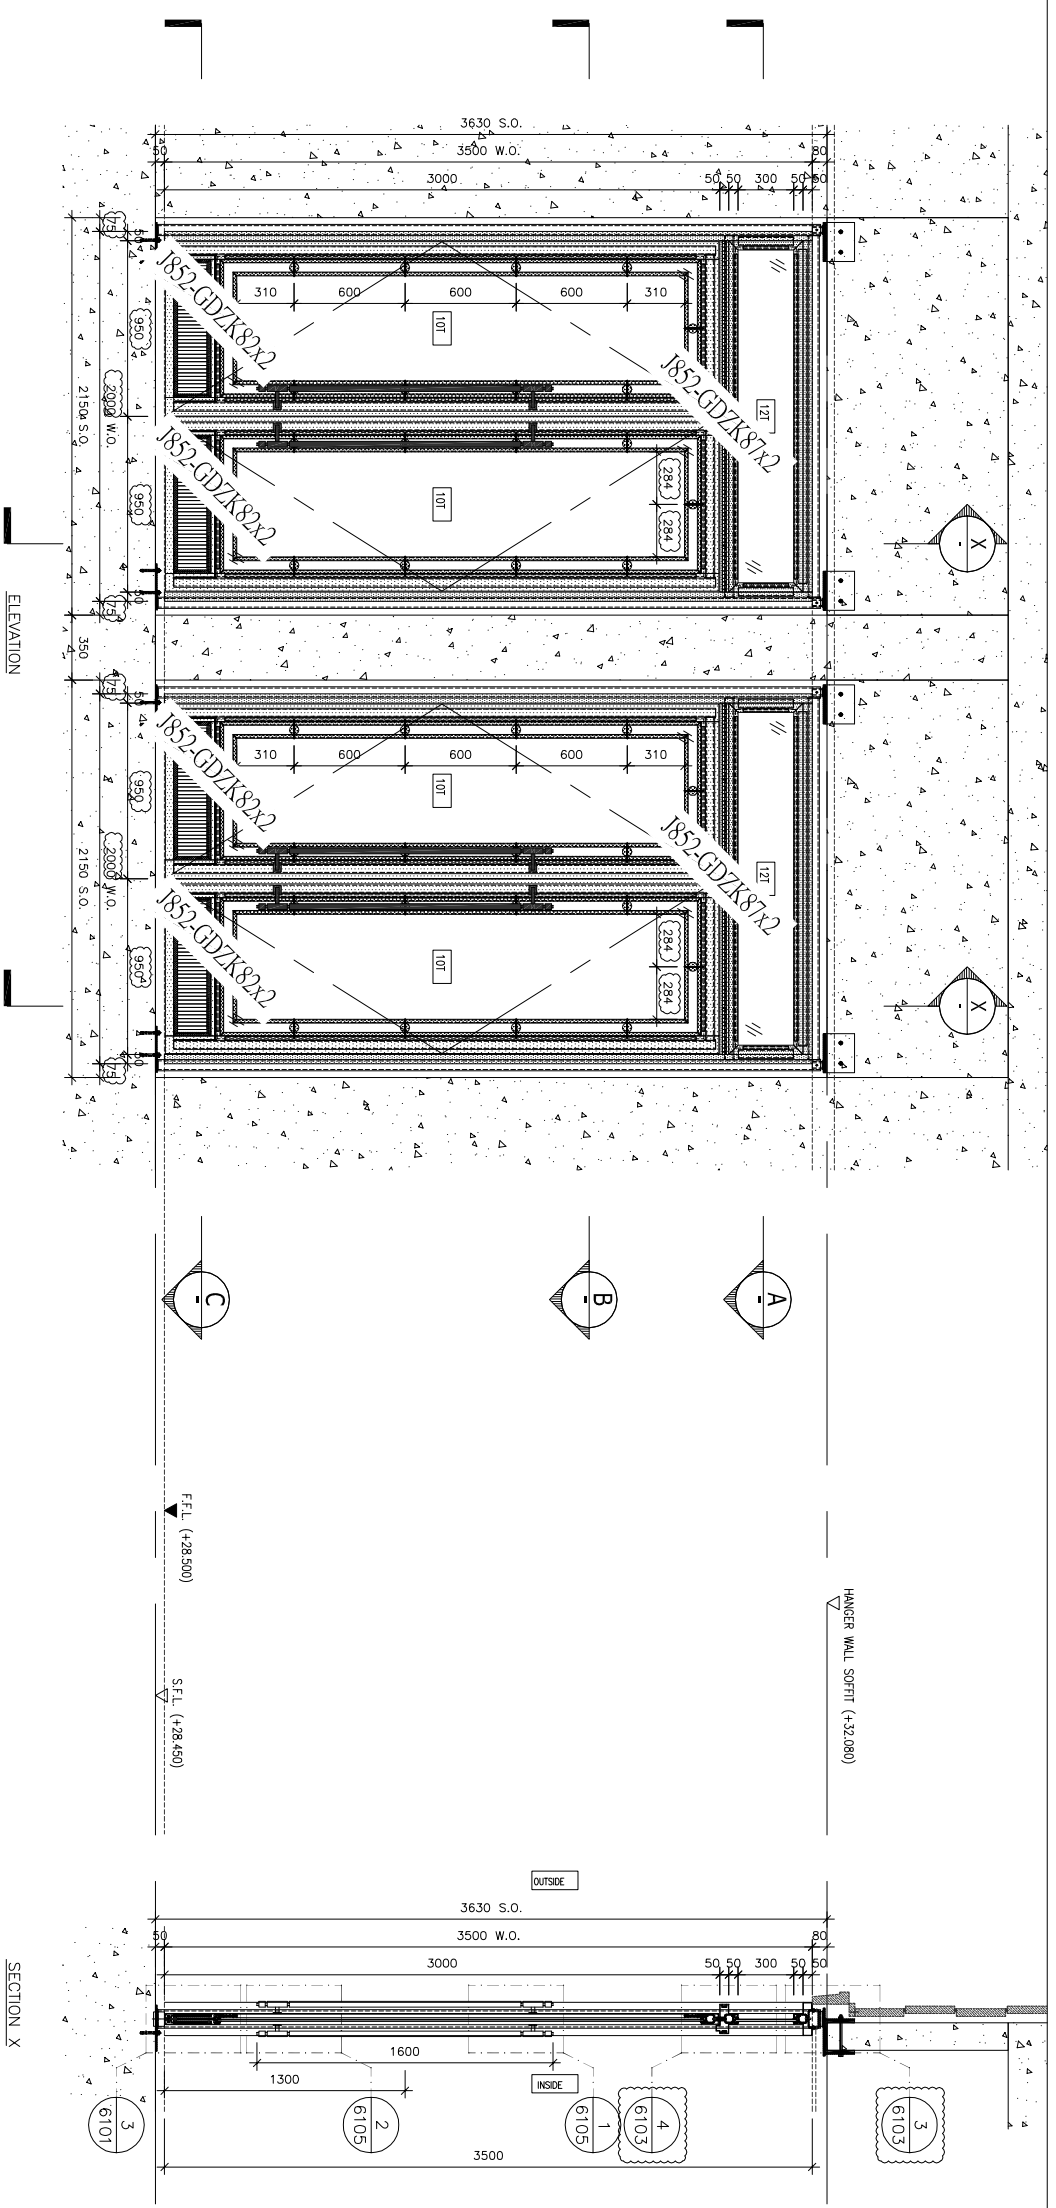

BO. REF. :	
CLIENT :	
ARCHITECT :	AGC DESIGN LTD
MAIN CONTRACTOR :	GAMMON
STRUCTURAL ENGINEER :	ARUP
FAÇADE CONSULTANT :	MEINHARDT
NOTE :	<ol style="list-style-type: none"> <li>ALL DIMENSIONS ARE IN MM.</li> <li>ALL ELEVATIONS ARE VIEWED FROM OUTSIDE.</li> <li>ALL DIMENSIONS TO BE VERIFIED ON SITE BEFORE FABRICATION.</li> </ol>
LEGEND :	<p>X1 --- DETAIL MARK NO.</p> <p>X001 --- REFER SHEET NO.</p> <p>1. F.F.L. --- FINISHED FLOOR LEVEL</p> <p>2. S.F.L. --- STRUCTURAL FLOOR LEVEL</p> <p>3. (R) --- REVERSED DETAIL</p> <p>4. (ZT) --- 12mm THK. TEMPERED GLASS</p> <p>5. (T) --- 16mm THK. REVERSED GLASS</p>

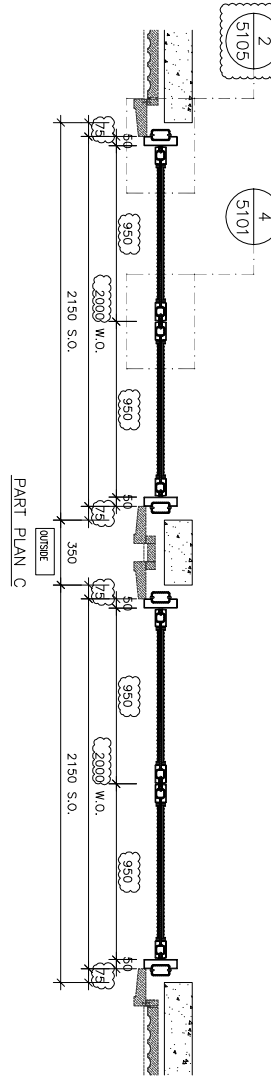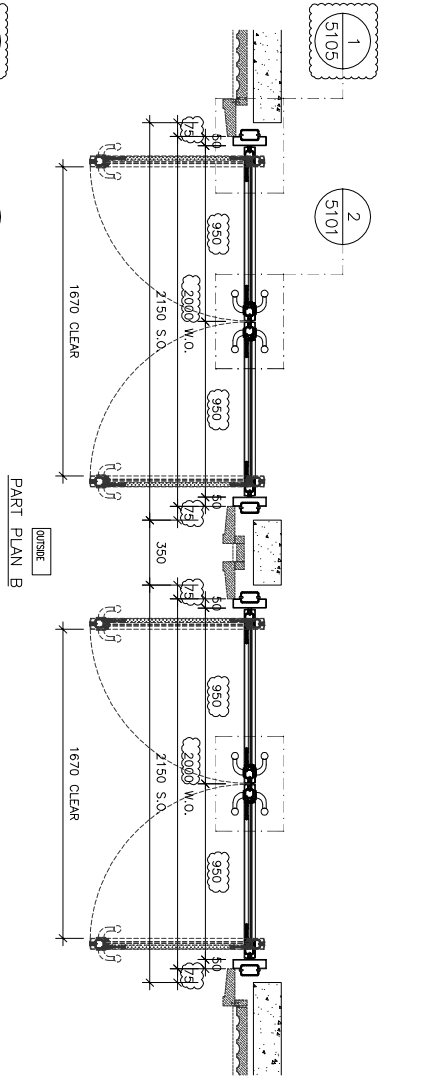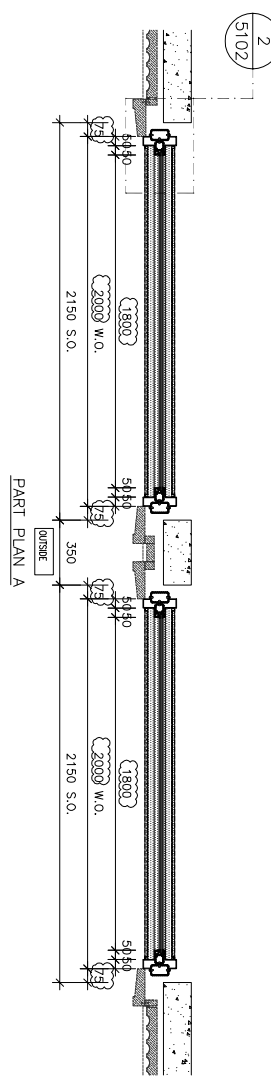

FLOOR	LOCATION	GLASS WALL MARK	QTY
G	CLUBHOUSE W.F. RM.1	CH04/G	1

NO.	DATE	REVISION
1	16/10/2011	REVISION SUBJECT TO ARCH. COMMENT
2	22/09/2011	REVISION SUBJECT TO ARCH. COMMENT
3	21/07/2011	REVISION SUBJECT TO ARCH. COMMENT
4	27/11/2011	REVISION SUBJECT TO ARCH. COMMENT
5	10/11/2011	REVISION SUBJECT TO ARCH. COMMENT

JOB NO. : J-852

PROJECT : PROPOSED DEVELOPMENT AT KOWLOON INLAND, LOT Nos. 60356P, 60368P, 60378P, 60388P, AND LOT No. 6005





TITLE : ELEVATION & PART PLAN FOR GLASS WALL(G/F)

DATE : 25-Mar-21 SCALE : 1:40

DRAWN BY : CJM CHECKED BY : DW

Unit 6-8, Sunny Industrial Centre, 1/F  
**MIDI** ALUMINIUM FABRICATOR LTD.  
 610 Chee Kwo Ling Road, Kowloon  
 Tel: 2498211-4 Fax: 8527272166  
 DMC NO. : JB52-PCW-4510 REV. : E



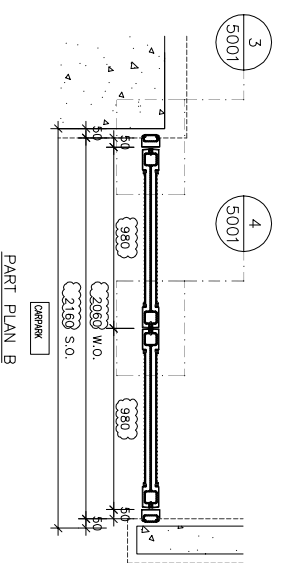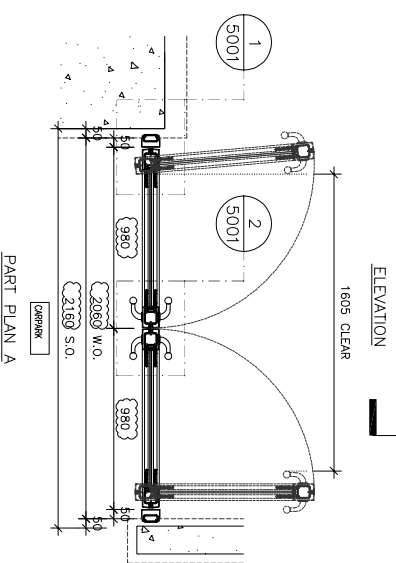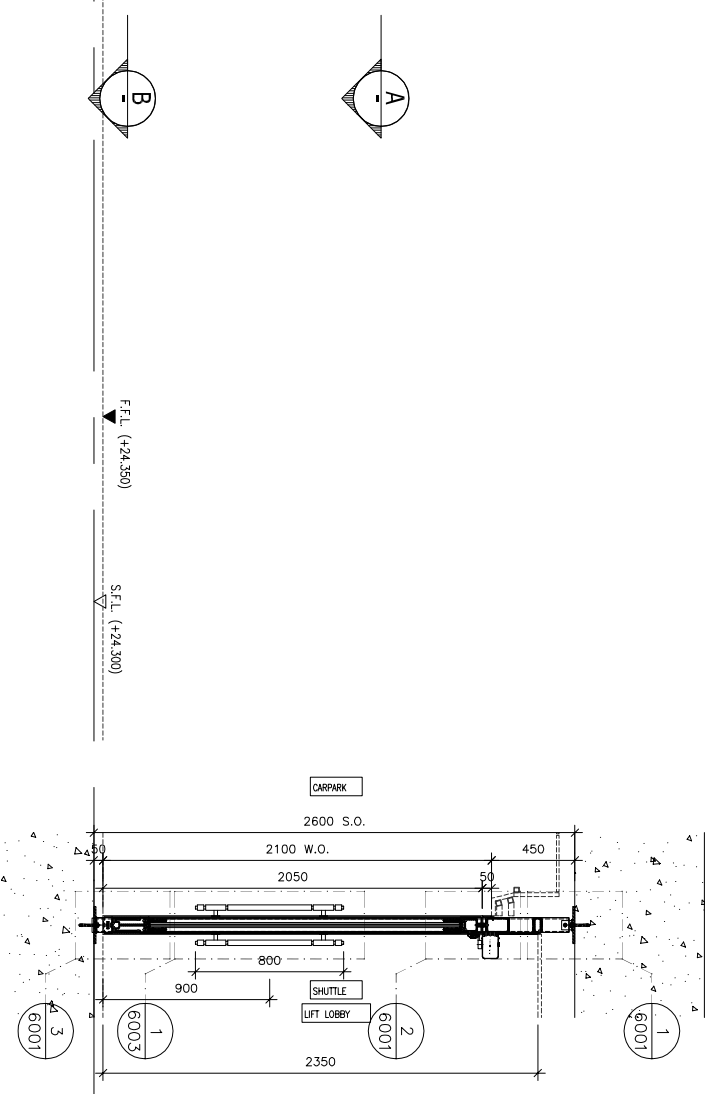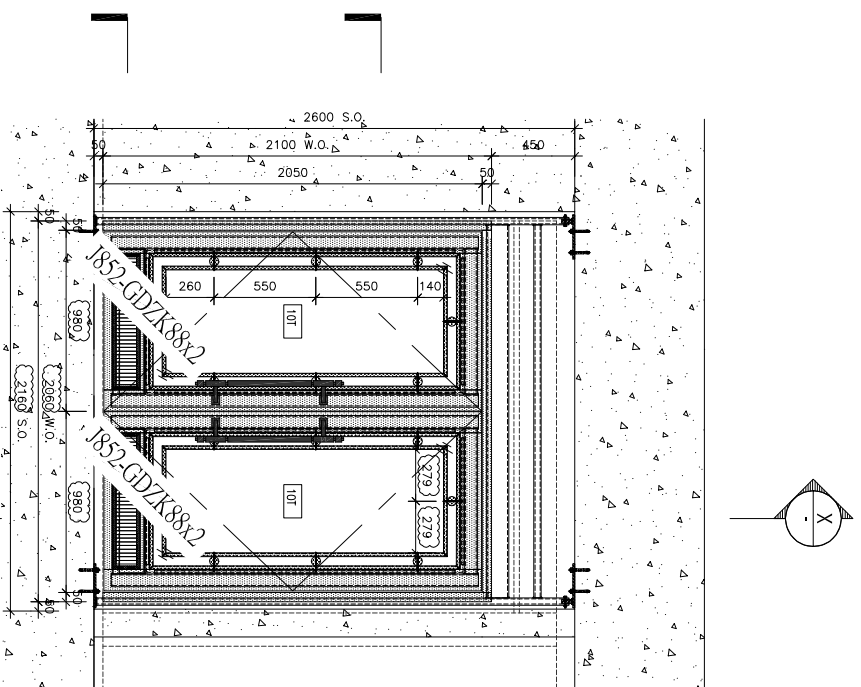

SECTION X

CLIENT :  
 ARCHITECT :  
**AGC DESIGN LTD**  
 10/F, 100, Nathan Road, Kowloon, Hong Kong  
 T: +852 2500 8888 F: +852 2500 8889  
 MAIN CONTRACTOR :  
**Gammon**  
 STRUCTURAL ENGINEER :  
**ARUP**  
 FIGURE CONSULTANT:  
**MEINHARDT**

NOTE:  
 1. ALL DIMENSIONS ARE IN MM.  
 2. ALL ELEVATIONS ARE VIEWED FROM OUTSIDE.  
 3. ALL DIMENSIONS TO BE VERIFIED ON SITE BEFORE FABRICATION.

LEGEND:  
 X1 --- DETAIL MARK NO.  
 X001 --- REFER SHEET NO.  
 1. F.F.L. --- FINISHED FLOOR LEVEL  
 2. S.F.L. --- STRUCTURAL FLOOR LEVEL  
 3. (R) --- REVERSED DETAIL  
 4. (12T) --- 12mm THK. TEMPERED GLASS  
 5. (10T) --- 10mm THK. REVERSED GLASS

NO.	DATE	REVISION
1	18/10/2011	REVISION SUBJECT TO ARCH. COMMENT
2	23/09/2011	REVISION SUBJECT TO ARCH. COMMENT
3	23/09/2011	REVISION SUBJECT TO ARCH. COMMENT
4	10/11/2011	REVISION SUBJECT TO ARCH. COMMENT
5	10/11/2011	REVISION SUBJECT TO ARCH. COMMENT


JOB NO. : J-852  
 PROJECT : PROPOSED DEVELOPMENT AT KOWLOON INLAND, LOT Nos. 6035R.P., 6036R.P., 6037R.P., 6038R.P., AND LOT No. 6005  
 TITLE : ELEVATION & PART PLAN FOR GLASS WALL(G-4)

DATE : 25-Mar-20 SCALE : 1:40  
 DRAWN BY : CJM CHECKED BY : DW

**美特铝业有限公司**  
**MIDI ALUMINIUM FABRICATOR LTD.**  
 Units 6-8, Sunny Industrial Centre, 1/F  
 610 Chee Kwo Ling Road, Kowloon  
 Tel: 2498211-4 Fax: 8522727266  
 DMC NO. : J852-PCW-4400 REV : E


FLOOR	LOCATION	GLASS WALL MARK	QTY
LG4	SHUTTLE LIFT LOBBY	S001/LG4	1



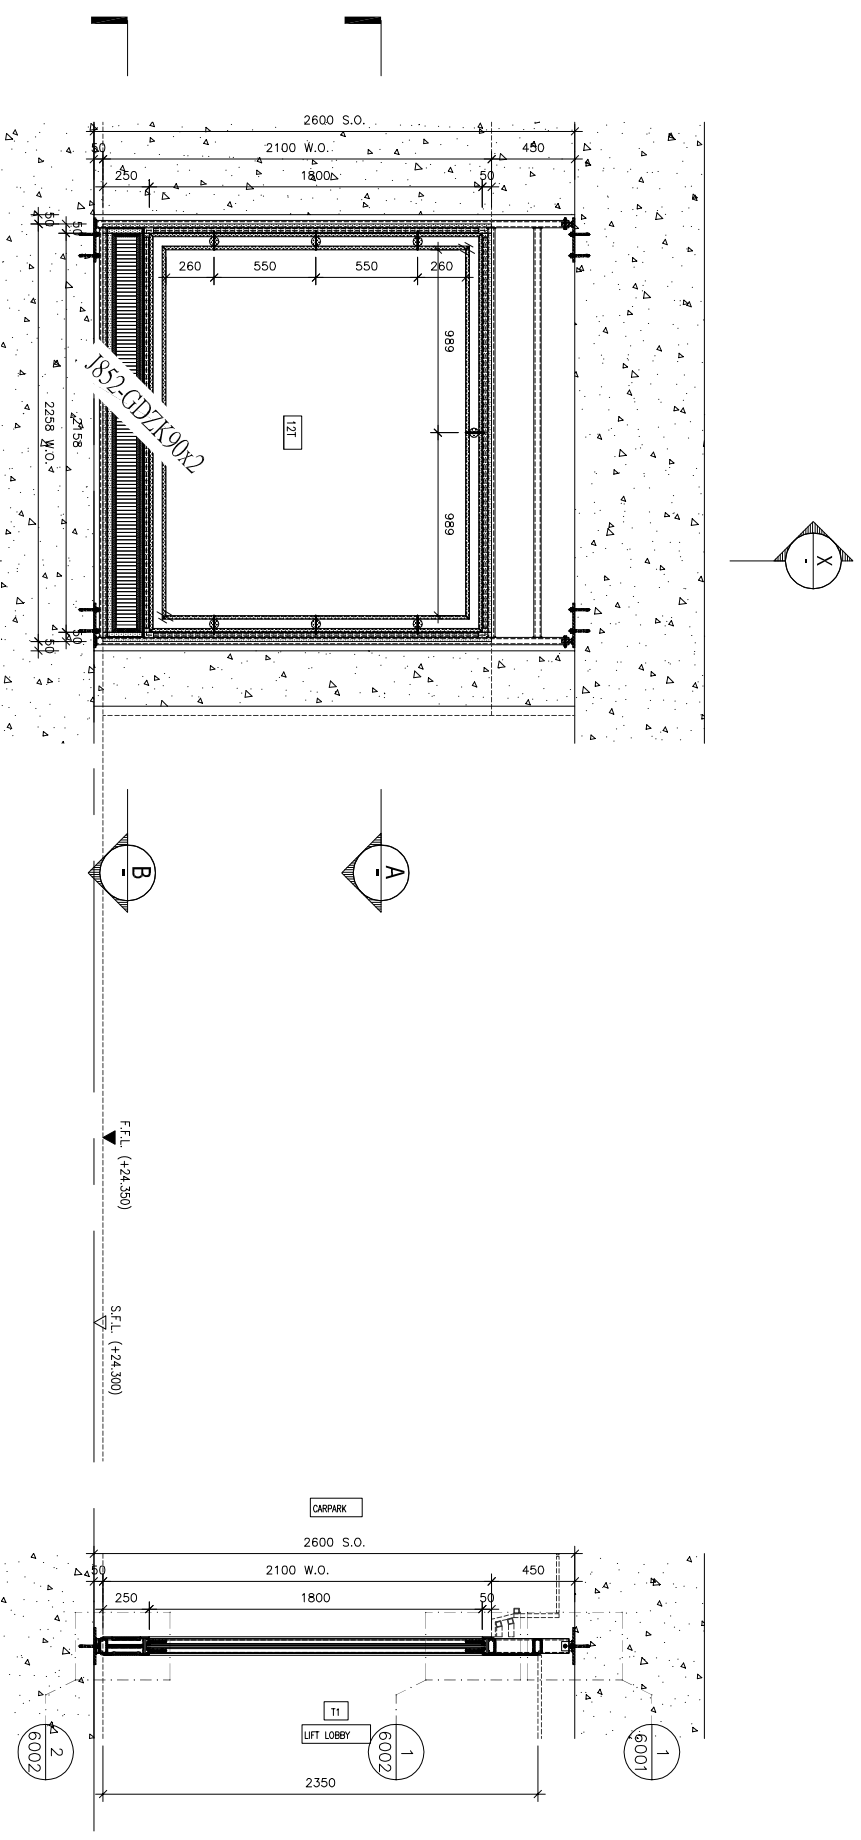


ELEVATION

SECTION X

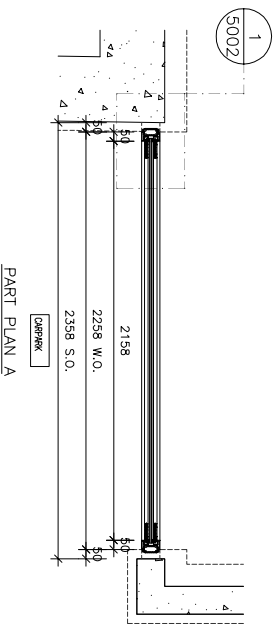

PART PLAN A

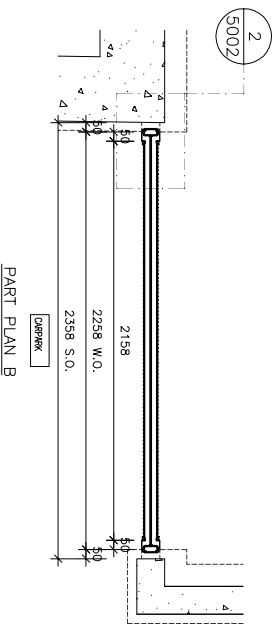

PART PLAN B

BO. REF. :	
CLIENT :	
ARCHITECT :	
MAIN CONTRACTOR :	
STRUCTURAL ENGINEER :	
FIGURE CONSULTANT :	

- NOTE :
1. ALL DIMENSIONS ARE IN mm.
  2. ALL ELEVATIONS ARE VIEWED FROM OUTSIDE.
  3. ALL DIMENSIONS TO BE VERIFIED ON SITE BEFORE FABRICATION.

LEGEND :

- X1 --- DETAIL MARK NO.  
 X001 --- REFER SHEET NO.
1. F.F.L. --- FINISHED FLOOR LEVEL
  2. S.F.L. --- STRUCTURAL FLOOR LEVEL
  3. --- REVERSED DETAIL
  4. --- 12mm THK. TEMPERED GLASS
  5. --- 10mm THK. REVERSED GLASS

NO.	DATE	REVISION
1	23/09/2021	REVISION SUBJECT TO ARCH COMMENT
2	23/09/2021	REVISION SUBJECT TO ARCH COMMENT
3	10/11/2021	REVISION SUBJECT TO ARCH COMMENT
4	10/11/2021	REVISION SUBJECT TO ARCH COMMENT
5	10/11/2021	REVISION SUBJECT TO ARCH COMMENT


JOB NO. : J-852  
 PROJECT : PROPOSED DEVELOPMENT AT KOWLOON INLAND, LOT Nos. 60356P., 60358P., 60359P., 60378P., 60380P., AND LOT No. 6005  
 TITLE : ELEVATION & PART PLAN FOR GLASS WALL(G-4)

DATE : 25-Mar-20 SCALE : 1:40

DRAWN BY : CJM CHECKED BY : DW

美特鋁質有限公司  
 610 Chee Kwo Ling Road, Kowloon  
 T423498211-4 Fax: (852) 27272166  
 DMC NO. : J852-PCW-4402 REV. : D


FLOOR	LOCATION	GLASS WALL MARK	QTY
LG4	TOWER 1 LIFT LOBBY	T102/LG4	1

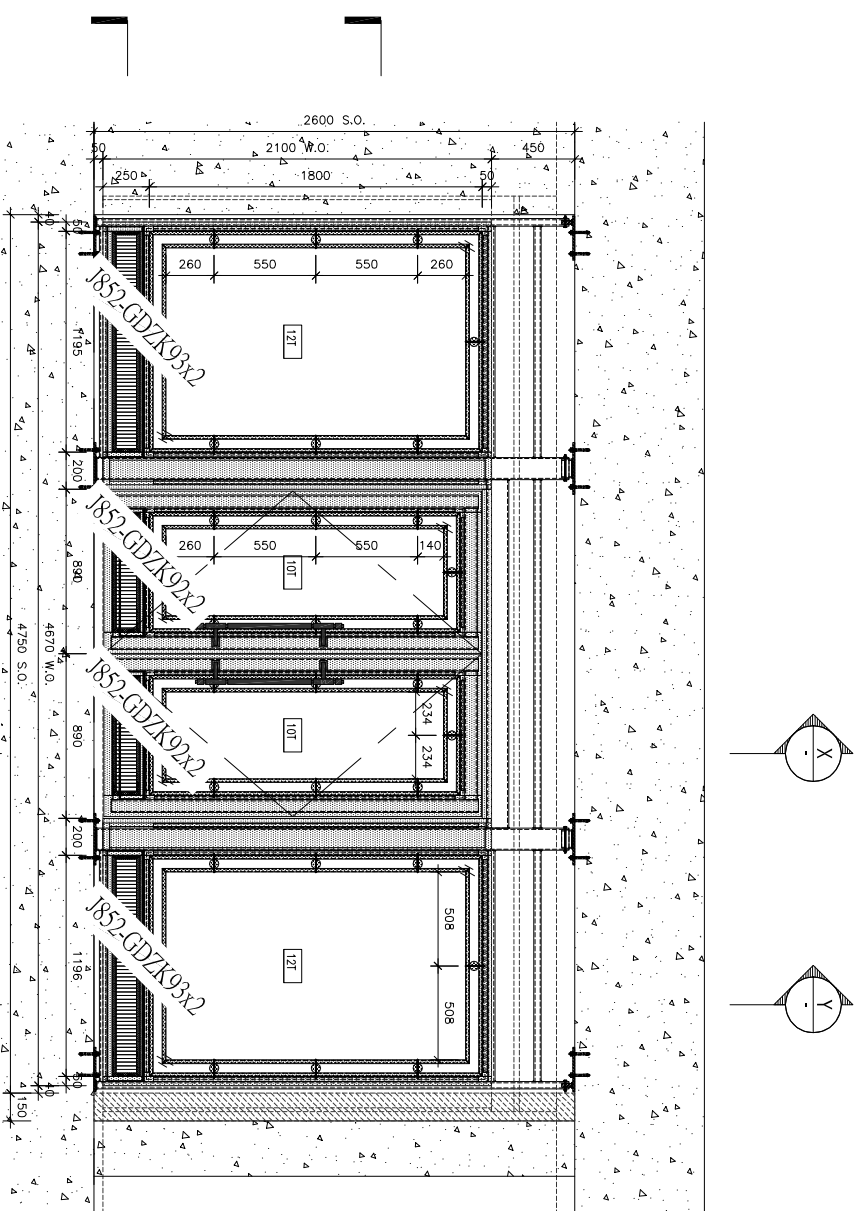

ELEVATION

SECTION X


SECTION Y

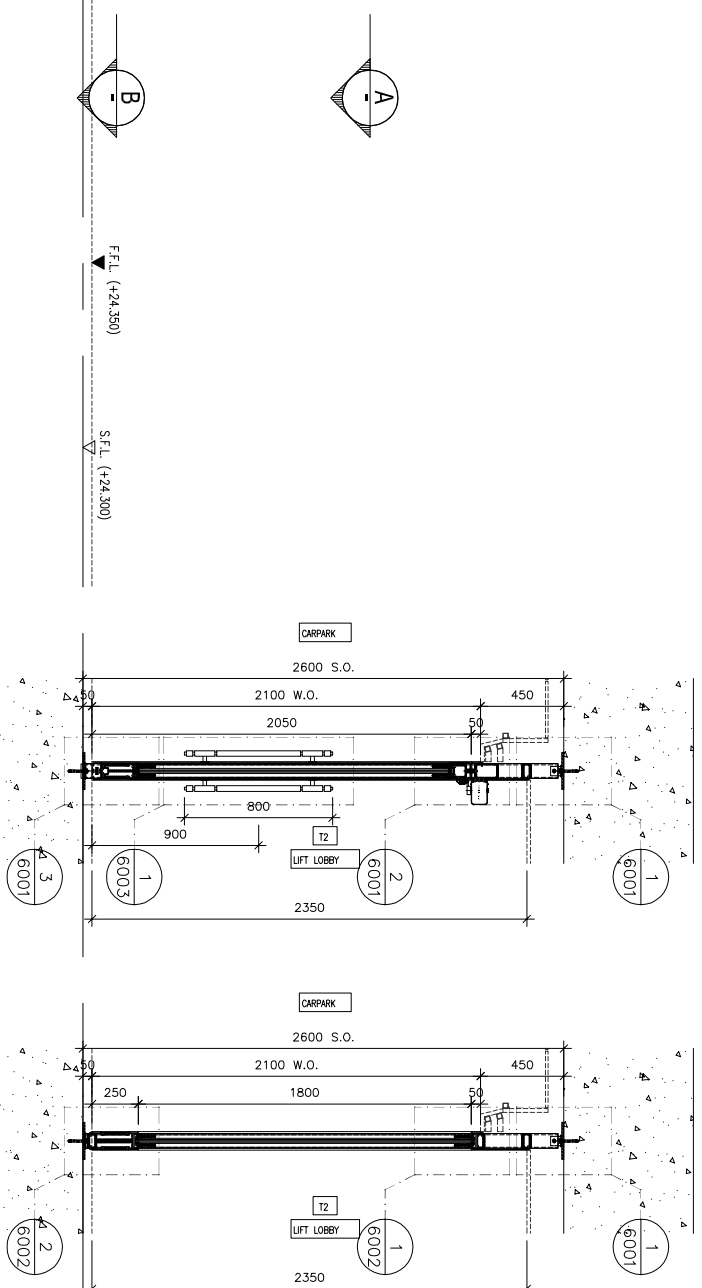

1500 CLEAR

PART PLAN A

PART PLAN B

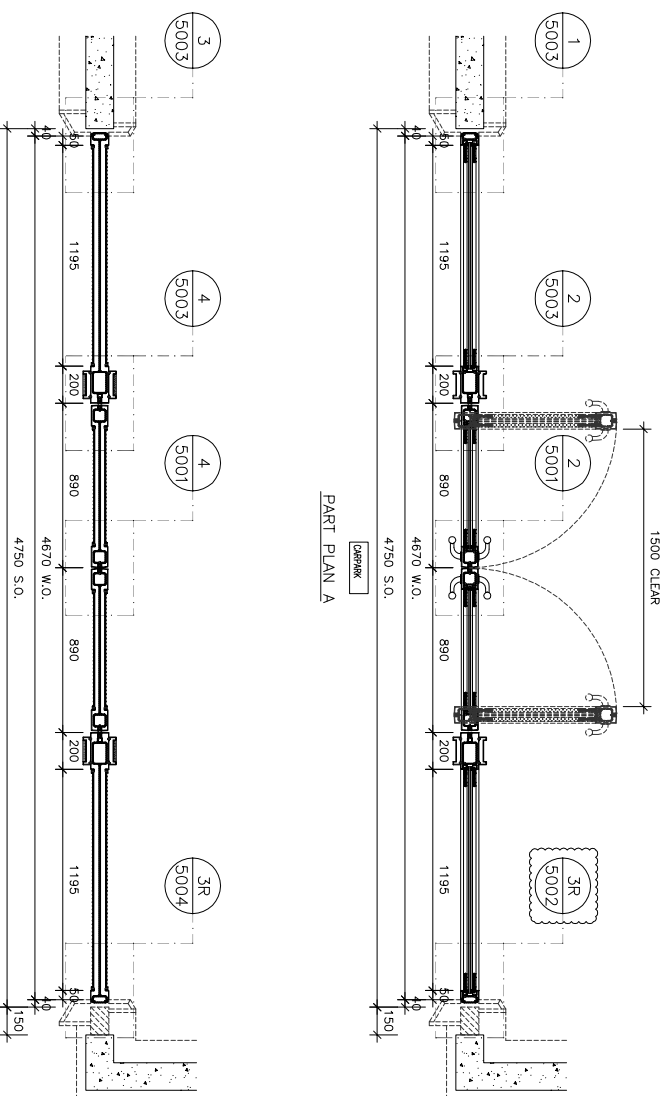

FLOOR	LOCATION	GLASS WALL MARK	QTY
LG4	TOWER 2 LIFT LOBBY	T201/LG4	1

BO. REF. :

CLIENT :

ARCHITECT : **AGC DESIGN LTD**

MAIN CONTRACTOR : **GAMMON**

STRUCTURAL ENGINEER : **ARUP**

FIGURE CONSULTANT : **MEINHARDT**

NOTE :

- ALL DIMENSIONS ARE IN mm.
- ALL ELEVATIONS ARE VIEWED FROM OUTSIDE.
- ALL DIMENSIONS TO BE VERIFIED ON SITE BEFORE FABRICATION.

LEGEND :

X1 --- DETAIL MARK NO.  
X001 --- REFER SHEET NO.

- F.F.L. --- FINISHED FLOOR LEVEL
- S.F.L. --- STRUCTURAL FLOOR LEVEL
- R --- REVERSED DETAIL
- 127 --- 12mm THK. TEMPERED GLASS
- 107 --- 10mm THK. REVERSED GLASS

NO.	DATE	REVISION
1	18/10/2021	REVISION SUBJECT TO ARCH. COMMENT
2	23/09/2021	REVISION SUBJECT TO ARCH. COMMENT
3	21/07/2021	REVISION SUBJECT TO ARCH. COMMENT
4	12/7/2021	REVISION SUBJECT TO ARCH. COMMENT
5	19/4/2021	REVISION SUBJECT TO ARCH. COMMENT

JOB NO. : J-852

PROJECT : PROPOSED DEVELOPMENT AT KOWLOON INLAND, LOT Nos. 6035R.P., 6036R.P., 6037R.P., 6038R.P., AND LOT No. 6005

TITLE : ELEVATION & PART PLAN FOR GLASS WALL(LG4)



DATE : 25-Mar-20 SCALE : 1:40

DRAWN BY : CJM CHECKED BY : DW


Unit 6-8, Sunny Industrial Centre, 1/F  
610 Chee Kwee Road, Kowloon  
Tel: 2498211-4 Fax: 8522727166

**美特铝业有限公司**  
MIDI ALUMINIUM FABRICATOR LTD.

DWG NO. : JB52-PCW-4403 REV. : E

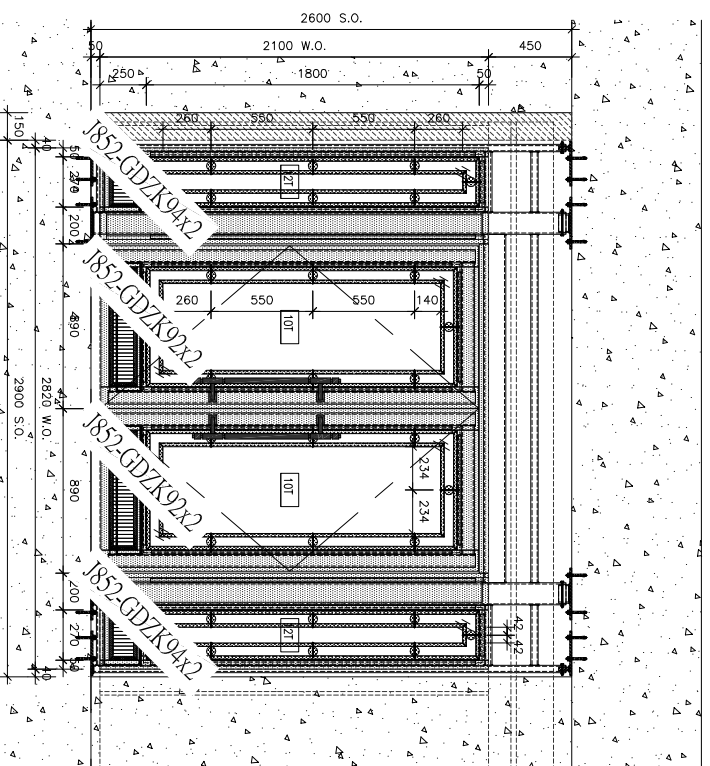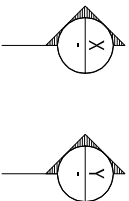


ELEVATION

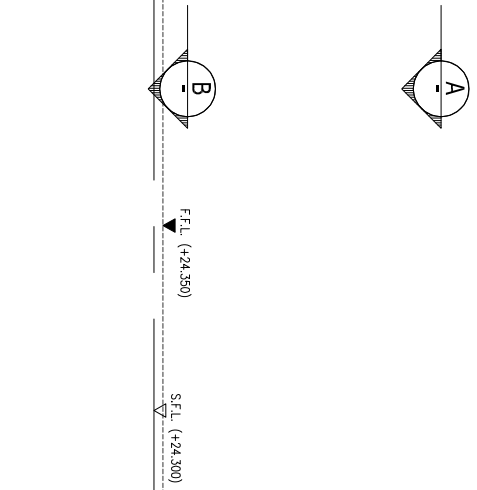


SECTION X

SECTION Y

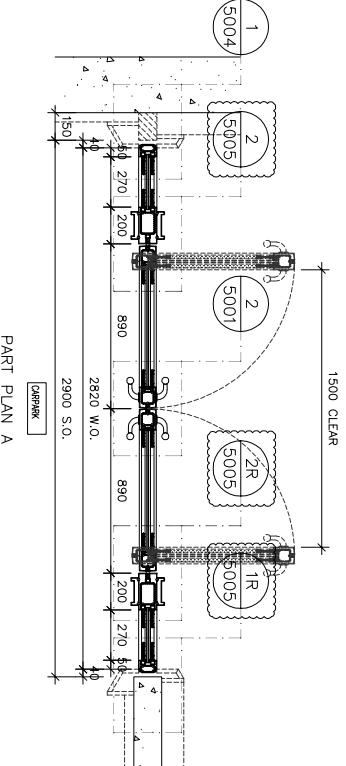

PART PLAN A

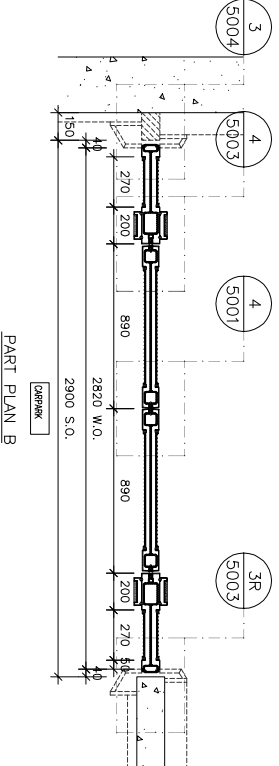

PART PLAN B

FLOOR	LOCATION	GLASS WALL MARK	QTY
LG4	TOWER 3 LIFT LOBBY	T301/LG4	1

BO. REF. :

CLIENT :

ARCHITECT :  
**AGC DESIGN LTD**  
 20/F, 100, Nathan Road, Kowloon, HONG KONG

MAIN CONTRACTOR :  
**Gammou**  
 10/F, 100, Nathan Road, Kowloon, HONG KONG

STRUCTURAL ENGINEER :  
**ARUP**  
 10/F, 100, Nathan Road, Kowloon, HONG KONG

FIGURE CONSULTANT:  
**MEINHARDT**  
 10/F, 100, Nathan Road, Kowloon, HONG KONG

NOTE :

- ALL DIMENSIONS ARE IN mm.
- ALL ELEVATIONS ARE VIEWED FROM OUTSIDE.
- ALL DIMENSIONS TO BE VERIFIED ON SITE BEFORE FABRICATION.

LEGEND :

X1 --- DETAIL MARK NO.  
 X001 --- REFER SHEET NO.

- F.F.L. --- FINISHED FLOOR LEVEL
- S.F.L. --- STRUCTURAL FLOOR LEVEL
- R --- REVERSED DETAIL
- 12T --- 12mm THK. TEMPERED GLASS
- 10T --- 10mm THK. REVERSED GLASS

JOB NO. : J-852



PROJECT : PROPOSED DEVELOPMENT AT KOWLOON INLAND, LOT Nos., 60356P., 60358P., 60378P., 60388P.P., AND LOT No. 6005

TITLE : ELEVATION & PART PLAN FOR GLASS WALL(LG4)

DATE : 25-Mar-20 SCALE : 1:40

DRAWN BY : CJM CHECKED BY : DW

UNITED STATES OF AMERICA  
**MIDI 美特铝质有限公司**  
 ALUMINIUM FABRICATOR LTD.  
 Units 6-8, Sunny Industrial Centre, 1/F  
 610 Chee Kwo Ling Road, Kowloon  
 Tel: 2498211-4 Fax: 8527272166  
 DMC NO. : J852-PCW-4A04 REV. : E

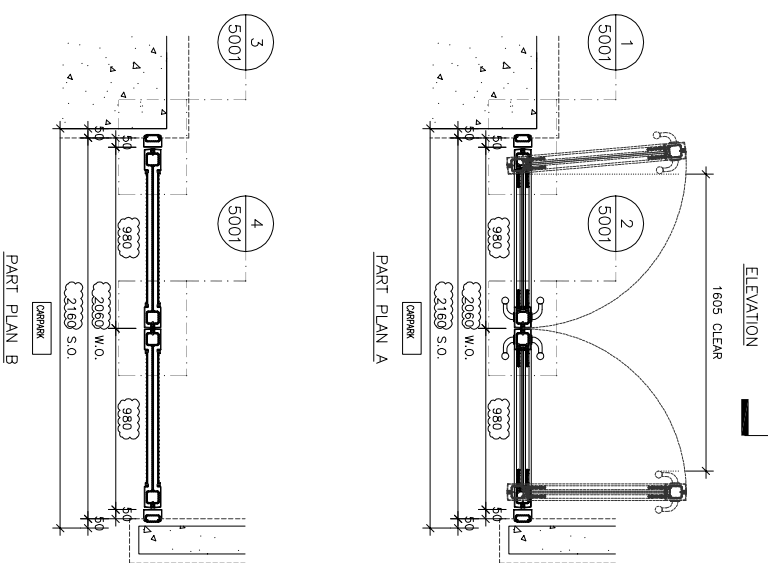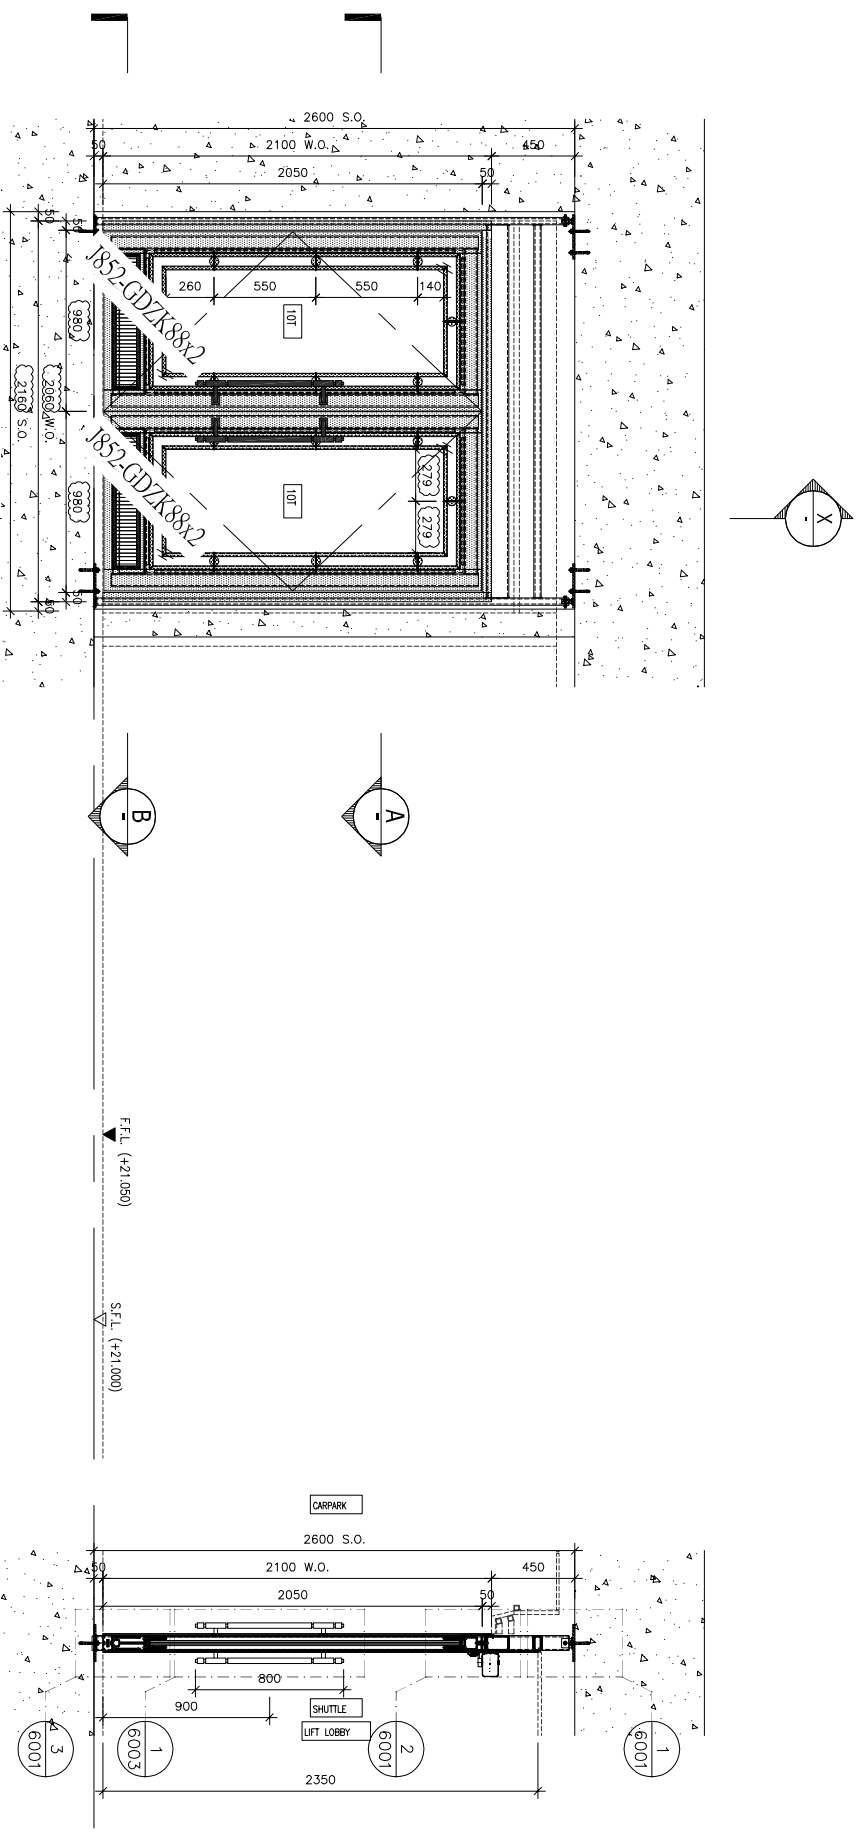

SECTION X

FLOOR	LOCATION	GLASS WALL MARK	QTY
LG3	SHUTTLE LIFT LOBBY	S001/LG3	1

BO. REF. :

CLIENT :

ARCHITECT : **AGC DESIGN LTD**

MAIN CONTRACTOR : **GAMMON**

STRUCTURAL ENGINEER : **ARUP**

FIGURE CONSULTANT : **MEINHARDT**

NOTE :

- ALL DIMENSIONS ARE IN MM.
- ALL ELEVATIONS ARE VIEWED FROM OUTSIDE.
- ALL DIMENSIONS TO BE VERIFIED ON SITE BEFORE FABRICATION.

LEGEND :

X1 --- DETAIL MARK NO.  
X001 --- REFER SHEET NO.

- F.F.L. --- FINISHED FLOOR LEVEL
- S.F.L. --- STRUCTURAL FLOOR LEVEL
- R --- REVERSED DETAIL
- 12T --- 12mm THK. TEMPERED GLASS
- 10T --- 10mm THK. REVERSED GLASS

NO.	DATE	REVISION
1	18/10/2011	REVISION SUBJECT TO ARCH. COMMENT
2	23/09/2011	REVISION SUBJECT TO ARCH. COMMENT
3	23/09/2011	REVISION SUBJECT TO ARCH. COMMENT
4	10/11/2011	REVISION SUBJECT TO ARCH. COMMENT
5	10/11/2011	REVISION SUBJECT TO ARCH. COMMENT

JOB NO. : J-852

PROJECT : PROPOSED DEVELOPMENT AT KOWLOON INLAND, LOT Nos. 6035R.P., 6036R.P., 6037R.P., 6038R.P., AND LOT No. 6005

TITLE : ELEVATION & PART PLAN FOR GLASS WALL(LG3)


DATE : 25-Mar-20 SCALE : 1:40

DRAWN BY : CJM CHECKED BY : DW

UNIT 6-8, Sunny Industrial Centre, 1/F  
610 Chee Kwo Ling Road, Kowloon  
Tel: 2498211-4 Fax: 8527272166



**美特铝业有限公司**  
**MIDI ALUMINIUM FABRICATOR LTD.**

DWG NO. : JB52-PCW-4300 REV. : E

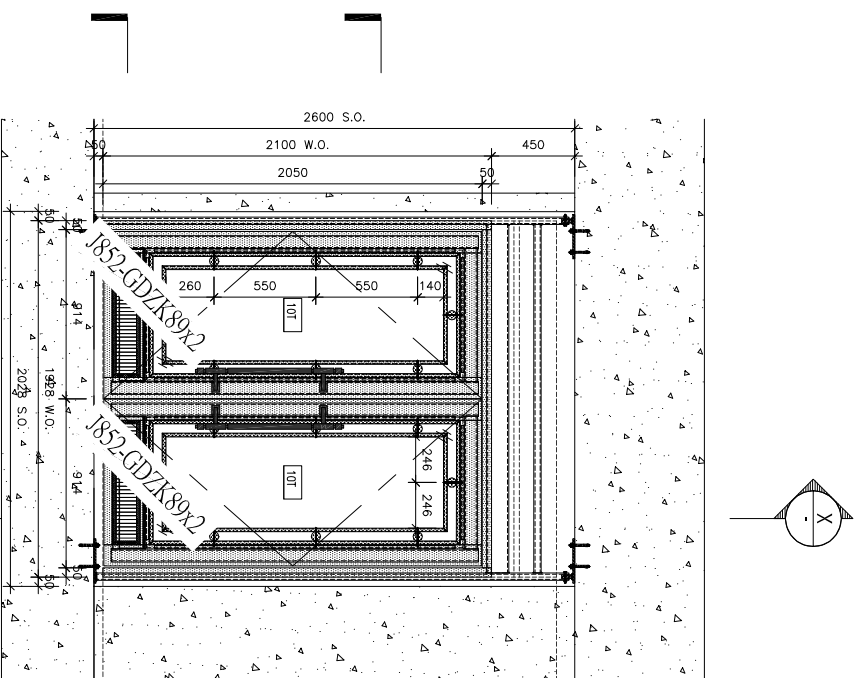


ELEVATION

SECTION X

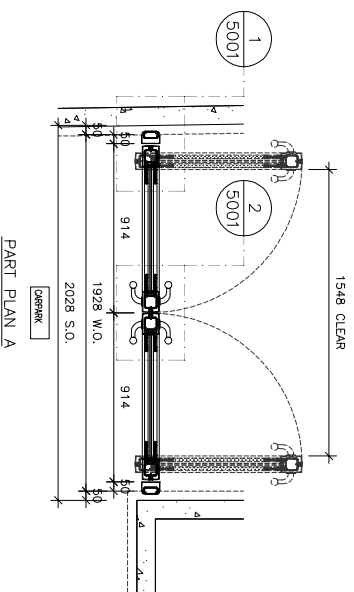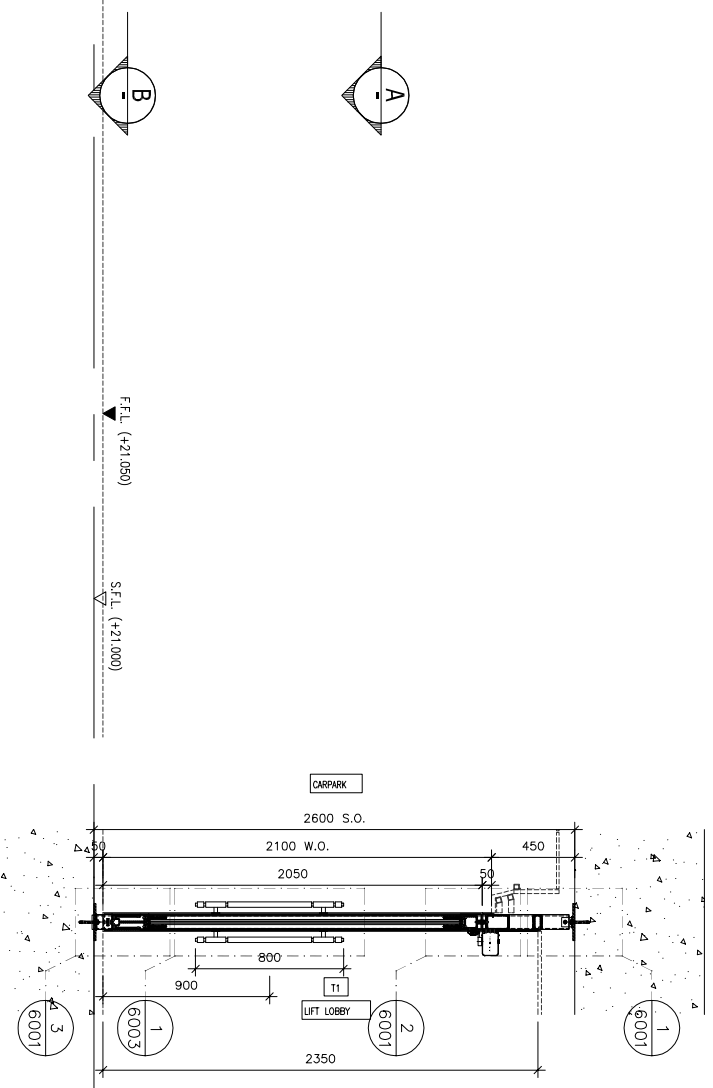

PART PLAN A

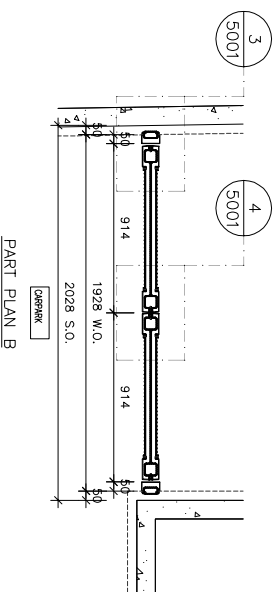

PART PLAN B

NOTE:

1. ALL DIMENSIONS ARE IN MM.
2. ALL ELEVATIONS ARE VIEWED FROM OUTSIDE.
3. ALL DIMENSIONS TO BE VERIFIED ON SITE BEFORE FABRICATION.

LEGEND:

- X1 --- DETAIL MARK NO.
- X001 --- REFER SHEET NO.
- 1. F.F.L. --- FINISHED FLOOR LEVEL
- 2. S.F.L. --- STRUCTURAL FLOOR LEVEL
- 3. (R) --- REVERSED DETAIL
- 4. (12T) --- 12mm THK. TEMPERED GLASS
- 5. (10T) --- 10mm THK. TEMPERED GLASS

NO.	DATE	REVISION
1	23/09/2021	REVISION SUBJECT TO ARCH COMMENT
2	23/09/2021	REVISION SUBJECT TO ARCH COMMENT
3	10/11/2021	REVISION SUBJECT TO ARCH COMMENT
4	19/12/2021	REVISION SUBJECT TO ARCH COMMENT
5		REVISION

JOB NO. : J-852  
 PROJECT : PROPOSED DEVELOPMENT AT KOWLOON INLAND, LOT Nos., 60356P., 60358P., 60378P., 60388P., AND LOT No. 6005  
 TITLE : ELEVATION & PART PLAN FOR GLASS WALL(LG3)

DATE : 25-Mar-20 SCALE : 1:40  
 DRAWN BY : CJM CHECKED BY : DW

**美特铝业有限公司**  
 MIDU ALUMINIUM FABRICATOR LTD.  
 Units 6-8, Sunny Industrial Centre, 1/F  
 610 Chee Kwo Ling Road, Kowloon  
 Tel: 23489211-4 Fax: 65027272/272666  
 DMC NO. : JB52-PCW-4301

FLOOR	LOCATION	GLASS WALL MARK	QTY
LG3	TOWER 1 LIFT LOBBY	T101/LG3	1

BO. REF. :

CLIENT :

ARCHITECT :

**AGC DESIGN LTD**  
 20/F, 200 Nathan Road, Kowloon, Hong Kong

MAIN CONTRACTOR :

**Gammon**

STRUCTURAL ENGINEER :


**ARUP**

FAÇADE CONSULTANT :

**MEINHARDT**

REV. : D





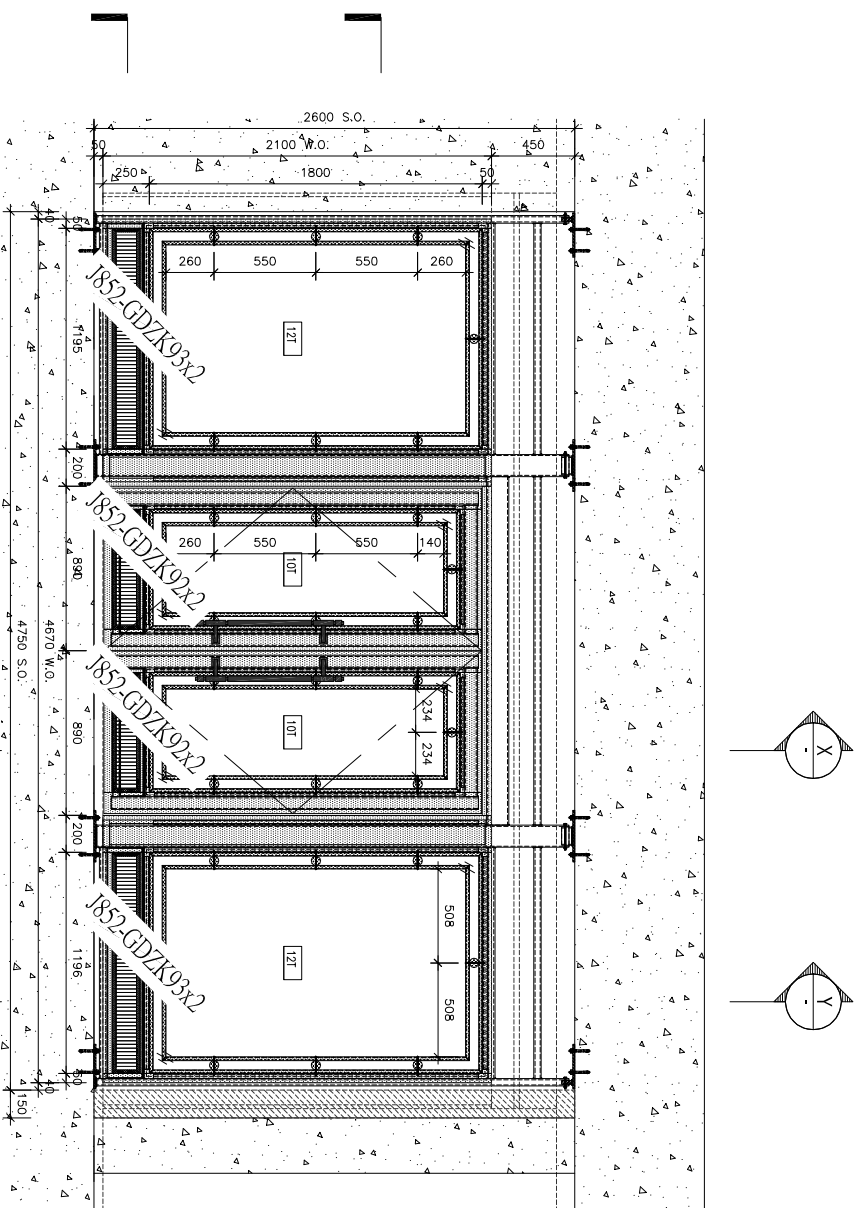


ELEVATION

SECTION X

SECTION Y

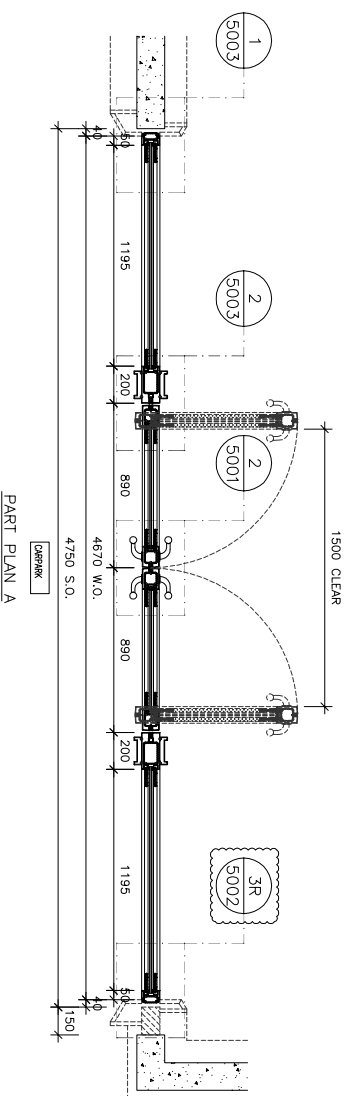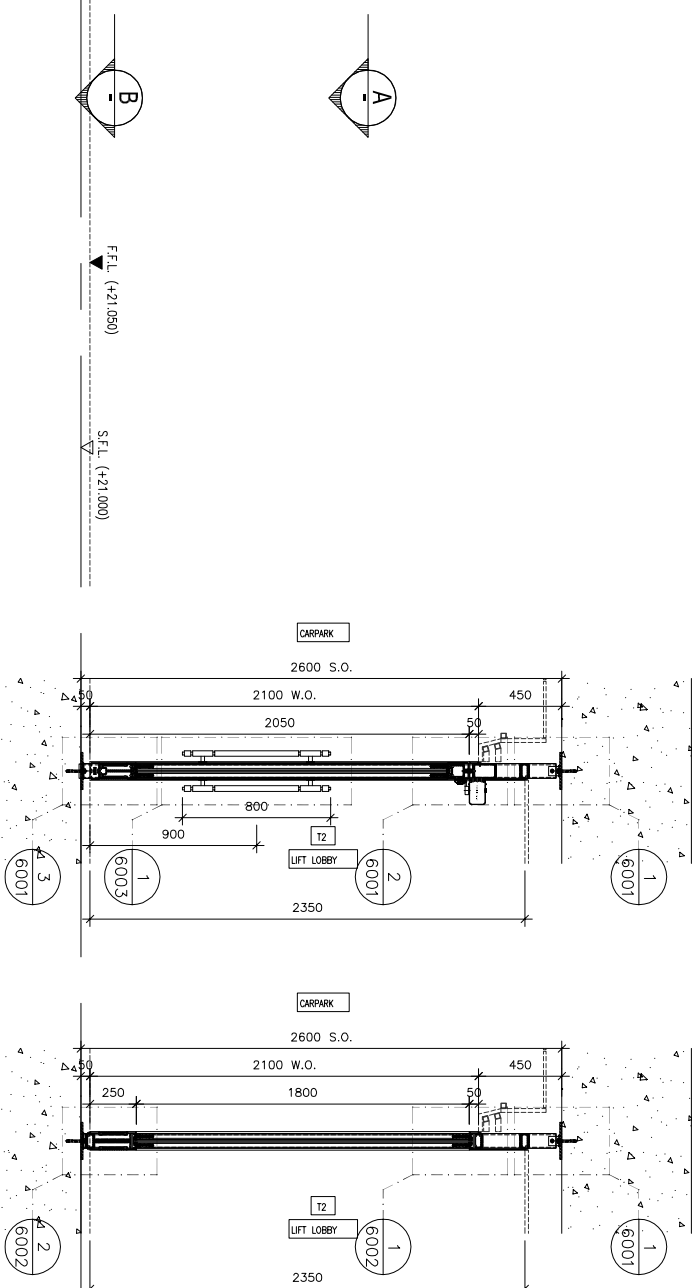

PART PLAN A

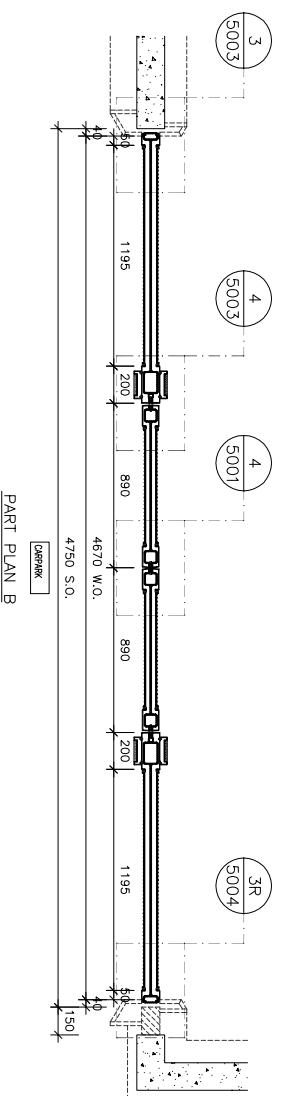

PART PLAN B

BD REF :

CLIENT :

ARCHITECT :

**AGC**  
DESIGN LTD

MAIN CONTRACTOR :

**Gammou**

STRUCTURAL ENGINEER :

**ARUP**

FIGURE CONSULTANT :

**MEINHARDT**

NOTE :

1. ALL DIMENSIONS ARE IN mm.
2. ALL ELEVATIONS ARE VIEWED FROM OUTSIDE.
3. ALL DIMENSIONS TO BE VERIFIED ON SITE BEFORE FABRICATION.

LEGEND :

- X1 --- DETAIL MARK NO.
- X001 --- REFER SHEET NO.
- 1. F.F.L. --- FINISHED FLOOR LEVEL.
- 2. S.F.L. --- STRUCTURAL FLOOR LEVEL.
- 3. (R) --- REVERSED DETAIL.
- 4. (2T) --- 12mm THK. TEMPERED GLASS.
- 5. (10T) --- 10mm THK. REVERSED GLASS.

NO.	DATE	REVISION
1	18/10/2011	REVISION SUBJECT TO ARCH COMMENT
2	23/09/2011	REVISION SUBJECT TO ARCH COMMENT
3	21/07/2011	REVISION SUBJECT TO ARCH COMMENT
4	12/7/2011	REVISION SUBJECT TO ARCH COMMENT
5	19/4/2011	REVISION SUBJECT TO ARCH COMMENT

JOB NO. : J-852

PROJECT : PROPOSED DEVELOPMENT  
AT KOWLOON INLAND,  
LOT Nos. 6035R.P., 6036R.P., 6037R.P.,  
6038R.P., AND LOT No. 6005

TITLE : ELEVATION & PART PLAN  
FOR GLASS WALL(LG3)



DATE : 25-Mar-20 SCALE : 1:40

DRAWN BY : CJM CHECKED BY : DW

**美特铝业有限公司**  
MIDI ALUMINIUM FABRICATOR LTD.  
Units 6-8, Sunny Industrial Centre, 1/F  
610 Chee Kwo Ling Road, Kowloon  
Tel: 2498211-4 Fax: 65027272/27166  
DWG NO. : JB52-PCW-4303

FLOOR	LOCATION	GLASS WALL MARK	QTY
LG3	TOWER 2 LIFT LOBBY	T201/LG3	1


REV : E

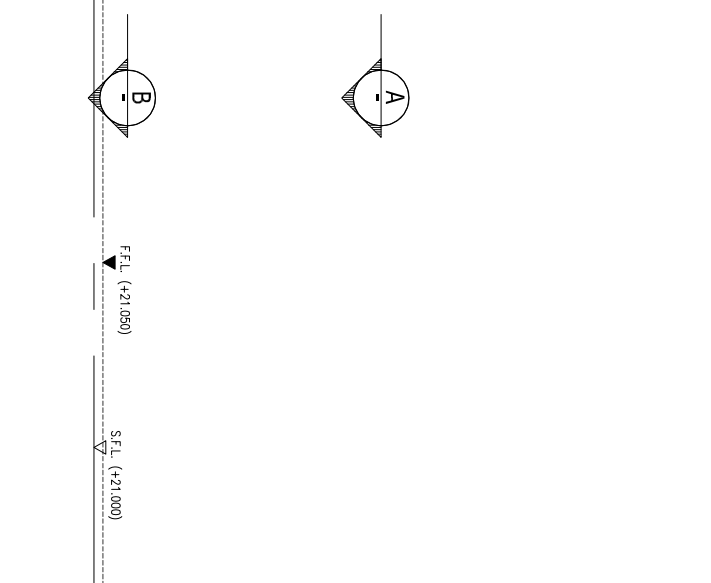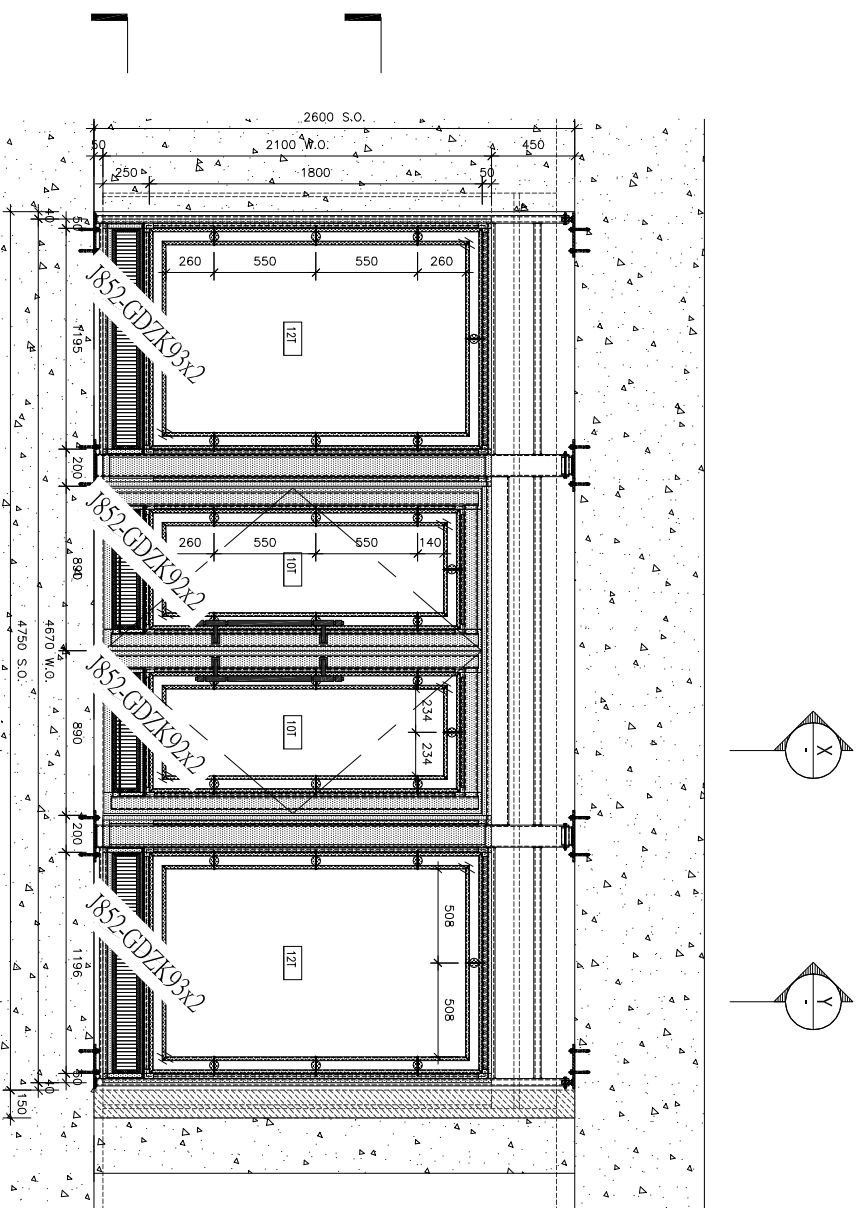


SECTION X

SECTION Y

ELEVATION

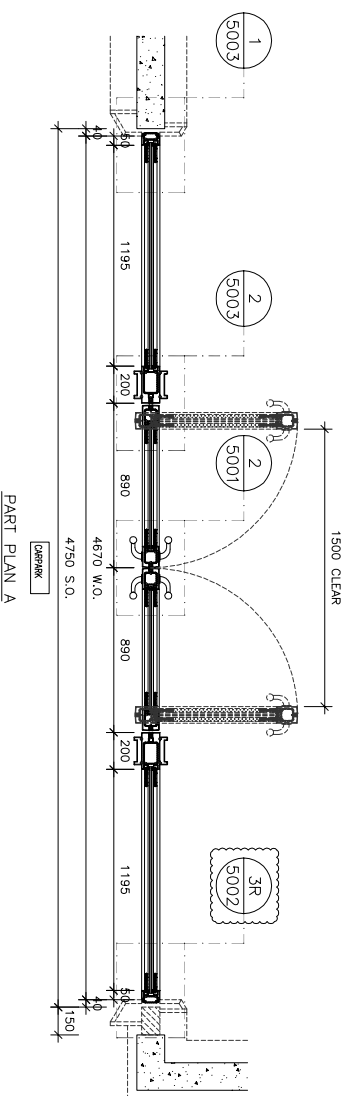

PART PLAN A

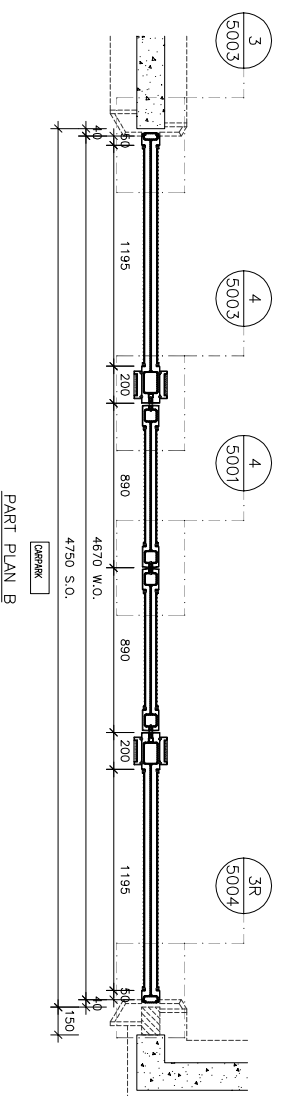

PART PLAN B

FLOOR	LOCATION	GLASS WALL MARK	QTY
LG3	TOWER 3 LIFT LOBBY	T301/LG3	1

BD REF :

CLIENT :

ARCHITECT : **AGC DESIGN LTD**

MAIN CONTRACTOR : **Gammon**

STRUCTURAL ENGINEER : **ARUP**

FIGURE CONSULTANT : **MEINHARDT**

PROJECT : PROPOSED DEVELOPMENT AT KOWLOON INLAND, LOT Nos. 6035R.P., 6036R.P., 6037R.P., 6038R.P., AND LOT No. 6005

TITLE : ELEVATION & PART PLAN FOR GLASS WALL(LG3)

DATE : 25-Mar-20 SCALE : 1:40

DRAWN BY : CJM CHECKED BY : DW

Unit: 6-8, Sunny Industrial Centre, 1/F  
610 Chee Kwee Road, Kowloon  
Tel: 2498211-4 Fax: 65027272  
1852-PCW-4304

REV : E

- NOTE:
- ALL DIMENSIONS ARE IN mm.
  - ALL ELEVATIONS ARE VIEWED FROM OUTSIDE.
  - ALL DIMENSIONS TO BE VERIFIED ON SITE BEFORE FABRICATION.

LEGEND:


X1 --- DETAIL MARK NO.  
X001 --- REFER SHEET NO.

- F.F.L. --- FINISHED FLOOR LEVEL
- S.F.L. --- STRUCTURAL FLOOR LEVEL
- R --- REVERSED DETAIL
- 12T --- 12mm THK. TEMPERED GLASS
- 10T --- 10mm THK. REVERSED GLASS

NO.	DATE	REVISION
1	18/10/2011	REVISION SUBJECT TO ARCH. COMMENT
2	23/09/2011	REVISION SUBJECT TO ARCH. COMMENT
3	21/08/2011	REVISION SUBJECT TO ARCH. COMMENT
4	12/7/2011	REVISION SUBJECT TO ARCH. COMMENT
5	19/4/2011	REVISION SUBJECT TO ARCH. COMMENT

JOB NO. : J-852



PROJECT : PROPOSED DEVELOPMENT AT KOWLOON INLAND, LOT Nos. 6035R.P., 6036R.P., 6037R.P., 6038R.P., AND LOT No. 6005

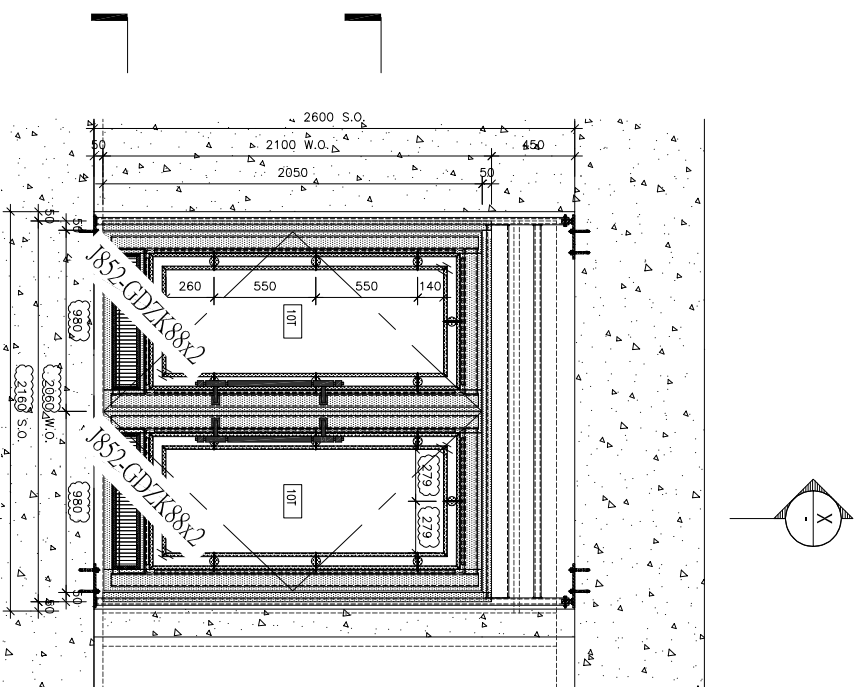


ELEVATION

1605 CLEAR

SECTION X

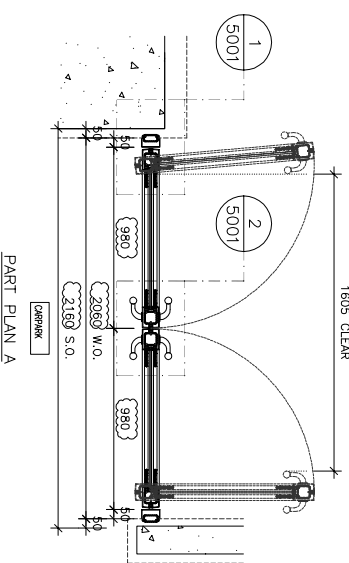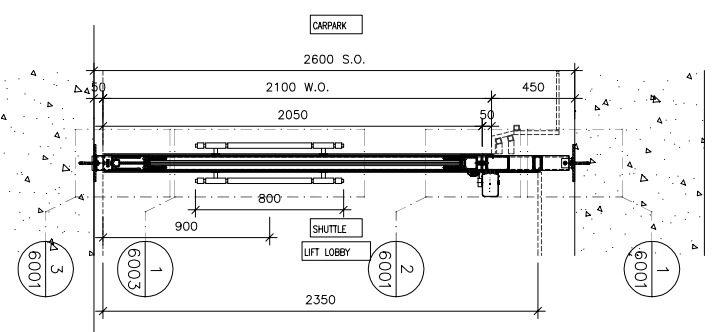

PART PLAN A

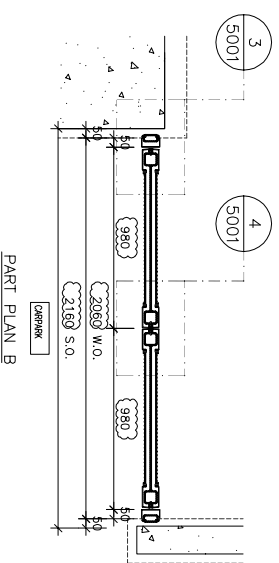

PART PLAN B

NOTE:

1. ALL DIMENSIONS ARE IN mm.
2. ALL ELEVATIONS ARE VIEWED FROM OUTSIDE.
3. ALL DIMENSIONS TO BE VERIFIED ON SITE BEFORE FABRICATION.

LEGEND:

- X1 --- DETAIL MARK NO.
- X001 --- REFER SHEET NO.
- 1. F.F.L. --- FINISHED FLOOR LEVEL
- 2. S.F.L. --- STRUCTURAL FLOOR LEVEL
- 3. (R) --- REVERSED DETAIL
- 4. (2T) --- 12mm THK. TEMPERED GLASS
- 5. (1T) --- 10mm THK. TEMPERED GLASS

NO.	DATE	REVISION
1	18/10/2011	REVISION SUBJECT TO ARCH. COMMENT
2	23/09/2011	REVISION SUBJECT TO ARCH. COMMENT
3	23/09/2011	REVISION SUBJECT TO ARCH. COMMENT
4	10/17/2011	REVISION SUBJECT TO ARCH. COMMENT
5	10/14/2011	REVISION SUBJECT TO ARCH. COMMENT

JOB NO. : J-852

PROJECT : PROPOSED DEVELOPMENT  
AT KOWLOON INLAND,  
LOT Nos. 6035R.P., 6036R.P., 6037R.P.,  
6038R.P., AND LOT No. 6005

TITLE : ELEVATION & PART PLAN  
FOR GLASS WALL(LG2)

DATE : 25-Mar-20 SCALE : 1:40

DRAWN BY : CJM CHECKED BY : DW

Unit 6-8, Sunny Industrial Centre, 1/F  
610 Chee Kwo Ling Road, Kowloon  
Tel: 23489211-4 Fax: 85227272566

美特铝业有限公司  
MIDI ALUMINIUM FABRICATOR LTD.

DWG NO. : J852-PCW-4200 REV : E

FLOOR	LOCATION	GLASS WALL MARK	QTY
LG2	SHUTTLE LIFT LOBBY	S001/LG2	1

BO. REF. :

CLIENT :

ARCHITECT :

AGC DESIGN LTD

MAIN CONTRACTOR :


Gammon

STRUCTURAL ENGINEER :


ARUP

FAÇADE CONSULTANT :


MEINHARDT

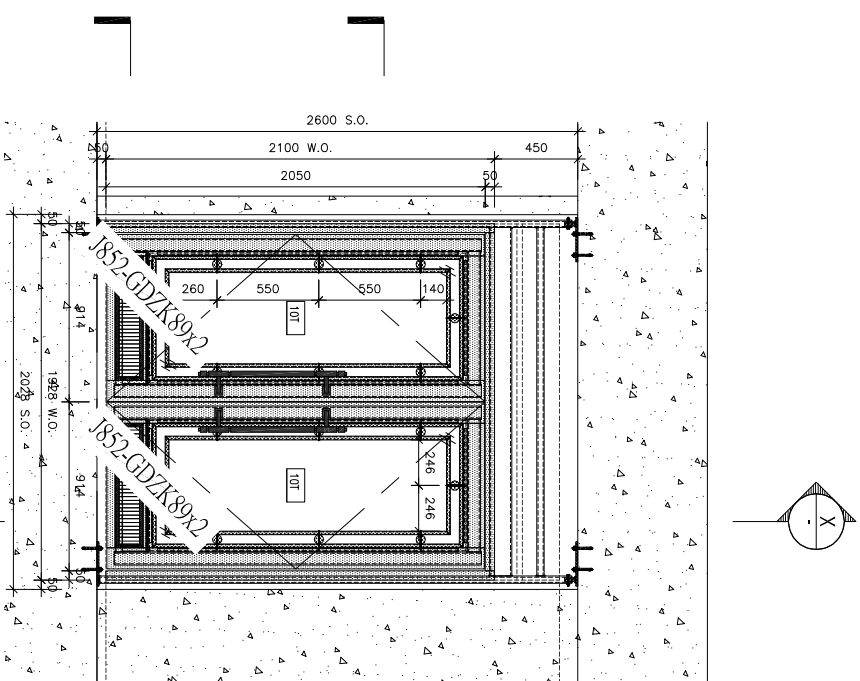


ELEVATION

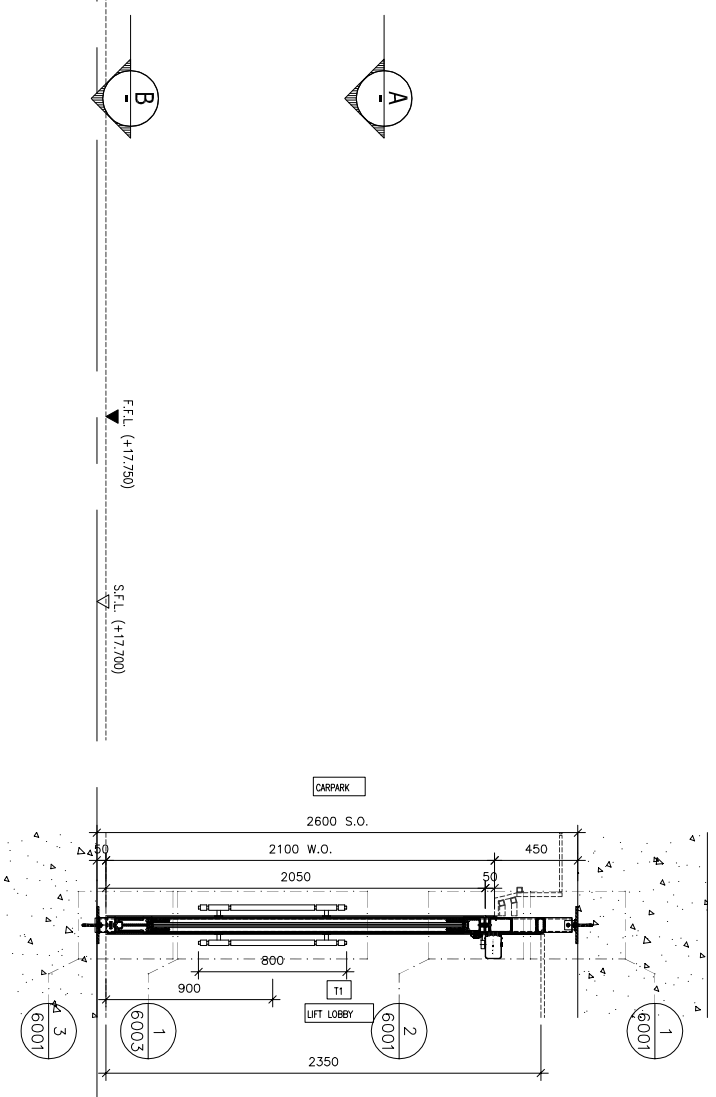

SECTION X

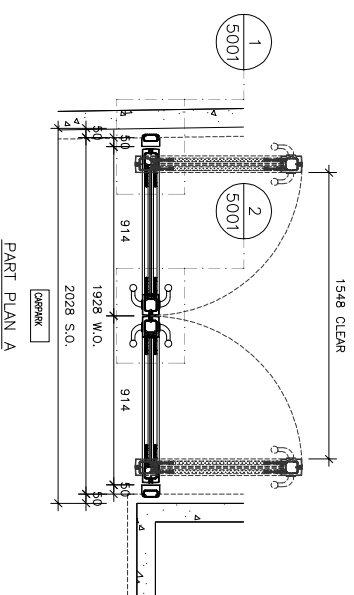

PART PLAN A

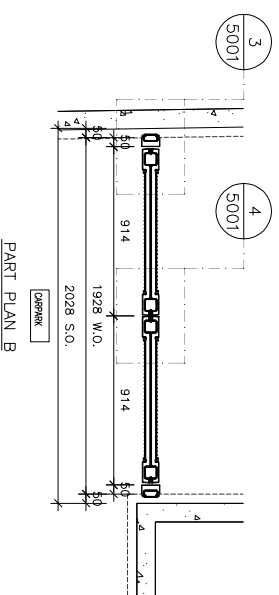

PART PLAN B

BO. REF. :  
 CLIENT :  
 ARCHITECT :  
**AGC DESIGN LTD**  
 2/F, 100, Nathan Road, Kowloon, HONG KONG  
 MAIN CONTRACTOR :  
**Gammon**  
 STRUCTURAL ENGINEER :  
**ARUP**  
 FACILE CONSULTANT:  
**MEINHARDT**

NOTE:  
 1. ALL DIMENSIONS ARE IN MM.  
 2. ALL ELEVATIONS ARE VIEWED FROM OUTSIDE.  
 3. ALL DIMENSIONS TO BE VERIFIED ON SITE BEFORE FABRICATION.

LEGEND:  
 X1 --- DETAIL MARK NO.  
 X001 --- REFER SHEET NO.  
 1. F.F.L. --- FINISHED FLOOR LEVEL  
 2. S.F.L. --- STRUCTURAL FLOOR LEVEL  
 3. (R) --- REVERSED DETAIL  
 4. (12T) --- 12mm THK. TEMPERED GLASS  
 5. (10T) --- 10mm THK. TEMPERED GLASS


NO.	DATE	REVISION
1	23/09/2021	REVISION SUBJECT TO ARCH COMMENT
2	23/09/2021	REVISION SUBJECT TO ARCH COMMENT
3	10/11/2021	REVISION SUBJECT TO ARCH COMMENT
4	10/11/2021	REVISION SUBJECT TO ARCH COMMENT
5	10/11/2021	REVISION SUBJECT TO ARCH COMMENT

JOB NO. : J-852  
 PROJECT : PROPOSED DEVELOPMENT AT KOWLOON INLAND, LOT Nos., 60356P., 60358P., 60359P., 60377R.P., 60388R.P., AND LOT No. 6005  
 TITLE : ELEVATION & PART PLAN FOR GLASS WALL(LG2)

DATE : 25-Mar-20 SCALE : 1:40  
 DRAWN BY : CJM CHECKED BY : DW

**MIDI** 美特鋁質有限公司  
 ALUMINIUM FABRICATOR LTD.  
 Units 6-8, Sunny Industrial Centre, 1/F  
 610 Chee Kwo Ling Road, Kowloon  
 Tel: 2498211-4 Fax: 8532727272727272  
 DMC NO. : JB52-PCW-4201 REV. : D

FLOOR	LOCATION	GLASS WALL MARK	QTY
LG2	TOWER 1 LIFT LOBBY	T101/LG2	1

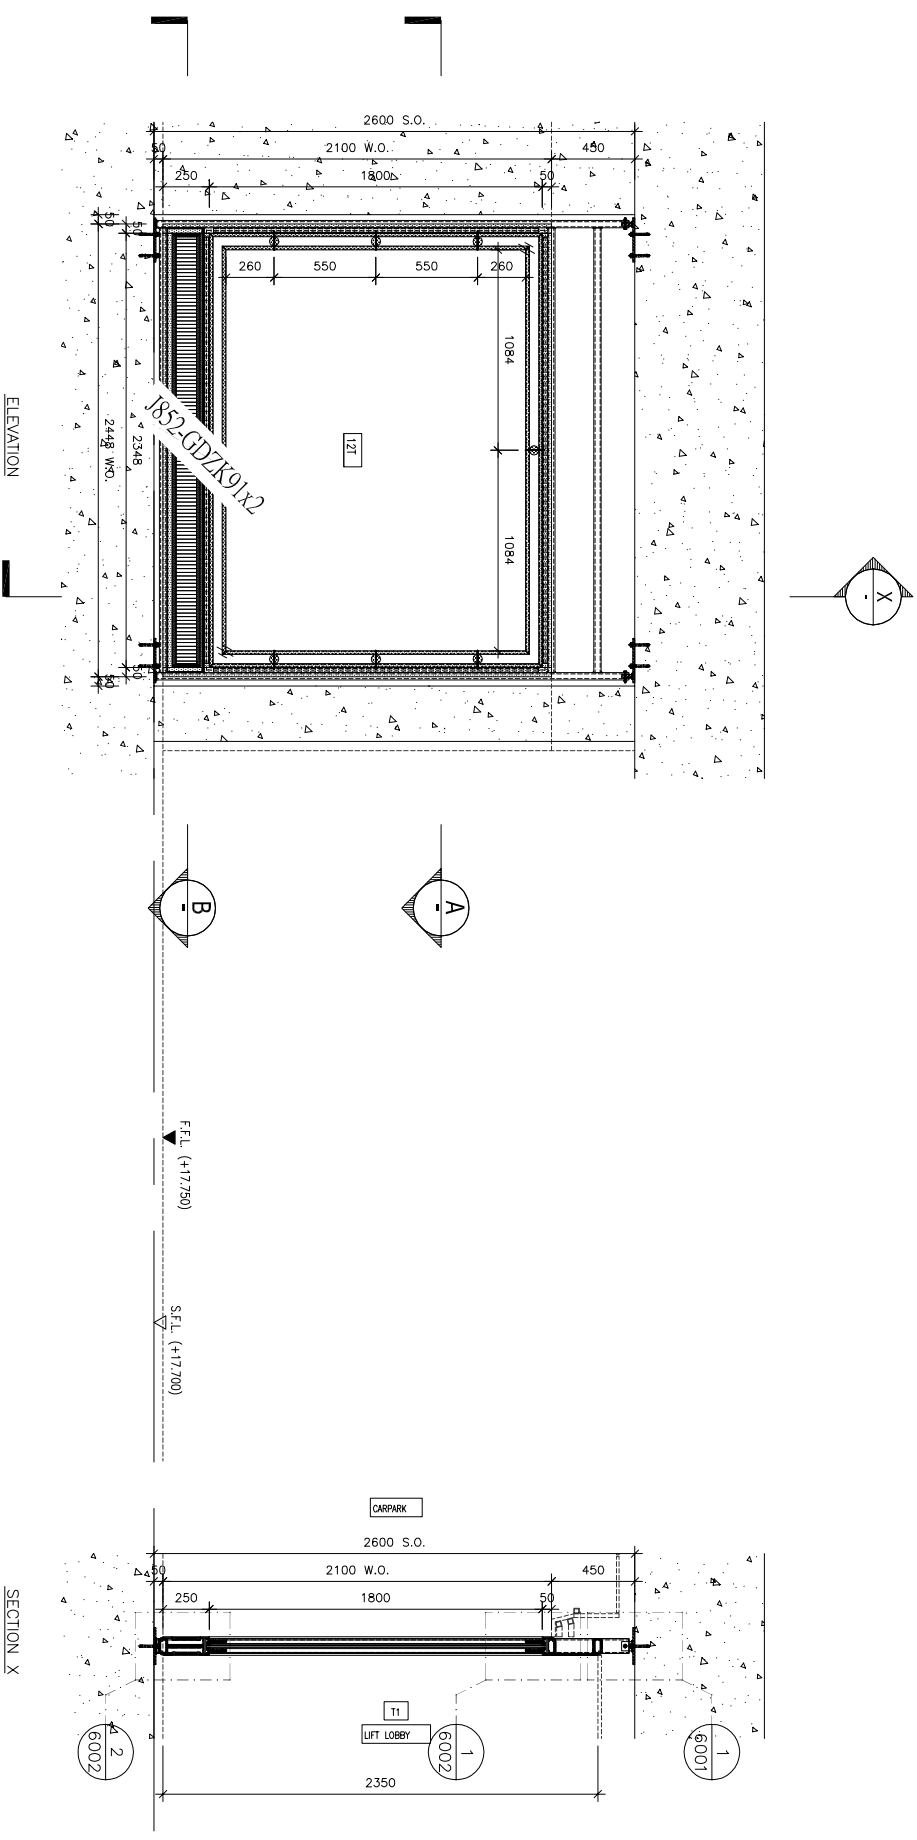

SECTION X

ELEVATION

PART PLAN A

PART PLAN B

- NOTE:
1. ALL DIMENSIONS ARE IN mm.
  2. ALL ELEVATIONS ARE VIEWED FROM OUTSIDE.
  3. ALL DIMENSIONS TO BE VERIFIED ON SITE BEFORE FABRICATION.
- LEGEND:
- X1 --- DETAIL WORK NO.
  - X001 --- REFER SHEET NO.
1. F.F.L. --- FINISHED FLOOR LEVEL
  2. S.F.L. --- STRUCTURAL FLOOR LEVEL
  3.  $\text{\textcircled{R}}$  --- REVERSED DETAIL
  4. 127 --- 12mm THK. TEMPERED GLASS
  5. 107 --- 10mm THK. TEMPERED GLASS

NO.	DATE	REVISION
1	23/09/2021	REVISION SUBJECT TO ARCH COMMENT
2	23/09/2021	REVISION SUBJECT TO ARCH COMMENT
3	10/11/2021	REVISION SUBJECT TO ARCH COMMENT
4	10/11/2021	REVISION SUBJECT TO ARCH COMMENT
5	10/11/2021	REVISION SUBJECT TO ARCH COMMENT

JOB NO. : J-852

PROJECT : PROPOSED DEVELOPMENT AT KOWLOON INLAND, LOT Nos. 6035R.P., 6036R.P., 6037R.P., 6038R.P., AND LOT No. 6005

TITLE : ELEVATION & PART PLAN FOR GLASS WALL(LG2)

DATE : 25-Mar-20 SCALE : 1:40

DRAWN BY : CJM CHECKED BY : DW

**美特铝质有限公司**  
**MIDI ALUMINIUM FABRICATOR LTD.**  
 Units 6-8, Sunny Industrial Centre, 1/F  
 610 Chee Kwo Ling Road, Kowloon  
 Tel: 23498211-4 Fax: 603272727366  
 DMC NO. : JB52-PCW-4202 REV : D

FLOOR	LOCATION	GLASS WALL MARK	QTY
LG2	TOWER 1 LIFT LOBBY	T102/LG2	1

BO. REF. :

CLIENT :



ARCHITECT : **AGC DESIGN LTD**

MAIN CONTRACTOR :


STRUCTURAL ENGINEER : **GAMMON**

FAÇADE CONSULTANT : **ARUP**

**MEINHARDT**

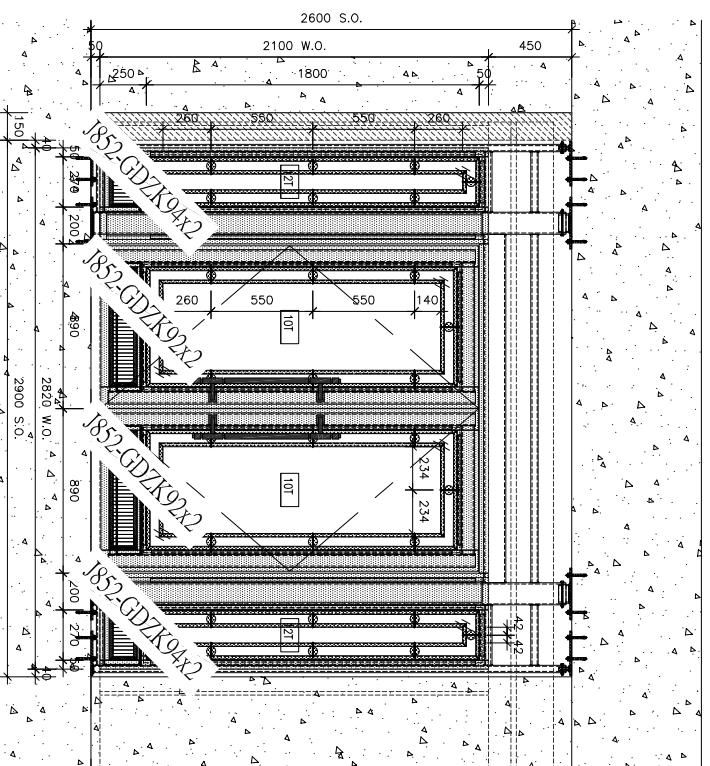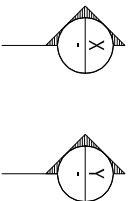


ELEVATION

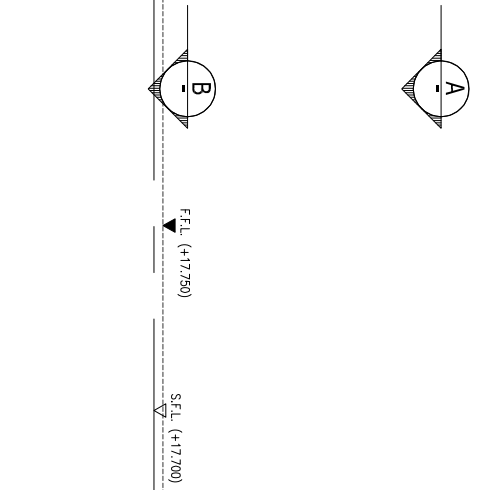


SECTION X

SECTION Y

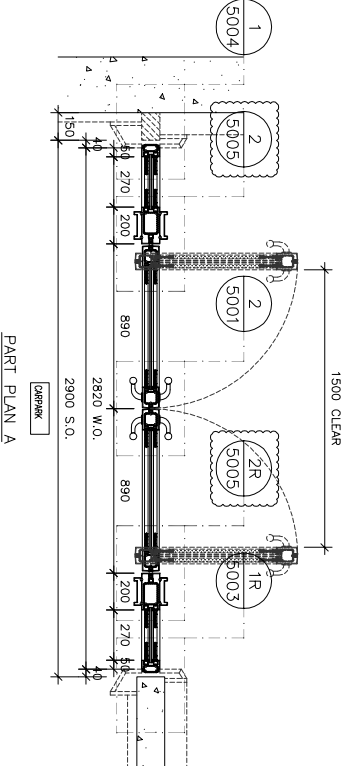

PART PLAN A

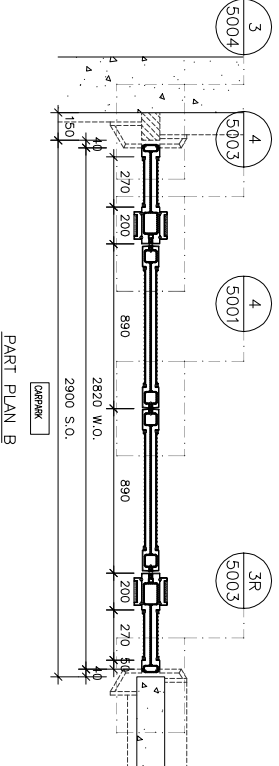

PART PLAN B

FLOOR	LOCATION	GLASS WALL MARK	QTY
LG2	TOWER 2 LIFT LOBBY	T201/LG2	1

BO. REF. :

CLIENT :

ARCHITECT :  
**AGC DESIGN LTD**

MAIN CONTRACTOR :

**Gammou**

STRUCTURAL ENGINEER :

**ARUP**

FIGURE CONSULTANT :

**MEINHARDT**

- NOTE :
- ALL DIMENSIONS ARE IN mm.
  - ALL ELEVATIONS ARE VIEWED FROM OUTSIDE.
  - ALL DIMENSIONS TO BE VERIFIED ON SITE BEFORE FABRICATION.

LEGEND :



- X1 --- DETAIL MARK NO.
- X001 --- REFER SHEET NO.
- 1. F.F.L. --- FINISHED FLOOR LEVEL
- 2. S.F.L. --- STRUCTURAL FLOOR LEVEL
- 3. --- REVERSED DETAIL
- 4. --- 12mm THK. TEMPERED GLASS
- 5. --- 10mm THK. TEMPERED GLASS

NO.	DATE	REVISION
1	18/10/2011	REVISION SUBJECT TO ARCH. COMMENT
2	23/09/2011	REVISION SUBJECT TO ARCH. COMMENT
3	23/09/2011	REVISION SUBJECT TO ARCH. COMMENT
4	10/7/2011	REVISION SUBJECT TO ARCH. COMMENT
5	10/4/2011	REVISION SUBJECT TO ARCH. COMMENT

JOB NO. : J-852  
PROJECT : PROPOSED DEVELOPMENT AT KOWLOON INLAND, LOT Nos., 60356P., 60358P., 60378P., 60388P.P., AND LOT No. 6005

TITLE : ELEVATION & PART PLAN FOR GLASS WALL(LG2)

DATE : 25-Mar-20 SCALE : 1:40  
DRAWN BY : CJM CHECKED BY : DW  
**MIDI 美特铝业有限公司**  
610 Chee Kwo Ling Road, Kowloon  
Tel: 2498211-4 Fax: 65027272/27166  
DWC NO. : JB52-PCW-4203 REV. : E

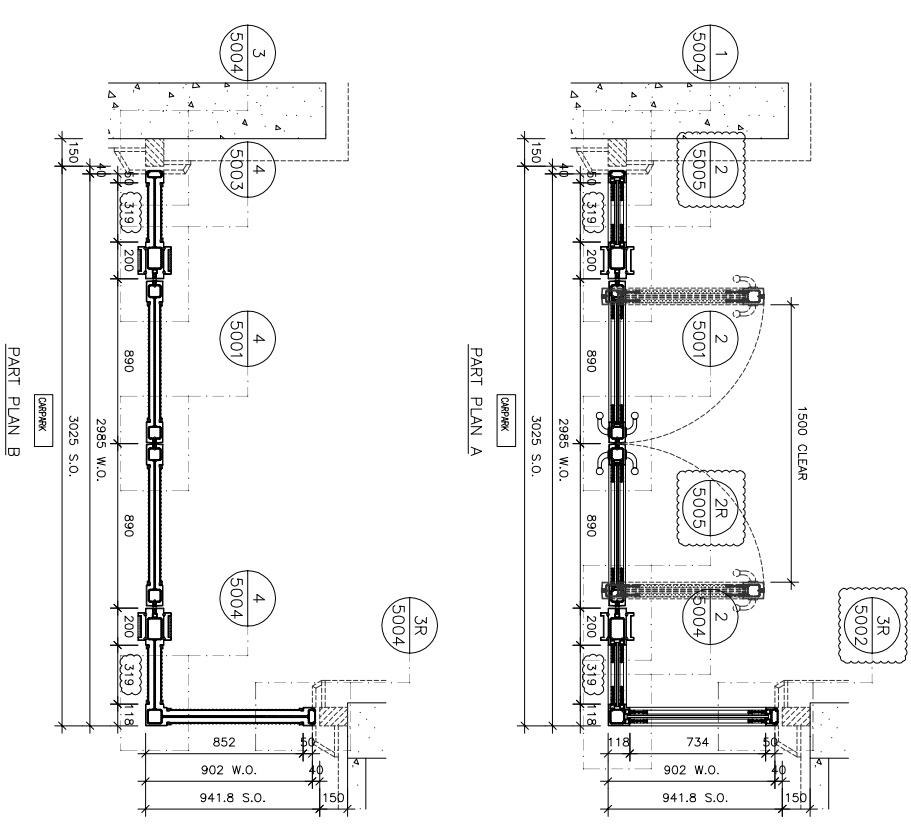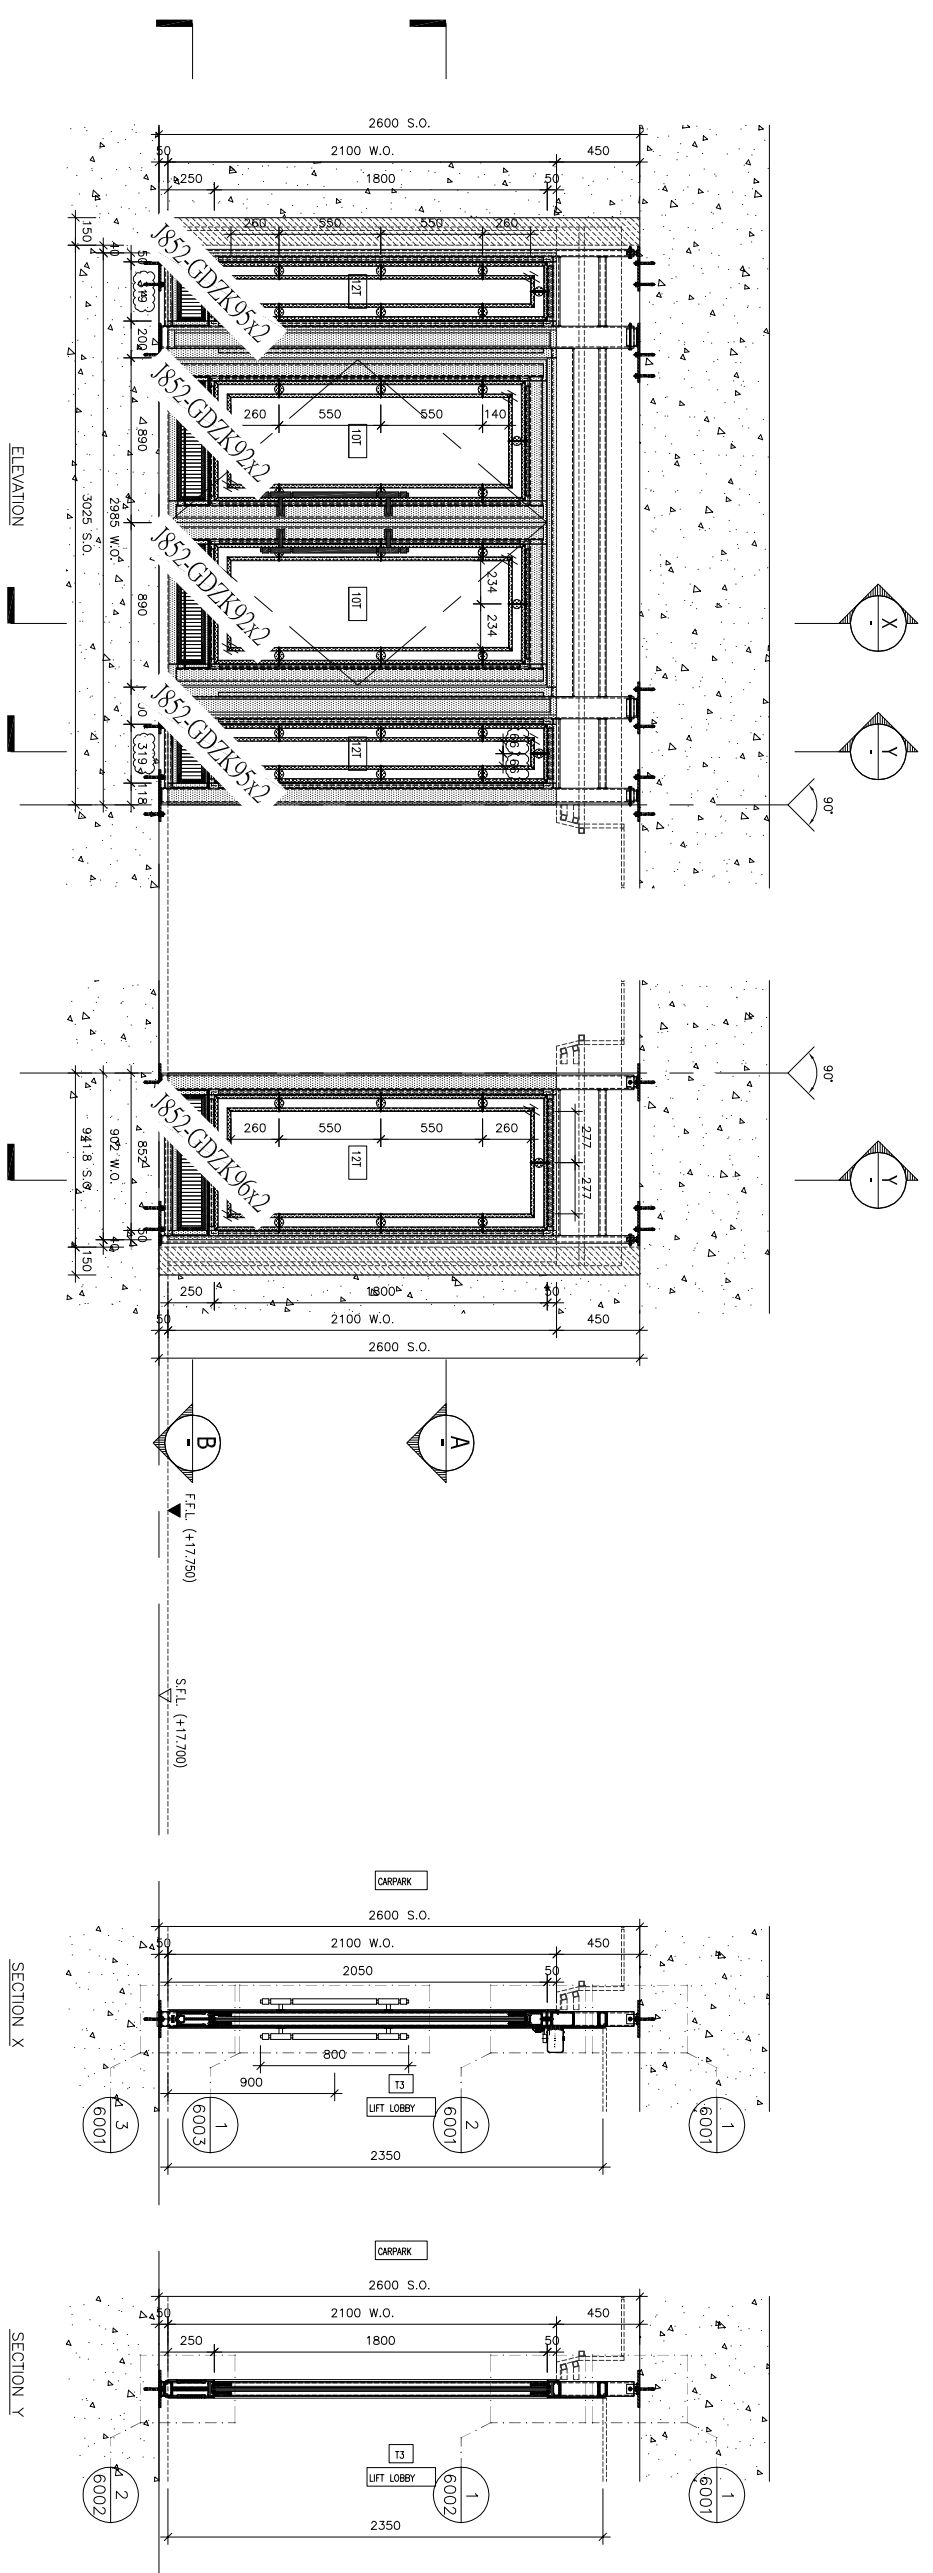

FLOOR	LOCATION	GLASS WALL MARK	QTY
LG2	TOWER 3 LIFT LOBBY	T301/LG2	1

BD REF :

CLIENT :

ARCHITECT : **AGC DESIGN LTD**

MAIN CONTRACTOR :

STRUCTURAL ENGINEER : **GAMMON**

FIGURE CONSULTANT : **ARUP**

MEINHARDT

NOTE :

- ALL DIMENSIONS ARE IN mm.
- ALL ELEVATIONS ARE VIEWED FROM OUTSIDE.
- ALL DIMENSIONS TO BE VERIFIED ON SITE BEFORE FABRICATION.

LEGEND :

X1 --- DETAIL MARK NO.  
X001 --- REFER SHEET NO.

- F.F.L. --- FINISHED FLOOR LEVEL
- S.F.L. --- STRUCTURAL FLOOR LEVEL
- R --- REVERSED DETAIL
- 12T --- 12mm THK. TEMPERED GLASS
- 10T --- 10mm THK. REVERSED GLASS

JOB NO. : J-852

PROJECT : PROPOSED DEVELOPMENT AT KOWLOON INLAND, LOT Nos. 6035R.P., 6036R.P., 6037R.P., 6038R.P., AND LOT No. 6005

TITLE : ELEVATION & PART PLAN FOR GLASS WALL(LG2)

DATE : 25-Mar-20 SCALE : 1:40

DRAWN BY : CJM CHECKED BY : DW



Unit 6-8, Sunny Industrial Centre, 1/F  
610 Chee Kwo Ling Road, Kowloon  
Tel: 2498211-4 Fax: 65027272/27266  
DWC NO. : JB52-PCW-4204 REV : E

NO.	DATE	REVISION
1	16/01/2011	REVISION SUBJECT TO ARCH. COMMENT
2	23/09/2011	REVISION SUBJECT TO ARCH. COMMENT
3	23/09/2011	REVISION SUBJECT TO ARCH. COMMENT
4	10/11/2011	REVISION SUBJECT TO ARCH. COMMENT
5	19/04/2011	REVISION SUBJECT TO ARCH. COMMENT

Unit 6-8, Sunny Industrial Centre, 1/F  
610 Chee Kwo Ling Road, Kowloon  
Tel: 2498211-4 Fax: 65027272/27266  
DWC NO. : JB52-PCW-4204 REV : E

美特铝业有限公司  
MIDI ALUMINIUM FABRICATOR LTD.

Unit 6-8, Sunny Industrial Centre, 1/F  
610 Chee Kwo Ling Road, Kowloon  
Tel: 2498211-4 Fax: 65027272/27266  
DWC NO. : JB52-PCW-4204 REV : E

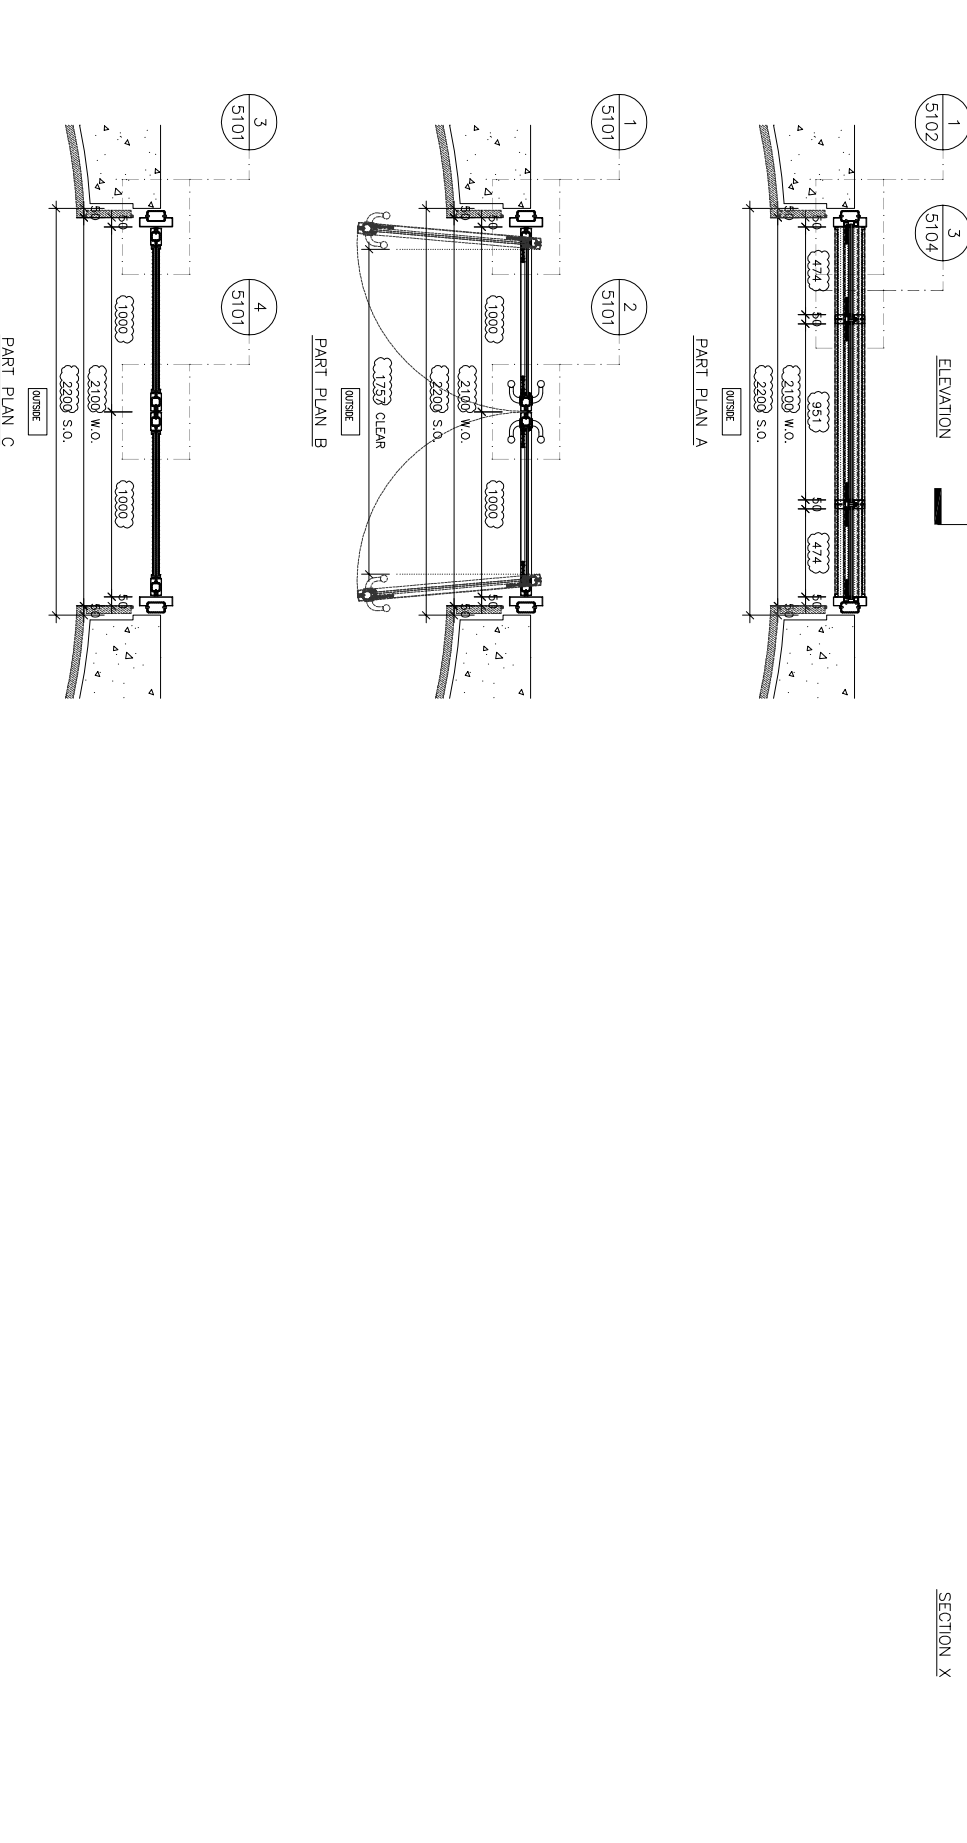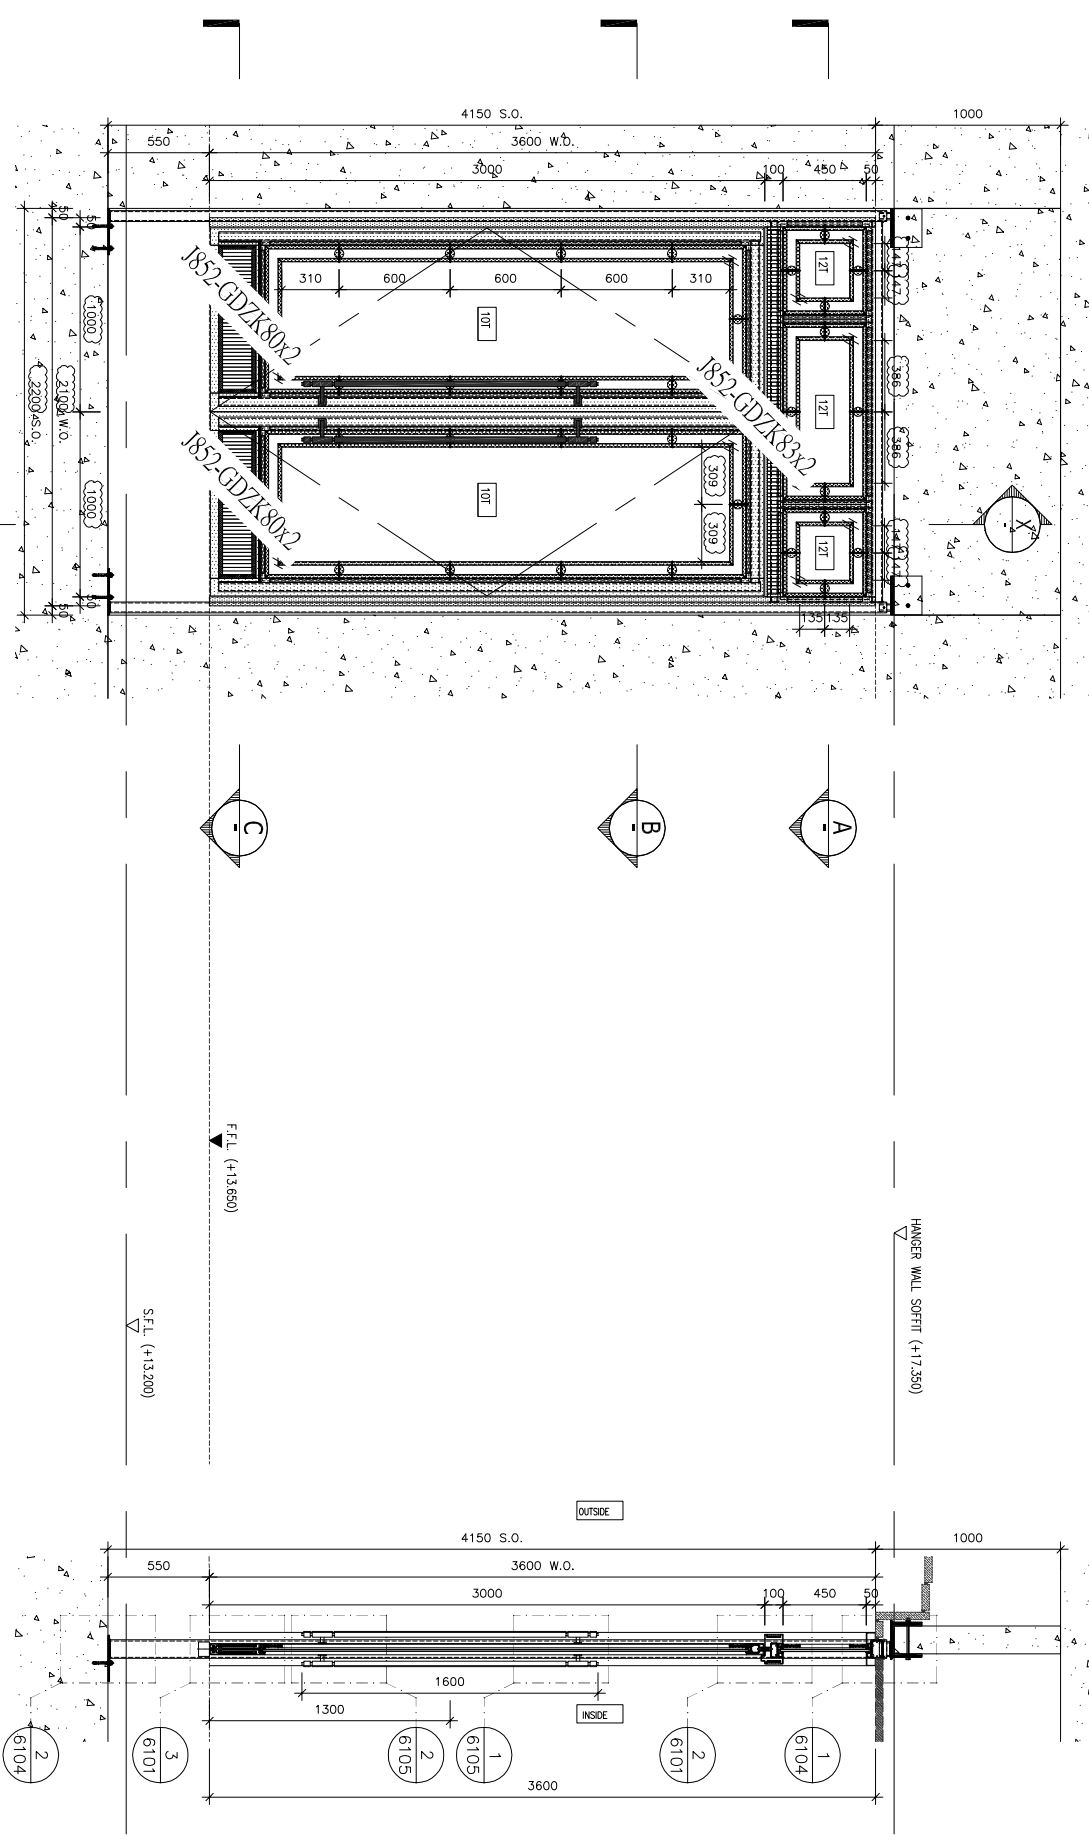

FLOOR	LOCATION	GLASS WALL MARK	QTY
LG1	SHUTTLE LIFT LOBBY	S001/LG1	1

BO. REF. :

CLIENT :

ARCHITECT : **AGC DESIGN LTD**

MAIN CONTRACTOR :

STRUCTURAL ENGINEER : **GAMMON**

FAÇADE CONSULTANT : **ARUP**

GLASS FABRICATOR : **MEINHARDT**

PROJECT : PROPOSED DEVELOPMENT AT KOWLOON INLAND, LOT Nos. 6035R.P., 6036R.P., 6037R.P., 6038R.P., AND LOT No. 6005

TITLE : ELEVATION & PART PLAN FOR GLASS WALL(G1)

DATE : 25-Mar-20 SCALE : 1:40

DRAWN BY : CJM CHECKED BY : DW

Unit 6-8, Sunny Industrial Centre, 1/F  
610 Chee Kwo Ling Road, Kowloon  
Tel: 2498211-4 Fax: 65027272  
MIDI ALUMINIUM FABRICATOR LTD.

DWG NO. : JB52-PCW-4100 REV. : C

JOB NO. : J-852

NO. DATE REVISION

1. ALL DIMENSIONS ARE IN MM.  
2. ALL ELEVATIONS ARE VIEWED FROM OUTSIDE.  
3. ALL DIMENSIONS TO BE VERIFIED ON SITE BEFORE FABRICATION.

LEGEND :

X1 --- DETAIL MARK NO.  
X001 --- REFER SHEET NO.

1. F.F.L. --- FINISHED FLOOR LEVEL  
2. S.F.L. --- STRUCTURAL FLOOR LEVEL  
3.  $\overleftarrow{R}$  --- REVERSED DETAIL  
4. 12T --- 12mm THK. TEMPERED GLASS  
5. 10T --- 10mm THK. REVERSED GLASS



## 鋁材開料總表

工程號碼: J-852 工程名稱: 亞皆老街

序號	鋁料編號	名稱	表面處理		開料長度	實用長料總數量		浪費率(%)
			顏色	層厚		支數	長度	
1	X86038		灰色		5800	60	348000	0.40

送至: \_\_\_\_\_

由: \_\_\_\_\_

日期: \_\_\_\_\_

簡短說明: \_\_\_\_\_

共2頁 第1頁

打印日期: 2021/11/17 打印時間: 17:11

鋁材開料清單 X86038

鋁料 長度	窗號	編號(用料狀況)	實用長度(長料開數)	需要 支數	開料 支數	長料 支數	餘料 支數	編號(剩餘長度)
5800	J852-GDAL31-01, J852-GDAL31-02, J852-GDAL31-02a	(餘料)24, 26, 26	158.0	952	54	0	3	24@(110)x1 26@(3674)x1 26@(110)x1
5800	J852-GDAL30-01, J852-GDAL31-01, J852-GDAL31-02a	1-28	158.0		898	28	0	1-23@(110)x23 24@(3998)x1 25@(110)x1 26@(4970)x1 27@(110)x1 28@(4646)x1
5800	J852-GDAL30-04, J852-GDAL31-08, J852-GDAL31-09, J852-GDAL31-10, J852-GDAL31-11, J852-GDAL31-12, J852-GDAL31-13, J852-GDAL31-14, J852-GDAL31-15	(餘料)28, 46, 46-47, 47, 47-49, 49	108.0	1086	141	0	9	28@(54)x1 46@(180)x1 46@(68)x1 47@(2308)x1 47@(1860)x1 47-48@(68)x2 49@(3428)x1 49@(2980)x1
5800	J852-GDAL30-04, J852-GDAL31-09, J852-GDAL31-12, J852-GDAL31-13	29-49	108.0		945	21	0	29-45@(68)x17 46@(3764)x1 47@(3204)x1 48@(2196)x1 49@(5220)x1
5800	J852-GDAL30-02, J852-GDAL31-03, J852-GDAL31-04, J852-GDAL31-05, J852-GDAL31-06	(餘料)1-27, 49, 58, 58, 58-59	68.0	800	128	0	32	1-27@(38)x27 49@(28)x1 58@(884)x1 58@(308)x1 58@(20)x1 59@(4916)x1
5800	J852-GDAL30-02, J852-GDAL31-05	50-59	68.0		672	10	0	50-57@(20)x8 58@(3764)x1 59@(5492)x1
5800	J852-GDAL30-03, J852-GDAL31-07	(餘料)1-49, 59-60	18.0	544	377	0	51	1-27@(16)x27 28@(10)x1 29-48@(2)x20 49@(6)x1 59@(10)x1 60@(698)x1
5800	J852-GDAL30-03	60	18.0		167	1	0	60@(2106)x1