

工程指示 / 要求簡箋(E.I.)

工程指示編號：EI / 4288 / 22

修改版次：-

工程編號：J - 858

工程名稱：將軍澳日出康城 11

工程項目：Showflat 用幕牆玻璃(奧海城 showflat,寶發用玻璃)(補訂)

收件人：Maggie

發件人：Eric Liu

日期：13/01/2022

要求提供 / 確認 事項：

- | | | |
|------------------------------------|-------------------------------------|-------------------------------|
| <input type="checkbox"/> 初步鋁料 B.M. | <input type="checkbox"/> 加工拆圖，然後生產 | <input type="checkbox"/> 尺寸表 |
| <input type="checkbox"/> 正式鋁料 B.M. | <input type="checkbox"/> 技術上資料 / 指示 | <input type="checkbox"/> 報價 |
| <input type="checkbox"/> 配件 B.M. | <input type="checkbox"/> 樣辦或貨品說明書 | <input type="checkbox"/> 分判合約 |

內容：

請按 BM 訂購玻璃送地盤

EI4154 已訂 59 件，13/01/2022 收到寶發電郵修改玻璃 BM，共需要 83 件，此 EI 補訂 24 件

地址：奧海城 1 期 shop#101

聯絡人：Ken, 90629019

請在 2022.01.27 前完成上列要求。

附：1 頁 BM

以上項目為：

- 原合約工程包 原合約工程加 / 減賬 新工程報價

原因：-

分發東莞各部門：

- () 生產技術總監 連附件 () 技術部 連附件 () 生產部 連附件 () 機械設計部 連附件
 () 採購部 連附件 () 生產統籌部 連附件 () 小羅&清 連附件
 () 質檢部 連附件 () 會計部 連附件 () 報關組 連附件 () 其他 楊榮輝 連附件

分發其他分判：

分發香港各部門：


- () 行政部 連附件 () 會計部 連附件 () 統籌部 連附件 () 工程部地盤科文 連附件
 () 採購部 連附件 () QS 部 連附件 () 維修部 連附件 () 其他 _____ 連附件

傳遞編號：

HK 122

發件人簽署：

項目經理簽署：

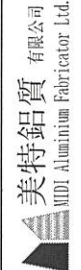


美特鋁質有限公司
MIDI Aluminum Fabricator Ltd.

地盤用玻璃B.M.表

BM編號:		工程號:	J-858	計算:	日期:	送呈:		
修改內容		地盤名稱:	康城11	核對:	日期:	副本:		
玻璃圖號		項目類別:	Show flat幕牆玻璃	批准:	日期:	A/C Code:		
修改內容		修改版次:		此BM依據				
顏色與類型		總計玻璃面積 (平方米):		15.812				
序號	玻璃圖號	厚度 (mm)	玻璃尺寸			數量 (塊)	總面積 (平方米)	備註
			寬度 (mm)	高度 (mm)	面積 (mm²)			
1	3G1-01	34.0	626.5	2349.0	1	1.472	詳見加工圖858-VMU-BL01	
2	3G1-02	34.0	1755.5	2349.0	1	4.124	詳見加工圖858-VMU-BL01	
3	3G1-03	34.0	528.0	2349.0	1	1.240	詳見加工圖858-VMU-BL01	
7				合計	3	6.836		
8	3G2-01	32.0	664.0	1456.5	2	1.934	詳見加工圖858-VMU-BL02	
9	3G2-02	32.0	564.0	1456.5	1	0.821	詳見加工圖858-VMU-BL02	
12	3G2-05	32.0	664.0	849.5	2	1.128	詳見加工圖858-VMU-BL02	
13	3G2-06	32.0	564.0	849.5	1	0.479	詳見加工圖858-VMU-BL02	
16				合計	6	4.363		
17	3G3-01	12	626.5	362.5	1	0.227	詳見加工圖858-VMU-BL03	
18	3G3-02	12	664.0	362.5	1	0.241	詳見加工圖858-VMU-BL03	
19	3G3-03	12	664.0	577.5	1	0.383	詳見加工圖858-VMU-BL03	
20	3G3-04	12	1755.5	577.5	1	1.014	詳見加工圖858-VMU-BL03	
21	3G3-05	12	528.0	577.5	1	0.305	詳見加工圖858-VMU-BL03	
22	3G3-06	12	564.0	577.5	1	0.326	詳見加工圖858-VMU-BL03	
31	3G3-15	12	626.5	387.5	1	0.243	詳見加工圖858-VMU-BL03	
32	3G3-16	12	664.0	387.5	2	0.515	詳見加工圖858-VMU-BL03	
33	3G3-17	12	1755.5	387.5	1	0.680	詳見加工圖858-VMU-BL03	
34	3G3-18	12	528.0	387.5	1	0.205	詳見加工圖858-VMU-BL03	
35	3G3-19	12	564.0	387.5	1	0.219	詳見加工圖858-VMU-BL03	
40				合計	12	4.356		
41	3G4-01	12.0	624.0	145.0	2	0.181	詳見加工圖858-VMU-BL04	
42	3G4-02	12.0	524.0	145.0	1	0.076	詳見加工圖858-VMU-BL04	
45				合計	3	0.257		
46				總計	24	15.81		

加工注意事項:

- 1).本表中所採用之玻璃為信義玻璃廠出品之玻璃原片
- 2).本表中所有玻璃對角線尺寸偏差要求不超過正負2mm。
- 3).本表中所有玻璃要求粗磨邊處理並倒稜角。
- 4).本表中不同種類玻璃參照玻璃加工圖加工。
- 5).本表中所有強化玻璃均需HEAT SOAK TEST。
- 6).本表中所有玻璃之入櫃方向均以寬度方向進入。
- 7).本表中所有玻璃成品送交東莞美而特廠，每次交貨時須齊層、齊款、齊數量，每次來貨之具體數量由美而特廠生產統籌部提供。
- 8).本表中所有玻璃成品均需注明室內外面及其玻璃編號，以便識別。


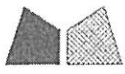


美特鋁質 有限公司
MIDI Aluminium Fabricator Ltd.


工程號	J858	地盤	荃灣
-----	------	----	----

玻璃編號	W	H	數量
A-1	659.5	2351.0	1
A-2	1764.5	2351.0	1
A-3	537.0	2351.0	1
合計		共3幅	

G1

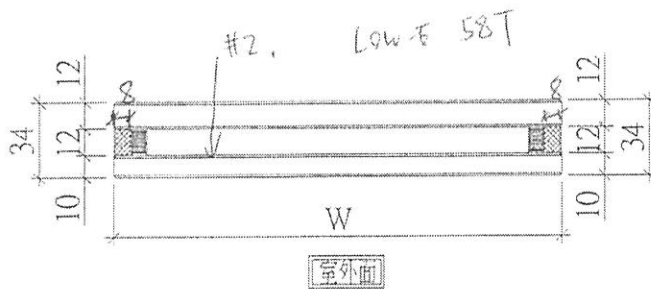
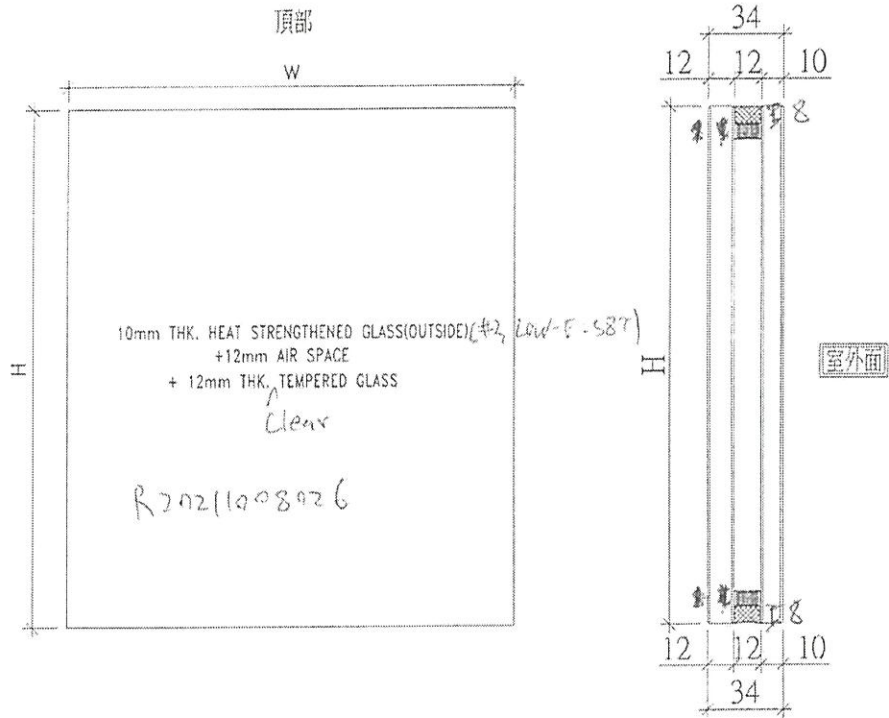


名稱	玻璃拆圖	制圖	WYY	2021.11.29	修改		
材料	-	復核			日期		
顏色	-	批准			圖號	858-VMU-BL01	

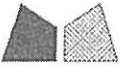 美特鋁質 有限公司 MIDI Aluminium Fabricator Ltd.			
工程號	J858	地盤	荃灣

玻璃編號	W	H	數量
B-1	667.0	1756.0	2
B-2	667.0	556.0	2
B-3	582.0	1756.0	1
B-4	582.0	556.0	1
B-5	567.0	1756.0	1
B-6	567.0	556.0	1
合計	共8幅		

Q2

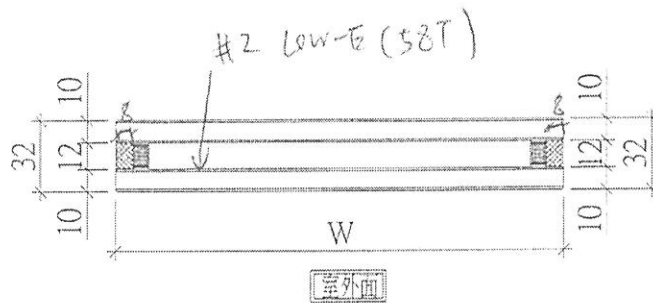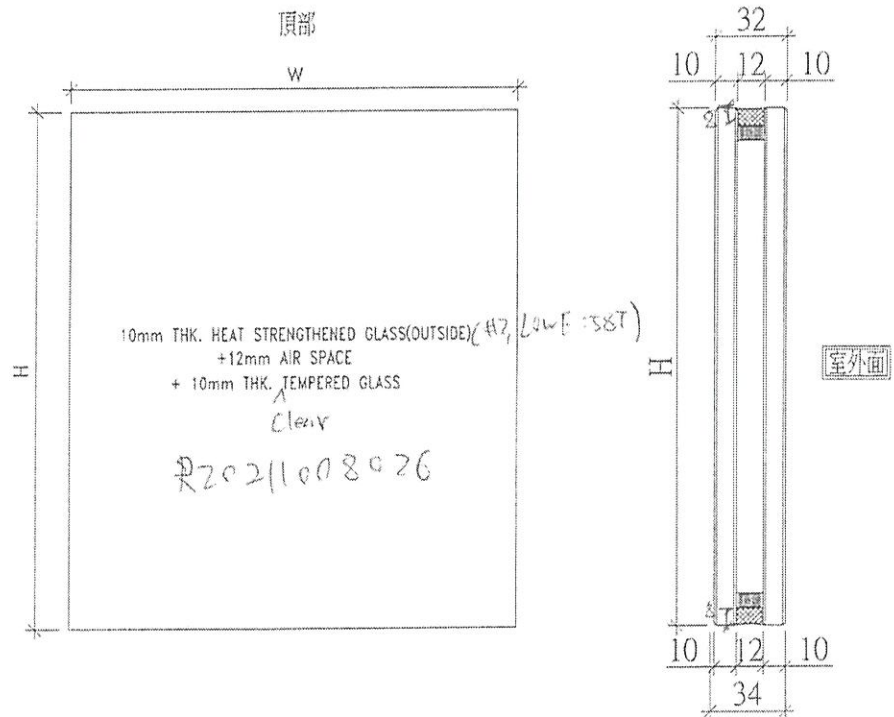


名稱	玻璃拆圖	制圖	WYY	2021.11.29	修改		
材料	-	復核			日期		
顏色	-	批准			圖號	858-VMU-BL02	

 美特鋁質 有限公司 MIDI Aluminium Fabricator Ltd.			
工程號	J858	地盤	荃灣

玻璃編號	寬度W	高度H	數量
C-1	659.5	453.5	1
C-2	667.0	453.5	1
C-3	667.0	661.0	1
C-4	1764.5	661.0	1
C-5	537.0	661.0	1
C-6	582.0	453.5	1
C-7	659.5	311.0	1
C-8	667.0	311.0	2
C-9	1764.5	311.0	1
C-10	537.0	311.0	1
C-11	582.0	311.0	1
C-12	567.0	661.0	1
C-13	567.0	311.0	1
合計		共14幅	

G3

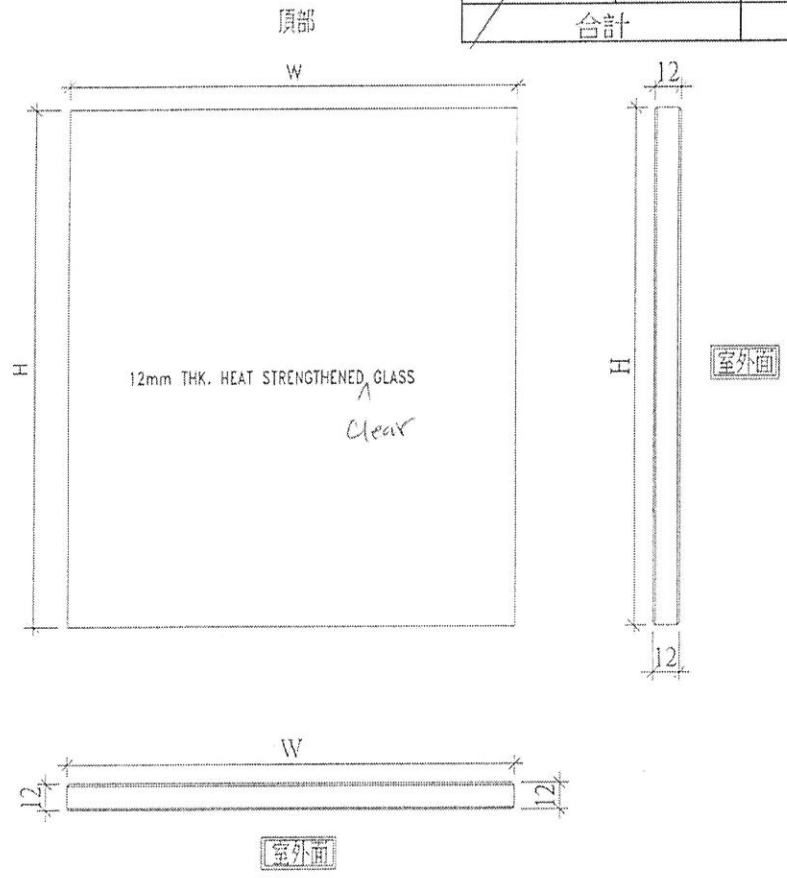

名稱	玻璃拆圖	制圖	WYY	2021.11.29	修改		
材料	-	復核			日期		
顏色	-	批准			圖號	858-VMU-BL03	

From: <tobylam@polyfair.corp.com.hk>
To: <jason.lcs.midi@gmail.com>, <midi@midiltd.com.hk>, <eric.lkw.midi@gmail.com>
Subject: RE: LP11 - Polyfair Drawing Submission - DT06 (S3) Sales Office Mock up 2nd submission
Date sent: Thu, 13 Jan 2022 14:55:57 +0800
Copies to: "Ginny Chau" <ginnychau@rlphk.com>, "florence cheung" <florencecheung@rlphk.com>, "Yuen Fun Wong" <yfwong@rlphk.com>, "Marina TONG [RLPHK]" <marinatong@rlphk.com>, "Monnie" <Monnie.lee@aecom.com>, "Chan Pui Huen" <chanpuihuen@sino.com>, "Wilson Cheng" <wilsoncheng@sino.com>, <herbertthung@sino.com>, "Francis Lai" <francislai@sino.com>, "Andy Chan Yan Wai" <andywchan@sino.com>, "Wilfred Tam" <wilfredtam@sino.com>, "Yung Sik Hon" <yungsikhon@sino.com>, "Eddy Zhang" <eddyzhang@sino.com>, "Janie Share" <janieshare@sino.com>, "johnny" <johnny@polyfair.corp.com.hk>, <clarence@polyfair.corp.com.hk>, <kmw@polyfair.corp.com.hk>, <jingochow@polyfair.corp.com.hk>, <kmw_pf@hotmail.com>, <cskong@polyfair.corp.com.hk>, <may@fusion.com.hk>, "Crystal Cheng" <crystalcheng@fusion.com.hk>, <williamcheung@fusion.com.hk>, <tobylam_polyfair@163.com>, <tobylam_polyfair@163.com>

Dear Midi,

Please find the **revised glass BOM** for curtain wall at show flat for glass order and superseded the bom S3-GS-01, S3-GS-02 sent on 14,16/12/2021.

Thank you for your attention.

Best Regards,

Toby Lam
Polyfair Construction & Engineering Ltd.
Room 1206-7, 12/F., Fortress Tower,
250 King's Road, North Point, Hong Kong
P +852-3595 2227 | M +852-9347 6196
F +852-3595 2177 | E tobylam@polyfair.corp.com.hk

From: tobylam@polyfair.corp.com.hk <tobylam@polyfair.corp.com.hk>
Sent: Thursday, December 16, 2021 2:40 PM
To: 'jason.lcs.midi@gmail.com' <jason.lcs.midi@gmail.com>; 'midi@midiltd.com.hk' <midi@midiltd.com.hk>
Cc: 'Ginny Chau' <ginnychau@rlphk.com>; 'florence cheung' <florencecheung@rlphk.com>; 'Yuen Fun Wong' <yfwong@rlphk.com>; 'Marina TONG [RLPHK]' <marinatong@rlphk.com>; 'Monnie' <Monnie.lee@aecom.com>; 'Chan Pui Huen' <chanpuihuen@sino.com>; 'Wilson Cheng' <wilsoncheng@sino.com>; 'herbertthung@sino.com' <herbertthung@sino.com>; 'Francis Lai' <francislai@sino.com>; 'Andy Chan Yan Wai' <andywchan@sino.com>; 'Wilfred Tam' <wilfredtam@sino.com>; 'Yung Sik Hon' <yungsikhon@sino.com>; 'Eddy Zhang' <eddyzhang@sino.com>; 'Janie Share' <janieshare@sino.com>; 'johnny' <johnny@polyfair.corp.com.hk>; 'clarence@polyfair.corp.com.hk' <clarence@polyfair.corp.com.hk>; 'kmw@polyfair.corp.com.hk' <kmw@polyfair.corp.com.hk>; 'jingochow@polyfair.corp.com.hk' <jingochow@polyfair.corp.com.hk>; 'kmw_pf@hotmail.com'

2022-1-13 更新收單 B.M

Glass Panel Distribution Table

Project : PROPOSED RESIDENTIAL DEVELOPMENT AT TKOTL70RP, PHASE 11, LOHAS PARK, TSEUNG KWAN O, N.T.
Job No.: PF-21006
Title: (S3) VMU FOR SALES OFFICE MOCK-UP
Type:

Reference No.: S3-GPL-01
Date : 15/12/21
Revision No.: B
Date : 29/12/21

只補訂此數量
↓

Tag No.	Glass Type	Panel Type	Module Dimension		Glass Panel Size		Glass Area (m ²)	Unit Weight (kg)	MOCK-UP	Total Quantity	已到貨	需要補訂 (2022/1/13 截止Mid)	Total Glass Area (m ²)	Revision	Glazing type ref. no.	Glazing frame ref. no.	Remarks (Ref. Fab. Drawing Of Glass Panel)
			Width (mm)	Height (mm)	Width (mm)	Height (mm)											
3G1-01	CW-G1	Fixed Vision	662.5	2395.0	626.5	2349.0	1.47	82.9	2	2	1	1	2.94	B			S3-G01-001
3G1-02	CW-G1	Fixed Vision(Corner)	1847.5	2395.0	1755.5	2349.0	4.12	232.2	3	3	2	1	12.37	B			S3-G01-001
3G1-03	CW-G1	Fixed Vision(Corner)	620.0	2395.0	528.0	2349.0	1.24	69.9	3	3	2	1	3.72	B			S3-G01-001
3G1-04	CW-G1	Fixed Vision	612.5	2395.0	576.5	2349.0	1.35	76.3	1	1	1	0	1.35				S3-G01-001
3G1-05	CW-G1	Fixed Vision	1512.5	2395.0	1476.5	2349.0	3.47	195.3	1	1	1	0	3.47				S3-G01-001
3G1-06	CW-G1	Fixed Vision	837.5	2395.0	801.5	2349.0	1.88	106.0	1	1	1	0	1.88				S3-G01-001
Total :									11	11	8	3	25.74	B			
													0				
3G2-01	CW-G2	Openable Sash	700.0	1500.0	664.0	1456.5	0.97	49.5	5	5	3	2	4.84	B			S3-G02-001
3G2-02	CW-G2	Openable Sash	600.0	1500.0	564.0	1456.5	0.82	42.1	3	3	2	1	2.46	B			S3-G02-001
3G2-03	CW-G2	Openable Sash	632.5	1500.0	596.5	1456.5	0.87	44.5	1	1	1	0	0.87	A			S3-G02-001
3G2-04	CW-G2	Openable Sash	612.5	1500.0	576.5	1456.5	0.84	43.0	1	1	1	0	0.84	A			S3-G02-001
3G2-05	CW-G2	Fixed Vision	700.0	895.0	664.0	849.5	0.56	28.9	5	5	3	2	2.82	B			S3-G02-001
3G2-06	CW-G2	Fixed Vision	600.0	895.0	564.0	849.5	0.48	24.5	3	3	2	1	1.44	B			S3-G02-001
3G2-07	CW-G2	Fixed Vision	632.5	895.0	596.5	849.5	0.51	25.9	1	1	1	0	0.51	A			S3-G02-001
3G2-08	CW-G2	Fixed Vision	612.5	895.0	576.5	849.5	0.49	25.1	1	1	1	0	0.49	A			S3-G02-001
Total :									20	20	14	6	14.26	B			
													0				
3G3-01	CW-G3	Fixed Spandrel	662.5	625.0	626.5	362.5	0.23	7.0	2	2	1	1	0.45	B			S3-G03-001
3G3-02	CW-G3	Fixed Spandrel	700.0	625.0	664.0	362.5	0.24	7.4	3	3	2	1	0.72	B			S3-G03-001
3G3-03	CW-G3	Fixed Spandrel	700.0	625.0	664.0	362.5	0.24	7.4	2	2	1	1	0.72	B			S3-G03-001
3G3-04	CW-G3	Fixed Spandrel(Corner)	1847.5	625.0	1755.5	362.5	0.31	10.6	2	2	1	1	2.03	B			S3-G03-001
3G3-05	CW-G3	Fixed Spandrel(Corner)	620.0	625.0	528.0	362.5	0.30	9.4	2	2	1	1	0.61	B			S3-G03-001
3G3-06	CW-G3	Fixed Spandrel	600.0	625.0	564.0	362.5	0.33	10.0	2	2	1	1	0.65	B			S3-G03-001
3G3-07	CW-G3	Fixed Spandrel	632.5	625.0	596.5	362.5	0.34	10.6	1	1	1	0	0.34	A			S3-G03-001
3G3-08	CW-G3	Fixed Spandrel	612.5	625.0	576.5	362.5	0.33	10.2	1	1	1	0	0.33	A			S3-G03-001
3G3-09	CW-G3	Fixed Spandrel	600.0	625.0	564.0	362.5	0.20	6.3	1	1	1	0	0.20	A			S3-G03-001
3G3-10	CW-G3	Fixed Spandrel(Corner)	620.0	625.0	528.0	362.5	0.19	5.9	1	1	1	0	0.19	A			S3-G03-001
3G3-11	CW-G3	Fixed Spandrel(Corner)	1847.5	625.0	1755.5	362.5	0.64	19.5	1	1	1	0	0.64	A			S3-G03-001
3G3-12	CW-G3	Fixed Spandrel	1512.5	625.0	1476.5	362.5	0.54	16.4	1	1	1	0	0.54	A			S3-G03-001
3G3-13	CW-G3	Fixed Spandrel	612.5	625.0	576.5	362.5	0.21	6.4	1	1	1	0	0.21	A			S3-G03-001
3G3-14	CW-G3	Fixed Spandrel	837.5	625.0	801.5	362.5	0.29	8.9	1	1	1	0	0.29	A			S3-G03-001
3G3-15	CW-G3	Fixed Spandrel	662.5	425.0	626.5	387.5	0.24	7.5	2	2	1	1	0.49	B			S3-G03-001
3G3-16	CW-G3	Fixed Spandrel	700.0	425.0	664.0	387.5	0.26	7.9	5	5	3	2	1.29	B			S3-G03-001
3G3-17	CW-G3	Fixed Spandrel(Corner)	1847.5	425.0	1755.5	387.5	0.88	20.9	3	3	2	1	2.04	B			S3-G03-001
3G3-18	CW-G3	Fixed Spandrel(Corner)	620.0	425.0	528.0	387.5	0.20	6.3	3	3	2	1	0.61	B			S3-G03-001
3G3-19	CW-G3	Fixed Spandrel	600.0	425.0	564.0	387.5	0.22	6.7	3	3	2	1	0.66	B			S3-G03-001
3G3-20	CW-G3	Fixed Spandrel	632.5	425.0	596.5	387.5	0.23	7.1	1	1	1	0	0.23				S3-G03-001
3G3-21	CW-G3	Fixed Spandrel	612.5	425.0	576.5	387.5	0.22	6.9	2	2	2	0	0.45				S3-G03-001
3G3-22	CW-G3	Fixed Spandrel	1512.5	425.0	1476.5	387.5	0.57	17.6	1	1	1	0	0.57				S3-G03-001
3G3-23	CW-G3	Fixed Spandrel	837.5	425.0	801.5	387.5	0.31	9.5	1	1	1	0	0.31				S3-G03-001
Total :									42	42	30	12	14.62	B			
													0				
3G4-01	CW-G4	Fixed Vision	700.0	145.0	624.0	145.0	0.09	2.8	5	5	3	2	0.45	B			S3-G04-001
3G4-02	CW-G4	Fixed Vision	600.0	145.0	524.0	145.0	0.08	2.3	3	3	2	1	0.23	B			S3-G04-001
3G4-03	CW-G4	Fixed Vision	632.5	145.0	596.5	145.0	0.08	2.5	1	1	1	0	0.08	A			S3-G04-001
3G4-04	CW-G4	Fixed Vision	612.5	145.0	576.5	145.0	0.08	2.4	1	1	1	0	0.08	A			S3-G04-001
Total :									10	10	7	3	0.84	B			
													0				
													0				
													0				
Total Glass / Floor :									83	83	59	24	55.46	B			

Summary of glass type

Glass Type Schedule	
CW-G1	10mm THK. HEAT STRENGTHENED GLASS (OUTSIDE) +12mm AIR SPACE +12mm THK. TEMPERED GLASS (IGU)(TYPICAL VISION PANEL)
CW-G2	10mm THK. HEAT STRENGTHENED GLASS (OUTSIDE) +12mm AIR SPACE +10mm THK. TEMPERED GLASS (IGU) (TYPICAL VISION PANEL)
CW-G3	12mm THK. HEAT STRENGTHENED GLASS (TYPICAL SPANDREL PANEL)
CW-G4	12mm THK. CLEAR TEMPERED GLASS

备注:所有玻璃参照簽樣板。

總數 83 件玻璃
= 55.46 m²

已訂 59 件 (39.65 m²)

補訂玻璃面積 = 15.81 m²
(記錄用)

只補訂此數量

此頁作記錄用

報價, 記錄用

Email = 2/12 15:31



美特鋁質有限公司
MIDI ALUMINIUM FABRICATOR LTD.

Email = 2/12 15:44

Quotation

To : Polyfair Construction & Engineering Ltd. - Email : kmw_pf@hotmail.com
 Attn : Man Contract Name : Show Flat Mock Up for LP 11
 Our Ref. : QT/10812/MD/1288 Instruction Ref. : E-mail
 Date : 2nd December, 2021 Instruction Date : 5-Oct-2021
 Subject : Quotation for Supply and Delivery Sliding Door and Glass Panel for Show Flat Mock Up of Lohas Park 11 at Olympic City

Copy Distribution: Client Architect Consultant Others

Item	Description	Rate Refer	Qty.	Unit	Rate	(HK\$) Amount
	<u>Quotation for Supply and Delivery Sliding Door and Glass Panel for Show Flat Mock Up of Lohas Park 11 at Olympic City</u>					
1.	Sliding Door system		4	No	20,000	\$80,000.00
2.	Glazing (for CW &SD) GL-01, GL-02, GL-03, GL-04, GL-05		100	Sup	1,500	\$150,000.00
3.	Transportation Cost		1	Item	10,000	\$10,000.00
<p><i>(An aluminium extrusion (transoms) included for Sliding System)</i></p>						Total Amount: \$240,000.00

Remarks:

- a) 30% of total Sub-Contract Sum for Deposit upon the sub-contract to be awarded.
- b) The frame and sash (散料) & Glass panel will be delivered to sales office street level only.
- c) Fabrication Drawing should be provide by Client.

MIDI ALUMINIUM FABRICATOR LTD
Signed:

Agreed by :
(with company chop)

Marco Tam
Director

Name : Sun [Signature]
Date : 2/12/2021

Encl

FM/MT/DS/YL/yl

九龍茶果嶺道610號生利工業中心1樓6-8號
 Units 6-8, 1st Floor, Sunray Industrial Centre, 610 Cha Kwo Ling Road, Kln.
 TEL (電話): 2348 9211 FAX (傳真): 2772 7666 E-mail Address (電郵): midi@midiltd.com.hk

