

工程指示 / 要求簡箋(E.I.)

工程指示編號：EI / 4²⁹³ / 22

修改版次：

工程編號：J - 852

工程名稱：亞皆老街中電

工程項目：大樓 天面 Glass Wall 鋁板和鋁角

收件人：生統

發件人：Ant Yeung

日期：15/01/2022

要求提供 / 確認 事項：

- | | | |
|------------------------------------|-------------------------------------|-------------------------------|
| <input type="checkbox"/> 初步鋁料 B.M. | <input type="checkbox"/> 加工拆圖，然後生產 | <input type="checkbox"/> 尺寸表 |
| <input type="checkbox"/> 正式鋁料 B.M. | <input type="checkbox"/> 技術上資料 / 指示 | <input type="checkbox"/> 報價 |
| <input type="checkbox"/> 配件 B.M. | <input type="checkbox"/> 樣辦或貨品說明書 | <input type="checkbox"/> 分判合約 |

內容：

請按加工圖生產大樓 天面 Glass Wall 鋁板和鋁角 (按現場覆尺)

謝謝 軒仔收貨

請在 2022.01.25 前完成上列要求。

附：1 頁 BM

- | | | |
|---------------------------------|--------------------------------------|--------------------------------|
| <input type="checkbox"/> 原合約工程包 | <input type="checkbox"/> 原合約工程加 / 減賬 | <input type="checkbox"/> 新工程報價 |
|---------------------------------|--------------------------------------|--------------------------------|

原因：-

分發東莞各部門：

- | | | | |
|--|---|--|--|
| <input type="checkbox"/> 生產技術總監 <input type="checkbox"/> 連附件 | <input type="checkbox"/> 技術部 <input type="checkbox"/> 連附件 | <input type="checkbox"/> 生產部 <input type="checkbox"/> 連附件 | <input type="checkbox"/> 機械設計部 <input type="checkbox"/> 連附件 |
| <input type="checkbox"/> 採購部 <input type="checkbox"/> 連附件 | <input type="checkbox"/> 生產統籌部 <input type="checkbox"/> 連附件 | <input type="checkbox"/> 小羅 & 清 <input type="checkbox"/> 連附件 | |
| <input type="checkbox"/> 質檢部 <input type="checkbox"/> 連附件 | <input type="checkbox"/> 會計部 <input type="checkbox"/> 連附件 | <input type="checkbox"/> 報關組 <input type="checkbox"/> 連附件 | <input type="checkbox"/> 其他 楊榮輝 <input type="checkbox"/> 連附件 |

分發其他分判：

- | |
|---|
| <input checked="" type="checkbox"/> 水洪 <input type="checkbox"/> 連附件 |
|---|

分發香港各部門：


- | | | | |
|---|--|---|---|
| <input type="checkbox"/> 行政部 <input type="checkbox"/> 連附件 | <input type="checkbox"/> 會計部 <input type="checkbox"/> 連附件 | <input type="checkbox"/> 統籌部 <input type="checkbox"/> 連附件 | <input checked="" type="checkbox"/> 工程部地盤科文 <input type="checkbox"/> 連附件 祥哥 |
| <input type="checkbox"/> 採購部 <input type="checkbox"/> 連附件 | <input type="checkbox"/> QS 部 <input type="checkbox"/> 連附件 | <input type="checkbox"/> 維修部 <input type="checkbox"/> 連附件 | <input type="checkbox"/> 其他 _____ <input type="checkbox"/> 連附件 |

傳遞編號：

HK 0122/22

發件人簽署：

項目經理簽署：

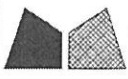


美特鋁質有限公司
MIDI Aluminium Fabricator Ltd.

工程號	J852	地盤	亞答老街
-----	------	----	------

产品编号	L(MM)	数量	A	N	M	B	N1	M1	备注
		10							

4.2


SECTION A-A

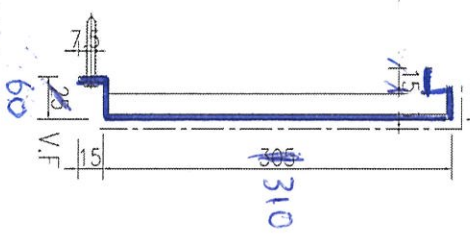

Handwritten dimensions: 25, 15, 30, 25

Handwritten note: L = 2725 mm


Handwritten note: 2725

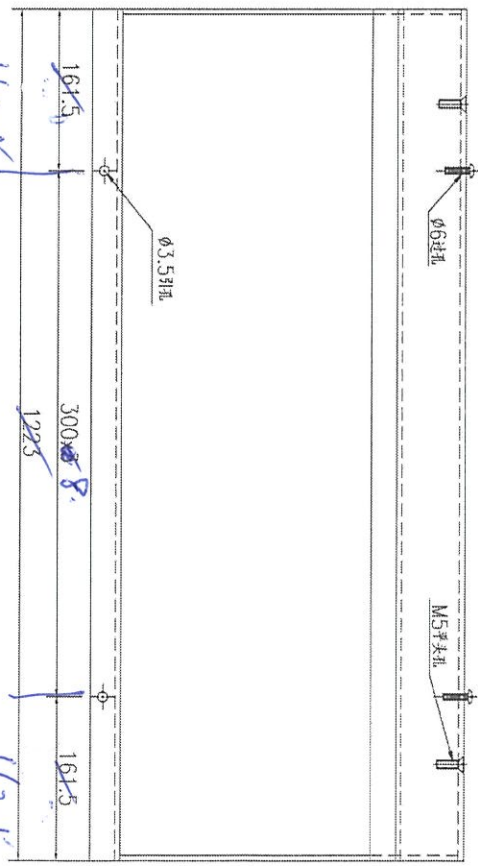

Handwritten note: 162.5

Handwritten note: 300

Handwritten note: 162.5

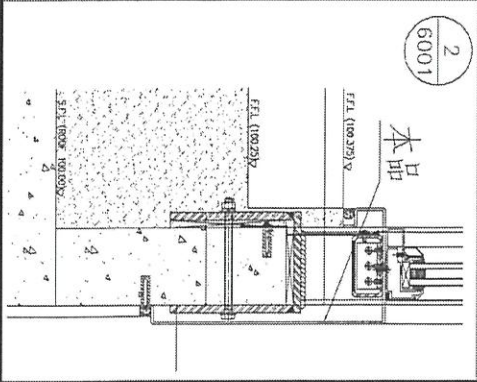


名稱	鋁板加工圖	制圖	吳禱瑜	2021-09-27	修改日期	TRF-AL-2496
材料	3mm厚鋁板	復核			圖號	J852-GS-LB04
顏色	UCT201498XL (A)-3(灰色)	批准				

20x20x3

角钢

M:16

L = 1400mm

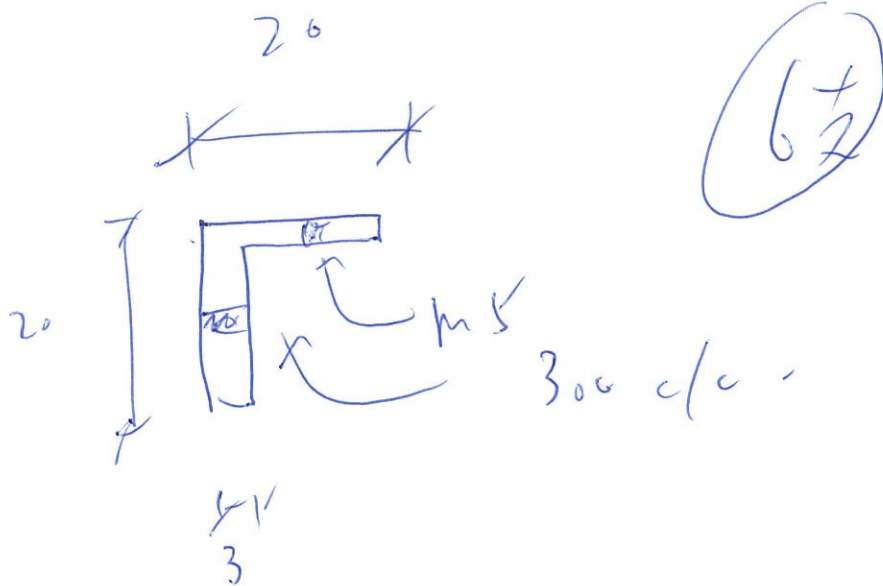

TK-L-20

Handwritten notes in blue ink, possibly indicating a revision or specific detail.

Handwritten note: "无边玻璃幕墙" (Edgeless Glass Curtain Wall).

Handwritten note: "out" circled in blue.

Handwritten note: "14/6/20" circled in blue.

