

工程指示 / 要求簡箋 ENGINEER INSTRUCTIONS (E.I.)

工程指示編號:	EI- 4614	修改版本:	-
	HK- 666		
工程編號:	J 852	工程名稱:	亞皆老街中電
收件人:	生統	發件人:	Karina Lee
工程項目:	趟門框 地盤用鋁角 T1-T3 : 1-23/F (67*35*2mm) (71*35*2mm) 連石塊角	日期:	14/04/2022

<input checked="" type="checkbox"/> 原合約工程包	<input type="checkbox"/> 原合約工程加 / 減賬 QT-	<input type="checkbox"/> 新工程報價 QT-
--------------------------------------------	------------------------------------------	------------------------------------

信件批核號碼/圖紙參考編號:	批核模具圖紙編號:
客戶指示附件:	管理內部批簽署:

<input type="checkbox"/> 初步鋁料 B.M.	<input checked="" type="checkbox"/> 加工拆圖, 然後生產	<input type="checkbox"/> 尺寸表
<input type="checkbox"/> 正式鋁料 B.M.	<input type="checkbox"/> 技術上資料/指示	<input type="checkbox"/> 報價
<input type="checkbox"/> 配件 B.M.	<input type="checkbox"/> 樣辦或貨品說明書	<input type="checkbox"/> 分判合約
<input type="checkbox"/> 其他:		

內容: 由於趟門框開去水孔, T1-T3 : 1-23/F 趟門框, 需要鋁角遮去水孔。
E14529已做樣板+在現場已試安裝。
廳: 左右2邊鋁角長度需預長125mm用作界避位用 (只限有門中企至門中企)
房: 鋁角長度需預長50mm
鋁料請貼上窗號。
謝謝

分層分單位打掣
刀口位置需補油

完成上列要求日期: 25/04/2022

國內

<input type="checkbox"/> 生產技術總監	<input type="checkbox"/> 連附件	<input type="checkbox"/> 技術部	<input type="checkbox"/> 連附件	<input type="checkbox"/> 生產部	<input type="checkbox"/> 連附件
<input type="checkbox"/> 採購部	<input type="checkbox"/> 連附件	<input checked="" type="checkbox"/> 生產統籌部	<input checked="" type="checkbox"/> 連附件	<input type="checkbox"/> 報關組	<input type="checkbox"/> 連附件
<input type="checkbox"/> 質檢部	<input type="checkbox"/> 連附件	<input type="checkbox"/> 會計部	<input type="checkbox"/> 連附件	<input type="checkbox"/> 機械設計部	<input type="checkbox"/> 連附件
<input type="checkbox"/> 其他:					


香港

<input type="checkbox"/> 行政部	<input type="checkbox"/> 連附件	<input type="checkbox"/> 會計部	<input type="checkbox"/> 連附件	<input type="checkbox"/> 統籌部	<input type="checkbox"/> 連附件	<input type="checkbox"/> 工程部	<input type="checkbox"/> 連附件
<input type="checkbox"/> 採購部	<input type="checkbox"/> 連附件	<input type="checkbox"/> QS部	<input type="checkbox"/> 連附件	<input checked="" type="checkbox"/> 地盤管理	<input checked="" type="checkbox"/> 連附件	<input type="checkbox"/> 維修部	<input type="checkbox"/> 連附件

*發件人簽署:	*組別成員批核簽署:
傳遞編號:	項目經理簽署:

材料: 2mm 厚鋁角

加口位置補油

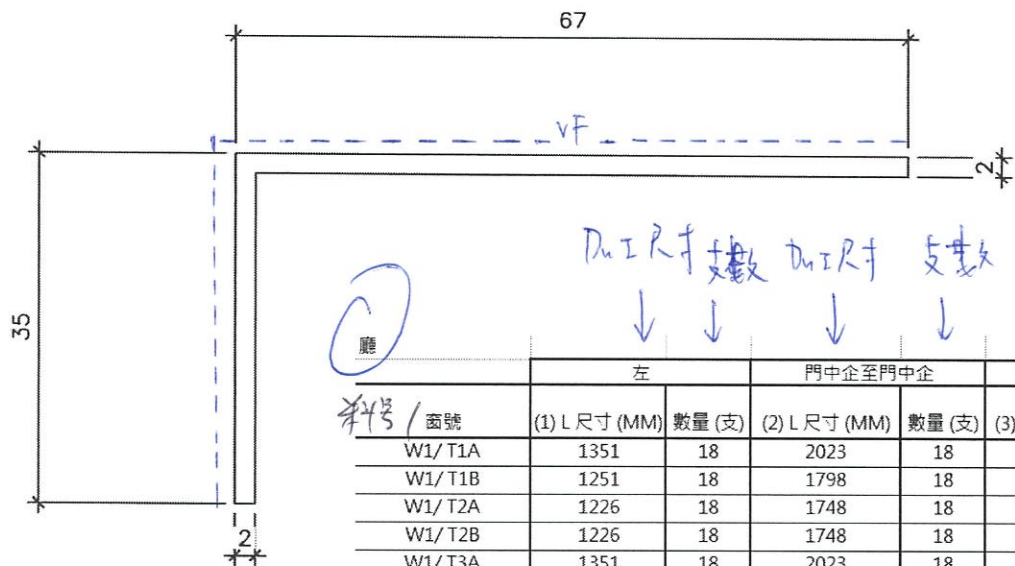


加口位置補油
 ↓ ↓ ↓ ↓ ↓ ↓
 加口位置補油

料號 / 窗號	左		門中企至門中企		右		座數 / 樓層	參考用	
	(1) L尺寸 (MM)	數量 (支)	(2) L尺寸 (MM)	數量 (支)	(3) L尺寸 (MM)	數量 (支)		SO數 (批澀面至批澀面)	額外 (MM)
W1/ T1A	1351	18	2023	18	1351	18	T1: 1-21/F	4475	(1) (2) 125
W1/ T1B	1251	18	1798	18	1251	18	T1: 1-21/F	4050	(1) (2) 125
W1/ T2A	1226	18	1748	18	1226	18	T2: 1-21/F	3950	(1) (2) 125
W1/ T2B	1226	18	1748	18	1226	18	T2: 1-21/F	3950	(1) (2) 125
W1/ T3A	1351	18	2023	18	1351	18	T3: 1-21/F	4475	(1) (2) 125
W1/ T3B	1251	18	1798	18	1251	18	T3: 1-21/F	4050	(1) (2) 125
W1/ T1C	2800	18	/	/	/	/	T1: 1-21/F	2800	/
W1/ T2C	2800	18	/	/	/	/	T2: 1-21/F	2800	/
W1/ T3C	2800	18	/	/	/	/	T3: 1-21/F	2800	/
22W4/ T1A	2216	1	2218	1	2216	1	T1: 22/F	6400	(1) (2) 125
23W4/ T1A	2216	1	2218	1	2216	1	T1: 23/F	6400	(1) (2) 125
22W1/ T2A	1176	1	1748	1	1176	1	T2: 22/F	3850	(1) (2) 125
22W1/ T2B	1176	1	1748	1	1176	1	T2: 22/F	3850	(1) (2) 125
22W4/ T3A	2216	1	2218	1	2216	1	T3: 22/F	6400	(1) (2) 125
23W4/ T3A	2216	1	2218	1	2216	1	T3: 23/F	6400	(1) (2) 125
23W1/ T2A	2202.5	1	2012.5	1	2535	1	T2: 23/F	6500	/
22W1/ T1C	2800	1	/	/	/	/	T1: 22/F	2800	/
23W1/ T1C	2800	1	/	/	/	/	T1: 23/F	2800	/
22W1/ T2C	2800	1	/	/	/	/	T2: 22/F	2800	/
23W1/ T2C	2800	1	/	/	/	/	T2: 23/F	2800	/
22W1/ T3C	2800	1	/	/	/	/	T3: 22/F	2800	/
23W1/ T3C	2800	1	/	/	/	/	T3: 23/F	2800	/

請參考附圖2

顏色: UCT806812XL-3

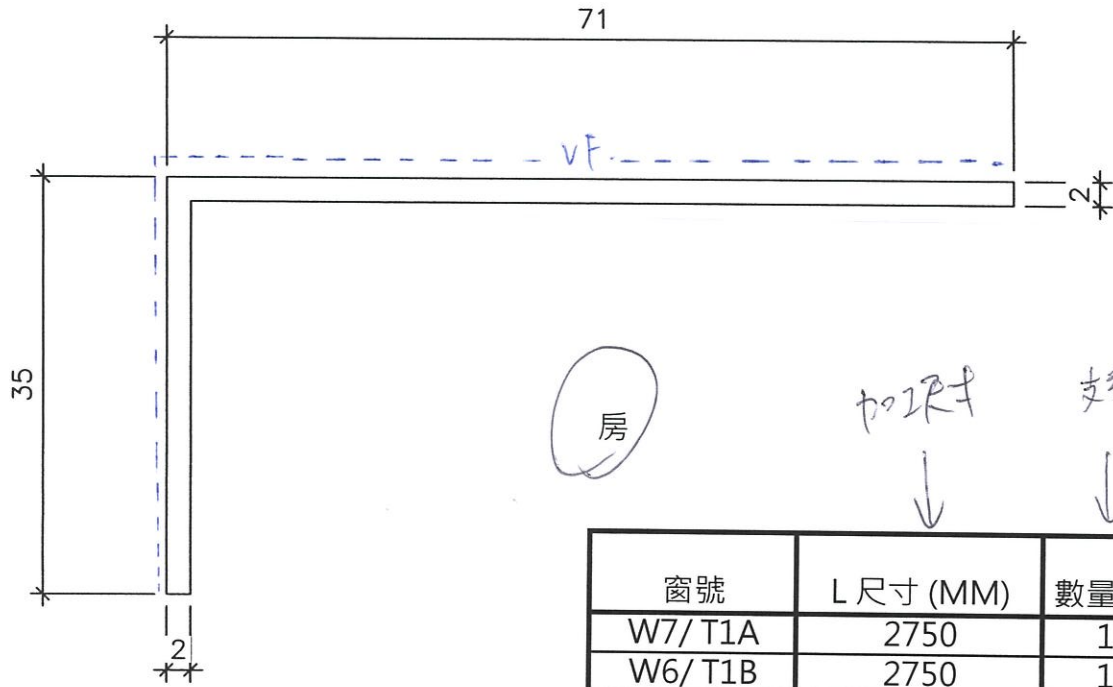

材料= 2mm厚鋁角
 加位補油

房

加尺寸 支數
 ↓ ↓

窗號	L 尺寸 (MM)	數量 (支)	座數/ 樓層	參考用	
				SO數 (批盪面全批盪面)	額外 (MM)
W7/ T1A	2750	18	T1: 1-21/F	2700	50
W6/ T1B	2750	18	T1: 1-21/F	2700	50
W6/ T2A	2750	18	T2: 1-21/F	2700	50
W6/ T2B	2750	18	T2: 1-21/F	2700	50
W7/ T3A	2750	18	T3: 1-21/F	2700	50
W6/ T3B	2750	18	T3: 1-21/F	2700	50
W7/ T2A	2750	18	T1: 1-21/F	2700	50
22W3/ T1A	2675	1	T1: 22/F	2625	50
23W3/ T1A	2675	1	T1: 23/F	2625	50
22W6/ T2A	2750	1	T2: 22/F	2700	50
22W6/ T2B	2750	1	T2: 22/F	2700	50
22W3/ T3A	2675	1	T3: 22/F	2625	50
23W3/ T3A	2675	1	T3: 23/F	2625	50
23W12/ T2A	2050	1	T2: 23/F	2000	50

→ 顏色: UCT806812XL-3


15:07



+852 6745 5348

13/4/2022 12:26


所有媒體

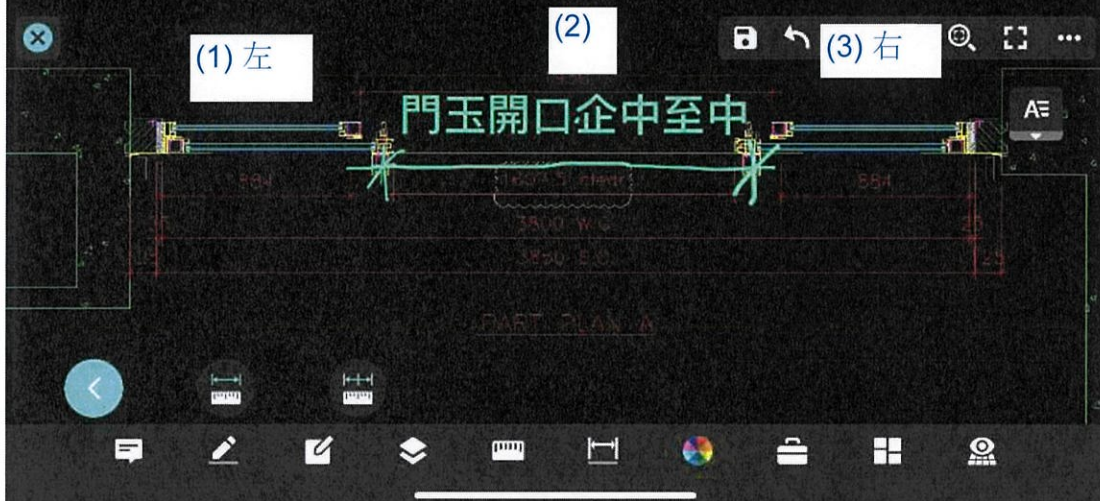

先度門中至中 然後 so 總數-返門中至中個數除 2 後
各加 125= 有 3 條


磨


安裝效果

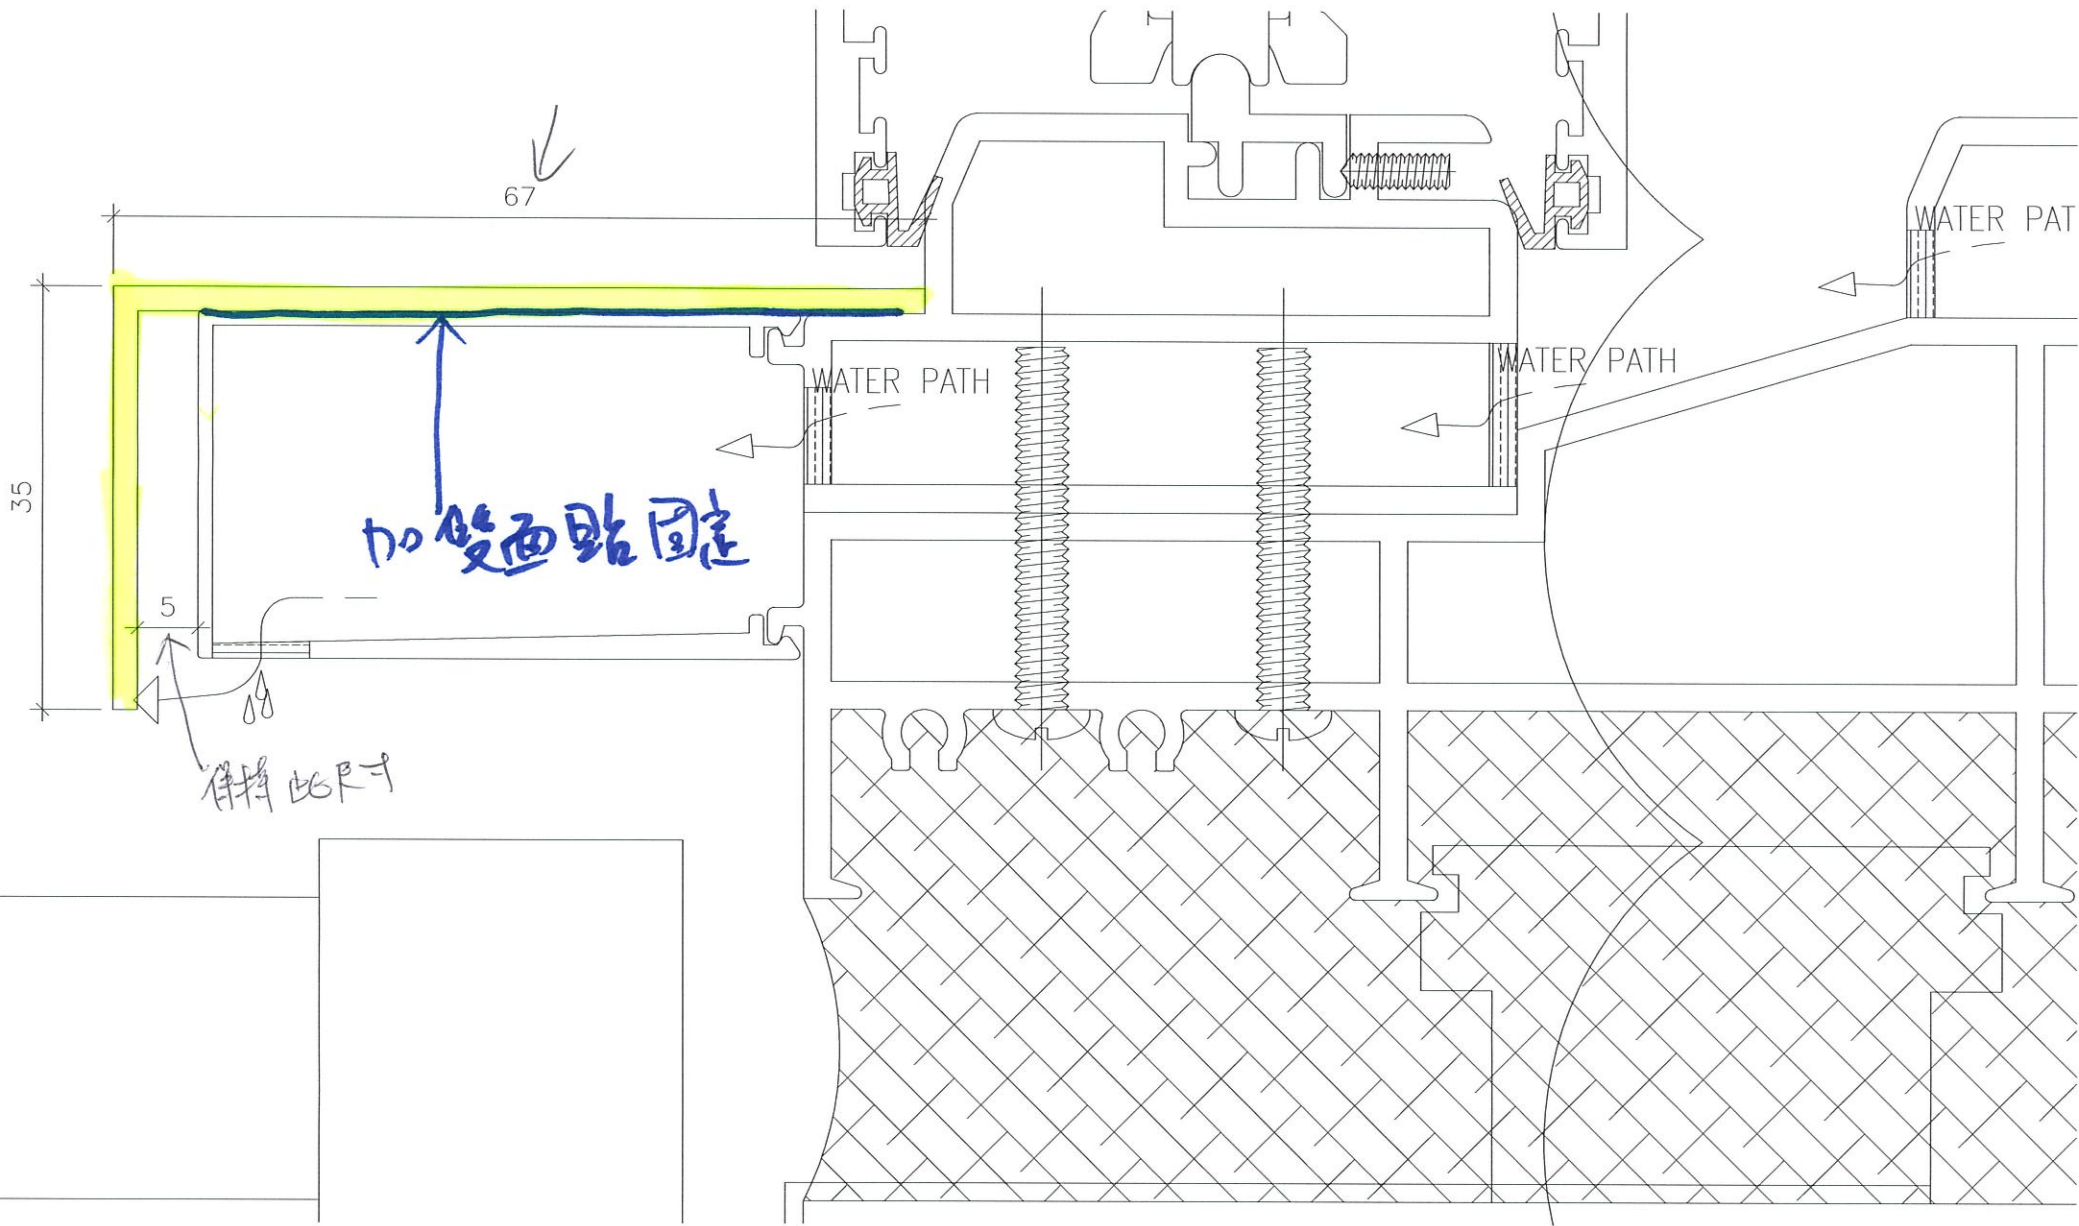


房

安裝效果

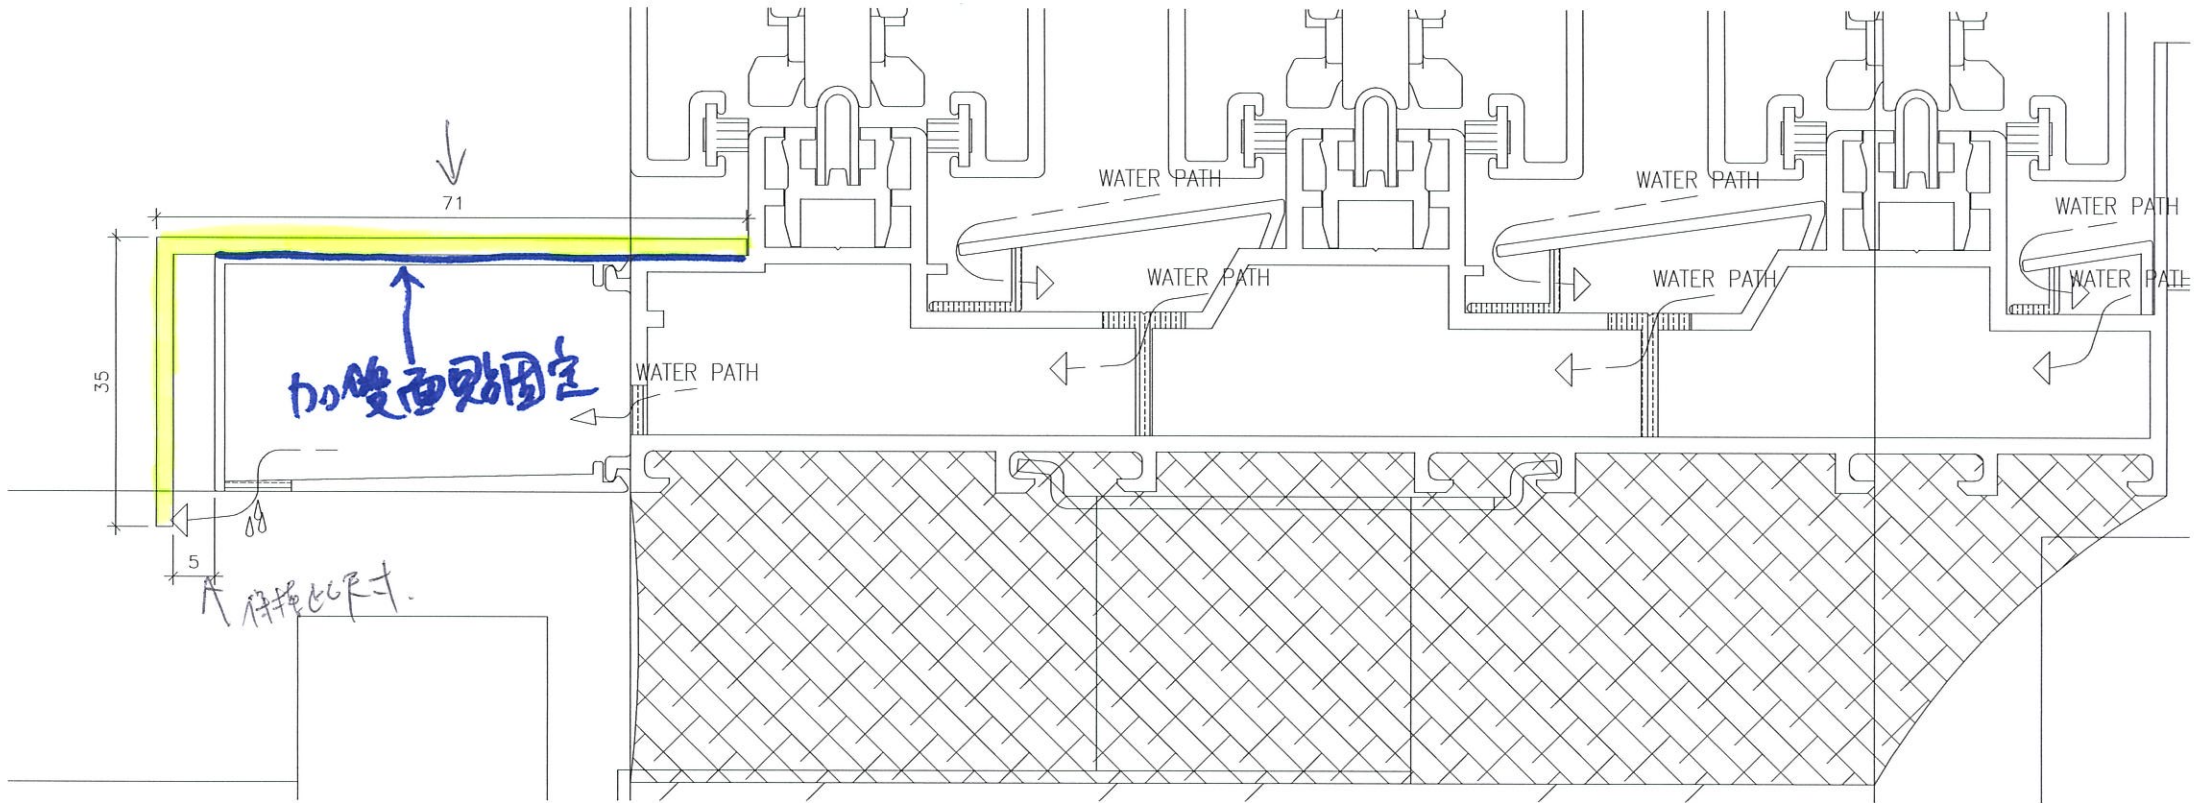

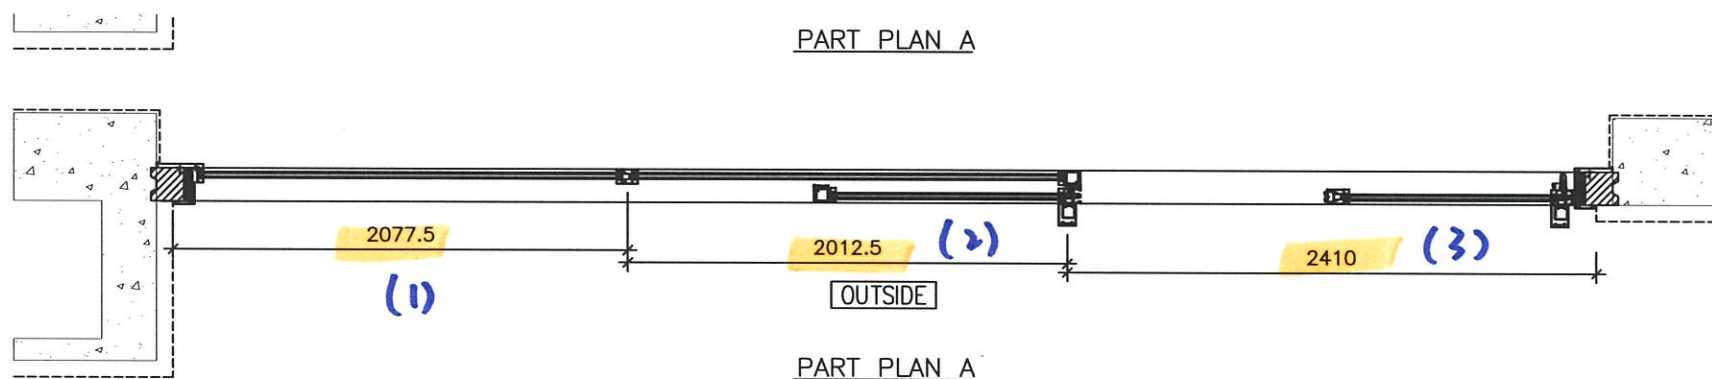

WINDOW MARK	 小業主改款
LOCATION	23/F LIV./DIN. AT TOWER 2 FLAT A
SECTION	67mm ALUM. SECTION
GLAZING	GL-01
QUANTITY	1
REMARKS	FACADE (PF-41)







Our ref. MC/XXXXX/852
Gammon Construction Limited
139-147 Argyle Street,
Kowloon

20 April 2022
By Email & Hand

Attn.: Mr Dick Yuen / Ms Penny Chau

Dear Sir,

Submission of Proposal of Method Statement for Additional Water Drain Hole for Sliding Door (MST072)

Regarding the captioned project, we would like to submit the Proposal of Method Statement for Additional Water Drain Hole for Sliding Door for your review and comment.


Thank you for your kind attention.

Yours faithfully,
MIDI ALUMINIUM FABRICATOR LTD.

Marco Tam
Director

cc. Gammon	- Ms. Esther Chung / Mr. Sam Tang /	(w/e)	
	- Mr. Jackson Mok / Mr. Joe Ng		
Sino	- Mr. Billy Tang / Mr. Jimmy Cheung /	(w/e)	(Email
		Only)	
	- Mr. Terry Wan / Mr. Jaja Wong		
AGC	- Mr. Raymond Ho / Mr. Eliot Chan	(w/e)	(Email
		Only)	
MFT	- Mr. Brian Leung / Mr. Nigel Lo	(w/e)	(Email
		Only)	
	- Ms. Eunice Yan / Ms. Cosimo Wong/ Mr. Neo Wong		

FM / MT / DW / AY /  / EL / KL / yl

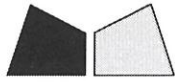

Proposal

For

Additional Water Drain Hole

For

Sliding Door

Project : Proposed Residential Development at 139-147 Argyle Street,
Kowloon (J3860)

Date : 19 April 2022

Revision : 0

Ref. No. : J852

● **Problem:**

樣板層趟門試水後發現去水量不足，需加開去水孔

● **Remedial Works:**

- 1) 現場拆除室外趟門底橫向收口
- 2) 在趟門框加開 8x8mm 長去水孔(A)，分二/三/四趟(見附圖及開孔位置)
- 3) 在趟門室外底橫飾線上加開 10x8mm 長去水孔(B)，分二/三/四趟(見附圖及開孔位置)
- 4) 增加鋁角在原趟門底橫向收口上，鋁角離底橫收口 5mm，以供足夠空間作去水用




兩道

(A) 門框內
新增 8x8mm 去水孔

(B) 牆門外底橫飾線
新增 8x10mm 高去水孔

兩端

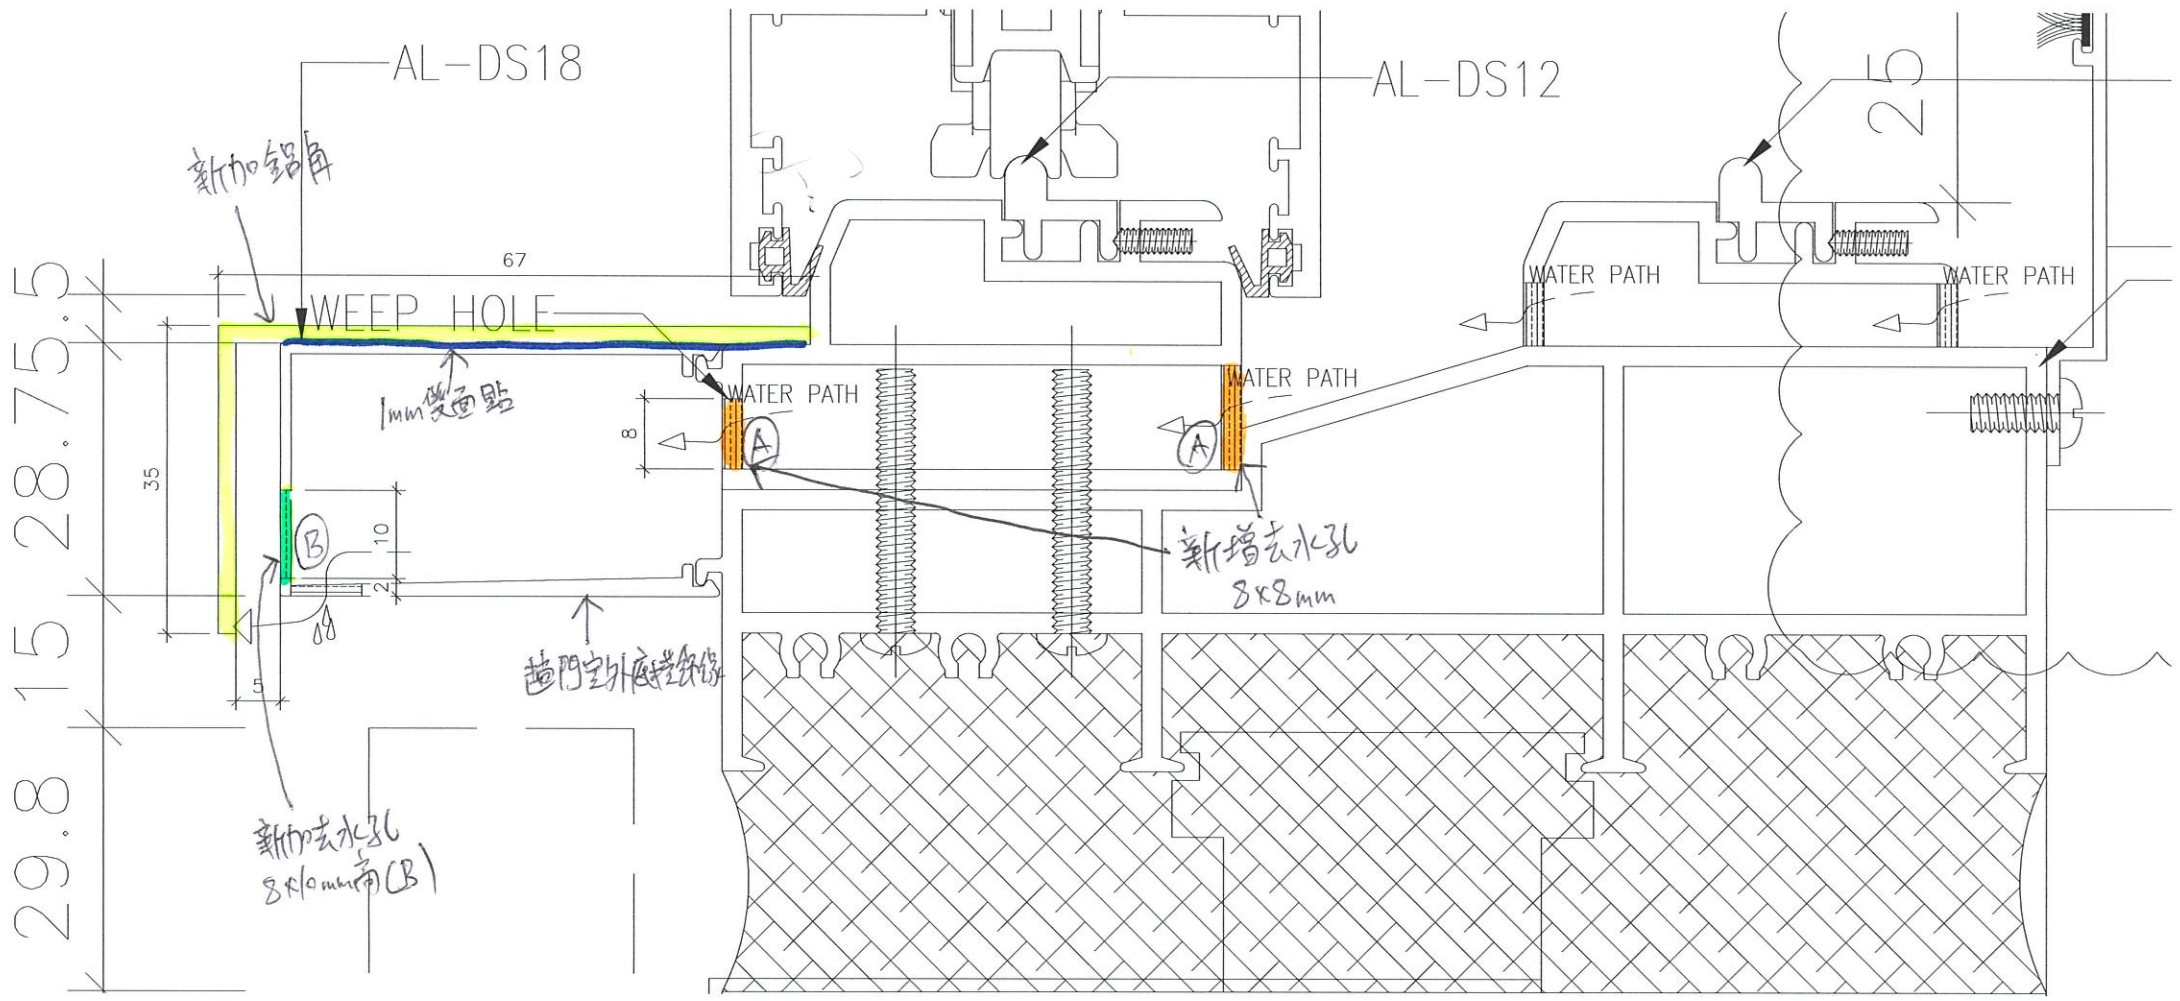


三插

- (A) 門框內
新增 8x8mm 去水孔
- (B) 窗門室外底橫飾線
新增 8x10mm 高去水孔



三軸

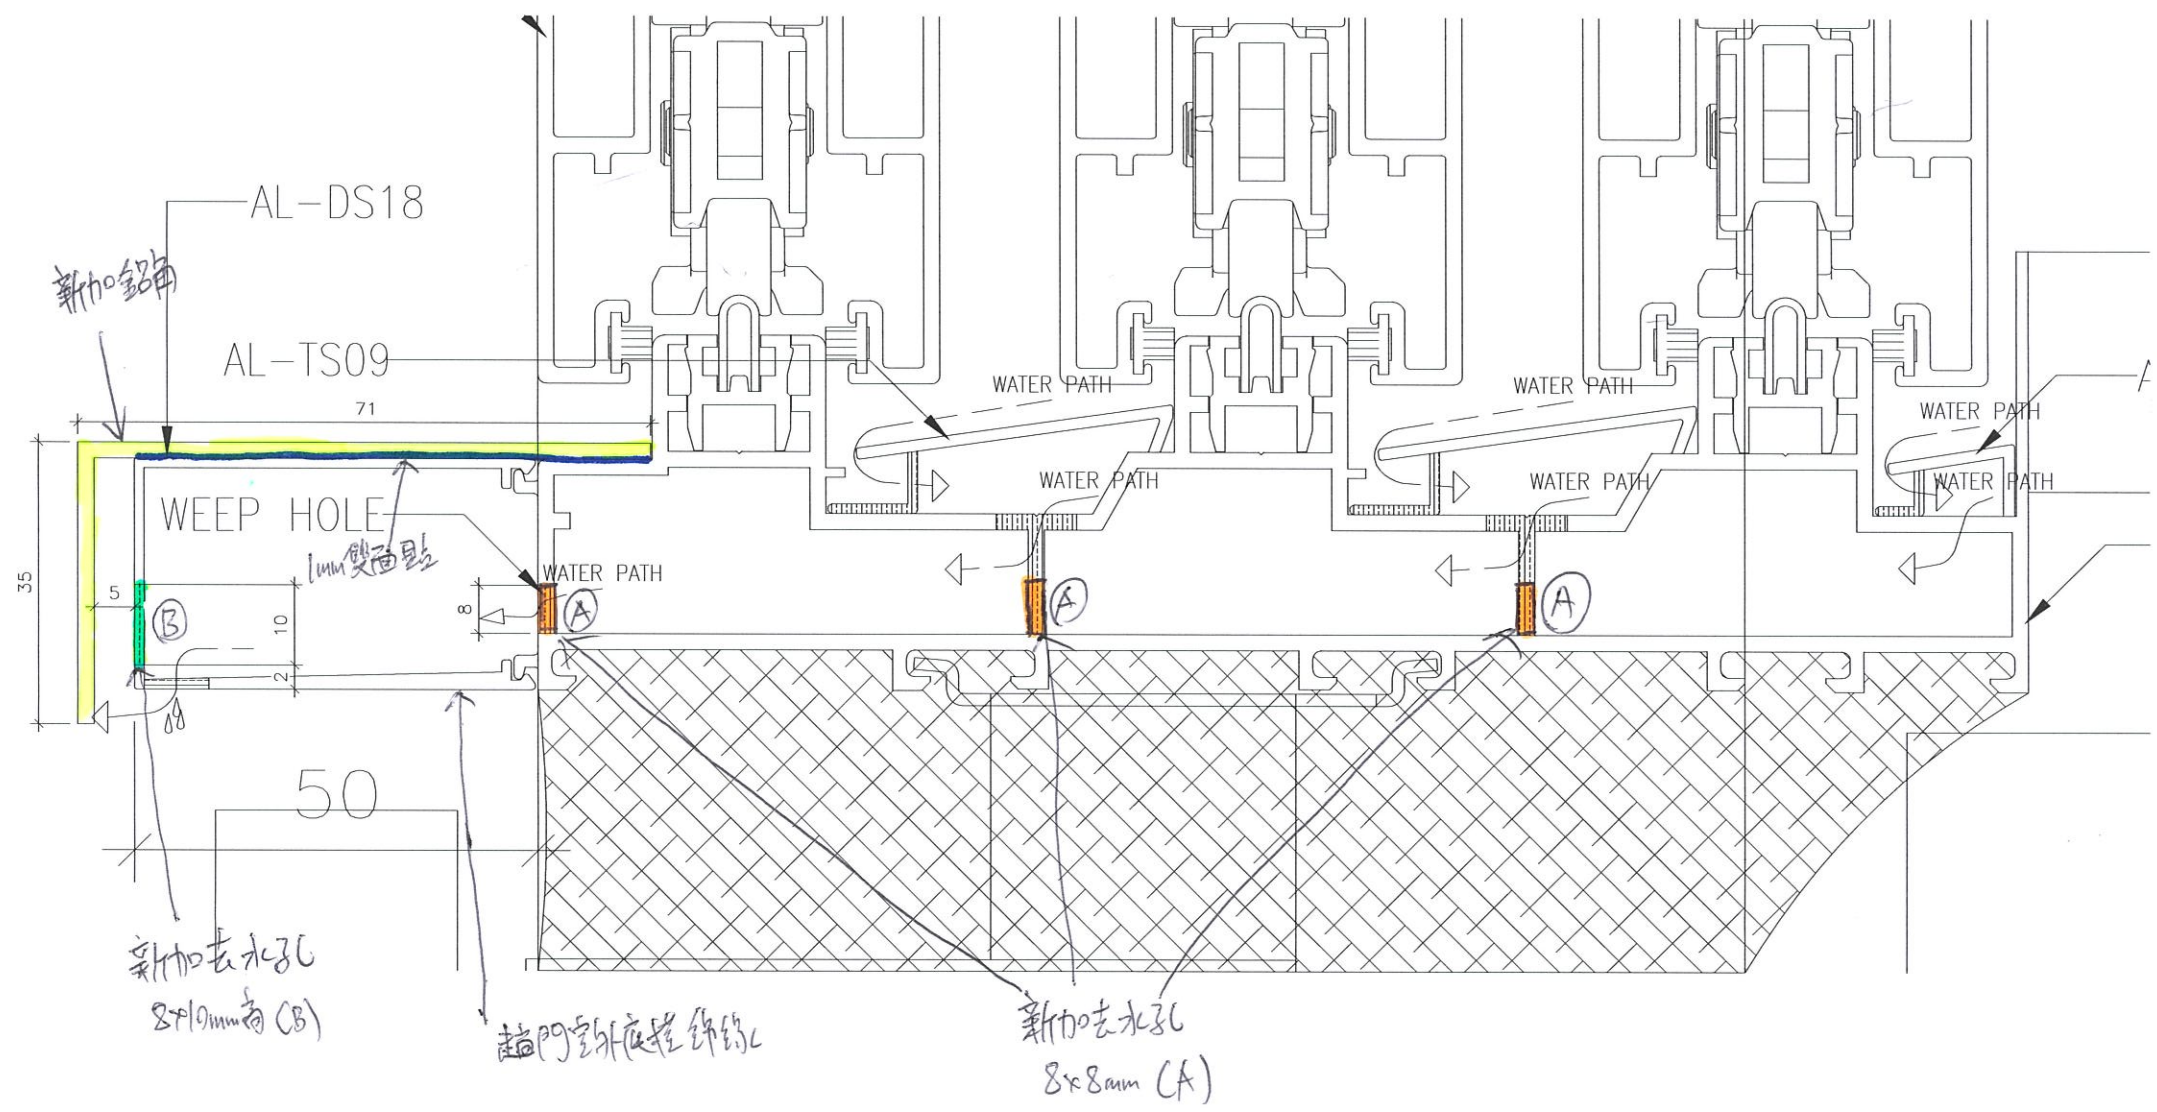

四趟

門框內新增 8x8 mm 去孔 (A)
插門室外底接卸線新增 8x10 高去孔 (B)



2535 W.O.

F. (GL01)

S.D. (GL01)

S.D. (GL01)

F. (GL01)

240

900

900

240

B 9 9 B

B 9 9 B

B 9 9 B

B 9 9 B

1021.5

1141

1141

1021.5

4325 W.O.

4375 S.O.

25

25

125

125

四抽

