

工程指示 / 要求簡箋 ENGINEER INSTRUCTIONS (E.I.)

工程指示編號:	EI- 4655	修改版本:	-
	HK- 0736		
工程編號:	J 852	工程名稱:	亞答街中電
收件人:	4號	發件人:	Ang Yeung
工程項目:	鐘錶 - 玻璃框河 俾修錶已 (14支)	日期:	05/05/2022

<input type="checkbox"/> 原合約工程包	<input type="checkbox"/> 原合約工程加 / 減賬 QT-	<input type="checkbox"/> 新工程報價 QT-
---------------------------------	--	------------------------------------

信件批核號碼/圖紙參考編號:	批核模具圖紙編號:
客戶指示附件:	管理內部批簽署:

<input type="checkbox"/> 初步鋁料 B.M.	<input type="checkbox"/> 加工拆圖, 然後生產	<input type="checkbox"/> 尺寸表
<input type="checkbox"/> 正式鋁料 B.M.	<input type="checkbox"/> 技術上資料/指示	<input type="checkbox"/> 報價
<input type="checkbox"/> 配件 B.M.	<input type="checkbox"/> 樣辦或貨品說明書	<input type="checkbox"/> 分判合約
<input type="checkbox"/> 其他:		

內容: 鐘錶鐘錶修理機框河, 俾修錶已 40x3mm  
送地盤 L=1000mm  
UCT 9.2435SL3 白色 14支

完成上列要求日期:

國內

<input type="checkbox"/> 生產技術總監	<input type="checkbox"/> 連附件	<input type="checkbox"/> 技術部	<input type="checkbox"/> 連附件	<input type="checkbox"/> 生產部	<input type="checkbox"/> 連附件
<input type="checkbox"/> 採購部	<input type="checkbox"/> 連附件	<input checked="" type="checkbox"/> 生產統籌部	<input checked="" type="checkbox"/> 連附件	<input type="checkbox"/> 報關組	<input type="checkbox"/> 連附件
<input type="checkbox"/> 質檢部	<input type="checkbox"/> 連附件	<input type="checkbox"/> 會計部	<input type="checkbox"/> 連附件	<input type="checkbox"/> 機械設計部	<input type="checkbox"/> 連附件
<input type="checkbox"/> 香港辦	<input type="checkbox"/> 連附件	<input type="checkbox"/> 其他:			



<input type="checkbox"/> 行政部	<input type="checkbox"/> 連附件	<input type="checkbox"/> 會計部	<input type="checkbox"/> 連附件	<input type="checkbox"/> 統籌部	<input type="checkbox"/> 連附件	<input type="checkbox"/> 工程部	<input type="checkbox"/> 連附件
<input type="checkbox"/> 採購部	<input type="checkbox"/> 連附件	<input type="checkbox"/> QS部	<input type="checkbox"/> 連附件	<input checked="" type="checkbox"/> 地盤管理	<input checked="" type="checkbox"/> 連附件	<input type="checkbox"/> 維修部	<input type="checkbox"/> 連附件

*發件人簽署:		*組別成員批核簽署:	
傳遞編號:		項目經理簽署:	


分機

40x5鋁板  
2支


L=1000mm

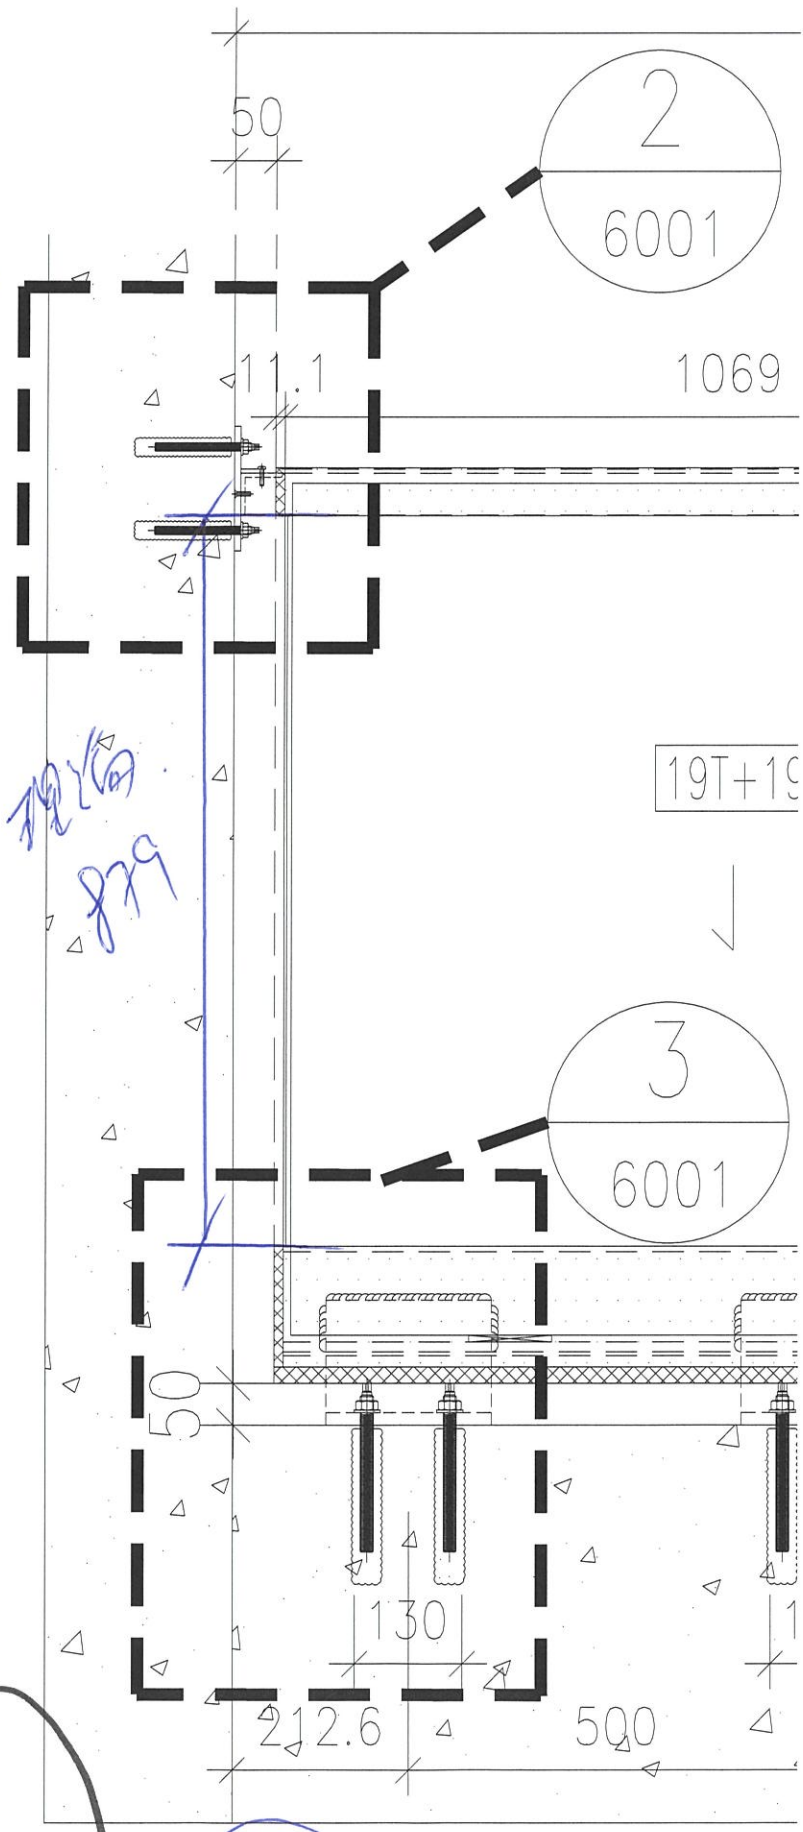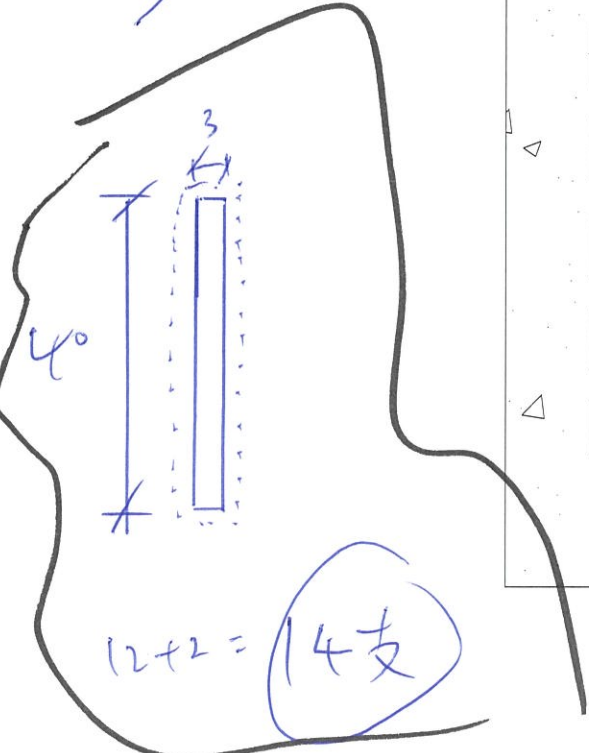


白色 UCT 9024355e-3

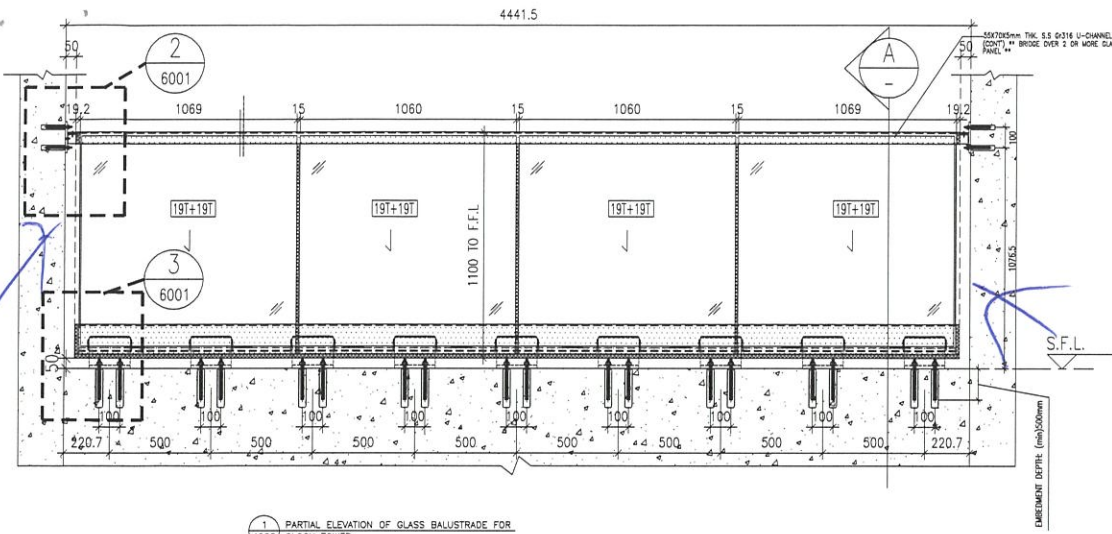


1 PARTIAL ELEVATION OF GLASS BALUSTRADE FOR CLOCK TOWER

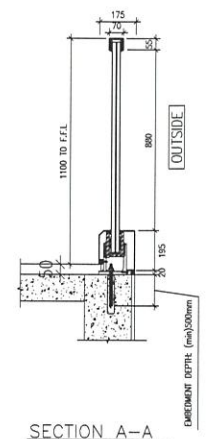

SECTION A-A REFER TO DWG: 1/4001

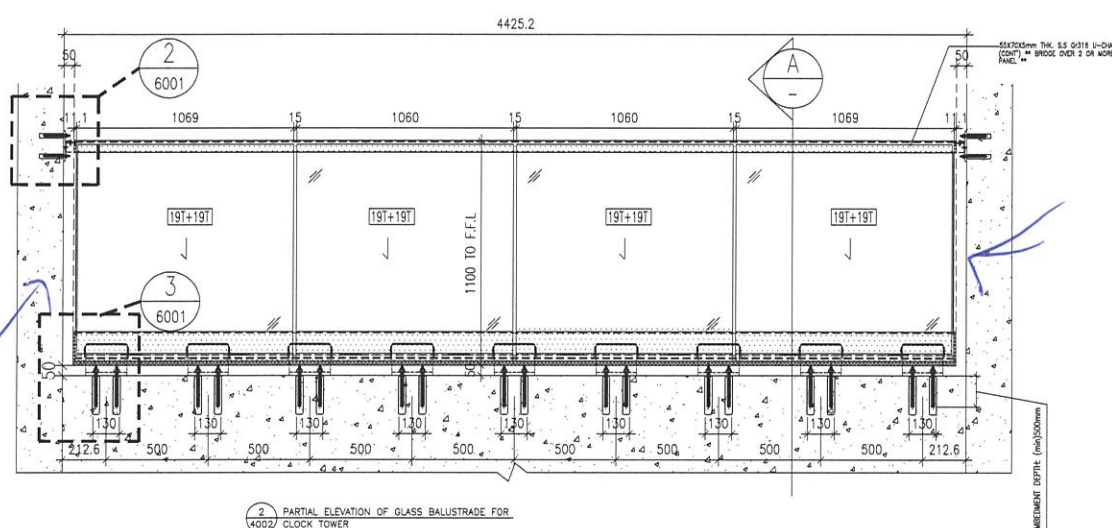

2 PARTIAL ELEVATION OF GLASS BALUSTRADE FOR CLOCK TOWER

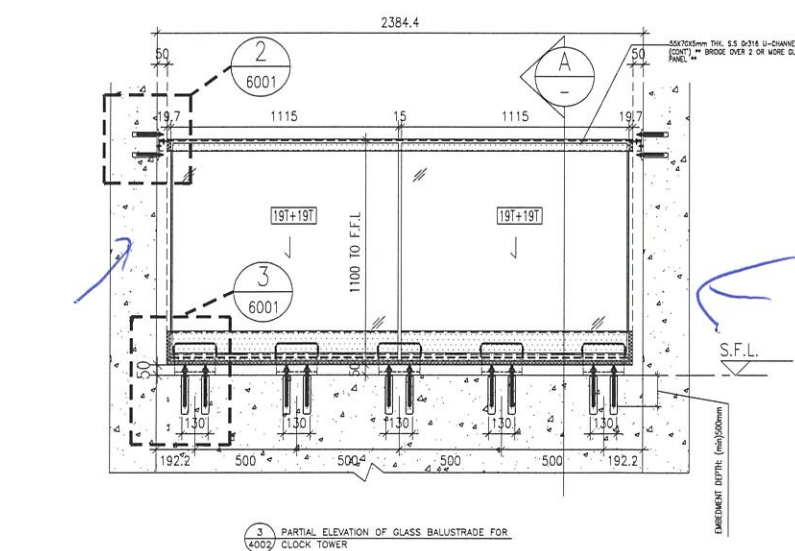

3 PARTIAL ELEVATION OF GLASS BALUSTRADE FOR CLOCK TOWER

合欄樓  
X 2  
6x2 212  
+ 2

<p>DATE: 17-Dec-20 SCALE: 1:25 DRAWN BY: ALHR CHECKED BY: DW</p>		<p>JOB NO.: J-852 PROJECT: 24A KADODRE AVENUE and 147 ARCTIC STREET, KOWLOON K11 6038 R.P., K11 6037 R.P., K11 6036 R.P., K11 6035 R.P., and K11 6005</p>		<p>NO. 1 DATE REVISION BY</p>		<p>NOTE: 1. ALL DIMENSIONS ARE IN mm. 2. ALL DIMENSIONS ARE TO BE TAKEN FROM OUTSIDE BEFORE FABRICATION. 3. ALL DIMENSIONS TO BE VERIFIED ON SITE.</p>		<p>ARCHITECT: <b>AGC DESIGN LTD</b></p>		<p>BLD. REF: 3/3063/10</p>	
<p>TITLE: GLASS BALUSTRADE PART ELEV. &amp; PART SECTION (CLOCK TOWER)</p>		<p>LEGEND: ① DETAIL MARK NO. ② REFER SHEET NO. 1. F.F.L. -- FINISHED FLOOR LEVEL 2. S.F.L. -- STRUCTURAL FLOOR LEVEL 3. @ -- REVERSED DETAIL</p>		<p>MAIN CONSULTANT: <b>ARUP</b></p>		<p>STRUCTURAL ENGINEER: <b>Gammorn</b></p>		<p>ARCHITECT: <b>AGC DESIGN LTD</b></p>		<p>AS BUILD</p>	
<p>Units 6-8, Sunny Industrial Centre, 1/F 610 Chee Koo Ling Road, Kowloon Tel: 23448921/4 Fax: (852) 27277666 DWG NO.: 4852-SIP-CIE-4002 REV: AB</p>		<p>At Licensed Site (Refer to Project Information/1-3) All Licensed Site Markers (Refer to Project Information/1-3) All Licensed Site Markers (Refer to Project Information/1-3) All Licensed Site Markers (Refer to Project Information/1-3)</p>		<p>FACE CONSULTANT: <b>MEYERHARDT</b></p>		<p>MAIN CONTRIBUTOR: <b>Gammorn</b></p>		<p>ARCHITECT: <b>AGC DESIGN LTD</b></p>		<p>AS BUILD</p>	

