



工程指示 / 要求簡箋(E.I.)

工程指示編號：EI / 627 / 23

修改版次：-

工程編號：J - 852

工程名稱：亞皆老街中電

工程項目：後加 玻璃槽 2 條

收件人：生統 / 維修部

發件人：Ant Yeung

日期：22/05/2023

要求提供 / 確認 事項：

- ( ) 初步鋁料 B.M.
- ( ) 加工拆圖，然後生產
- ( ) 尺寸表
- ( ) 正式鋁料 B.M.
- ( ) 技術上資料 / 指示
- ( ) 報價
- ( ) 配件 B.M.
- ( ) 樣辦或貨品說明書
- ( ) 分判合約
- ( ) 其他：\_\_\_\_\_

內容：\_

請按維修組要求做 2 條玻璃槽, 2 條, 1 米 PE00E5006(可用其他合尺寸存料返噴),

底部用鋁角封篤。主色 UCT201498XL(A)-3

頂部給予兩塊欄河玻璃頂膠蓋供地盆 顏色為 J852 主色 UCT201498XL(A)-3

送維修組偉哥收貨

請在 2023 / 06 / 21 前完成上列要求。

附：4 頁

以上項目為：

- 原合約工程包
- 原合約工程加 / 減賬
- 新工程報價

原因：-

分發東莞各部門：

- ( ) 生產技術總監  連附件
- ( ) 技術部  連附件
- ( ) 生產部  連附件
- ( ) 機械設計部  連附件
- ( ) 採購部  連附件
- ( ) 生產統籌部  連附件
- ( ) 小羅 & 清  連附件
- ( ) 質檢部  連附件
- ( ) 會計部  連附件
- ( ) 報關組  連附件
- ( ) 其他 \_\_\_\_\_  連附件

分發香港各部門：

- ( ) 行政部  連附件
- ( ) 會計部  連附件
- ( ) 統籌部  連附件
- ( ) 工程部地盤科文  連附件
- ( ) 採購部  連附件
- ( ) QS 部  連附件
- ( ) 維修部  連附件
- ( ) 其他 \_\_\_\_\_  連附件

傳遞編號：

發件人簽署：

HK 1133 / 23


項目經理簽署：

頂有  
A型  
A型



底  
有包1  
有鋼到等. 孔玻璃用

X2.

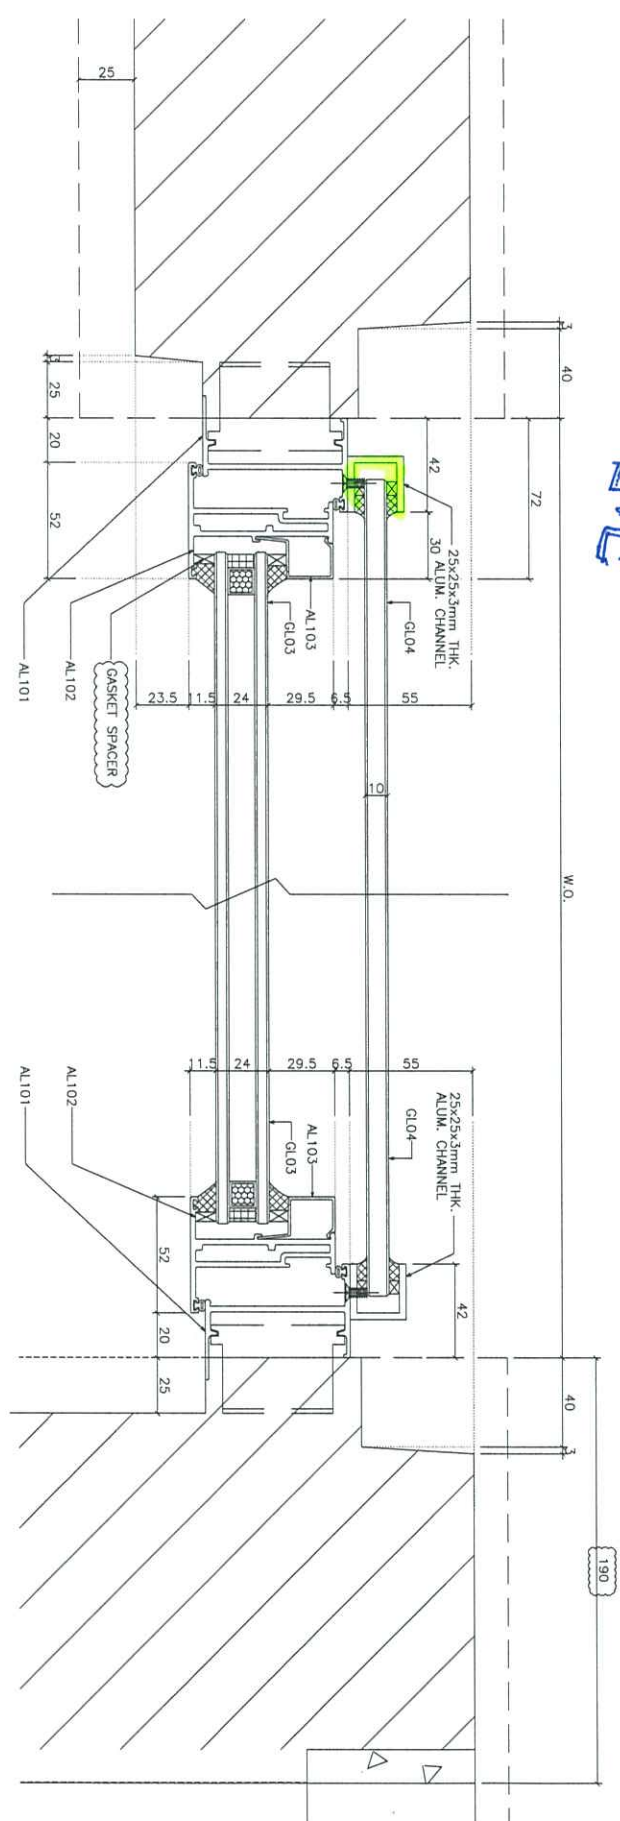

1 HORIZONTAL DETAIL OUTSIDE  
SCALE 1:2

2 HORIZONTAL DETAIL OUTSIDE  
SCALE 1:2

PE 00 E 5006







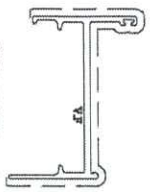
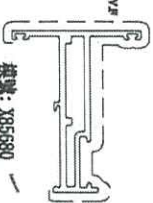
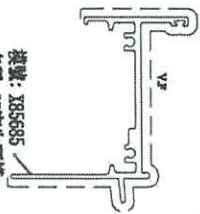
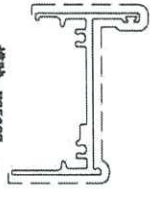
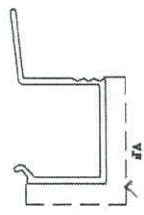
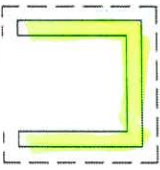
1車表

2條




自行製

B.D. REF :  
CLIENT :  
ARCHITECT :  
AGC DESIGN LTD  
MAIN CONTRACTOR :  
STRUCTURAL ENGINEER :  
Gammion  
FRACOE CONSULTANT :  
ARUP  
MEINHARDT  
NOTE :  
1. ALL DIMENSIONS ARE IN MM.  
2. ALL ELEVATIONS ARE VIEWED FROM OUTSIDE.  
3. ALL DIMENSIONS TO BE VERIFIED ON SITE BEFORE FABRICATION.  
LEGEND :  
DETAIL MARK NO.  
REFER SHEET NO.  
1 FCL 1/2008 1/2008

# J-852佛沙窗鋁料模圖-2

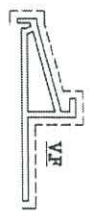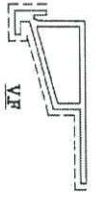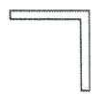 <p>模號: X858334 名稱: 70度玻璃夾角 合金狀態: 6063-T6 重量: 0.325 KG/M V.F.: 48.56</p>	 <p>模號: X858388 名稱: 70度百頁片 合金狀態: 6063-T6 重量: 0.741 KG/M V.F.: 93.356</p>	 <p>模號: X858399 名稱: 70度百頁窗下框 合金狀態: 6063-T6 重量: 1.516 KG/M V.F.: 162.921</p>	 <p>模號: X85840 名稱: 70度百頁窗上框 合金狀態: 6063-T6 重量: 1.516 KG/M V.F.: 163.081</p>	 <p>模號: BE0000706 名稱: 50*50*5度角 合金狀態: 6063-T6 重量: 1.287 KG/M V.F.: -</p>	 <p>模號: X84553 名稱: 一字槽 合金狀態: 6063-T6 重量: 0.34 KG/M V.F.: -</p>
 <p>模號: X85679 名稱: 65度生邊企 合金狀態: 6063-T6 重量: 0.872 KG/M V.F.: 174.82</p>	 <p>模號: X85680 名稱: 65度生邊玉 合金狀態: 6063-T6 重量: 1.298 KG/M V.F.: 176.4</p>	 <p>模號: X85685 名稱: 65度生頂橫 合金狀態: 6063-T6 重量: 1.149 KG/M V.F.: 213.77</p>	 <p>模號: X85687 名稱: 65度生底橫 合金狀態: 6063-T6 重量: 1.014 KG/M V.F.: 174.82</p>	 <p>模號: X85693 名稱: 65度玻璃線 合金狀態: 6063-T6 重量: 0.214 KG/M V.F.: 37</p>	 <p>模號: PE0005006 名稱: 25*25*25*3斜槽 合金狀態: 6063-T6 重量: 0.561 KG/M V.F.: 81</p>

新

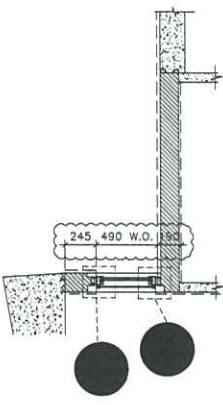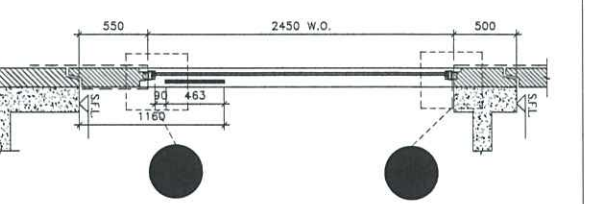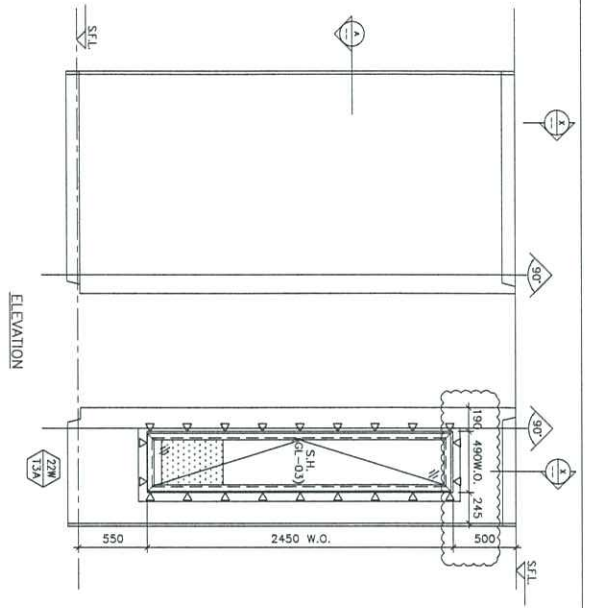

ELEVATION

ELEVATION

SECTION "X-X"

PART PLAN A

*Handwritten signature: SUT*

TYPE	TYPE I	TYPE II	TYPE III	TYPE IV
OPENABLE WINDOW DIMENSION	(WIDTH)	490	490	490
	(HEIGHT)	1928	1928	1928
NUMBER OF OPENABLE AREA WINDOW		1	1	1
GLAZING AREA		346	346	346
OPENABLE		1928	1928	1928
HEIGHT		1928	1928	1928
TOTAL		0.667	0.667	0.667
OPENABLE AREA		0.667	0.667	0.667
WIDTH		490	490	490
HEIGHT		1798	1798	1798
TOTAL		0.730	0.730	0.730

PROVIDED	GLAZING AREA	OPENABLE AREA
	0.667	0.730
	m <sup>2</sup>	m <sup>2</sup>

WINDOW MARK	22A 13A
LOCATION	22/F M.B. & ENB. AT TOWER 3 FLAT A
SECTION	70mm ALUM. SECTION
GLAZING	GL-01, GL-03
QUANTITY	1
REMARKS	FAÇADE (PF-34)

**BLD. REF.:**

**CLIENT:**

**ARCHITECT:**

**MAIN CONTRACTOR:**

**STRUCTURAL ENGINEER:**

**FAÇADE CONSULTANT:**

**NOTE:**  
 1. ALL DIMENSIONS ARE IN mm.  
 2. ALL DIMENSIONS ARE TAKEN FROM OUTSIDE.  
 3. ALL DIMENSIONS TO BE CHECKED ON SITE BEFORE FABRICATION.  
 4. REFER SHEET NO. (X) FOR DETAIL MARK NO.  
 5. REFER SHEET NO. (Y) FOR DETAIL MARK NO.  
 6. CLASS LEADER  
 7. F.F.L.--FINISHED FLOOR LEVEL  
 8. S.F.L.--STRUCTURAL FLOOR LEVEL  
 9. R.F.L.--REVERSED LEVEL  
 10. T.F.L.--TRACING LEVEL  
 11. T.L.O.--TRACING LEVEL LOCATION  
 12. CLASS LEADER  
 13. Q1.01--6mm+12mm AIR GAP+10mm THK. LGU.  
 14. Q1.02--6mm+12mm AIR GAP+12mm THK. LGU.  
 15. Q1.03--6mm+12mm AIR GAP+16mm THK. LGU.  
 16. Q1.04--6mm THK. DUBBED GLASS (PNEUMATIC BEARING)  
 17. Q1.05--6mm+12mm AIR GAP+16mm THK. LGU.

**JOB NO.:** J-852

**PROJECT:**  
 PROPOSED RESIDENTIAL DEVELOPMENT  
 AT 139 - 147 ARBON STREET,  
 NOL 6005, 6035 R.P., 6036 R.P.,  
 6037 R.P. & 6038 R.P.

**TITLE:**  
 WINDOW SCHEDULE FOR  
 ALUM. WINDOW

**DATE:** 05-04-19    **SCALE:** 1:140

**DRAWN BY:** JMN    **CHECKED BY:** DW

**UNIT:** mm

**REVISION:**

**REV.:** F

**CONTACT:**  
 美特堅有限公司  
 MIDO Architecture & Construction Ltd.  
 610 Sha Tin Road, Sha Tin, New Territories, H.K.  
 Tel: 23489211-4 Fax: (852) 27277666  
 DMC NO.: 852-50-PW-4371



橫向  
相牆  
槽  
差  
2 2 恩