

工程指示 / 要求簡箋 ENGINEER INSTRUCTIONS(E.I.)

工程指示編號:	EI- 6946	修改版本:	B
	HK- 2750		
工程編號:	J 853	工程名稱:	延坪道 (第2期)
收件人:	生統 / 謝永林	發件人:	Sam Lo
工程項目:	復裝圖拆圖修改	日期:	27/11/2023

<input type="checkbox"/> 原合約工程包	<input type="checkbox"/> 原合約工程加 / 減賬 QT-	<input type="checkbox"/> 新工程報價 QT-
---------------------------------	--	------------------------------------

信件批核號碼/圖紙參考編號:	批核模具圖紙編號:
客戶指示附件:	管理內部批簽署:

<input type="checkbox"/> 初步鋁料 B.M.	<input type="checkbox"/> 加工拆圖, 然後生產	<input type="checkbox"/> 尺寸表
<input type="checkbox"/> 正式鋁料 B.M.	<input type="checkbox"/> 技術上資料 / 指示	<input type="checkbox"/> 報價
<input type="checkbox"/> 配件 B.M.	<input type="checkbox"/> 樣辦或貨品說明書	<input type="checkbox"/> 分判合約
<input type="checkbox"/> 其他:		

內容: 修改B: 更新圖紙
① J853-SD-HIW-2123
② J853-SD-HIW-2124
完成上列要求日期:

國內

<input type="checkbox"/> 生產技術總監	<input type="checkbox"/> 連附件	<input type="checkbox"/> 技術部	<input type="checkbox"/> 連附件	<input type="checkbox"/> 生產部	<input type="checkbox"/> 連附件
<input type="checkbox"/> 採購部	<input type="checkbox"/> 連附件	<input checked="" type="checkbox"/> 生產統籌部	<input checked="" type="checkbox"/> 連附件	<input type="checkbox"/> 報關組	<input type="checkbox"/> 連附件
<input type="checkbox"/> 質檢部	<input type="checkbox"/> 連附件	<input type="checkbox"/> 會計部	<input type="checkbox"/> 連附件	<input type="checkbox"/> 機械設計部	<input type="checkbox"/> 連附件
<input type="checkbox"/> 香港辦	<input type="checkbox"/> 連附件	<input type="checkbox"/> 其他:			

香港

<input type="checkbox"/> 行政部	<input type="checkbox"/> 連附件	<input type="checkbox"/> 會計部	<input type="checkbox"/> 連附件	<input type="checkbox"/> 統籌部	<input type="checkbox"/> 連附件	<input type="checkbox"/> 工程部	<input type="checkbox"/> 連附件
<input type="checkbox"/> 採購部	<input type="checkbox"/> 連附件	<input type="checkbox"/> QS部	<input type="checkbox"/> 連附件	<input type="checkbox"/> 地盤管理	<input type="checkbox"/> 連附件	<input type="checkbox"/> 維修部	<input type="checkbox"/> 連附件

*發件人簽署: <i>Lo</i>	*組別成員批核簽署: <i>Lo</i>
傳遞編號: HK-2750	項目經理簽署:

B.D. REF :

CLIENT : SHIMAO GROUP HOLDINGS LIMITED

ARCHITECT : WONG TUNG & PARTNERS LIMITED

MAIN CONTRACTOR : HIP HING CONSTRUCTION CO. LTD

STRUCTURAL ENGINEER : C.M. WONG & ASSOCIATES LTD



FRACADE CONSULTANT : MENHARDT

NOTE:  
 1. ALL DIMENSIONS ARE IN mm.  
 2. ALL ELEVATIONS ARE VIEWED FROM OUTSIDE.  
 3. ALL ELEVATIONS TO BE VERIFIED ON SITE BEFORE FABRICATION.  
 LEGEND:  
 (1) DETAIL MARK NO.  
 (2) REFER SHEET NO.  
 1. F.F.L. -- FINISHED FLOOR LEVEL  
 2. S.F.L. -- STRUCTURAL FLOOR LEVEL  
 3. (R) -- REVERSED DETAIL  
 4. ▲ -- FINING LOCATION  
 5. GLASS LEGEND  
 6. GLO1 -- 10mm HS. 112mm AR 04+10mm TP THK. LGL  
 GLO4 -- 10mm HS. 112mm CLEAR TEMPERED GLASS  
 GLO6 -- 10mm HS. 112mm AR 04+10mm TP THK. LGL  
 P001 -- 10mm TP+12mm AR 04+10mm TP  
 7. [E1] 120x60x6mm THK. G.M.S. R.H.S.  
 [E2] 120x120x6mm THK. G.M.S. S.H.S.  
 [E3] 200x100x6mm THK. G.M.S. R.H.S.  
 [E4] [AL] -- PVF2 COATED ALUMINIUM SPRAY TRIMMER (4 COAT SYSTEM) CODE: EG-06-0334032 COLOR: 607Y 07/093 METALLIC



A 30/10/2023 GENERAL REVISED

JOB NO. : J-853  
 PROJECT : PROPOSED RESIDENTIAL DEVELOPMENT AT N.K.I.L. 6542 YIN PING ROAD KOWLOON

DATE : 12-FEB-23 SCALE : 1:40  
 DRAWN BY : Asing CHECKED BY :  
 MIDY ARCHITECTURE PRACTICE LTD.  
 Units 6-8, Sunray Industrial Centre, 1/F  
 610 Che Kwo Ling Road, Kowloon  
 Tel: 2489211-4 Fax: (852) 2727686  
 DWG NO. : 4653-50-RW-2123 REV. : A

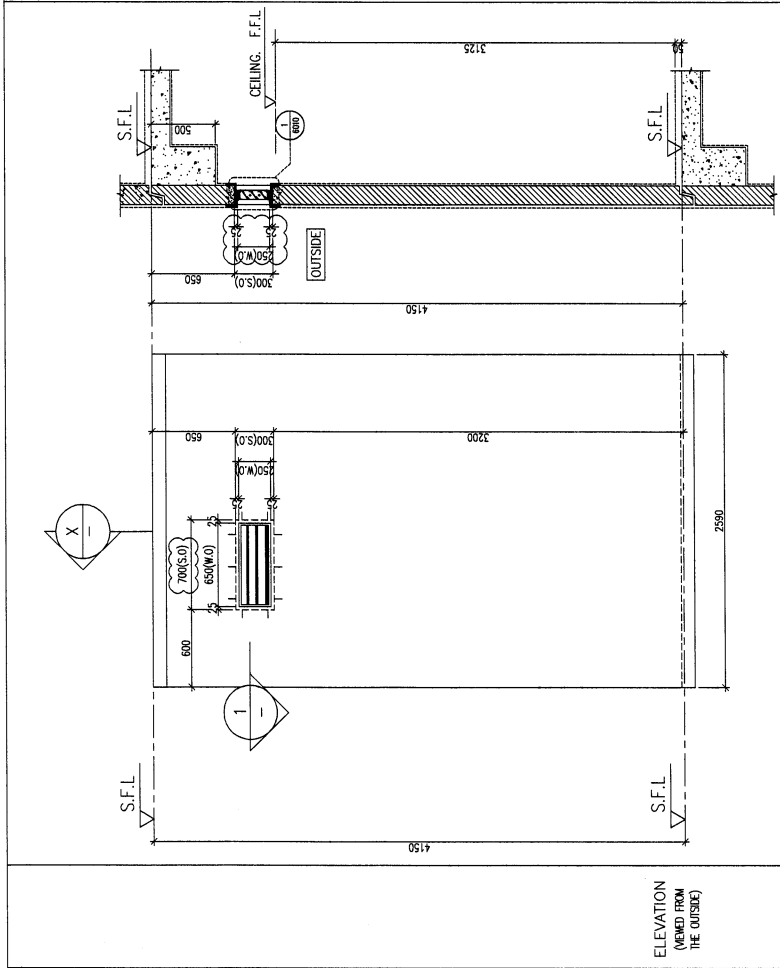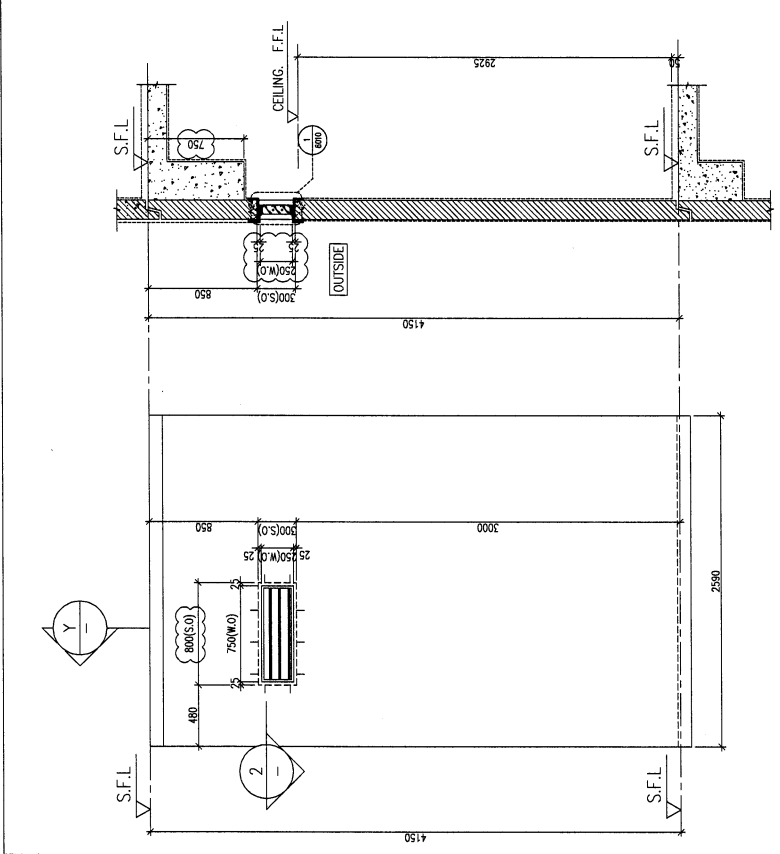

ELEVATION (VIEWED FROM THE OUTSIDE)

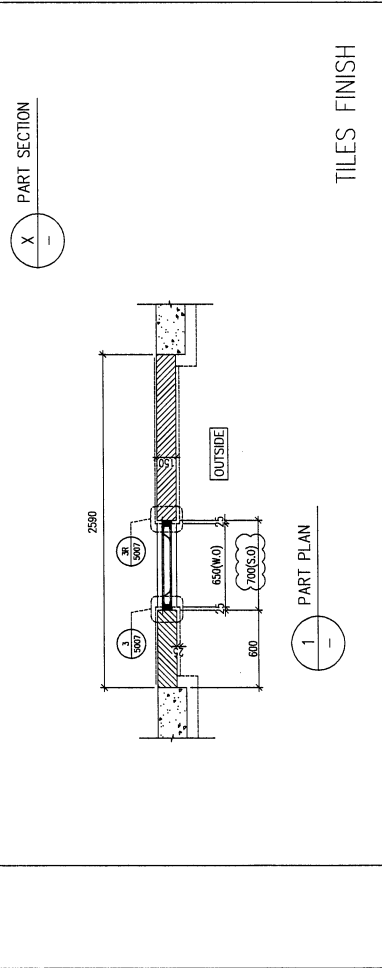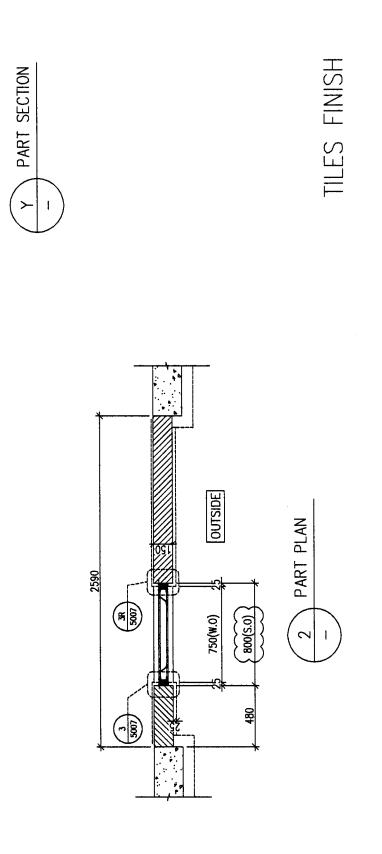

ELEVATION (VIEWED FROM THE OUTSIDE)

TILES FINISH

PROVIDED	
GLAZING AREA	— m <sup>2</sup>
OPENABLE AREA	— m <sup>2</sup>
FREE AREA	58.5 %

MIRROR	
HOUSE TYPE A1 - 3/F M. BATH	70mm ALUM. SECTION [AL1]
GLO1	1 No. (HOUSE NO. HA2 & HA6 HANDED)

TILES FINISH

PROVIDED	
GLAZING AREA	— m <sup>2</sup>
OPENABLE AREA	— m <sup>2</sup>
FREE AREA	58.5 %

MIRROR	
HOUSE TYPE A - 1/F MULTI-PURPOSE ROOM	70mm ALUM. SECTION [AL1]
GLO1	2 Nos. (HOUSE NO. HA2 & HA6 HANDED)

WINDOW MARK	QUANTITY
HOUSE TYPE A1 - 1/F MULTI-PURPOSE ROOM	1 No. (HOUSE NO. HA7)
HOUSE TYPE A - 1/F MULTI-PURPOSE ROOM	2 Nos. (HOUSE NO. HA2 & HA6 HANDED)

B.O. REF. :

CLIENT : SHIMAO GROUP HOLDINGS LIMITED

ARCHITECT : WONG TUNG & PARTNERS LIMITED

MAIN CONTRACTOR : HIP HING CONSTRUCTION CO LTD

STRUCTURAL ENGINEER : ICMA C M WONG & ASSOCIATES LTD

FACADE CONSULTANT : MEINHARDT

NOTE :  
 1. ALL DIMENSIONS ARE IN MM.  
 2. ALL ELEVATIONS ARE VIEWED FROM OUTSIDE.  
 3. ALL DIMENSIONS TO BE VERIFIED ON SITE BEFORE FABRICATION.

LEGEND :  
 (A1) — DETAIL MARK NO.  
 (S01) — REFER SHEET NO.

1. F.F.L. — FINISHED FLOOR LEVEL.  
 2. S.F.L. — STRUCTURAL FLOOR LEVEL.  
 3. (P) — REVERSED DETAIL.  
 4. ▲ — FINING LOCATION

5. GLASS LEGEND  
 6. GLO1 — 10mm IS. 12mm AR OPT-TEMP TP THK. IGLL  
 GLO4 — 12mm CLEAR TEMPERED GLASS  
 GLO5 — 12mm CLEAR TEMPERED GLASS  
 P001 — 10mm TP+12mm AR G04+8mm TP  
 P002 — 10mm TP+12mm AR G04+8mm TP

7. [S1] 120x60x6mm THK. G.M.S. R.H.S.  
 [S2] 120x120x6mm THK. G.M.S. S.H.S.  
 [S3] 200x100x6mm THK. G.M.S. R.H.S

8. [LAL] J-PWF COATED ALUMINIUM SPRAY FINISH  
 (A COAT SYSTEM CODE: EC-06-1004222 COLOR : 8007 0/05 METALLIC

B | 13/11/2023 GENERAL REVISED  
 A | 06/10/2023 GENERAL REVISED

JOB NO. : J-853

PROJECT : PROPOSED RESIDENTIAL DEVELOPMENT AT N.K.L.L. 6542 YIN PING ROAD KOWLOON



TITLE : IN-SITU ALUM. WINDOW SCHEDULE FOR HOUSE TYPE A

DATE : 12-FEB-23 SCALE : 1:40

DRAWN BY : Aching CHECKED BY :

UNIT : MIDT ALUMINIUM FABRICATOR LTD.  
 Units 6-8, Sunny Industrial Centre, 1/F  
 242-248B21-1, 248(S)272766

DWG NO. : 4853-30-HW-2124 REV. : B

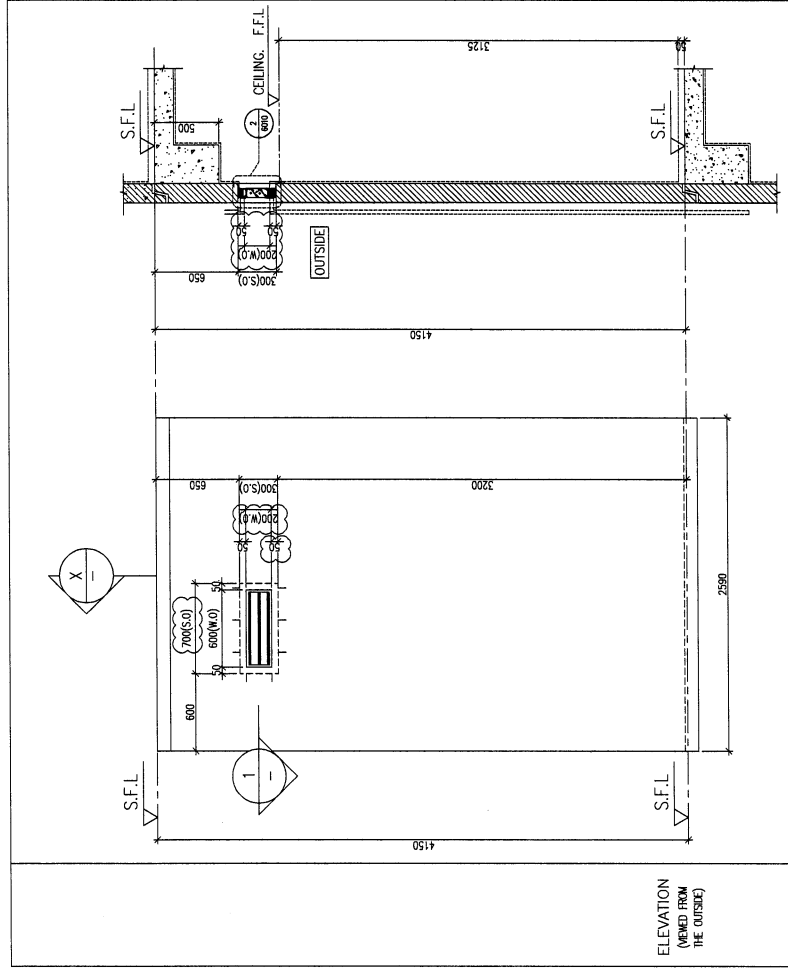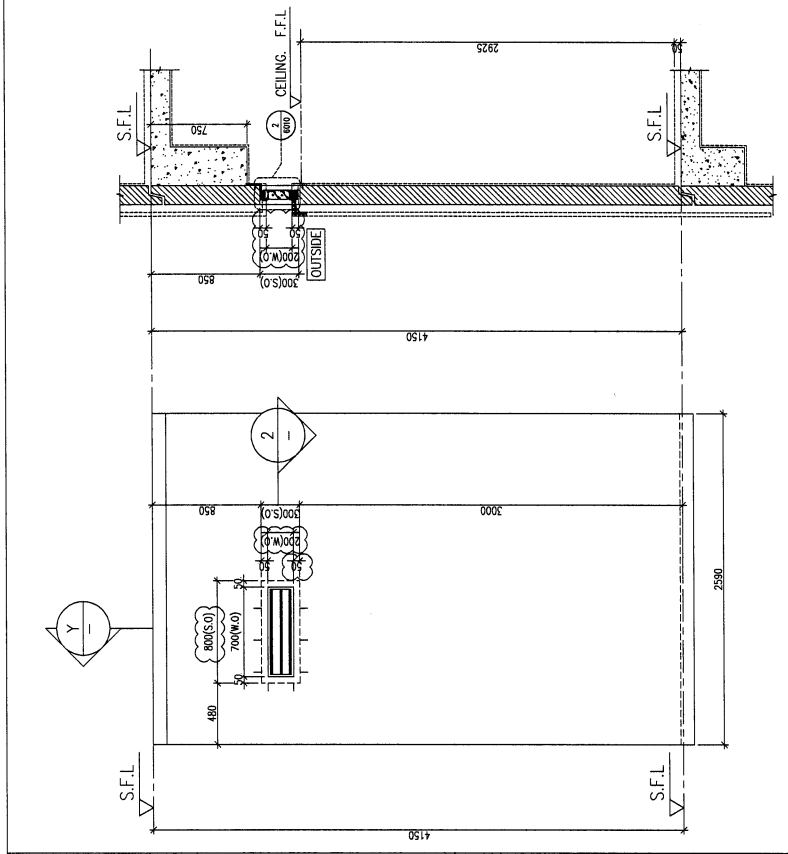

STONE CLADDING FINISH

2 PART PLAN

2 PART SECTION

PROVIDED	
GLAZING AREA	— m <sup>2</sup>
OPENABLE AREA	— m <sup>2</sup>
FREE AREA	58.5 %

WINDOW MARK	MIRROR
HOUSE TYPE A — 1/F MULTI-PURPOSE ROOM	HOUSE TYPE A1 — 3/F M. BATH
70mm ALUM. SECTION [A1]	70mm ALUM. SECTION [A1]
GLO1	GLO1
1 No. HOUSE NO. HA8	3 Nos HOUSE NO. HA1, HA3 & HA5

STONE CLADDING FINISH

1 PART PLAN

X PART SECTION

PROVIDED	
GLAZING AREA	— m <sup>2</sup>
OPENABLE AREA	— m <sup>2</sup>
FREE AREA	58.5 %

WINDOW MARK	MIRROR
HOUSE TYPE A — 1/F MULTI-PURPOSE ROOM	HOUSE TYPE A1 — 1/F MULTI-PURPOSE ROOM
70mm ALUM. SECTION [A1]	70mm ALUM. SECTION [A1]
GLO1	GLO1
1 No. HOUSE NO. HA8	3 Nos HOUSE NO. HA1, HA3 & HA5