



工程指示 / 要求簡箋 ENGINEER INSTRUCTIONS(E.I.)

工程指示編號:	EI-7133	修改版本:	A
	HK-0575		
工程編號:	J 853	工程名稱:	延坪道 (第2期)
收件人:	生統/	發件人:	Jingo
工程項目:	Up欄河 6a 施工圖 拆圖用	日期:	28/03/2024

<input type="checkbox"/> 原合約工程包	<input type="checkbox"/> 原合約工程加 / 減脹 QT-	<input type="checkbox"/> 新工程報價 QT-
---------------------------------	--	------------------------------------

信件批核號碼/圖紙參考編號:	批核模具圖紙編號:
客戶指示附件:	管理內部批簽署:

<input type="checkbox"/> 初步鋁料 B.M.	<input type="checkbox"/> 加工拆圖, 然後生產	<input type="checkbox"/> 尺寸表
<input type="checkbox"/> 正式鋁料 B.M.	<input type="checkbox"/> 技術上資料/指示	<input type="checkbox"/> 報價
<input type="checkbox"/> 配件 B.M.	<input type="checkbox"/> 樣辦或貨品說明書	<input type="checkbox"/> 分判合約
<input type="checkbox"/> 其他:		

內容:
請按 6a 施工圖做拆圖

完成上列要求日期: 02/04/2024

國內

<input type="checkbox"/> 生產技術總監	<input type="checkbox"/> 連附件	<input checked="" type="checkbox"/> 技術部	<input checked="" type="checkbox"/> 連附件	<input type="checkbox"/> 生產部	<input type="checkbox"/> 連附件
<input type="checkbox"/> 採購部	<input type="checkbox"/> 連附件	<input checked="" type="checkbox"/> 生產統籌部	<input checked="" type="checkbox"/> 連附件	<input type="checkbox"/> 報關組	<input type="checkbox"/> 連附件
<input type="checkbox"/> 質檢部	<input type="checkbox"/> 連附件	<input type="checkbox"/> 會計部	<input type="checkbox"/> 連附件	<input type="checkbox"/> 機械設計部	<input type="checkbox"/> 連附件
<input type="checkbox"/> 香港辦	<input type="checkbox"/> 連附件	<input type="checkbox"/> 其他:			

香港

<input type="checkbox"/> 行政部	<input type="checkbox"/> 連附件	<input type="checkbox"/> 會計部	<input type="checkbox"/> 連附件	<input type="checkbox"/> 統籌部	<input type="checkbox"/> 連附件	<input type="checkbox"/> 工程部	<input type="checkbox"/> 連附件
<input type="checkbox"/> 採購部	<input type="checkbox"/> 連附件	<input type="checkbox"/> QS部	<input type="checkbox"/> 連附件	<input type="checkbox"/> 地盤管理	<input type="checkbox"/> 連附件	<input type="checkbox"/> 維修部	<input type="checkbox"/> 連附件

*發件人簽署:	*組別成員批核簽署:
傳遞編號:	項目經理簽署:

PROJECT :

PROPOSED RESIDENTIAL
DEVELOPMENT AT
NKIL 6542, TAI WO PING, KOWLOON


6a

SHOPDRAWING SUBMISSION
FOR HOUSE GLASS BALUSTRADE (UP GLASS BALUSTRADE FOR)
(UP GLASS BALUSTRADE FOR HOUAE TYPE B, C, D, D1, E, E1 & G)
DATE: 26-MAR.-2024



Units 6-8, Sunray Industrial Centre, 1/F
610 Cha Kwo Ling Road, Kowloon
Tel:33489211-4 Fax:(852)2727666

B.D. REF :

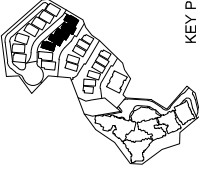

KEY PLAN

CLIENT :

SHIMAO GROUP HOLDINGS LIMITED

ARCHITECT : HONG HING & ASSOCIATES LIMITED

MAIN CONTRACTOR : 協興建築有限公司 HHP HING CONSTRUCTION CO LTD

STRUCTURAL ENGINEER :

C M WONG & ASSOCIATES LTD 黃志明建築工程師有限公司

FAÇADE CONSULTANT :

WEINHARDT

NOTE :

- 1. ALL DIMENSIONS ARE IN mm.
- 2. ALL ELEVATIONS ARE VIEWED FROM OUTSIDE.
- 3. ALL DIMENSIONS TO BE VERIFIED ON SITE BEFORE FABRICATION.

LEGEND :

- (X1) DETAIL MARK NO.
- (X2) REFER SHEET NO.

- 1. F.F.L. -- FINISHED FLOOR LEVEL
 - 2. S.F.L. -- STRUCTURAL FLOOR LEVEL
 - 3. -- REVERSED DETAIL
- R.C. STRUCTURAL ELEMENT
COL. / BEAM / SLAB
IS (UNDER SEPARATED SUBMISSION)

E	20/12/2023	GENERAL REVISED
D	30/11/2023	GENERAL REVISED
C	8/8/2023	GENERAL REVISED
B	10/5/2023	GENERAL REVISED
A	3/1/2023	GENERAL REVISED
NO.	DATE	BY
		80928

JOB NO. : J-853

PROJECT : PROPOSED RESIDENTIAL DEVELOPMENT AT N.K.I.L. 6542 YIN PING ROAD KOWLOON

TITLE : 1/F TO R/F LOCATION PLAN FOR HOUSE GLASS BALUSTRADE AT HOUSE TYPE C (HOUSE NO. HB3, HB5, HB6, HB7 & HB8)

DATE : 08-Dec-22


SCALE : 1:75 (A1)

DRAWN BY : Asing


CHECKED BY :

美特 紀實有限公司 MIDY INTERNATIONAL ENGINEERING LTD. Units 6-8, Suncoy Industrial Centre, 1/F 810, Cho Kwai Road, Kowloon. Tel: 23689211-4 Fax: (852) 27271966


REV. : E

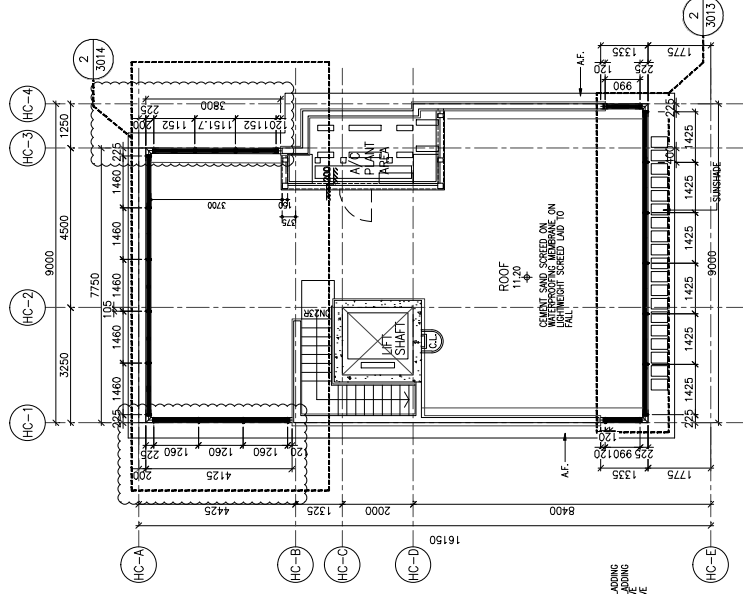

HOUSE TYPE C - ROOF PLAN (HOUSE NO. HB3, HB5, HB6, HB7 & HB8)

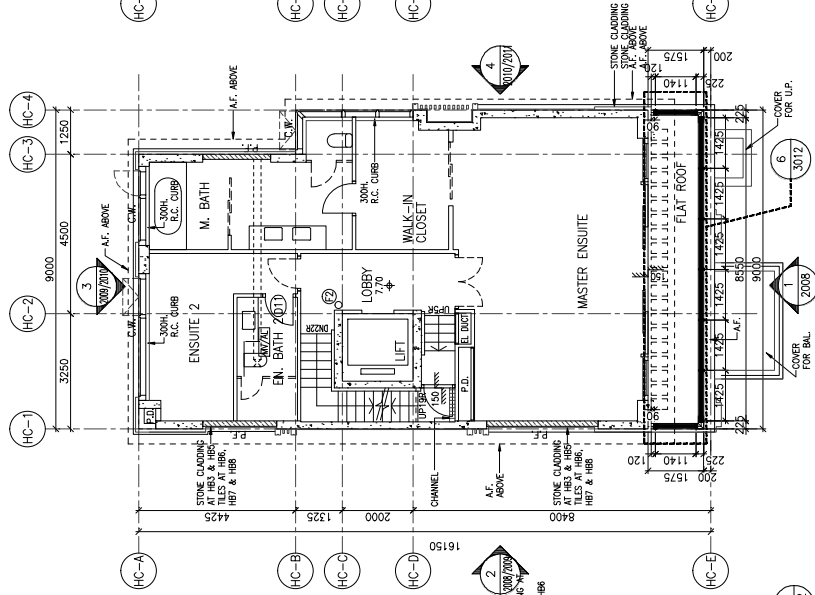


HOUSE TYPE C - 2/F PLAN (HOUSE NO. HB3, HB5, HB6, HB7 & HB8)

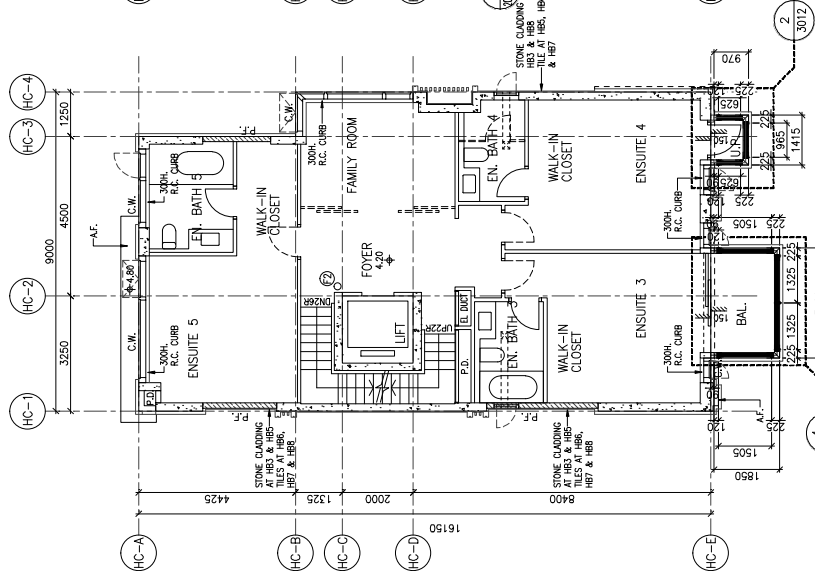

HOUSE TYPE C - 1/F PLAN (HOUSE NO. HB3, HB5, HB6, HB7 & HB8)

B.D. REF :

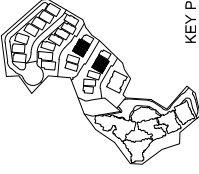

KEY PLAN

CLIENT :

SHIMAO GROUP HOLDINGS LIMITED


ARCHITECT :



MAIN CONTRACTOR :



STRUCTURAL ENGINEER :

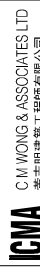

FAÇADE CONSULTANT :



NOTE :
1. ALL DIMENSIONS ARE IN mm.
2. ALL ELEVATIONS ARE VIEWED FROM OUTSIDE.
3. ALL DIMENSIONS TO BE VERIFIED ON SITE BEFORE FABRICATION.

LEGEND :

- (X1) DETAIL MARK NO.
- (X2) REFER SHEET NO.
- 1. F.F.L. -- FINISHED FLOOR LEVEL
- 2. S.F.L. -- STRUCTURAL FLOOR LEVEL
- 3. (R) -- REVERSED DETAIL
- R.C. STRUCTURAL ELEMENT
- COL. / BEAM / SLAB
- IS (UNDER SEPARATED SUBMISSION)

D	30/11/2023	GENERAL REVISED
C	8/8/2023	GENERAL REVISED
B	10/5/2023	GENERAL REVISED
A	3/1/2023	GENERAL REVISED
NO.	DATE	BY
		6808D

JOB NO. : J-853

PROJECT :
PROPOSED RESIDENTIAL DEVELOPMENT AT N.K.I.L. 6542 YIN PING ROAD KOWLOON

TITLE :
1/F & R/F LOCATION PLAN FOR HOUSE GLASS BALUSTRADE AT HOUSE TYPE D (HOUSE NO. HC3, HC5, HD5 & HD6)


DATE : 08-Dec-22
SCALE : 1:75 (A1)

DRAWN BY : Aising
CHECKED BY :




Units 6-8, Suncoy Industrial Centre, 1/F
810, Cho Kwong Road, Kowloon
Tel: 23489211-4 Fax: (852) 27271666

REV. : E
DWG NO. : J853-SD-HGB/D-1005

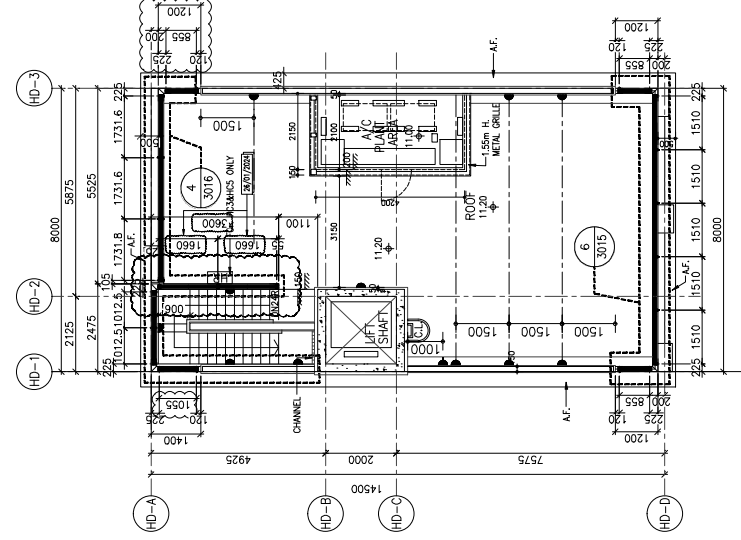


HOUSE TYPE D - ROOF PLAN
(HOUSE NO. HC3, HC5, HD5 & HD6)

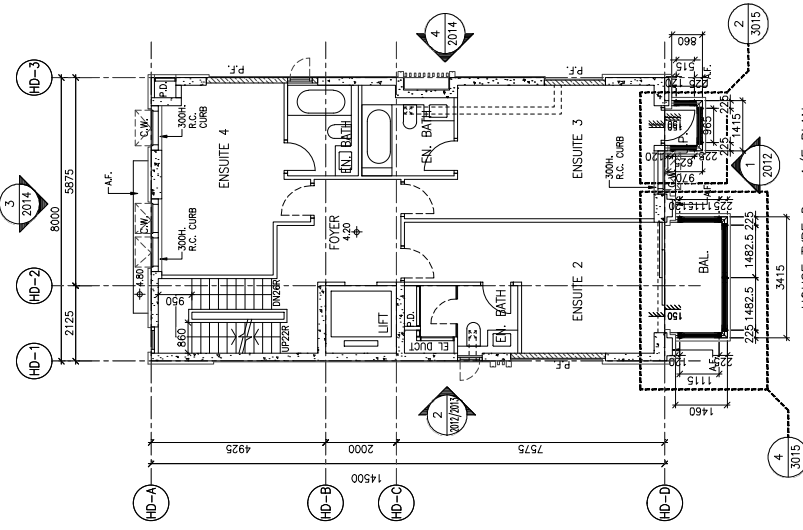

HOUSE TYPE D - 1/F PLAN
(HOUSE NO. HC3, HC5, HD5 & HD6)

B.D. REF :

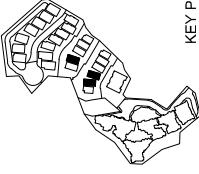

KEY PLAN

CLIENT :

SHIMAO GROUP HOLDINGS LIMITED

ARCHITECT :



MAIN CONTRACTOR :

協興建築有限公司
HIP HING CONSTRUCTION CO LTD

STRUCTURAL ENGINEER :

C/M WONG & ASSOCIATES LTD
黃志明建築工程師有限公司

FAÇADE CONSULTANT :



NOTE :

- 1. ALL DIMENSIONS ARE IN mm.
- 2. ALL ELEVATIONS ARE VIEWED FROM OUTSIDE.
- 3. ALL DIMENSIONS TO BE VERIFIED ON SITE BEFORE FABRICATION.

LEGEND :

- (X1) DETAIL MARK NO.
- (X02) REFER SHEET NO.
- 1. F.F.L. -- FINISHED FLOOR LEVEL
- 2. S.F.L. -- STRUCTURAL FLOOR LEVEL
- 3. (R) -- REVERSED DETAIL

R.C. STRUCTURAL ELEMENT
COL. / BEAM / SLAB
IS (UNDER SEPARATED SUBMISSION)

NO.	DATE	BY	REVISION
D	30/11/2023		GENERAL REVISED
C	8/8/2023		GENERAL REVISED
B	10/5/2023		GENERAL REVISED
A	3/1/2023		GENERAL REVISED

JOB NO. : J-853

PROJECT :
PROPOSED RESIDENTIAL
DEVELOPMENT AT N.K.I.L. 6542
YIN PING ROAD
KOWLOON

TITLE :


1/F & R/F LOCATION PLAN
FOR HOUSE GLASS BALUSTRADE
AT HOUSE TYPE D1
(HOUSE NO. HC2, HD2, HD3)

DATE : 08-Dec-22

SCALE : 1:75 (A1)


DRAWN BY : Asing

CHECKED BY :

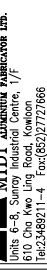


Units 6-8, Suncoy Industrial Centre, 1/F
810, Cho Kwong Road, Kowloon
Tel: 23689211-4 Fax: 23689212/21986

DWG NO. : JB53-SD-HGB/D1-1006 REV. : E

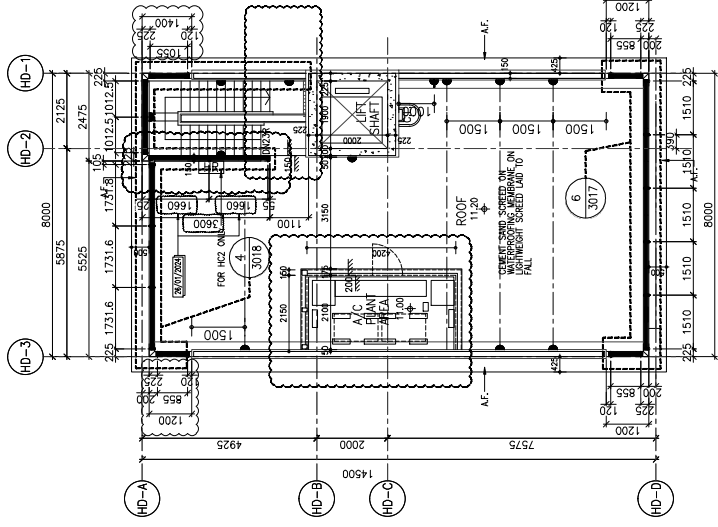


HOUSE TYPE D1 -- ROOF PLAN
(HOUSE NO. HC2, HD2, HD3)

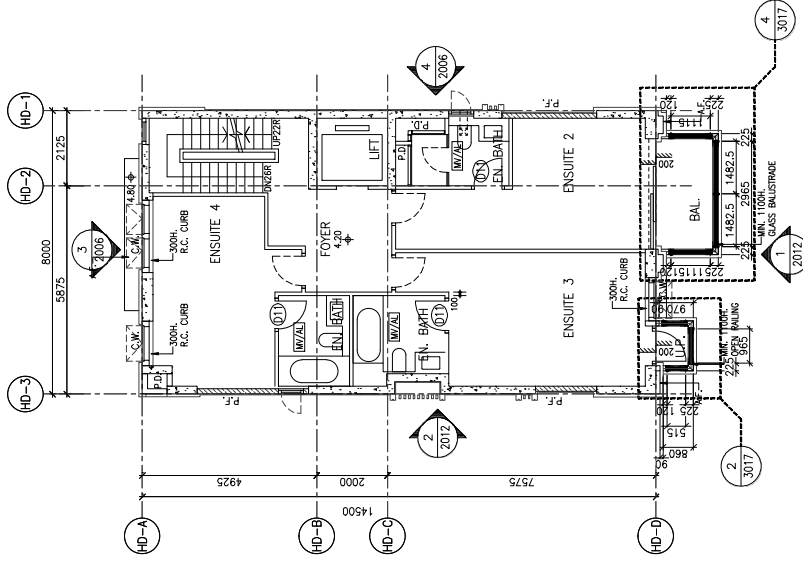

HOUSE TYPE D1 -- 1/F PLAN
(HOUSE NO. HC2, HD2, HD3)

B.D. REF :

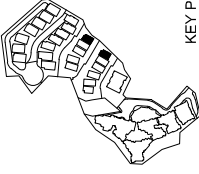

KEY PLAN


CLIENT :

SHIMAO GROUP HOLDINGS LIMITED

ARCHITECT :



MAIN CONTRACTOR :

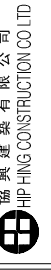

STRUCTURAL ENGINEER :



FAÇADE CONSULTANT :



NOTE :

1. ALL DIMENSIONS ARE IN mm.
2. ALL ELEVATIONS ARE VIEWED FROM OUTSIDE.
3. ALL DIMENSIONS TO BE VERIFIED ON SITE BEFORE FABRICATION.

LEGEND :

- (X1) DETAIL MARK NO.
- (X2) REFER SHEET NO.

1. F.F.L. -- FINISHED FLOOR LEVEL
 2. S.F.L. -- STRUCTURAL FLOOR LEVEL
 3. (R) -- REVERSED DETAIL
- R.C. STRUCTURAL ELEMENT
COL. / BEAM / SLAB
IS (UNDER SEPARATED SUBMISSION)

NO.	DATE	BY	REVISION
D	30/11/2023		GENERAL REVISED
C	8/8/2023		GENERAL REVISED
B	10/5/2023		GENERAL REVISED
A	3/1/2023		GENERAL REVISED

JOB NO. : J-853

PROJECT : PROPOSED RESIDENTIAL DEVELOPMENT AT N.K.I.L. 6542 YIN PING ROAD KOWLOON


TITLE : 1/F & R/F LOCATION PLAN FOR HOUSE GLASS BALUSTRADE AT HOUSE TYPE E (HOUSE NO. HC6 & HD7)

DATE : 08-Dec-22 SCALE : 1:75 (A1)


DRAWN BY : Asing CHECKED BY :



REV. : E DWG NO. : J853-SD-HGB/E-1007

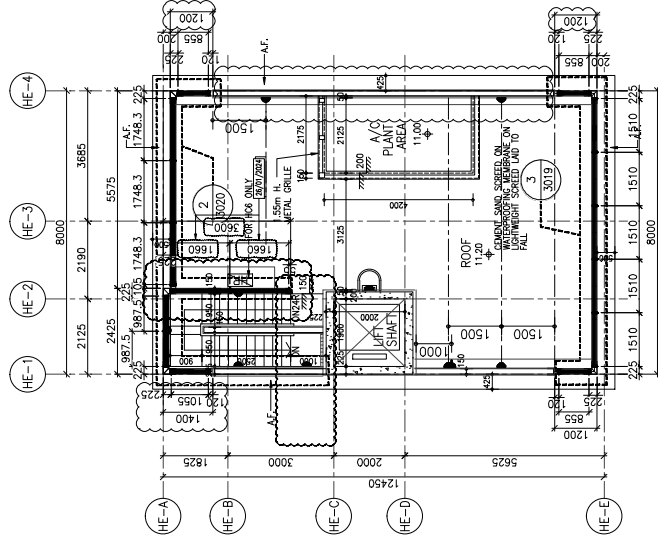


HOUSE TYPE E - ROOF PLAN (HOUSE NO. HC6 & HD7)

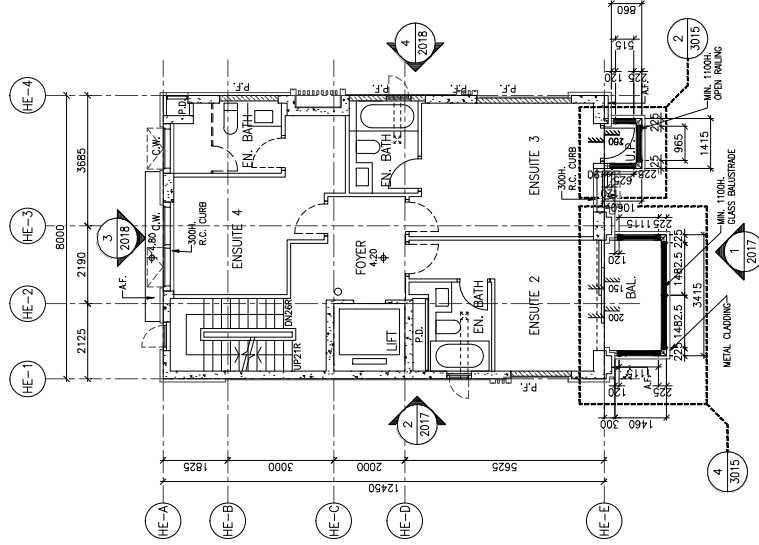

HOUSE TYPE E - 1/F PLAN (HOUSE NO. HC6 & HD7)

B.D. REF :

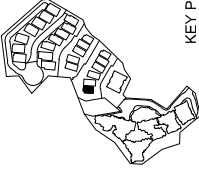

KEY PLAN

CLIENT :

SHIMAO GROUP HOLDINGS LIMITED


ARCHITECT :



MAIN CONTRACTOR :



STRUCTURAL ENGINEER :

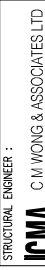

FAÇADE CONSULTANT :



NOTE :

- 1. ALL DIMENSIONS ARE IN mm.
- 2. ALL ELEVATIONS ARE VIEWED FROM OUTSIDE.
- 3. ALL DIMENSIONS TO BE VERIFIED ON SITE BEFORE FABRICATION.

LEGEND :

① DETAIL MARK NO.

② REFER SHEET NO.

1. F.F.L -- FINISHED FLOOR LEVEL

2. S.F.L -- STRUCTURAL FLOOR LEVEL

3. Ⓞ -- REVERSED DETAIL

R.C. STRUCTURAL ELEMENT

COL. / BEAM / SLAB

IS (UNDER SEPARATED SUBMISSION)

D	30/11/2023	GENERAL REVISED
C	8/8/2023	GENERAL REVISED
B	10/5/2023	GENERAL REVISED
A	3/1/2023	GENERAL REVISED
NO.	DATE	REVISION

JOB NO. : J-853

PROJECT :

PROPOSED RESIDENTIAL DEVELOPMENT AT N.K.I.L. 6542 YIN PING ROAD KOWLOON

TITLE :


1/F & R/F LOCATION PLAN FOR HOUSE GLASS BALUSTRADE AT HOUSE TYPE E1 (HOUSE NO. HD1)

DATE : 08-Dec-22

SCALE : 1:75 (A1)


DRAWN BY : Asing

CHECKED BY :

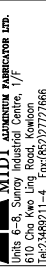


Units 6-8, Suncoy Industrial Centre, 1/F 810 Chee Kwo Ling Road, Kowloon Tel: 23489211-4 Fax: (852) 27271866

DWG NO. : J853-S0-HGB/E1-1008 REV. : E

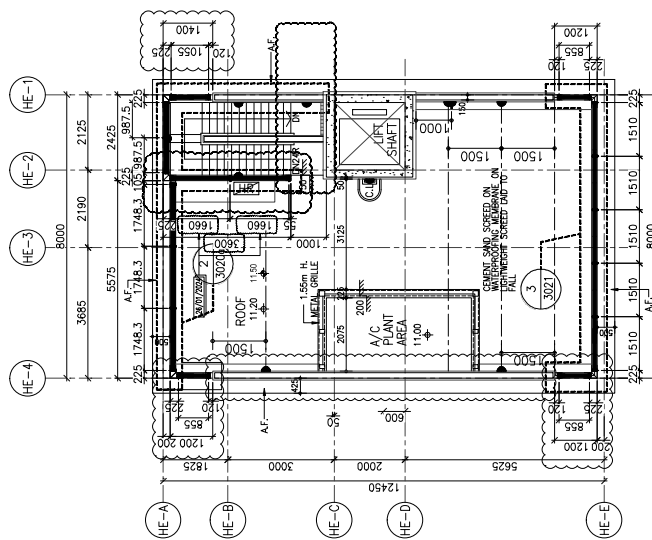


HOUSE TYPE E1 - ROOF PLAN (HOUSE NO. HD1)

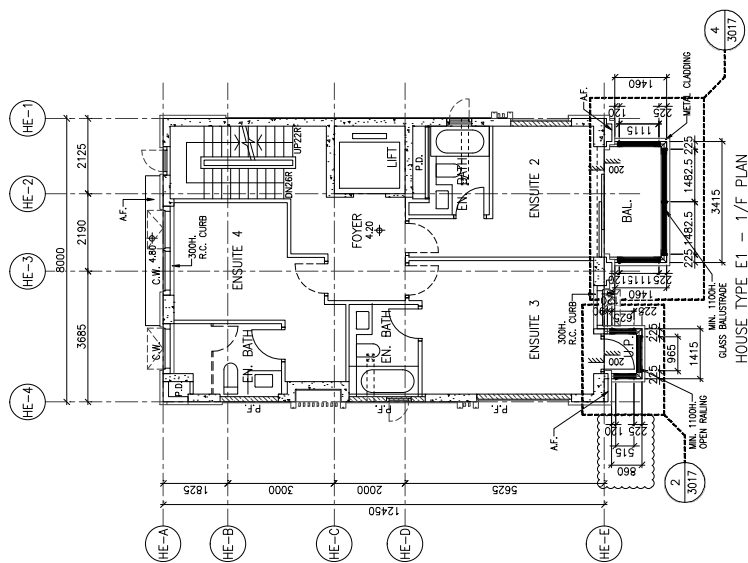

HOUSE TYPE E1 - 1/F PLAN (HOUSE NO. HD1)

B.D. REF :

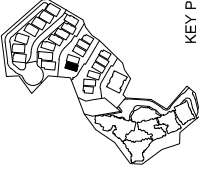

KEY PLAN

CLIENT :

SHIMAO GROUP HOLDINGS LIMITED


ARCHITECT :



MAIN CONTRACTOR :



STRUCTURAL ENGINEER :

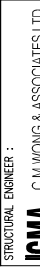

FAÇADE CONSULTANT :



NOTE :

- 1. ALL DIMENSIONS ARE IN mm.
- 2. ALL ELEVATIONS ARE VIEWED FROM OUTSIDE.
- 3. ALL DIMENSIONS TO BE VERIFIED ON SITE BEFORE FABRICATION.

LEGEND :

- (X1) DETAIL MARK NO.
- (X2) REFER SHEET NO.

- 1. F.F.L. -- FINISHED FLOOR LEVEL
 - 2. S.F.L. -- STRUCTURAL FLOOR LEVEL
 - 3. (R) -- REVERSED DETAIL
- R.C. STRUCTURAL ELEMENT
COL. / BEAM / SLAB
IS (UNDER SEPARATED SUBMISSION)

C	8/8/2023	GENERAL REVISED	
B	10/5/2023	GENERAL REVISED	
A	3/1/2023	GENERAL REVISED	
NO.	DATE	REASON	BY

JOB NO. : J-853

PROJECT :

PROPOSED RESIDENTIAL DEVELOPMENT AT N.K.I.L. 6542 YIN PING ROAD KOWLOON

TITLE :


1/F & R/F LOCATION PLAN FOR HOUSE GLASS BALUSTRADE AT HOUSE TYPE G (HOUSE NO. HC1)

DATE : 08-Dec-22

SCALE : 1:75 (A1)


DRAWN BY : Asing

CHECKED BY :

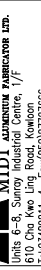


Units 6-8, Suncoy Industrial Centre, 1/F, 810, Cho Yee Ling Road, Kowloon, Tel: 23489211-4 Fax: (852) 27271866

REV. : C

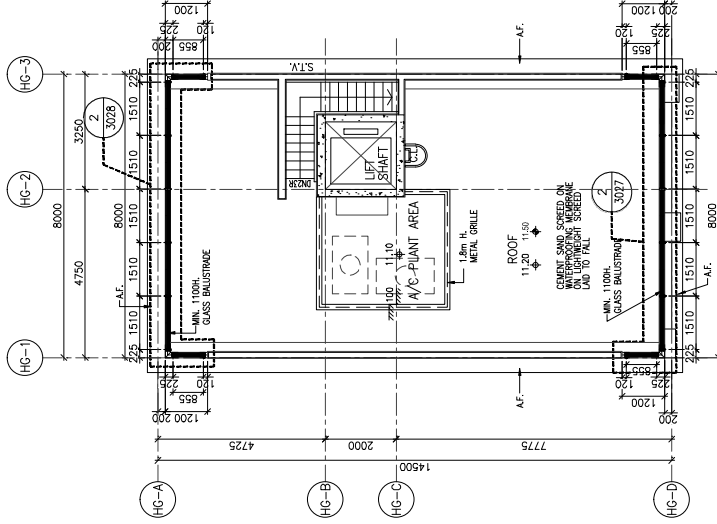

HOUSE TYPE G - ROOF PLAN (HOUSE NO. HC1)

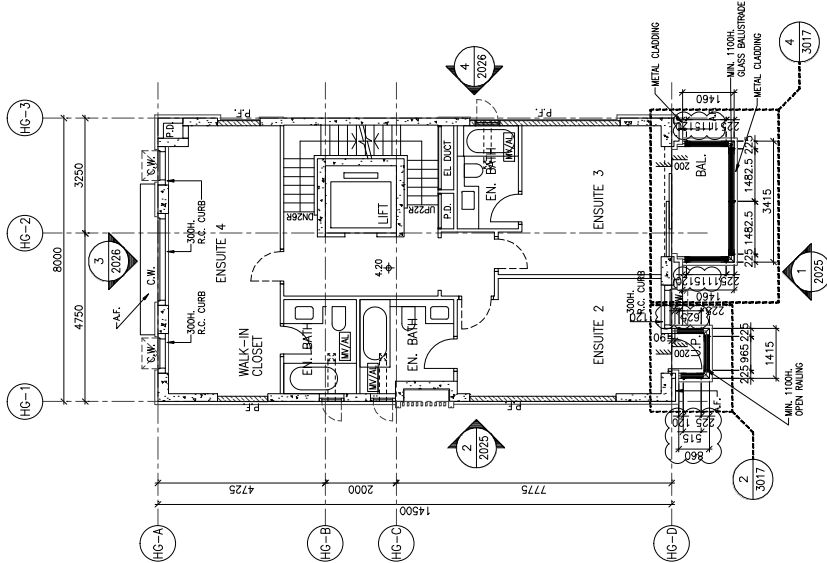

HOUSE TYPE G - 1/F PLAN (HOUSE NO. HC1)

CLIENT :
SHIMAO GROUP HOLDINGS LIMITED

ARCHITECT :
YONG TUNG & PARTNERS LIMITED
ARCHITECTS & PLANNERS



MAIN CONTRACTOR :
HIP HING CONSTRUCTION CO LTD

STRUCTURAL ENGINEER :
GMA C M WONG & ASSOCIATES LTD

FAÇADE CONSULTANT:
MEIN-HARDT

NOTE :

1. ALL DIMENSIONS ARE IN mm.
2. ALL ELEVATIONS ARE VIEWED FROM OUTSIDE.
3. ALL DIMENSIONS TO BE VERIFIED ON SITE BEFORE FABRICATION.

LEGEND :

- (X1) DETAIL MARK NO.
- (X00) REFER SHEET NO.
- 1. F.F.L. -- FINISHED FLOOR LEVEL
- 2. S.F.L. -- STRUCTURAL FLOOR LEVEL
- 3. (R) -- REVERSED DETAIL









R.C. STRUCTURAL ELEMENT
COL. / BEAM / SLAB
IS (UNDER SEPARATED SUBMISSION)

NO.	DATE	REVISION
E	22/12/2023	GENERAL REVISED
D	2/12/2023	GENERAL REVISED
C	8/8/2023	GENERAL REVISED
B	10/5/2023	GENERAL REVISED
A	3/1/2023	GENERAL REVISED

JOB NO. : J-853
PROJECT : PROPOSED RESIDENTIAL DEVELOPMENT AT N.K.I.L. 6542 YIN PING ROAD KOWLOON


TITLE : PART ELEVATION/PART PLAN & PART SECTION FOR HOUSE GLASS BALUSTRADE

DATE : 08-Dec-22 SCALE : 1:25 (A1)
DRAWN BY : ASING CHECKED BY :
美特 鋸寶有限公司
MIDI Aluminium Fabricator Ltd.
Units 6-8, Sunray Industrial Centre, 1/F
610 Ono Kwo Ling Road, Kowloon
Tel:23489211-4 Fax:(852)27277866
DWG NO. : J853-SD-HGB-3012 REV. : G

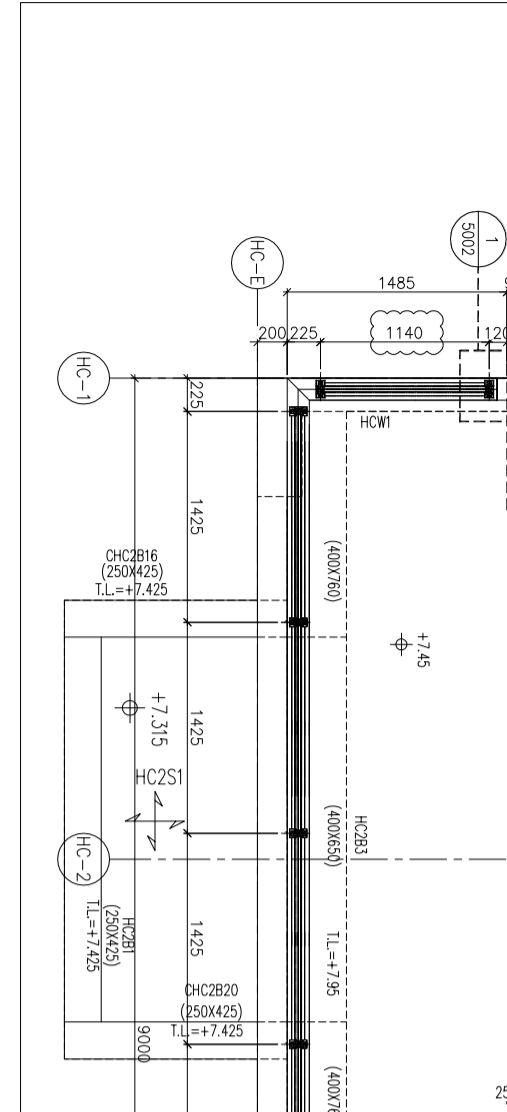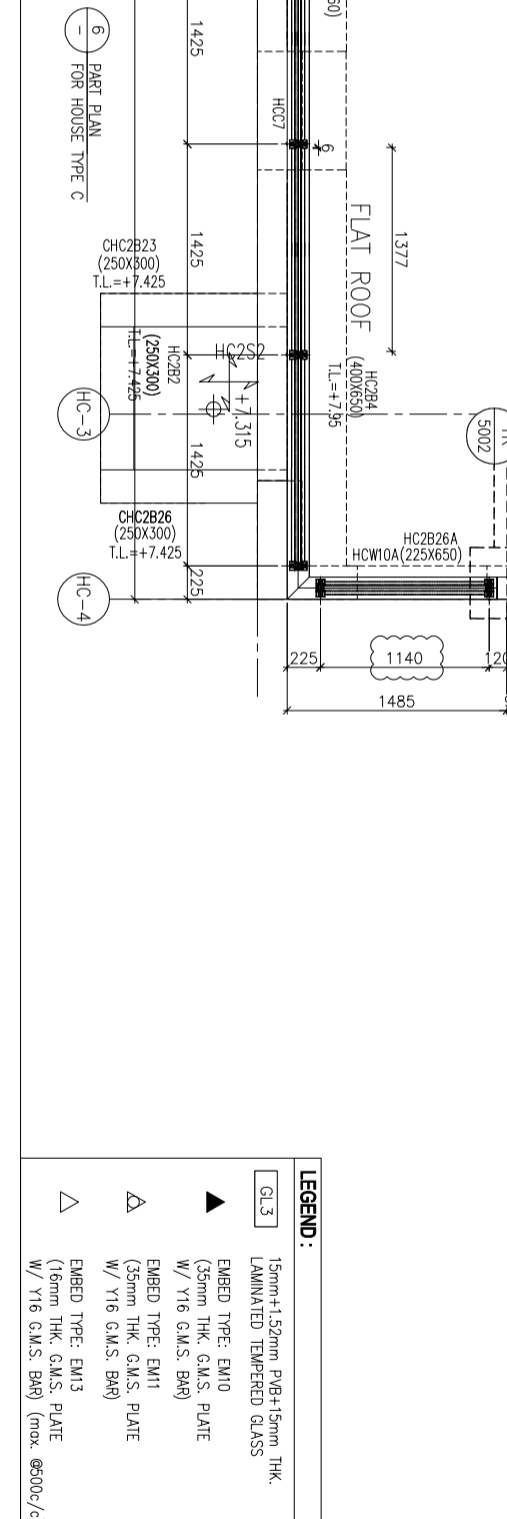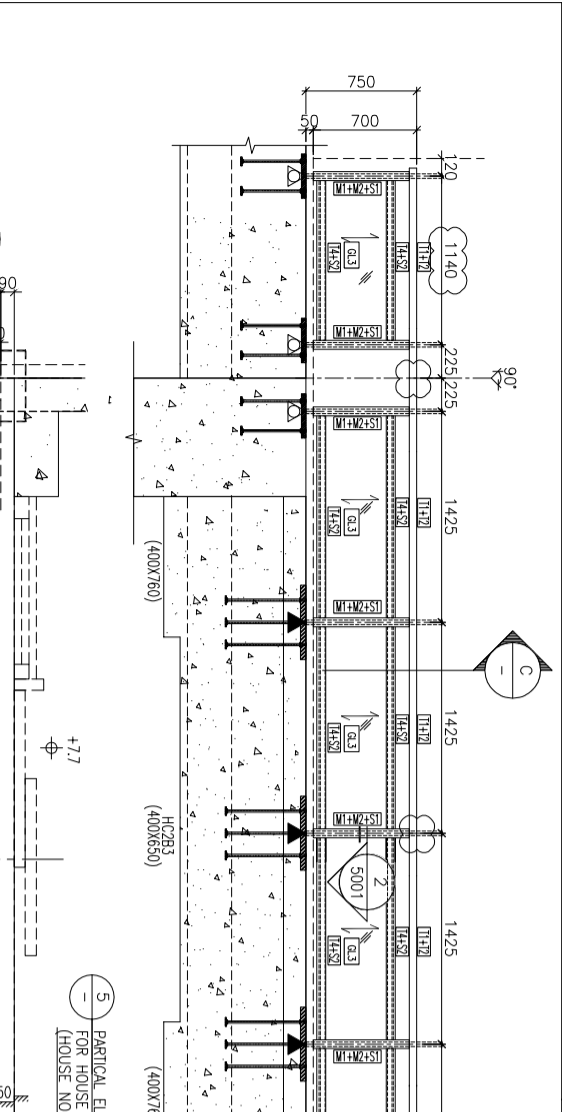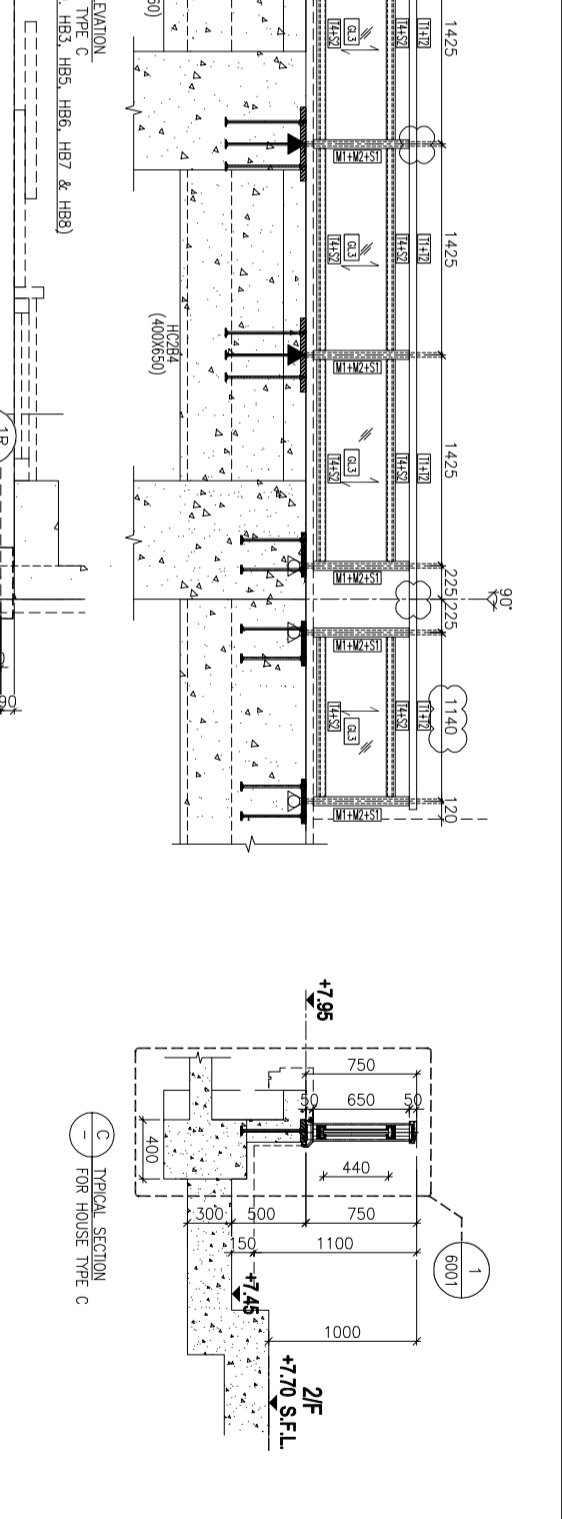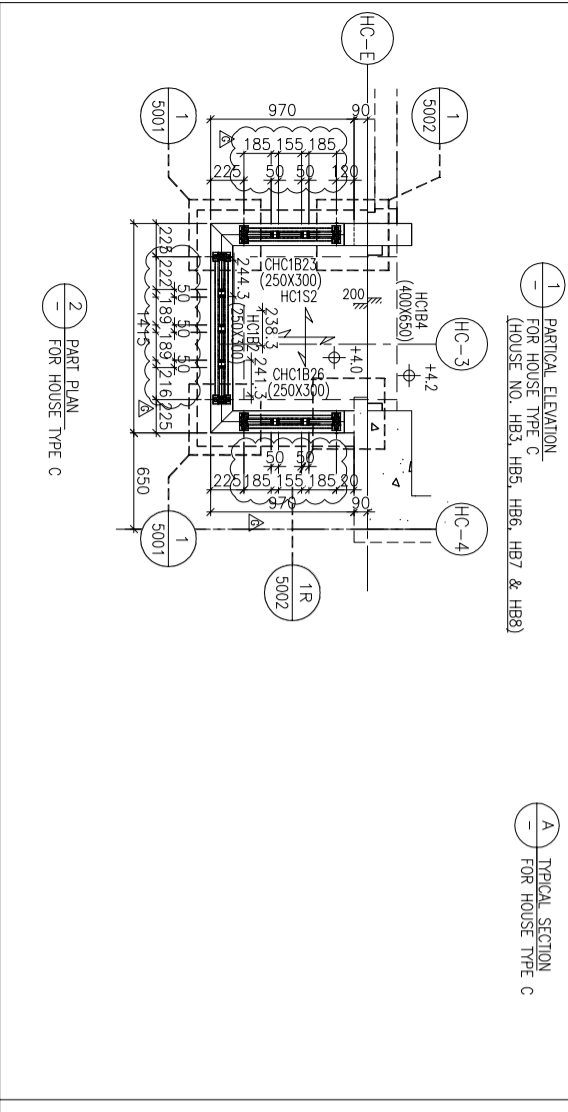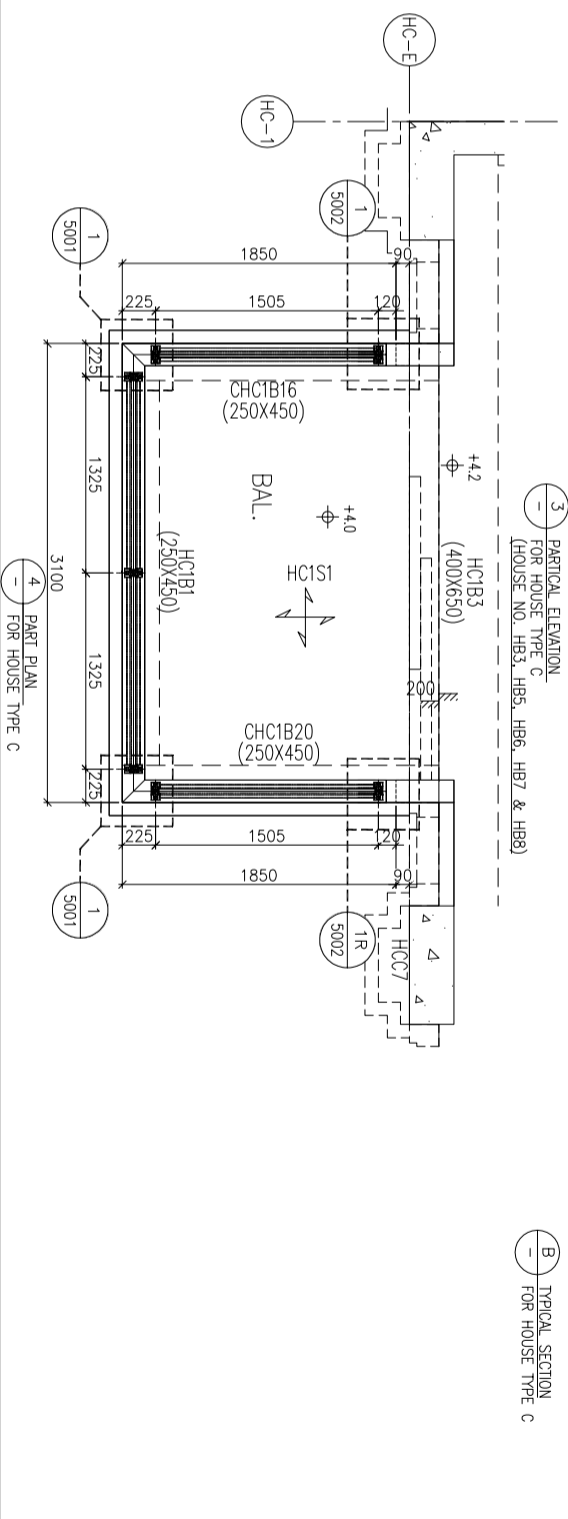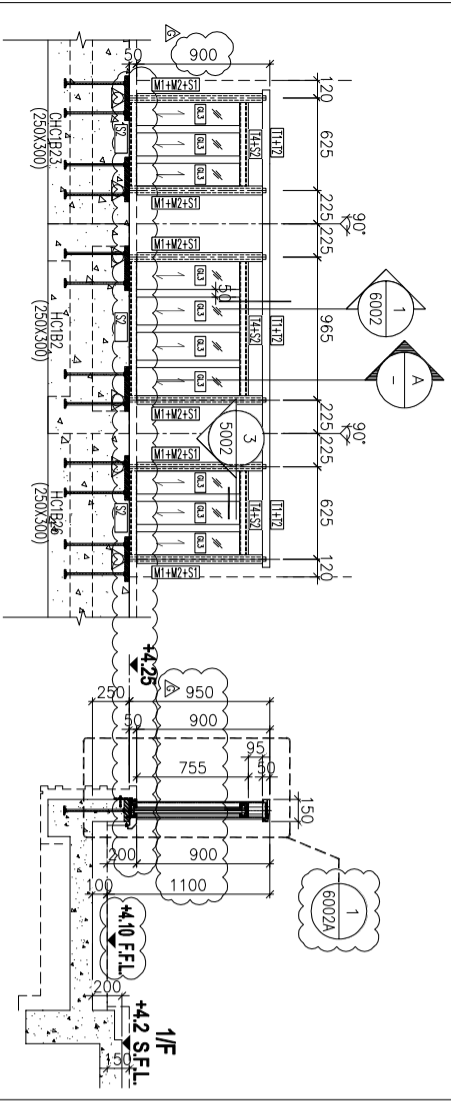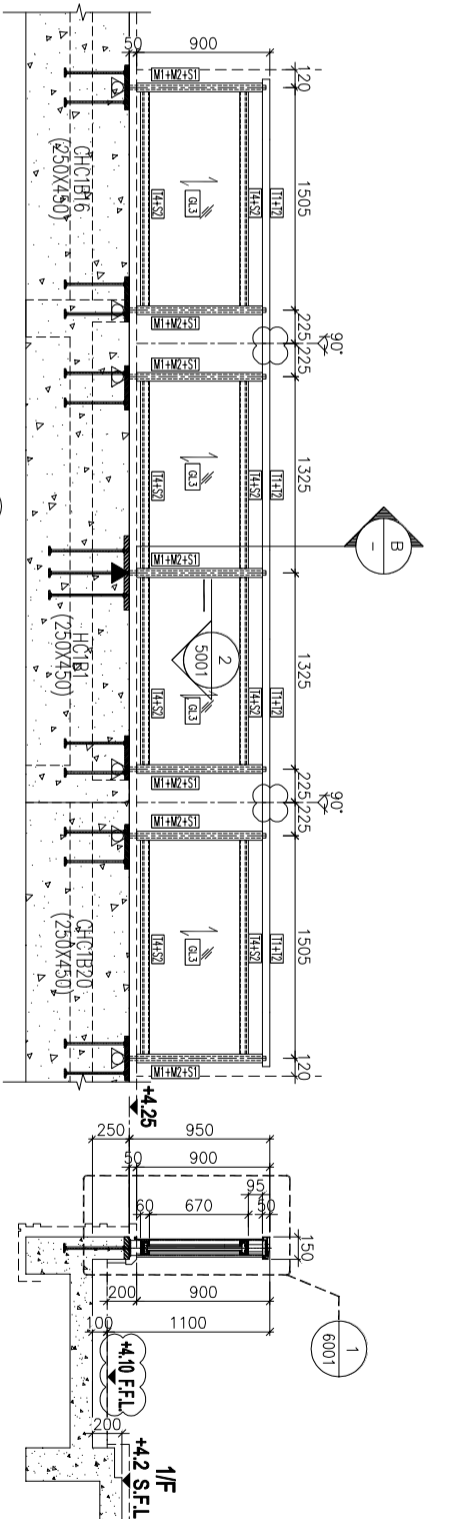


LEGEND :


GL3	15mm+1.57mm PVB+15mm THK. LAMINATED TEMPERED GLASS
▲	EMBED TYPE: EM10 (35mm THK. G.M.S. PLATE W/ Y16 G.M.S. BAR)
△	EMBED TYPE: EM11 (35mm THK. G.M.S. PLATE W/ Y16 G.M.S. BAR)
▽	EMBED TYPE: EM13 (16mm THK. G.M.S. PLATE W/ Y16 G.M.S. BAR) (max. @500c/c)

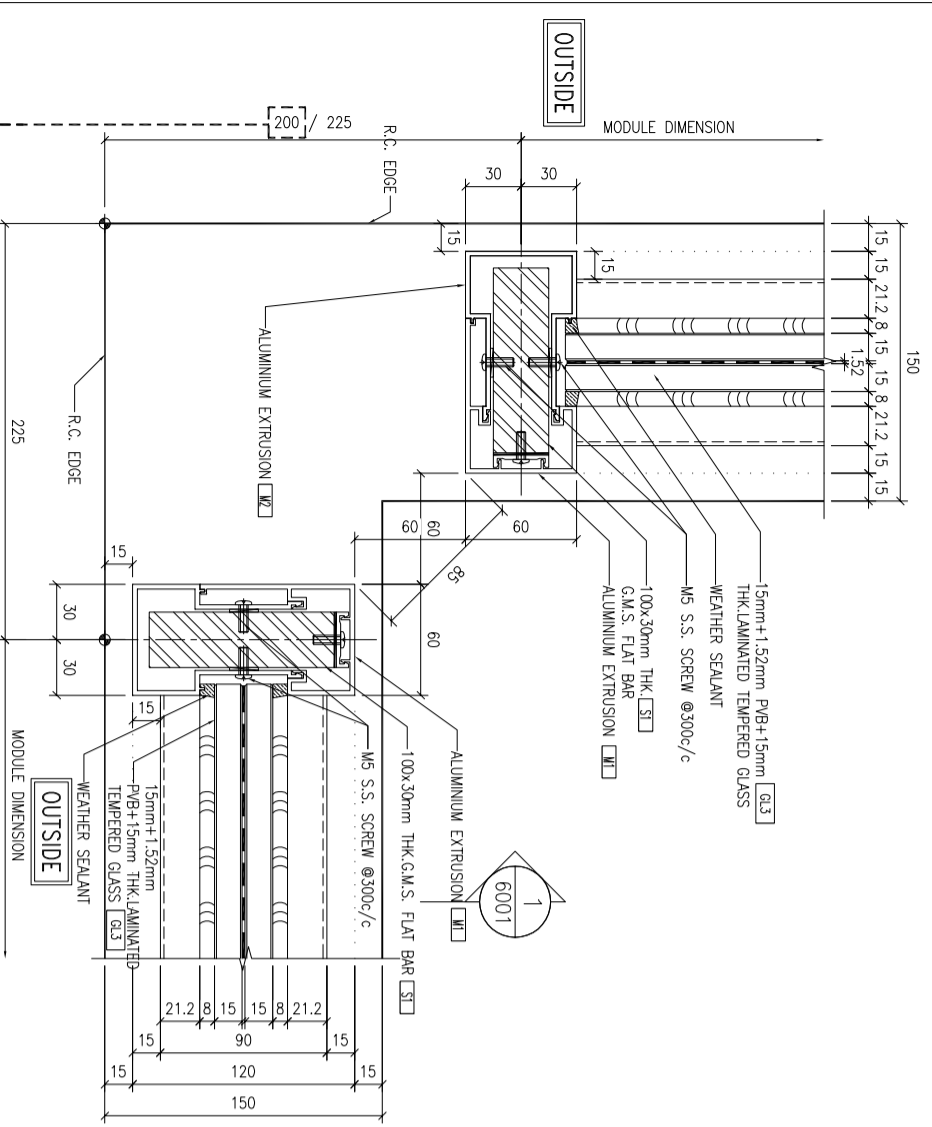


1 TYPICAL CORNER DETAIL
5001 HOUSE GLASS BALUSTRADE

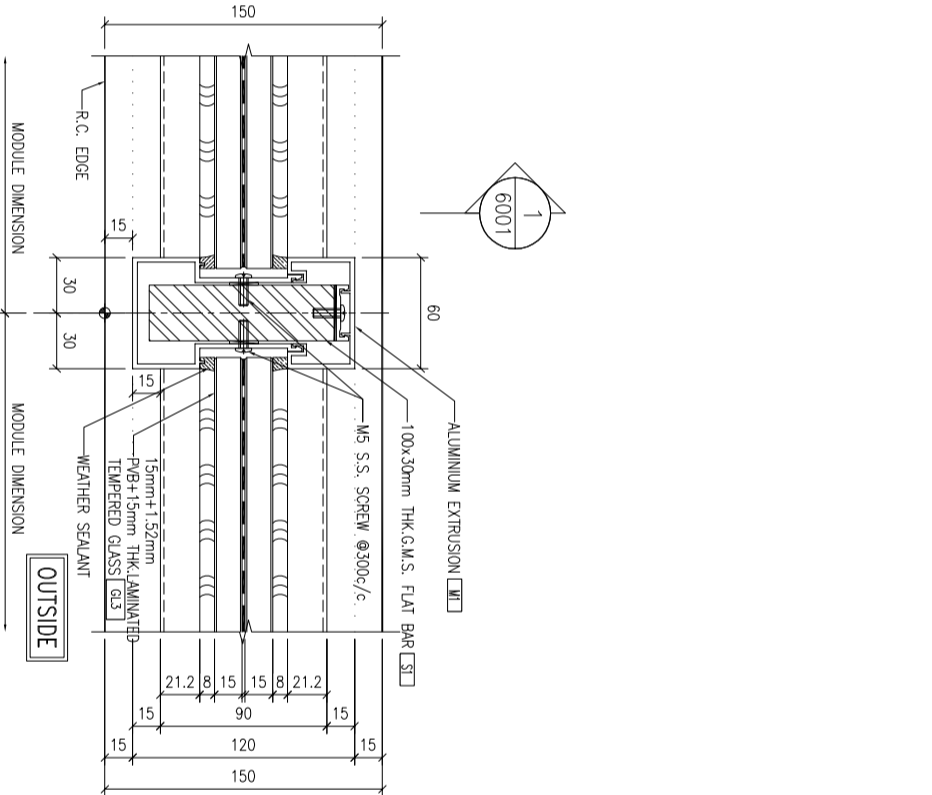


2 TYPICAL MULLION DETAIL
5001 HOUSE GLASS BALUSTRADE

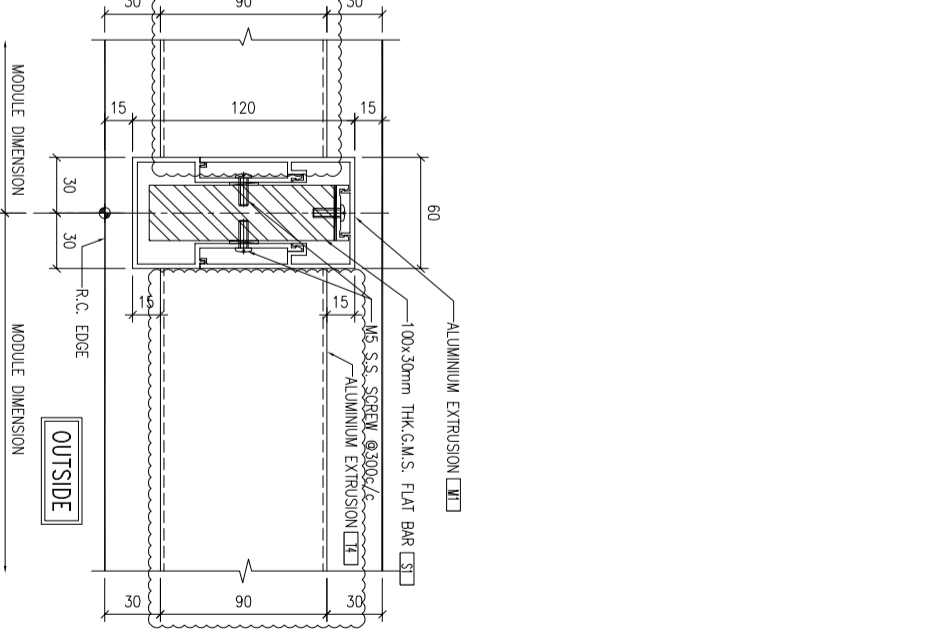

3 TYPICAL MULLION DETAIL
5001 HOUSE GLASS BALUSTRADE

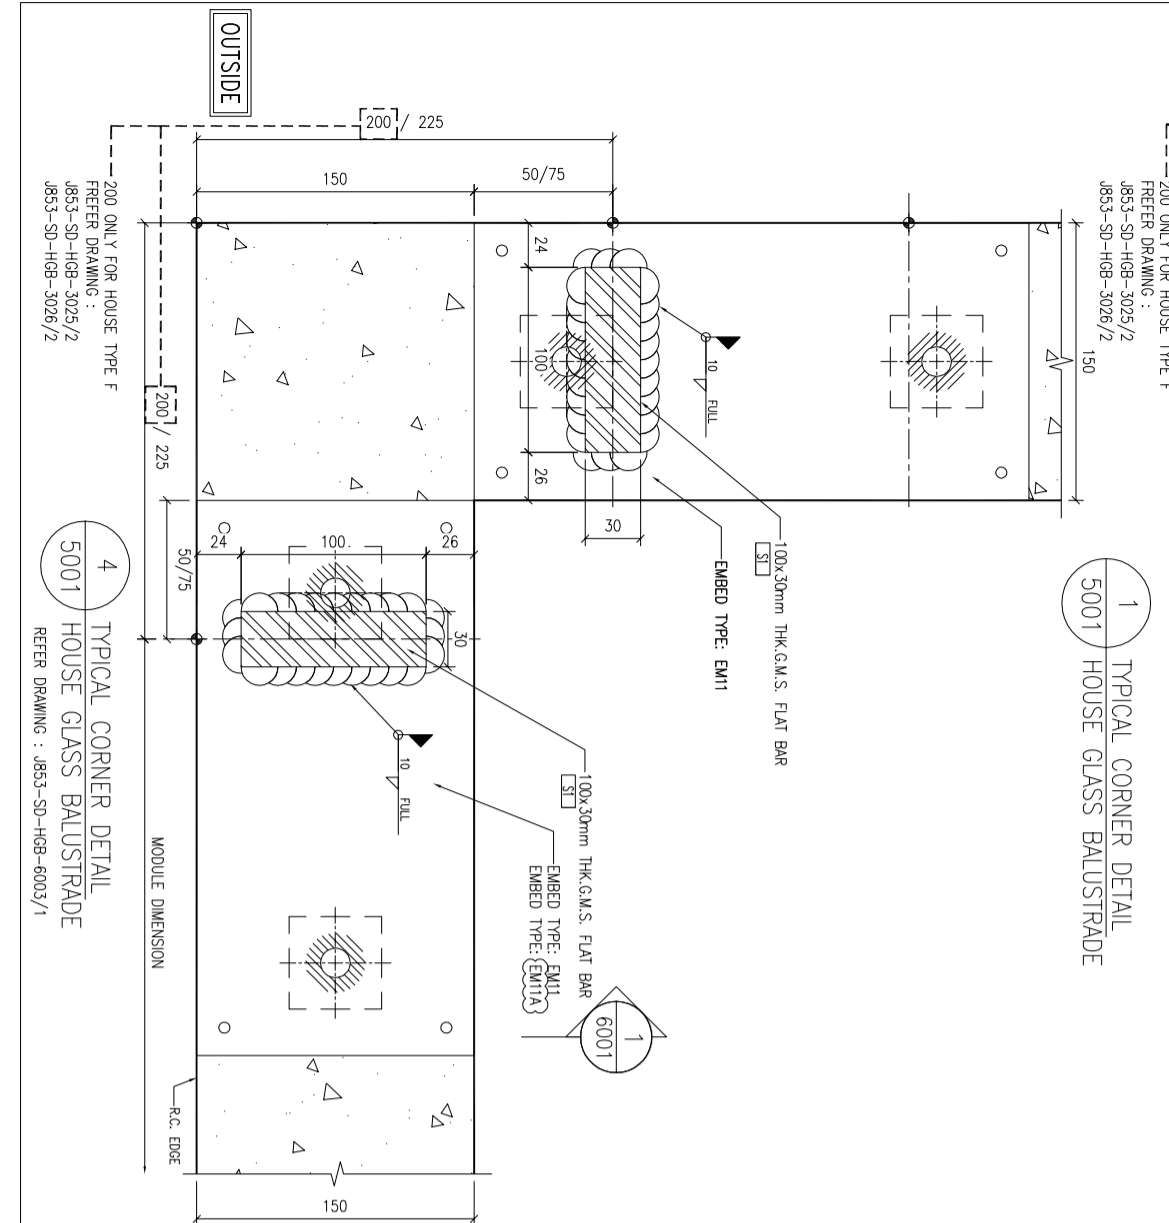

4 TYPICAL CORNER DETAIL
5001 HOUSE GLASS BALUSTRADE

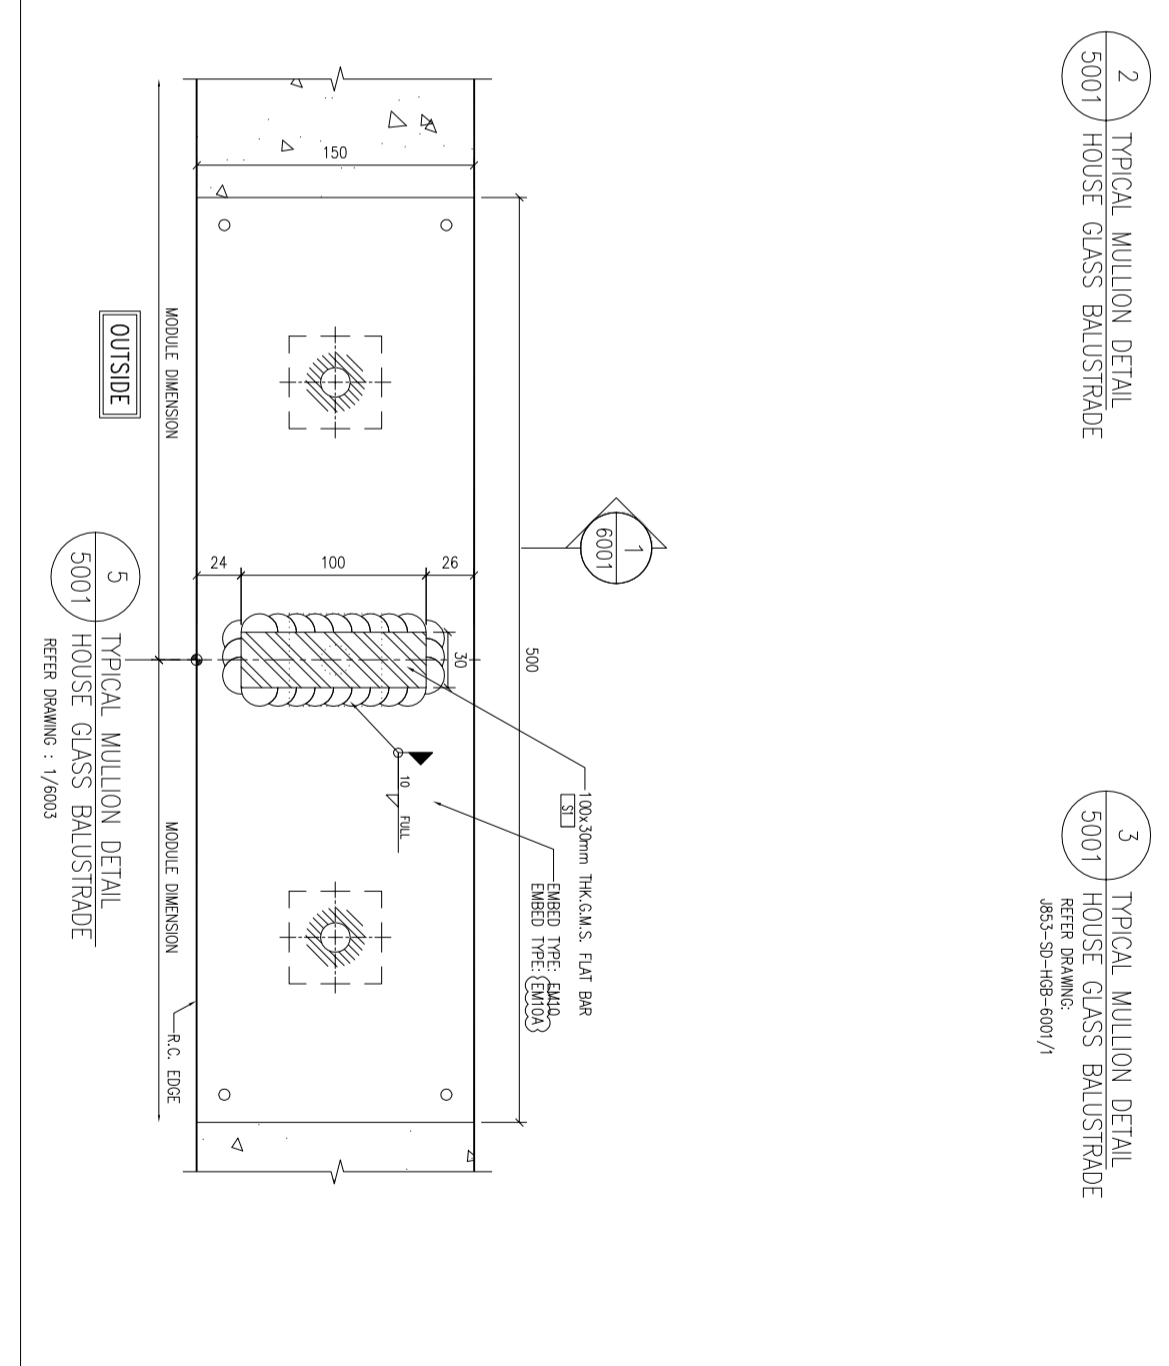

5 TYPICAL MULLION DETAIL
5001 HOUSE GLASS BALUSTRADE

B.O. REF :

CLIENT :
SHIMAO GROUP
HOLDINGS LIMITED

ARCHITECT :
WONG TUNG & PARTNERS LIMITED
ARCHITECTS & PLANNERS

MAIN CONTRACTOR :
HIP HING CONSTRUCTION CO LTD

STRUCTURAL ENGINEER :
C M WONG & ASSOCIATES LTD

FAÇADE CONSULTANT:
MENHARDT

NOTE :
1. ALL DIMENSIONS ARE IN mm.
2. ALL ELEVATIONS ARE VIEWED FROM OUTSIDE.
3. ALL DIMENSIONS TO BE VERIFIED ON SITE BEFORE FABRICATION.

LEGEND :
X1 --- DETAIL MARK NO.
X201 --- REFER SHEET NO.
1. F.F.L. --- FINISHED FLOOR LEVEL
2. S.F.L. --- STRUCTURAL FLOOR LEVEL
3. (R) --- REVERSED DETAIL

NO.	DATE	REVISION
C	21/12/2023	GENERAL REVISED
B	10/5/2023	GENERAL REVISED
A	3/1/2023	GENERAL REVISED

JOB NO. : J-853
PROJECT : PROPOSED RESIDENTIAL DEVELOPMENT AT N.K.I.L. 6542 YIN PING ROAD KOWLOON
TITLE : TYPICAL MULLION DETAIL FOR HOUSE GLASS BALUSTRADE
DATE : 10-Dec-22 SCALE : 1:2 (A1)
DRAWN BY : Asing CHECKED BY :

UNITED MIDD Aluminium Fabricator Ltd.
Units 6-8, Sunray Industrial Centre, 1/F
610 Che Kwo Ling Road, Kowloon
Tel: 23489211-4 Fax: (852) 27277866
DWG NO. : J853-SD-HGB-5001 REV. : C

REFER DRAWING : J853-SD-HGB-3025/2
J853-SD-HGB-3026/2
200 ONLY FOR HOUSE TYPE F

REFER DRAWING : J853-SD-HGB-6003/1

REFER DRAWING : 1/6003

CLIENT :
SHIMAO GROUP
HOLDINGS LIMITED

ARCHITECT :
WONG TUNG & PARTNERS LIMITED
ARCHITECTS & PLANNERS



MAIN CONTRACTOR :
HIP HING CONSTRUCTION CO LTD

STRUCTURAL ENGINEER :
CMA C M WONG & ASSOCIATES LTD

FAÇADE CONSULTANT:

MEIN-HARDT

- NOTE :
1. ALL DIMENSIONS ARE IN mm.
 2. ALL ELEVATIONS ARE VIEWED FROM OUTSIDE.
 3. ALL DIMENSIONS TO BE VERIFIED ON SITE BEFORE FABRICATION.

LEGEND :

- (X1) DETAIL MARK NO.
- (X001) REFER SHEET NO.
- 1. F.F.L.--FINISHED FLOOR LEVEL
- 2. S.F.L.--STRUCTURAL FLOOR LEVEL
- 3. (R) --REVERSED DETAIL



NO.	DATE	REVISION	BY
D	21/12/2023	GENERAL REVISED	
C	2/12/2023	GENERAL REVISED	
B	10/5/2023	GENERAL REVISED	
A	3/1/2023	GENERAL REVISED	

JOB NO. : J-853
PRODUCT : PROPOSED RESIDENTIAL DEVELOPMENT AT N.K.I.L. 6542 YIN PING ROAD KOWLOON


TITLE : TYPICAL MULLION DETAIL FOR HOUSE GLASS BALUSTRADE

DATE : 10-Dec-22 SCALE : 1:2 (A1)
DRAWN BY : Asing CHECKED BY :


美特鋁業有限公司
MIDI Aluminium Fabricator Ltd.
Units 6-8, Sunray Industrial Centre, 1/F
610 Chee Kwong Road, Kowloon
Tel:23489211-4 Fax:(852)27277866
DWG NO. : J853-SD-HGB-5002 REV. : D

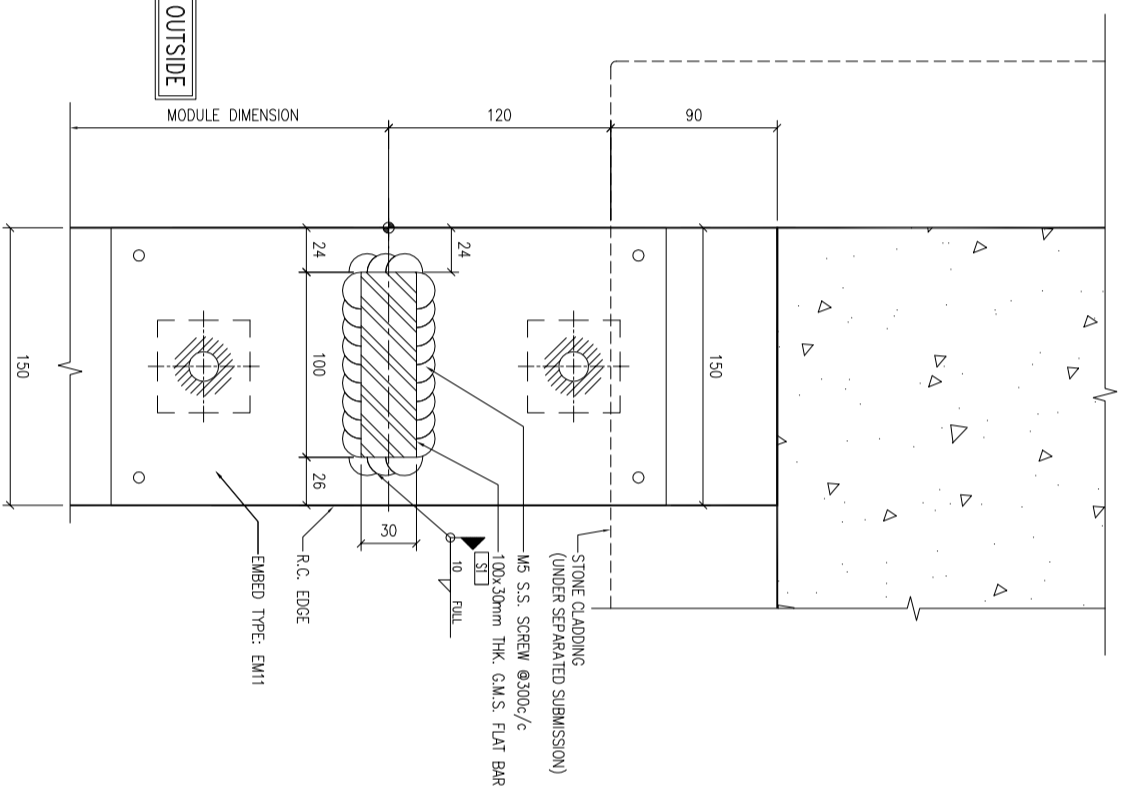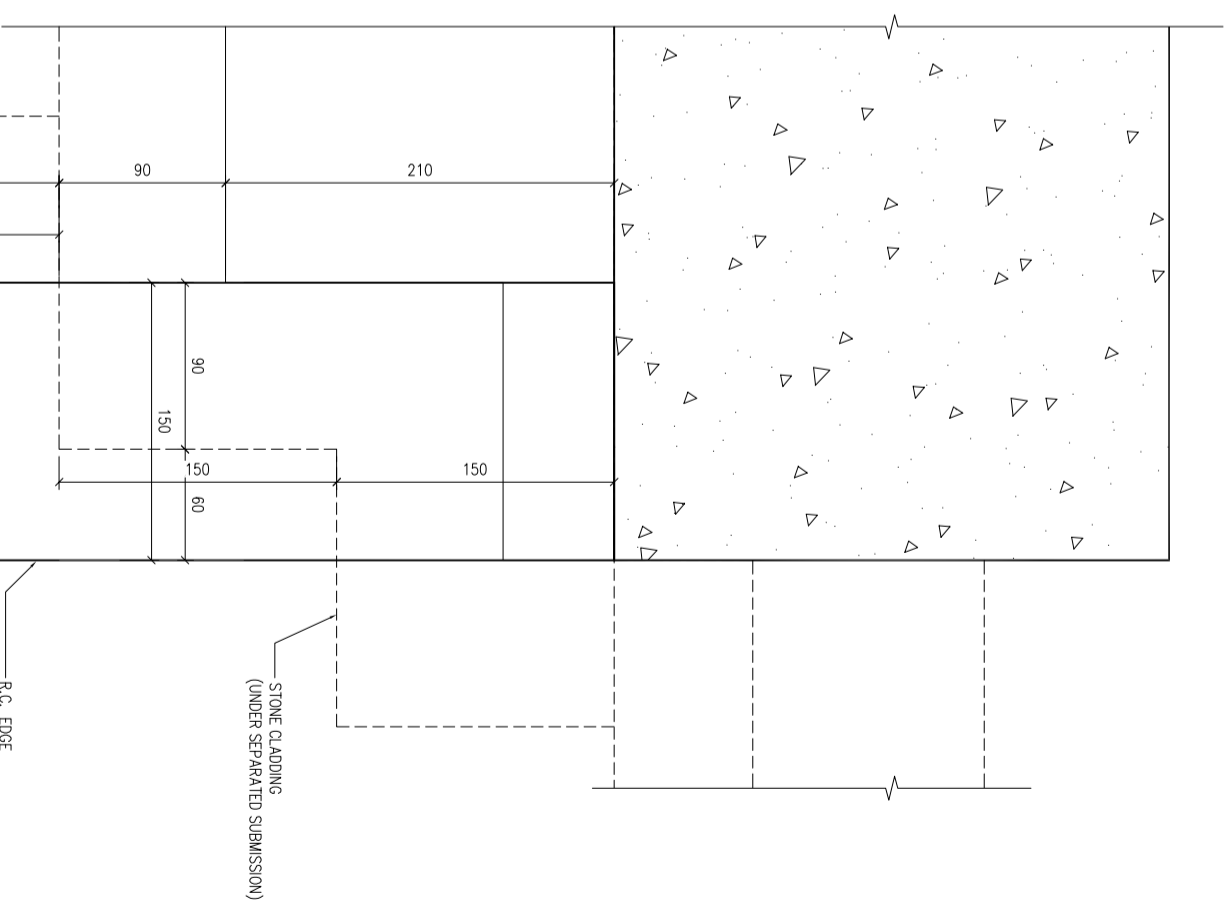


2 TYPICAL MULLION DETAIL
5002 HOUSE GLASS BALUSTRADE
REFER DRAWING : J853-SD-HGB-6002/2

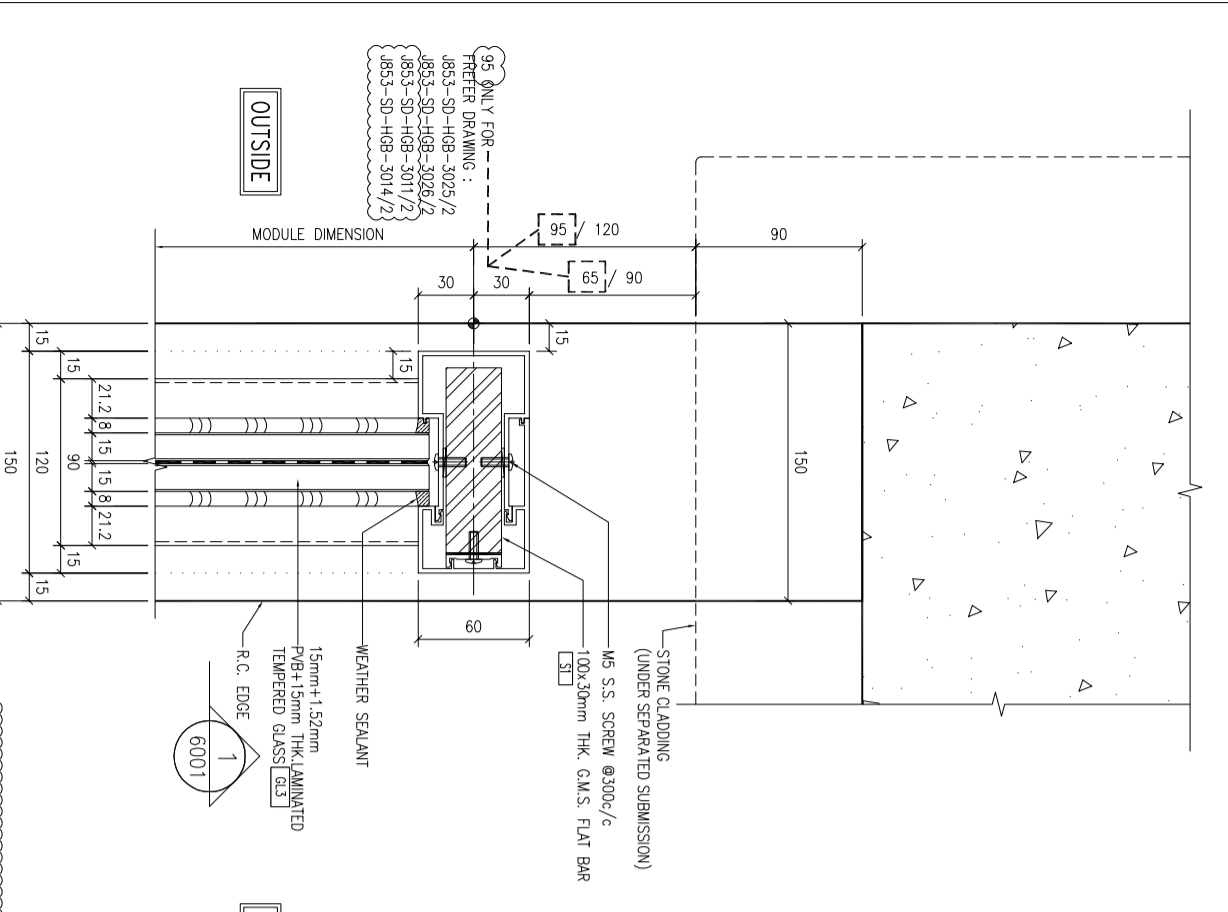

1 TYPICAL MULLION DETAIL
5002 HOUSE GLASS BALUSTRADE

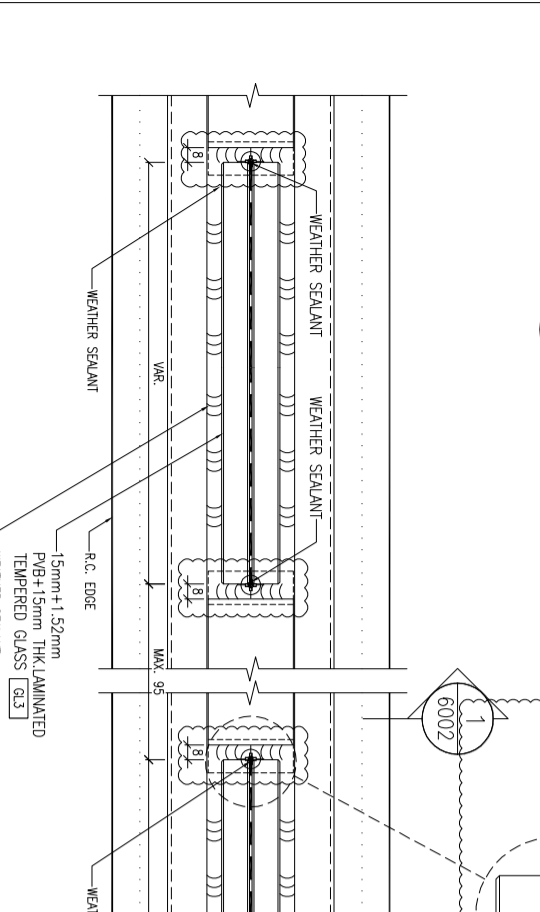

3 TYPICAL MULLION DETAIL
5002 HOUSE GLASS BALUSTRADE
REFER DRAWING : J853-SD-HGB-6003/2

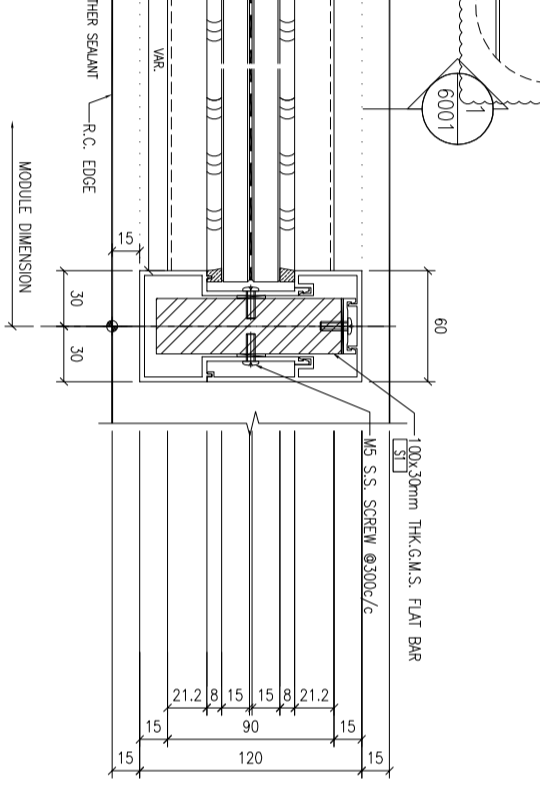

4 TYPICAL MULLION DETAIL
5002 HOUSE GLASS BALUSTRADE

