

工程指示 / 要求簡箋 ENGINEER INSTRUCTIONS(E.I.)

工程指示編號:	EI- 7141	修改版本:	-
	HK- /		
工程編號:	J 853	工程名稱:	延坪道 (第2期)
收件人:	Maggie Loh	發件人:	Joe Chan
工程項目:	欄河 Row A (HA1~HA8) 地盤用玻璃 (紅色)	日期:	13/12/2023

<input type="checkbox"/> 原合約工程包	<input type="checkbox"/> 原合約工程加 / 減脹 QT-	<input type="checkbox"/> 新工程報價 QT-
---------------------------------	--	------------------------------------

信件批核號碼/圖紙參考編號:	批核模具圖紙編號:
客戶指示附件:	管理內部批簽署:

<input type="checkbox"/> 初步鋁料 B.M.	<input type="checkbox"/> 加工拆圖, 然後生產	<input type="checkbox"/> 尺寸表
<input type="checkbox"/> 正式鋁料 B.M.	<input type="checkbox"/> 技術上資料/指示	<input type="checkbox"/> 報價
<input type="checkbox"/> 配件 B.M.	<input type="checkbox"/> 樣辦或貨品說明書	<input type="checkbox"/> 分判合約
<input type="checkbox"/> 其他:		

內容: 請依附件資料, 生產玻璃, 送地盤.
 - 按 BS EN 1479-1:2016 標準熱浸.
 - 請分層包裝出貨, 附分棟數量表資料

完成上列要求日期: 15/1/2024 (先要HA2層) (其他層預算2月底出貨)

國內

<input type="checkbox"/> 生產技術總監	<input type="checkbox"/> 連附件	<input type="checkbox"/> 技術部	<input type="checkbox"/> 連附件	<input type="checkbox"/> 生產部	<input type="checkbox"/> 連附件
<input type="checkbox"/> 採購部	<input type="checkbox"/> 連附件	<input type="checkbox"/> 生產統籌部	<input type="checkbox"/> 連附件	<input type="checkbox"/> 報關組	<input type="checkbox"/> 連附件
<input type="checkbox"/> 質檢部	<input type="checkbox"/> 連附件	<input type="checkbox"/> 會計部	<input type="checkbox"/> 連附件	<input type="checkbox"/> 機械設計部	<input type="checkbox"/> 連附件
<input type="checkbox"/> 香港辦	<input type="checkbox"/> 連附件	<input type="checkbox"/> 其他:			

香港

<input type="checkbox"/> 行政部	<input type="checkbox"/> 連附件	<input type="checkbox"/> 會計部	<input type="checkbox"/> 連附件	<input type="checkbox"/> 統籌部	<input type="checkbox"/> 連附件	<input type="checkbox"/> 工程部	<input type="checkbox"/> 連附件
<input type="checkbox"/> 採購部	<input type="checkbox"/> 連附件	<input type="checkbox"/> QS部	<input type="checkbox"/> 連附件	<input checked="" type="checkbox"/> 地盤管理	<input checked="" type="checkbox"/> 連附件	<input type="checkbox"/> 維修部	<input type="checkbox"/> 連附件

炳哥

*發件人簽署:		*組別成員批核簽署:	
傳遞編號:		項目經理簽署:	

J853-香港延坪道(第二期别墅)-Glass Balustrade-地盘玻璃分栋数量统计表

工程： J853-香港延坪道(第二期别墅)

日期： 11-Dec-23


序号	部件图编号									总数量	备注
		HA1	HA2	HA3	HA5	HA6	HA7	HA8			
1	J853-GB-GL3-001-01	2	2	2	2	2	2	2	2	14	
2	J853-GB-GL3-001-02	2	2	2	2	2	2	2	2	14	
3	J853-GB-GL3-001-03	12	12	12	12	12	12	12	12	84	
4	J853-GB-GL3-001-04	2	2	2	2	2	2	2	2	14	
5	J853-GB-GL3-001-05	1	1	1	1	1	1	1	1	7	
6	J853-GB-GL3-001-06	1	1	1	1	1	1	1	1	7	
7	J853-GB-GL3-002-01	1	1	1	1	1	1	1	1	7	
8	J853-GB-GL3-002-02	1	1	1	1	1	1	1	1	7	
9	J853-GB-GL3-002-03	2	2	2	2	2	2	2	2	14	
10	J853-GB-GL3-002-04	1	1	1	1	1	1	1	1	7	
11	J853-GB-GL3-002-05	1	1	1	1	1	1	1	1	7	
12	J853-GB-GL3-002-06	1	1	1	1	1	1	1	1	7	
13	J853-GB-GL3-002-07	1	1	1	1	1	1	1	1	7	
14	J853-GB-GL3-002-08	1	1	1	1	1	1	1	1	7	
15	J853-GB-GL3-002-09	5	5	5	5	5	5	5	5	35	
16	J853-GB-GL3-002-10	1	1	1	1	1	1	1	1	7	
17	J853-GB-GL3-002-11	1	1	1	1	1	1	1	1	7	
18	J853-GB-GL3-002-12	3	3	3	3	3	3	3	3	21	
		39	39	39	39/1	39	39	39	39	273	

工程號:	J-653	計算:	J.L.	日期:	20/11/2023	送呈:	Joe
地盘名稱:	香港延坪道(第二期別墅)	核對:		日期:		副本:	
項目類別:	Glass Balustrade-HA1~HA8	批准:		日期:		版本:	
A/C Code:		總數量:	273	總面積 (m²):	304.02		




序號	修改標示	加工圖号	玻璃编号	玻璃名稱	厚度 (mm)	玻璃尺寸		數量(塊)	面積 (m²)		備註
						寬度W (mm)	高度H (mm)		單件	總面積	
1		J853-GB-GL3-001	J853-GB-GL3-001-01	GL3:15mm THK. CLEAR TEMPERED + 1.52mm THK. (PVB) + 15mm THK. CLEAR TEMPERED LAMINATED GLASS	31.52	1921	640	14	1.23	17.21	
2		J853-GB-GL3-001	J853-GB-GL3-001-02			666	640	14	0.43	5.97	
3		J853-GB-GL3-001	J853-GB-GL3-001-03			1621	440	84	0.71	59.91	
4		J853-GB-GL3-001	J853-GB-GL3-001-04			911	440	14	0.40	5.61	
5		J853-GB-GL3-001	J853-GB-GL3-001-05			766	440	7	0.34	2.36	
6		J853-GB-GL3-001	J853-GB-GL3-001-06			811	440	7	0.36	2.50	
7		J853-GB-GL3-002	J853-GB-GL3-002-01			1736	1094	7	1.90	13.29	
8		J853-GB-GL3-002	J853-GB-GL3-002-02			1323	1094	7	1.45	10.13	
9		J853-GB-GL3-002	J853-GB-GL3-002-03			1343	1094	14	1.47	20.57	
10		J853-GB-GL3-002	J853-GB-GL3-002-04			1271	1094	7	1.39	9.73	
11		J853-GB-GL3-002	J853-GB-GL3-002-05			898	1094	7	0.98	6.88	
12		J853-GB-GL3-002	J853-GB-GL3-002-06			1661	1094	7	1.82	12.72	
13		J853-GB-GL3-002	J853-GB-GL3-002-07			1619	1094	7	1.77	12.40	
14		J853-GB-GL3-002	J853-GB-GL3-002-08			1396	1094	7	1.53	10.69	
15		J853-GB-GL3-002	J853-GB-GL3-002-09			1376	1094	35	1.51	52.69	
16		J853-GB-GL3-002	J853-GB-GL3-002-10			1355	1094	7	1.48	10.38	
17		J853-GB-GL3-002	J853-GB-GL3-002-11			1680	1094	7	1.84	12.87	
18		J853-GB-GL3-002	J853-GB-GL3-002-12			1659	1094	21	1.81	38.11	
總合計:						273				304.02	

加工注意事項:

- 1). 本表中所有玻璃對角線尺寸偏差要求不超過正負2mm.
- 2). 本表中所有玻璃要求粗磨邊處理並倒棱角.
- 3). 本表中玻璃要求粗磨邊處理並倒棱角, 攔河玻璃頂底要精磨邊, 而所有玻璃之入爐方向需保持一致.
- 4). 本表中不同種類玻璃參照玻璃加工圖加工.
- 5). 本表中所有強化玻璃均需HEAT SOAK TEST.
- 6). 本表中所有玻璃均需注明室內外面及其玻璃編號, 以便識別.

 美特铝质 有限公司 MIDI Aluminium Fabricator Ltd.				工程号	J853	制图	J.L.	20/11/23	物料号	详见玻璃BM表			
				地盘	香港延坪路	复核	-	-	图号	J853-GB-GL3-001			
版本		采用	工厂	地盘	√	名称	玻璃加工图	批准	-	-	数量	-	
日期		颜色	-			材料	GL3:15 T+1.52PBV+15 T	单件面积(㎡)	-	长度	-	宽度	-

頂

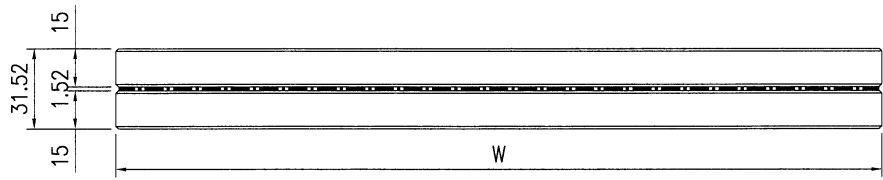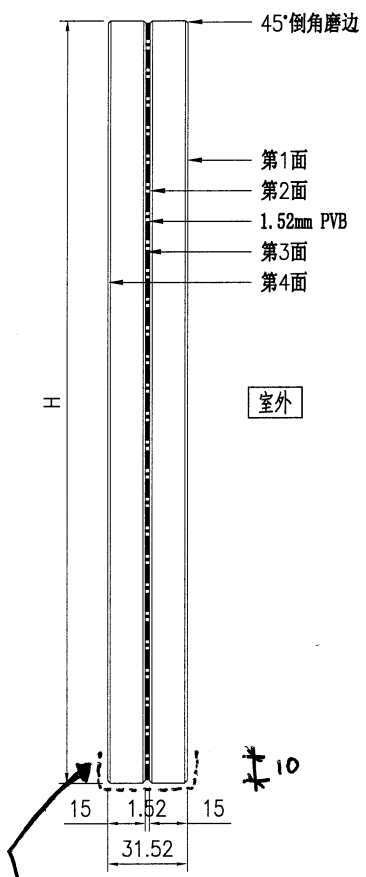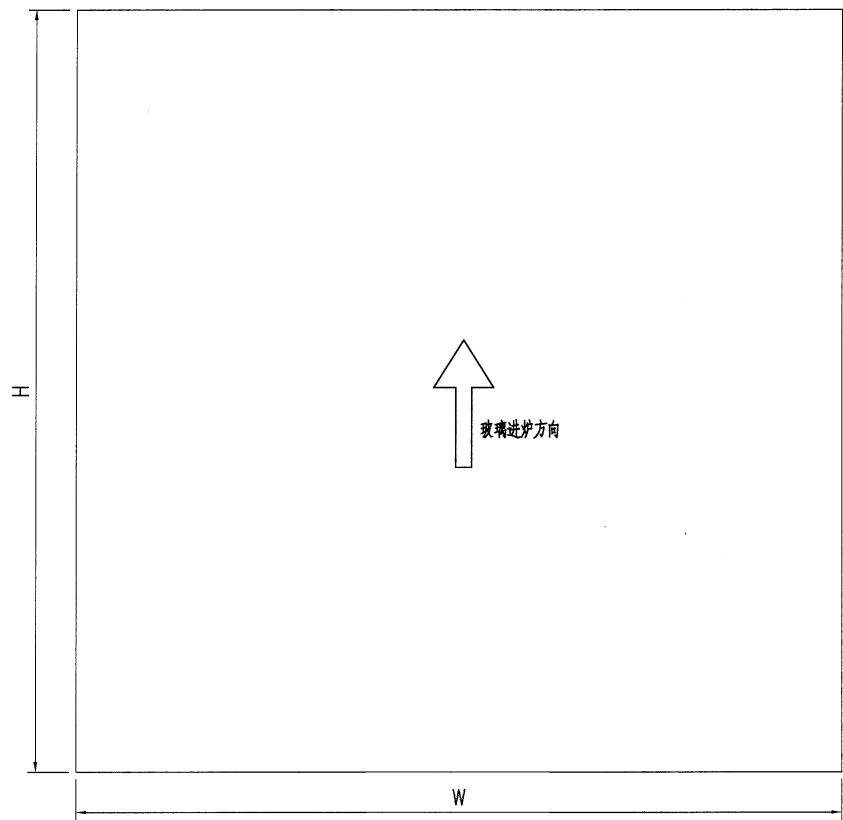

室外




技术说明:

- 1.玻璃为: GL3:15mm THK. CLEAR TEMPERED + 1.52mm THK. (PVB) + 15mm THK. CLEAR TEMPERED LAMINATED GLASS
- 2.色号为: - , Low-e膜在第 面;
- 3.中空铝隔条, 两面涂丁基胶涂抹均匀, 内层为铝框本色, 玻璃四周1x45°机磨边;
- 4.玻璃密封胶采用: , 胶深符合相应规范要求;
- 5.中空玻璃应符合《中空玻璃》GB1194-2002国家标准, 并按《玻璃幕墙工程质量检验标准》JGJ/T139-2001进行质量检验;
- 6.玻璃出厂前必须粘好相应编号及内外标签, 玻璃单边长度超过2m, 所有全钢化玻璃需要热浸处理;
- 7.玻璃钢化波纹方向平行分布; 图中标注尺寸单位为mm, 进炉方向与滚轮垂直。



美特铝质有限公司
MIDI Aluminium Fabricator Ltd.

工程号	J853	制图	J.L.	20/11/23	物料号	详见玻璃BM表	
地盘	香港延坪路	复核	-	-	图号	J853-GB-GL3-002	
版本		名称	玻璃加工图	批准	-	数量	-
日期		材料	GL3:15 T+1.52PVB+15 T	单件面积(m ²)	-	长度	-

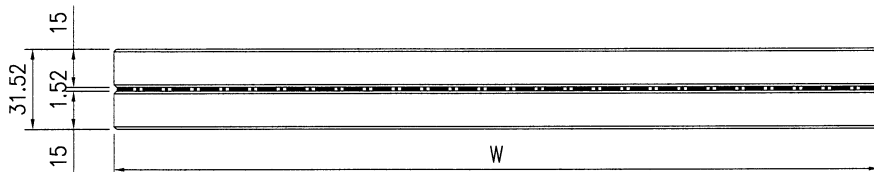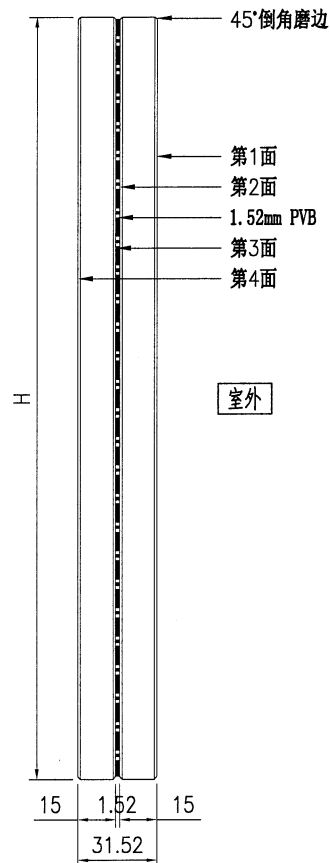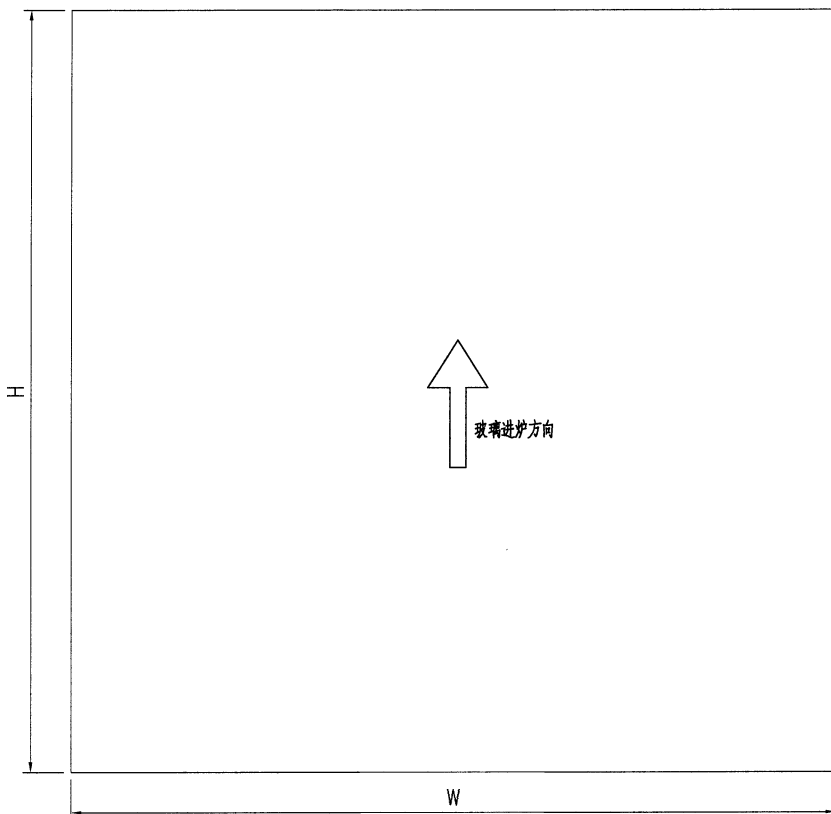

室外

技术说明:

- 1.玻璃为: GL3:15mm THK. CLEAR TEMPERED + 1.52mm THK. (PVB) + 15mm THK. CLEAR TEMPERED LAMINATED GLASS
- 2.色号为: - , Low-e膜在第 面;
- 3.中空铝隔条, 两面涂丁基胶涂抹均匀, 内层为铝框本色, 玻璃四周1x45°机磨边;
- 4.玻璃密封胶采用: , 胶深符合相应规范要求;
- 5.中空玻璃应符合《中空玻璃》GB1194-2002国家标准, 并按《玻璃幕墙工程质量检验标准》JGJ/T139-2001进行质量检验;
- 6.玻璃出厂前必须粘好相应编号及内外标签, 玻璃单边长度超过2m, 所有全钢化玻璃需要热浸处理;
- 7.玻璃钢化波纹方向平行分布; 图中标注尺寸单位为mm, 进炉方向与滚轮垂直。

B.D. REF :
 CLIENT : SHIMAO GROUP HOLDINGS LIMITED
 ARCHITECT : WONG TUNG & PARTNERS LIMITED
 MAIN CONTRACTOR : 裕興建築有限公司
 STRUCTURAL ENGINEER : C M WONG & ASSOCIATES LTD
 FACADE CONSULTANT : MENHARDT



NOTE:
 1. ALL DIMENSIONS ARE IN MM.
 2. ALL ELEVATIONS ARE VIEWED FROM OUTSIDE.
 3. ALL DIMENSIONS TO BE VERIFIED ON SITE BEFORE FABRICATION.

LEGEND:
 1. F.F.L. --- FINISHED FLOOR LEVEL
 2. S.F.L. --- STRUCTURAL FLOOR LEVEL
 3. (R) --- REVERSED DETAIL
 R.C. STRUCTURAL ELEMENT COL. / BEAM / SLAB IS (UNDER SEPARATED SUBMISSION)

C	8/8/2023	GENERAL REVISED
B	10/5/2023	GENERAL REVISED
A	3/1/2023	GENERAL REVISED
REV	DATE	REASON

J-853
 PROJECT : PROPOSED RESIDENTIAL DEVELOPMENT AT N.K.I.L. 6542 TIN PING ROAD KOWLOON

TITLE : PART ELEVATION PART PLAN & PART SECTION FOR HOUSE GLASS BALUSTRADE FOR HOUSE TYPE A1
 GLASS MARKING DWG
 SCALE : 1:25 (A1)
 DATE : 08-Dec-22
 DRAWN BY : Aching
 CHECKED BY :
 UNIT : 6-8, Sunny Industrial Centre, 1/F
 610 Che Kwo Ling Road, Kowloon
 TEL: 2368211-4 Fax: (852) 2727666
 DING NO. : 853-08-GL-3002 REV. : -

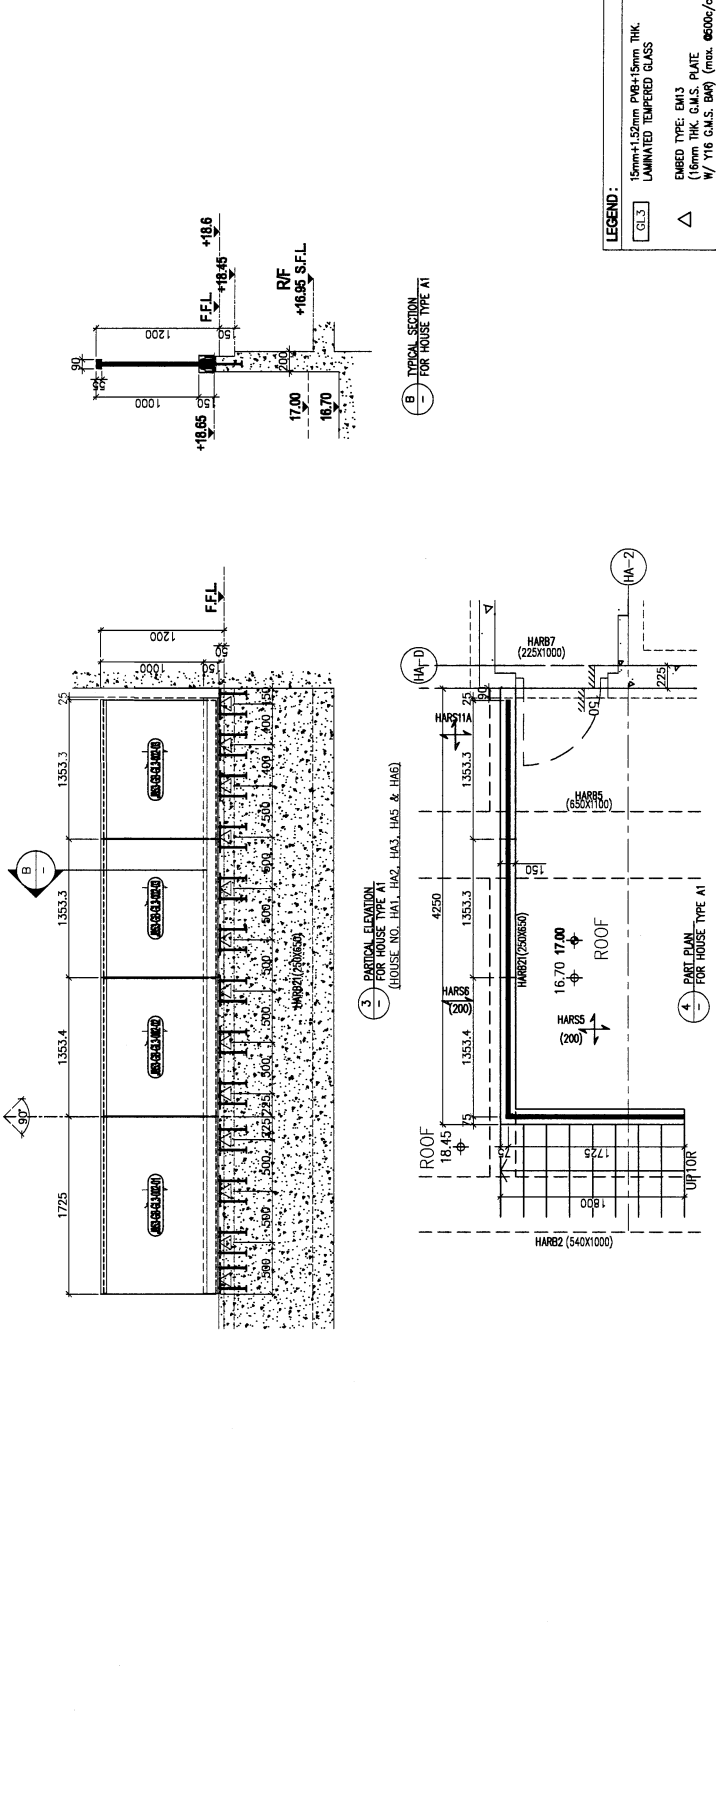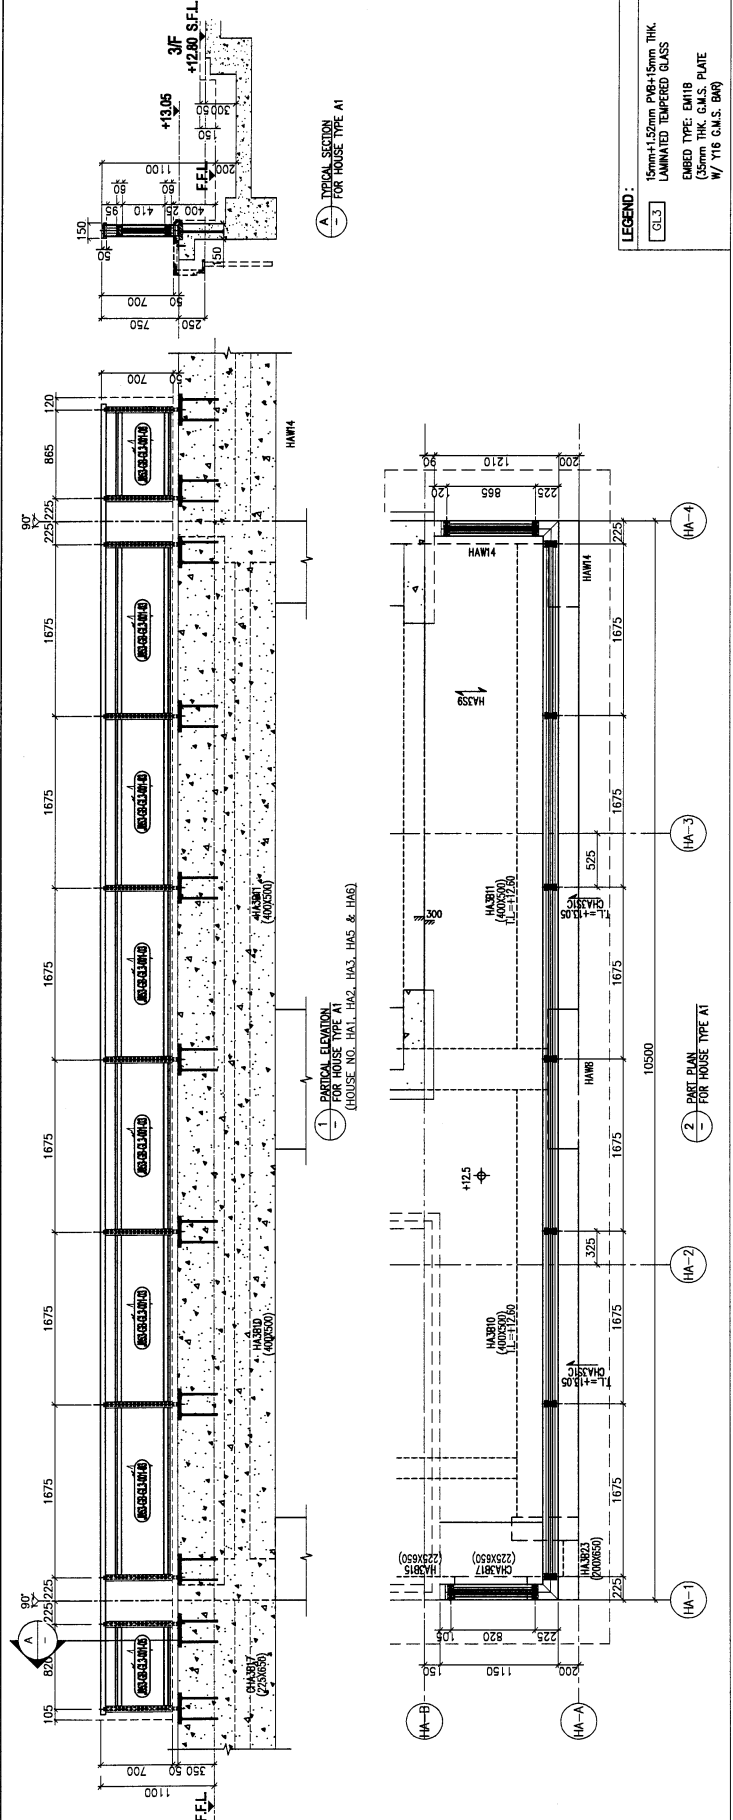

B.O. REF :

CLIENT : SHIMAO GROUP HOLDINGS LIMITED

ARCHITECT : YONG TUNG & PARTNERS LIMITED



MAIN CONTRACTOR : 協興建築有限公司 HOP HING CONSTRUCTION CO. LTD

STRUCTURAL ENGINEER :

ICMA C M WONG & ASSOCIATES LTD 黃志明建築工程師有限公司

PACKAGE CONSULTANT :



NOTE: 1. ALL DIMENSIONS ARE IN MM. 2. ALL ELEVATIONS ARE VIEWED FROM OUTSIDE. 3. ALL DIMENSIONS TO BE VERIFIED ON SITE BEFORE FABRICATION.

LEGEND:

DETAIL MARK NO. REFER SHEET NO.

FFL --- FINISHED FLOOR LEVEL

S.F.L --- STRUCTURAL FLOOR LEVEL

--- REVERSED DETAIL

R.C. STRUCTURAL ELEMENT

COL / BEAM / SLAB

IS (UNDER SEPARATED SUBMISSION)

C	9/6/2023	GENERAL REVISION
B	10/5/2023	GENERAL REVISION
A	3/7/2023	GENERAL REVISION
M	DATE	REVISION
BY		

JOB NO. : J-853



PROJECT : PROPOSED RESIDENTIAL DEVELOPMENT AT 'NKILL' 6542 TIN PING ROAD KOWLOON

TITLE : PART ELEVATION PART PLAN & PART SECTION FOR HOUSE CLASS BALUSTRADE FOR HOUSE TYPE A1 GLASS MARKING DWG

DATE : 08-Dec-22 SCALE : 1:25 (A1)

DRAWN BY : Aching CHECKED BY :

MTDI 美特銘有限公司 Units 6-8, Sunray Industrial Centre, 1/F 610 Che Koo Ling Road, Kowloon Tel: (852) 27272686 Fax: (852) 27272686 DWG NO. : J853-08-GL-3003 REV. : -

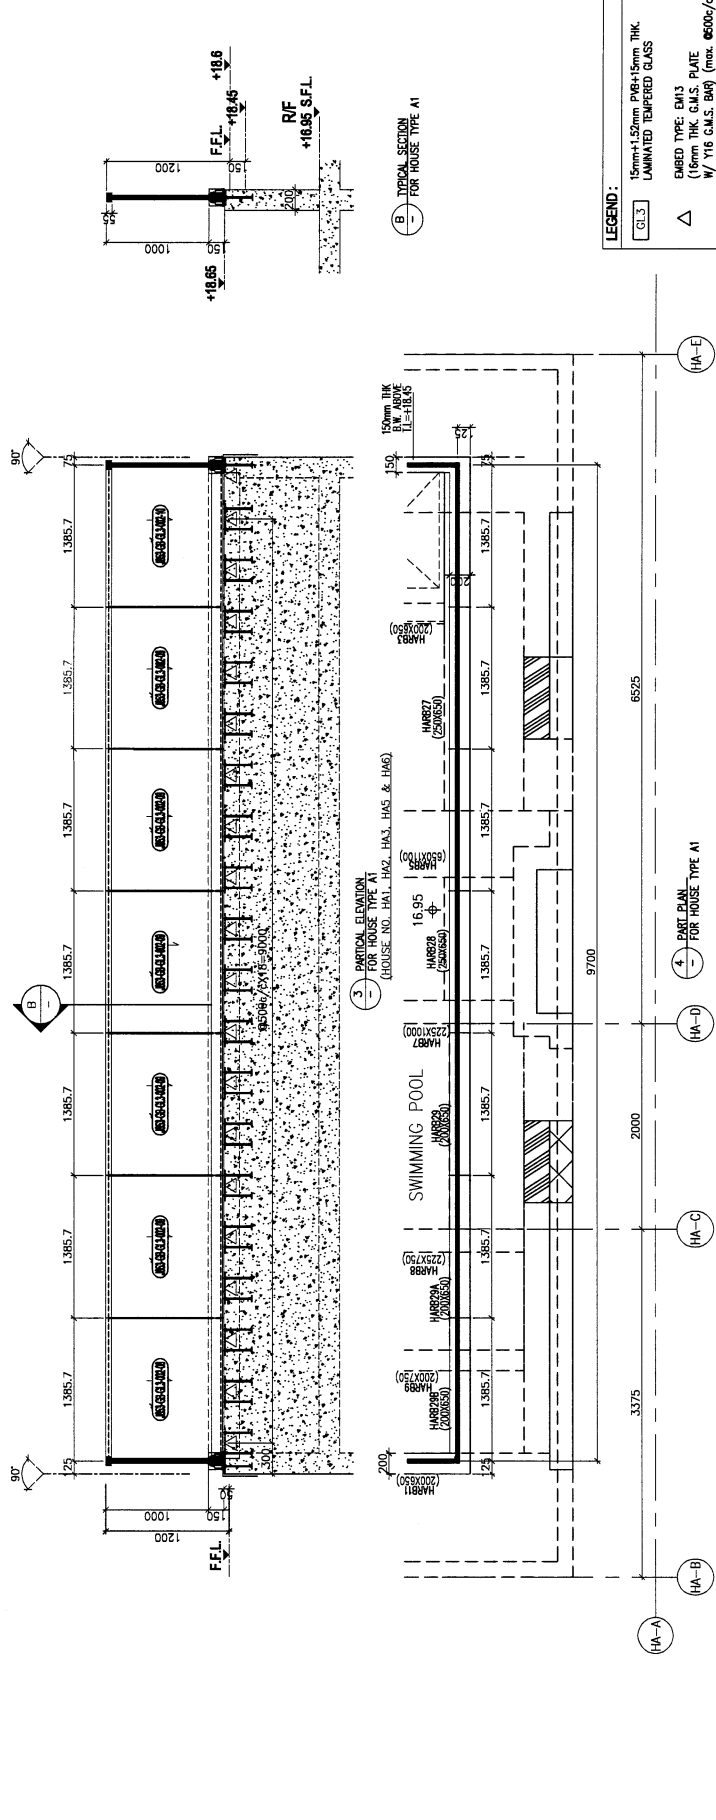
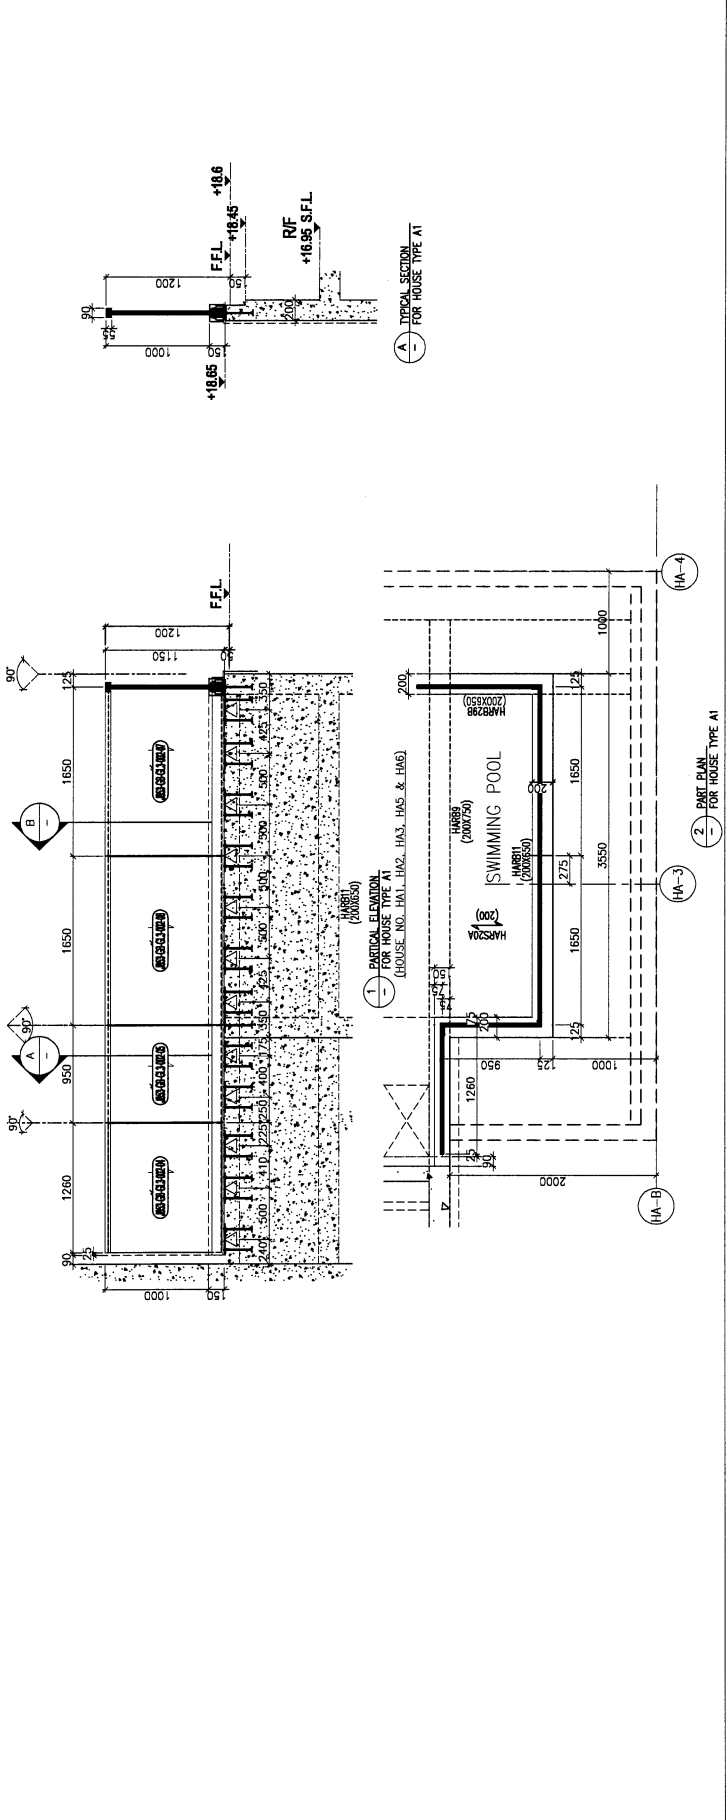


LEGEND:

GL3 15mm+15mm PWB+15mm THK LAMINATED TEMPERED GLASS

△ EMBED TYPE: B.M3 (16mm THK, G.M.S. PLATE W/ Y16 G.M.S. BAR) (max. 6500c/c)

B.D. REF. :										
CLIENT :	SHIMAO GROUP HOLDINGS LIMITED									
ARCHITECT :	WONG TUNG & PARTNERS LIMITED WONG TUNG & PARTNERS									
MAIN CONTRACTOR :	裕興建築有限公司 YU HING CONSTRUCTION CO. LTD									
STRUCTURAL ENGINEER :	C M WONG & ASSOCIATES LTD 黃志明建築工程師有限公司									
FAÇADE CONSULTANT :	MENHARD									
NOTE :	1. ALL DIMENSIONS ARE IN "MM". 2. ALL ELEVATIONS ARE VIEWED FROM OUTSIDE. 3. ALL DIMENSIONS TO BE VERIFIED ON SITE BEFORE FABRICATION.									
LEGEND :	(A) DETAIL MARK NO. REFER SHEET NO. 1. F.F.L. -- FINISHED FLOOR LEVEL 2. S.F.L. -- STRUCTURAL FLOOR LEVEL 3. (R) -- REVERSED DETAIL R.C. STRUCTURAL ELEMENT COL. / BEAM / SLAB IS (UNDER SEPARATED SUBMISSION)									
C	9/9/2023	GENERAL REVISED							BY	
B	10/5/2023	GENERAL REVISED							DATE	
A	3/1/2023	GENERAL REVISED							DATE	
NO.		REVISION							BY	
JOB NO. :	J-853									
PROJECT :	PROPOSED RESIDENTIAL DEVELOPMENT AT N.K.I.L. 6542 TIN PING ROAD KOWLOON									
TITLE :	PART ELEVATION PART PLAN & PART SECTION FOR HOUSE CLASS BALUSTRADE									
DATE :	08-Dec-22									
SCALE :	1:25 (A1)									
CLASS MARKING DWG										
DRAWN BY :	Asing									
CHECKED BY :										
Units 6-8, Sunny Industrial Centre, 1/F	美特銘有限公司 MTDI ARCHITECTURE ASSOCIATES LTD. 610 Chee Koo Ling Road, Kowloon Tel: 2488211-4 Fax: (852) 2727866									
DWG NO. :	J853-08-GL-3004									
REV. :	-									

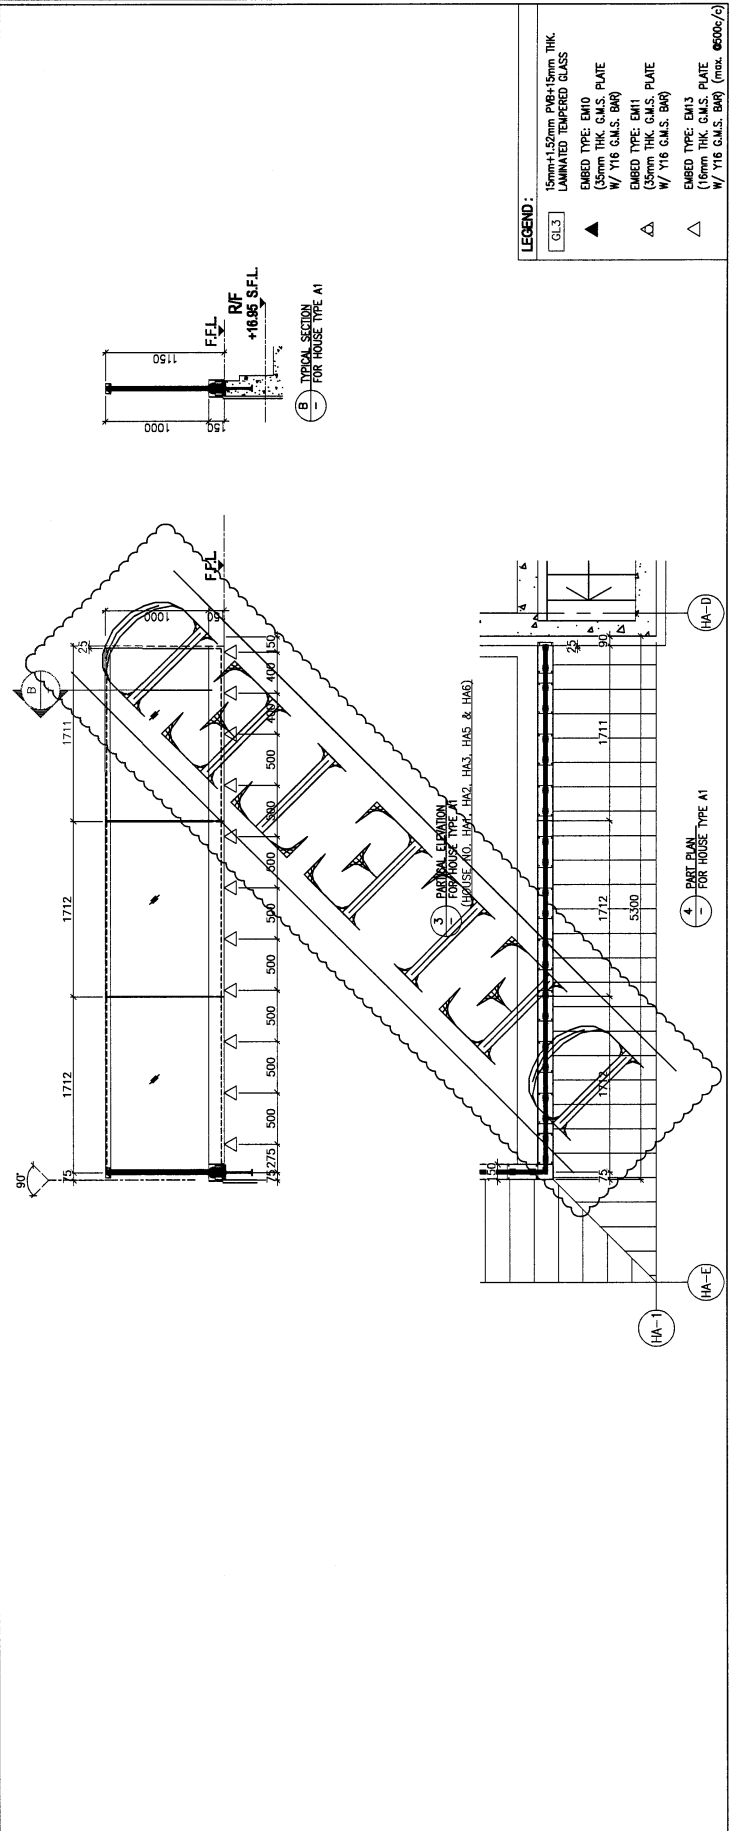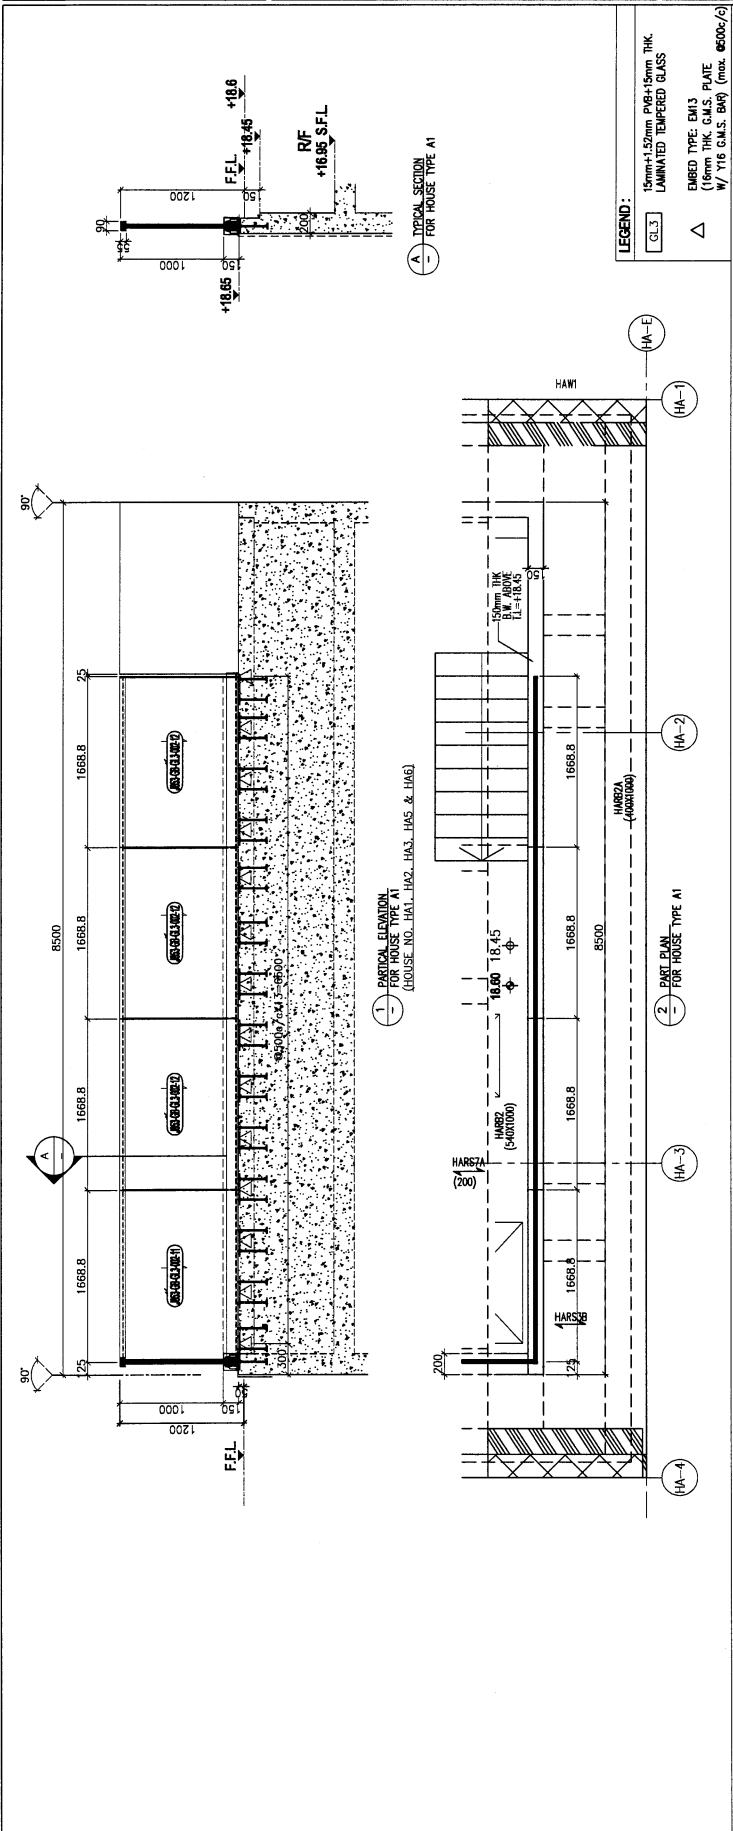

B.O. REF :
 CLIENT : SHIMAO GROUP HOLDINGS LIMITED
 ARCHITECT : WONG TUNG & PARTNERS LIMITED
 MAIN CONTRACTOR : 綠興建築有限公司
 HIP HING CONSTRUCTION CO. LTD
 STRUCTURAL ENGINEER : CMA C M WONG & ASSOCIATES LTD
 黃志明建築工程師有限公司
 FACADE CONSULTANT : MEINHARDT

NOTE :
 1. ALL DIMENSIONS ARE IN MM.
 2. ALL ELEVATIONS ARE VIEWED FROM OUTSIDE.
 3. ALL DIMENSIONS TO BE VERIFIED ON SITE BEFORE FABRICATION.

LEGEND :
 (A) DETAIL MARK NO.
 (B) REFER SHEET NO.
 1. F.F.L. -- FINISHED FLOOR LEVEL.
 2. S.F.L. -- STRUCTURAL FLOOR LEVEL.
 3. (R) -- REVERSED DETAIL.
 R.C. STRUCTURAL ELEMENT
 COL. / BEAM / SLAB
 IS (UNDER SEPARATED SUBMISSION)

C	8/8/2023	GENERAL REMISED
B	10/5/2023	GENERAL REMISED
A	3/1/2023	GENERAL REMISED
NO.	DATE	REVISION

JOB NO. : J-853
 PROJECT : PROPOSED RESIDENTIAL DEVELOPMENT AT N.K.I.L. 6542
 TIN PING ROAD KOWLOON
 TITLE : PART ELEVATION/PART PLAN & PART SECTION FOR HOUSE TYPE A
 GLASS MARKING DWG
 DATE : 08-Dec-22
 SCALE : 1:25 (A1)
 DRAWN BY : Aching
 CHECKED BY :
 UNIT 6-8, Sunny Industrial Centre, 1/F
 610 Chee Kwo Ling Road, Kowloon
 Tel: 2469211-4 Fax: (852) 7727866
 DWG NO. : J853-08-GL-3008
 REV. : -

