

工程指示 / 要求簡箋 ENGINEER INSTRUCTIONS(E.I.)

工程指示編號:	EI- 7354	修改版本:	-
	HK- /		
工程編號:	J 853	工程名稱:	延坪道 (第2期)
收件人:	林哥	發件人:	Joe Chan
工程項目:	Row B (HBS~HB8) 幕牆 修補方案用拉爆	日期:	26/02/2024

<input type="checkbox"/> 原合約工程包	<input type="checkbox"/> 原合約工程加 / 減賬 QT-	<input type="checkbox"/> 新工程報價 QT-
---------------------------------	--	------------------------------------

信件批核號碼/圖紙參考編號:	批核模具圖紙編號:
客戶指示附件:	管理內部批簽署:

<input type="checkbox"/> 初步鋁料 B.M.	<input type="checkbox"/> 加工拆圖, 然後生產	<input type="checkbox"/> 尺寸表
<input type="checkbox"/> 正式鋁料 B.M.	<input type="checkbox"/> 技術上資料/指示	<input type="checkbox"/> 報價
<input type="checkbox"/> 配件 B.M.	<input type="checkbox"/> 樣辦或貨品說明書	<input type="checkbox"/> 分判合約
<input type="checkbox"/> 其他:		

內容:	請依附件資料, 訂購拉爆螺絲, 連地盤. (用於屋仔 HBS~HB8)
完成上列要求日期:	ASAP


國內

<input type="checkbox"/> 生產技術總監	<input type="checkbox"/> 連附件	<input type="checkbox"/> 技術部	<input type="checkbox"/> 連附件	<input type="checkbox"/> 生產部	<input type="checkbox"/> 連附件
<input type="checkbox"/> 採購部	<input type="checkbox"/> 連附件	<input type="checkbox"/> 生產統籌部	<input type="checkbox"/> 連附件	<input type="checkbox"/> 報關組	<input type="checkbox"/> 連附件
<input type="checkbox"/> 質檢部	<input type="checkbox"/> 連附件	<input type="checkbox"/> 會計部	<input type="checkbox"/> 連附件	<input type="checkbox"/> 機械設計部	<input type="checkbox"/> 連附件
<input type="checkbox"/> 香港辦	<input type="checkbox"/> 連附件	<input type="checkbox"/> 其他:			

香港

<input type="checkbox"/> 行政部	<input type="checkbox"/> 連附件	<input type="checkbox"/> 會計部	<input type="checkbox"/> 連附件	<input type="checkbox"/> 統籌部	<input type="checkbox"/> 連附件	<input type="checkbox"/> 工程部	<input type="checkbox"/> 連附件
<input type="checkbox"/> 採購部	<input type="checkbox"/> 連附件	<input type="checkbox"/> QS部	<input type="checkbox"/> 連附件	<input checked="" type="checkbox"/> 地盤管理	<input checked="" type="checkbox"/> 連附件	<input type="checkbox"/> 維修部	<input type="checkbox"/> 連附件

*發件人簽署:		*組別成員批核簽署:	
傳遞編號:		項目經理簽署:	

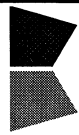

美特鋁質有限公司
MIDI Aluminium Fabricator Ltd.

地盤用配件B.M.表

BM編號:

工程號: J-853

地盤名稱: 香港延坪道(第二期別墅)

項目類別: Curtain Wall (HB5-8修補方案)

A/C Code:

計算: J.L.

核對:

批准:

日期: 26/2/2024

日期:

日期:



送呈: Joe

副本:

版本:

序號	修改標示	加工圖号	配件编号	配件名稱	顏色	實用	後備	總數	單位	備註
1				HST3-R M16 x 145mm 拉爆	S.S.316	48	2	50	套	每粒配1絲帽, 1平介, 1彈介
2				HST3-R M20 x 170mm 拉爆	S.S.316	48	2	50	套	每粒配1絲帽, 1平介, 1彈介
3										
4										
5										
6										
7										
8										
9										
10										

HBS ~ HBB 幕牆修補方案

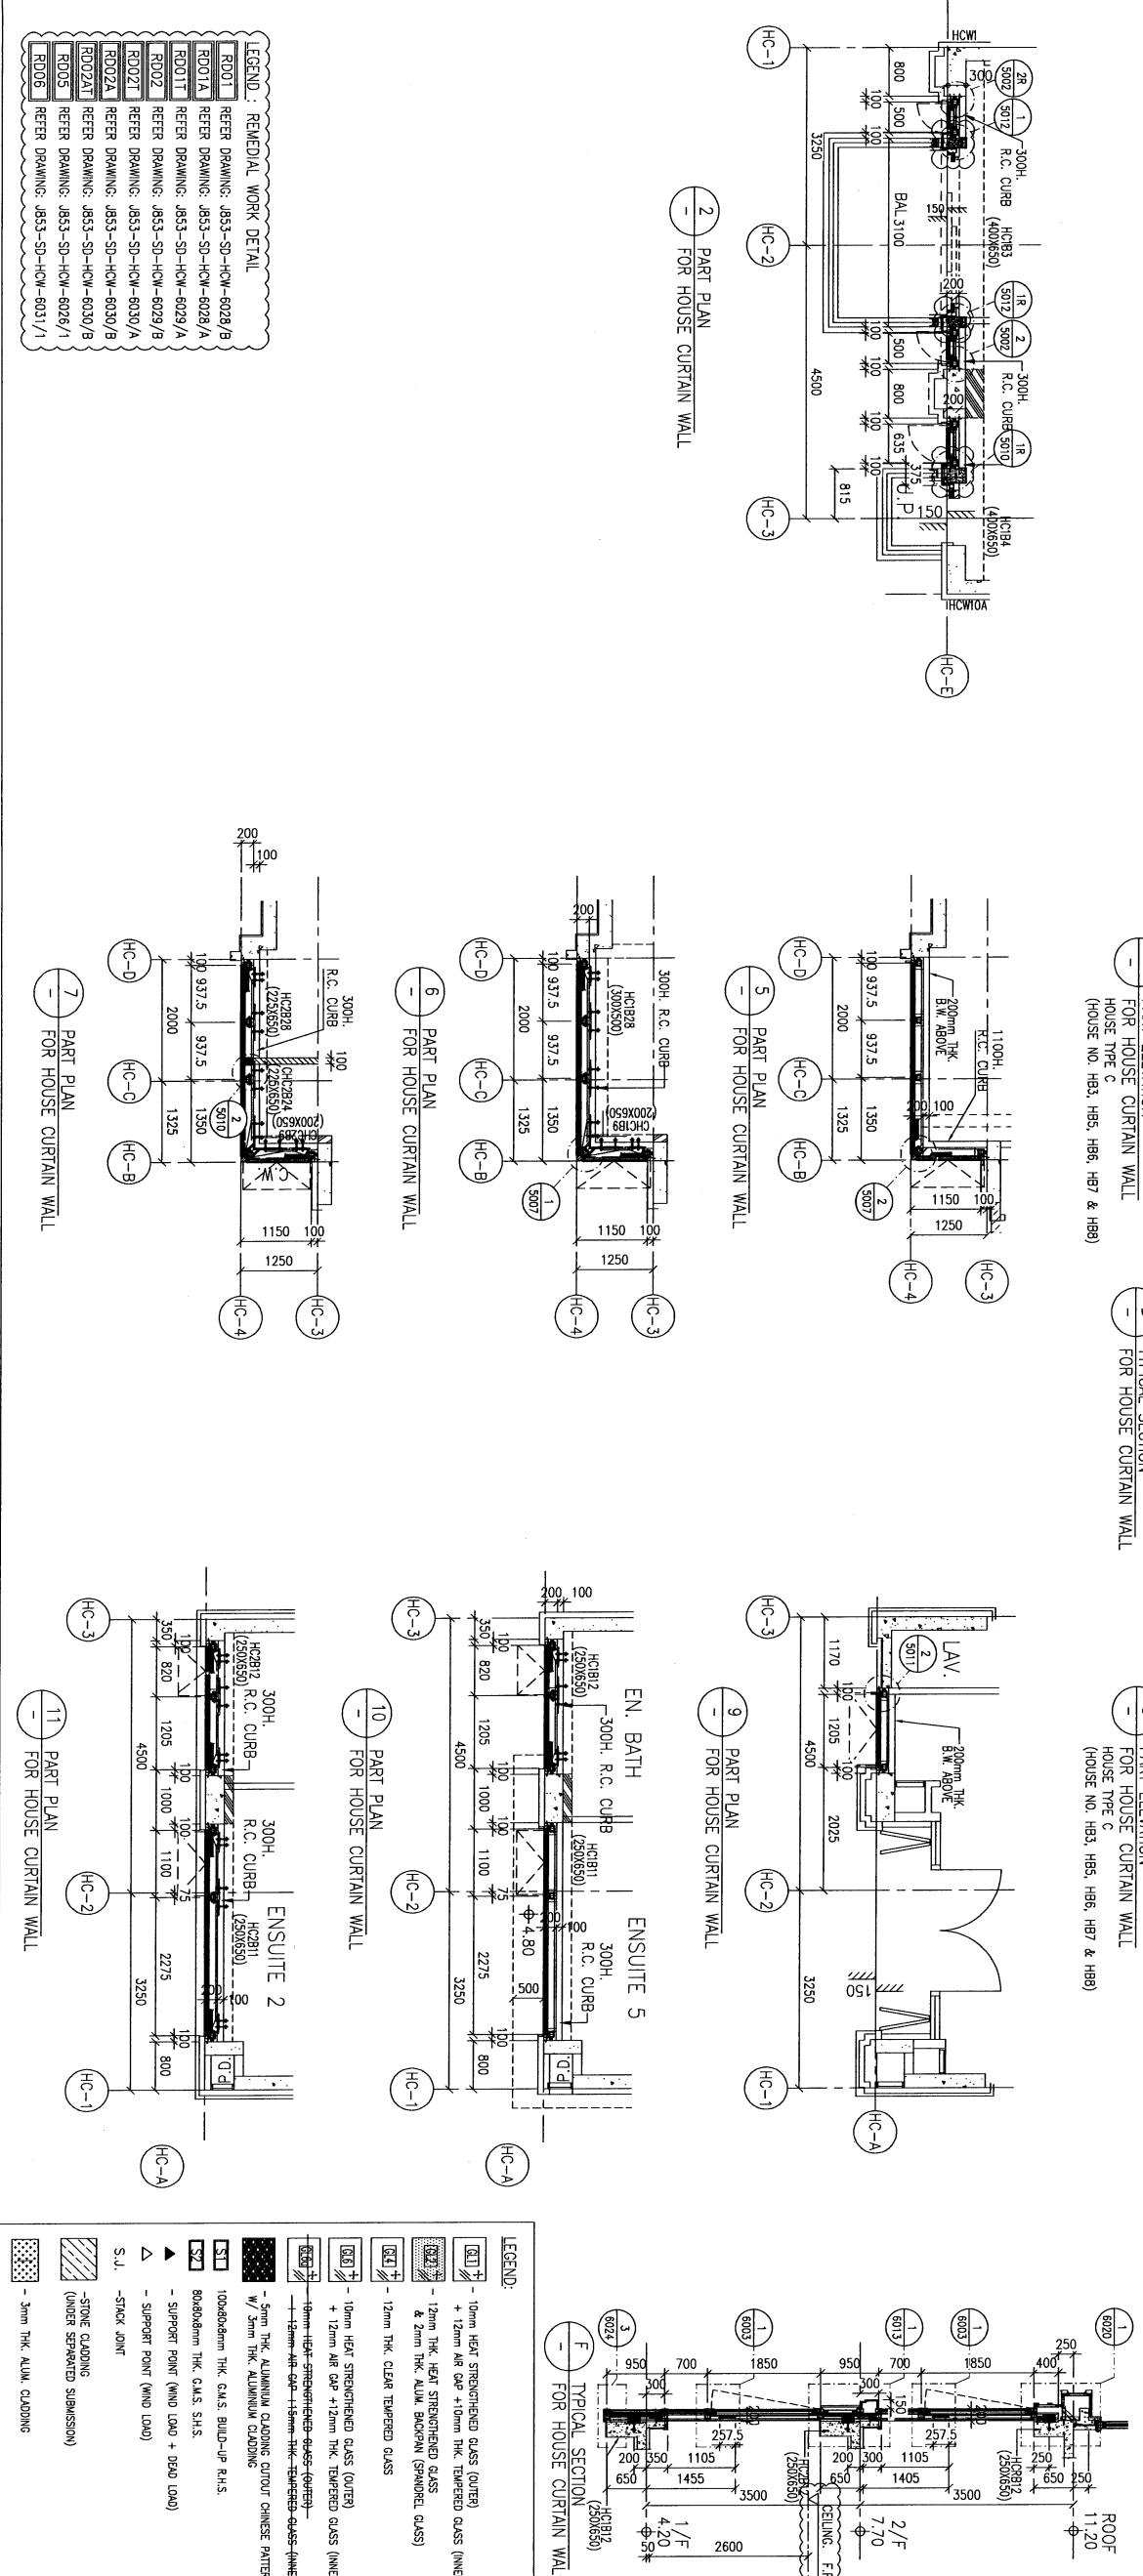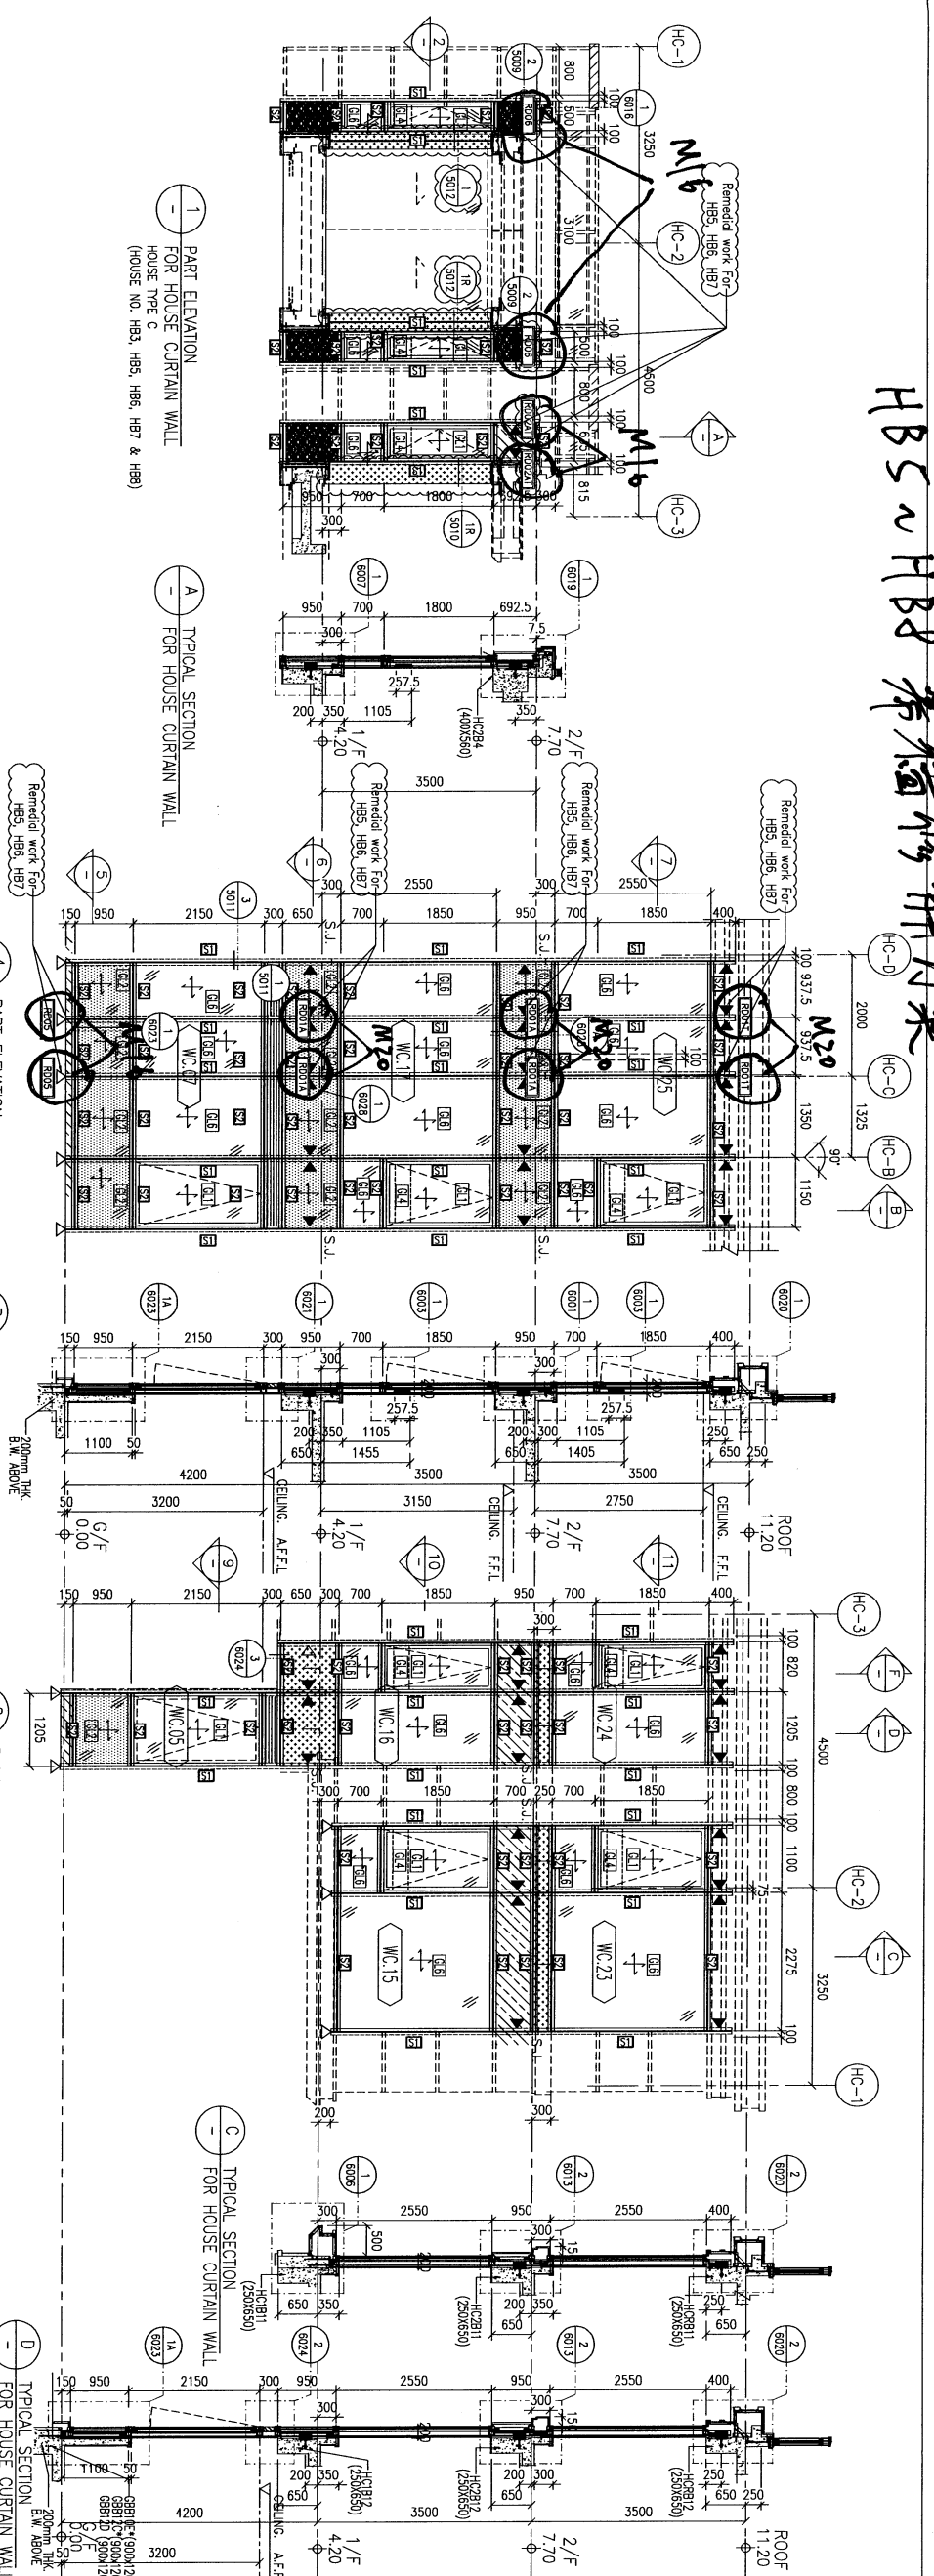

B.D. REF. :	
CLIENT :	SHIMAO GROUP HOLDINGS LIMITED
ARCHITECT :	WONG TUNG & PARTNERS LIMITED ARCHITECTS & ENGINEERS
MAIN CONTRACTOR :	協興建築有限公司 HIP HING CONSTRUCTION CO LTD
STRUCTURAL ENGINEER :	GMA C M WONG & ASSOCIATES LTD 黃志明建築工程師有限公司
FACADE CONSULTANT :	MEINHARDT
NOTE :	1. ALL DIMENSIONS ARE IN mm. 2. ALL ELEVATIONS ARE VIEWED FROM OUTSIDE. 3. ALL DIMENSIONS TO BE VERIFIED ON SITE BEFORE FABRICATION.
LEGEND :	<ul style="list-style-type: none"> ① DETAIL MARK NO. ② REFER SHEET NO. ③ F.F.L. --- FINISHED FLOOR LEVEL ④ S.F.L. --- STRUCTURAL FLOOR LEVEL ⑤ --- REVERSED DETAIL ⑥ R.C. STRUCTURAL ELEMENT ⑦ COL. / BEAM / SLAB ⑧ IS (UNDER SEPARATED SUBMISSION)
JOB NO. :	J-853
PROJECT :	PROPOSED RESIDENTIAL DEVELOPMENT AT N.K.I.L. 6542 YIN PING ROAD KOWLOON
TITLE :	PART ELEVATION AND PART PLAN FOR HOUSE CURTAIN WALL AT HOUSE TYPE C (HOUSE NO. H83, H85, H86, H87 & H88)
DATE :	27-04-17
SCALE :	1:60 (A1)
DRAWN BY :	ASING
CHECKED BY :	
UNITS 6-8 Sunray Industrial Centre, 1/F 610 Che Kwo Ling Road, Kowloon Tel: 23489211-4 Fax: (852) 2727866	
REV. : D	

LEGEND: REMEDIAL WORK DETAIL

RD001	REFER DRAWING: J853-SD-HCW-6028/B
RD01A	REFER DRAWING: J853-SD-HCW-6028/A
RD02	REFER DRAWING: J853-SD-HCW-6029/B
RD02A	REFER DRAWING: J853-SD-HCW-6030/B
RD02AT	REFER DRAWING: J853-SD-HCW-6026/1
RD05	REFER DRAWING: J853-SD-HCW-6026/1
RD06	REFER DRAWING: J853-SD-HCW-6031/1