



工程指示 / 要求簡箋 ENGINEER INSTRUCTIONS(E.I.)

工程指示編號:	EI- 7655 D	修改版本:	- D
	HK- 1448		
工程編號:	J 853	工程名稱:	延坪道 (第2期)
收件人:	生統/	發件人:	Jingo
工程項目:	Feature wall 飾線 鋁料加工圖修改	日期:	7/8/2024

<input type="checkbox"/> 原合約工程包	<input type="checkbox"/> 原合約工程加 / 減賬 QT-	<input type="checkbox"/> 新工程報價 QT-
---------------------------------	--	------------------------------------

信件批核號碼/圖紙參考編號:	批核模具圖紙編號:
客戶指示附件:	管理內部批簽署:

<input type="checkbox"/> 初步鋁料 B.M.	<input type="checkbox"/> 加工拆圖, 然後生產	<input type="checkbox"/> 尺寸表
<input type="checkbox"/> 正式鋁料 B.M.	<input type="checkbox"/> 技術上資料/指示	<input type="checkbox"/> 報價
<input type="checkbox"/> 配件 B.M.	<input type="checkbox"/> 樣辦或貨品說明書	<input type="checkbox"/> 分判合約
<input type="checkbox"/> 其他:		

內容: 按派位圖包裝

完成上列要求日期: 7/8/2024

國內

<input type="checkbox"/> 生產技術總監	<input type="checkbox"/> 連附件	<input type="checkbox"/> 技術部	<input type="checkbox"/> 連附件	<input type="checkbox"/> 生產部	<input type="checkbox"/> 連附件
<input type="checkbox"/> 採購部	<input type="checkbox"/> 連附件	<input checked="" type="checkbox"/> 生產統籌部	<input checked="" type="checkbox"/> 連附件	<input type="checkbox"/> 報關組	<input type="checkbox"/> 連附件
<input type="checkbox"/> 質檢部	<input type="checkbox"/> 連附件	<input type="checkbox"/> 會計部	<input type="checkbox"/> 連附件	<input type="checkbox"/> 機械設計部	<input type="checkbox"/> 連附件
<input type="checkbox"/> 香港辦	<input type="checkbox"/> 連附件	<input type="checkbox"/> 其他:			

香港

<input type="checkbox"/> 行政部	<input type="checkbox"/> 連附件	<input type="checkbox"/> 會計部	<input type="checkbox"/> 連附件	<input type="checkbox"/> 統籌部	<input type="checkbox"/> 連附件	<input type="checkbox"/> 工程部	<input type="checkbox"/> 連附件
<input type="checkbox"/> 採購部	<input type="checkbox"/> 連附件	<input type="checkbox"/> QS部	<input type="checkbox"/> 連附件	<input checked="" type="checkbox"/> 地盤管理	<input checked="" type="checkbox"/> 連附件	<input type="checkbox"/> 維修部	<input type="checkbox"/> 連附件

*發件人簽署:	*組別成員批核簽署:
傳遞編號:	項目經理簽署:

PROJECT
YIN PING ROAD KOWLOON
FEATURE WALL (PHASE 2)

MATERIAL
格栅组装图

COATING

COLOUR

MARK. NO.

QTY.


REV. OR PART NO.	PART NUMBER	Dim. A	Dim. B	Dim. C	Dim. D	Dim. E	Dim. F	Dim. G	Dim. H	QTY.	Inv. Code
-	P2-UN-A02	-	-	-	-	-	-	-	-	2	

ASSEMBLE ON PARTS

注：用于 A 区域

注：地盘用

序号	编号	数量
①	P2-AL-A05A	7
②	P2-AL-A06A	7
③	P2-AL-A02	7
④	P2-AP-A03A	1
⑤	P2-AL-A01	7
⑥	P2-AL-A01B	

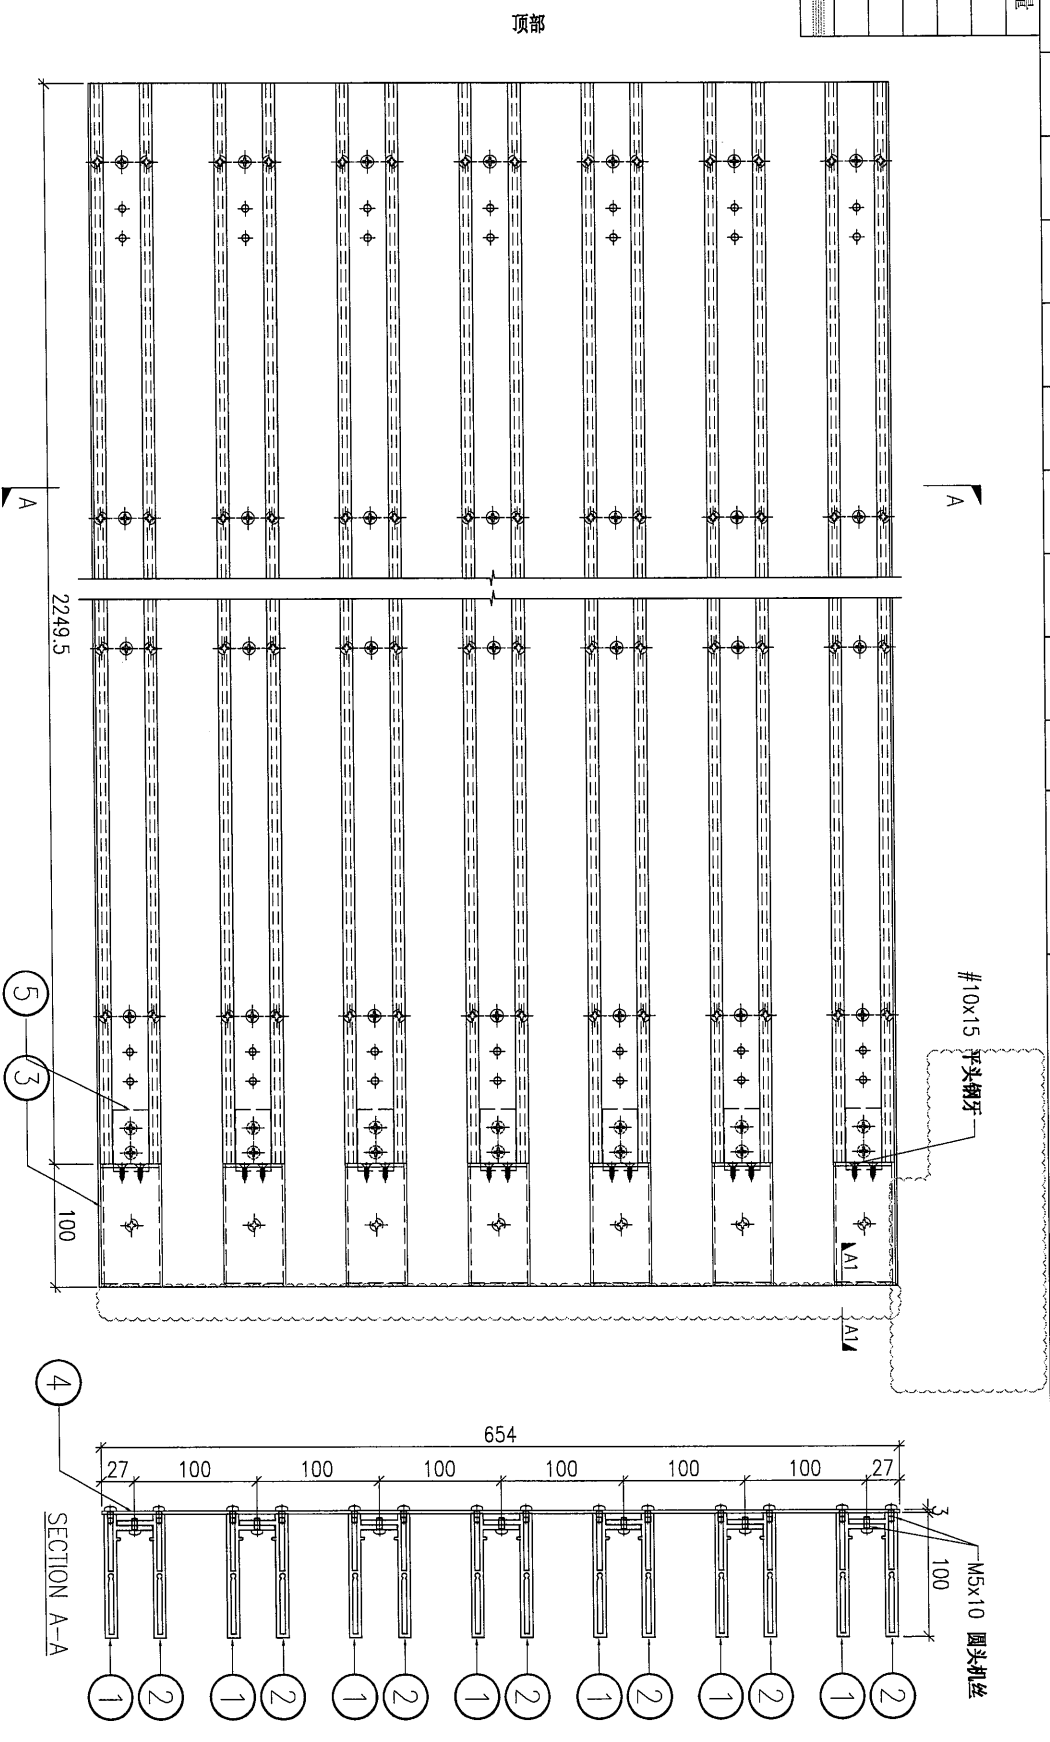

DWG. NO. P2-UN-A02

REV. A

SCALE -

DATE 13-04-2024

DRAWN BY

APPROVED BY

PROJECT
YIN PING ROAD KOWLOON
FEATURE WALL (PHASE 2)

MATERIAL
格栅组装图

COATING

COLOUR

MARK. NO.


QTY.

ASSEMBLE ON PARTS

注: 地盘用

REV. ORIGIN BY	PART NUMBER	Dim. A	Dim. B	Dim. C	Dim. D	Dim. E	Dim. F	Dim. G	Dim. H	QTY.	Inv. Code
-	P2-UN-A03	-	-	-	-	-	-	-	-	1	

序号	编号	数量
①	P2-AL-A07	7
②	P2-AL-A08	7
③	P2-AL-A02	7
④	P2-AP-A04	1
⑤	P2-AL-A01	7
⑥	P2-AL-A01B	1

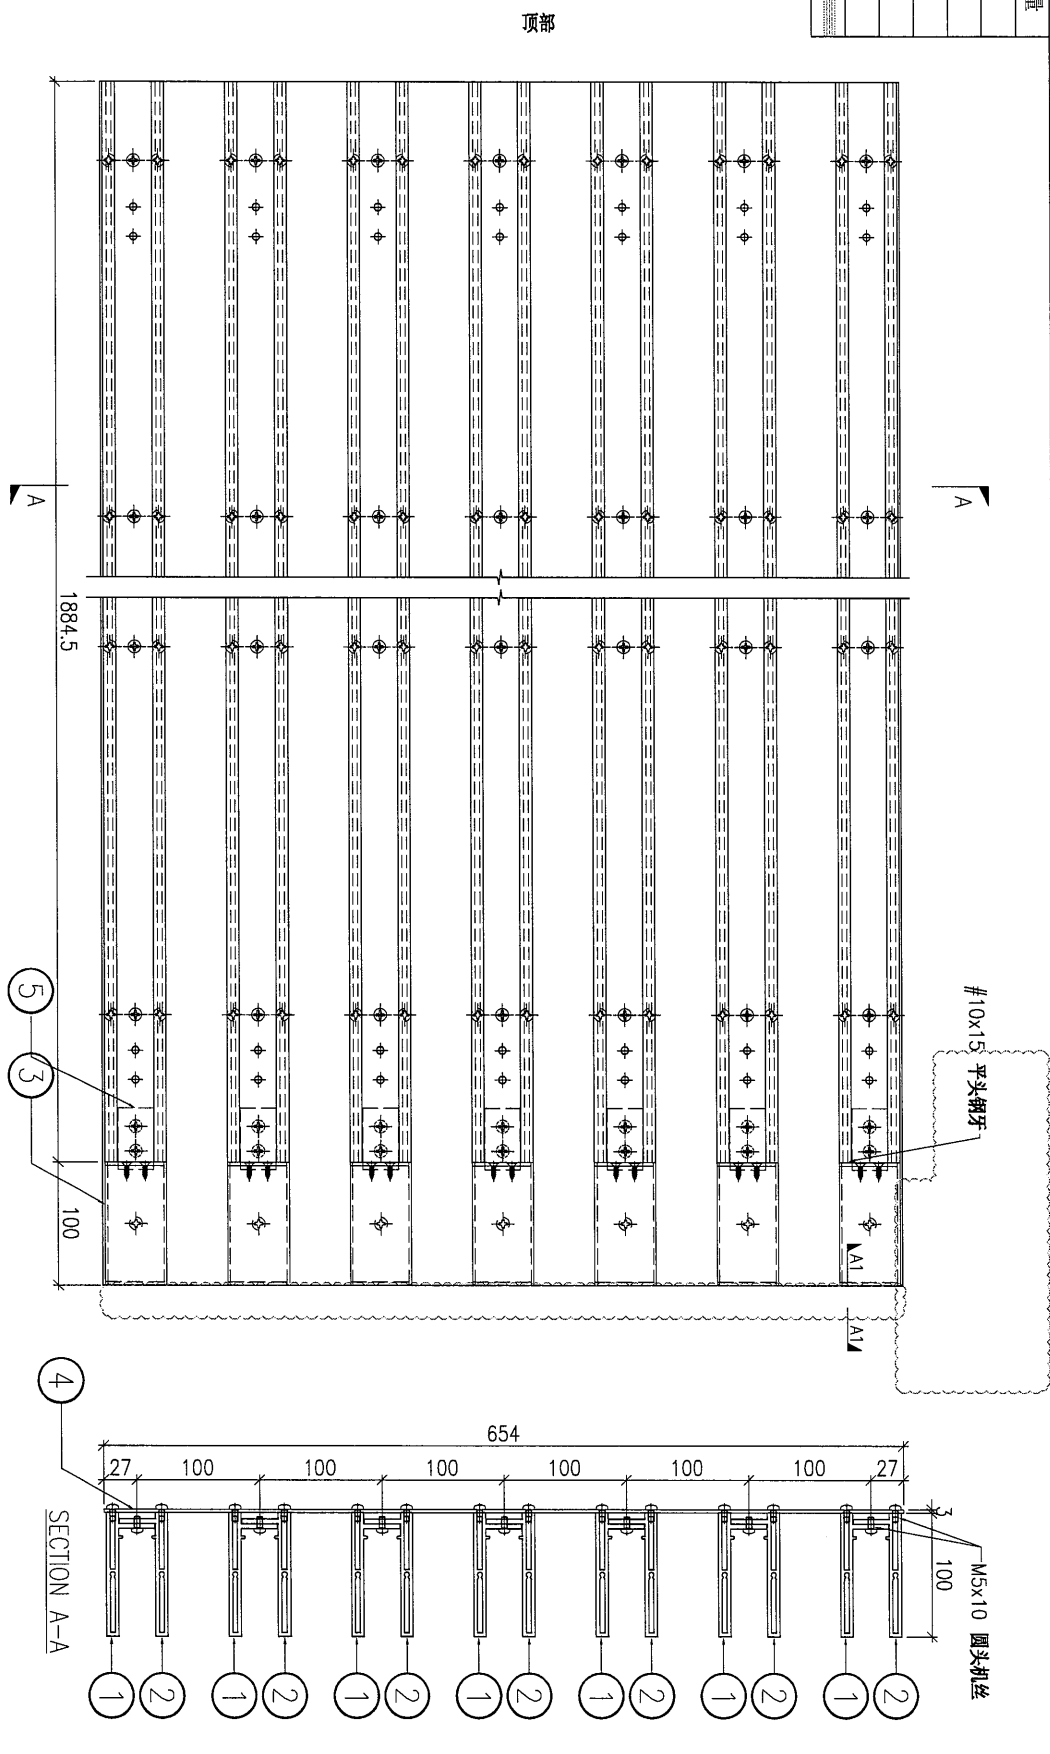

DWG. NO.	REV.	SCALE	DATE	DRAWN BY	APPROVED BY
P2-UN-A03	A	-	13-04-2024	-	-

PROJECT
YIN PING ROAD KOWLOON
FEATURE WALL (PHASE 2)

MATERIAL
格栅组装图

COATING

COLOUR

MARK. NO.

QTY.


ASSEMBLE ON PARTS

注：地盘用

checked date by	PART NUMBER	Dim. A	Dim. B	Dim. C	Dim. D	Dim. E	Dim. F	Dim. G	Dim. H	QTY.	Inv. Code
-	P2-UN-B02	-	-	-	-	-	-	-	-	3	

序号	编号	数量
①	P2-AL-B05A	7
②	P2-AL-B06A	7
③	P2-AL-B02	7
④	P2-AP-B03A	1
⑤	P2-AL-B01	7
⑥	P2-AL-B01B	1

格栅

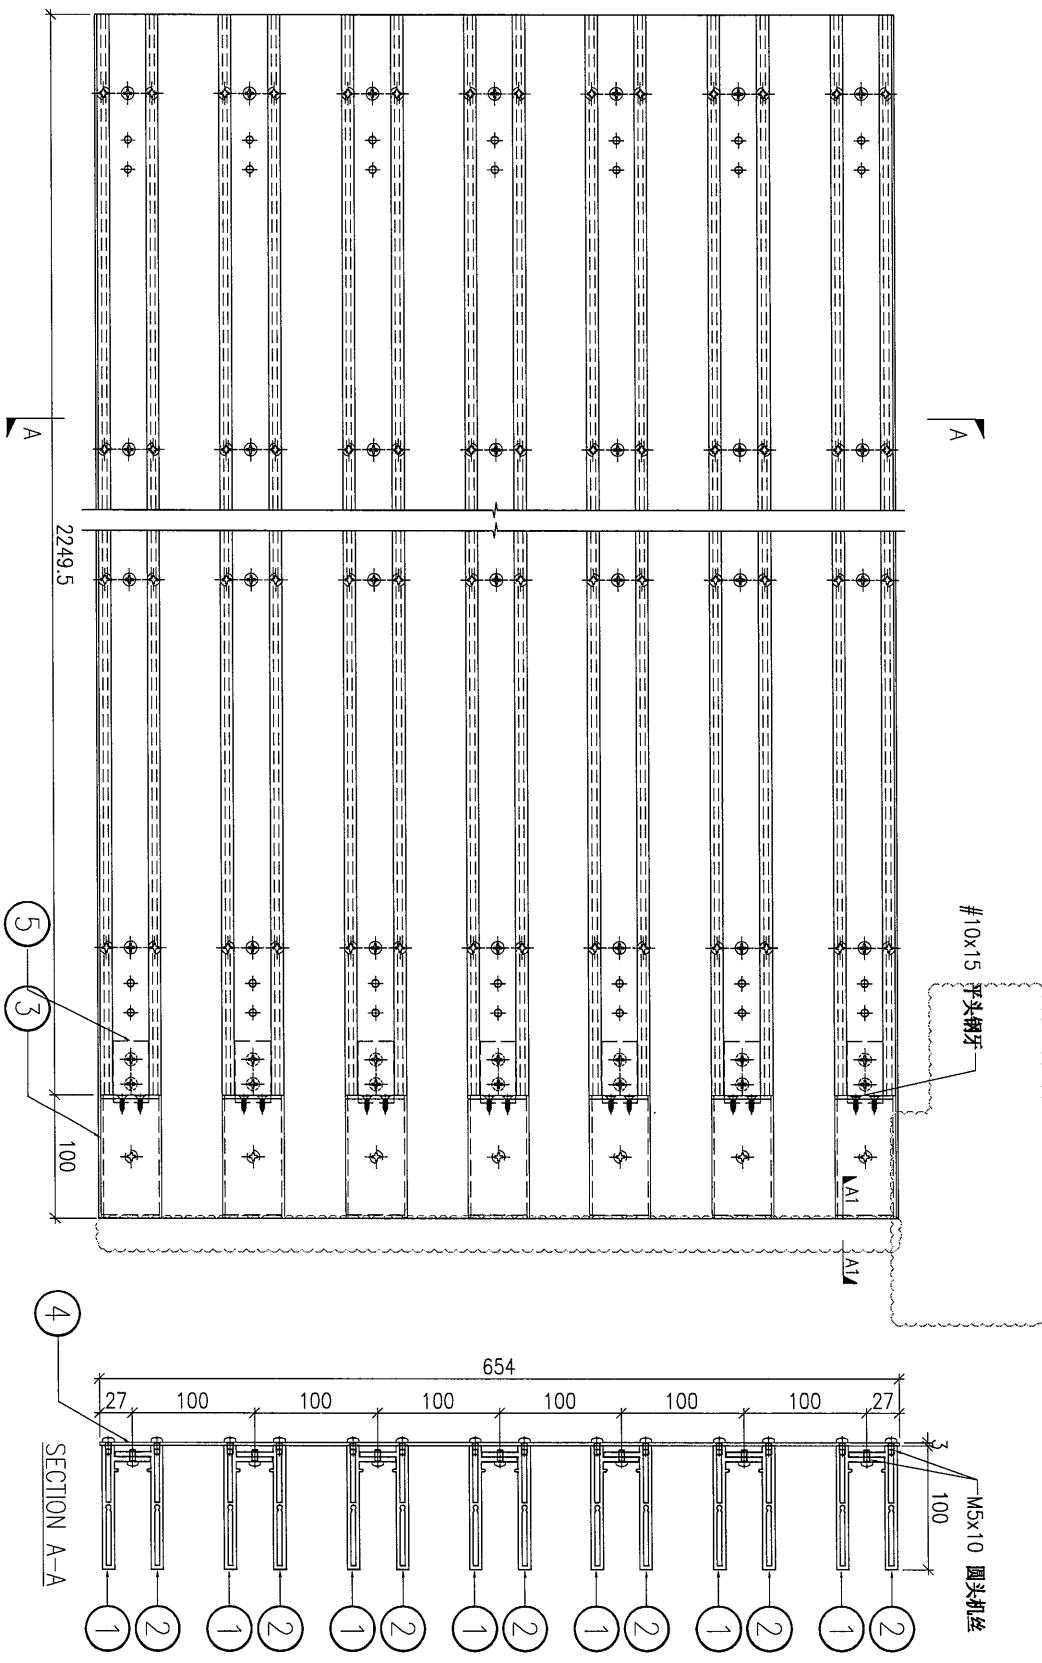

DWG. NO.	REV.	SCALE	DATE	DRAWN BY	APPROVED BY
P2-UN-B02	A	-	13-04-2024	-	-

