

工程指示 / 要求簡箋 ENGINEER INSTRUCTIONS(E.I.)

工程指示編號:	EI-7672	修改版本:	-
	HK- /		
工程編號:	J 853	工程名稱:	延坪道 (第2期)
收件人:	Maggie Lor	發件人:	Joe Chan
工程項目:	Row B HBI-3 GB 欄河 及 HBI-8 up 欄河地盤用玻璃 (黃色)	日期:	22/04/2024

<input type="checkbox"/> 原合約工程包	<input type="checkbox"/> 原合約工程加 / 減賬 QT-	<input type="checkbox"/> 新工程報價 QT-
---------------------------------	--	------------------------------------

信件批核號碼/圖紙參考編號:	批核模具圖紙編號:
客戶指示附件:	管理內部批簽署:

<input type="checkbox"/> 初步鋁料 B.M.	<input type="checkbox"/> 加工拆圖, 然後生產	<input type="checkbox"/> 尺寸表
<input type="checkbox"/> 正式鋁料 B.M.	<input type="checkbox"/> 技術上資料/指示	<input type="checkbox"/> 報價
<input type="checkbox"/> 配件 B.M.	<input type="checkbox"/> 樣辦或貨品說明書	<input type="checkbox"/> 分判合約
<input type="checkbox"/> 其他:		

內容: 請依附件資料, 生產玻璃, 送地盤
 - 按 BS EN 14179-1:2016 標準熱浸
 - 請分層包裝出貨.

完成上列要求日期: 10/5/2024 完成

國內

<input type="checkbox"/> 生產技術總監	<input type="checkbox"/> 連附件	<input type="checkbox"/> 技術部	<input type="checkbox"/> 連附件	<input type="checkbox"/> 生產部	<input type="checkbox"/> 連附件
<input type="checkbox"/> 採購部	<input type="checkbox"/> 連附件	<input type="checkbox"/> 生產統籌部	<input type="checkbox"/> 連附件	<input type="checkbox"/> 報關組	<input type="checkbox"/> 連附件
<input type="checkbox"/> 質檢部	<input type="checkbox"/> 連附件	<input type="checkbox"/> 會計部	<input type="checkbox"/> 連附件	<input type="checkbox"/> 機械設計部	<input type="checkbox"/> 連附件
<input type="checkbox"/> 香港辦	<input type="checkbox"/> 連附件	<input type="checkbox"/> 其他:			

香港

<input type="checkbox"/> 行政部	<input type="checkbox"/> 連附件	<input type="checkbox"/> 會計部	<input type="checkbox"/> 連附件	<input type="checkbox"/> 統籌部	<input type="checkbox"/> 連附件	<input type="checkbox"/> 工程部	<input type="checkbox"/> 連附件
<input type="checkbox"/> 採購部	<input type="checkbox"/> 連附件	<input type="checkbox"/> QS部	<input type="checkbox"/> 連附件	<input checked="" type="checkbox"/> 地盤管理	<input checked="" type="checkbox"/> 連附件	<input type="checkbox"/> 維修部	<input type="checkbox"/> 連附件

*發件人簽署:		*組別成員批核簽署:	
傳遞編號:		項目經理簽署:	

J853-香港延坪道(第二期别墅)-Glass Balustrade-地盘玻璃分栋数量统计表 (HB1-3 GB & HB1-8 UP)

工程: J853-香港延坪道(第二期别墅)

日期: 17-Apr-24

Rev:

序号	部件图编号								总数量	备注
		HB1	HB2	HB3	HB5	HB6	HB7	HB8		
1	J853-GB-GL3-001-13	2	2						4	
2	J853-GB-GL3-001-14	2	2						4	
3	J853-GB-GL3-001-15	2	2						4	
4	J853-GB-GL3-001-16	6	6						12	
5	J853-GB-GL3-001-17	2	2						4	
6	J853-GB-GL3-001-18	6	6						12	
7	J853-GB-GL3-001-19	3	3	3					9	
8	J853-GB-GL3-001-20	5	5						10	
9	J853-GB-GL3-001-21	3	3	3					9	
10	J853-GB-GL3-001-22			2					2	
11	J853-GB-GL3-001-23			2					2	
12	J853-GB-GL3-001-24			6					6	
13	J853-GB-GL3-001-25			2					2	
14	J853-GB-GL3-001-26			6					6	
15	J853-GB-GL3-001-28			5					5	
16	J853-GB-GL3-001-30			2					2	
17	J853-GB-GL3-003-01	2	2	2	2	2	2	2	14	
18	J853-GB-GL3-003-02	2	2	2	2	2	2	2	14	
19	J853-GB-GL3-003-03	4	4	4	4	4	4	4	28	
20	J853-GB-GL3-003-04	2	2	2	2	2	2	2	14	
		41	41	41	10	10	10	10	163	


BM編號:

工程號:	J-853	計算:	J. L.	日期:	20/4/2024	送呈:	Joe
地盘名稱:	香港延坪道(第二期別墅)	核對:		日期:		副本:	
項目類別:	HB1-HB3 GB & HB1~HB8 UP	批准:		日期:		版本:	
A/C Code:		總數量:	163	總面積 (m ²):	97.51		

序號	修改標示	加工圖号	玻璃编号	玻璃名稱	厚度 (mm)	玻璃尺寸		數量 (塊)	面積 (m ²)		備註
						寬度W (mm)	高度H (mm)		單件	總面積	
1		J853-GB-GL3-001	J853-GB-GL3-001-13	GL3: 15mm THK. CLEAR TEMPERED + 1.52mm THK. (PVB) + 15mm THK. CLEAR TEMPERED LAMINATED GLASS SAMPLE NO.: R20230105032	31.52	1281	640	4	0.82	3.28	玻璃底部塗DC791黑膠
2		J853-GB-GL3-001	J853-GB-GL3-001-14			1418	640	4	0.91	3.63	玻璃底部塗DC791黑膠
3		J853-GB-GL3-001	J853-GB-GL3-001-15			911	440	4	0.40	1.60	玻璃底部塗DC791黑膠
4		J853-GB-GL3-001	J853-GB-GL3-001-16			1538	440	12	0.68	8.12	玻璃底部塗DC791黑膠
5		J853-GB-GL3-001	J853-GB-GL3-001-17			801	840	4	0.67	2.69	玻璃底部塗DC791黑膠
6		J853-GB-GL3-001	J853-GB-GL3-001-18			1538	840	12	1.29	15.50	玻璃底部塗DC791黑膠
7		J853-GB-GL3-001	J853-GB-GL3-001-19			1208	840	9	1.01	9.13	玻璃底部塗DC791黑膠
8		J853-GB-GL3-001	J853-GB-GL3-001-20			1566	840	10	1.32	13.15	玻璃底部塗DC791黑膠
9		J853-GB-GL3-001	J853-GB-GL3-001-21			1098	840	9	0.92	8.30	玻璃底部塗DC791黑膠
10		J853-GB-GL3-001	J853-GB-GL3-001-22			1451	640	2	0.93	1.86	玻璃底部塗DC791黑膠
11		J853-GB-GL3-001	J853-GB-GL3-001-23	1271	640	2	0.81	1.63	玻璃底部塗DC791黑膠		
12		J853-GB-GL3-001	J853-GB-GL3-001-24	1371	440	6	0.60	3.62	玻璃底部塗DC791黑膠		
13		J853-GB-GL3-001	J853-GB-GL3-001-25	936	840	2	0.79	1.57	玻璃底部塗DC791黑膠		
14		J853-GB-GL3-001	J853-GB-GL3-001-26	1371	840	6	1.15	6.91	玻璃底部塗DC791黑膠		
15		J853-GB-GL3-001	J853-GB-GL3-001-28	1406	840	5	1.18	5.91	玻璃底部塗DC791黑膠		
16		J853-GB-GL3-001	J853-GB-GL3-001-30	1086	840	2	0.91	1.82	玻璃底部塗DC791黑膠		
17		J853-GB-GL3-003	J853-GB-GL3-003-01	GL3: 15mm THK. CLEAR TEMPERED + 1.52mm THK. (PVB) + 15mm THK. CLEAR TEMPERED LAMINATED GLASS SAMPLE NO.: R20230105032	31.52	195	728	14	0.14	1.99	玻璃企向兩端 DC688玻璃膠封邊
18		J853-GB-GL3-003	J853-GB-GL3-003-02			189	728	14	0.14	1.93	玻璃企向兩端 DC688玻璃膠封邊
19		J853-GB-GL3-003	J853-GB-GL3-003-03			161	728	28	0.12	3.28	玻璃企向兩端 DC688玻璃膠封邊
20		J853-GB-GL3-003	J853-GB-GL3-003-04			155	728	14	0.11	1.58	玻璃企向兩端 DC688玻璃膠封邊
						總合計:	163			97.51	

加工注意事項:




- 1). 本表中所有玻璃對角線尺寸偏差要求不超過正負2mm.
- 2). 本表中所有玻璃要求粗磨邊處理並倒棱角.
- 3). 本表中玻璃要求粗磨邊處理並倒棱角, 攔河玻璃頂底要精磨邊, 而所有玻璃之入爐方向需保持一致.
- 4). 本表中不同種類玻璃參照玻璃加工圖加工.
- 5). 本表中所有強化玻璃均需HEAT SOAK TEST.
- 6). 本表中所有玻璃均需注明室內外面及其玻璃編號, 以便識別.

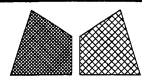

美特铝质有限公司
MIDI Aluminium Fabricator Ltd.

工程号	J853	制图	J.L.	20/11/23	物料号	详见玻璃BM表			
地盘	香港延坪路	复核	-	-	图号	J853-GB-GL3-001			
版本	A	名称	玻璃加工图	批准	-	数量	-		
日期	14/12	材料	GL3:15 T+1.52PBV+15 T	单件面积(m ²)	-	长度	-	宽度	-


采用	工厂	地盘	√
颜色	-		

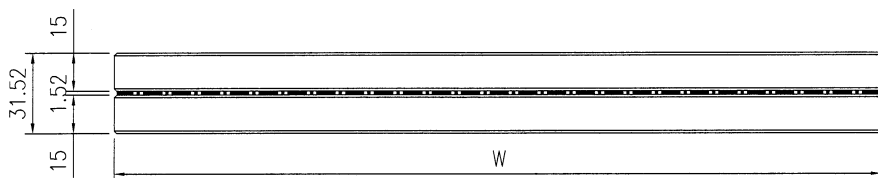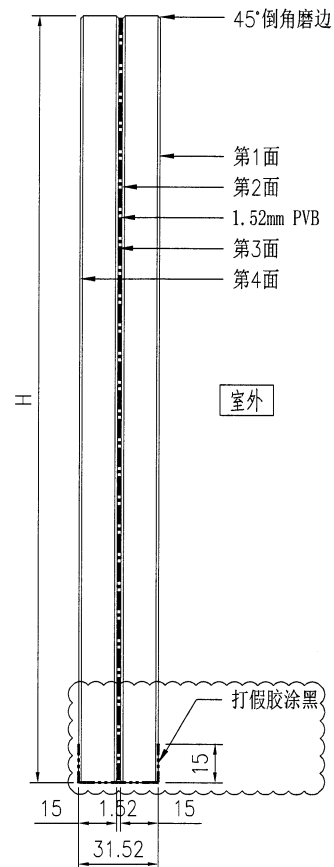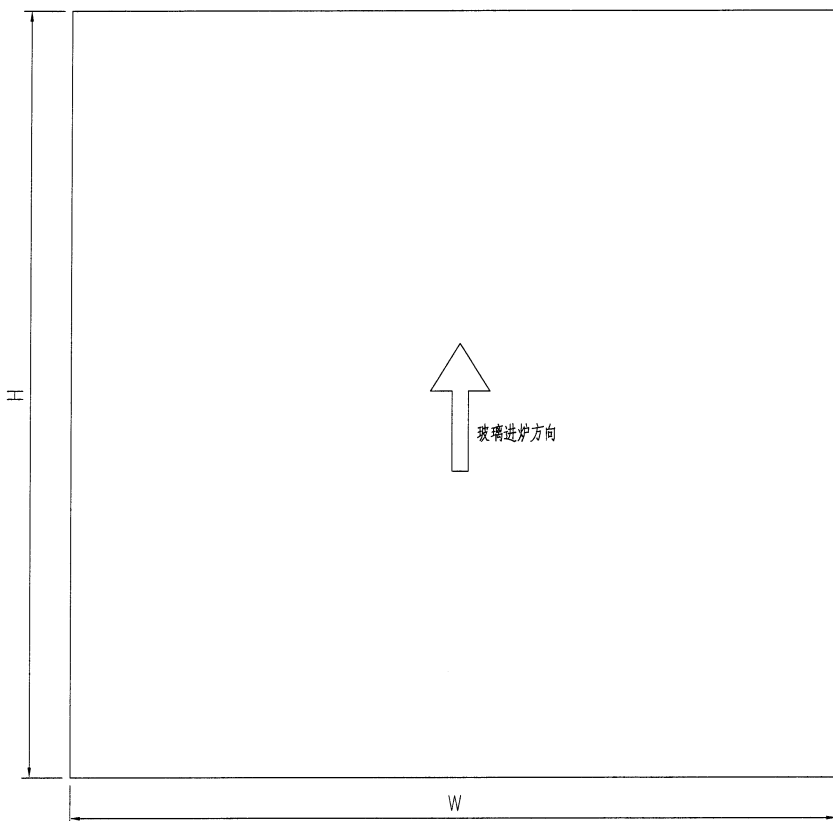

室外





技术说明:

- 1.玻璃为: GL3:15mm THK. CLEAR TEMPERED + 1.52mm THK. (PVB) + 15mm THK. CLEAR TEMPERED LAMINATED GLASS
- 2.色号为: - , Low-e膜在第 面;
- 3.中空铝隔条, 两面涂丁基胶涂抹均匀, 内层为铝框本色, 玻璃四周1x45°机磨边;
- 4.玻璃密封胶采用: , 胶深符合相应规范要求;
- 5.中空玻璃应符合《中空玻璃》GB1194-2002国家标准, 并按《玻璃幕墙工程质量检验标准》JGJ/T139-2001进行质量检验;
- 6.玻璃出厂前必须粘好相应编号及内外标签,玻璃单边长度超过2m, 所有钢化玻璃需要热浸处理;
- 7.玻璃钢化波纹方向平行分布; 图中标注尺寸单位为mm, 进炉方向与滚轮垂直。

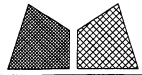




美特铝质有限公司
MIDI Aluminium Fabricator Ltd.

工程号	J853	制图	J.L.	27/12/23	物料号	详见玻璃BM表			
地盘	香港延坪路	复核	-	-	图号	J853-GB-GL3-003			
版本		名称	玻璃加工图	批准	-	-	数量	-	
日期		材料	GL3:15 T+1.52PBV+15 T	单件面积(m ²)	-	长度	-	宽度	-

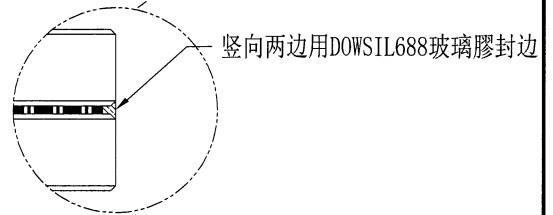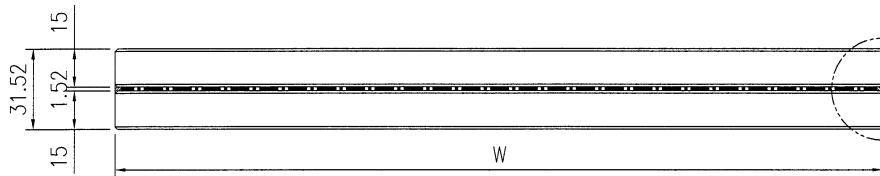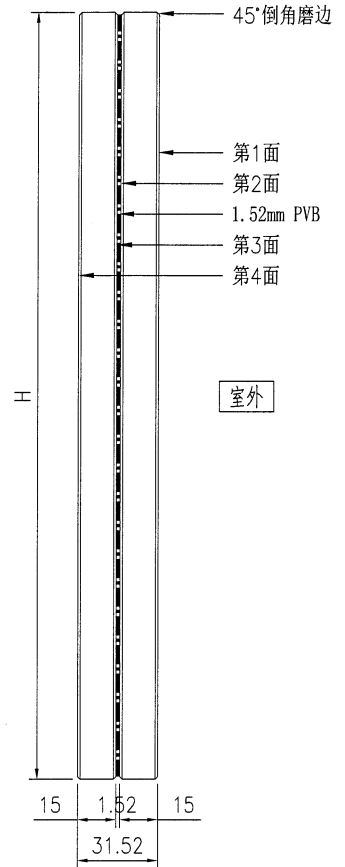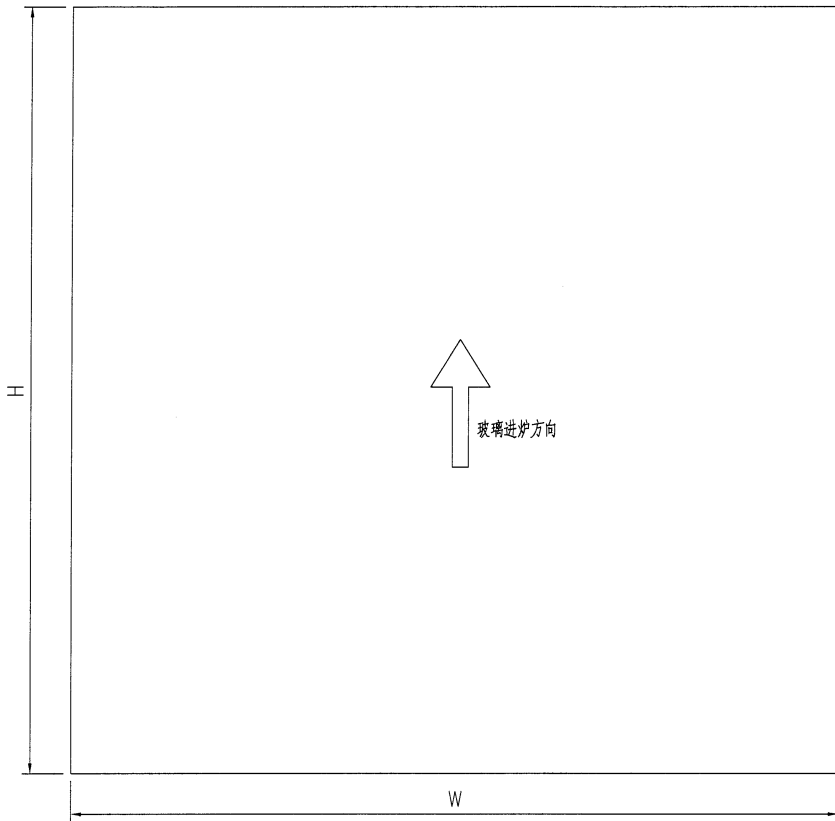

技术说明:

- 1.玻璃为: GL3:15mm THK. CLEAR TEMPERED + 1.52mm THK. (PVB) + 15mm THK. CLEAR TEMPERED LAMINATED GLASS
- 2.色号为: -, Low-e膜在第____面;
- 3.中空铝隔条, 两面涂丁基胶涂抹均匀, 内层为铝框本色, 玻璃四周1x45°机磨边;
- 4.玻璃密封胶采用: _____, 胶深符合相应规范要求;
- 5.中空玻璃应符合《中空玻璃》GB1194-2002国家标准, 并按《玻璃幕墙工程质量检验标准》JGJ/T139-2001进行质量检验;
- 6.玻璃出厂前必须粘好相应编号及内外标签, 玻璃单边长度超过2m, 所有全钢化玻璃需要热浸处理;
- 7.玻璃钢化波纹方向平行分布; 图中标注尺寸单位为mm, 进炉方向与滚轮垂直。

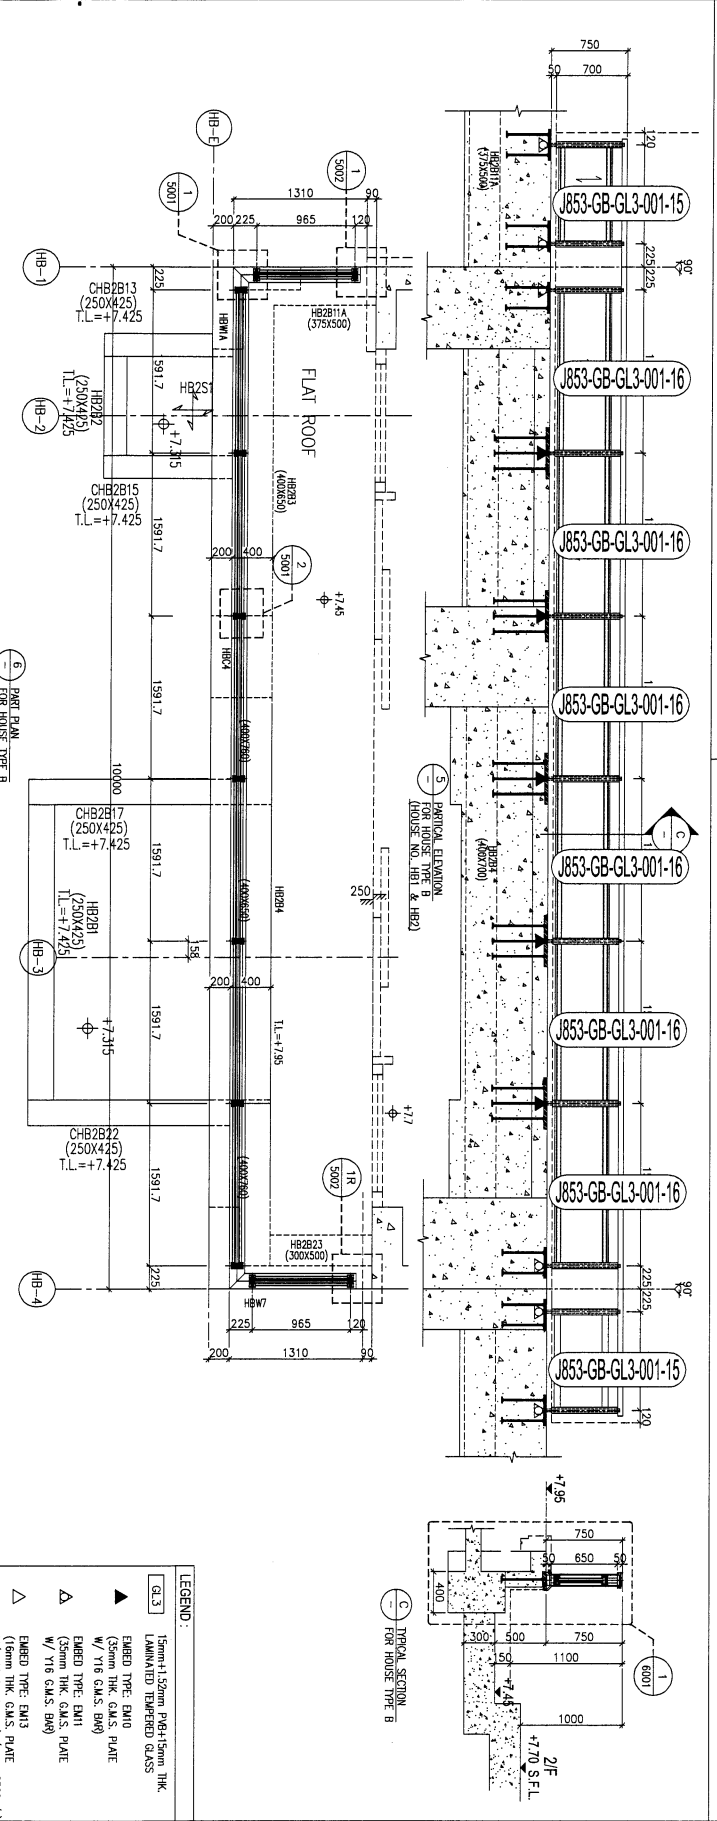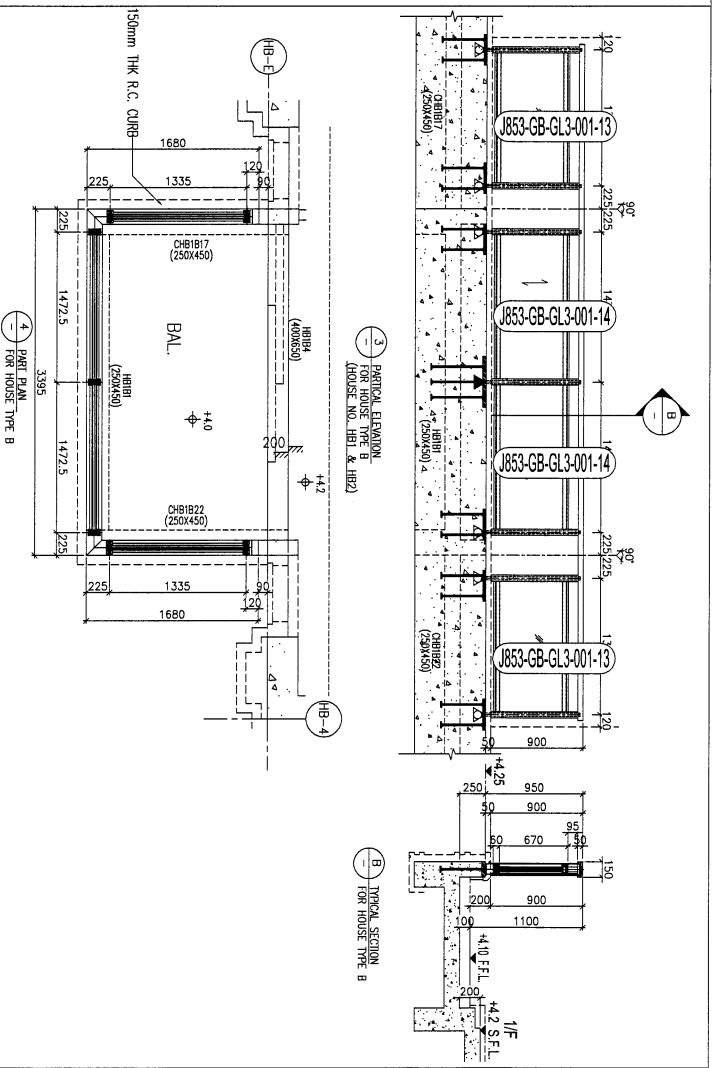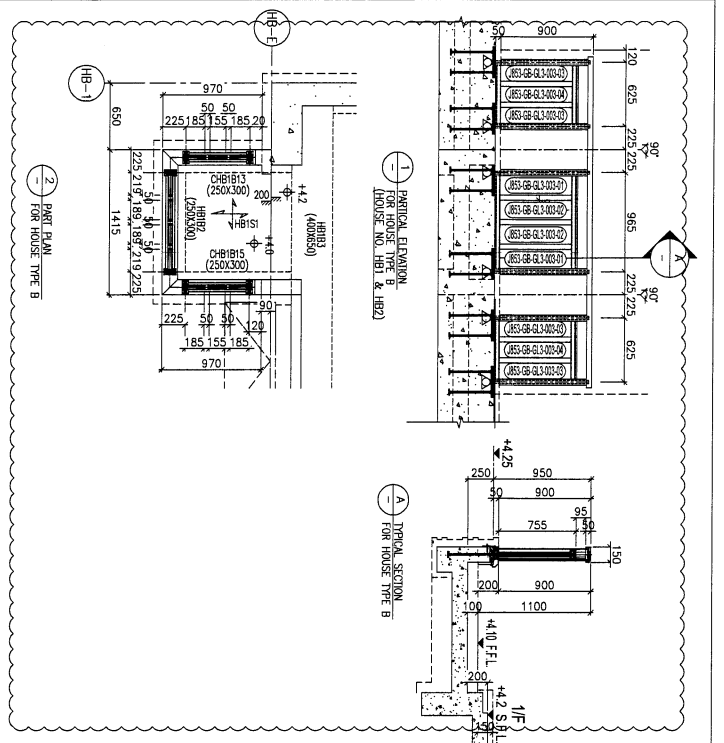

DATE: 22/02/2023	GENERAL REVISION
DATE: 27/02/2023	GENERAL REVISION
DATE: 01/03/2023	GENERAL REVISION
DATE: 10/05/2023	GENERAL REVISION
DATE: 31/07/2023	GENERAL REVISION
DATE: 01/08/2023	GENERAL REVISION

LEGEND:
 GL-3 15mm+15mm PVB+15mm THK LAMINATED TONED GLASS
 EMBED TYPE: EM10 (35mm THK, G.M.S. PLATE W/ Y16 G.M.S. BAY)
 EMBED TYPE: EM11 (35mm THK, G.M.S. PLATE W/ Y16 G.M.S. BAY)
 EMBED TYPE: EM13 (35mm THK, G.M.S. PLATE W/ Y16 G.M.S. BAY)

LEGEND:
 X1 DETAIL MARK NO.
 1001 REFER SHEET NO.
 1. F.F.L. - FINISHED FLOOR LINE
 2. S.F.L. - STRUCTURAL FLOOR LEVEL
 3. R.C. STRUCTURAL ELEMENT IS / BEAM / SLAB IS (UNDER SEPARATED SUBMISSION)
 4. 150mm THK R.C. CURB

LEGEND:
 1. ALL DIMENSIONS ARE IN mm.
 2. ALL ELEVATIONS ARE VIEWED FROM OUTSIDE.
 3. ALL DIMENSIONS TO BE VERIFIED ON SITE BEFORE FABRICATION.

LEGEND:
 1. ALL DIMENSIONS ARE IN mm.
 2. ALL ELEVATIONS ARE VIEWED FROM OUTSIDE.
 3. ALL DIMENSIONS TO BE VERIFIED ON SITE BEFORE FABRICATION.


JOB NO.: J-853
PRODUCT: PROPOSED RESIDENTIAL DEVELOPMENT AT N.K.I.L. 6542 YIN PING ROAD KOWLOON
TITLE: PART ELEVATION/PART PLAN & PART SECTION FOR HOUSE GLASS BALUSTRADE
GLASS MARKING: DWG
DATE: 08-Dec-22 **SCALE:** 1:25 (A1)
DRAWN BY: Asing **CHECKED BY:**
DATE: 08-Dec-22 **SCALE:** 1:25 (A1)

CLIENT: SHIMAO GROUP HOLDINGS LIMITED
ARCHITECT: HOPE TIME & PARTNERS LIMITED
STRUCTURAL ENGINEER: C.M.WONG & ASSOCIATES LTD
FAÇADE CONSULTANT: MENYHARDT


MAIN CONTRACTOR: HIP HING CONSTRUCTION CO LTD
ARCHITECT: HOPE TIME & PARTNERS LIMITED
STRUCTURAL ENGINEER: C.M.WONG & ASSOCIATES LTD
FAÇADE CONSULTANT: MENYHARDT

DATE: 08-Dec-22 **SCALE:** 1:25 (A1)
DRAWN BY: Asing **CHECKED BY:**
DATE: 08-Dec-22 **SCALE:** 1:25 (A1)


CLIENT: SHIMAO GROUP HOLDINGS LIMITED
ARCHITECT: HOPE TIME & PARTNERS LIMITED
STRUCTURAL ENGINEER: C.M.WONG & ASSOCIATES LTD
FAÇADE CONSULTANT: MENYHARDT

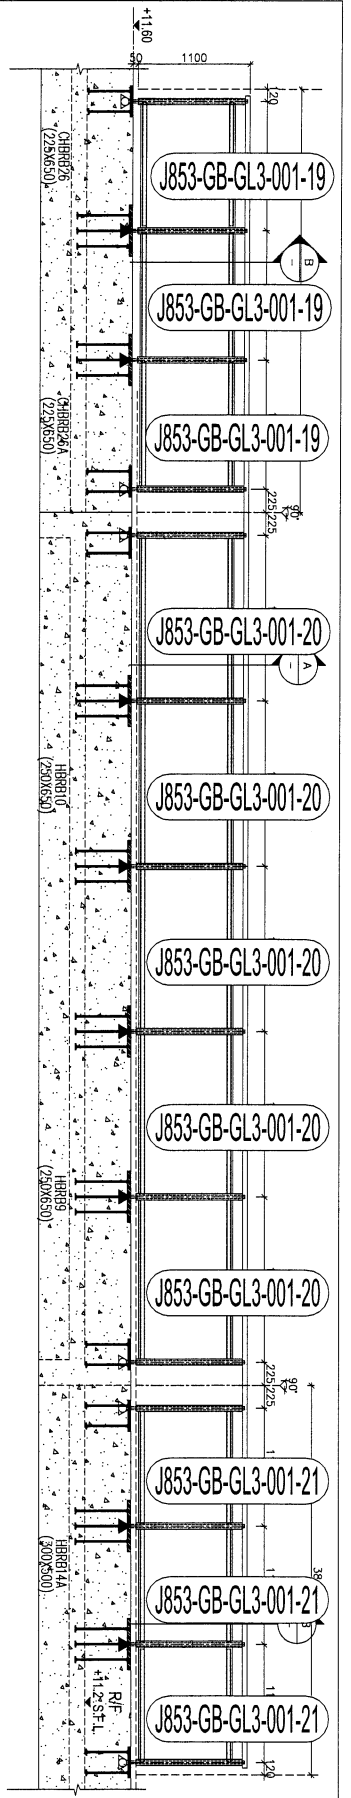

1 PARTIAL ELEVATION FOR HOUSE TYPE B (HOUSE NO. H01 & H02)

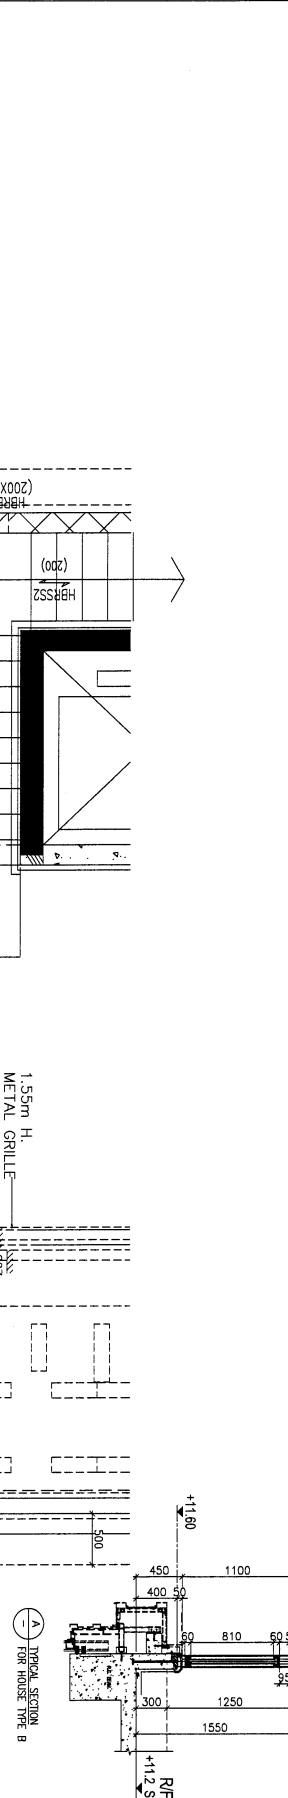

2 TYPICAL SECTION FOR HOUSE TYPE B

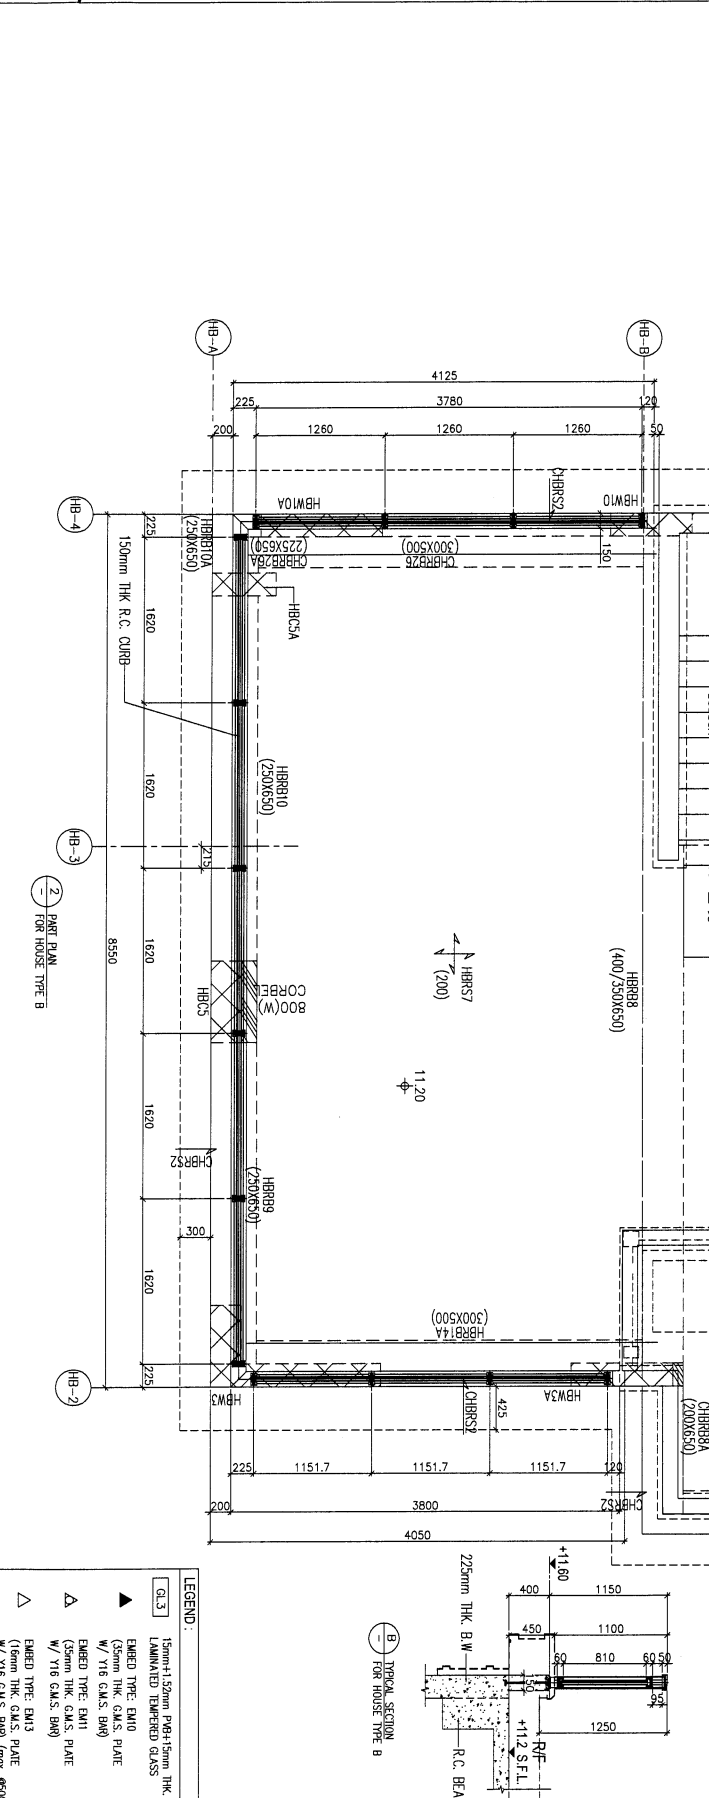

3 PART PLAN FOR HOUSE TYPE B

B.O. REF :
 CLIENT : SHIMAO GROUP HOLDINGS LIMITED
 ARCHITECT : HOOK TING & PARTNERS LIMITED
 MAIN CONTRACTOR :
 STRUCTURAL ENGINEER : C M WONG & ASSOCIATES LTD
 FACADE CONSULTANT : MEINHARDT

NOTE :
 1. ALL DIMENSIONS ARE IN MM.
 2. ALL EXTENSIONS ARE VIEWED FROM OUTSIDE BEFORE FABRICATION.
 3. ALL DIMENSIONS TO BE CHECKED ON SITE.
 LEGEND :
 (X) DETAIL MARK NO.
 (S) REFER SHEET NO.
 1. F.F.L. --- FINISHED FLOOR LEVEL
 2. S.F.L. --- STRUCTURAL FLOOR LEVEL
 3. (R) --- REVERSED DETAIL
 R.C. STRUCTURAL ELEMENT
 COL. / BEAM / SLAB
 IS (UNLESS SEPARATED SUBMISSION)

DATE	22/12/2023	GENERAL REVISED
D	2/12/2023	GENERAL REVISED
C	8/8/2023	GENERAL REVISED
B	10/5/2023	GENERAL REVISED
A	3/1/2023	GENERAL REVISED
NO.		REVISION
BY		

JOB NO. : J-853
 PROJECT : PROPOSED RESIDENTIAL DEVELOPMENT AT N.K.I.L. 6942 TIN PHING ROAD KOWLOON

TITLE : PART ELEVATION PART PLAN & R/C SECTION FOR HOUSE GLASS BALUSTRADE GLASS MARKING DWG

DATE : 08-Dec-22 SCALE : 1:25 (A1)
 DRAWN BY : Aiding CHECKED BY :
 UNIT 6-8, Sunny Industrial Centre, 1/F, 610 Che Kwo Ling Road, Kowloon
 TEL: 23489211-4 Fax: (852) 27272166
 DMC NO. : 853-09-3011 REV : -

LEGEND:
 GL3 15mm+15mm PROF+15mm THK EMBED TYPE ENJO (35mm THK G.M.S. PLATE W/ Y16 G.M.S. BAR)
 15mm+15mm PROF+15mm THK LAMINATED THERMO GLASS EMBED TYPE ENJO (35mm THK G.M.S. PLATE W/ Y16 G.M.S. BAR)
 EMBED TYPE ENJO (35mm THK G.M.S. PLATE W/ Y16 G.M.S. BAR)
 EMBED TYPE ENJO (15mm THK G.M.S. PLATE W/ Y16 G.M.S. BAR) (max. 4500x3000)

